



Florida Department of Transportation

RON DESANTIS
GOVERNOR

719 South Woodland Boulevard
DeLand, FL 32720

KEVIN J. THIBAUT, P.E.
SECRETARY

October 1, 2021

ADDENDUM NO. 2

To: PROSPECTIVE BIDDERS AND PLAN HOLDERS

FINANCIAL PROJECT NUMBER: 427986-1-72-28

CONTRACT NUMBER: E5X07

COUNTY: Volusia

DESCRIPTION: Drainage Repair

PLANS REVISION

Plan sheets 18, 19, and SQ-6 of the subject project have been revised. Please go to the Online Ordering Website at <https://fdotwp1.dot.state.fl.us/contractproposalprocessingonlineordering> to download the Plans Revision from your order history. Please substitute these sheets for the like-numbered sheets in the Plans you now have.

AMENDMENT NOTIFICATION

If you are a BID DOCUMENT HOLDER for the subject project, please go to the Online Ordering Website at <https://fdotwp1.dot.state.fl.us/contractproposalprocessingonlineordering/> to download Amendment File E5X07.002x for this Bid Document from your Order History.

If you are a BID DOCUMENT HOLDER, please acknowledge receipt of this Addendum in AASHTOWare Project Bids by opening the Acceptance of Bidding Acknowledgements folder and confirming your acknowledgement of Amendment and Addenda files. Failure to load all amendment files will cause the bid to be rejected.

Sincerely,

DocuSigned by:

A handwritten signature in black ink that reads "Michelle Sloan". The signature is written in a cursive style.

Michelle Sloan

Procurement Services Manager


District 5

SUMMARY OF MISCELLANEOUS DRAINAGE ITEMS (SR A1A from the Indian River Bridge to Callalisa Creek)

PAY ITEM NO.	PAY ITEM DESCRIPTION	LOCATION	SIDE	UNIT	QUANTITY	TOTAL		CONSTRUCTION REMARKS
		STA. TO STA.			P	P	F	
E431-1-21	PIPE LINER, CURED IN PLACE, 0-24"	299+30 TO 299+30	LT	LF	50			
E431-1-21	PIPE LINER, CURED IN PLACE, 0-24"	299+30 TO 299+30	RT	LF	30			
E431-1-21	PIPE LINER, CURED IN PLACE, 0-24"	303+12 TO 303+12	LT	LF	30			
E431-1-21	PIPE LINER, CURED IN PLACE, 0-24"	303+12 TO 303+12	RT	LF	30			
E431-1-21	PIPE LINER, CURED IN PLACE, 0-24"	308+58 TO 308+58	LT	LF	20			
E431-1-21	PIPE LINER, CURED IN PLACE, 0-24"	308+58 TO 308+58	RT	LF	20			
E431-1-21	PIPE LINER, CURED IN PLACE, 0-24"	313+38 TO 313+38	LT	LF	20			
E431-1-21	PIPE LINER, CURED IN PLACE, 0-24"	313+38 TO 313+38	RT	LF	20			
E431-1-21	PIPE LINER, CURED IN PLACE, 0-24"	315+50 TO 315+50	LT	LF	30			
E431-1-21	PIPE LINER, CURED IN PLACE, 0-24"	315+65 TO 315+65	RT	LF	20			
E431-1-21	PIPE LINER, CURED IN PLACE, 0-24"	322+38 TO 322+38	LT	LF	20			
E431-1-21	PIPE LINER, CURED IN PLACE, 0-24"	322+38 TO 322+38	RT	LF	20			
E431-1-21	PIPE LINER, CURED IN PLACE, 0-24"	325+38 TO 325+38	RT	LF	30			
E431-1-21	PIPE LINER, CURED IN PLACE, 0-24"	325+95 TO 325+95	LT	LF	20			
E431-1-21	PIPE LINER, CURED IN PLACE, 0-24"	328+25 TO 328+25	LT	LF	20			
E431-1-21	PIPE LINER, CURED IN PLACE, 0-24"	328+25 TO 328+25	RT	LF	20			
E431-1-21	PIPE LINER, CURED IN PLACE, 0-24"	330+65 TO 330+65	RT	LF	50			
E431-1-21	PIPE LINER, CURED IN PLACE, 0-24"	330+65 TO 330+65	RT	LF	20			
				TOTAL =	470			

REVISIONS

DATE	DESCRIPTION	DATE	DESCRIPTION




D5 DELAND OPERATIONS
 Scott Kiris, P.E.
 No. 79378
 1658 North Kepler Road
 DeLand, Florida 32724

STATE OF FLORIDA
 DEPARTMENT OF TRANSPORTATION


ROAD NO.	COUNTY	FINANCIAL PROJECT ID
SR A1A	VOLUSIA	427986-1-72-28

SUMMARY OF QUANTITIES

SHEET NO.
 SQ-6

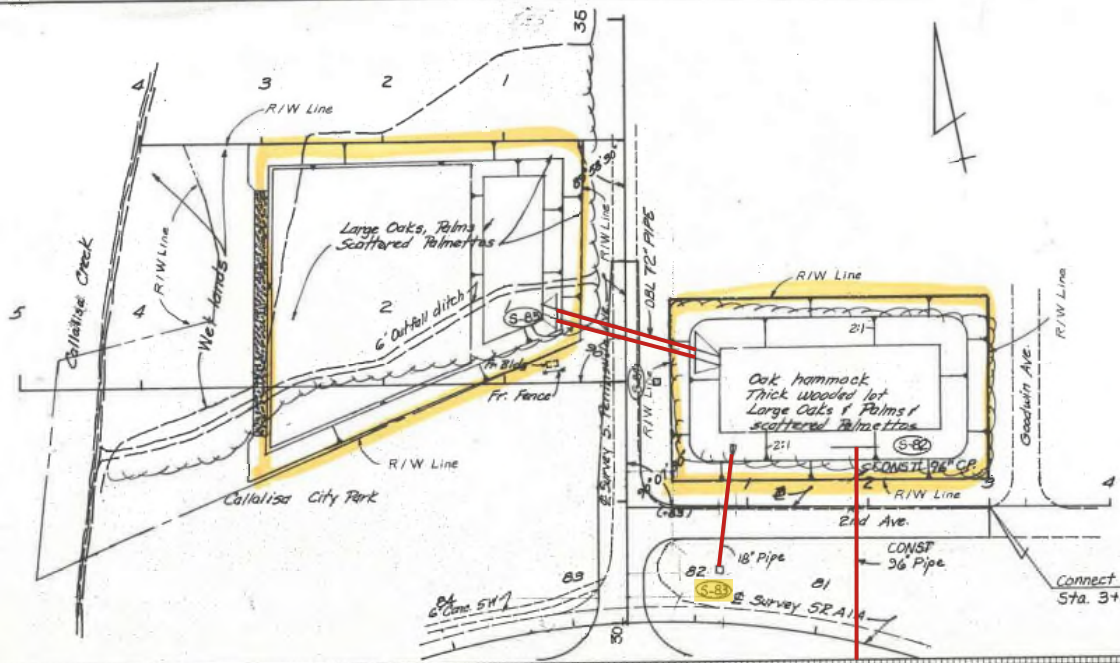


Note:
For details of Water Retention Areas
See Sheet No. 27

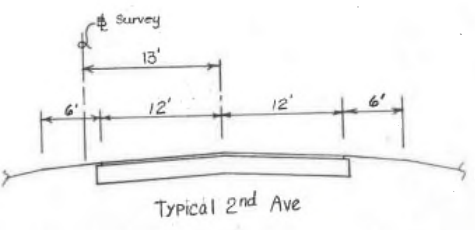

Scale 1"=50'

SEE SHEET 10 OF EXISTING PLANS FOR
OUTFALL PIPE FROM A1A

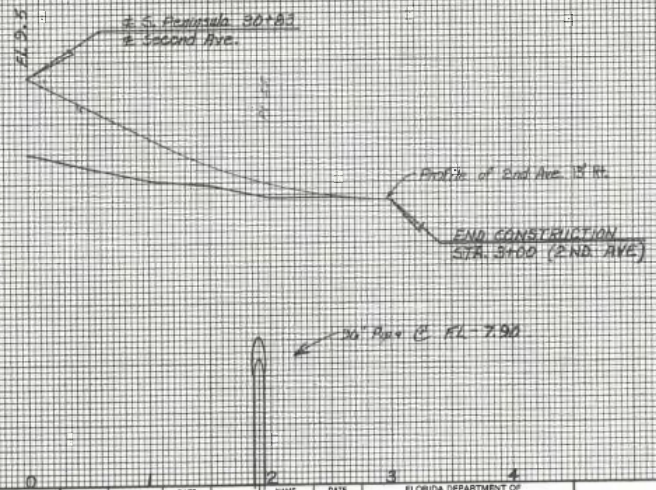

REVISIONS				FLORIDA DEPARTMENT OF TRANSPORTATION			
DATE	BY	DESCRIPTION	DATE	BY	DESCRIPTION	NAME	DATE
						J. R. H.	1-88
						D. M. B.	2-88
						J. R. H.	2-88
						H. M. B.	2-88

Plan and Profile Second Ave.

STANDARD PLAN AND PROFILE SHEET
YOUR PERMANENT FILES