



Florida Department of Transportation

RON DESANTIS
GOVERNOR

605 Suwannee Street
Tallahassee, FL 32399-0450

KEVIN J. THIBAUT, P.E.
SECRETARY

March 12, 2020

ADDENDUM NO. 1

TO: PROSPECTIVE BIDDERS AND PLAN HOLDERS

PROPOSAL/CONTRACT ID: T3756

FINANCIAL PROJECT NUMBER(S): 436615 1 52 01

FEDERAL AID PROJECT NUMBER(S): D318121B

COUNTY(IES): Gadsden

PROJECT NAME(S): CR 268 (High Bridge Rd.), From Joe Adams Rd. To Brickyard Rd.

BIDS TO BE RECEIVED: March 25, 2020

CLARIFICATION

Attached please find a clarification issued for this proposal.

AMENDMENT NOTIFICATION

If you are a BID DOCUMENT HOLDER for the subject project, please go to the Online Ordering Web Site at <https://fdotwp1.dot.state.fl.us/contractproposalprocessingonlineordering> to download Amendment File T3756.001 for this Bid Document from your Order History.

If you are a BID DOCUMENT HOLDER, please acknowledge receipt of this Addendum in AASHTOWare Project Bids by opening the Acceptance of Bidding Acknowledgements folder and confirming your acknowledgement of Amendment and Addenda files. Failure to load all amendment files will cause the bid to be rejected.

Sincerely,

A handwritten signature in blue ink that reads "Alan Autry". The signature is fluid and cursive, with a long horizontal stroke at the end.

Alan Autry, Manager
Contracts Administration Office

AA:cj

Attachment



Florida Department of Transportation

RON DESANTIS
GOVERNOR

1074 Highway 90
Chipley, Florida 32428

KEVIN J. THIBAUT, P.E.
SECRETARY

March 5, 2020

Ms. Lisa Robinson
Public Works Director
Gadsden County Roadway Dept.
1284 High Bridge Rd
Quincy, FL 32351

SUBJECT: Bridge Closure – Bridge No. 500045

Dear Ms. Robinson:

This letter is to inform you of the deficiencies of Bridge No. 500045, CR 268 over Little River. Following our inspection, it has been determined that the bridge must be **closed** until the following deficiencies have been corrected:

- Backfill and place bank and shore riprap in Spans 2 through 17.
- Install crutch bents at Bents 17 through 23.
OR
- Replace bridge.

Upon closure of the structure and once reopened after completion of repairs, please notify Tenille Fielding at tenille.fielding@dot.state.fl.us. If you need additional information, please call the District Three Structures Maintenance Office at (850) 638-0250.

Florida Statute 335.074 – Safety Inspection of Bridges – Section 5 as modified by the 2012 Legislature now requires the governmental entity having maintenance responsibility to reduce the maximum load limits or close the bridge as per the inspection report’s recommendation. Posting limits shall occur within 30 days of notification. Bridge closures shall be done immediately. If the maintaining entity does not meet these time limits, the Florida Department of Transportation is required to post or close the bridge as recommended and assess the costs to the maintaining entity.

Sincerely,

A handwritten signature in blue ink that reads "April Day Williams".

April Day Williams, P.E.

District Structures Maintenance Engineer

CC: Tim Hendrix, David Riley, Steven Fisher, Timothy Barnard, Tenille Fielding, David Orr, David Stump, William Lynes, Zeidie Sisk

Element 8290 – Channel

CONDITION STATE 4

No Change:

1. There is scour beneath the bridge between Spans 2 and 17, with depths up to 7.0 ft deep (See Sketch 1). This bridge has piles of unknown length.
2. Scour, up to 5.1 ft deep, has occurred at Bents 17 through 23 since the 1990 report (See Scour Critical Sketch 1). This bridge has piles of unknown length.
3. The groundline elevation at Bent 22 has previously surpassed the estimated pile tip elevation and localized scour 4.0 ft deep has occurred since the December 2019 inspection (See Scour Critical Sketch 2).

Element 227 – Re Conc Pile


CONDITION STATE 4

No Change:

1. Scour, up to 7.0 ft deep, has occurred at Bents 17 through 23, reducing the pile embedment (See Sketch 1). This bridge has piles of unknown lengths.


BRIDGE NO. 500045
GADSDEN COUNTY

227 RE CONC PILE
8290 CHANNEL

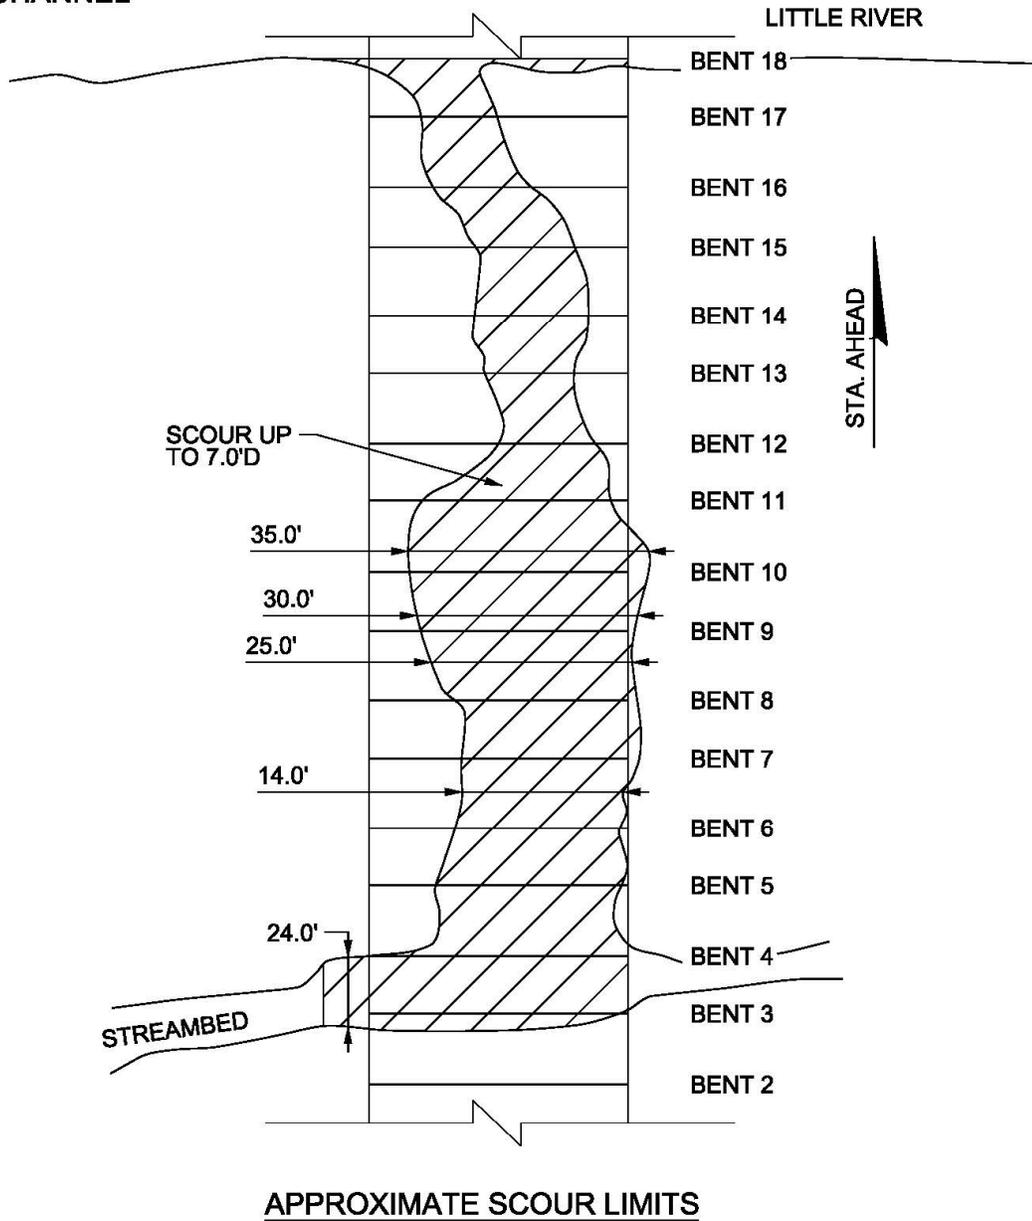


Sketch 1: Scour in Spans 2 through 17

BRIDGE NO. 500045
GADSDEN COUNTY

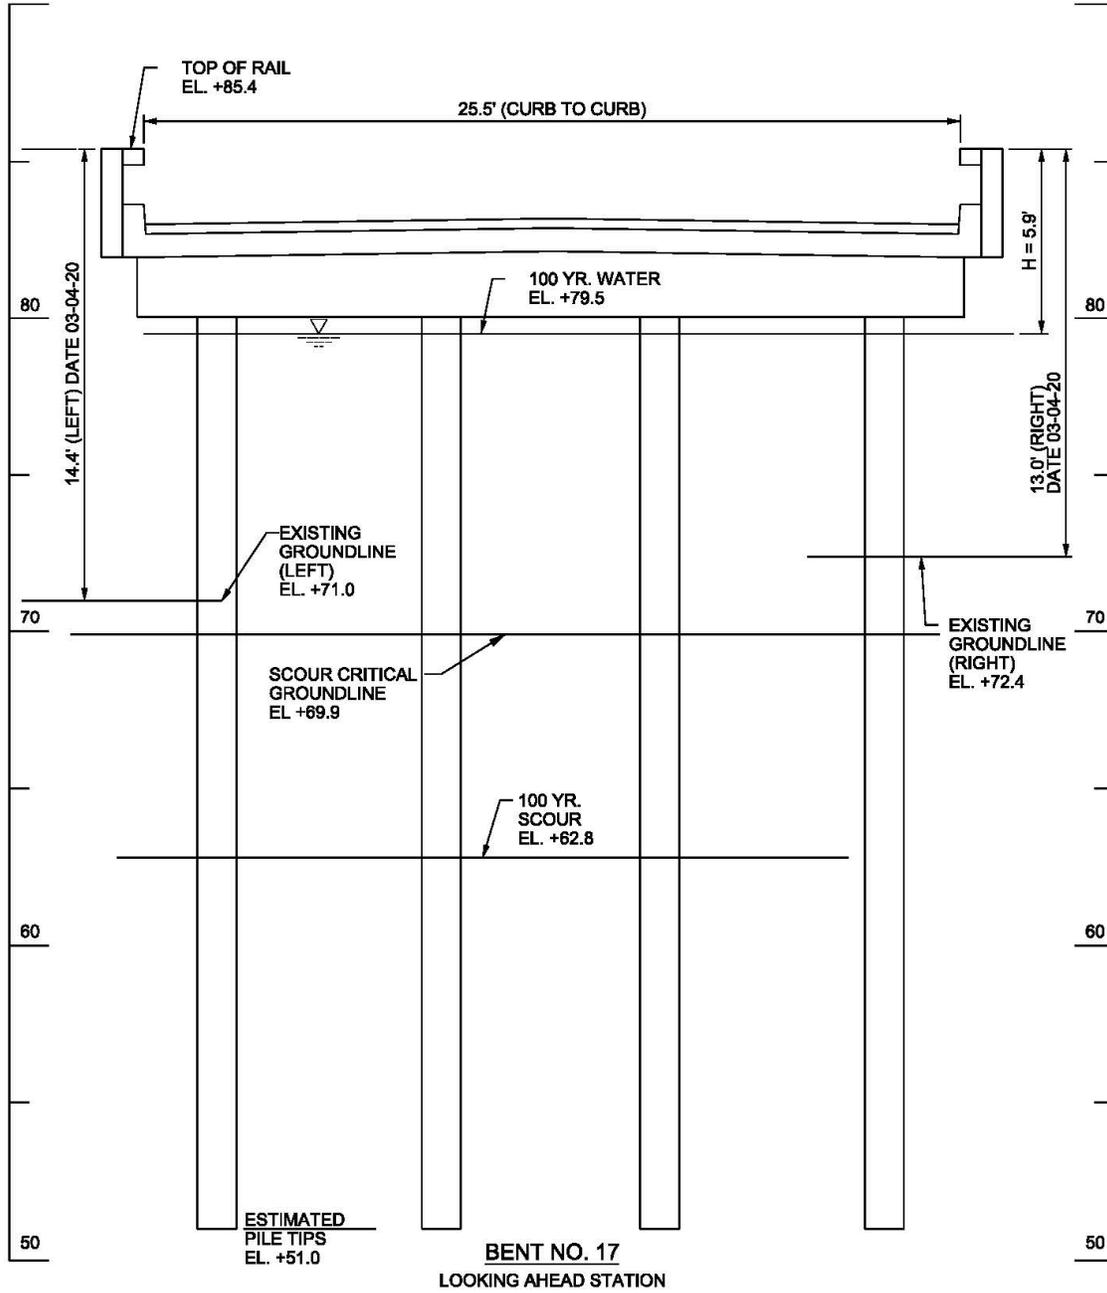

Scour Critical Sketch 1

BRIDGE NO. 500045
GADSDEN COUNTY

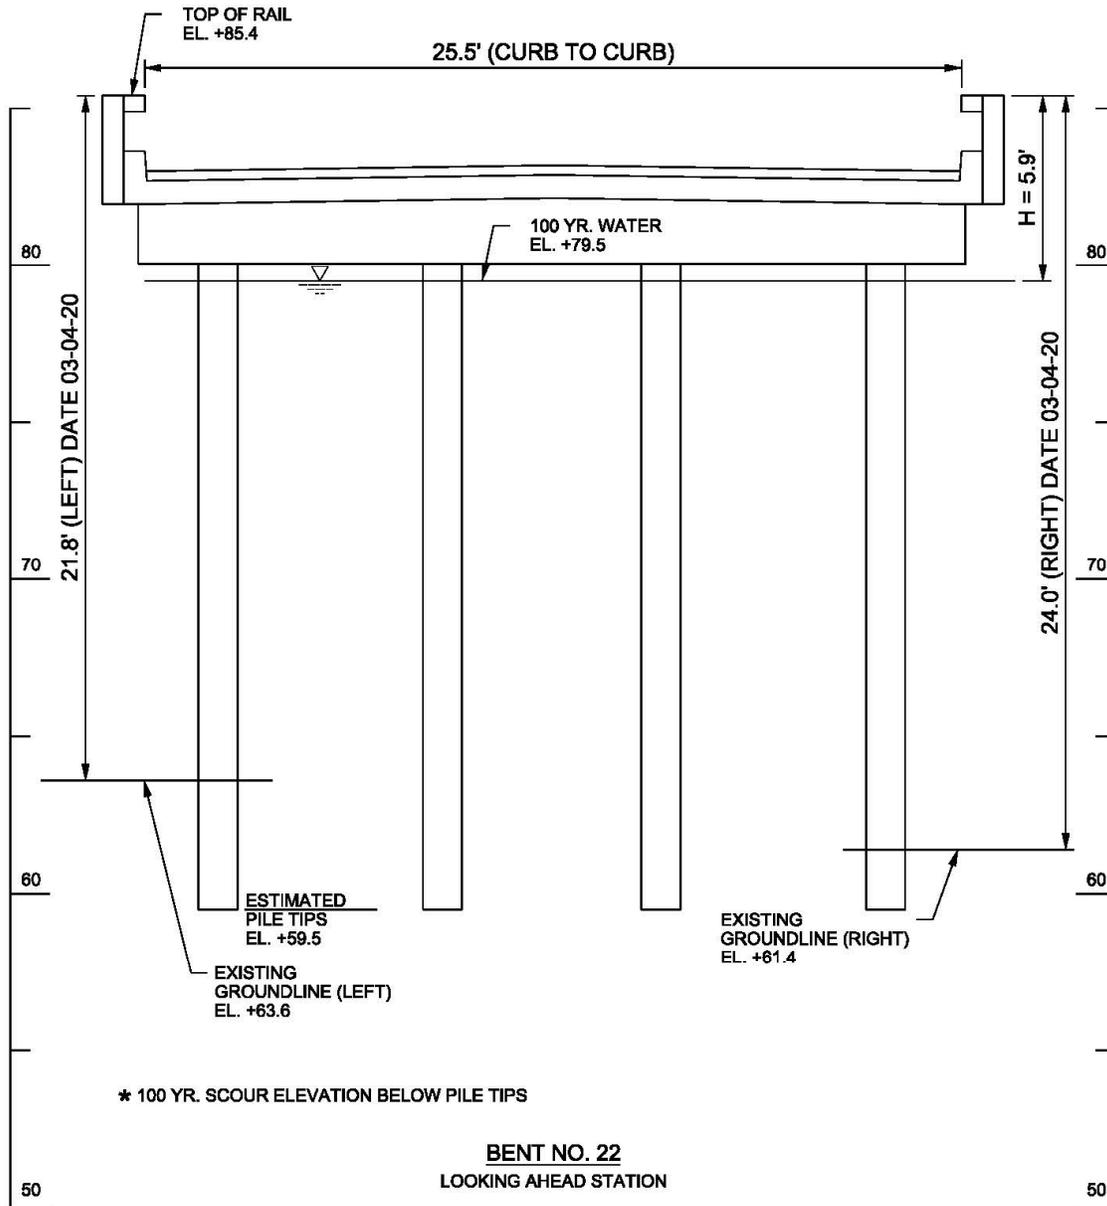

Scour Critical Sketch 2