

# ORIGINATION FORM

Proposed Revisions to a Standard Plans Index  
(Please provide all information – Incomplete forms will be returned)

## Contact Information:

Date: August 1, 2018  
Originator: Richard Stepp  
Phone: (850) 414-4313  
Email: richard.stepp@dot.state.fl.us

## Standard Plans:

Index Number: 521-010  
Sheet Number (s): New Sheets 1,2  
Index Title: Opaque Visual Barrier

## Summary of the changes:

New Sheet 1: Provide designs for all variations of Single-Slope and existing F-Shape barriers; tighten spacing of vertical and horizontal reinforcing steel, create a minimum transverse joint spacing to ensure sufficient dowel connection to barrier; create leave-out concept for measurement; add accommodation for welded wire reinforcing and variable barrier heights

New Sheet 2: Add detail for discontinuation at 56" height barrier sections; Add detail for continuing over 44" height barrier sections

## Commentary / Background:

Redeveloped entire Standard for improved functionality and clarity of details.  
Added new FDM verbiage and created all new SPI for guidance on usage.  
Added new coordination of Standard with Specification Section 521 and corresponding new Pay Item.

## Other Affected Offices / Documents: (Provide name of responsible personnel)

- | Yes                                 | No                                  |  |
|-------------------------------------|-------------------------------------|--|
| <input type="checkbox"/>            | <input checked="" type="checkbox"/> | Other Standard Plans –                     |
| <input checked="" type="checkbox"/> | <input type="checkbox"/>            | FDOT Design Manual – Mary Jane Hayden      |
| <input checked="" type="checkbox"/> | <input type="checkbox"/>            | Basis of Estimates Manual – Melissa Hollis |
| <input checked="" type="checkbox"/> | <input type="checkbox"/>            | Standard Specifications – Dan Hurtado      |
| <input type="checkbox"/>            | <input checked="" type="checkbox"/> | Approved Product List –                    |
| <input type="checkbox"/>            | <input checked="" type="checkbox"/> | Construction –                             |
| <input type="checkbox"/>            | <input checked="" type="checkbox"/> | Maintenance –                              |


## Origination Package Includes: (Email or hand deliver package to Derwood Sheppard)

- | Yes                                 | N/A                                 |   |
|-------------------------------------|-------------------------------------|---|
| <input type="checkbox"/>            | <input checked="" type="checkbox"/> | Redline Mark-ups                          |
| <input type="checkbox"/>            | <input checked="" type="checkbox"/> | Proposed Standard Plan Instructions (SPI) |
| <input checked="" type="checkbox"/> | <input type="checkbox"/>            | Revised SPI                               |
| <input type="checkbox"/>            | <input checked="" type="checkbox"/> | Other Support Documents                   |

## Implementation:

- Design Bulletin (Interim)    DCE Memo    Program Mgmt. Bulletin    FY-Standard Plans (Next Release)

Contact the Roadway Design Office for assistance in completing this form

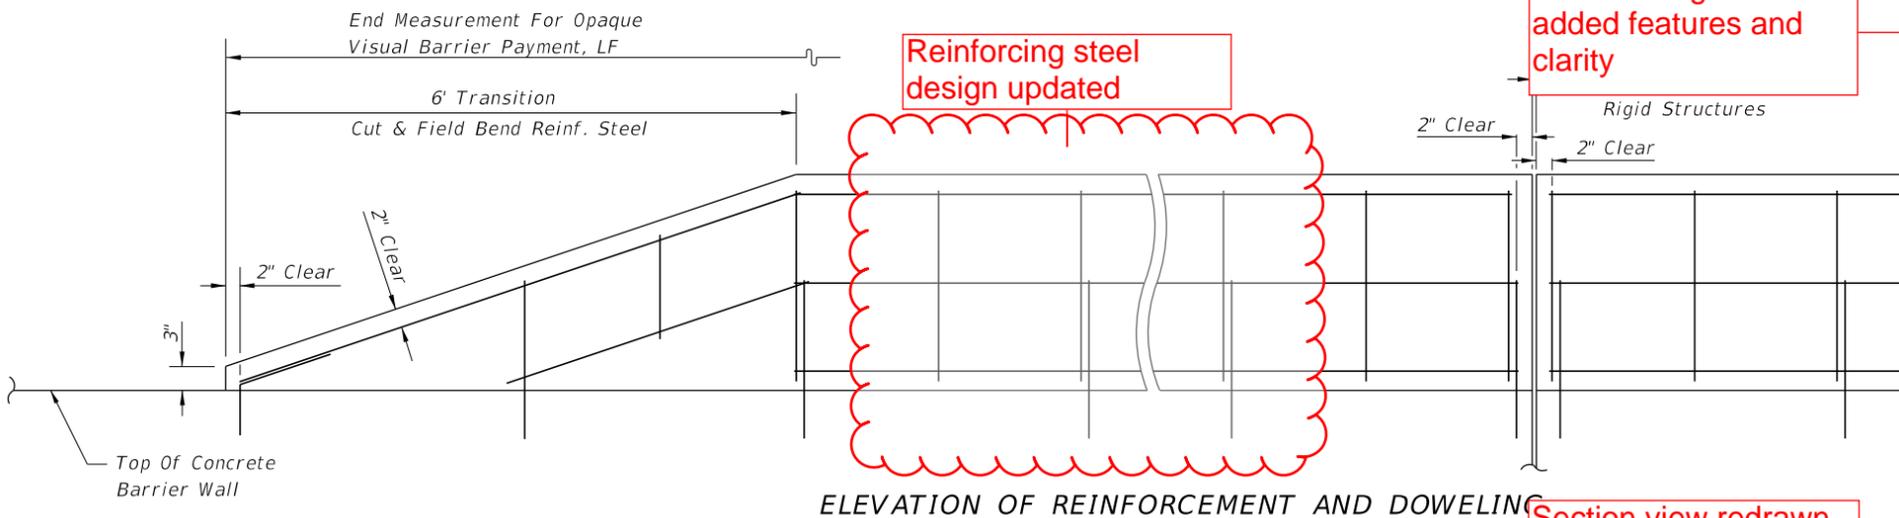


ELEVATION OF REINFORCEMENT AND DOWELING

**Redeveloped Standard to update design and add additional features, including:**

1. new heights for Single-Slope Concrete Barrier, Traffic Railing, and all existing F-Shape
2. tighter spacing of reinforcing steel
3. minimum transverse joint spacing
4. "leave-out" concept for handling barrier-mounted structures
5. accommodation for welded wire reinforcing and variable barrier heights

ESTIMATED QUANTITIES, LF	
Concrete	0.042 CY
Reinforcing Steel	3.27 Lbs.*
*5.38 Lbs. With 2'-2" Dowels	

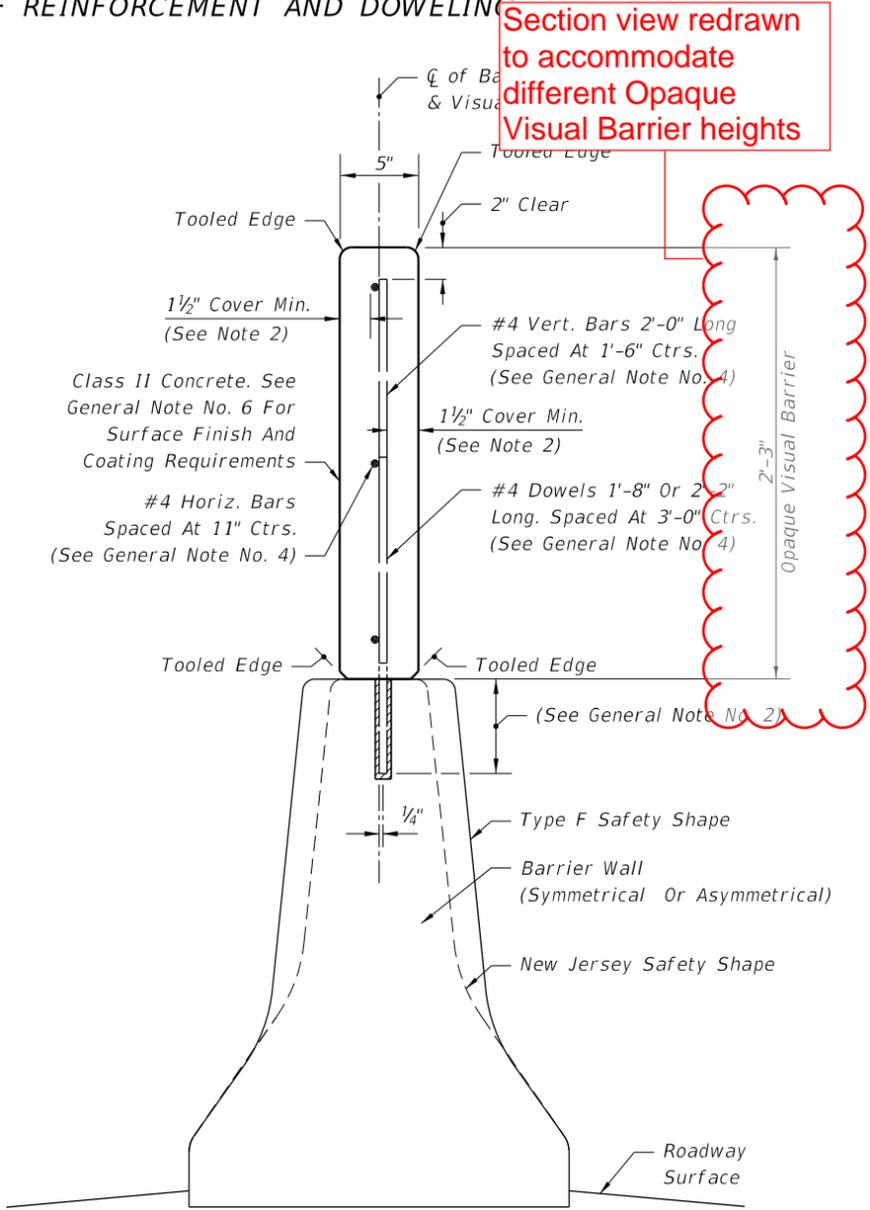

END VIEW


Notes re-organized for added features and clarity

**GENERAL NOTES**


1. The opaque visual barrier is intended to function as a visual screen, and is not intended to resist vehicle impact loads nor to restrain, contain or restrict vehicles or cargo. The barrier is designed to withstand zone wind loading and strikes by light debris; and, designed to yield to exceptional strikes by vehicles or cargo, and to contain ruptured segments of the screen when yielding to such strikes.
2. When the opaque visual barrier is constructed on an existing barrier wall, dowels shall be 1'-8" in length, embedded 6" into the barrier wall and set with an approved non shrink grout. Embedment holes shall be 5#8" diameter, drilled to a depth 1#4" below the tip of the dowel unless greater depth is required to accept manufactured grout capsules.  
  
When the opaque visual barrier is constructed in conjunction with project concrete barrier walls, dowels may be set as described above, in either the drilled or preformed holes; or, placed when the barrier wall is cast. For dowels that are placed when the wall is cast, the dowel shall be 2'-2" in length and embedded to a depth of 12".  
  
When longitudinal reinforcing bars are encountered in the stem of existing barrier, shift the dowels to clear, maintaining the 11#2" Cover Minimum to the face of the Opaque Visual Barrier.
3. For both double and single faced concrete barrier walls the opaque visual barrier is to be located in the center of the top of the wall.  
  
For single faced barrier walls that are constructed around other vertical structures, the opaque visual barrier shall follow the alignments of only one of the walls and be centered atop that wall.  
  
For dual median barrier walls that follow differential profiles, the opaque visual barrier shall be constructed atop the wall with the higher elevation, unless conditions dictate otherwise. Lateral transitions or end overlaps for opaque visual barriers that alternate between dual walls shall be detailed in the plans.  
  
For median barrier walls that are divided when connecting to separated bridges, the opaque visual barrier shall be constructed atop the approach side barrier wall, unless differential profiles dictate locating the opaque visual barrier on the departure side barrier wall.  
  
Opaque visual barriers to be located on capped fills between dual barrier walls shall be detailed in the plans.
4. In lieu of the reinforcement shown, the Contractor may substitute welded wire fabric equal to or better than that shown, when approved by the Engineer. Details shall be submitted with requests for substitution.
5. The Contractor may construct contiguous precast concrete panels in lieu of the cast-in-place opaque screen when approved by the Engineer. Panel design and method for anchorage to the barrier wall shall be detailed by shop drawings when requesting the Engineer's approval.  
  
The Contractor may construct the opaque screen monolithically with the barrier wall; however, the screen design shall not be modified so as to cause the wall to be dynamically active from strikes on the screen; see design considerations in Note No. 1 above.
6. Exposed concrete surfaces shall have a Class 3 surface finish in accordance with Section 521 of the Standard Specification, unless another finish is called for in the plans.
7. Payment for opaque visual barrier shall be full compensation for concrete, reinforcement, dowels, casting, placement, drilling, grouting, tooling, finishing and work incidental thereto, and shall be paid for under the contract unit price for Opaque Visual Barrier (Concrete) (2'-3" Height), LF.

10/16/2017 1:31:59 PM



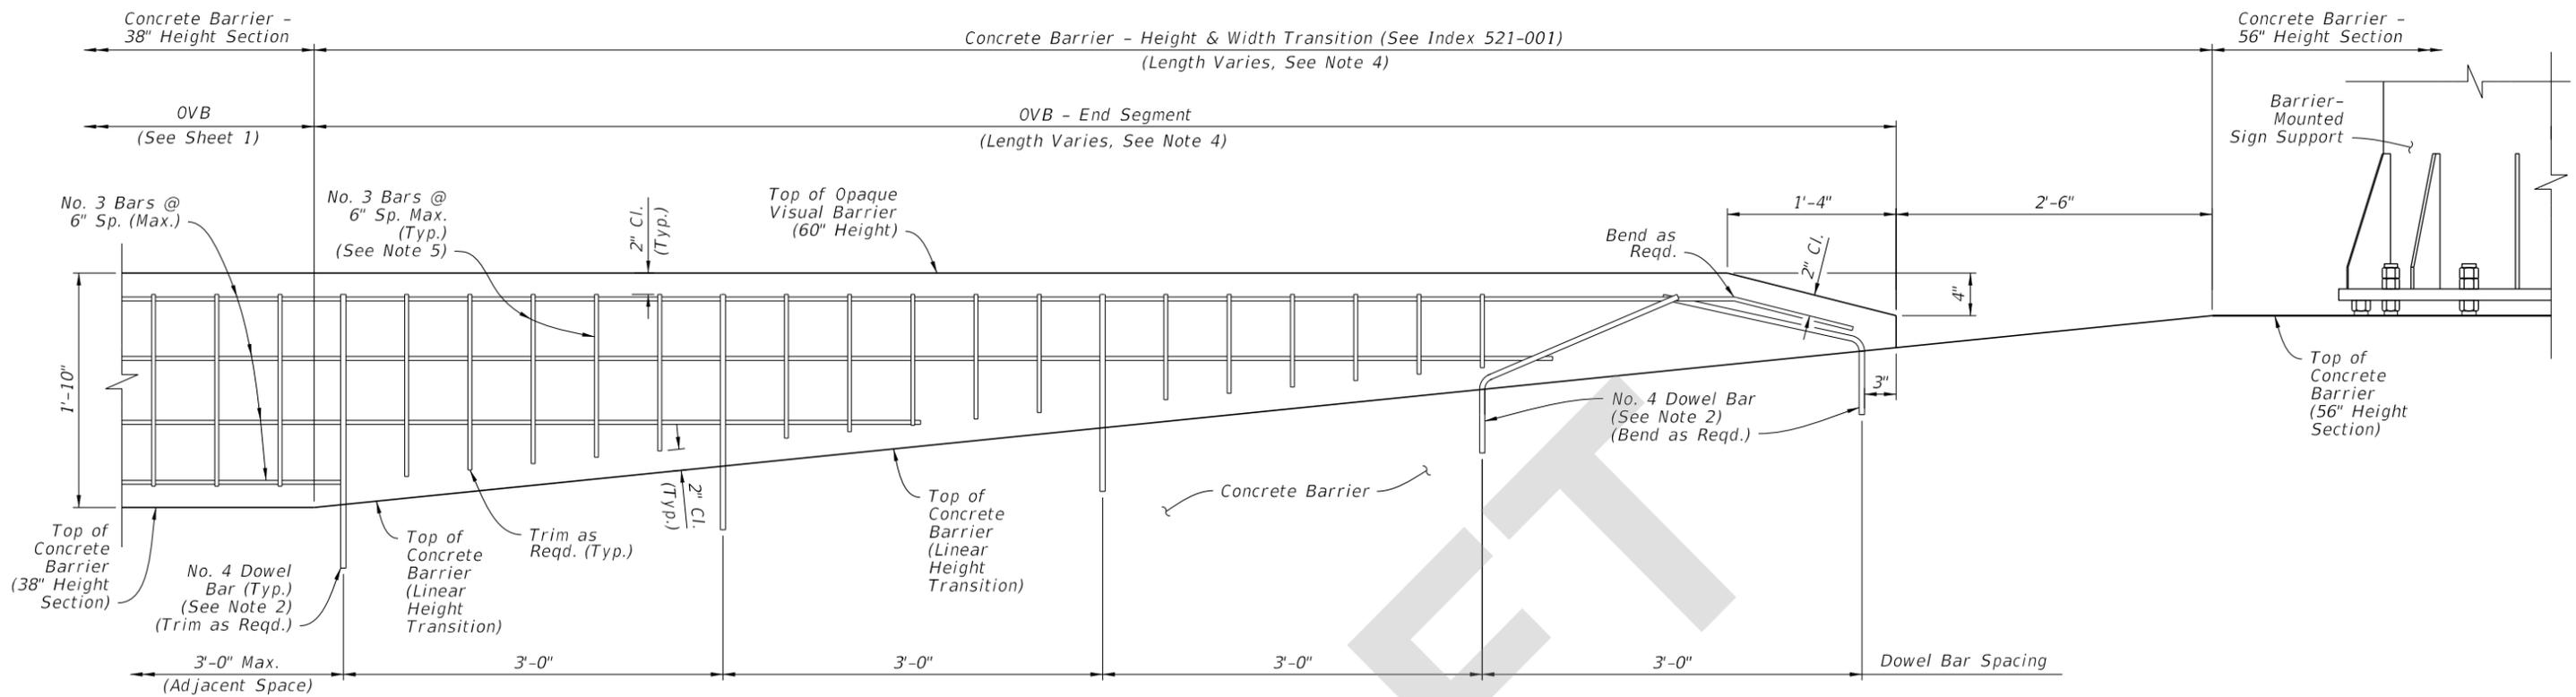

**ELEVATION VIEW 'A' - OVB END SEGMENT AT CONCRETE BARRIER HEIGHT TRANSITION FROM 38" HEIGHT TO 56" HEIGHT SECTION (REVERSE DIRECTION SIMILAR BY OPPOSITE HAND)**

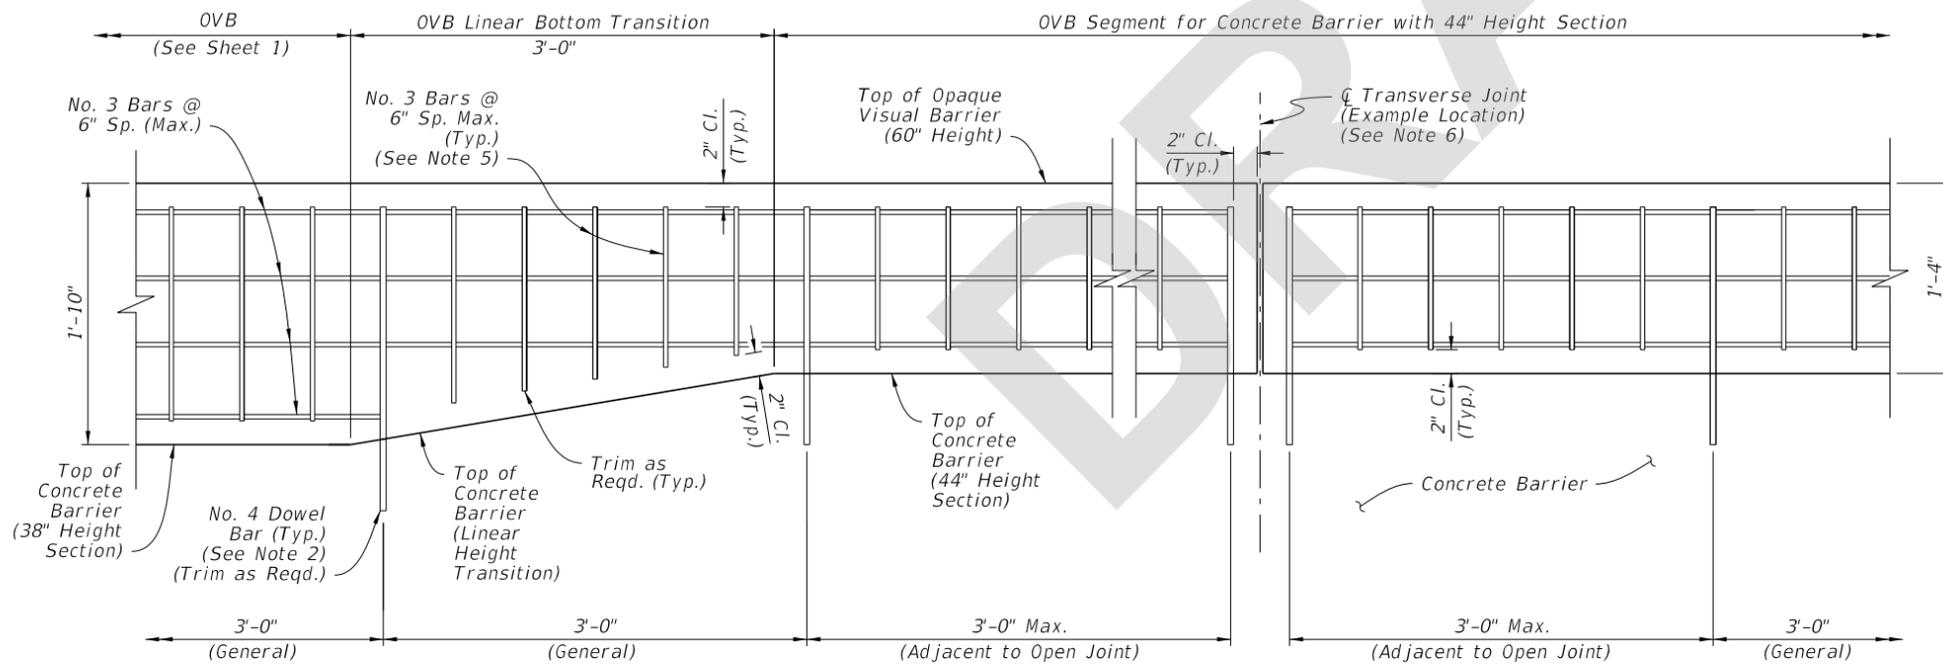

**ELEVATION VIEW 'B' - OVB SEGMENT FOR CONCRETE BARRIER WITH 44" HEIGHT SECTION (OVB LINEAR BOTTOM TRANSITION SHOWN, REVERSE DIRECTION SIMILAR BY OPPOSITE HAND)**

**NOTES:**

- LATERAL DIMENSIONS:** Maintain the OVB section width and lateral placement as defined on Sheet 1.
- DOWEL BAR LENGTHS & CONNECTIONS:** For the differing OVB section heights, trim or adjust the dowel bar lengths as required to meet the clearances shown while maintaining the dowel bar connection requirements of Sheet 1.  
Elevation View 'A' - For the two dowel bars closest to the OVB end location, use full dowel bar lengths and bend as shown to maintain clearances. Overlapping dowel bars may deviate from the lateral centerline as required.
- DOWEL BAR SPACING:**  
Elevation View 'B' - The dowel locations shown in this detail are examples only, and may shift to maintain the spacing pattern that is governed by adjacent OVB. Maintain the dowel bar spacing scheme as defined on Sheet 1; place dowel bars within the OVB Linear Bottom Transition as required.
- SEGMENT LENGTHS:**  
Elevation View 'A' - The length of the OVB End Segment is governed by the length of linear width and height transition of the Concrete Barrier.  
Elevation View 'B' - The length of the reduced-section OVB segment is governed by the length of Concrete Barrier with 44" Height Section.
- VERTICAL REINFORCING:** For the differing OVB section heights, trim or adjust the vertical No. 3 Bar lengths as required to meet the clearances shown.
- TRANSVERSE JOINTS:**  
Follow the requirements of Sheet 1.  
Elevation View 'A' - Do not place Transverse Joints within the End Segment.  
Elevation View 'B' - Maintain the Transverse Joint spacing scheme as defined on Sheet 1; place dowel bars within the OVB Linear Bottom Transition as required.

8/15/2018 5:11:00 PM

LAST REVISION 11/01/18	DESCRIPTION:	 FY 2019-20 STANDARD PLANS	<b>OPAQUE VISUAL BARRIER</b>	INDEX <b>521-010</b>	SHEET <b>2 of 2</b>
---------------------------	--------------	---	------------------------------	-------------------------	------------------------