

# ORIGINATION FORM

Proposed Revisions to a Standard Plans Index  
(Please provide all information – Incomplete forms will be returned)

## Contact Information:

Date: April 2, 2017  
Originator: **Andre Pavlov**  
Phone: (850) 414-4293  
Email: andre.pavlov@dot.state.fl.us

## Standard Plans:

Index Number: **715-002**  
Sheet Number (s): 1-5 of 8  
Index Title: Standard Aluminum Lighting

## Summary of the changes: Sheet 1: Changed GENERAL NOTE 4.B

Sheet 2: Updated all details - deleted or revising pole dimensions.

Sheet 3: Added duel dimensions to the ARM CONNECTION DETAIL and SECTION A-A; Deleted the ARM TABLE and its notes; Changed the ARM TUBE EXTRUSIONS NOTES.

Sheet 4: Changed FOUNDATIONS Depth Requirement Depth; Added duel dimensions to the POLE BASE ELEVATION; Deleted All Tables and Added new tables; Updated the NOTES.

Sheet 5: Added duel dimensions to the BASE PLATE PLAN; Deleted the POLE TABLE; Updated NOTES.

## Commentary / Background:

## Other Affected Offices / Documents: (Provide name of responsible personnel)

- | Yes                      | No                       |                             |
|--------------------------|--------------------------|-----------------------------|
| <input type="checkbox"/> | <input type="checkbox"/> | Other Standard Plans –      |
| <input type="checkbox"/> | <input type="checkbox"/> | FDOT Design Manual –        |
| <input type="checkbox"/> | <input type="checkbox"/> | Basis of Estimates Manual – |
| <input type="checkbox"/> | <input type="checkbox"/> | Standard Specifications –   |
| <input type="checkbox"/> | <input type="checkbox"/> | Approved Product List –     |
| <input type="checkbox"/> | <input type="checkbox"/> | Construction –              |
| <input type="checkbox"/> | <input type="checkbox"/> | Maintenance –               |

## Origination Package Includes: (Email or hand deliver package to Derwood Sheppard)

- | Yes                                 | N/A                      |   |
|-------------------------------------|--------------------------|---|
| <input checked="" type="checkbox"/> | <input type="checkbox"/> | Redline Mark-ups                          |
| <input type="checkbox"/>            | <input type="checkbox"/> | Proposed Standard Plan Instructions (SPI) |
| <input type="checkbox"/>            | <input type="checkbox"/> | Revised SPI                               |
| <input type="checkbox"/>            | <input type="checkbox"/> | Other Support Documents                   |

## Implementation:

- Design Bulletin (Interim)    DCE Memo    Program Mgmt. Bulletin    FY-Standard Plans (Next Release)

Contact the Roadway Design Office for assistance in completing this form

**GENERAL NOTES:**

1. Poles are designed to support the following:
  - A. Luminaire Effective Projected Area (EPA): 1.55 SF
  - B. Weight: 75 lb.
2. Shop Drawings: This Index is considered fully detailed, only submit shop drawings for minor modifications not included in the Plans.
3. Materials:
  - A. Pole, Pole Connection Extrusions and Arm Extrusions: ASTM B221, Alloy 6063-T6
  - B. Bars, Plates, Stiffeners and Backer Ring: ASTM B221, Alloy 6063-T6
  - C. Caps and Covers: ASTM B-26, Alloy 319-F
  - D. Steel Bearing Plate: ASTM A709 or ASTM A36 Grade 36
  - E. Aluminum Weld Material: ER 4043
  - F. Transformer and Frangible Base Materials: ASTM B26 or ASTM B108, Alloy 356-T6
  - G. Bolts, Nuts and Washers:
    - a. Shoe Base Bolts: ASTM F3125, Grade A325, Type 1
    - b. Nuts: ASTM A563 Grade DH Heavy-Hex
    - c. Washer: ASTM F436 Type 1
  - H. Anchor Bolts, Nuts, and Washers:
    - a. Anchor Bolts: ASTM F1554 Grade 55
    - b. Nuts: ASTM A563 Grade A Heavy-Hex
    - c. Plate Washer: ASTM A36
  - I. Stainless Steel Fasteners: ASTM F593 Alloy Group 2, Condition A, CW1 or SH1
  - J. Nut Covers: ASTM B26 (319-F)
  - K. Concrete: Class 1
  - L. Reinforcing Steel: Specification Section 415
4. Fabrication:
  - A. Weld Arm and Pole (Alloy 6063) in the T4 temper using 4043 filler. Age the Arm and Pole artificially to the T6 temper after welding.
  - B. ~~Upright Splices: Not Allowed.~~ Transverse welds are only allowed at the base.
  - C. Roadway Light Pole Taper: Taper as required to provide a round top O.D. of 6" and a base O.D. of 10". Portions of the pole near the base shoe and at the arm connections may be held constant at 10" and 6" respectively to simplify fabrication.
  - D. Median Barrier Mounted Light Pole Taper: Taper as required to provide a 6" O.D. round top with an 11" x 7" O.D. oblong base. Portions of the pole near the base and at the arm connections may be held constant at 11"x 7" oblong and 6" round respectively to simplify fabrication.
  - E. Provide 'J', 'S' or 'C' hook at top of pole for electrical wires.
  - F. Equip poles located on bridges, walls and concrete median barriers/Traffic Railings with a vibration damper.
  - G. Perform all welding in accordance with AWS D1.2.
  - H. Embedded Junction Box (EJB):
    - a. Weld all seams continuously and grind smooth.
    - b. Hot Dip Galvanize after Fabrication.
    - c. Provide a watertight cover with neoprene gasket and secure cover with galvanized screws.
  - I. For Median Barrier Mounted Aluminum Light Poles, the fabricator must demonstrate the ability to produce a crack free pole. The fabricator's Department-approved QC Plan must contain the following information prior to fabrication:
    - a. Tests demonstrating a pole with a 1/4" wall thickness achieves an ultimate moment capacity of 36 kip\*ft in the strong axis and 30 kip\*ft in the weak axis.
    - b. Tests demonstrating a pole with a 5/16" wall thickness achieves an ultimate moment capacity of 44 kip\*ft in the strong axis and 37 kip\*ft in the weak axis.
    - c. Test results showing the pole does not buckle at the shape transition area under the ultimate moment capacity loads.
    - d. Complete details and calculations for the reinforced 4"x 6" (Min.) handhole located 1'-6" above the base plate.
  - J. Identification Tag: (Submit details for approval.)
    - a. 2" x 4" (Max.) aluminum identification tag.
    - b. Locate on the inside of the transformer base and visible from the door opening.
    - c. Secure to transformer base with 1/8" diameter stainless steel rivets or screws.
    - d. Include the following information on the ID Tag:
      1. Financial Project ID
      2. Pole Height
      3. Manufacturer's Name

**ADDED:  
or Alloy 6061-T6**

**Deleted**

5. Coatings/Finish:
  - A. Pole and Arm Finish: 50 grit satin rubbed.
  - B. Galvanize Steel Bolts, Screws, Nuts and Washers: ASTM F2329
  - C. Hot Dip Galvanize EJB and other steel items including poles: ASTM A123
- Construction:
  - A. Foundation: Specification Section 455, except payment for the foundation and plant washers pole.
  - B. Frangible Base, Base Shoe, and Clamp:
    - a. Certify that the Clamp, Frangible Transformer Base, and Base Shoe Design are capable of providing the required capacity.
    - b. Certify the Base conforms to the current FHWA required AASHTO Frangibility Requirements, tested under NCHRP Report 350 Guidelines (e.g. Akron Foundry TB1-17).
    - c. Do not erect pole without Luminaire attached.
7. Embedded Junction Box (EJB): Install EJBs per Note 4 and in accordance with Specification Section 635, as shown on the following Sheets.
8. Wind Speed by County:
 

**120 MPH**  
Alachua, Baker, Bradford, Calhoun, Clay, Columbia, Dixie, Duval, Gadsden, Gilchrist, Hamilton, Jackson, Jefferson, Lafayette, Leon, Liberty, Nassau, Madison, Putnam, Suwannee, Taylor, Union and Wakulla Counties.


**140 MPH**  
Bay, Citrus, De Soto, Flagler, Franklin, Glades, Gulf, Hardee, Hendry, Hernando, Highlands, Hillsborough, Holmes, Lake, Levy, Manatee, Marion, Okaloosa, Okeechobee, Orange, Osceola, Pasco, Pinellas, Polk, Santa Rosa, Seminole, St. Johns, Sumter, Volusia, Walton and Washington Counties.

**160 MPH**  
Brevard, Broward, Charlotte, Collier, Escambia, Indian River, Lee, Martin, Miami-Dade, Monroe, Palm Beach, Sarasota and St. Lucie Counties.


10/27/2017 10:07:42 AM

**EEC 4/2/18**


LAST REVISION <del>11/01/17</del>	REVISION <b>04/03/18</b>	DESCRIPTION: <b>←</b>	 FY 2018-19 STANDARD PLANS	STANDARD ALUMINUM LIGHTING	INDEX 715-002	SHEET 1 of 8
--------------------------------------	-----------------------------	--------------------------	--	----------------------------	------------------	-----------------

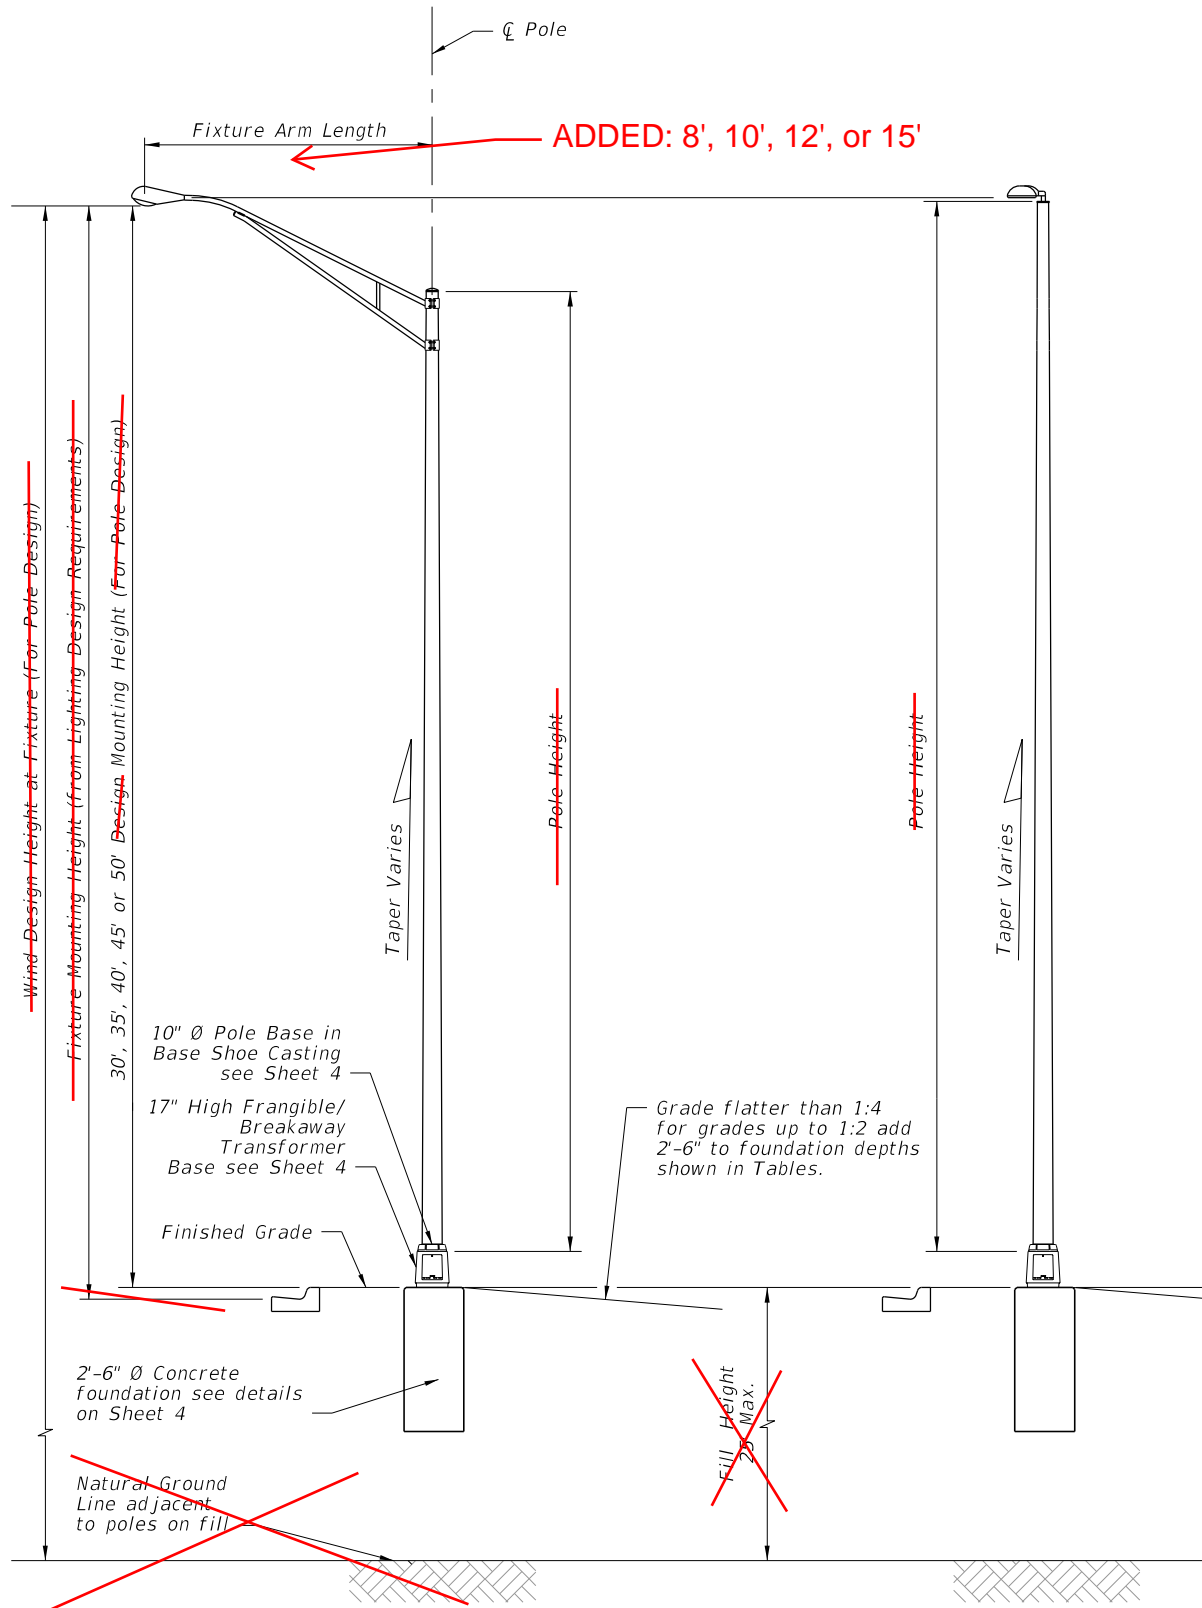

STANDARD ROADWAY ALUMINUM LIGHT POLE W/ARM

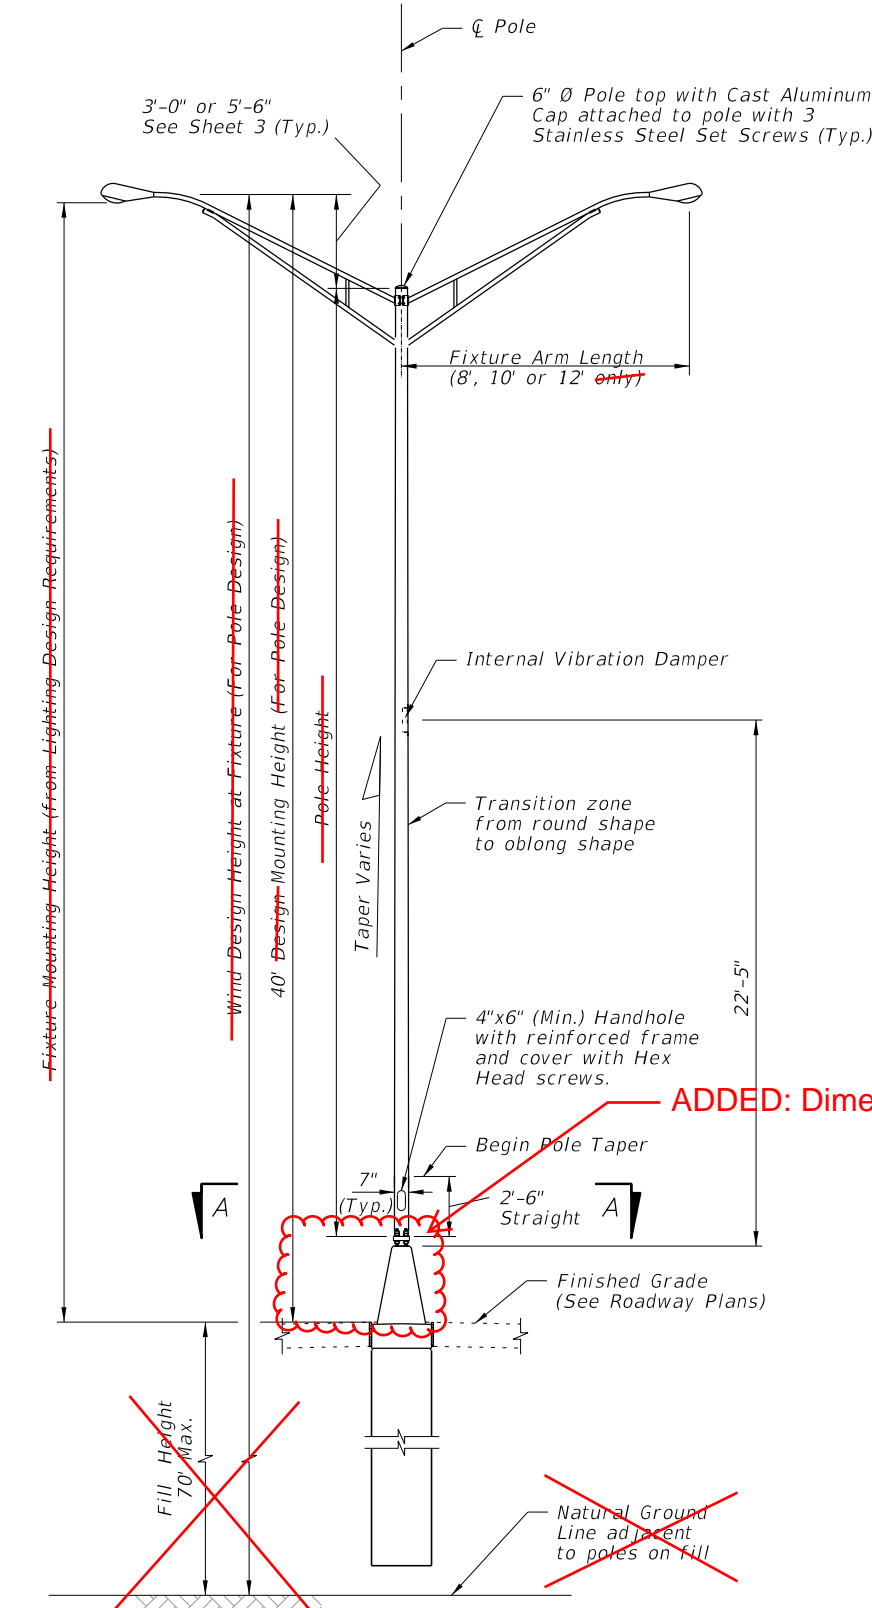

MEDIAN BARRIER MOUNTED ALUMINUM LIGHT POLE ON CYLINDRICAL FOUNDATION

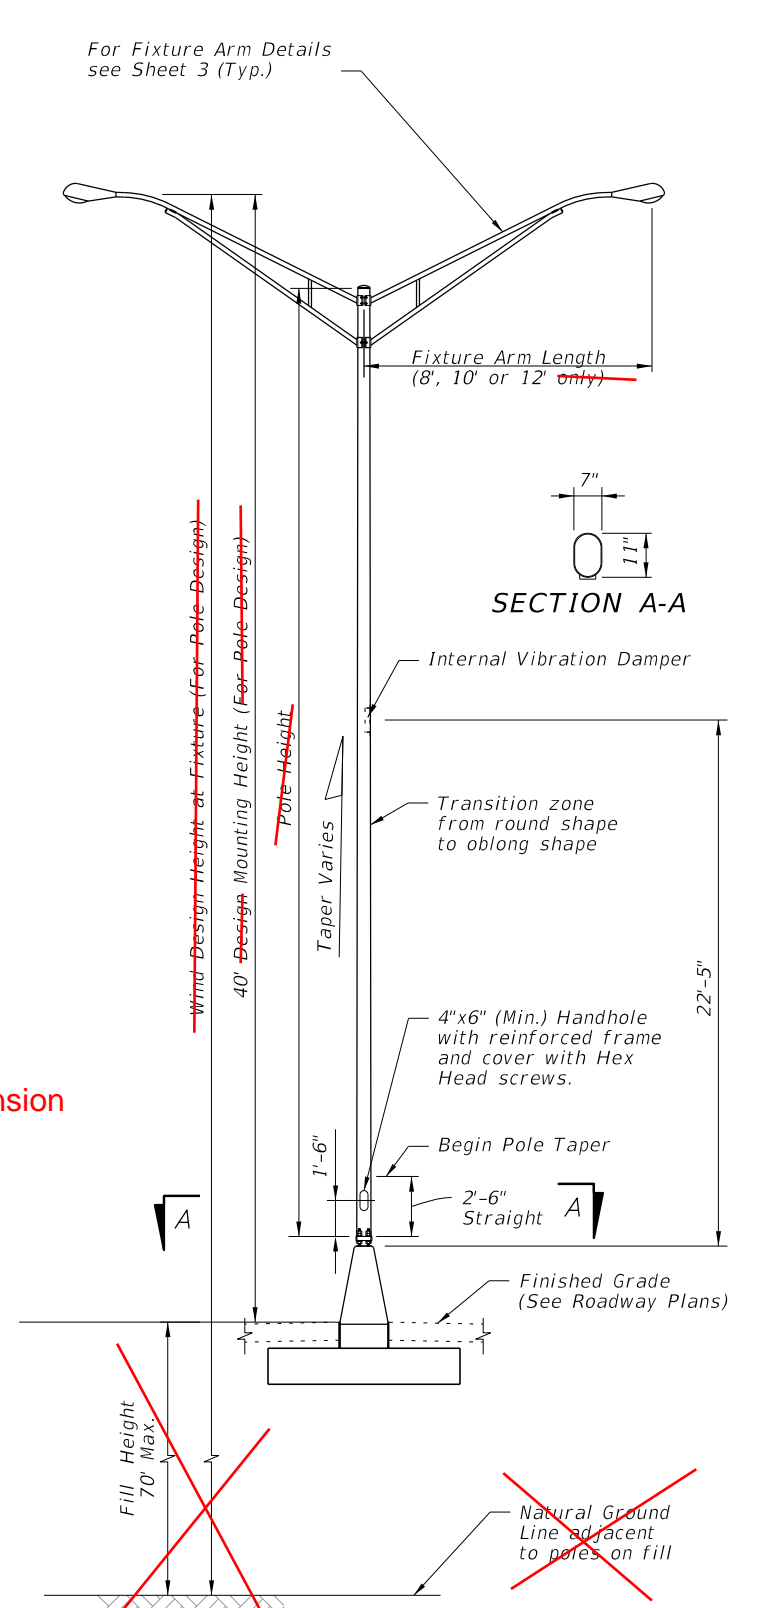

MEDIAN BARRIER MOUNTED ALUMINUM LIGHT POLE ON SPREAD FOOTING FOUNDATION

ELEVATIONS


10:07:42 AM  
10/27/2017

LAST REVISION	DESCRIPTION:
11/01/17	← 04/03/18


FDOT  
FY 2018-19  
STANDARD PLANS

STANDARD ALUMINUM LIGHTING


INDEX	SHEET
715-002	2 of 8

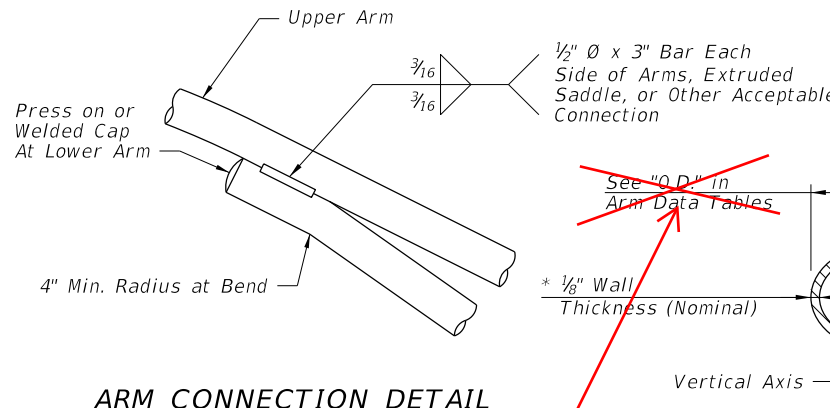


ARM CONNECTION DETAIL

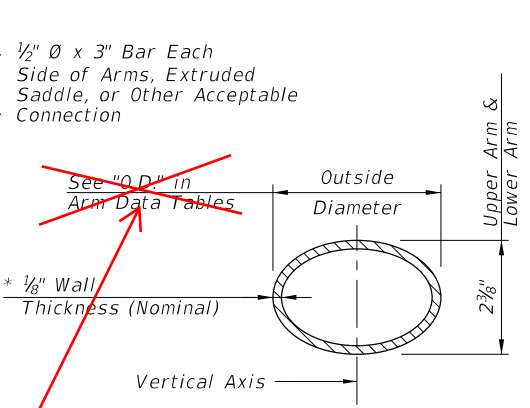


ARM SECTION

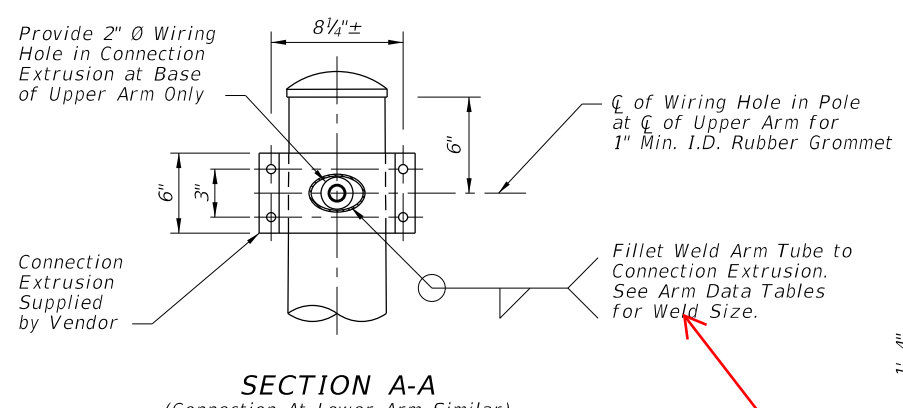

SECTION A-A  
(Connection At Lower Arm Similar)

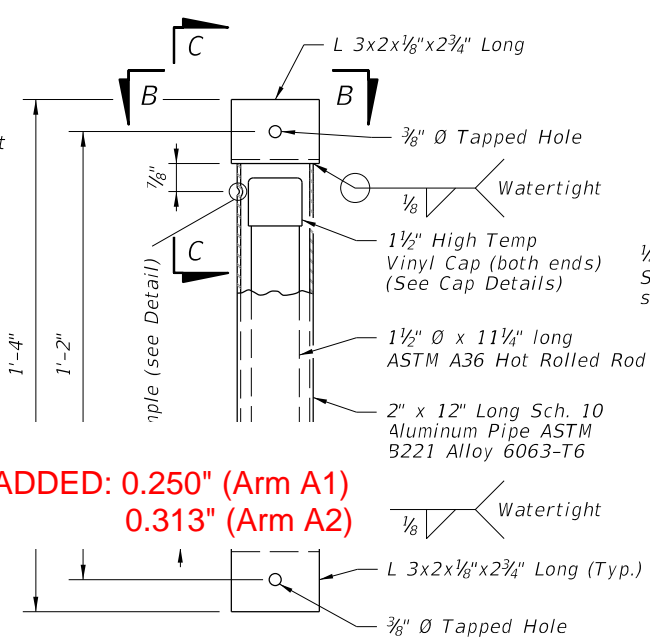


VIBRATION DAMPER ELEVATION

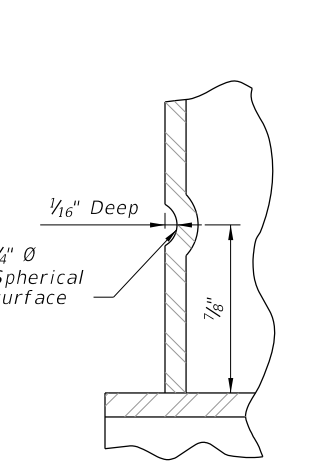


DIMPLE DETAIL

3.625" (Arm A1)  
4.625" (Arm A2)

ADDED: 0.250" (Arm A1)  
0.313" (Arm A2)

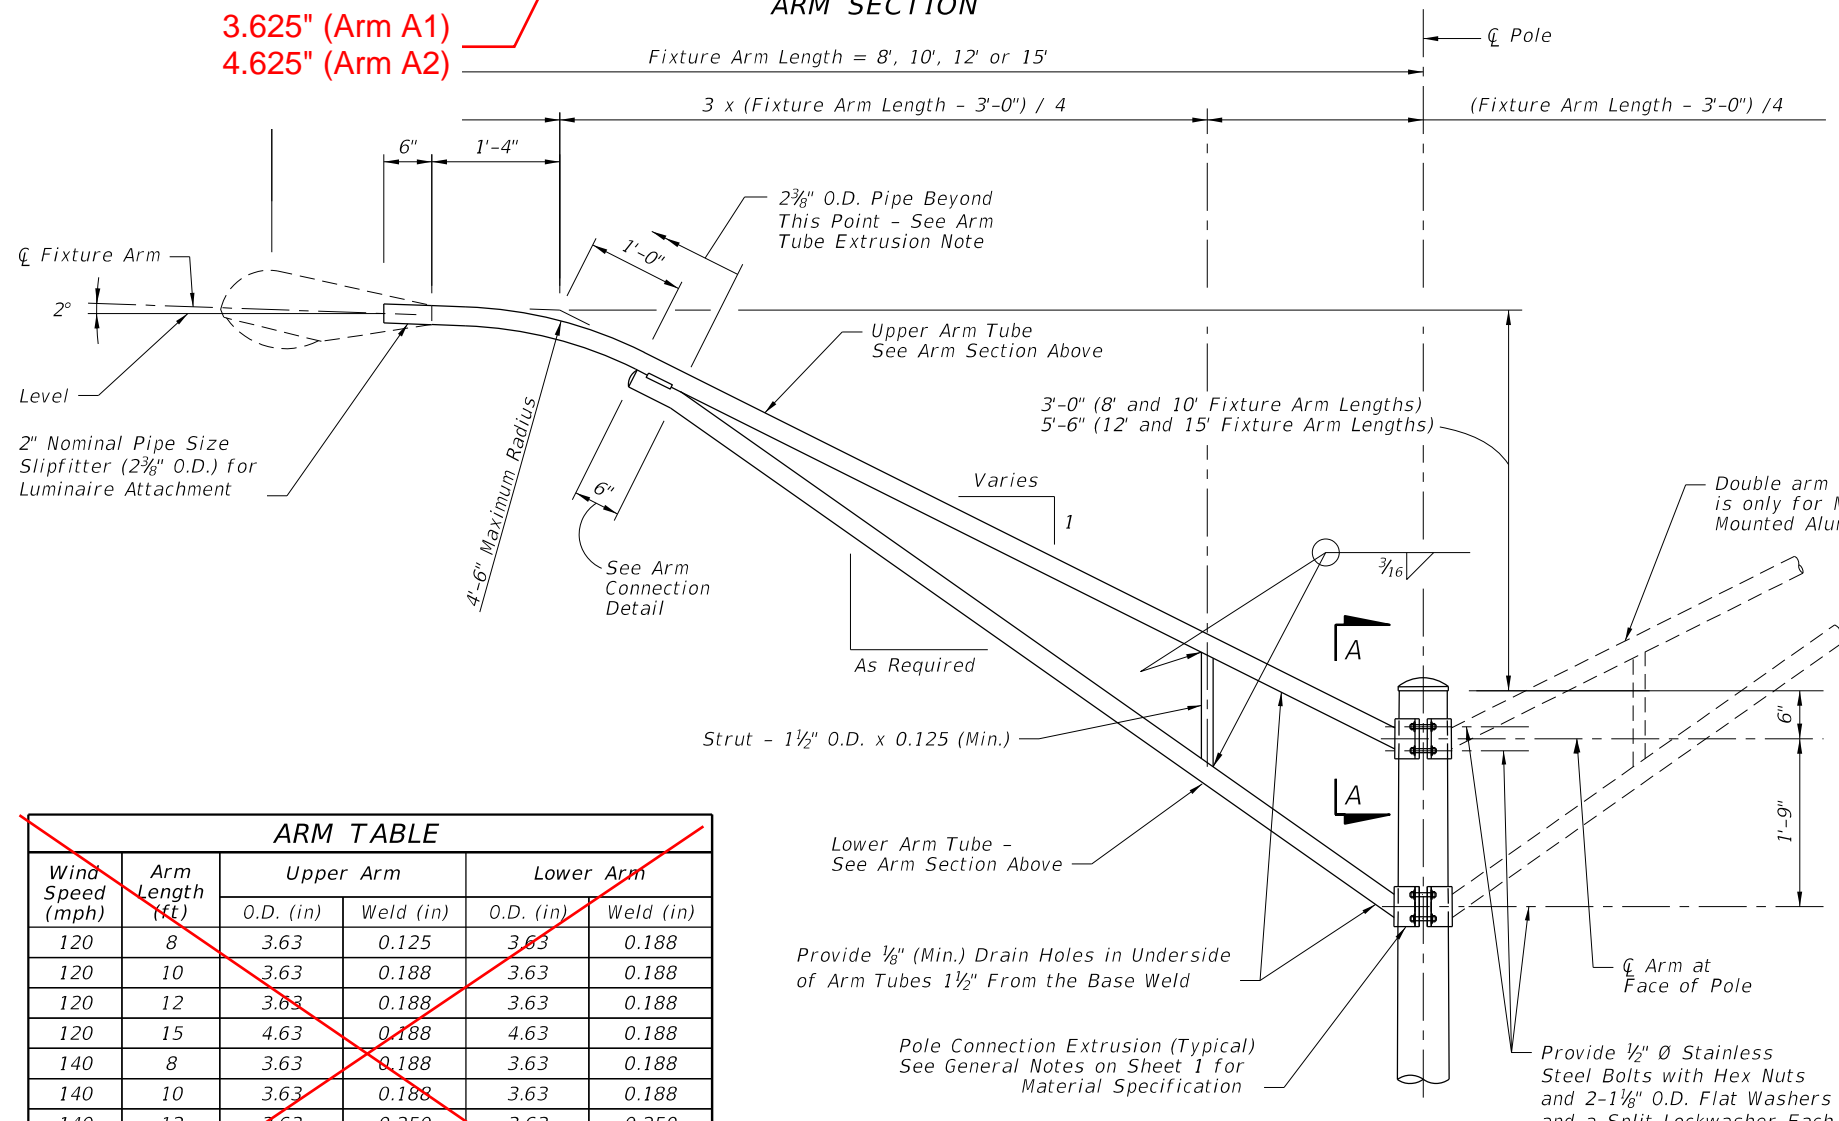


ARM ELEVATION

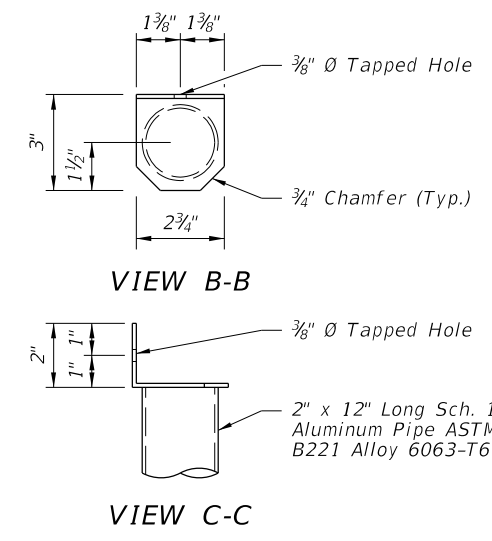

VIEW B-B

VIEW C-C

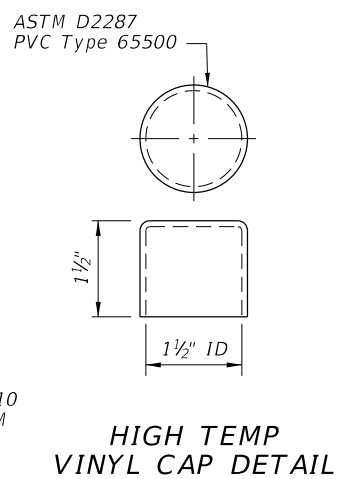

HIGH TEMP VINYL CAP DETAIL

ARM TABLE					
Wind Speed (mph)	Arm Length (ft)	Upper Arm		Lower Arm	
		O.D. (in)	Weld (in)	O.D. (in)	Weld (in)
120	8	3.63	0.125	3.63	0.188
120	10	3.63	0.188	3.63	0.188
120	12	3.63	0.188	3.63	0.188
120	15	4.63	0.188	4.63	0.188
140	8	3.63	0.188	3.63	0.188
140	10	3.63	0.188	3.63	0.188
140	12	3.63	0.250	3.63	0.250
140	15	4.63	0.250	4.63	0.250
160	8	3.63	0.188	3.63	0.188
160	10	3.63	0.250	3.63	0.250
160	12	4.63	0.250	4.63	0.250
160	15	4.63	0.313	4.63	0.313

\* Increase Member Wall Thickness as Necessary to Meet Minimum Requirements of the Welding Code for the Connection Weld Sizes Shown in the Arm and Pole Tables.

ARM TUBE EXTRUSIONS NOTES:

At the pole connections, provide arm tube extrusions with dimensions as shown in the ARM SECTION and as tabulated in the ARM DATA Tables. Uniformly transition elliptical section to a cylindrical section at the arm connection.

The fabricator may substitute elliptical cross sections other than those tabulated, provided the section properties about the vertical axis and the area of the section equal or exceed that of the required section, and provide minimum wall thickness of 1/8" nominal and within the Aluminum Association Tolerances.

The outside diameter about the minor axis should be held at 2 3/8" at the upper and lower arms.

10:07:43 AM  
10/27/2017





LAST REVISION 11/01/17	DESCRIPTION: ← 04/03/18
---------------------------	----------------------------

**FY 2018-19  
STANDARD PLANS**

**STANDARD ALUMINUM LIGHTING**


INDEX 715-002	SHEET 3 of 8
------------------	-----------------

**ARM & DAMPER DETAILS**

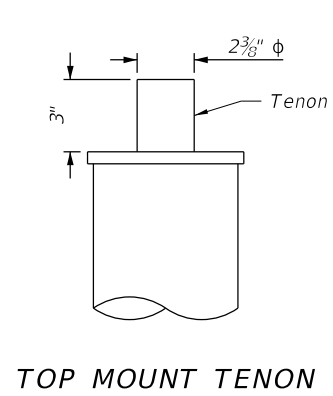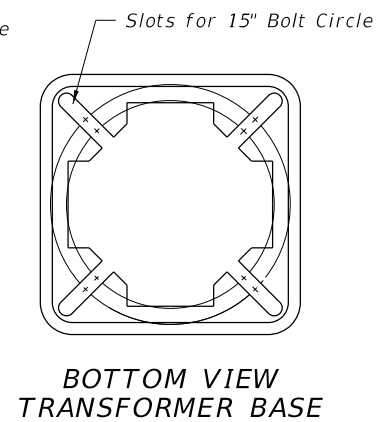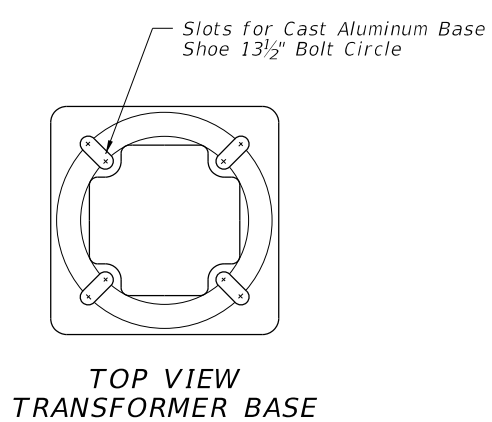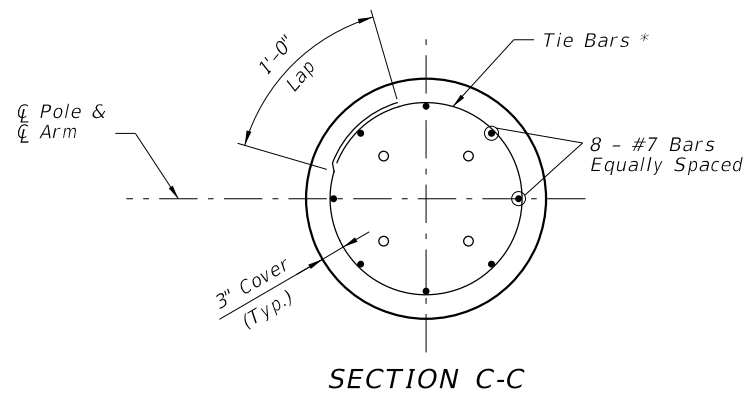

Wind Speed (mph)	Arm Length (ft)	Design Mounting Height (ft)	Pole wall (in)	Upper Weld (in)	Lower Weld (in)
120	8,10,12,15	30	0.125	0.125	0.125
120	8,10,12,15	35 & 40	0.188	0.125	0.188
120	8,10	45	0.250	0.125	0.25
120	12,15	45	0.250	0.188	0.250
120	8	50	0.313	0.125	0.250
120	10,12,15	50	0.313	0.188	0.250
140	8,10,12,15	30	0.188	0.125	0.188
140	8,10	35	0.188	0.125	0.188
140	12,15	35	0.250	0.125	0.250
140	8,10,12,15	40	0.250	0.125	0.250
140	8,				0.250
140	12,				0.250
140	8,10,				0.313
140	1,				0.313
160	8,10,				0.188
160	8,10,				0.250
160	8,10,				0.250
160	8,10	45	0.375	0.188	0.313
160	12,15	45	0.375	0.250	0.313


**ADDED NEW TABLES**  
 With Note: For Median Barrier Mounted Pole, Use Arm A1.

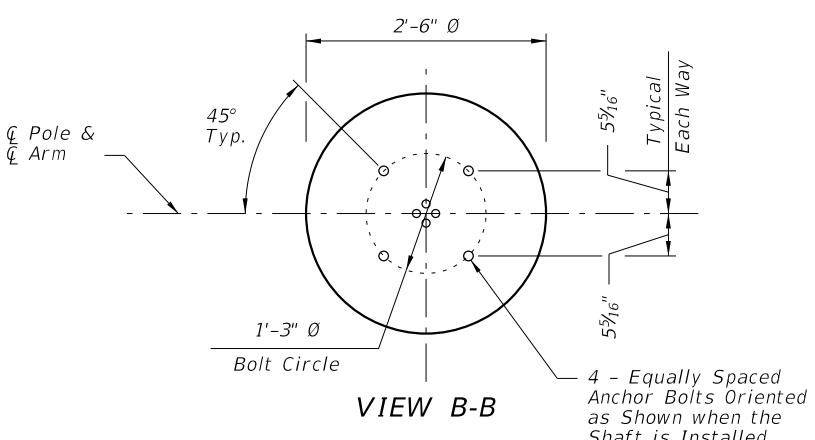


**NEW TABLE**  
 Pole Wall Thickness:  
 0.188" (Pole P1)  
 0.25" (Pole P2)  
 0.313" (pole P3)

Wind Speed (mph)	Design Mounting Height (ft)	Pole wall (in)	Upper Weld (in)	Lower Weld (in)
120	30 & 35	0.125	0.125	0.125
120	40	0.188	0.125	0.188
120	45	0.188	0.125	0.188
120	50	0.250	0.125	0.250
140	30	0.125	0.125	0.125
140	35 & 40	0.188	0.125	0.188
140	45	0.250	0.125	0.250
140	50	0.313	0.188	0.250
160	30	0.125	0.125	0.125
160	35	0.188	0.125	0.188
160	40	0.250	0.125	0.250
160	45	0.313	0.188	0.250
160	50	0.375	0.250	0.313

in accordance with

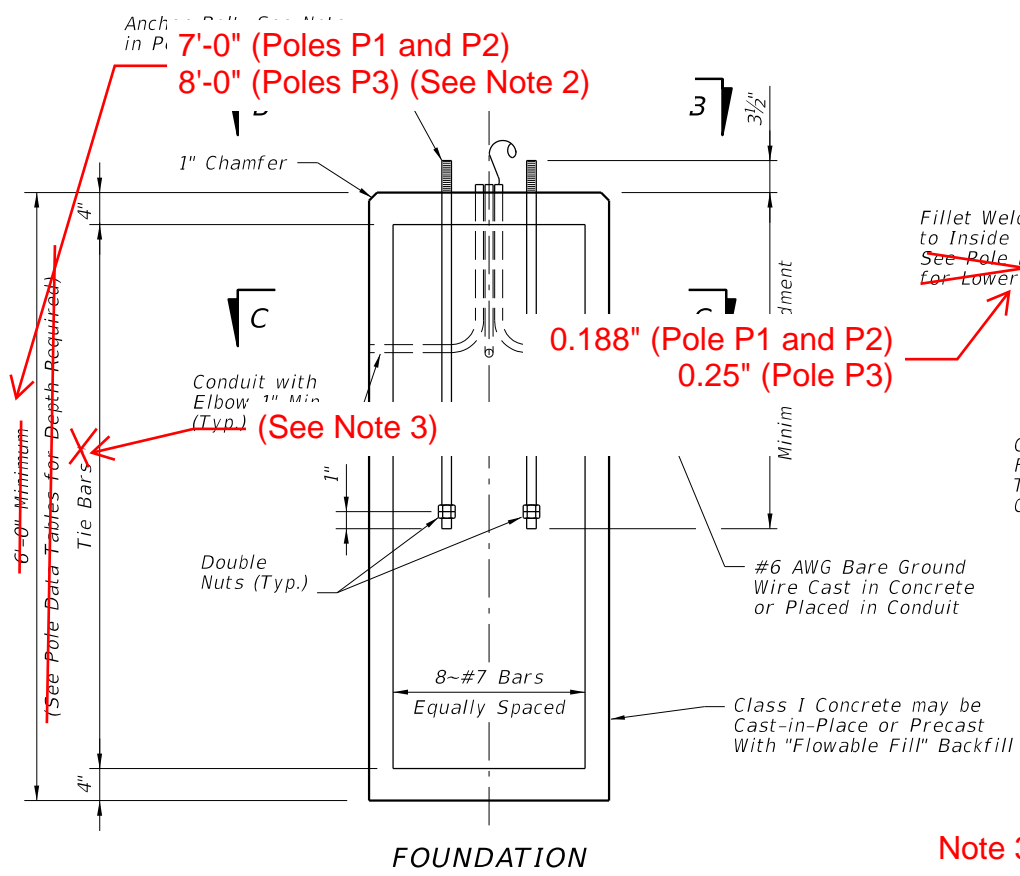

Note 3

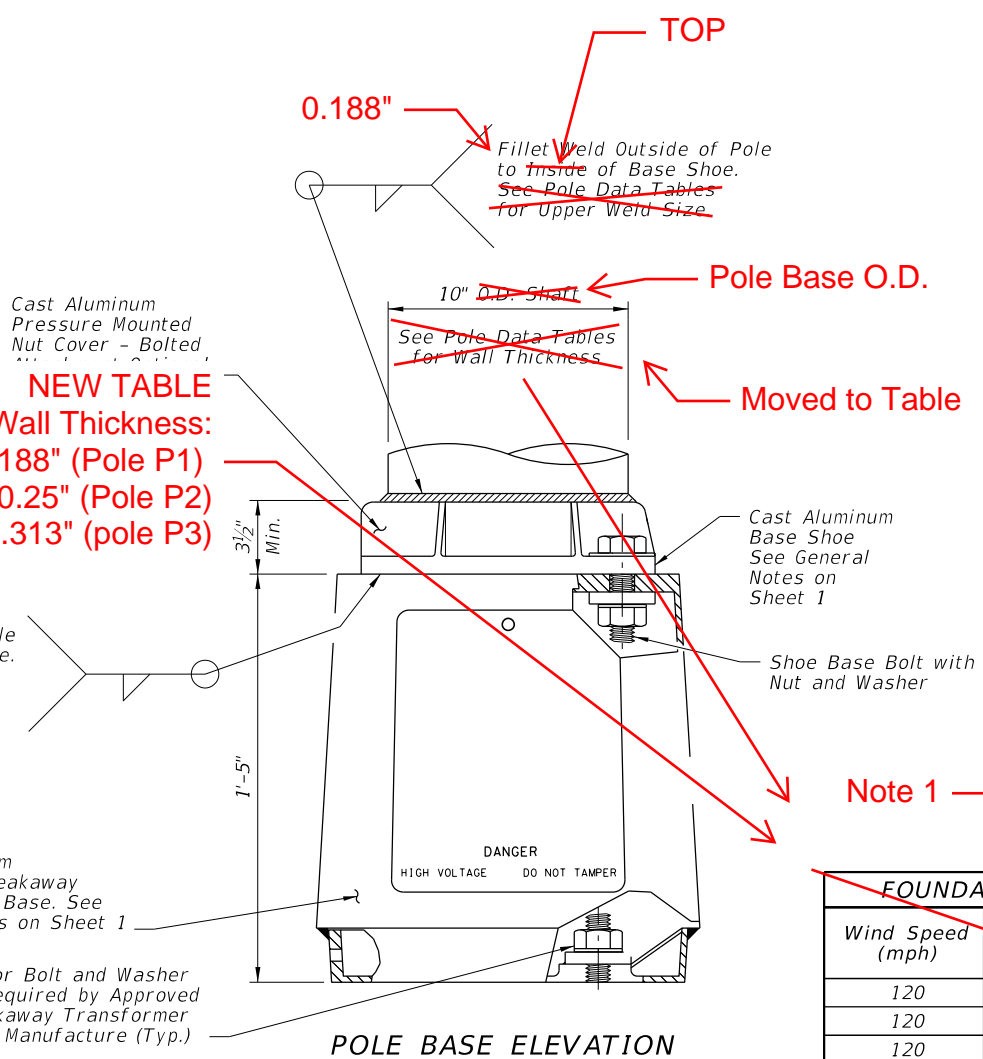

Note 1

Wind Speed (mph)	Design Mounting Height (ft)	Total Depth (FT)**
120	30 & 35	6
120	40 & 45	7
120	50	8
140	30, 35 & 40	7
140	45 & 50	8
160	30 & 35	7
160	40 & 45	8

Note 3

Wind Speed (mph)	Design Mounting Height (ft)	Total Depth (FT)**
120	30, 35 & 40	6
120	45 & 50	7
140	30 & 45	6
140	40 & 45	7
140	50	8
160	30	6
160	35 & 40	7
160	45 & 50	8

**NOTE:**  
 Pole wall thicknesses shown in the POLE TABLE are nominal and shall be within the Aluminum Association Tolerances. Thicker walls are permitted and tapered walls may be used provided the minimum Aluminum Association thicknesses are not violated.

**POLE AND BASE DETAILS FOR ROADWAY ALUMINUM LIGHT POLE**

10/27/2017 10:07:43 AM

LAST REVISION 11/01/17	DESCRIPTION: 04/03/18
---------------------------	--------------------------

**FDOT**  
 FY 2018-19  
 STANDARD PLANS




STANDARD ALUMINUM LIGHTING

INDEX 715-002	SHEET 4 of 8
------------------	-----------------



POLE TABLE				
WIND SPEED (MPH)	ARM LENGTH (FT)	DESIGN MOUNTING HEIGHT (FT)	POLE WALL (IN)	FILL HEIGHT (FT)
120	8, 10, 12	40	0.25	Up to 70'
140	8, 10, 12	40	0.25	Up to 70'
160	8, 10, 12	40	0.313	Up to 70'

NOTE: Pole wall thicknesses shown in the POLE TABLE are nominal and shall be within the Aluminum Association Tolerances. Thicker walls are permitted and tapered walls may be used provided the minimum Aluminum Association thicknesses are not violated.

- NOTE:
- For locations of Bearing Plates, Base Plates and Detail 'A' see Sheets 6 & 7.
  - Double Nuts: The bottom hex nut may be substituted by a half height 'Jam' nut.
  - Provide individual nut covers (not shown) for each bolt.

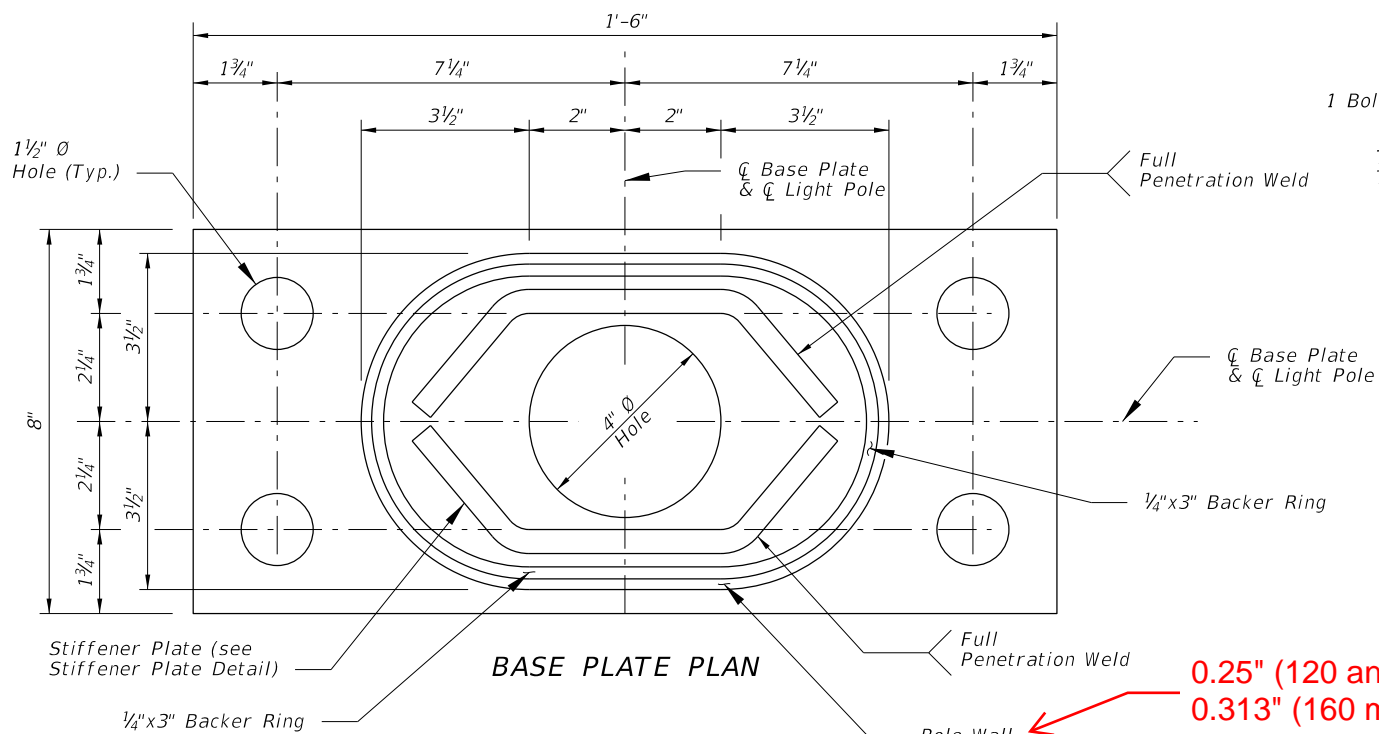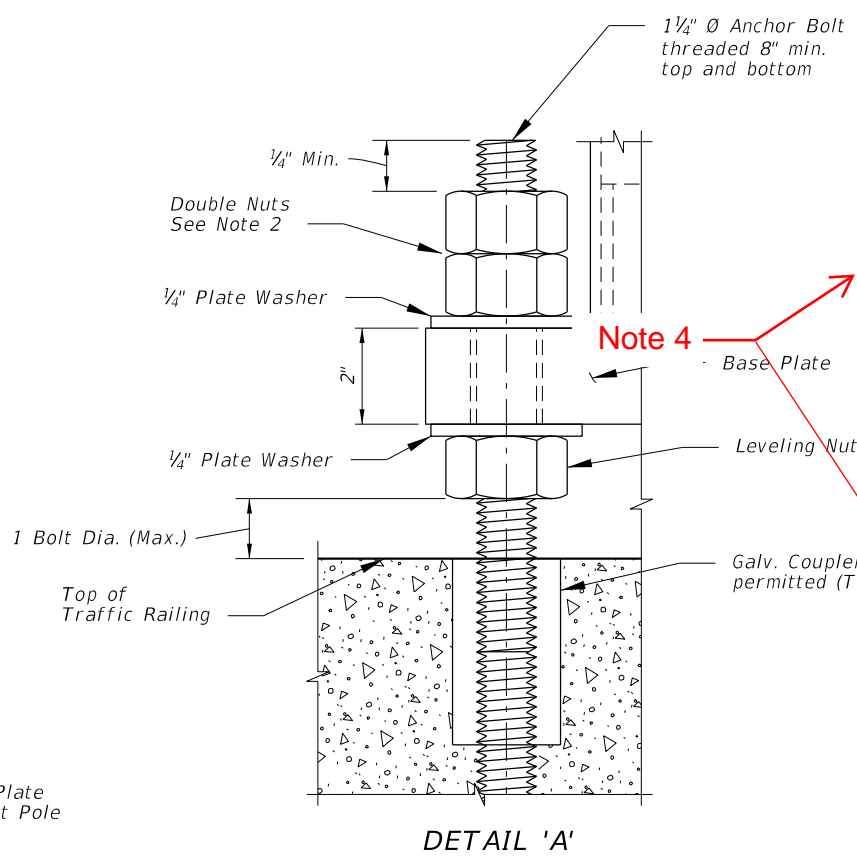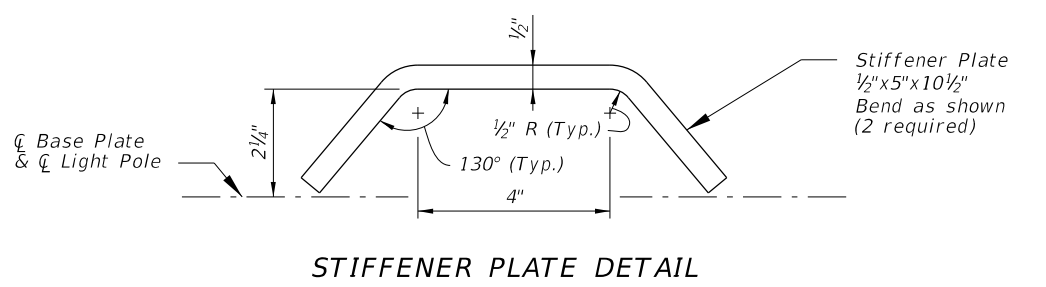

0.25" (120 and 140 mph)  
0.313" (160 mph)

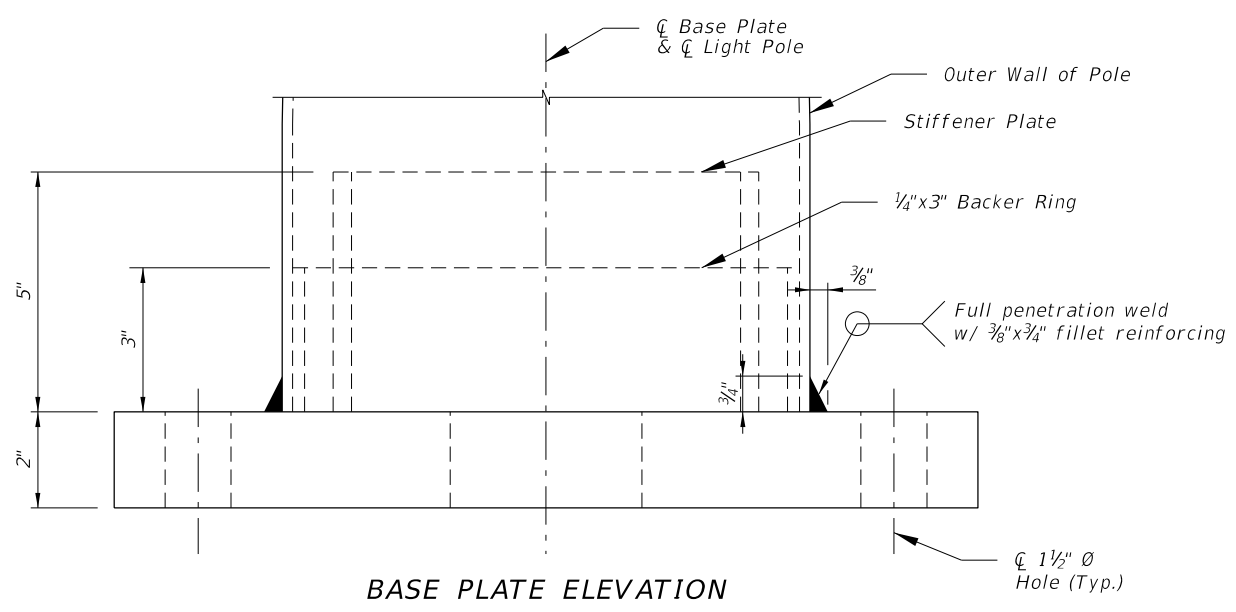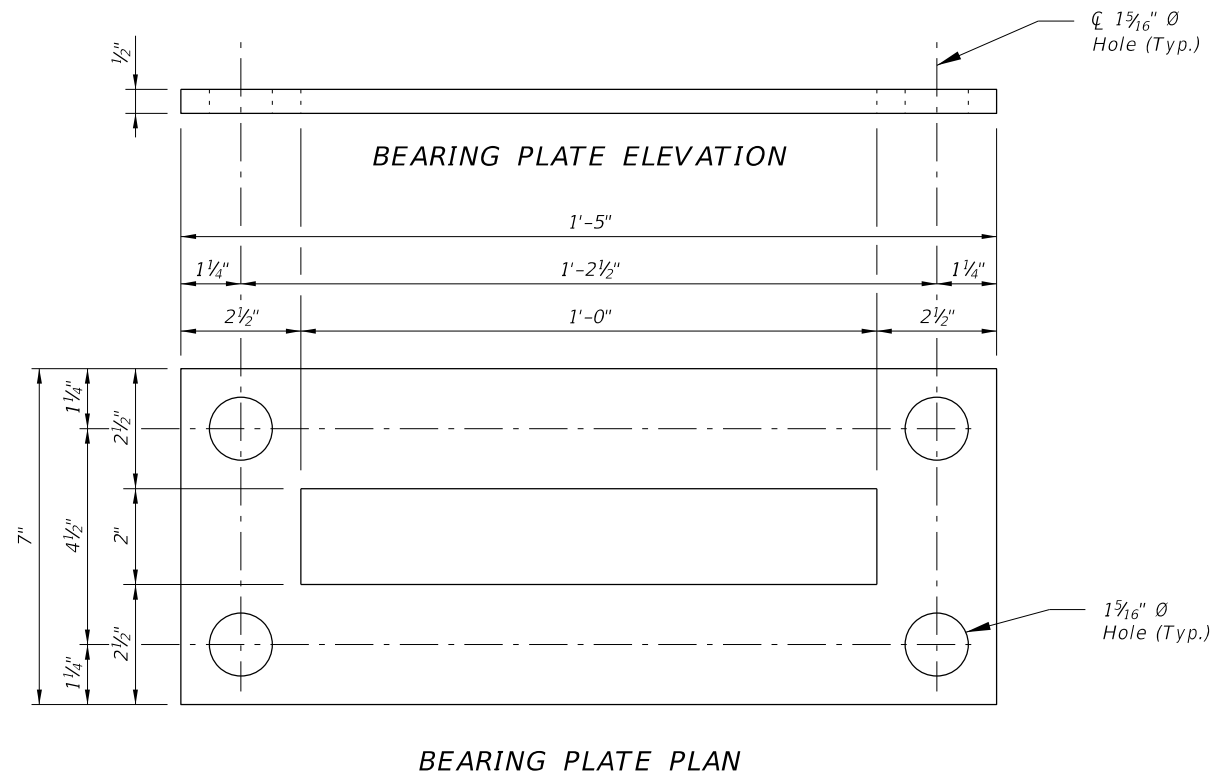

BASE PLATE DETAILS FOR MEDIAN BARRIER MOUNTED ALUMINUM LIGHT POLE

10/27/2017 10:07:44 AM

LAST REVISION	DESCRIPTION:
11/01/17	← 04/03/18

FY 2018-19  
 STANDARD PLANS

STANDARD ALUMINUM LIGHTING

INDEX	SHEET
715-002	5 of 8

**GENERAL NOTES:**

1. Poles are designed to support the following:
  - A. Luminaire Effective Projected Area (EPA): 1.55 SF
  - B. Weight: 75 lb.
2. Shop Drawings: This Index is considered fully detailed, only submit shop drawings for minor modifications not included in the Plans.
3. Materials:
  - A. Pole, Pole Connection Extrusions and Arm Extrusions: ASTM B221, Alloy 6063-T6 or Alloy 6061-T6
  - B. Bars, Plates, Stiffeners and Backer Ring: ASTM B221, Alloy 6063-T6
  - C. Caps and Covers: ASTM B-26, Alloy 319-F
  - D. Steel Bearing Plate: ASTM A709 or ASTM A36 Grade 36
  - E. Aluminum Weld Material: ER 4043
  - F. Transformer and Frangible Base Materials: ASTM B26 or ASTM B108, Alloy 356-T6
  - G. Bolts, Nuts and Washers:
    - a. Shoe Base Bolts: ASTM F3125, Grade A325, Type 1
    - b. Nuts: ASTM A563 Grade DH Heavy-Hex
    - c. Washer: ASTM F436 Type 1
  - H. Anchor Bolts, Nuts, and Washers:
    - a. Anchor Bolts: ASTM F1554 Grade 55
    - b. Nuts: ASTM A563 Grade A Heavy-Hex
    - c. Plate Washer: ASTM A36
  - I. Stainless Steel Fasteners: ASTM F593 Alloy Group 2, Condition A, CW1 or SH1
  - J. Nut Covers: ASTM B26 (319-F)
  - K. Concrete: Class 1
  - L. Reinforcing Steel: Specification 415
4. Fabrication:
  - A. Weld Arm and Pole (Alloy 6063) in the T4 temper using 4043 filler. Age the Arm and Pole artificially to the T6 temper after welding.
  - B. Transverse welds are only allowed at the base.
  - C. Roadway Light Pole Taper: Taper as required to provide a round top O.D. of 6" and a base O.D. of 10". Portions of the pole near the base shoe and at the arm connections may be held constant at 10" and 6" respectively to simplify fabrication.
  - D. Median Barrier Mounted Light Pole Taper: Taper as required to provide a 6" O.D. round top with an 11" x 7" O.D. oblong base. Portions of the pole near the base and at the arm connections may be held constant at 11" x 7" oblong and 6" round respectively to simplify fabrication.
  - E. Provide 'J', 'S' or 'C' hook at top of pole for electrical wires.
  - F. Equip poles located on bridges, walls and concrete median barriers/Traffic Railings with a vibration damper.
  - G. Perform all welding in accordance with AWS D1.2.
  - H. Embedded Junction Box (EJB):
    - a. Weld all seams continuously and grind smooth.
    - b. Hot Dip Galvanize after Fabrication.
    - c. Provide a watertight cover with neoprene gasket and secure cover with galvanized screws.
  - I. For Median Barrier Mounted Aluminum Light Poles, the fabricator must demonstrate the ability to produce a crack free pole. The fabricator's Department-approved QC Plan must contain the following information prior to fabrication:
    - a. Tests demonstrating a pole with a 1/4" wall thickness achieves and ultimate moment capacity of 36 kip\*ft in the strong axis and 30 kip\*ft in the weak axis.
    - b. Tests demonstrating a pole with a 5/16" wall thickness achieves an ultimate moment capacity of 44 kip\*ft in the strong axis and 37 kip\*ft in the weak axis.
    - c. Test results showing the pole does not buckle at the shape transition area under the ultimate moment capacity loads.
    - d. Complete details and calculations for the reinforced 4"x 6" (Min.) handhole located 1'-6" above the base plate.
  - J. Identification Tag: (Submit details for approval.)
    - a. 2" x 4" (Max.) aluminum identification tag.
    - b. Locate on the inside of the transformer base and visible from the door opening.
    - c. Secure to transformer base with 1/8" diameter stainless steel rivets or screws.
    - d. Include the following information on the ID Tag:
      1. Financial Project ID
      2. Pole Height
      3. Manufacturer's Name

5. Coatings/Finish:
  - A. Pole and Arm Finish: 50 grit satin rubbed.
  - B. Galvanize Steel Bolts, Screws, Nuts and Washers: ASTM F2329
  - C. Hot Dip Galvanize EJB and other steel items including poles and plate washers: ASTM A123
6. Construction:
  - A. Foundation: Specification 455, except payment for the foundation is included in the cost of the pole.
  - B. Frangible Base, Base Shoe, and Clamp:
    - a. Certify that the Clamp, Frangible Transformer Base, and Base Shoe Design are capable of providing the required capacity.
    - b. Certify the Base conforms to the current FHWA required AASHTO Frangibility Requirements, tested under NCHRP Report 350 Guidelines (e.g. Akron Foundry TB1-17).
    - c. Do not erect pole without Luminaire attached.
7. Embedded Junction Box (EJB): Install EJBs per Note 4 and in accordance with Specification 635, as shown on the following Sheets.
8. Wind Speed by County:
 


**120 MPH**  
Alachua, Baker, Bradford, Calhoun, Clay, Columbia, Dixie, Duval, Gadsden, Gilchrist, Hamilton, Jackson, Jefferson, Lafayette, Leon, Liberty, Nassau, Madison, Putnam, Suwannee, Taylor, Union and Wakulla Counties.

**140 MPH**  
Bay, Citrus, De Soto, Flagler, Franklin, Glades, Gulf, Hardee, Hendry, Hernando, Highlands, Hillsborough, Holmes, Lake, Levy, Manatee, Marion, Okaloosa, Okeechobee, Orange, Osceola, Pasco, Pinellas, Polk, Santa Rosa, Seminole, St. Johns, Sumter, Volusia, Walton and Washington Counties.


**160 MPH**  
Brevard, Broward, Charlotte, Collier, Escambia, Indian River, Lee, Martin, Miami-Dade, Monroe, Palm Beach, Sarasota and St. Lucie Counties.

8/15/2018 1:57:20 PM


LAST REVISION <b>04/03/18</b>	REVISION	DESCRIPTION:	 <b>FY 2018-19</b> <b>STANDARD PLANS</b>	<b>STANDARD ALUMINUM LIGHTING</b>	INDEX <b>715-002</b>	SHEET <b>1 of 8</b>
----------------------------------	----------	--------------	---	-----------------------------------	-------------------------	------------------------

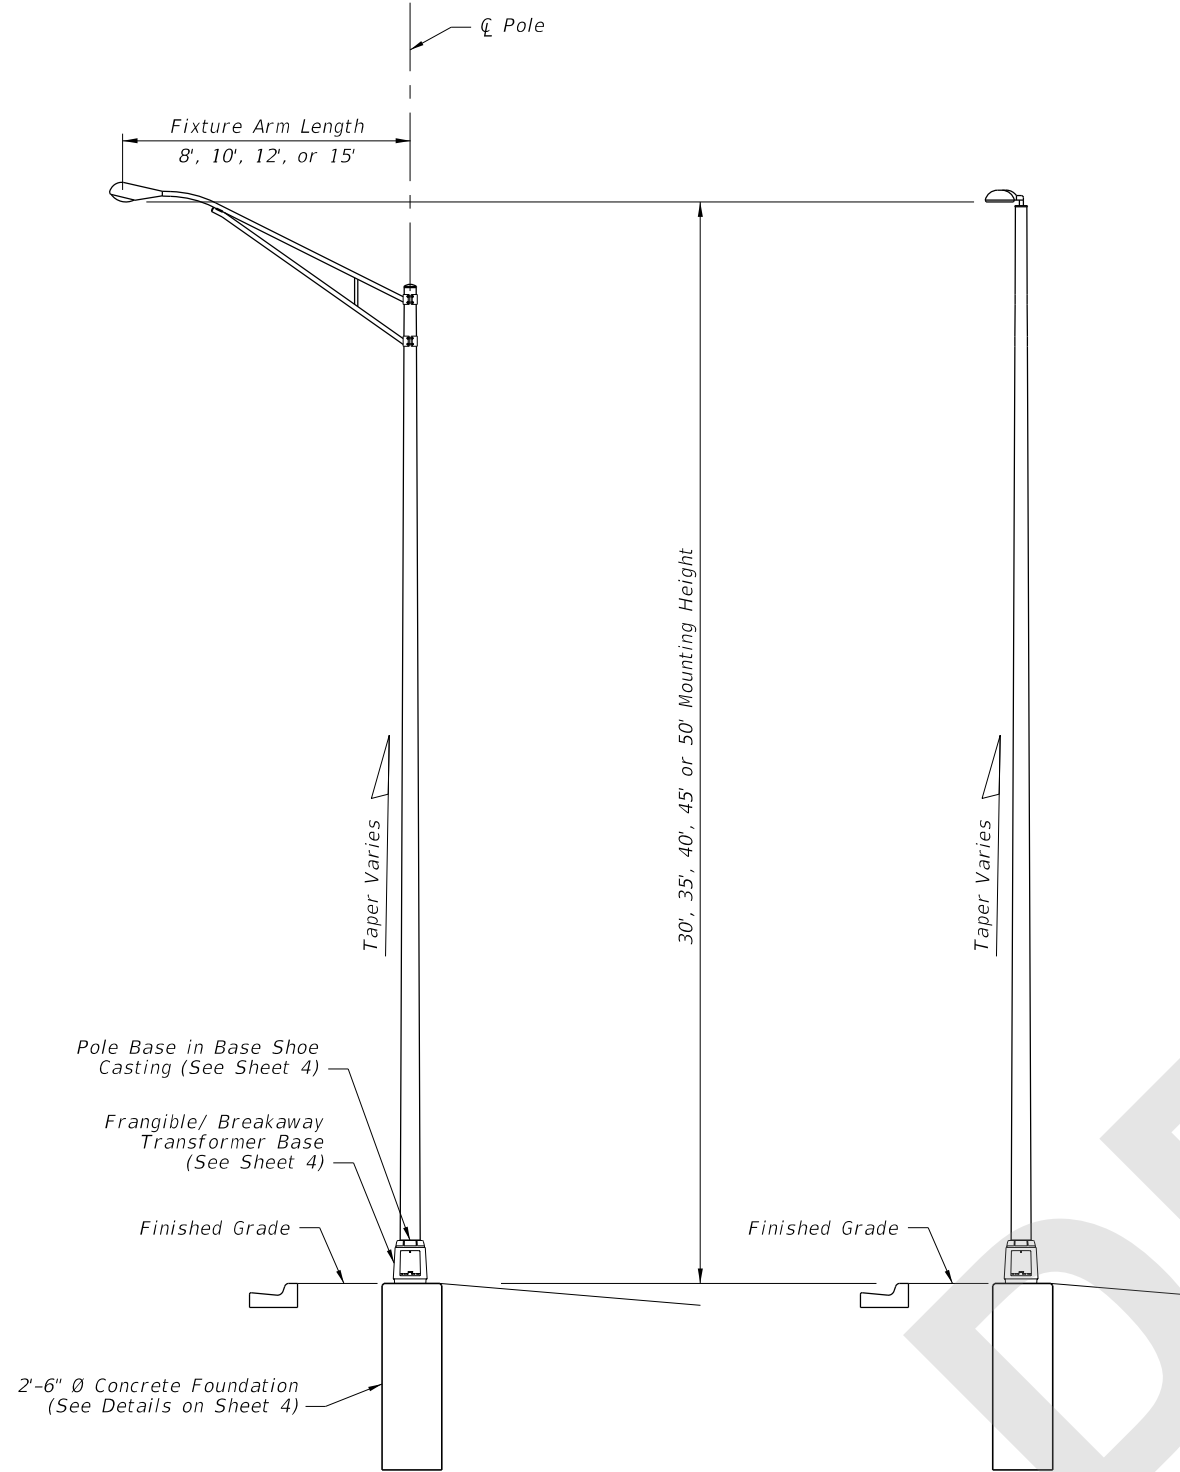

STANDARD ROADWAY  
ALUMINUM LIGHT POLE  
W/ARM

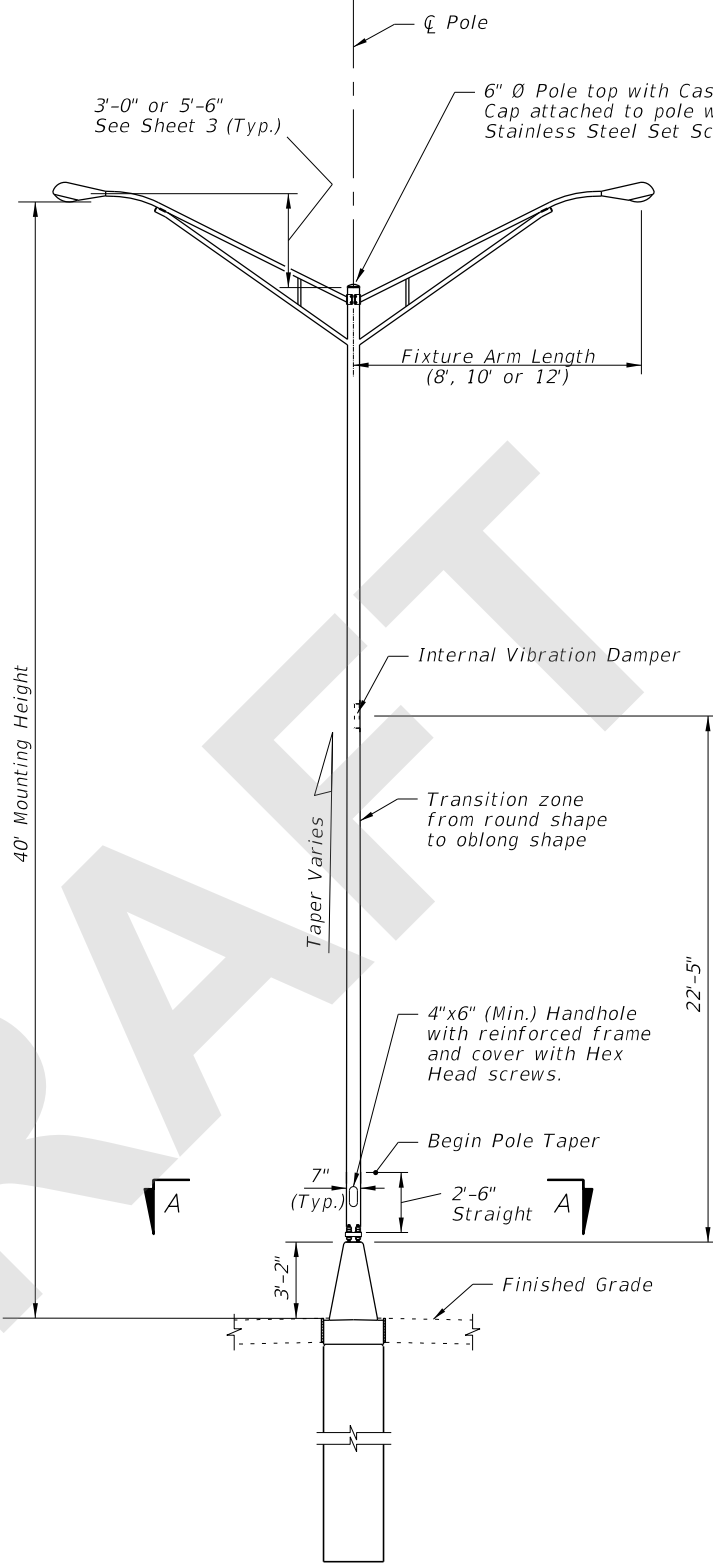


STANDARD ROADWAY  
ALUMINUM LIGHT POLE  
W/TOP MOUNT

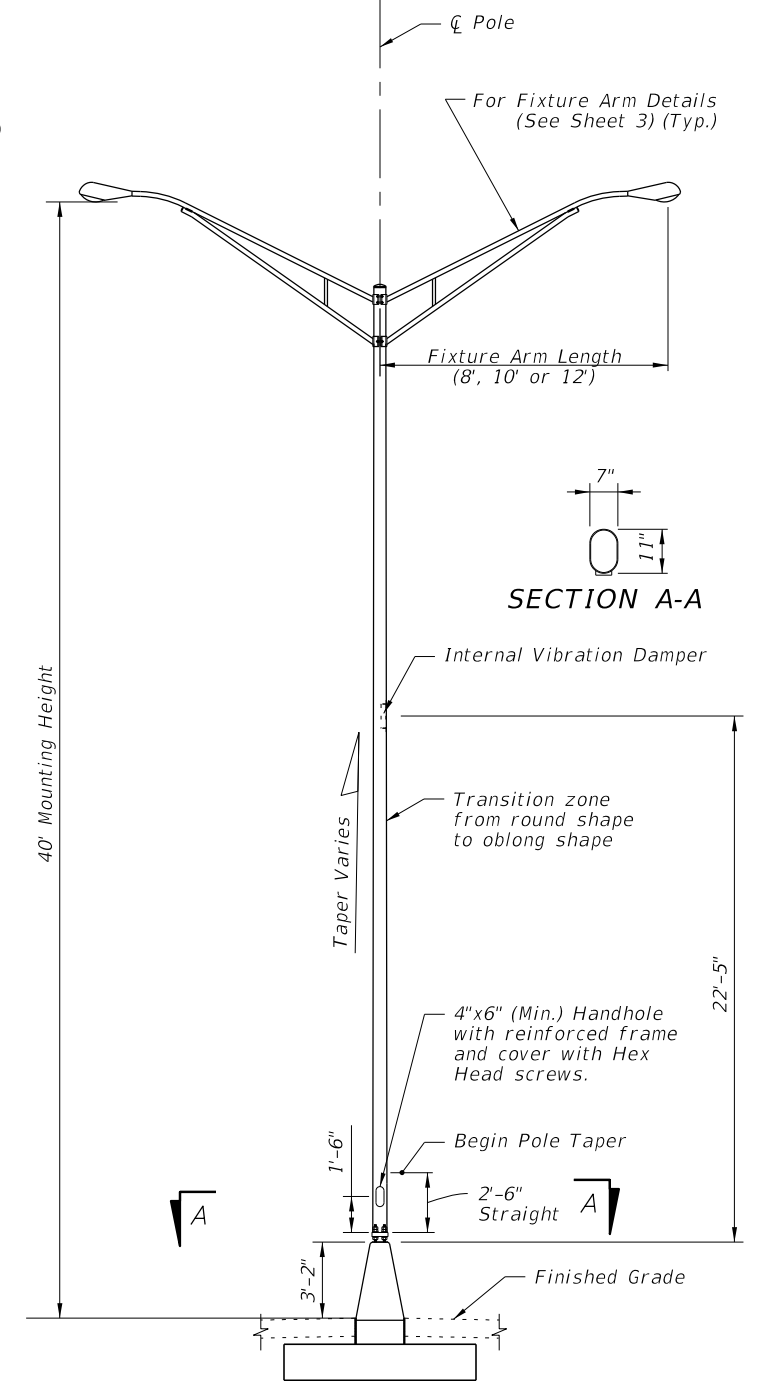

MEDIAN BARRIER MOUNTED ALUMINUM LIGHT POLE  
ON SPREAD FOOTING FOUNDATION

ELEVATIONS

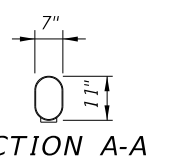

8/15/2018 1:57:21 PM


LAST REVISION 04/03/18	DESCRIPTION:
---------------------------	--------------


**FY 2018-19**  
**STANDARD PLANS**


STANDARD ALUMINUM LIGHTING

INDEX 715-002	SHEET 2 of 8
------------------	-----------------




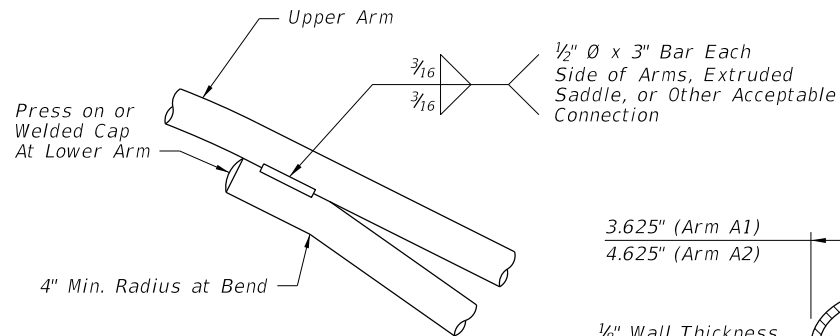


**ARM CONNECTION DETAIL**

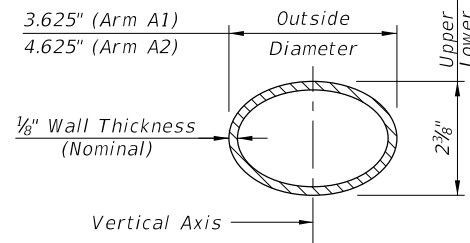


**ARM SECTION**

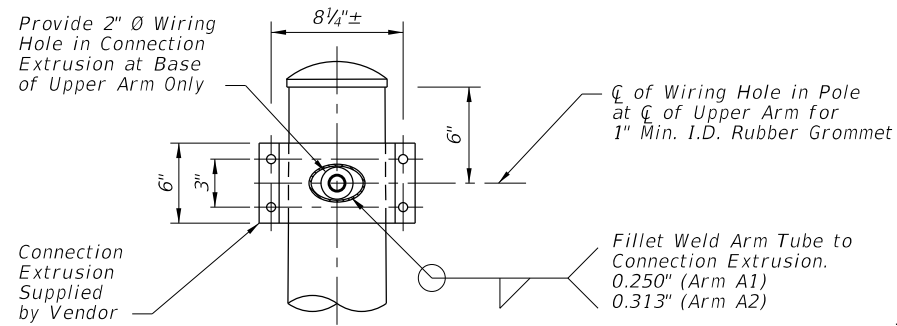


**SECTION A-A**  
(Connection At Lower Arm Similar)

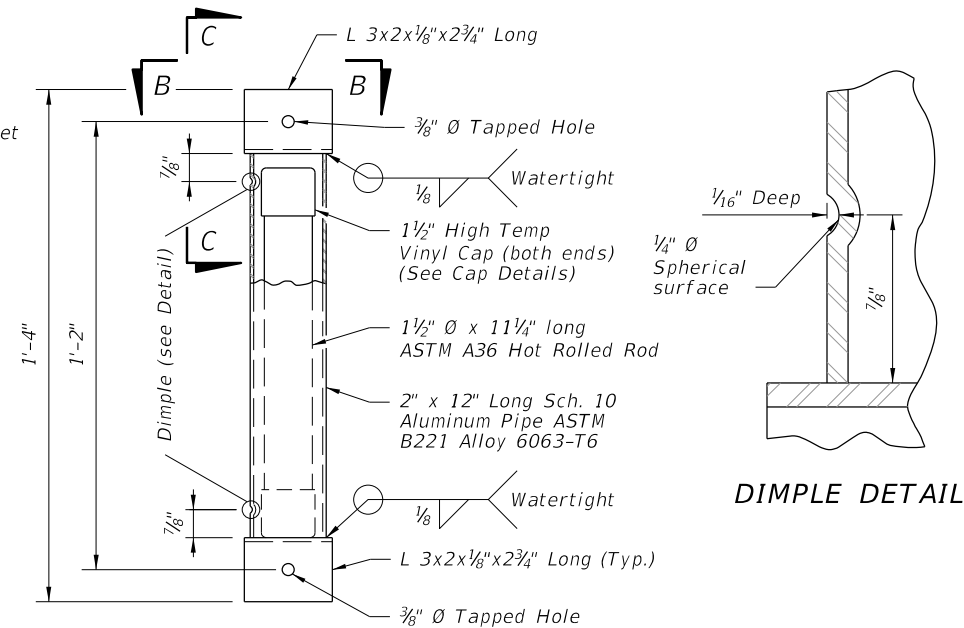

**VIBRATION DAMPER ELEVATION**

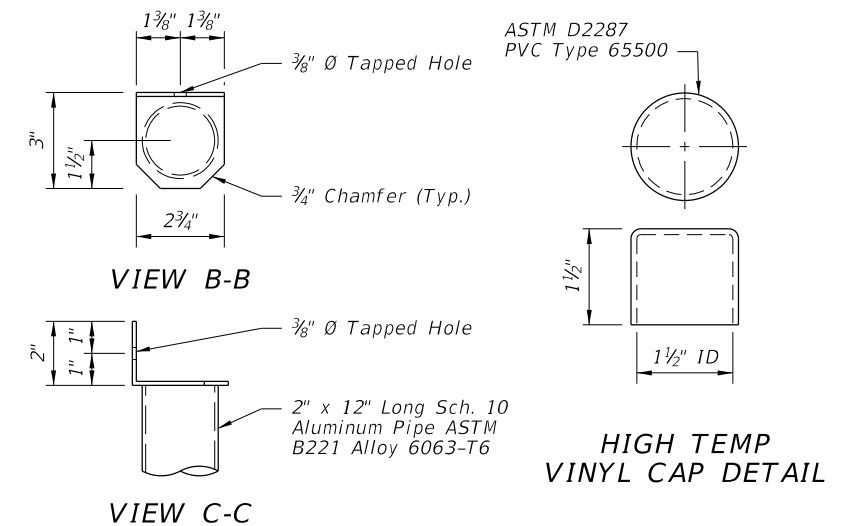

**HIGH TEMP VINYL CAP DETAIL**

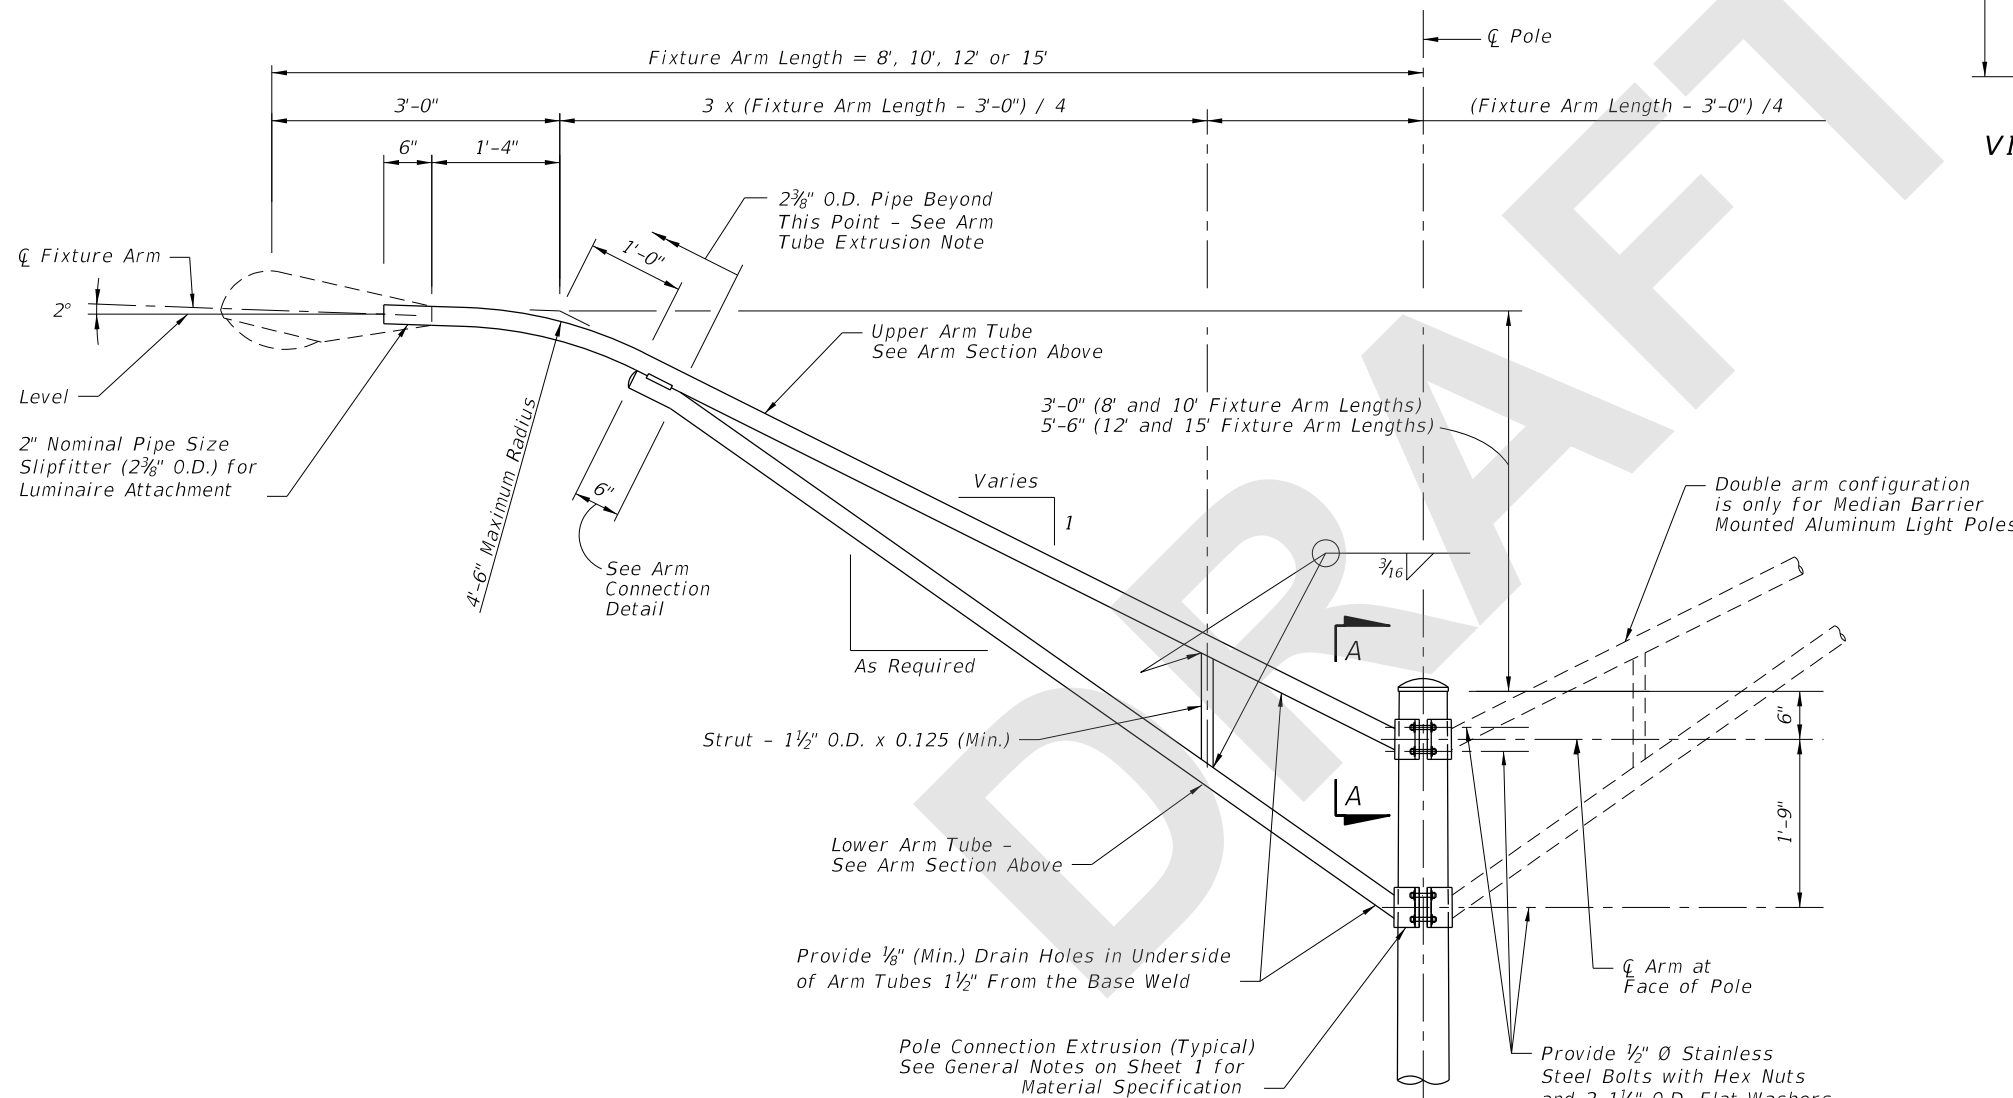

**ARM ELEVATION**

**ARM TUBE EXTRUSIONS NOTES:**

At the pole connections, provide arm tube extrusions with dimensions as shown. Uniformly transition elliptical section to a cylindrical section at the arm connection.

The fabricator may substitute elliptical cross sections other than those tabulated, provided the section properties about the vertical axis and the area of the section equal or exceed that of the required section, and provide minimum wall thickness of 1/8 inch nominal and within the Aluminum Association Tolerances.

The outside diameter about the minor axis should be held at 2 3/8 inches at the upper and lower arms.

8/15/2018 1:57:22 PM

LAST REVISION 04/03/18	DESCRIPTION:
---------------------------	--------------




FY 2018-19  
STANDARD PLANS

STANDARD ALUMINUM LIGHTING


INDEX  
715-002

SHEET  
3 of 8


**ARM & DAMPER DETAILS**

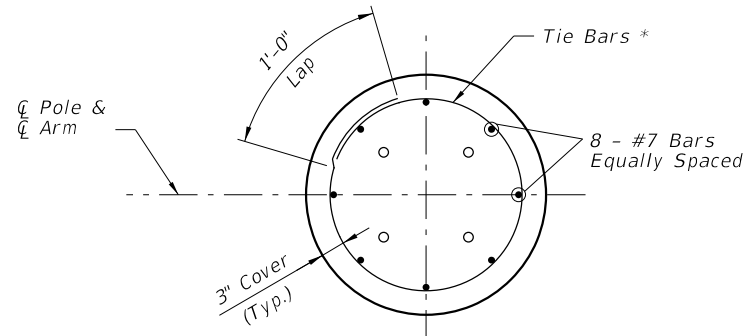


SECTION C-C

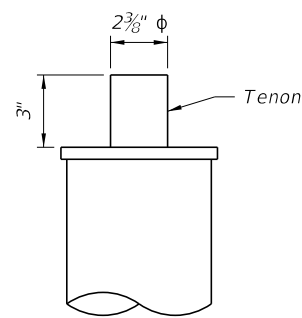


TOP MOUNT TENON

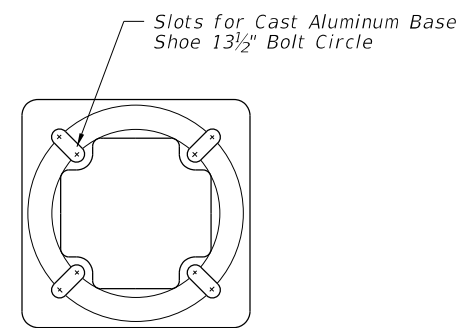


TOP VIEW TRANSFORMER BASE

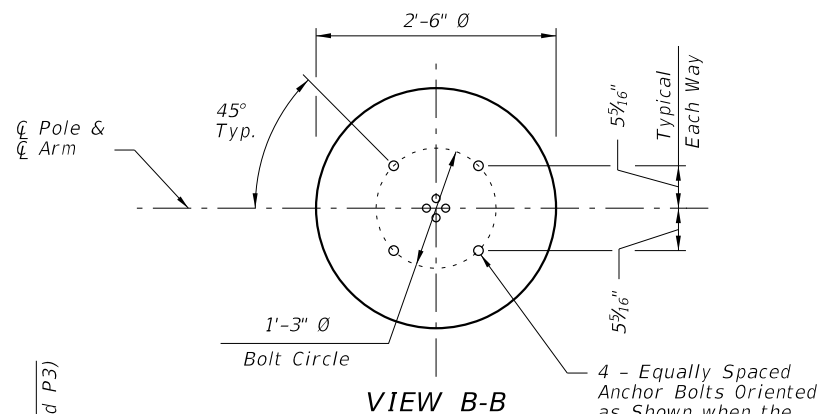

VIEW B-B

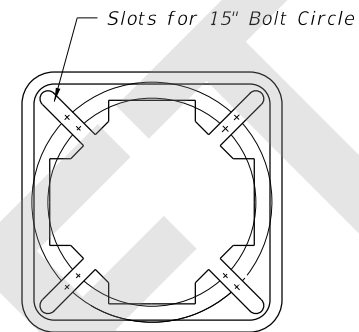


BOTTOM VIEW TRANSFORMER BASE

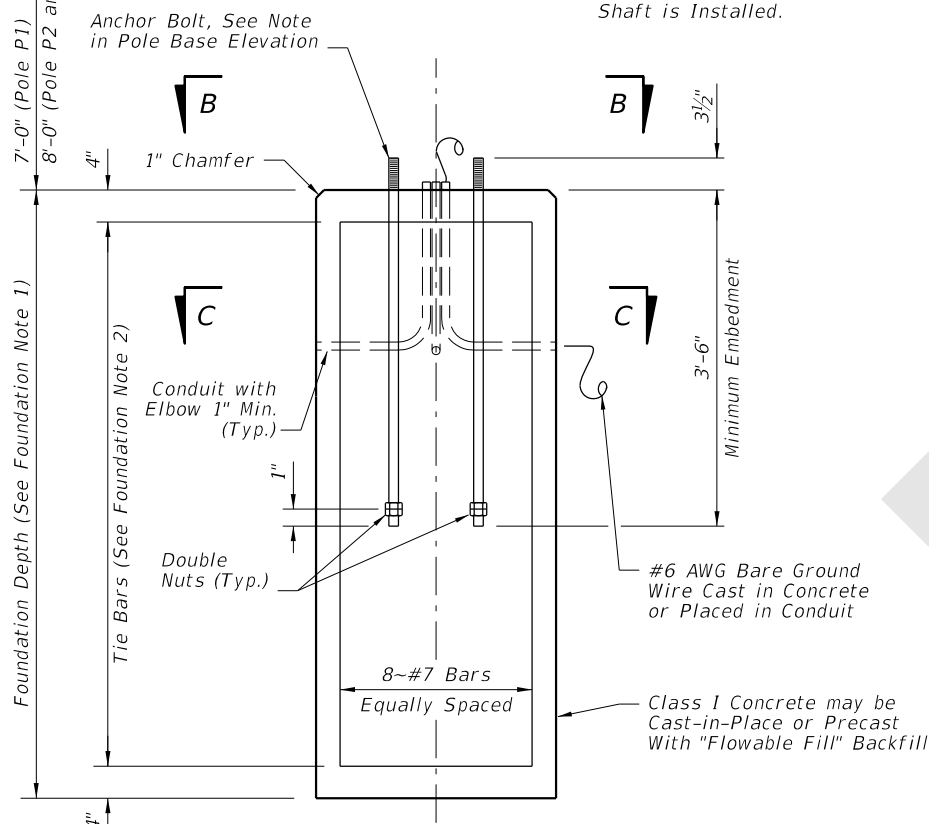

FOUNDATION NOTES:

1. Depths shown are for slopes flatter than 1:4, for slopes 1:2 or flatter, add 2'-6" to foundation depths shown.
2. Foundation Tie Bars: #4 Tie Bars @ 12" centers (max.) or D10 (or W10) spiral @ 6" pitch, 3 flat turns top and 1 flat turn bottom.

FOUNDATION

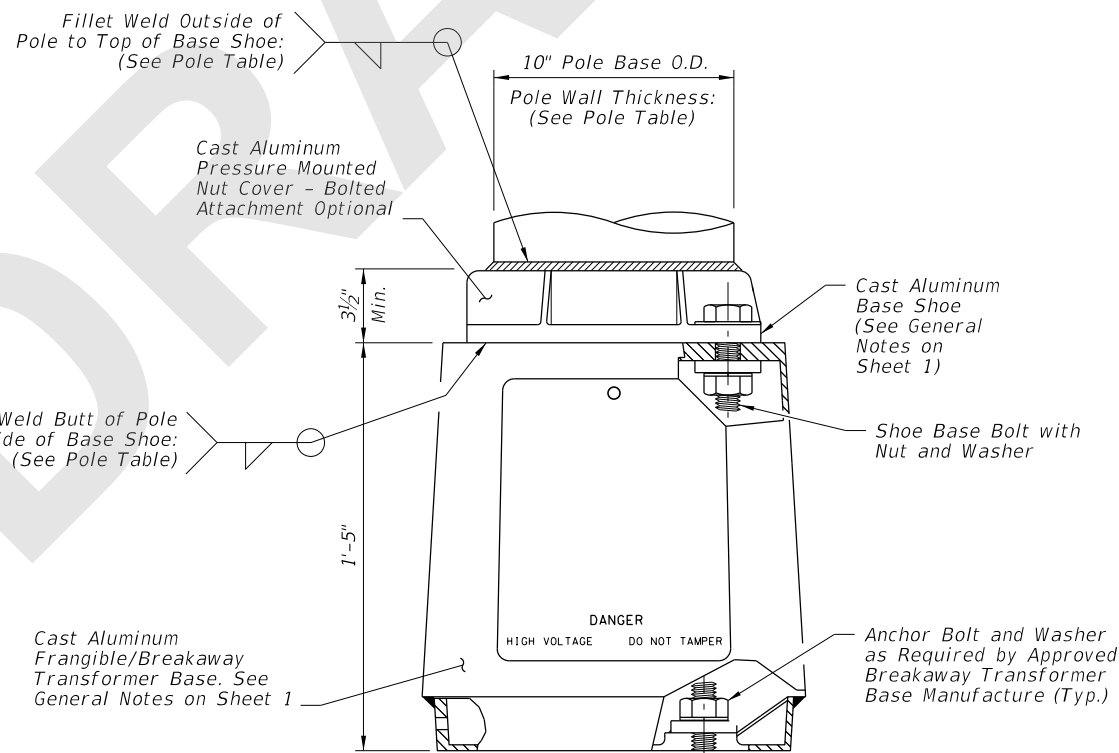

POLE BASE ELEVATION

ARM-POLE TABLE					
FOR STANDARD ALUMINUM LIGHT POLES WITH ARM					
Assembly Height (ft)	Wind Speed and Arm Lengths (ft)				
	120 mph 8, 10, 12, 15	140 mph 8, 10, 12	160 mph 15	8, 10	12, 15
30	A1-P1	A1-P1	A2-P1	A1-P1	A2-P1
35				A1-P2	A2-P2
40		A1-P2	A2-P2	A1-P3	A2-P3
45					
50	A1-P2	A1-P2	A2-P2	A1-P3	A2-P3

ARM POLE NOTES:

1. See ARM SECTION detail on Sheet 3 for all A1 and A2 Values.
2. See Pole Table for all P1, P2, and P3 values.
3. For Median Barrier Mounted Pole, Use Arm A1.

POLE TABLE			
Pole	Pole Wall Thickness	Top of Base Shoe Weld	Inside of Base Shoe Weld
P1	0.188	1/4"	3/16"
P2	0.250	5/16"	1/4"
P3	0.313	3/8"	5/16"


POLE NOTES:

1. Pole wall thicknesses shown are nominal and must be within the Aluminum Association tolerances.
2. Thicker walls are permitted and tapered walls may be used in accordance with the minimum Aluminum Association thicknesses.


TOP MOUNT POLE TABLE			
FOR STANDARD ALUMINUM LIGHT POLES WITH TOP MOUNT			
Assembly Height (ft)	Wind Speed and Arm Lengths (ft)		
	120 mph	140 mph	160 mph
30	Pole P1	Pole P1	Pole P1
35			Pole P2
40			
45			
50			

8/15/2018 1:57:22 PM


LAST REVISION 04/03/18	DESCRIPTION:
---------------------------	--------------

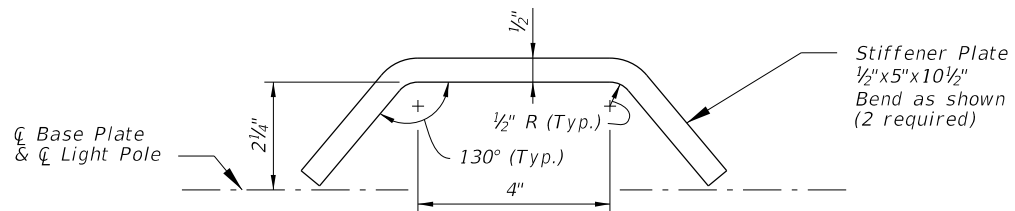


**STIFFENER PLATE DETAIL**

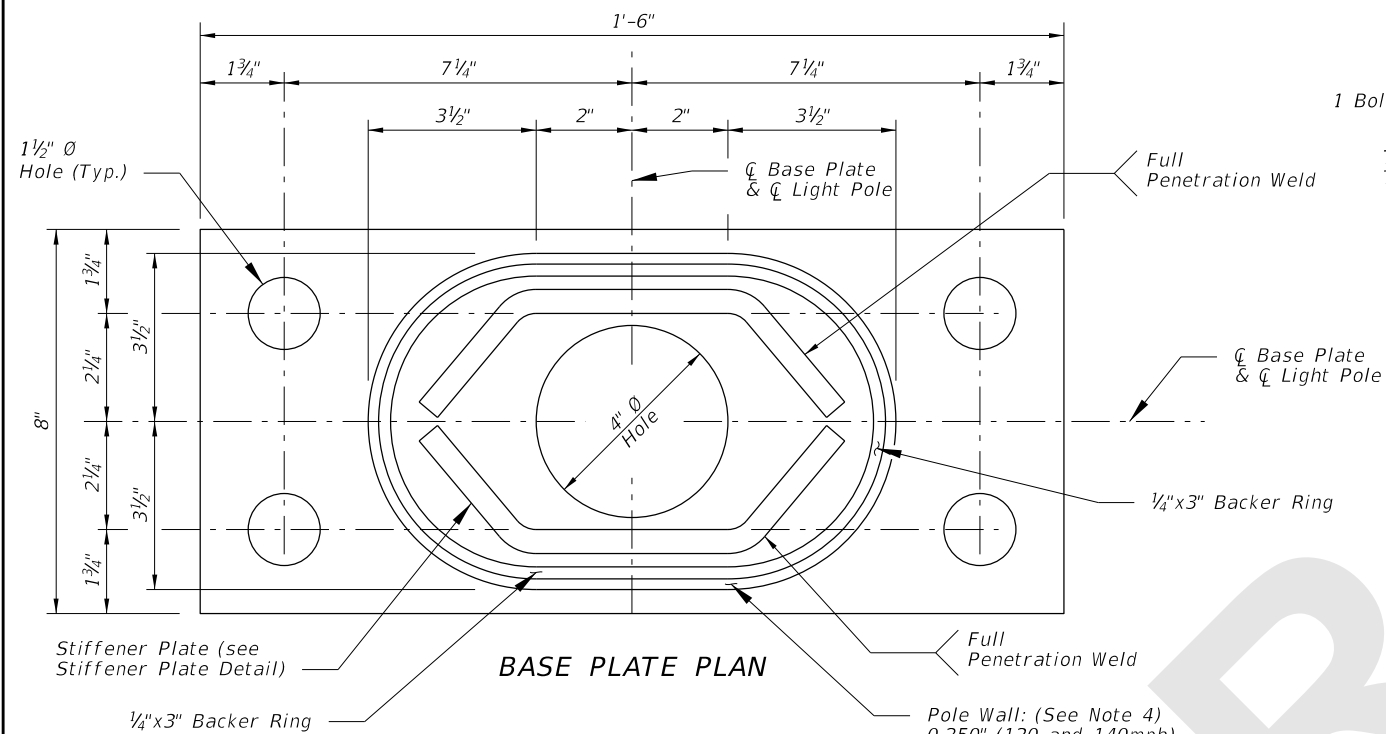

**BASE PLATE PLAN**

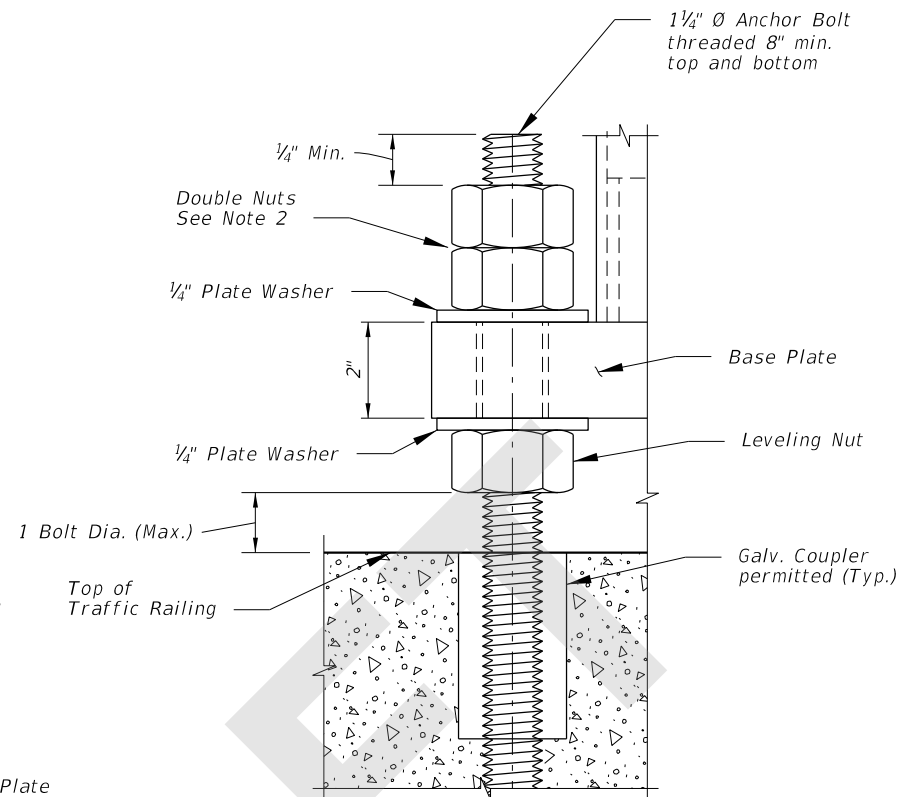

**DETAIL 'A'**

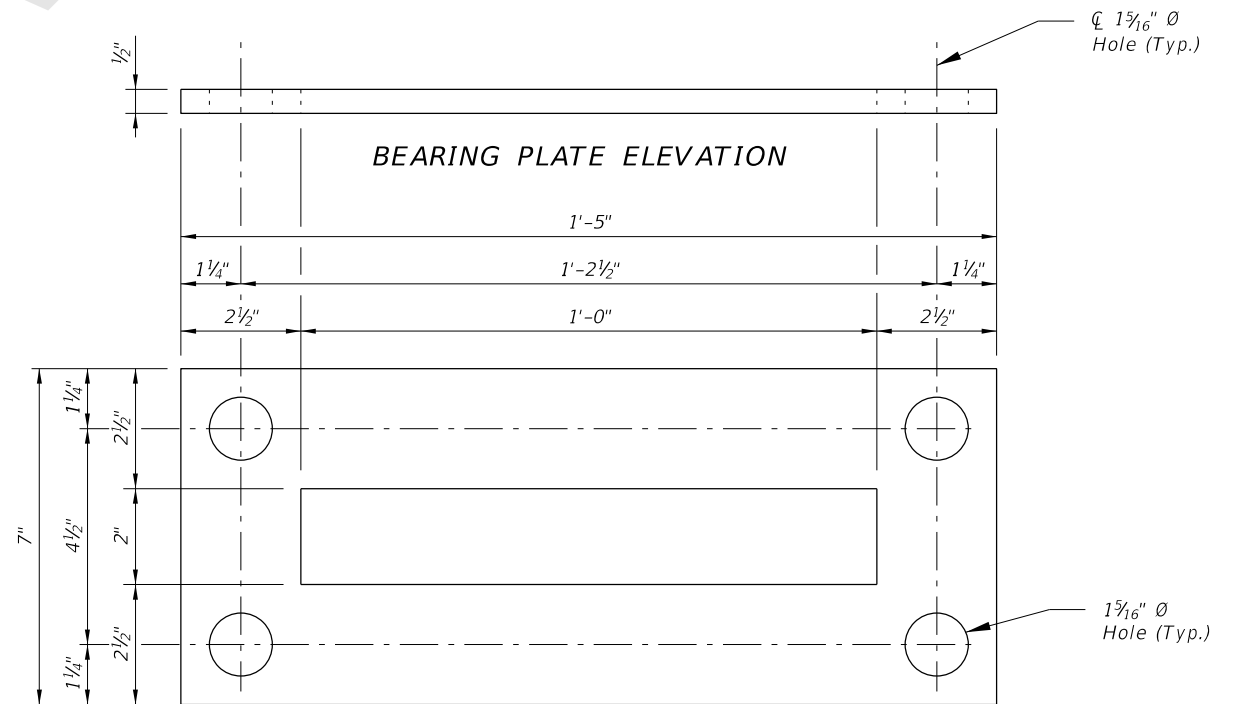


**BEARING PLATE ELEVATION**

**BEARING PLATE PLAN**

**NOTE:**

1. For locations of Bearing Plates, Base Plates and Detail 'A' see Sheets 6 & 7.
2. Double Nuts: The bottom hex nut may be substituted by a half height 'Jam' nut.
3. Provide individual nut covers (not shown) for each bolt.
4. Pole wall thicknesses shown are nominal and shall be within the Aluminum Association Tolerances. Thicker walls are permitted and tapered walls may be used in accordance with the minimum Aluminum Association thicknesses.

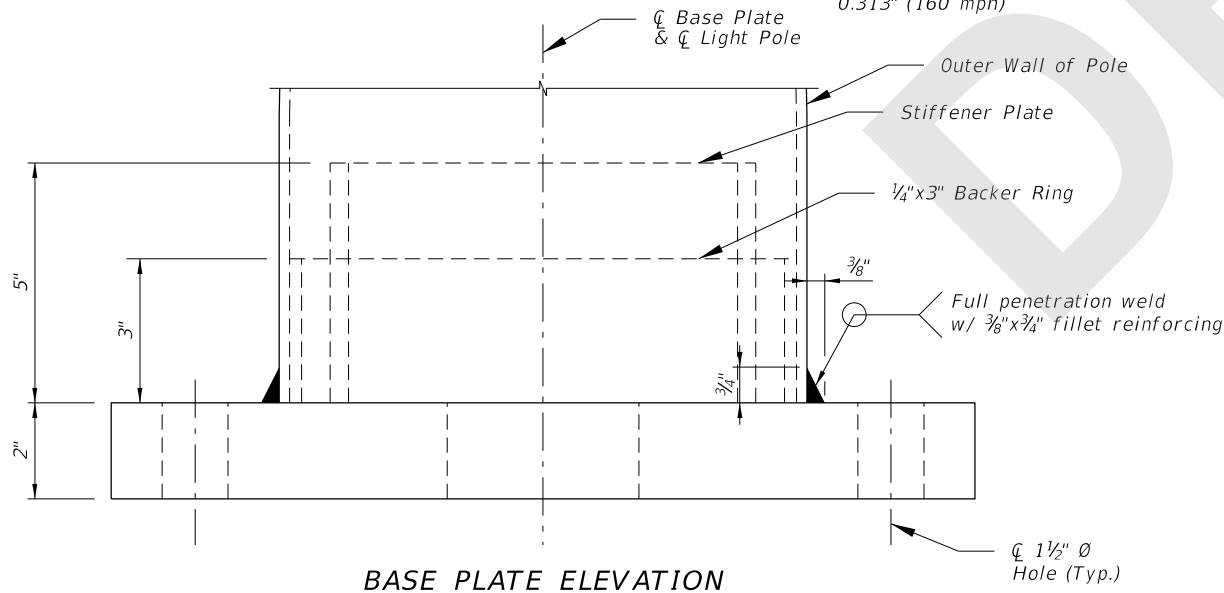

**BASE PLATE ELEVATION**

**BASE PLATE DETAILS FOR MEDIAN BARRIER MOUNTED ALUMINUM LIGHT POLE**

8/15/2018 1:57:23 PM

LAST REVISION	DESCRIPTION:
04/03/18	



FY 2018-19  
STANDARD PLANS

STANDARD ALUMINUM LIGHTING

INDEX  
715-002

SHEET  
5 of 8