
ORIGINATION FORM

Proposed Revisions to a Standard Plans Index (Please provide all information – Incomplete forms will be returned)

Contact Information:		Standard Plans:	
Date: May 7, 2018		Index Number: 440-002	
Originator: Rick Jenkins		Sheet Number (s): 1 of 1	
Phone: (850) 414-4355		Index Title: Underdrain Inspection Box	
Email: Ric	k.Jenkins@dot.state.fl.us		
	of the changes:		
Reorgani	zed Index into multiple sheets. Updated Note	es language.	
Commen	tary / Background:		
Note lang	guage updated to first person imperative to m	neet current standards.	
V N-	Other Affected Offices / Documents: (Provide name of responsible personnel)	
Yes No	Other Standard Plans –		
	FDOT Design Manual –		
	Basis of Estimates Manual –		
	Standard Specifications –		
	Approved Product List –		
	Construction –		
	Maintenance –		
	Origination Package Includes: (Email or h	nand deliver package to Derwood Sheppard)	
Yes N/A	Redline Mark-ups		
	Proposed Standard Plan Instructions (SPI)		
	Revised SPI		
	Other Support Documents		
Impleme	ntation:		
Design	Bulletin (Interim) DCE Memo Prog	gram Mgmt. Bulletin	
	Contact the Roadway Design Office	ce for assistance in completing this form	

NEW SHEET 1 OF 3

"GENERAL NOTES - TABLE OF CONTENTS - UNDERDRAIN INSPECTION BOX ASSEMBLY

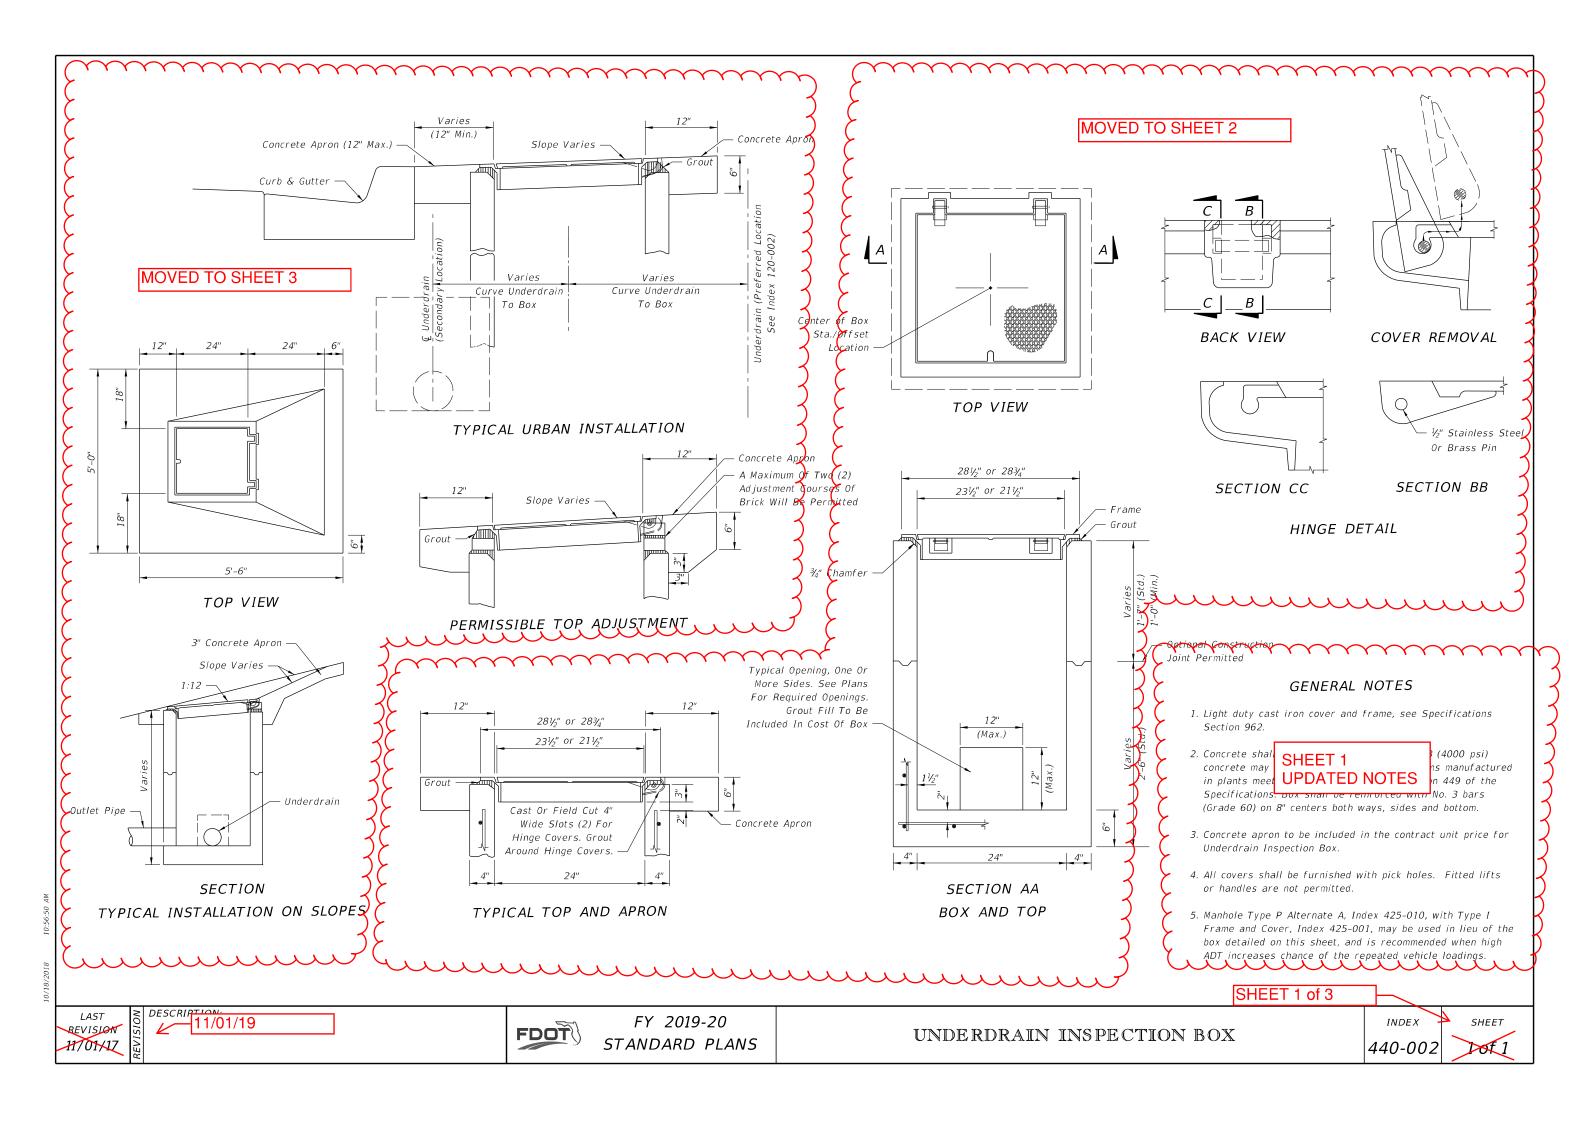


NEW SHEET 3 OF 3

TYPICAL URBAN, SLOPE, AND TOP ADJUSTMENT INSTALLATIONS

GENERAL NOTES:

- 1. Install light duty cast iron cover and frame in accordance with Specifications 962.
- 2. Use Class I concrete. Use No. 3 bars (Grade 60) on 8" centers both ways, sides and bottom.
- 3. Furnish covers with pick holes. Do not use fitted lifts or handles.
- 4. Manhole Type P Alternate A, Index 425-010, Type I Frame and Cover, Index 425-001, may be used in lieu of the box detailed in this Index.


TABLE OF CONTENTS:		
Sheet	Description	
1	General Notes and Contents	
2	Typical Inspection Box Installation	
3	Typical Urban, Slope, and Top Adjustment Installations	

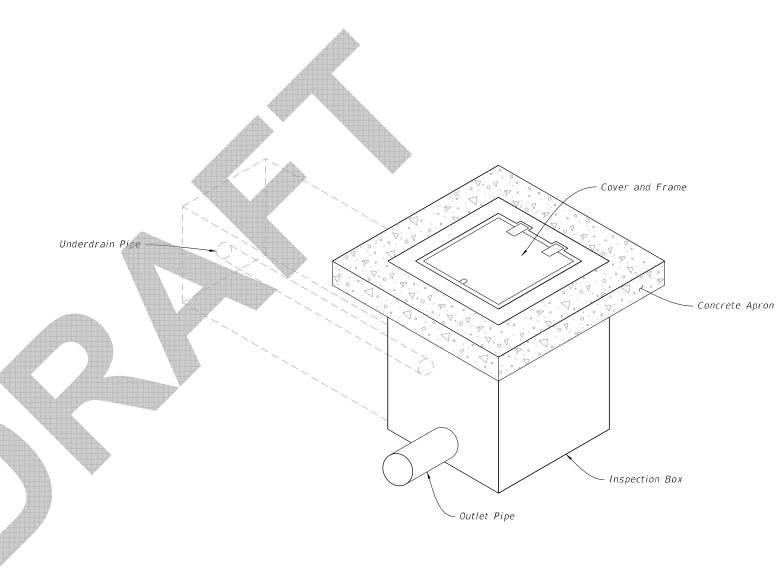

=UNDERDRAIN INSPECTION BOX ASSEMBLY ==

≥ DESCRIPTION: LAST REVISION 11/01/19

FDOT

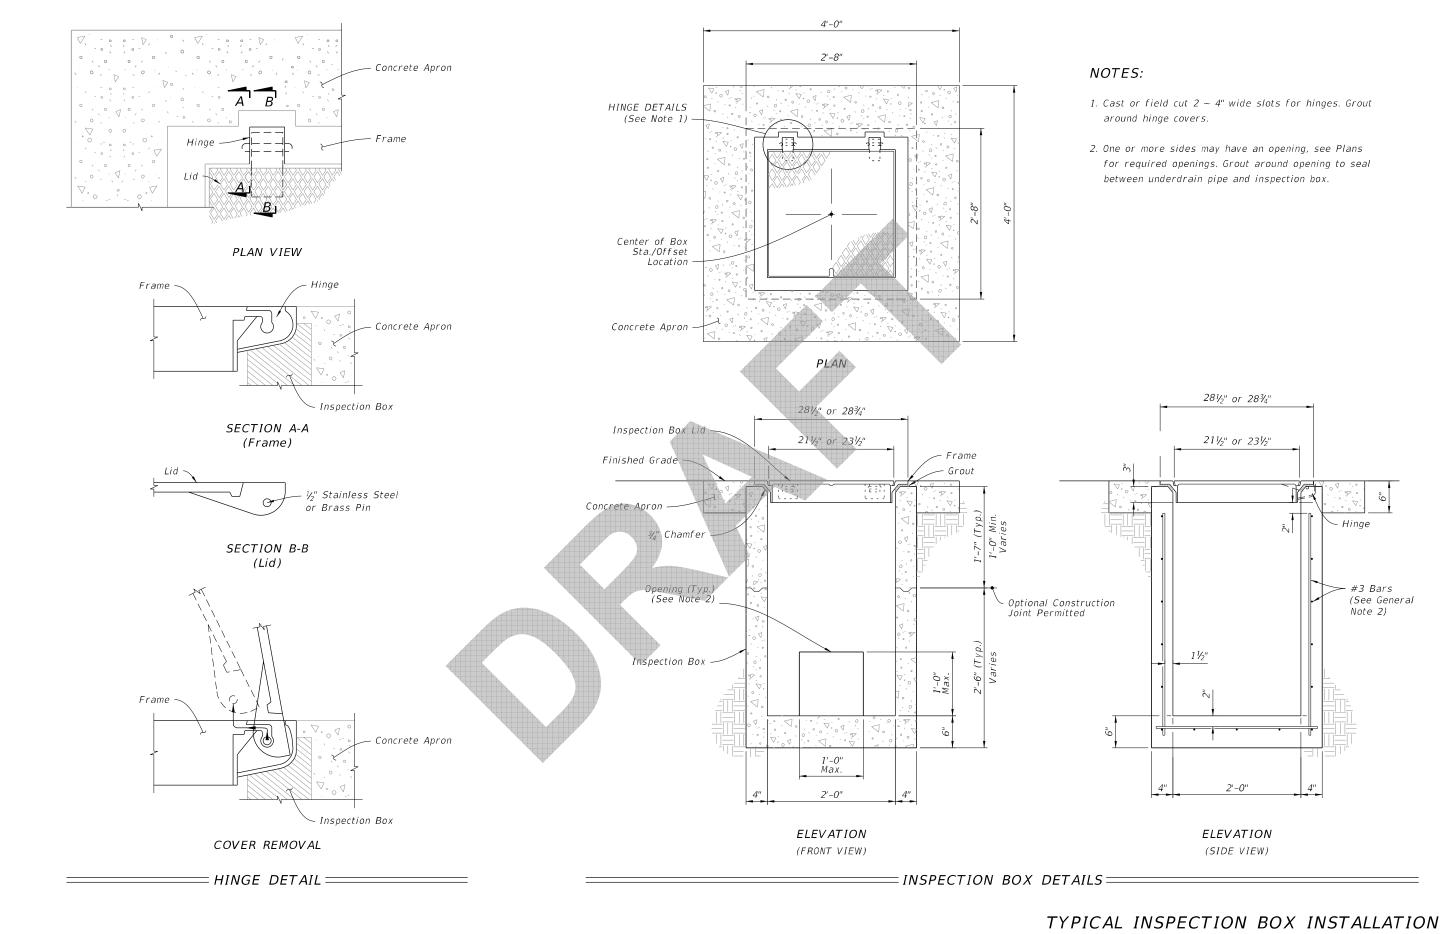


≥ DESCRIPTION: LAST REVISION 11/01/19

FDOT

FY 2020-21 STANDARD PLANS

INDEX 440-002

SHEET

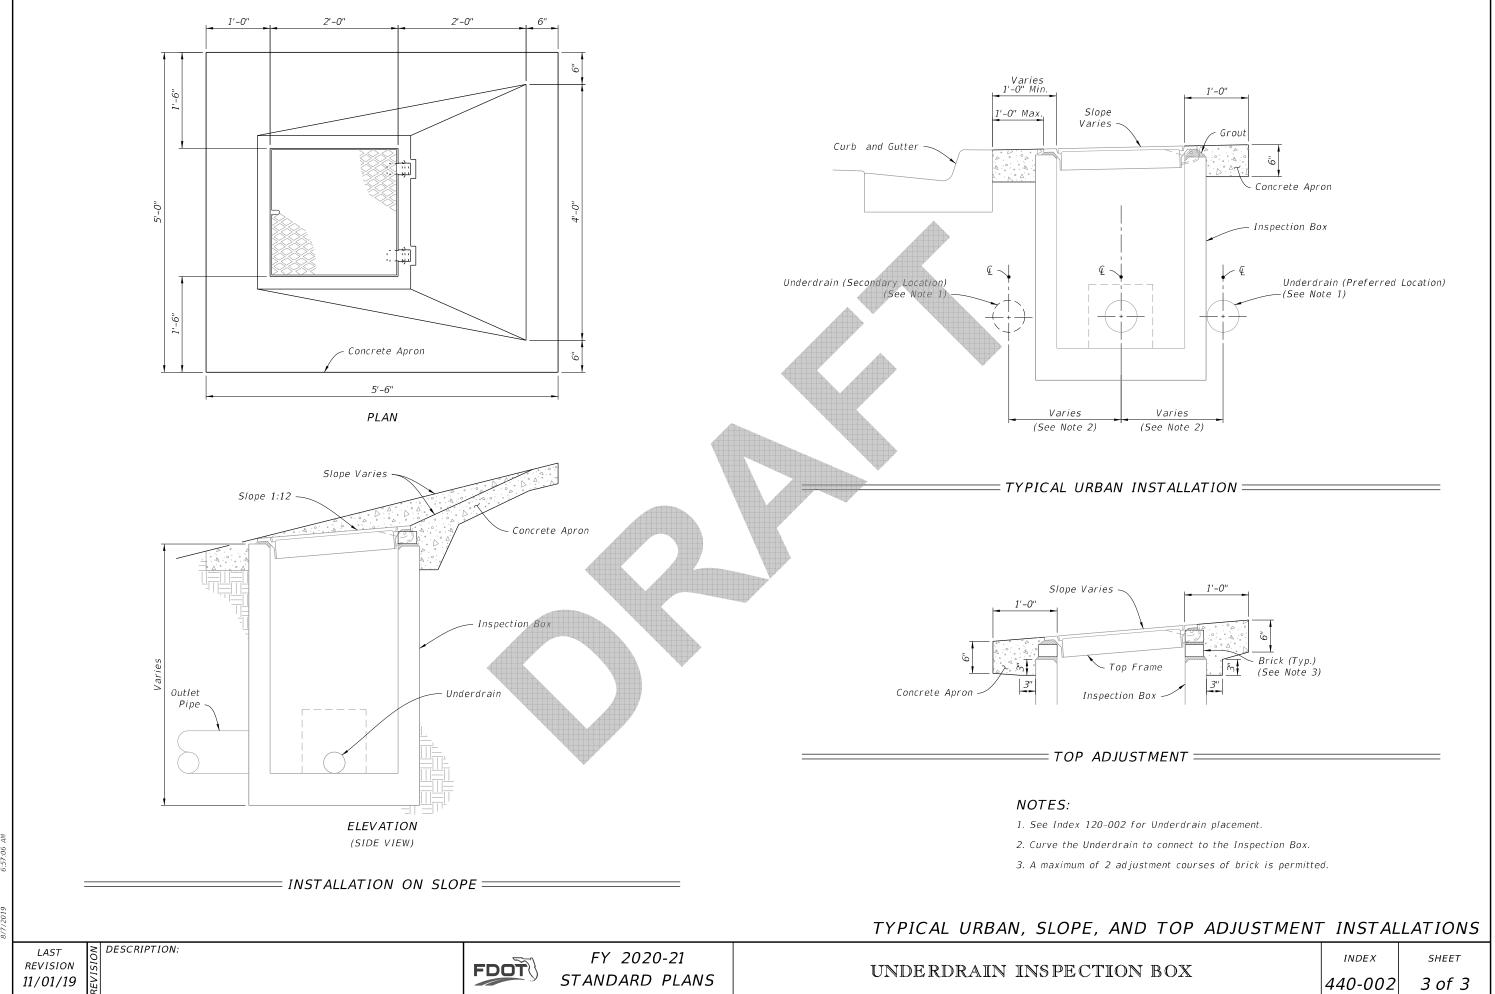

11/01/19

440-002