

## **ORIGINATION FORM**

Proposed Revisions to a Standard Plans Index (Please provide all information – Incomplete forms will be returned)

<b>Contact Information:</b>		Standard Plans:
Date: July 31, 2019		Index Number: 521-001
Originator: Richard Stepp		Sheet Number (s): 15-16
Phone: (850) 414-4313		Index Title: Concrete Barrier
Email: richard.stepp@dot.state.fl.us		
Summary of the changes: -Sheets 15 & 16: Change "Shoulder Barrier Inlet" to "Adjacent Barrier Inlet" callout		
	cary / Background:	ajacent barrier iniet canout
V N-	Other Affected Offices / Documents: (F	Provide name of responsible personnel)
Yes No	Other Standard Plans –	
	FDOT Design Manual –	
	Basis of Estimates Manual –	
	Standard Specifications –	
	Approved Product List –	
	Construction –	
	Maintenance –	
	Origination Package Includes: (Email or h	nand deliver package to Derwood Sheppard)
Yes N/A	Redline Mark-ups	
	Proposed Standard Plan Instructions (SPI)	
	Revised SPI	
	Other Support Documents	
Implementation:		
Design Bulletin (Interim) DCE Memo Program Mgmt. Bulletin FY-Standard Plans (Next Release)		
Contact the Roadway Design Office for assistance in completing this form		

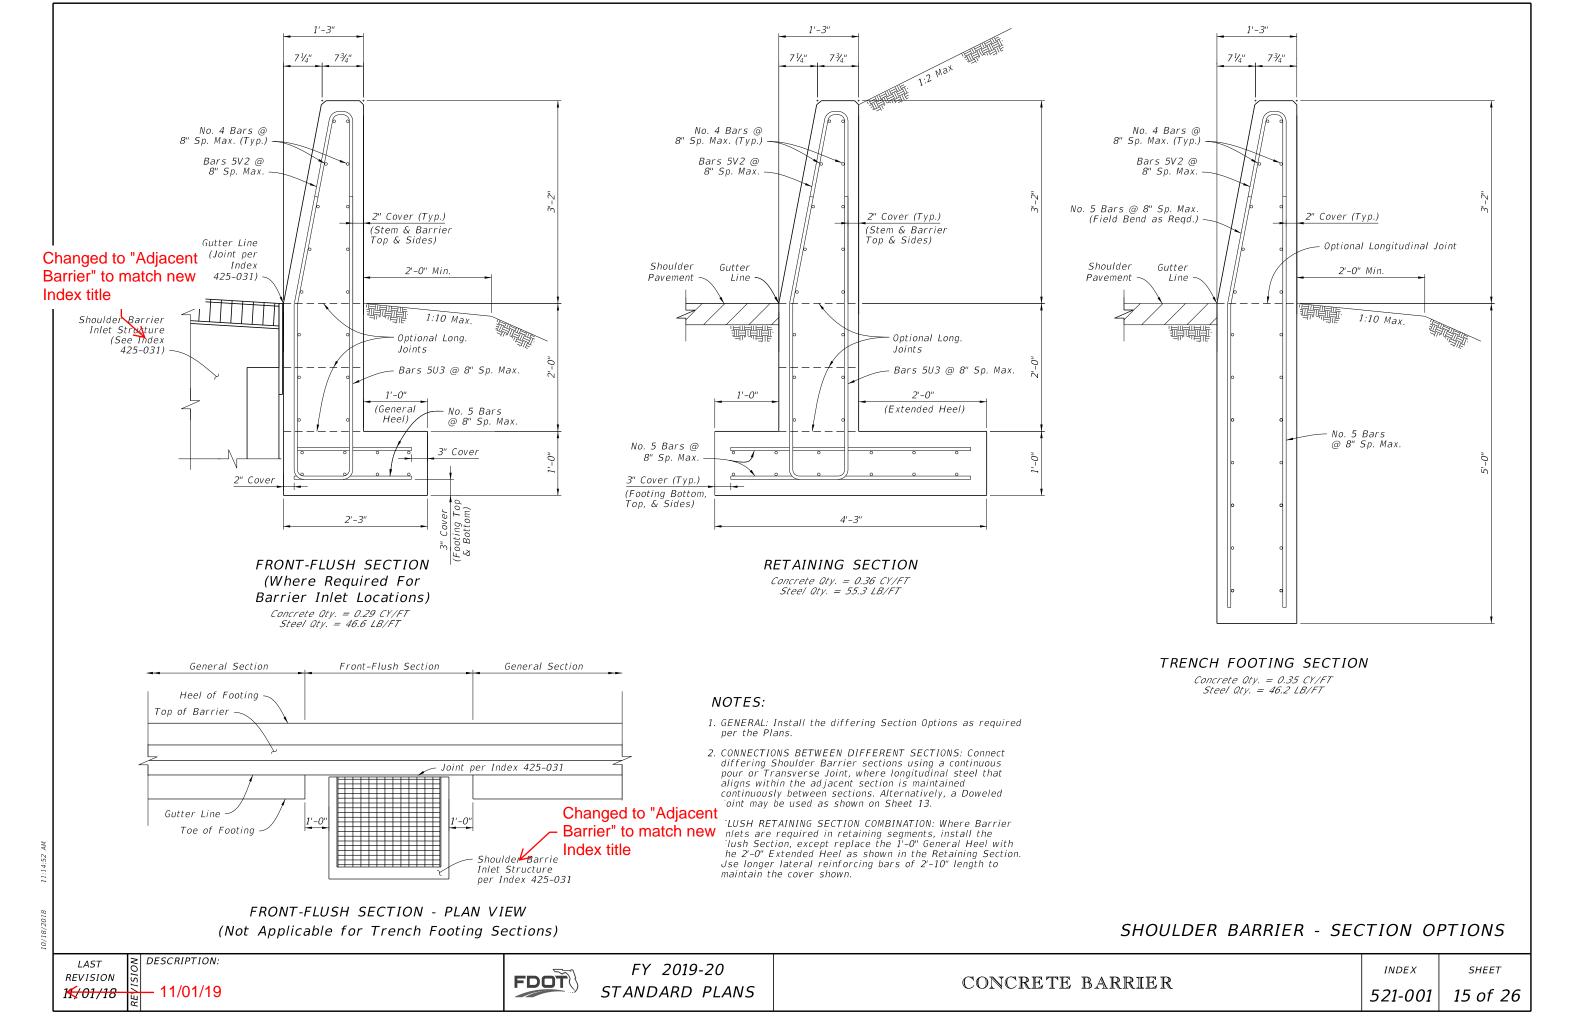

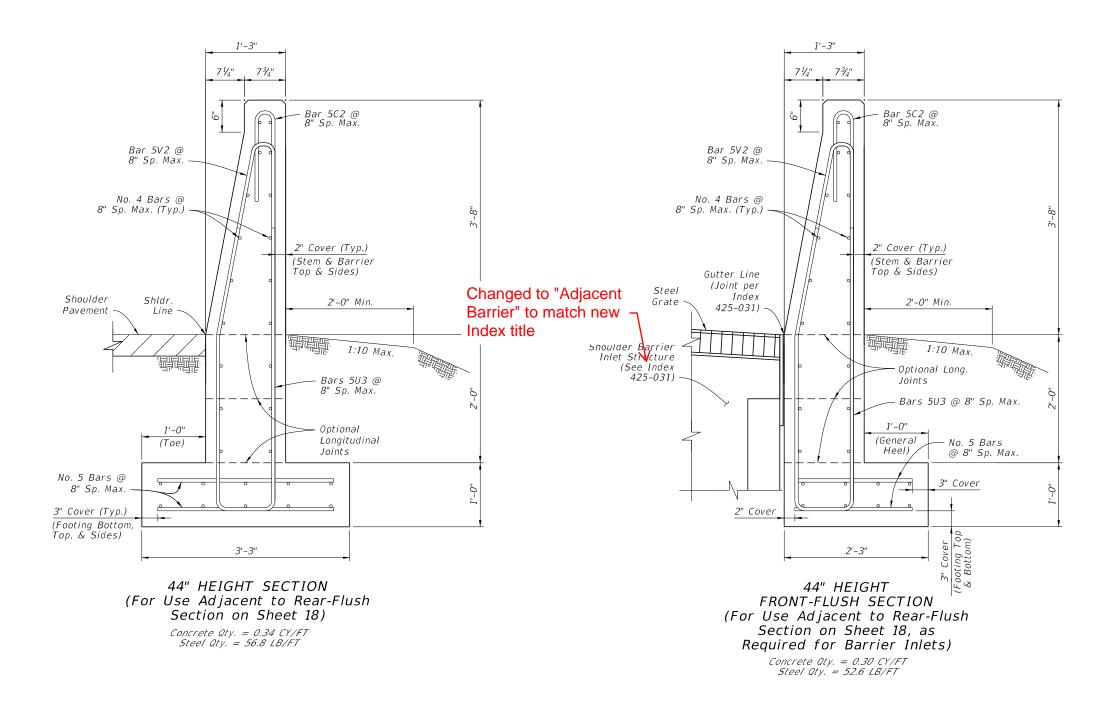

NOTE:

1. GENERAL: See the applicable Notes on Sheet 15.

SHOULDER BARRIER - SECTION OPTIONS (CONTINUED)


DESCRIPTION: LAST **REVISION** 11/01/19 *1<del>√/01/18</del>* 


FDOT

FY 2019-20 STANDARD PLANS

INDEX *521-001* 

SHEET 16 of 26

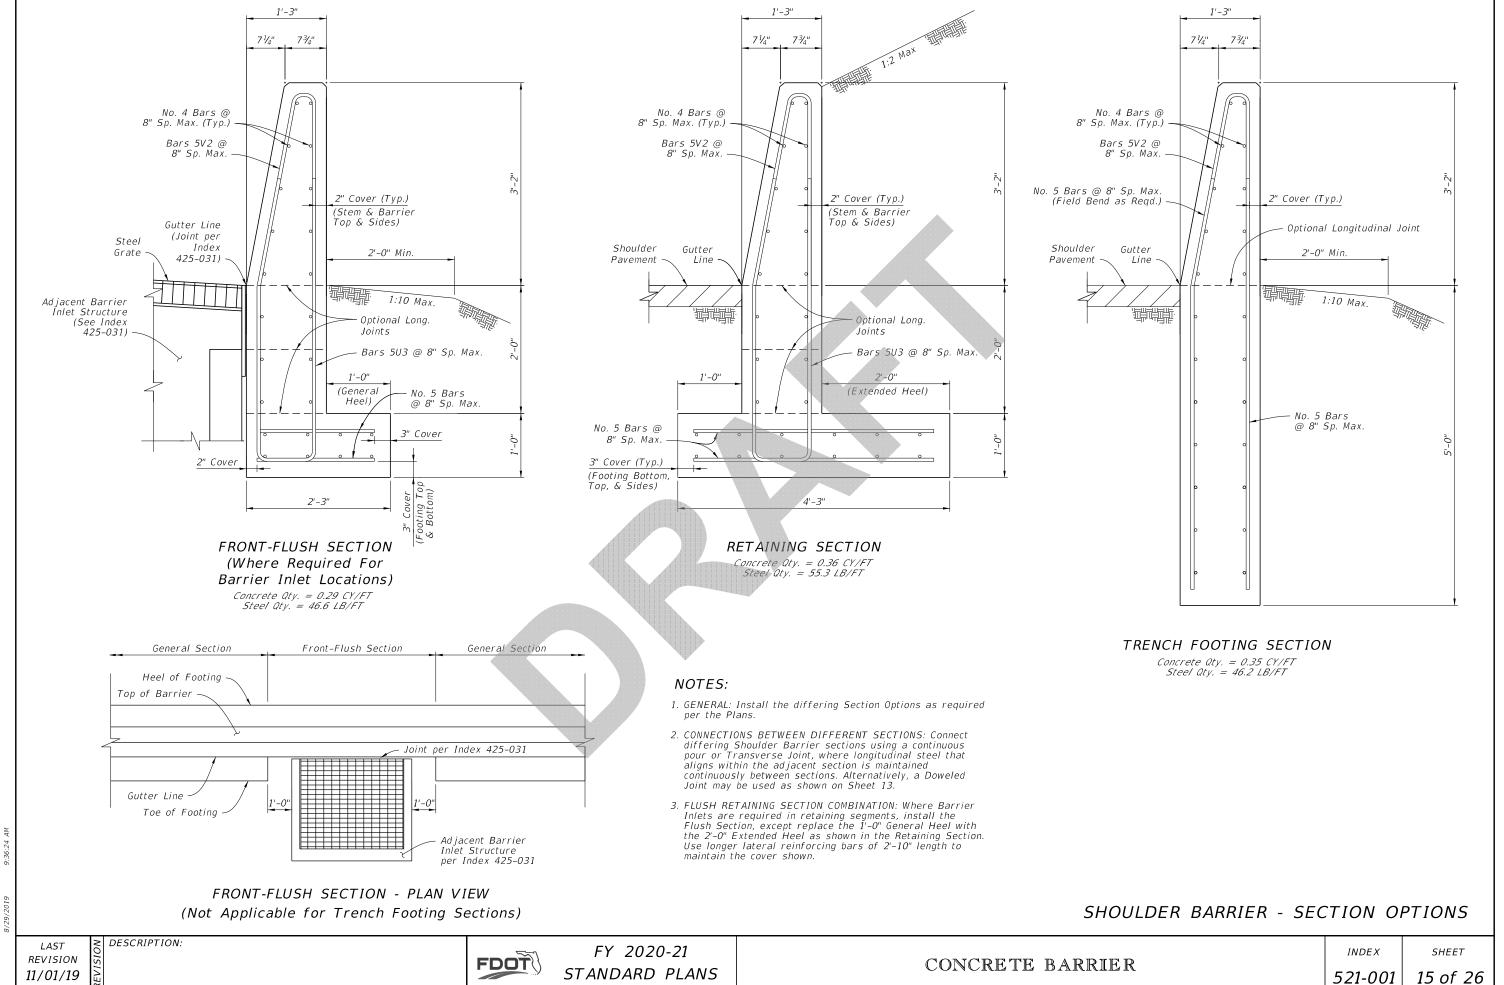

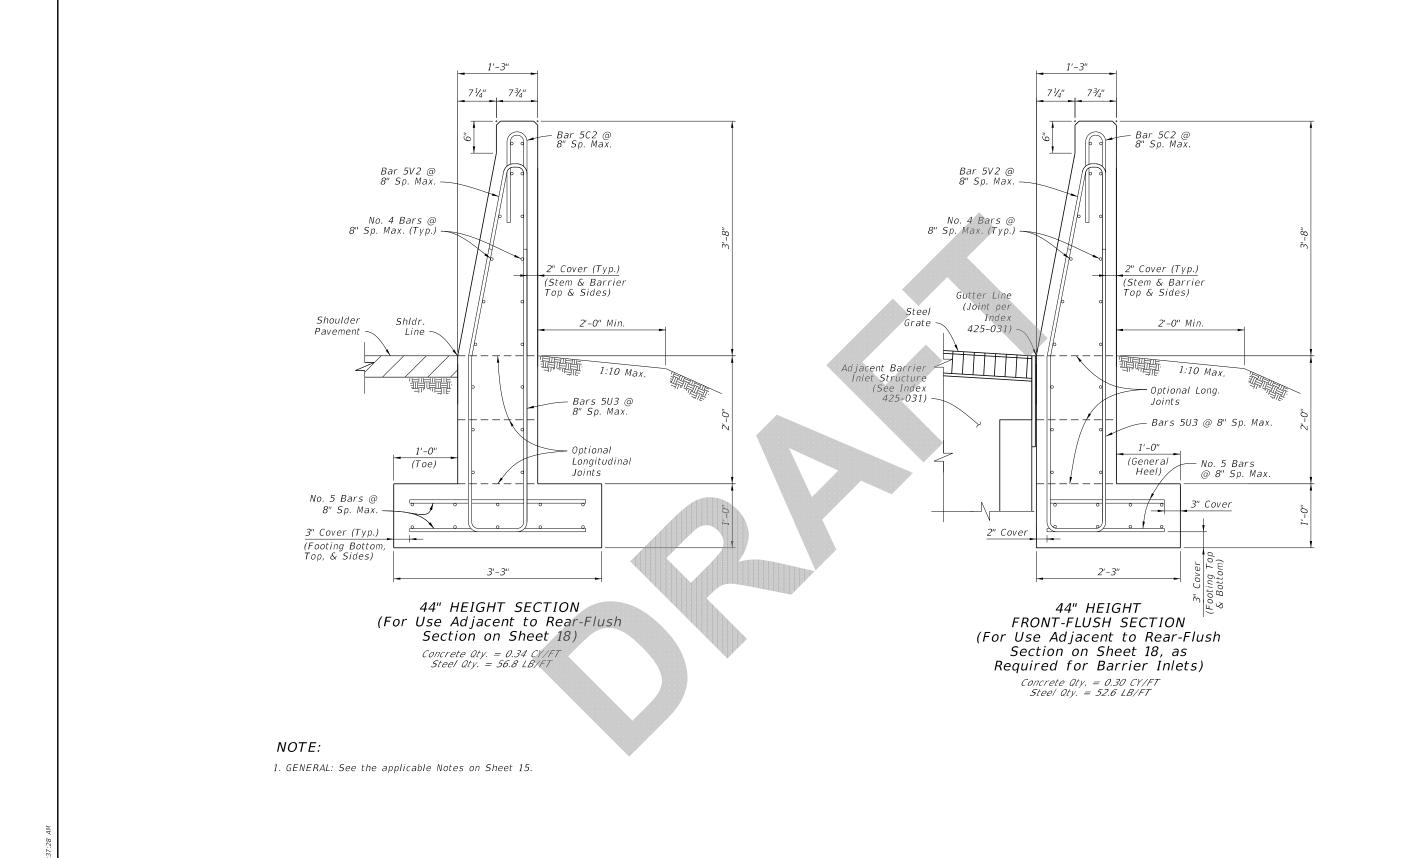

SHOULDER BARRIER - SECTION OPTIONS (CONTINUED)

LAST REVISION 11/01/19 ≥ DESCRIPTION:

FDOT

FY 2020-21 STANDARD PLANS

CONCRETE BARRIER

SHEET INDEX *521-001* 16 of 26