

# ORIGINATION FORM

Proposed Revisions to a Standard Plans Index  
(Please provide all information – Incomplete forms will be returned)

## Contact Information:

Date: August 6, 2019  
Originator: **Jeff Caster**  
Phone: (850) 414-5267  
Email: jeff.caster@dot.state.fl.us

## Standard Plans:

Index Number: **591-001**  
Sheet Number (s): 1 of 1  
Index Title: Landscape Irrigation Sleeves

## Summary of the changes:

New Index.

## Commentary / Background:

### Other Affected Offices / Documents: (Provide name of responsible personnel)

- | Yes                                 | No                                  |   |
|-------------------------------------|-------------------------------------|---|
| <input type="checkbox"/>            | <input checked="" type="checkbox"/> | Other Standard Plans –                                    |
| <input checked="" type="checkbox"/> | <input type="checkbox"/>            | FDOT Design Manual – Add to Landscape Chap. FDM 228 & 329 |
| <input checked="" type="checkbox"/> | <input type="checkbox"/>            | Basis of Estimates Manual –                               |
| <input checked="" type="checkbox"/> | <input type="checkbox"/>            | Standard Specifications – Specification 591               |
| <input type="checkbox"/>            | <input type="checkbox"/>            | Approved Product List –                                   |
| <input type="checkbox"/>            | <input type="checkbox"/>            | Construction –  |
| <input type="checkbox"/>            | <input type="checkbox"/>            | Maintenance –   |


### Origination Package Includes: (Email or hand deliver package to Derwood Sheppard)

- | Yes                                 | N/A                      |   |
|-------------------------------------|--------------------------|---|
| <input checked="" type="checkbox"/> | <input type="checkbox"/> | Redline Mark-ups                          |
| <input checked="" type="checkbox"/> | <input type="checkbox"/> | Proposed Standard Plan Instructions (SPI) |
| <input type="checkbox"/>            | <input type="checkbox"/> | Revised SPI                               |
| <input type="checkbox"/>            | <input type="checkbox"/> | Other Support Documents                   |


## Implementation:

- Design Bulletin (Interim)    DCE Memo    Program Mgmt. Bulletin    FY-Standard Plans (Next Release)


————— **Contact the Roadway Design Office for assistance in completing this form** —————

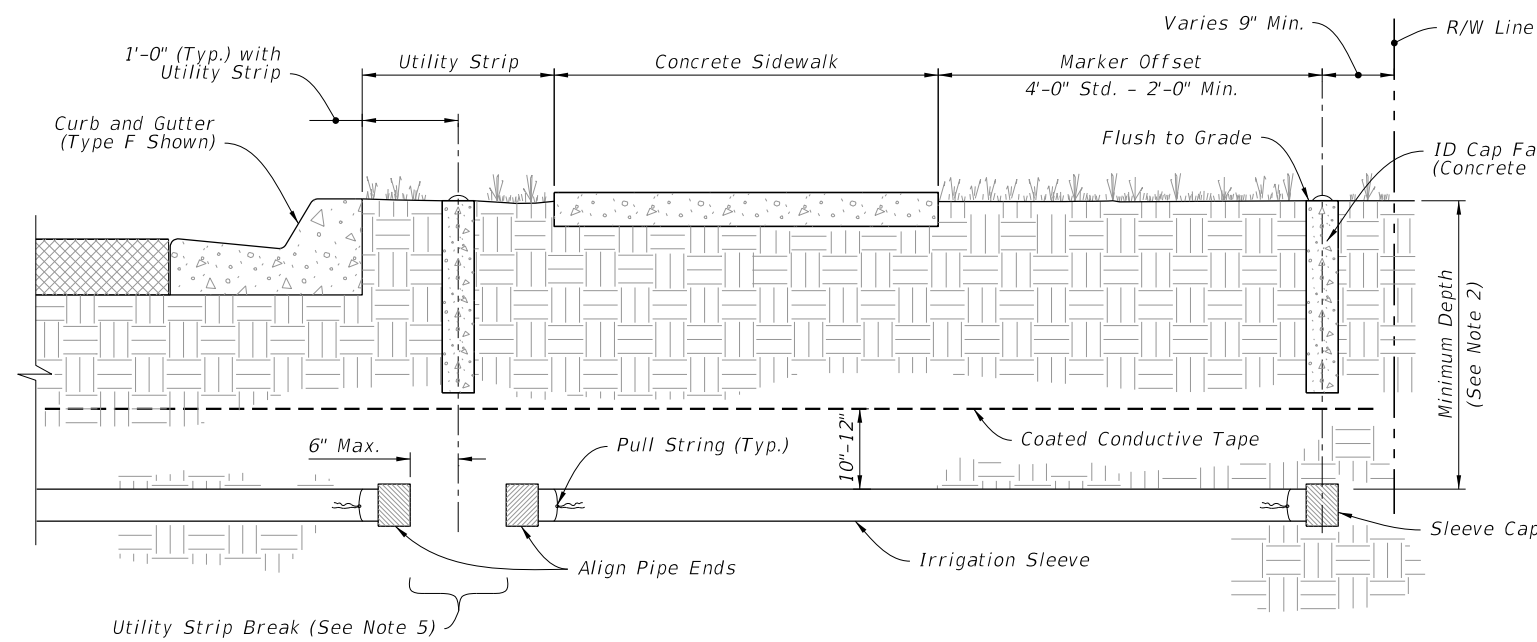


ROADWAY WITH UTILITY STRIP

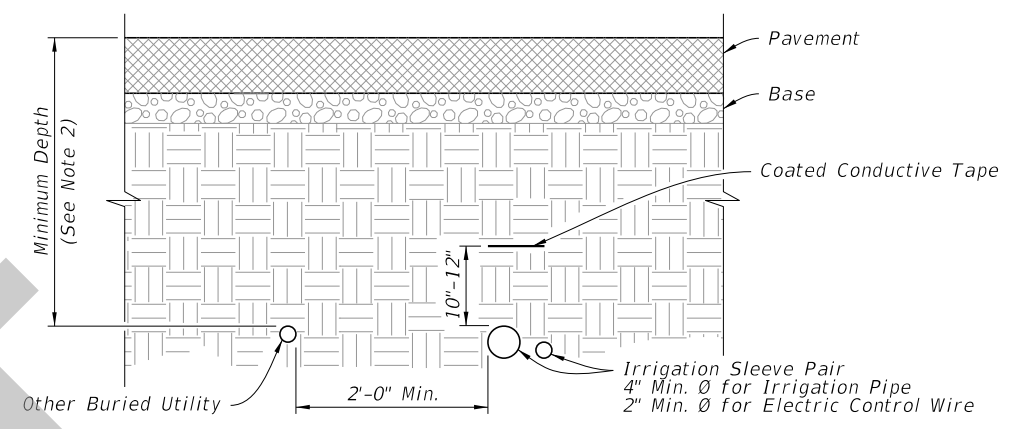

ROADWAY CROSS SECTION

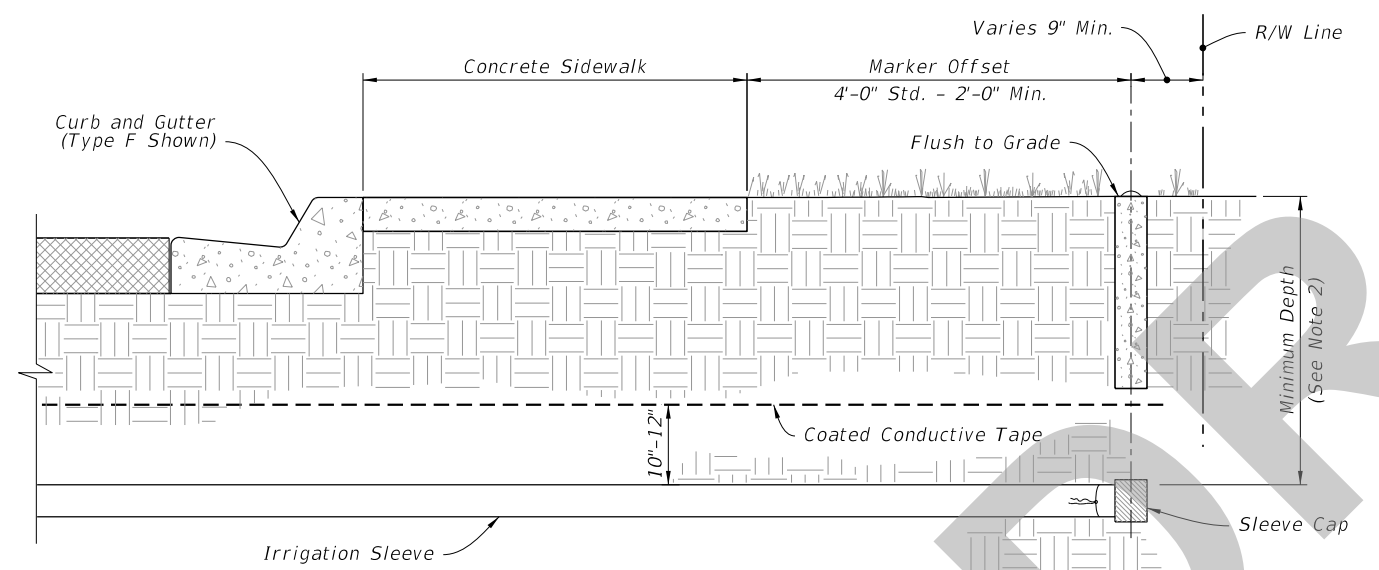

ROADWAY WITHOUT UTILITY STRIP

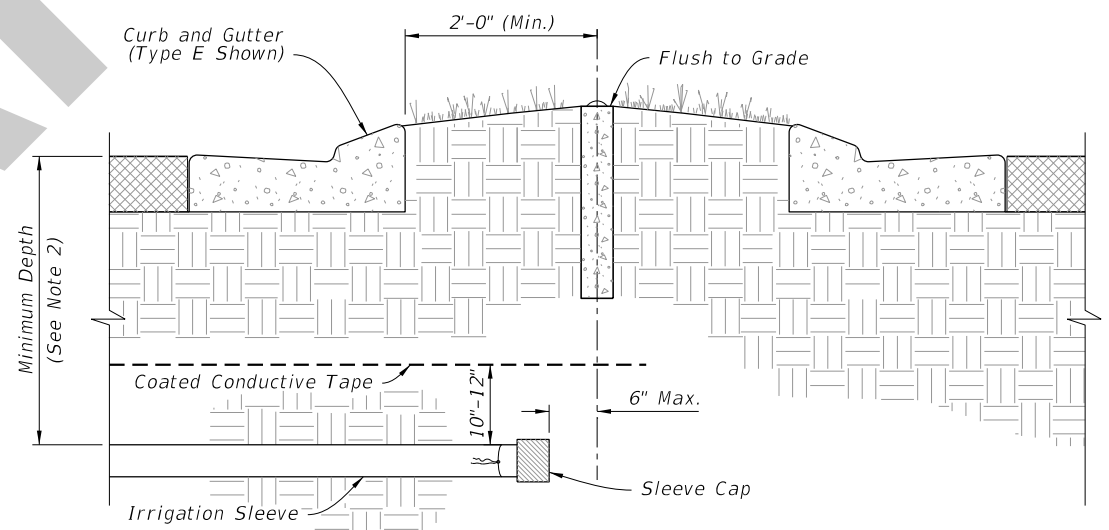


ROADWAY MEDIAN OR ROUNDABOUT

**NOTES:**

1. Work this Index with Specification 591.
2. Install Sleeve with the minimum depth measured from the top of the Irrigation Sleeve as shown in the Plans or specified in Index 630-001.
3. When installing Irrigation Sleeves in a median crossover, place sleeves along the centerline.
4. Irrigation Sleeves for Electrical Control Wire and Irrigation Pipe must be no further than 12" apart.
5. Install Utility Strip Breaks only when shown in the Plans.

8/27/2019 2:59:26 PM

LAST REVISION 11/01/19	REVISION	DESCRIPTION:	 FY 2020-21 STANDARD PLANS	LANDSCAPE IRRIGATION SLEEVES	INDEX 591-001	SHEET 1 of 1
---------------------------	----------	--------------	--	------------------------------	------------------	-----------------