

ORIGINATION FORM

Proposed Revisions to a Standard Plans Index
(Please provide all information – Incomplete forms will be returned)

Contact Information:

Date: June 17, 2019
Originator: **Ed Cashman**
Phone: (850) 414-4314
Email: edward.cashman@dot.state.fl.us

Standard Plans:

Index Number: **665-001**
Sheet Number (s): 1
Index Title: Pedestrian Detector Assembly Installation
Details

Summary of the changes:

Revised note 2.

Commentary / Background:

Revised note to reduce chance of conflict.

Other Affected Offices / Documents: (Provide name of responsible personnel)

- | Yes | No | |
|--------------------------|-------------------------------------|-----------------------------|
| <input type="checkbox"/> | <input checked="" type="checkbox"/> | Other Standard Plans – |
| <input type="checkbox"/> | <input checked="" type="checkbox"/> | FDOT Design Manual – |
| <input type="checkbox"/> | <input checked="" type="checkbox"/> | Basis of Estimates Manual – |
| <input type="checkbox"/> | <input checked="" type="checkbox"/> | Standard Specifications – |
| <input type="checkbox"/> | <input checked="" type="checkbox"/> | Approved Product List – |
| <input type="checkbox"/> | <input checked="" type="checkbox"/> | Construction – |
| <input type="checkbox"/> | <input checked="" type="checkbox"/> | Maintenance – |


Origination Package Includes: (Email or hand deliver package to Derwood Sheppard)

- | Yes | N/A | |
|-------------------------------------|--------------------------|-------------------------------------------|
| <input checked="" type="checkbox"/> | <input type="checkbox"/> | Redline Mark-ups |
| <input type="checkbox"/> | <input type="checkbox"/> | Proposed Standard Plan Instructions (SPI) |
| <input type="checkbox"/> | <input type="checkbox"/> | Revised SPI |
| <input type="checkbox"/> | <input type="checkbox"/> | Other Support Documents |

Implementation:

- Design Bulletin (Interim) DCE Memo Program Mgmt. Bulletin FY-Standard Plans (Next Release)

Contact the Roadway Design Office for assistance in completing this form

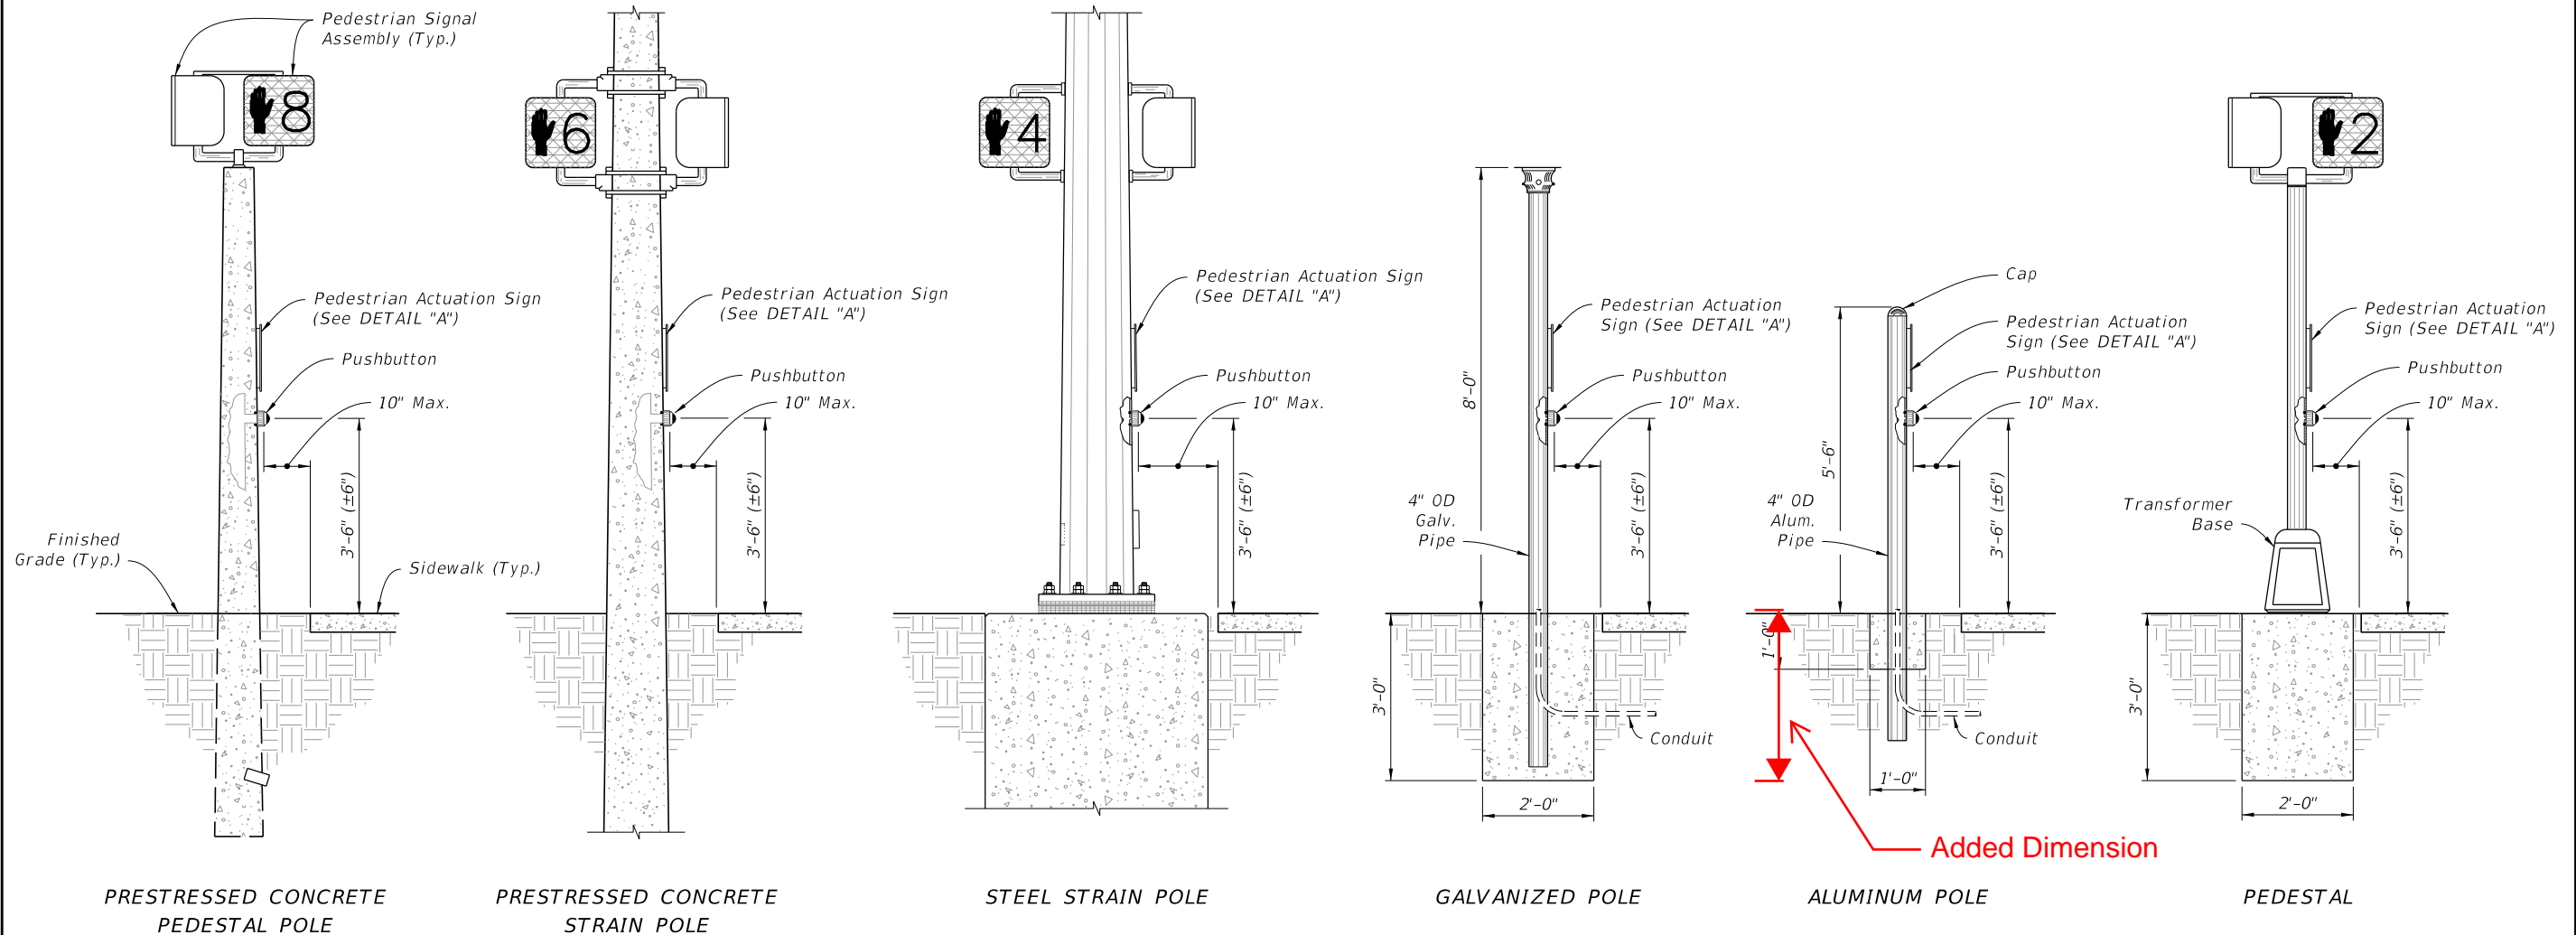

PRESTRESSED CONCRETE PEDESTAL POLE

PRESTRESSED CONCRETE STRAIN POLE


STEEL STRAIN POLE

GALVANIZED POLE

ALUMINUM POLE

PEDESTAL

PUSHBUTTON PEDESTRIAN DETECTORS

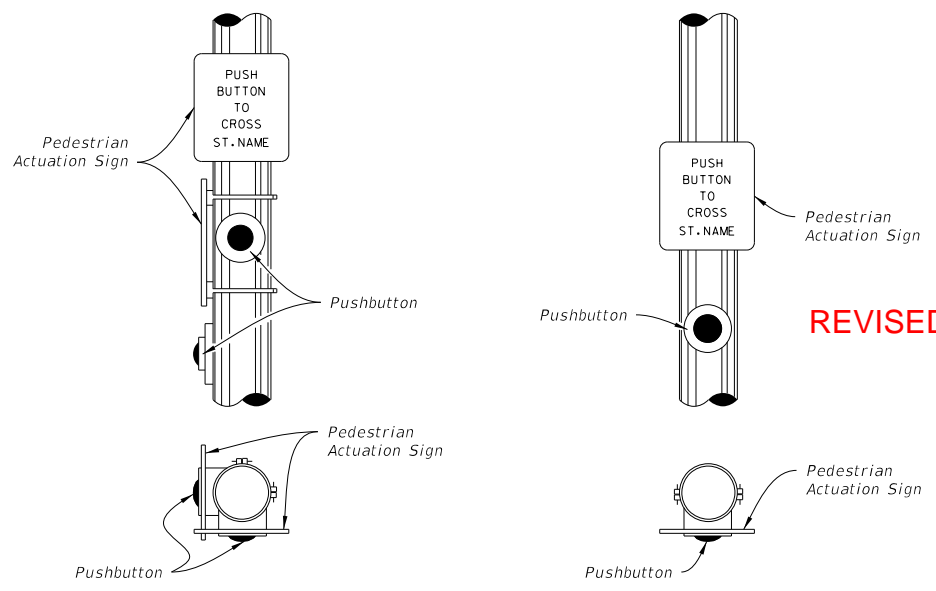

DETAIL "A"


REVISED NOTE 2: , or as shown int he Plans.

NOTES:

1. Mount Signs above the detectors. See Index 700-102 for sign details.
2. Install Pushbuttons and Pedestrian Actuation Signs with faces parallel to the crossing direction.
3. Mount pushbuttons and Signs in accordance with Specification 665.
4. Install all grounding per Specification 620.
5. Pushbutton mounting height shown above is taken at the center of the actuation switch.

1/8/2019 6:55:06 AM

LAST REVISION 11/01/18 REVISION	DESCRIPTION: ← 11/01/19		FY 2019-20 STANDARD PLANS	PEDESTRIAN DETECTOR ASSEMBLY INSTALLATION DETAILS	INDEX 665-001	SHEET 1 of 1
--------------------------------------------------	----------------------------	--	------------------------------	------------------------------------------------------	------------------	-----------------

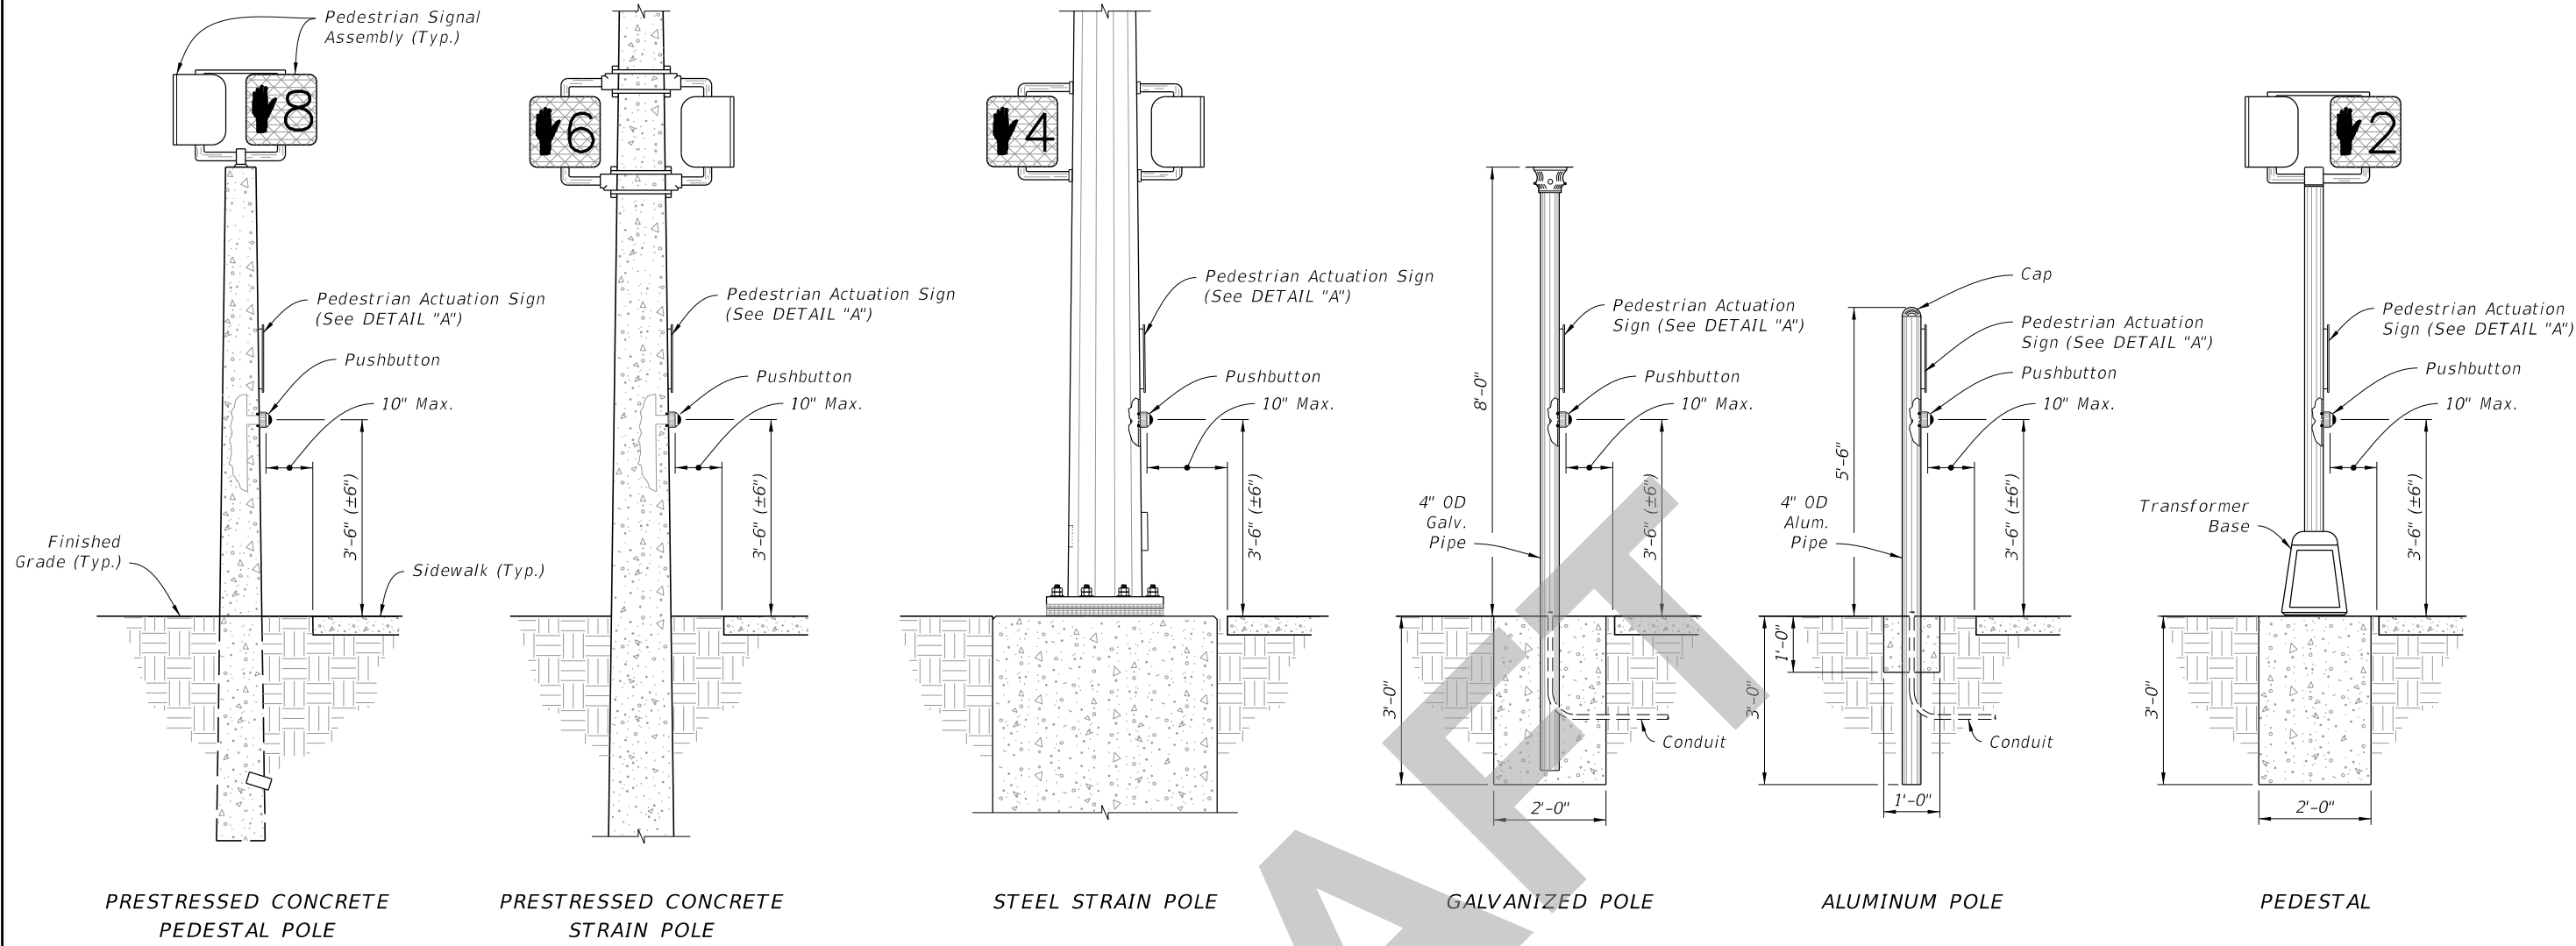

PRESTRESSED CONCRETE
PEDESTAL POLE

PRESTRESSED CONCRETE
STRAIN POLE


STEEL STRAIN POLE

GALVANIZED POLE

ALUMINUM POLE

PEDESTAL

PUSHBUTTON PEDESTRIAN DETECTORS

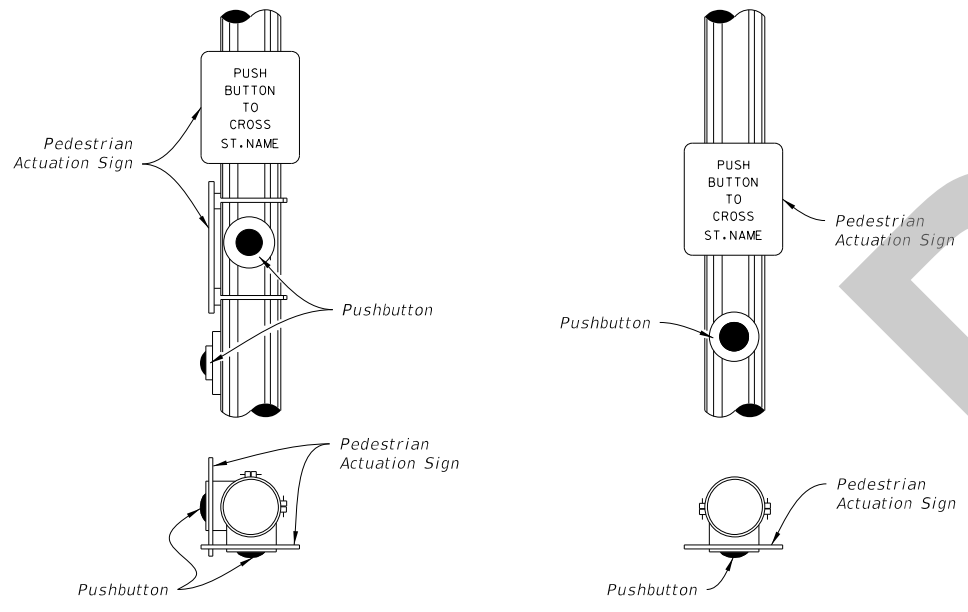


DETAIL "A"

NOTES:

1. Mount Signs above the detectors. See Index 700-102 for sign details.
2. Install Pushbuttons and Pedestrian Actuation Signs with faces parallel to the crossing direction, or as shown in the Plans.
3. Mount pushbuttons and Signs in accordance with Specification 665.
4. Install all grounding per Specification 620.
5. Pushbutton mounting height shown above is taken at the center of the actuation switch.

8/27/2019 3:05:04 PM

LAST REVISION 11/01/19	REVISION	DESCRIPTION:	 FY 2020-21 STANDARD PLANS	PEDESTRIAN DETECTOR ASSEMBLY INSTALLATION DETAILS	INDEX 665-001	SHEET 1 of 1
---------------------------	----------	--------------	----------------------------------------------------------------------------------------------------------------------	------------------------------------------------------	------------------	-----------------