

ORIGINATION FORM

Proposed Revisions to a Standard Plans Index
(Please provide all information – Incomplete forms will be returned)

Contact Information:

Date: July 31, 2019
Originator: **Ed Cashman**
Phone: (850) 414-4314
Email: Edward.cashman@dot.state.fl.us

Standard Plans:

Index Number: **706-001**
Sheet Number (s): 3
Index Title: Typical Placement of Raised Pavement Markers

Summary of the changes:

Changed striping limits in details.

Commentary / Background:

Revised details to be more consistent across Indexes.

Other Affected Offices / Documents: (Provide name of responsible personnel)

- | Yes | No | |
|--------------------------|-------------------------------------|-----------------------------|
| <input type="checkbox"/> | <input checked="" type="checkbox"/> | Other Standard Plans – |
| <input type="checkbox"/> | <input checked="" type="checkbox"/> | FDOT Design Manual – |
| <input type="checkbox"/> | <input checked="" type="checkbox"/> | Basis of Estimates Manual – |
| <input type="checkbox"/> | <input checked="" type="checkbox"/> | Standard Specifications – |
| <input type="checkbox"/> | <input checked="" type="checkbox"/> | Approved Product List – |
| <input type="checkbox"/> | <input checked="" type="checkbox"/> | Construction – |
| <input type="checkbox"/> | <input checked="" type="checkbox"/> | Maintenance – |


Origination Package Includes: (Email or hand deliver package to Derwood Sheppard)

- | Yes | N/A | |
|-------------------------------------|-------------------------------------|---|
| <input checked="" type="checkbox"/> | <input type="checkbox"/> | Redline Mark-ups |
| <input type="checkbox"/> | <input checked="" type="checkbox"/> | Proposed Standard Plan Instructions (SPI) |
| <input type="checkbox"/> | <input checked="" type="checkbox"/> | Revised SPI |
| <input type="checkbox"/> | <input checked="" type="checkbox"/> | Other Support Documents |


Implementation:

- Design Bulletin (Interim) DCE Memo Program Mgmt. Bulletin FY-Standard Plans (Next Release)



Contact the Roadway Design Office for assistance in completing this form

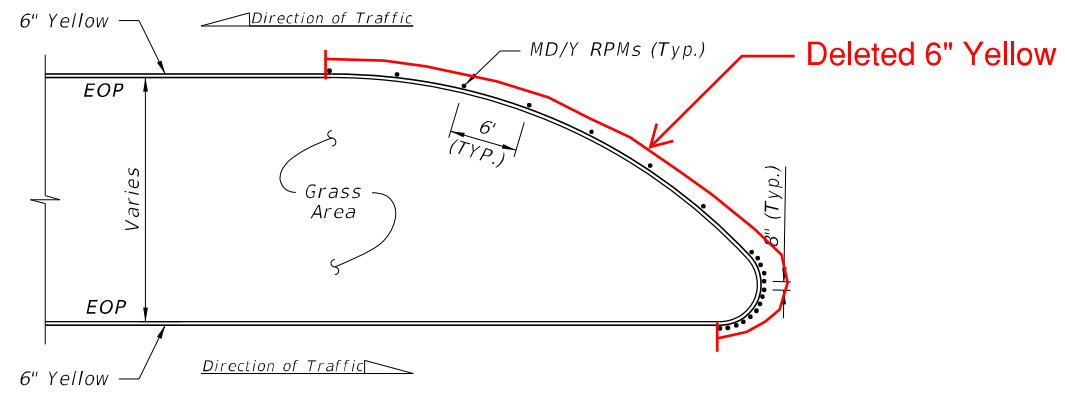


DETAIL "A"

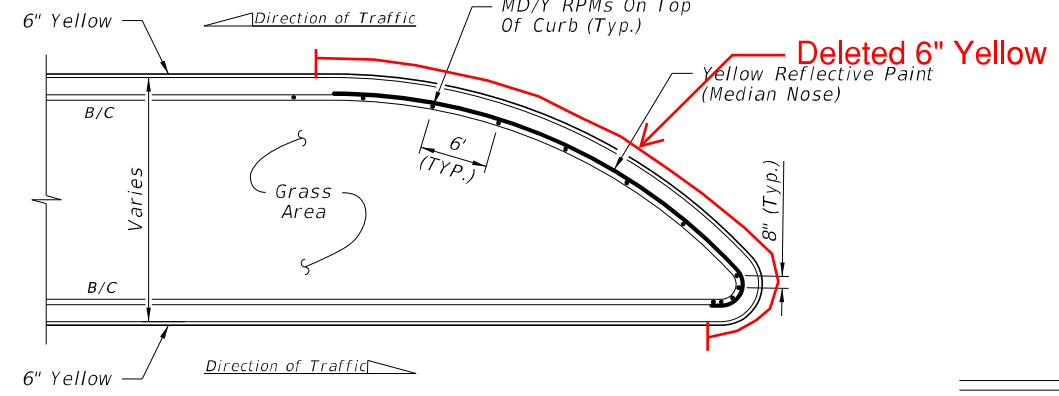

DETAIL "D"

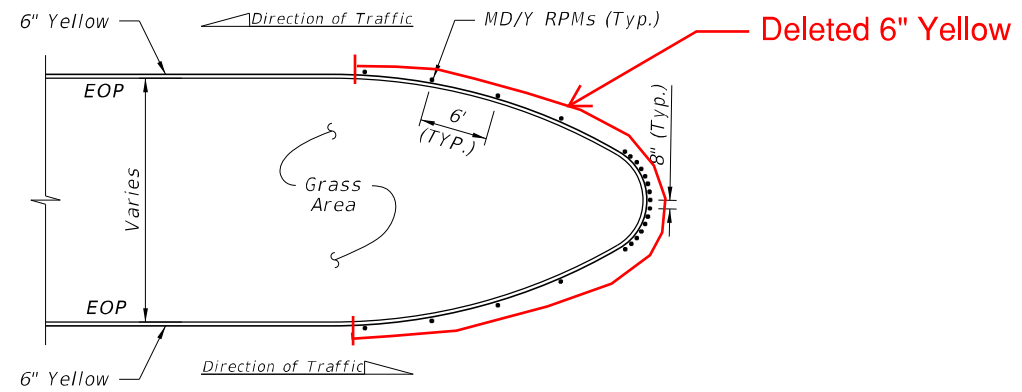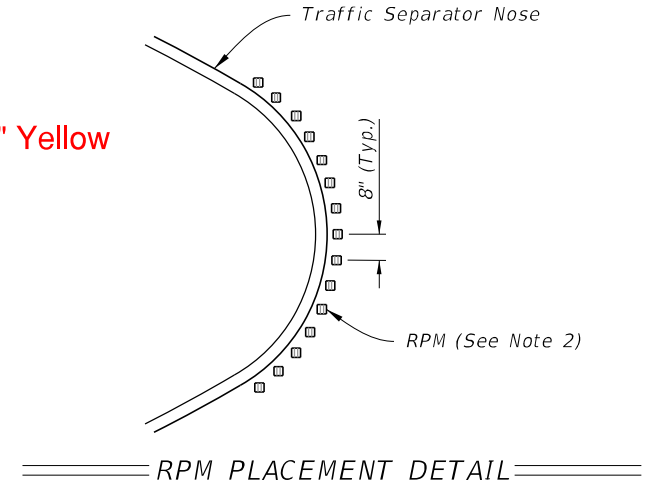


DETAIL "B"

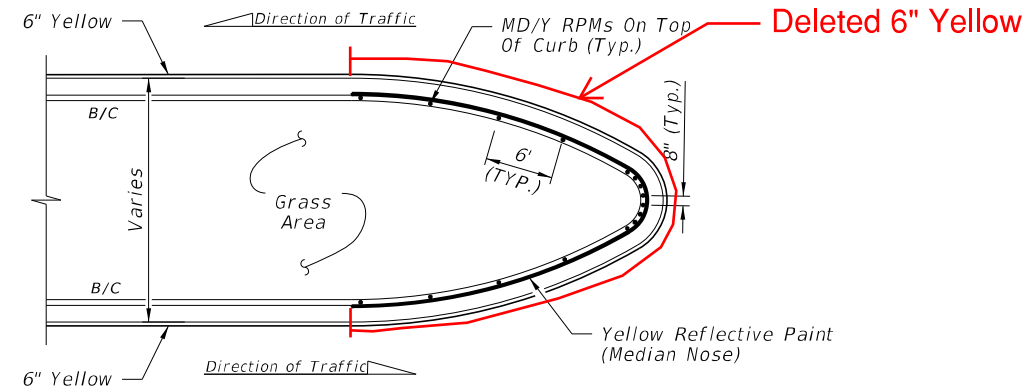


DETAIL "E"

POSTED SPEED LIMIT MPH	"Y" FEET
30 OR LESS	10
35	20
40	20
45	30
50 OR MORE	40

- LEGEND:**
- B/C = BACK OF CURB
 - EOP = EDGE OF PAVEMENT
 - RPM = RAISED PAVEMENT MARKER
 - W/R = WHITE/RED RPM
 - Y/Y = YELLOW/YELLOW RPM
 - Y/R = YELLOW/RED RPM
 - MD/Y = MONO-DIRECTIONAL YELLOW RPM

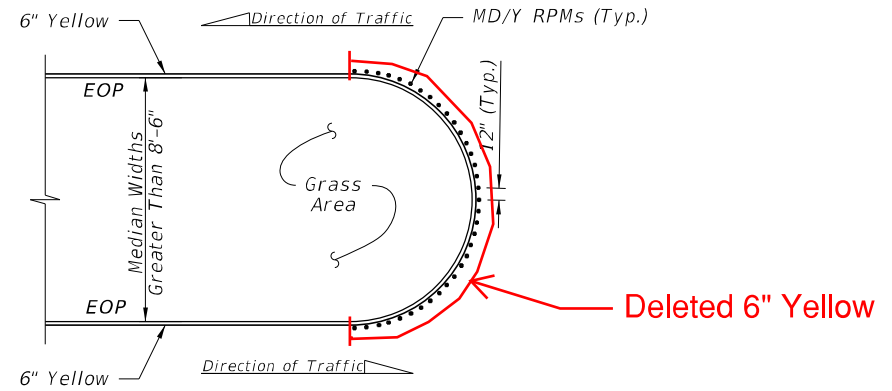

DETAIL "C"

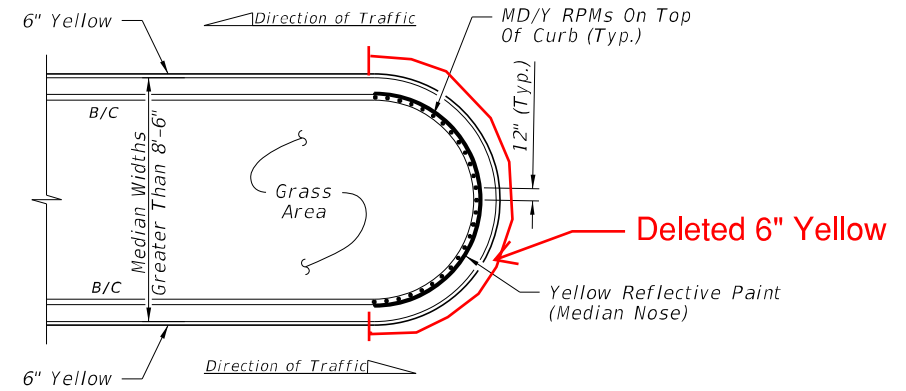

DETAIL "F"


- NOTES:**
- For Type "E" Curb, install RPMs along the pavement edge marking using the same spacing shown.
 - Orient traffic faces of RPMs in curb median radii to be parallel to direction of travel lanes.

FLUSH MEDIAN OPENINGS


TYPE "D" OR "F" CURB

RPM PLACEMENT AT MEDIAN OPENINGS
(When called for in the Plans)



12/11/2018 11:53:55 AM

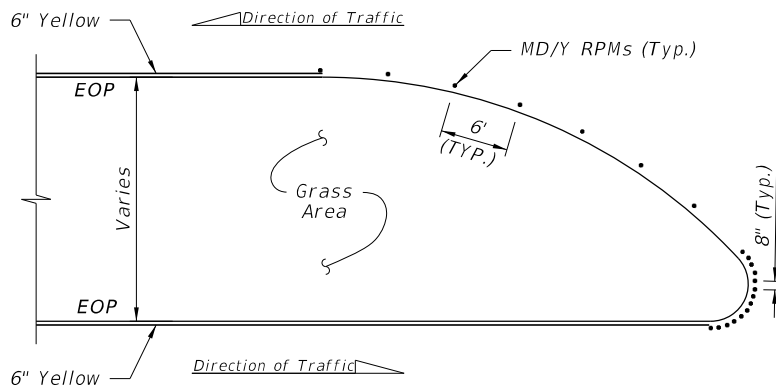


DETAIL "A"

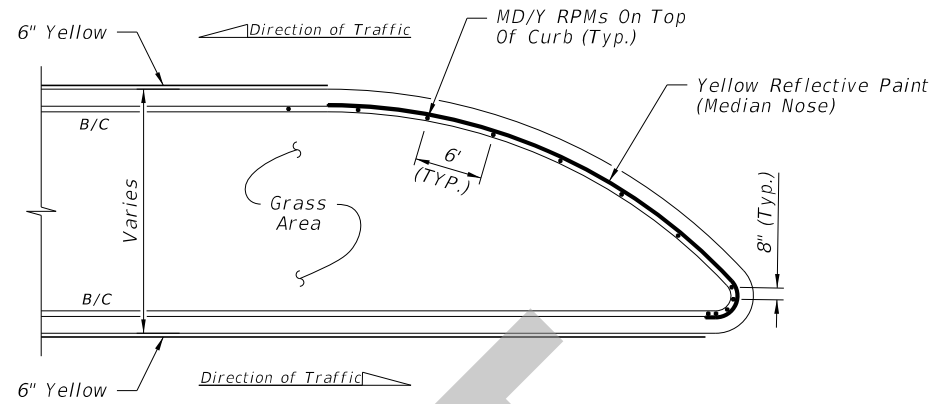


DETAIL "D"

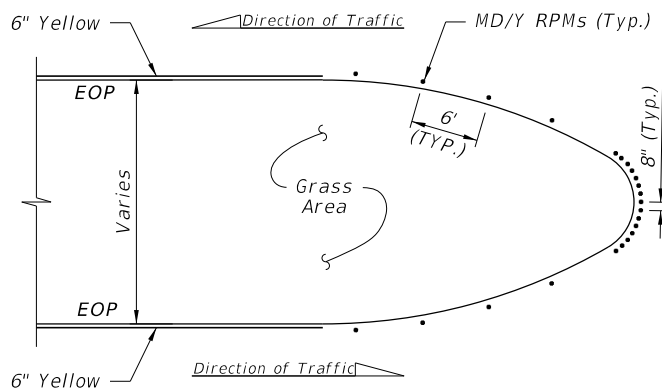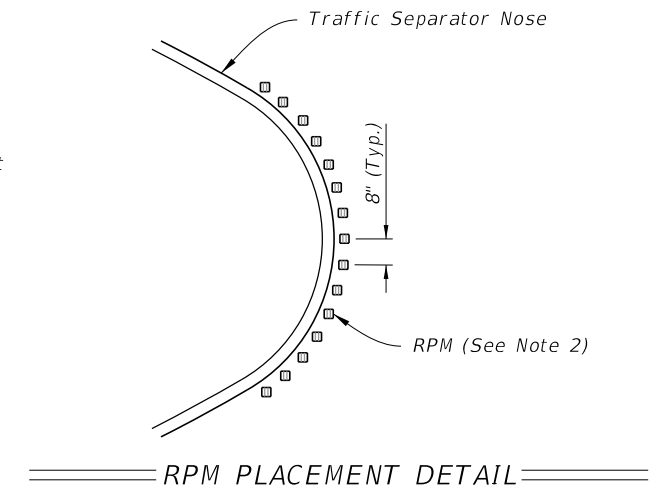


DETAIL "B"

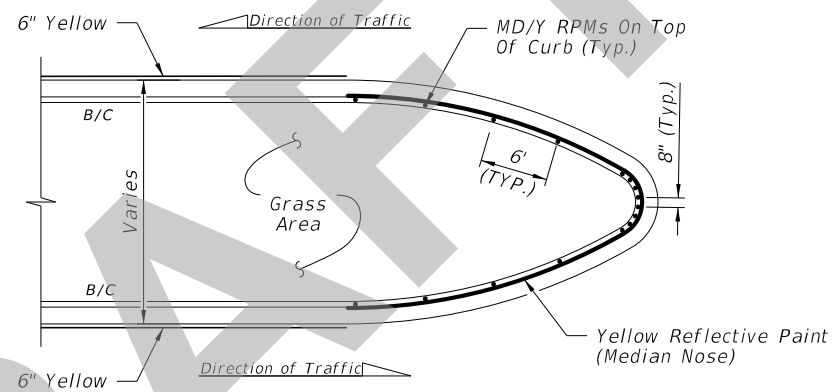

DETAIL "E"

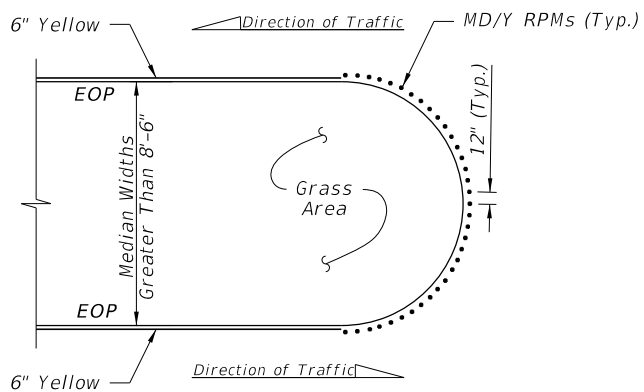

DETAIL "C"

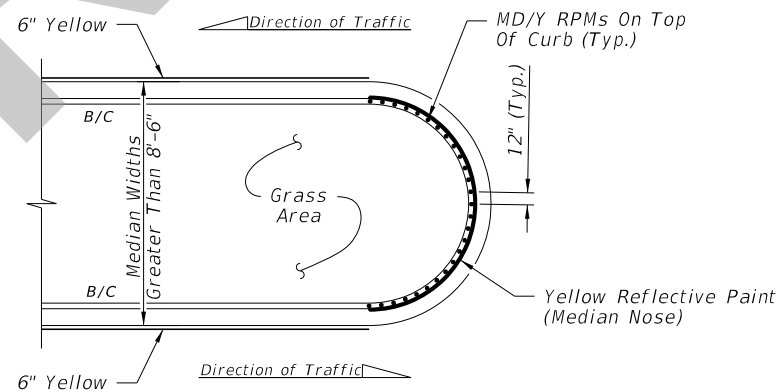

DETAIL "F"

FLUSH MEDIAN OPENINGS

TYPE "D" OR "F" CURB

RPM PLACEMENT AT MEDIAN OPENINGS
(When called for in the Plans)

POSTED SPEED LIMIT MPH	"Y" FEET
30 OR LESS	10
35	20
40	20
45	30
50 OR MORE	40

LEGEND:

- B/C = BACK OF CURB
- EOP = EDGE OF PAVEMENT
- RPM = RAISED PAVEMENT MARKER
- W/R = WHITE/RED RPM
- Y/Y = YELLOW/YELLOW RPM
- Y/R = YELLOW/RED RPM
- MD/Y = MONO-DIRECTIONAL YELLOW RPM

NOTES:

1. For Type "E" Curb, install RPMs along the pavement edge marking using the same spacing shown.
2. Orient traffic faces of RPMs in curb median radii to be parallel to direction of travel lanes.

8/5/2019 9:58:36 AM

LAST REVISION	DESCRIPTION:
11/01/19	



FY 2020-21
STANDARD PLANS

TYPICAL PLACEMENT OF
RAISED PAVEMENT MARKERS

INDEX
706-001

SHEET
3 of 6