

ORIGINATION FORM

Proposed Revisions to a Standard Plans Index
(Please provide all information – Incomplete forms will be returned)

Contact Information:

Date: November 13, 2018
Originator: **Cheryl Hudson**
Phone: 414-5332
Email: cheryl.hudson@dot.state.fl.us

Standard Plans:

Index Number: **715-010**
Sheet Number (s): 3 of 3
Index Title: High Mast Lighting

Summary of the changes:

Sheet 3: Double dimension Handhole Ring and Handhole Door to allow variation in opening size; Changed dimension from top of baseplate to bottom of handhole.

Commentary / Background:

Added Information to Note 4 on sheet 1, clarified intent of Note 2.

Other Affected Offices / Documents: (Provide name of responsible personnel)

- | Yes | No | |
|--------------------------|-------------------------------------|-----------------------------|
| <input type="checkbox"/> | <input checked="" type="checkbox"/> | Other Standard Plans – |
| <input type="checkbox"/> | <input checked="" type="checkbox"/> | FDOT Design Manual – |
| <input type="checkbox"/> | <input checked="" type="checkbox"/> | Basis of Estimates Manual – |
| <input type="checkbox"/> | <input checked="" type="checkbox"/> | Standard Specifications – |
| <input type="checkbox"/> | <input checked="" type="checkbox"/> | Approved Product List – |
| <input type="checkbox"/> | <input checked="" type="checkbox"/> | Construction – |
| <input type="checkbox"/> | <input checked="" type="checkbox"/> | Maintenance – |


Origination Package Includes: (Email or hand deliver package to Derwood Sheppard)

- | Yes | N/A | |
|-------------------------------------|-------------------------------------|---|
| <input checked="" type="checkbox"/> | <input type="checkbox"/> | Redline Mark-ups |
| <input type="checkbox"/> | <input checked="" type="checkbox"/> | Proposed Standard Plan Instructions (SPI) |
| <input checked="" type="checkbox"/> | <input type="checkbox"/> | Revised SPI |
| <input type="checkbox"/> | <input type="checkbox"/> | Other Support Documents |


Implementation:

- Design Bulletin (Interim) DCE Memo Program Mgmt. Bulletin FY-Standard Plans (Next Release)


————— **Contact the Roadway Design Office for assistance in completing this form** —————

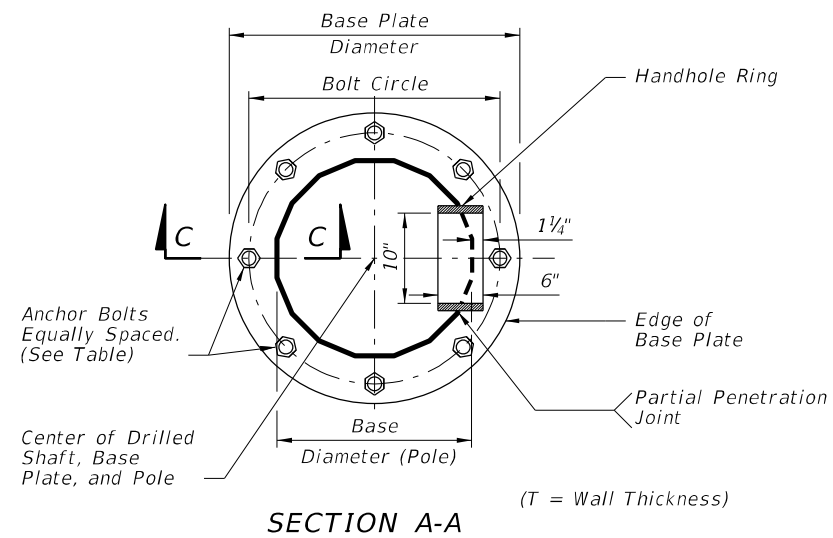

SECTION A-A

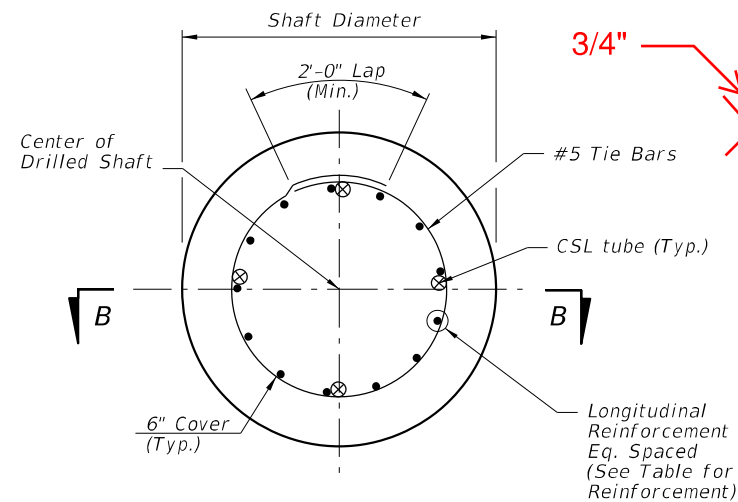


FOUNDATION PLAN
(Anchor Bolts and Conduits Not Shown)

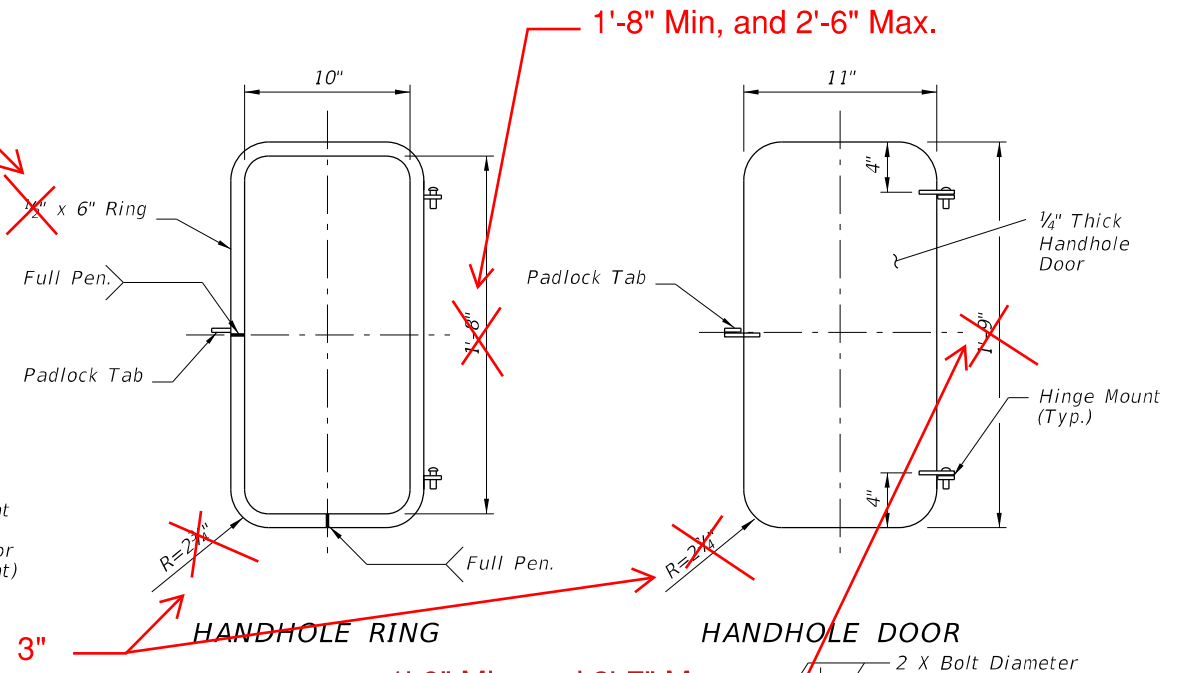


1'-8" Min, and 2'-6" Max.

3" HANDHOLE RING


HANDHOLE DOOR

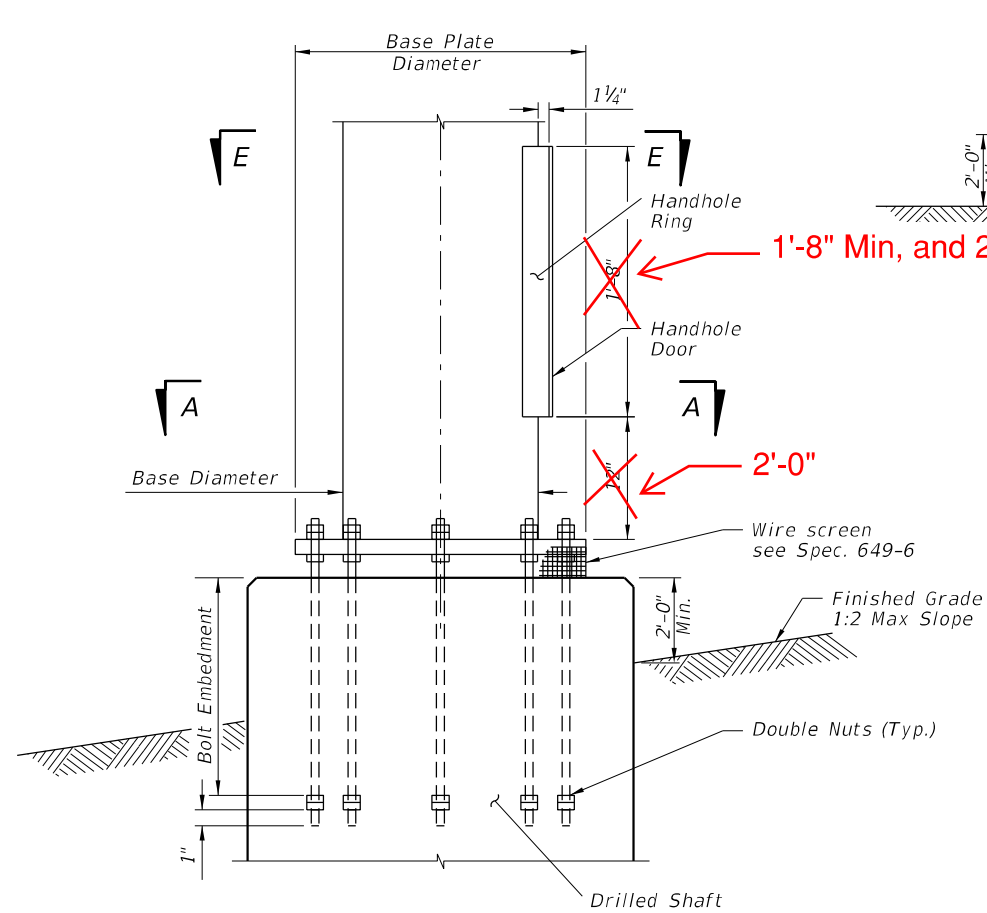


BASE PLATE AND ANCHORAGE ELEVATION
(Conduits Not Shown)

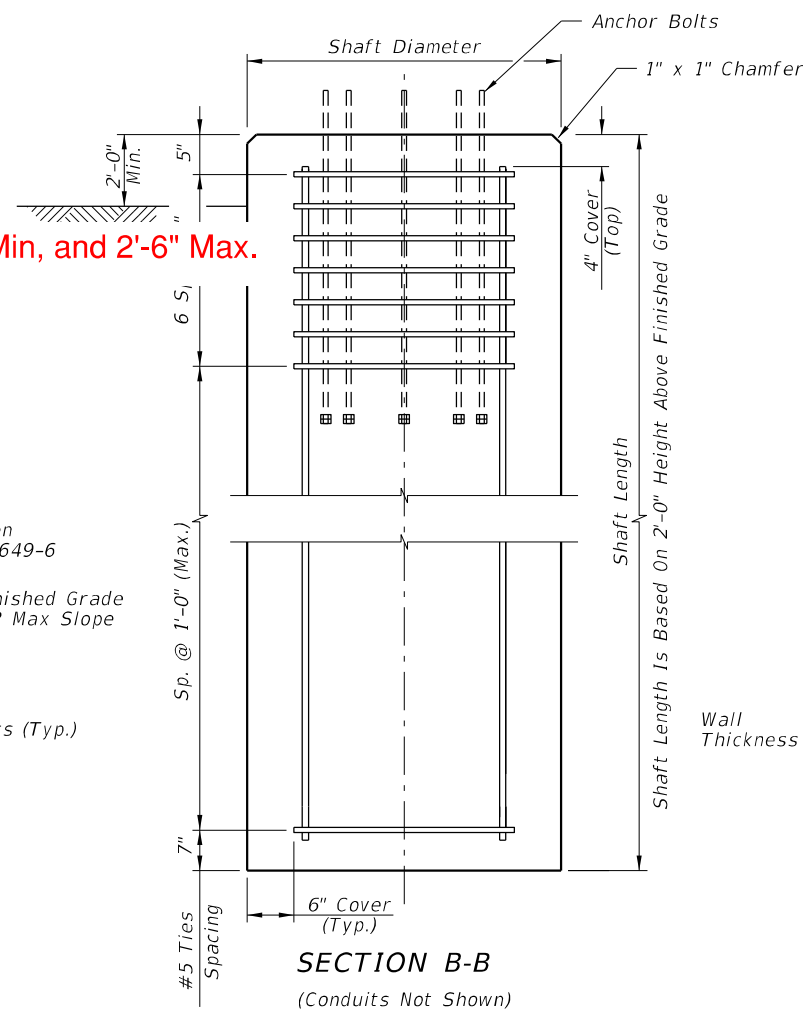

SECTION B-B
(Conduits Not Shown)

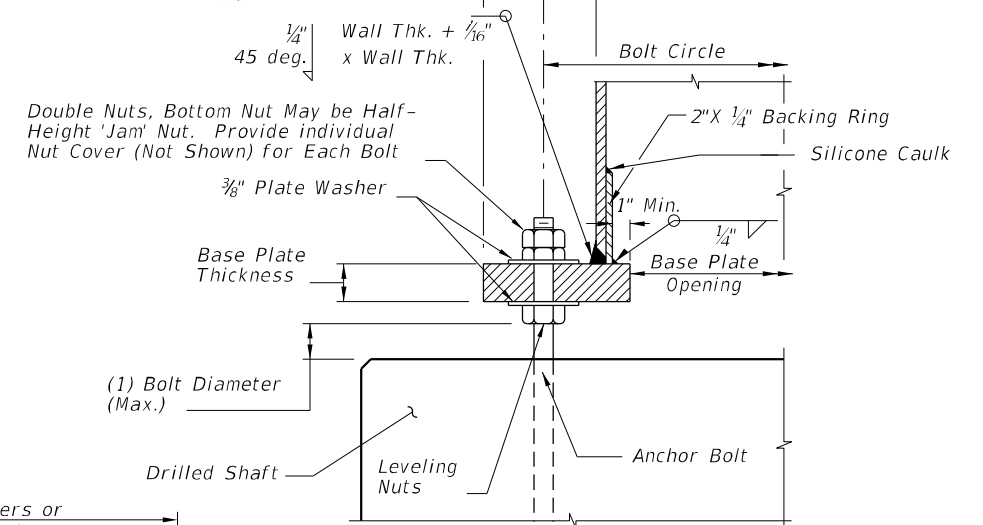

SECTION C-C

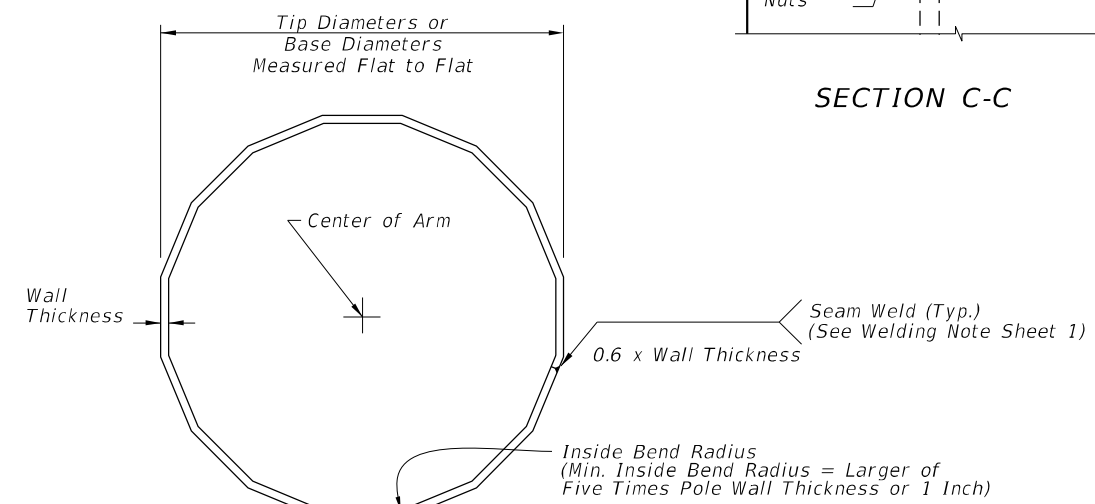

SECTION E-E

POLE FOUNDATION









10/18/2018 1:22:17 PM

LAST REVISION	DESCRIPTION:
11/01/18	
11/01/19	

FDOT
FY 2019-20
STANDARD PLANS

HIGH MAST LIGHTING

INDEX	SHEET
715-010	3 of 6

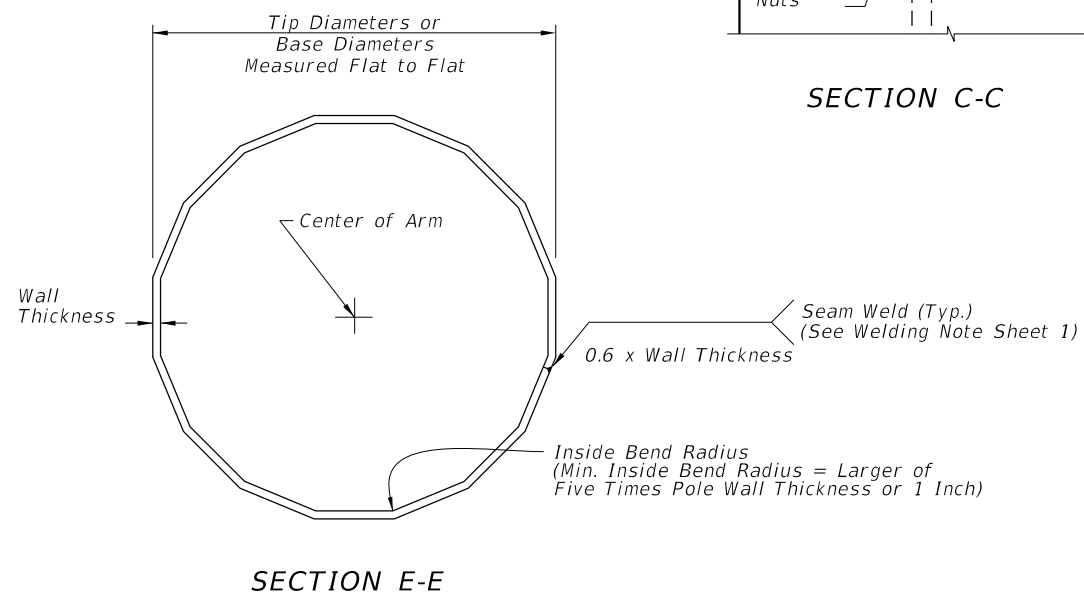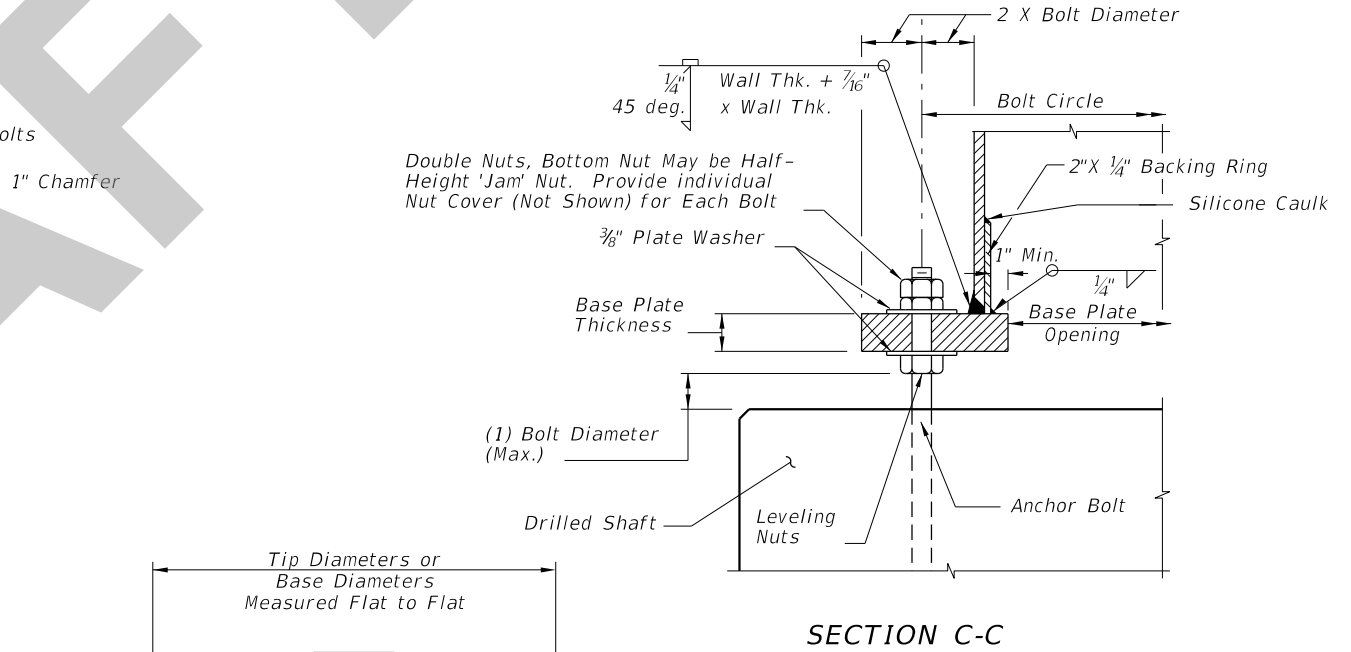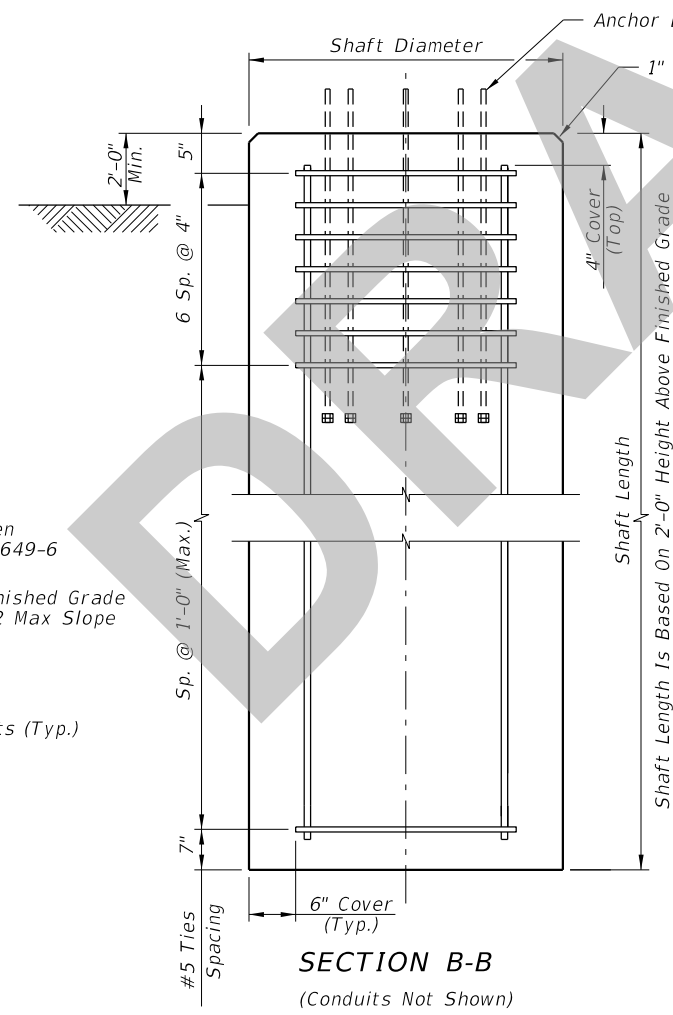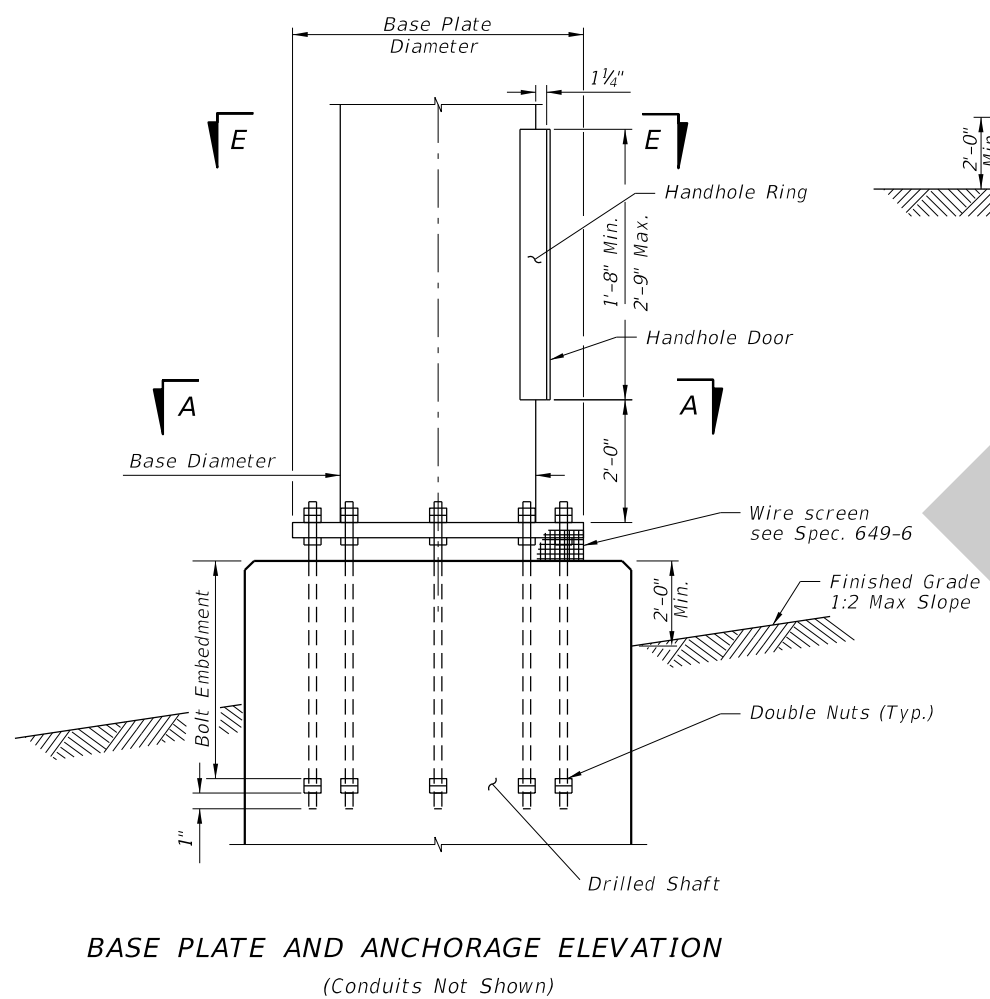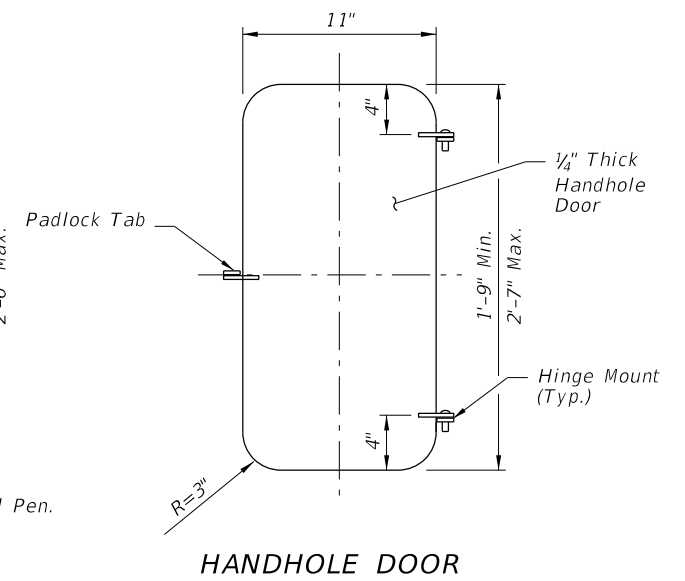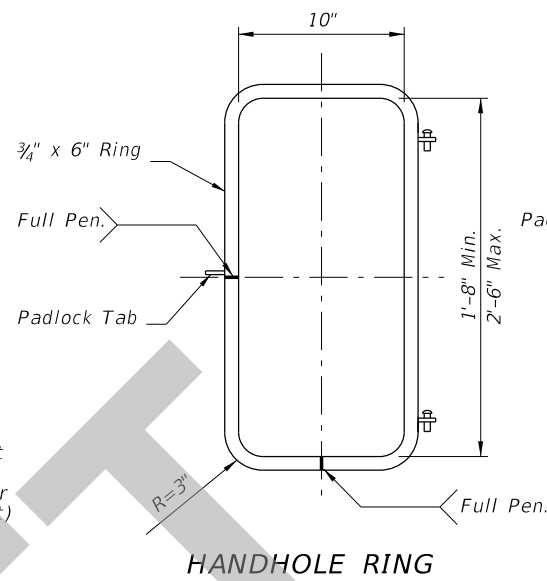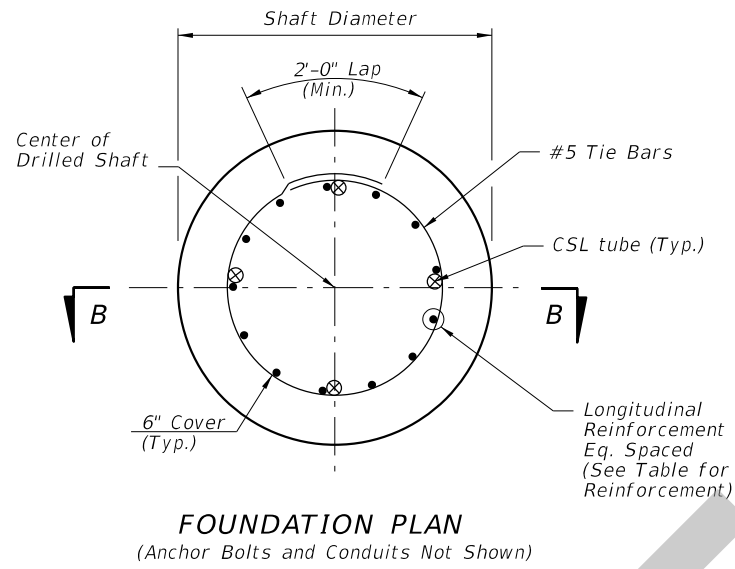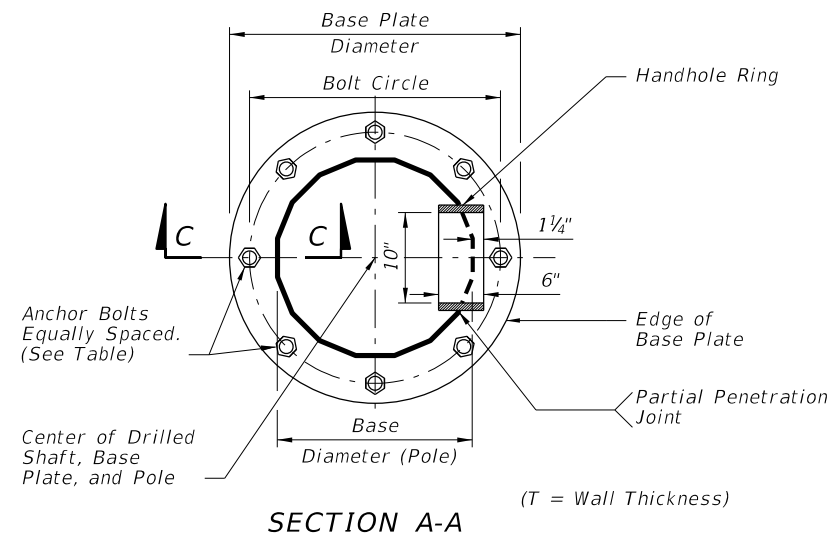

8/7/2019 2:40:54 PM

LAST REVISION 11/01/19	DESCRIPTION:
---------------------------	--------------

FY 2020-21 STANDARD PLANS

HIGH MAST LIGHTING

INDEX 715-010	SHEET 3 of 6
------------------	-----------------