
ORIGINATION FORM

Proposed Revisions to a Standard Plans Index
(Please provide all information — Incomplete forms will be returned)

Contact Information:

Date: May 26, 2020

Originator: Derwood Sheppard

Phone: (850) 414-4334

Email: derwood.sheppard@dot.state.fl.us

Standard Plans:

Index Number: 102-601

Sheet Number (s): 1

Index Title: Two-Lane, Two-Way, Work Outside Shoulder

Summary of the changes:

Sheet 1: Revised Detail and Notes (Consolidated with 102-611); Deleted 'Conditions'; Changed Index Title.

Commentary / Background:

Other Affected Offices / Documents: (Provide name of person contacted)

Yes	No	
☐	☐	Other Standard Plans –
☐	☐	FDOT Design Manual –
☐	☐	Basis of Estimates Manual –
☐	☐	Standard Specifications –
☐	☐	Approved Product List –
☐	☐	Construction –
☐	☐	Maintenance –

Origination Package Includes:

(Email or hand deliver package to Rick Jenkins)


Yes	N/A	
☒	☐	Redline Mark-ups
☐	☐	Proposed Standard Plan Instruction (SPI)
☐	☐	Revised SPI
☐	☐	Other Support Documents

Implementation:

☐	Design Bulletin (Interim)
☐	DCE Memo
☐	Program Mgmt. Bulletin
☒	FY-Standard Plans (Next Release)

Contact the Roadway Design Office for assistance in completing this form

2/26/2020 12:29:40 PM

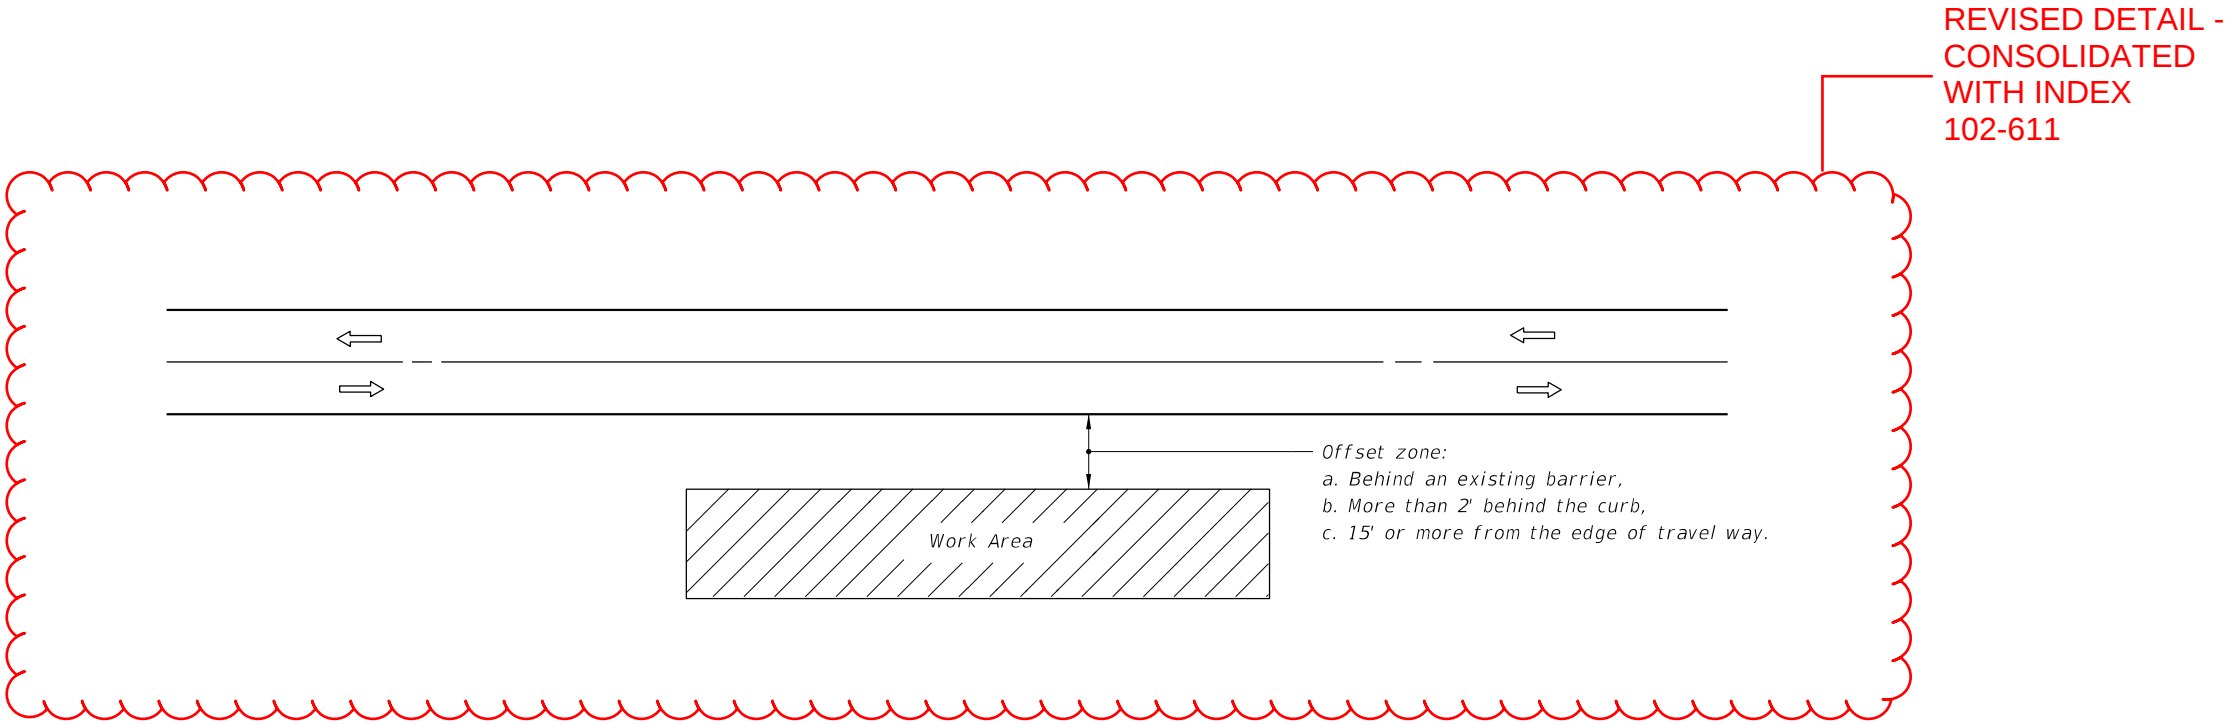

REVISED DETAIL -
CONSOLIDATED
WITH INDEX
102-611

GENERAL NOTES

1. If the work operation (excluding establishing and terminating the work area) requires that two or more work vehicles cross the offset zone in any one hour, traffic control will be in conformance with Index 102-602.
2. No special signing is required.
3. When a side road intersects the highway within the work area, additional TTC devices shall be placed in accordance with other applicable TCZ Indexes.
4. When construction activities encroach on a sidewalk refer to Index 102-660.
5. For general TCZ requirements and additional information, refer to Index 102-600.

REVISED NOTES
-
CONSOLIDATED
WITH INDEX
102-611

CONDITIONS

WHERE ANY VEHICLE, EQUIPMENT,
WORKERS AND THEIR ACTIVITIES
ARE BEHIND AN EXISTING BARRIER,
MORE THAN 2' BEHIND THE CURB,
OR 15' OR MORE FROM THE EDGE
OF TRAVEL WAY.

SYMBOLS

-  Work Area
-  Lane Identification + Direction of Traffic

CHANGED TO "TWO-LANE TWO-WAY AND
MULTILANE ROADWAY, WORK BEYOND
THE SHOULDER

11/01/20

2021-22



FY 2020-21
STANDARD PLANS

~~TWO LANE, TWO-WAY, WORK OUTSIDE SHOULDER~~

INDEX
102-601

SHEET
1 of 1


LAST
REVISION

11/01/17

DESCRIPTION:

REVISION

DELETED DETAIL -
CONSOLIDATED
WITH INDEX
102-601

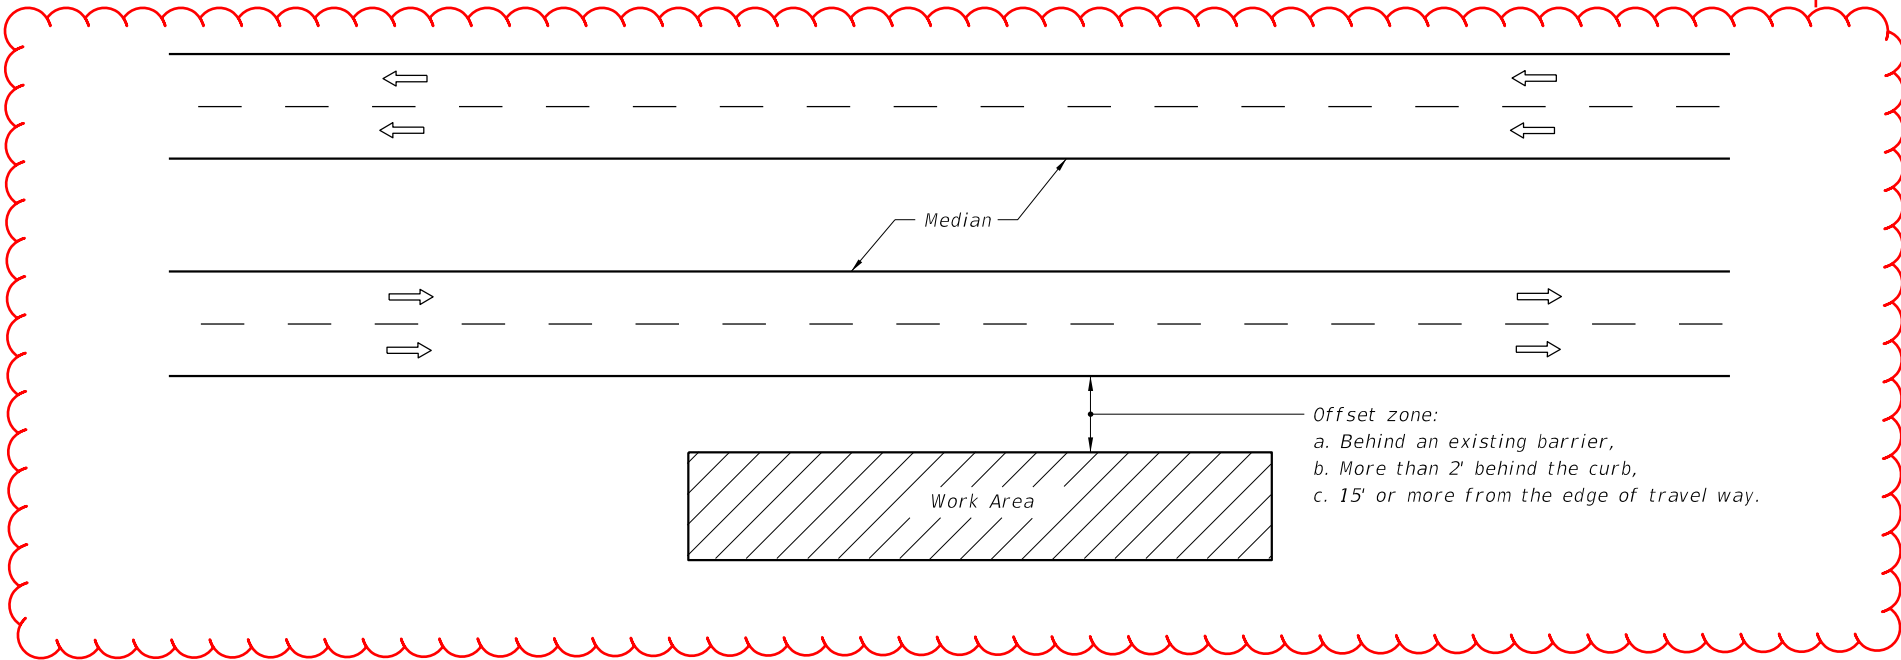

GENERAL NOTES

1. If the work operation (excluding establishing and terminating the work area), requires that two or more work vehicles cross the offset zone in any one hour, traffic control will be in accordance with Index 102-612.
2. No special signing is required.
3. This index also applies when work is being performed on a multilane undivided highway.
4. This index also applies to work performed in the median behind an existing barrier or more than 15' from the edge of travel way, both roadways. Work performed in the median behind curb and gutter shall be in accordance with Index 102-612.
5. When a side road intersects the highway within the work area, additional traffic control devices shall be placed in accordance with other applicable TCZ Indexes.
6. When construction activities encroach on a sidewalk, refer to Index 102-660.
7. For general TCZ requirements and additional information, refer to Index 102-600.

REVISED NOTES
AND MOVED TO
SHEET 1 -
CONSOLIDATED
WITH INDEX
102-601

SYMBOLS

-  Work Area
-  Lane Identification + Direction of Traffic

CONDITIONS

WHERE ANY VEHICLE, EQUIPMENT,
WORKERS AND THEIR ACTIVITIES
ARE BEHIND AN EXISTING BARRIER,
MORE THAN 2' BEHIND THE CURB,
OR 15' OR MORE FROM THE EDGE
OF TRAVEL WAY.

2/26/2020 12:33:15 PM

11/01/20


2021-22

LAST REVISION		DESCRIPTION:		INDEX		SHEET	
11/01/17	REVISION			102-611		1 of 1	



FY 2020-21
STANDARD PLANS

MULTILANE, WORK OUTSIDE SHOULDER

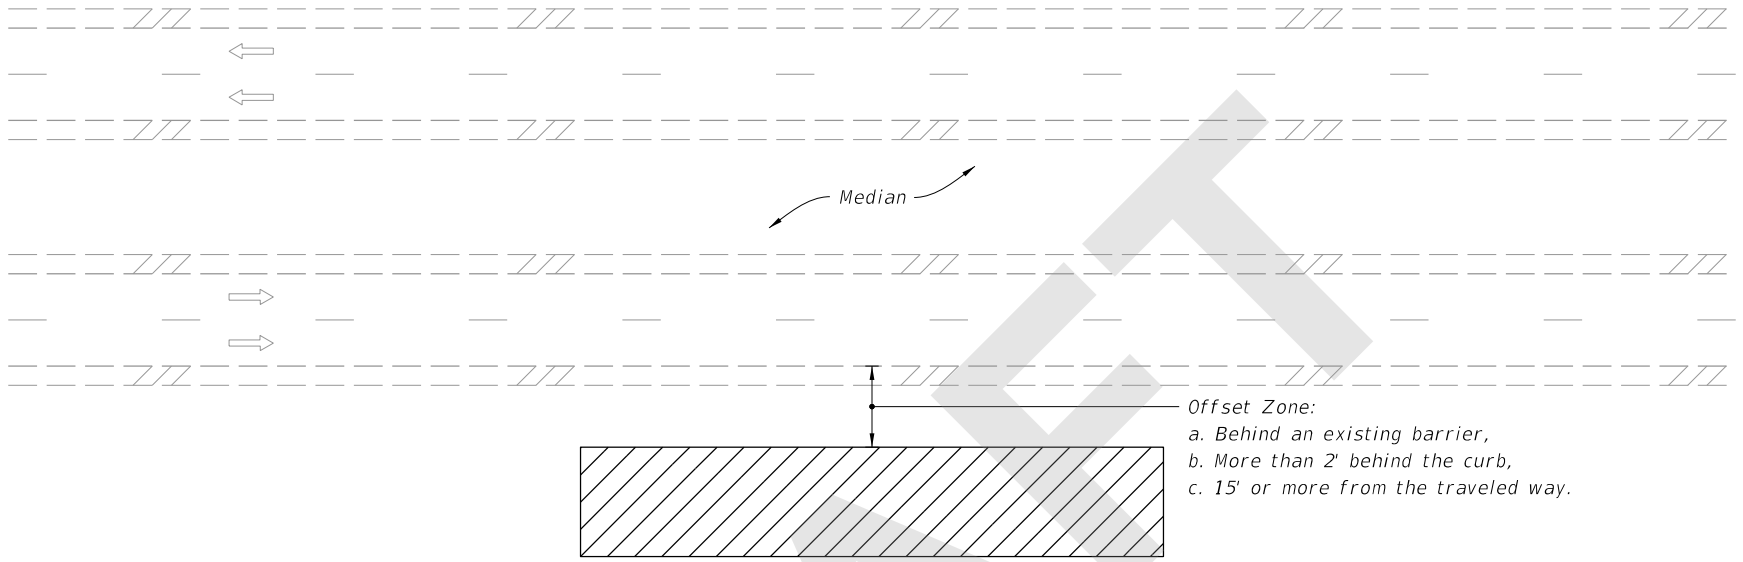

MULTILANE ROADWAY SHOWN, TWO-LANE ROADWAY SIMILAR

NOTES:

- 1. This Index applies to Two-Lane, Two-Way and Multilane Roadways, including Medians of divided roadways, with work beyond the shoulder.
- 2. Use Index 102-602 when the work operation (excluding establishing and terminating the work area) requires that two or more work vehicles cross the Offset Zone in any one hour period.
- 3. Use Index 102-660 when Work Area encroaches a Sidewalk.

SYMBOLS

- Work Area
- Lane Identification + Direction of Traffic

LAST REVISION 11/01/20	REVISION	DESCRIPTION:	FY 2021-22 STANDARD PLANS	TWO-LANE AND MULTILANE ROADWAY, WORK BEYOND THE SHOULDER	INDEX 102-601	SHEET 1 of 1
------------------------------	----------	--------------	------------------------------	---	------------------	-----------------