

---

## ORIGINATION FORM

---

Proposed Revisions to a Standard Plans Index  
(Please provide all information — Incomplete forms will be returned)

**Contact Information:**

Date: May 26, 2020  
Originator: Derwood Sheppard  
Phone: (850) 414-4334  
Email: derwood.sheppard@dot.state.fl.us

**Standard Plans:**

Index Number: 102-601  
Sheet Number (s): 1  
Index Title: Two-Lane, Two-Way, Work Outside Shoulder

**Summary of the changes:**

Sheet 1: Revised Detail and Notes (Consolidated with 102-611); Deleted 'Conditions'; Changed Index Title.

**Commentary / Background:**

**Other Affected Offices / Documents:** (Provide name of person contacted)

- | Yes                      | No                       |                             |
|--------------------------|--------------------------|-----------------------------|
| <input type="checkbox"/> | <input type="checkbox"/> | Other Standard Plans –      |
| <input type="checkbox"/> | <input type="checkbox"/> | FDOT Design Manual –        |
| <input type="checkbox"/> | <input type="checkbox"/> | Basis of Estimates Manual – |
| <input type="checkbox"/> | <input type="checkbox"/> | Standard Specifications –   |
| <input type="checkbox"/> | <input type="checkbox"/> | Approved Product List –     |
| <input type="checkbox"/> | <input type="checkbox"/> | Construction –              |
| <input type="checkbox"/> | <input type="checkbox"/> | Maintenance –               |

**Origination Package Includes:**

(Email or hand deliver package to Rick Jenkins)

- | Yes                                 | N/A                      |  |
|-------------------------------------|--------------------------|--|
| <input checked="" type="checkbox"/> | <input type="checkbox"/> | Redline Mark-ups                         |
| <input type="checkbox"/>            | <input type="checkbox"/> | Proposed Standard Plan Instruction (SPI) |
| <input type="checkbox"/>            | <input type="checkbox"/> | Revised SPI                              |
| <input type="checkbox"/>            | <input type="checkbox"/> | Other Support Documents                  |

**Implementation:**


- |                                     |                                  |
|-------------------------------------|----------------------------------|
| <input type="checkbox"/>            | Design Bulletin (Interim)        |
| <input type="checkbox"/>            | DCE Memo                         |
| <input type="checkbox"/>            | Program Mgmt. Bulletin           |
| <input checked="" type="checkbox"/> | FY-Standard Plans (Next Release) |

---

Contact the Roadway Design Office for assistance in completing this form

---

REVISED DETAIL -  
CONSOLIDATED  
WITH INDEX  
102-611

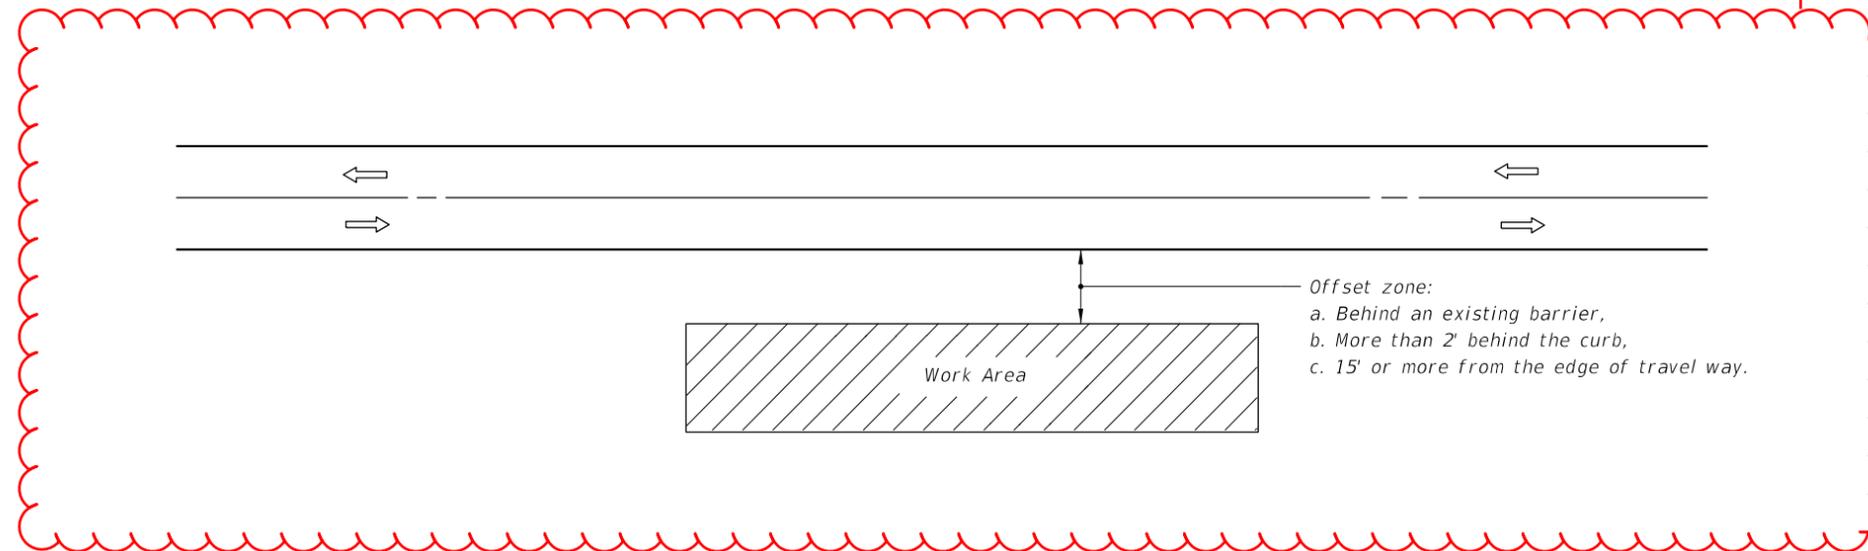

**GENERAL NOTES**

1. If the work operation (excluding establishing and terminating the work area) requires that two or more work vehicles cross the offset zone in any one hour, traffic control will be in conformance with Index 102-602.
2. No special signing is required.
3. When a side road intersects the highway within the work area, additional TTC devices shall be placed in accordance with other applicable TCZ Indexes.
4. When construction activities encroach on a sidewalk refer to Index 102-660.
5. For general TCZ requirements and additional information, refer to Index 102-600.

REVISED NOTES  
-  
CONSOLIDATED  
WITH INDEX  
102-611

**CONDITIONS**

WHERE ANY VEHICLE, EQUIPMENT,  
WORKERS AND THEIR ACTIVITIES  
ARE BEHIND AN EXISTING BARRIER,  
MORE THAN 2' BEHIND THE CURB,  
OR 15' OR MORE FROM THE EDGE  
OF TRAVEL WAY.

**SYMBOLS**

-  Work Area
-  Lane Identification + Direction of Traffic

11/01/20


2021-22

CHANGED TO "TWO-LANE TWO-WAY AND  
MULTILANE ROADWAY, WORK BEYOND  
THE SHOULDER

2/26/2020 12:29:40 PM

|                                      |              |   |   |                  |                 |
|--------------------------------------|--------------|---|---|------------------|-----------------|
| LAST REVISION<br><del>11/01/17</del> | DESCRIPTION: | <br>FY <del>2020-21</del><br>STANDARD PLANS | <del>TWO-LANE, TWO-WAY, WORK OUTSIDE SHOULDER</del> | INDEX<br>102-601 | SHEET<br>1 of 1 |
|--------------------------------------|--------------|---|---|------------------|-----------------|

DELETED DETAIL -  
CONSOLIDATED  
WITH INDEX  
102-601

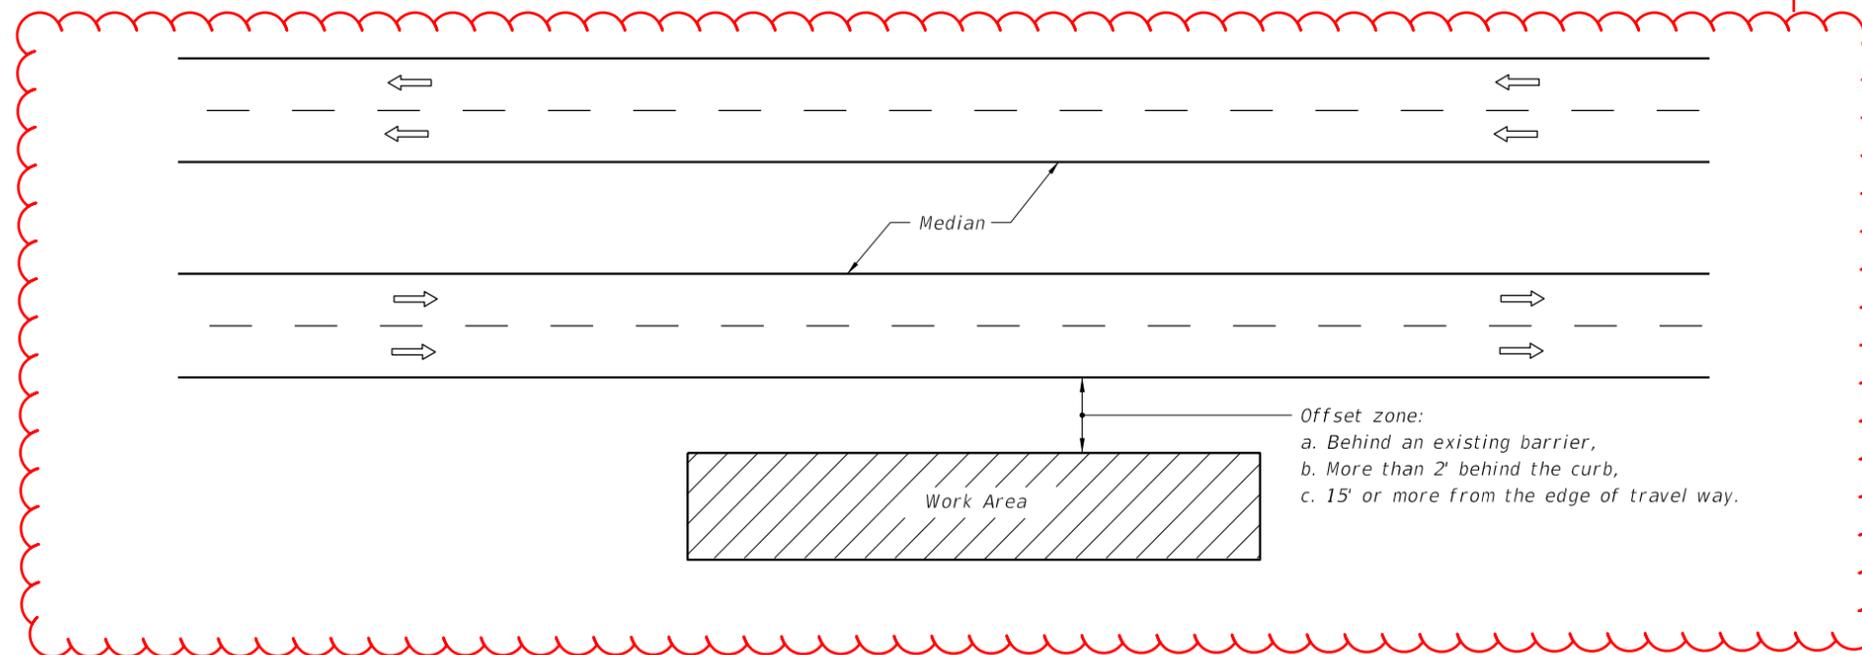

GENERAL NOTES

1. If the work operation (excluding establishing and terminating the work area), requires that two or more work vehicles cross the offset zone in any one hour, traffic control will be in accordance with Index 102-612.
2. No special signing is required.
3. This index also applies when work is being performed on a multilane undivided highway.
4. This index also applies to work performed in the median behind an existing barrier or more than 15' from the edge of travel way, both roadways. Work performed in the median behind curb and gutter shall be in accordance with Index 102-612.
5. When a side road intersects the highway within the work area, additional traffic control devices shall be placed in accordance with other applicable TCZ Indexes.
6. When construction activities encroach on a sidewalk, refer to Index 102-660.
7. For general TCZ requirements and additional information, refer to Index 102-600.

REVISED NOTES  
AND MOVED TO  
SHEET 1 -  
CONSOLIDATED  
WITH INDEX  
102-601

~~CONDITIONS~~

~~WHERE ANY VEHICLE, EQUIPMENT,  
WORKERS AND THEIR ACTIVITIES  
ARE BEHIND AN EXISTING BARRIER,  
MORE THAN 2' BEHIND THE CURB,  
OR 15' OR MORE FROM THE EDGE  
OF TRAVEL WAY.~~

SYMBOLS


- Work Area
- Lane Identification + Direction of Traffic

11/01/20

2021-22

2/26/2020 12:33:15 PM

|                                      |              |   |   |                              |                 |
|--------------------------------------|--------------|---|---|------------------------------|-----------------|
| LAST REVISION<br><del>11/01/17</del> | DESCRIPTION: | <br>FY <del>2020-21</del> 2021-22<br>STANDARD PLANS | <del>MULTILANE, WORK OUTSIDE SHOULDER</del> | INDEX<br>102- <del>611</del> | SHEET<br>1 of 1 |
|--------------------------------------|--------------|---|---|------------------------------|-----------------|

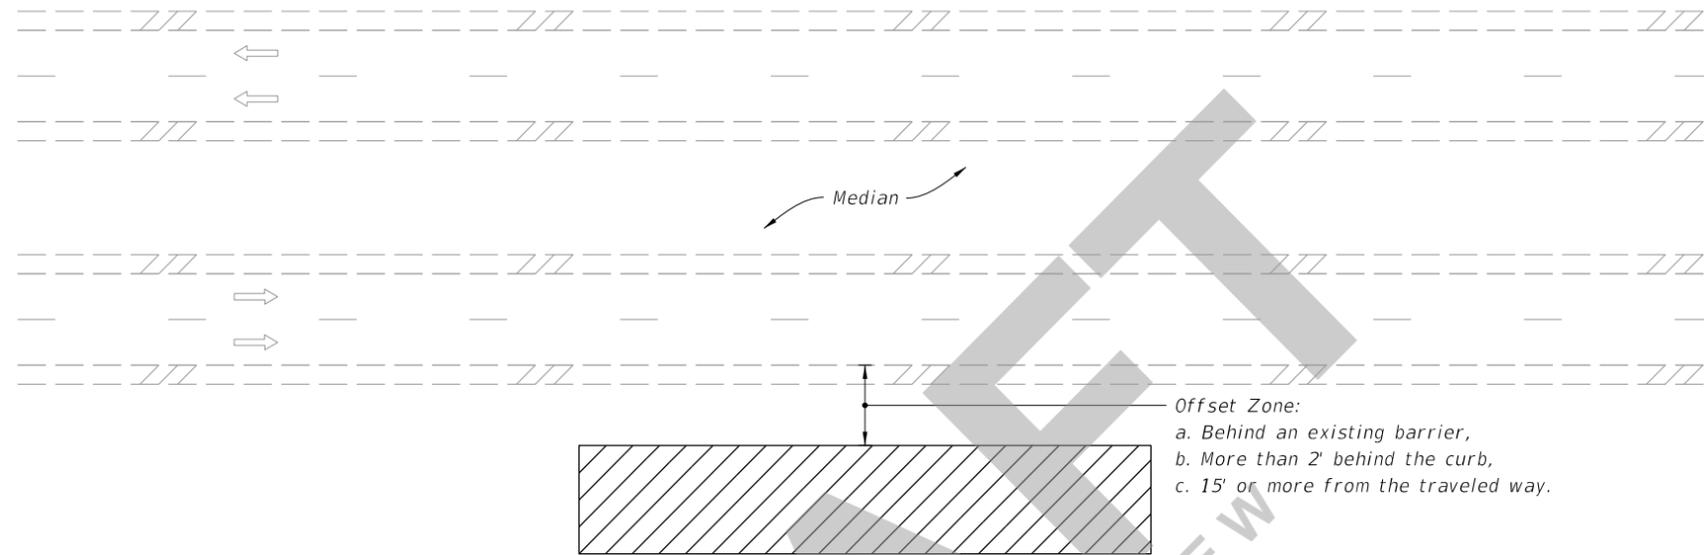

=====**MULTILANE ROADWAY SHOWN, TWO-LANE ROADWAY SIMILAR**=====

**NOTES:**

1. This Index applies to Two-Lane, Two-Way and Multilane Roadways, including Medians of divided roadways, with work beyond the shoulder.
2. Use Index 102-602 when the work operation (excluding establishing and terminating the work area) requires that two or more work vehicles cross the Offset Zone in any one hour period.
3. Use Index 102-660 when Work Area encroaches a Sidewalk.

**SYMBOLS**

- Work Area
- Lane Identification + Direction of Traffic

7/21/2020 9:45:42 AM

|                           |          |              |                                  |   |                  |                 |
|---------------------------|----------|--------------|----------------------------------|---|------------------|-----------------|
| LAST REVISION<br>11/01/20 | REVISION | DESCRIPTION: | <br>FY 2021-22<br>STANDARD PLANS | TWO-LANE AND MULTILANE ROADWAY,<br>WORK BEYOND THE SHOULDER | INDEX<br>102-601 | SHEET<br>1 of 1 |
|---------------------------|----------|--------------|----------------------------------|---|------------------|-----------------|