
ORIGINATION FORM

Proposed Revisions to a Standard Plans Index (Please provide all information — Incomplete forms will be returned)

Contact Information:

Date: May 5, 2020

Originator: Cheryl Hudson

Phone: 414-5332

Email: cheryl.hudson@dot.state.fl.us

Standard Plans:

Index Number: 450-511

Sheet Number (s): Sheet 2

Index Title: Bearing Plates (Type 1) -Prestressed Florida-I and
AASHTO Type II Beams**Summary of the changes:**

Delete dimension H (replace with number).

Commentary / Background:

H as shown is a hard dimension that does not change; therefore change it to 1 1/2".

**Other Affected Offices / Documents:** (Provide name of person contacted)

- | Yes | No | |
|--------------------------|-------------------------------------|--|
| <input type="checkbox"/> | <input checked="" type="checkbox"/> | Other Standard Plans – |
| <input type="checkbox"/> | <input checked="" type="checkbox"/> | FDOT Design Manual – |
| <input type="checkbox"/> | <input checked="" type="checkbox"/> | Basis of Estimates Manual – Change from DEV |
| <input type="checkbox"/> | <input checked="" type="checkbox"/> | Standard Specifications – Specification 450 update |
| <input type="checkbox"/> | <input checked="" type="checkbox"/> | Approved Product List – |
| <input type="checkbox"/> | <input checked="" type="checkbox"/> | Construction – |
| <input type="checkbox"/> | <input checked="" type="checkbox"/> | Maintenance – |

Origination Package Includes:



(Email or hand deliver package to Rick Jenkins)

- | Yes | N/A | |
|--------------------------|-------------------------------------|--|
| <input type="checkbox"/> | <input checked="" type="checkbox"/> | Redline Mark-ups |
| <input type="checkbox"/> | <input checked="" type="checkbox"/> | Proposed Standard Plan Instruction (SPI) |
| <input type="checkbox"/> | <input checked="" type="checkbox"/> | Revised SPI |
| <input type="checkbox"/> | <input checked="" type="checkbox"/> | Other Support Documents |



Implementation:

- | | |
|-------------------------------------|----------------------------------|
| <input type="checkbox"/> | Design Bulletin (Interim) |
| <input type="checkbox"/> | DCE Memo |
| <input type="checkbox"/> | Program Mgmt. Bulletin |
| <input checked="" type="checkbox"/> | FY-Standard Plans (Next Release) |

Contact the Roadway Design Office for assistance in completing this form

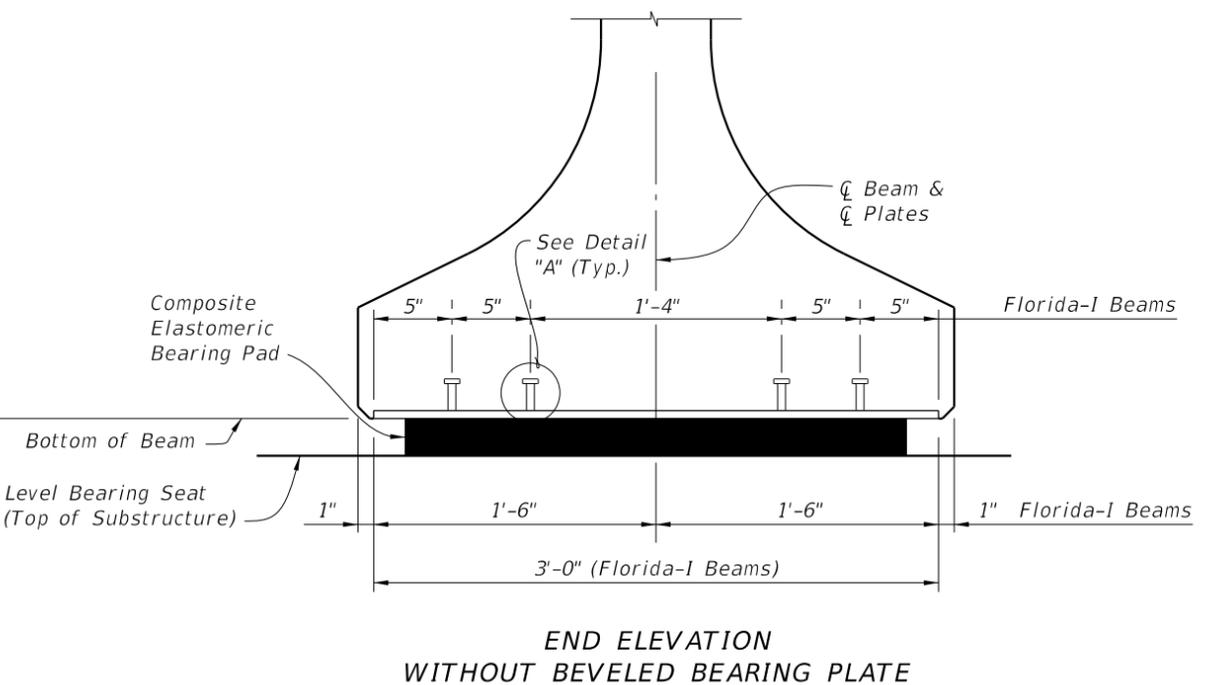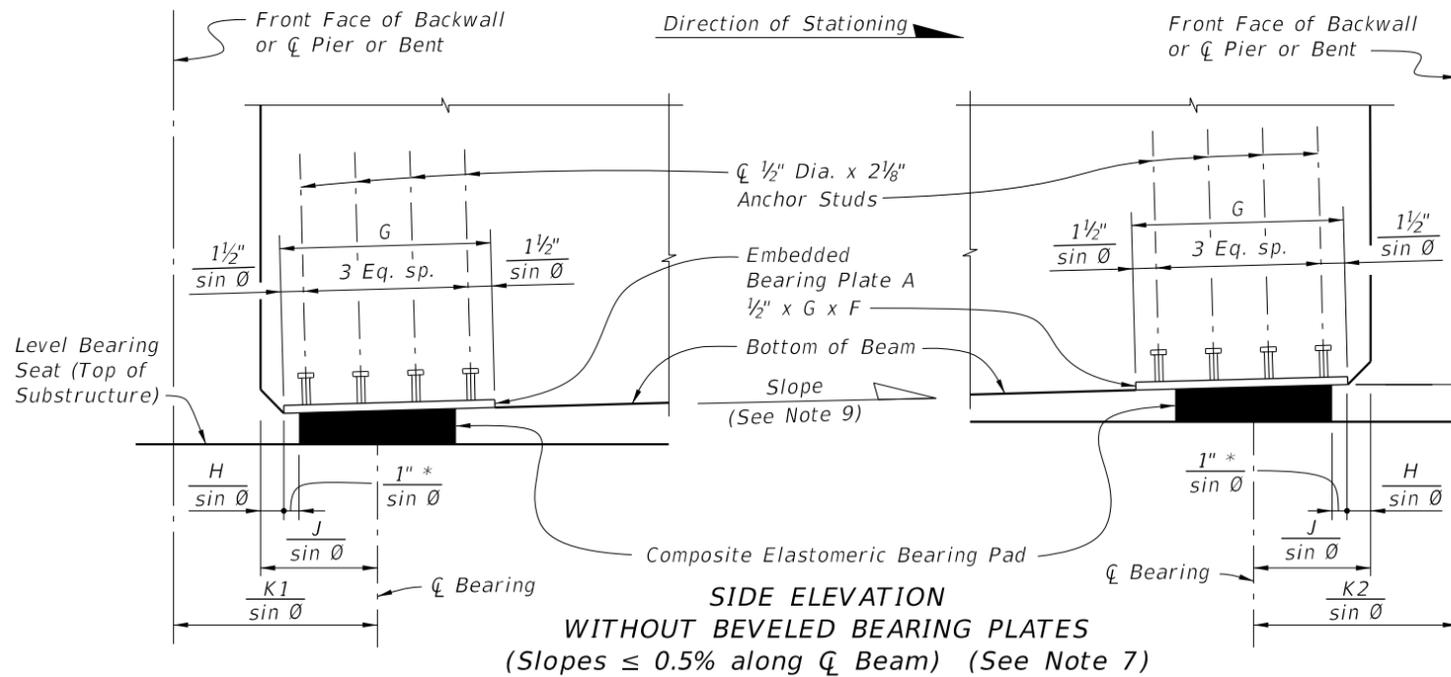


* 1/2\" Pad Type K

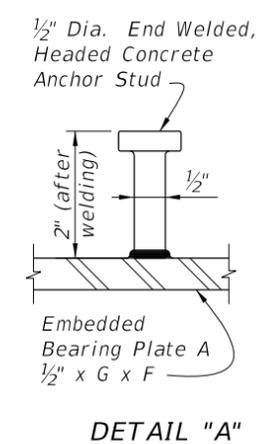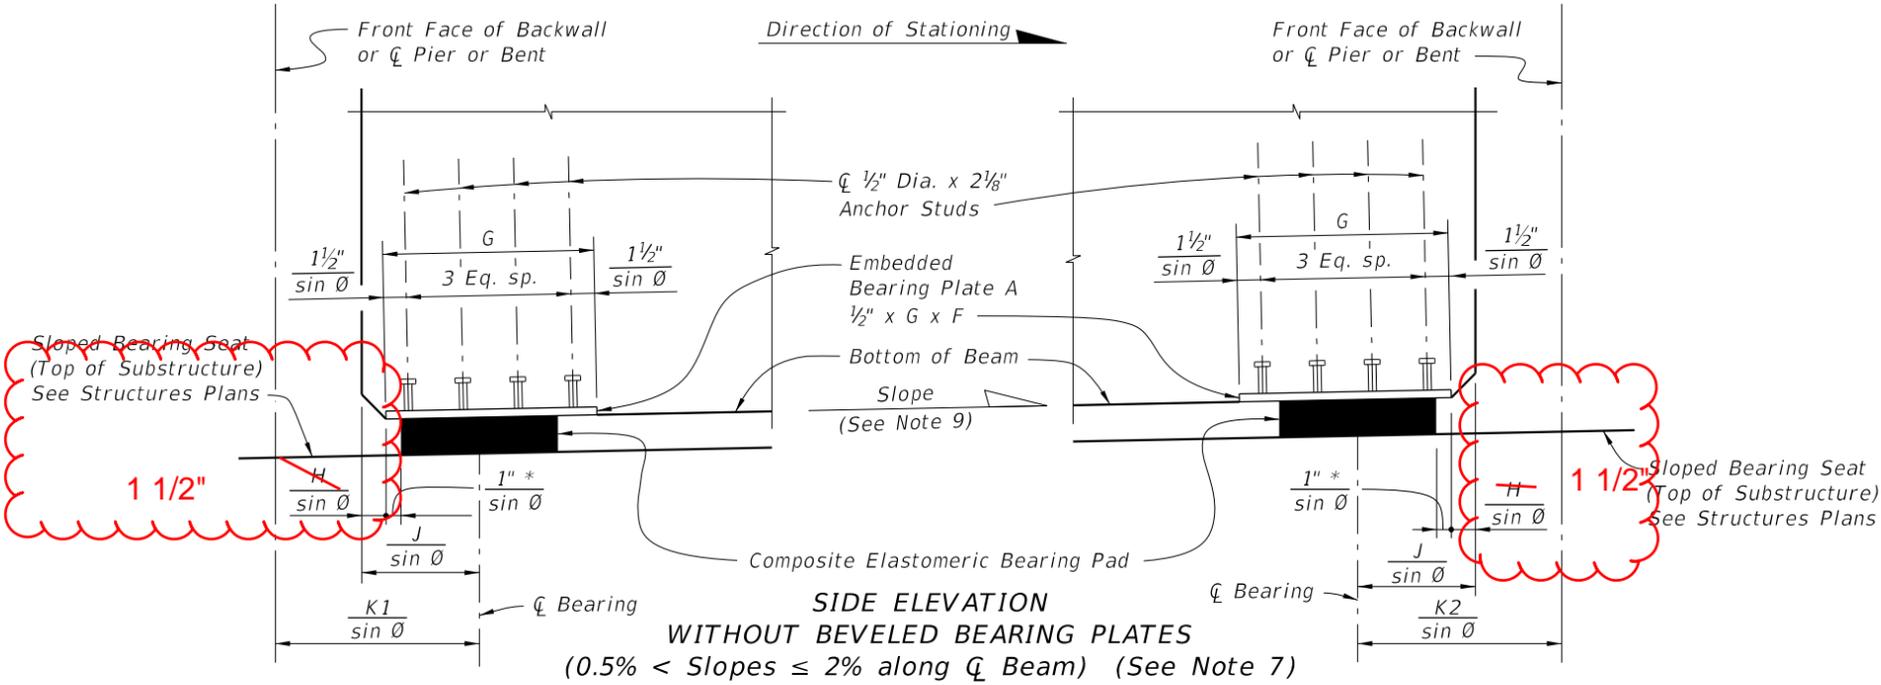


CROSS REFERENCE:
See Sheet 1 for ~~dimension H~~ and Notes.

10/14/2019 3:57:15 PM

LAST REVISION 07/01/14	REVISION	DESCRIPTION:	 FY 2020-21 STANDARD PLANS	BEARING PLATES (TYPE 1) - PRESTRESSED FLORIDA-I AND AASHTO TYPE II BEAMS	INDEX 450-511	SHEET 2 of 2
---------------------------	----------	--------------	--	---	------------------	-----------------

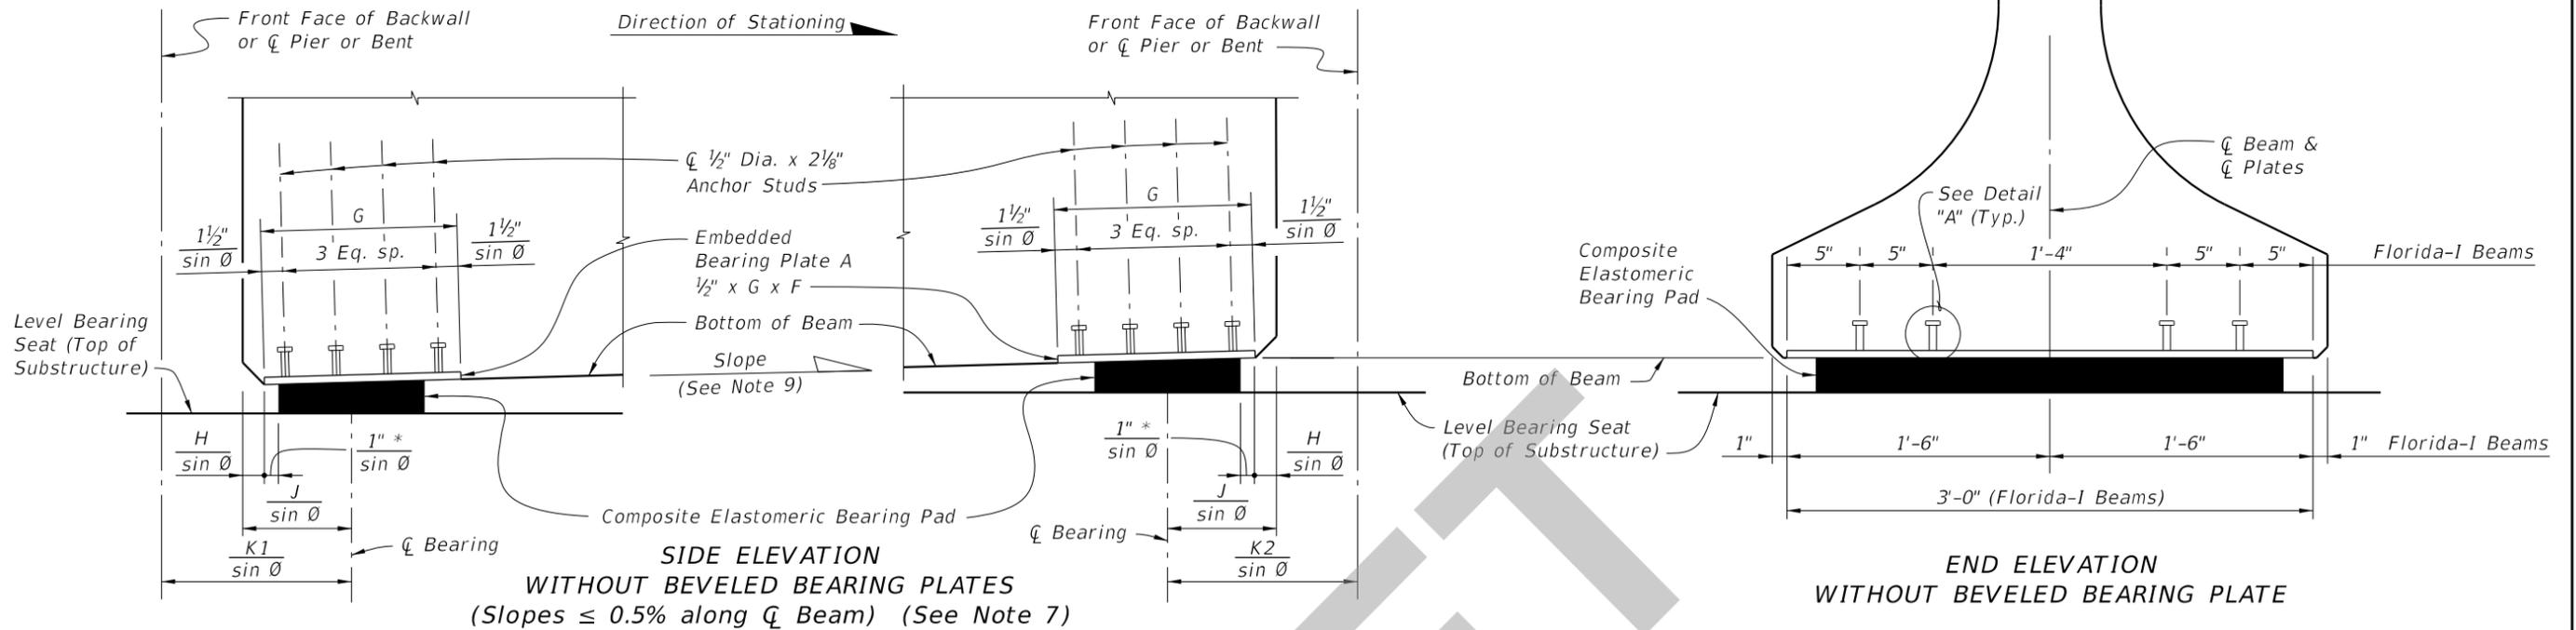

* $\frac{1}{2}$ " Pad Type K

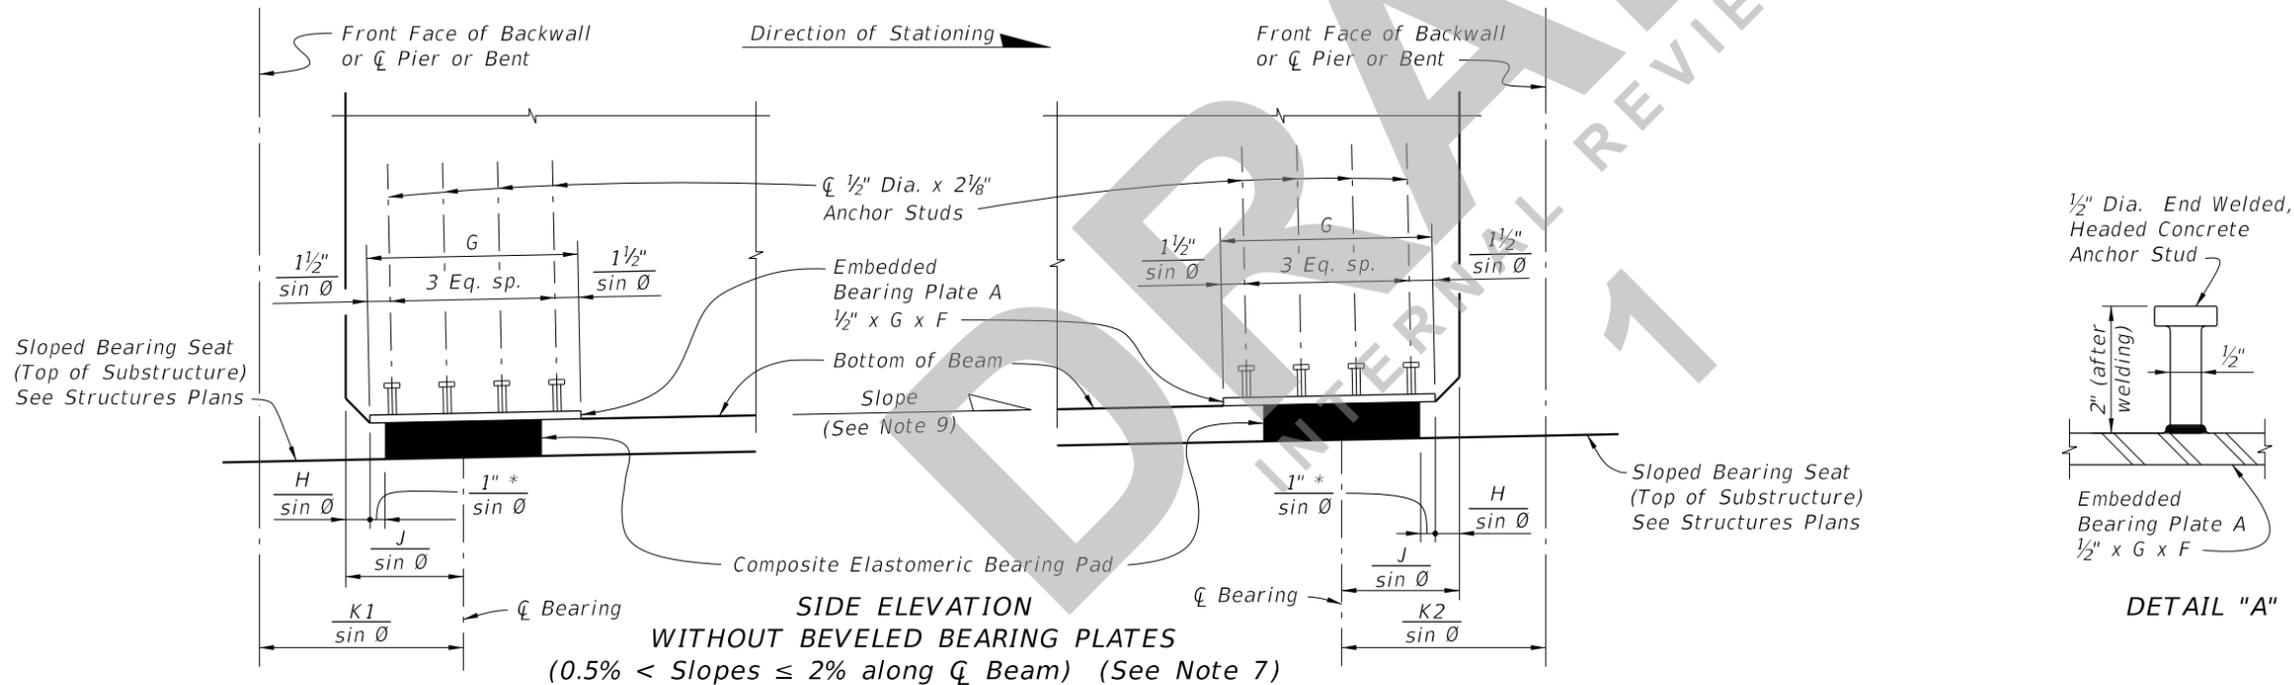

CROSS REFERENCE:
See Sheet 1 for dimension H and Notes.

7/27/2020 3:06:58 PM

LAST REVISION 07/01/14	REVISION	DESCRIPTION:	 FY 2020-21 STANDARD PLANS	BEARING PLATES (TYPE 1) - PRESTRESSED FLORIDA-I AND AASHTO TYPE II BEAMS	INDEX 450-511	SHEET 2 of 2
---------------------------	----------	--------------	---	---	------------------	-----------------