

---

## ORIGINATION FORM

---

### Proposed Revisions to a Standard Plans Index (Please provide all information — Incomplete forms will be returned)

**Contact Information:**

Date: February 12, 2020

Originator: Cheryl Hudson

Phone: 414-5332

Email: cheryl.hudson@dot.state.fl.us

**Standard Plans:**

Index Number: 455-154

Sheet Number (s): 1

Index Title: 60" Prestressed CFRP & SS Concrete Cylinder  
Pile**Summary of the changes:**

Change Silica Fume, metakaolin or ultra-fine flyash to Highly Reactive Pozzolans

**Commentary / Background:**

Specification changed to fit silica fume, metakaolin and ultra-fine flyash under Highly Reactive Pozzolans

**Other Affected Offices / Documents:** (Provide name of person contacted)

- | Yes                      | No                                  |                             |
|--------------------------|-------------------------------------|-----------------------------|
| <input type="checkbox"/> | <input checked="" type="checkbox"/> | Other Standard Plans –      |
| <input type="checkbox"/> | <input checked="" type="checkbox"/> | FDOT Design Manual –        |
| <input type="checkbox"/> | <input checked="" type="checkbox"/> | Basis of Estimates Manual – |
| <input type="checkbox"/> | <input checked="" type="checkbox"/> | Standard Specifications –   |
| <input type="checkbox"/> | <input checked="" type="checkbox"/> | Approved Product List –     |
| <input type="checkbox"/> | <input checked="" type="checkbox"/> | Construction –              |
| <input type="checkbox"/> | <input checked="" type="checkbox"/> | Maintenance –               |

**Origination Package Includes:**

(Email or hand deliver package to Rick Jenkins)

- | Yes                                 | N/A                                 |  |
|-------------------------------------|-------------------------------------|--|
| <input checked="" type="checkbox"/> | <input type="checkbox"/>            | Redline Mark-ups                         |
| <input type="checkbox"/>            | <input checked="" type="checkbox"/> | Proposed Standard Plan Instruction (SPI) |
| <input type="checkbox"/>            | <input checked="" type="checkbox"/> | Revised SPI                              |
| <input type="checkbox"/>            | <input checked="" type="checkbox"/> | Other Support Documents                  |


**Implementation:**

- |                                     |                                  |
|-------------------------------------|----------------------------------|
| <input type="checkbox"/>            | Design Bulletin (Interim)        |
| <input type="checkbox"/>            | DCE Memo                         |
| <input type="checkbox"/>            | Program Mgmt. Bulletin           |
| <input checked="" type="checkbox"/> | FY-Standard Plans (Next Release) |


---

Contact the Roadway Design Office for assistance in completing this form

---

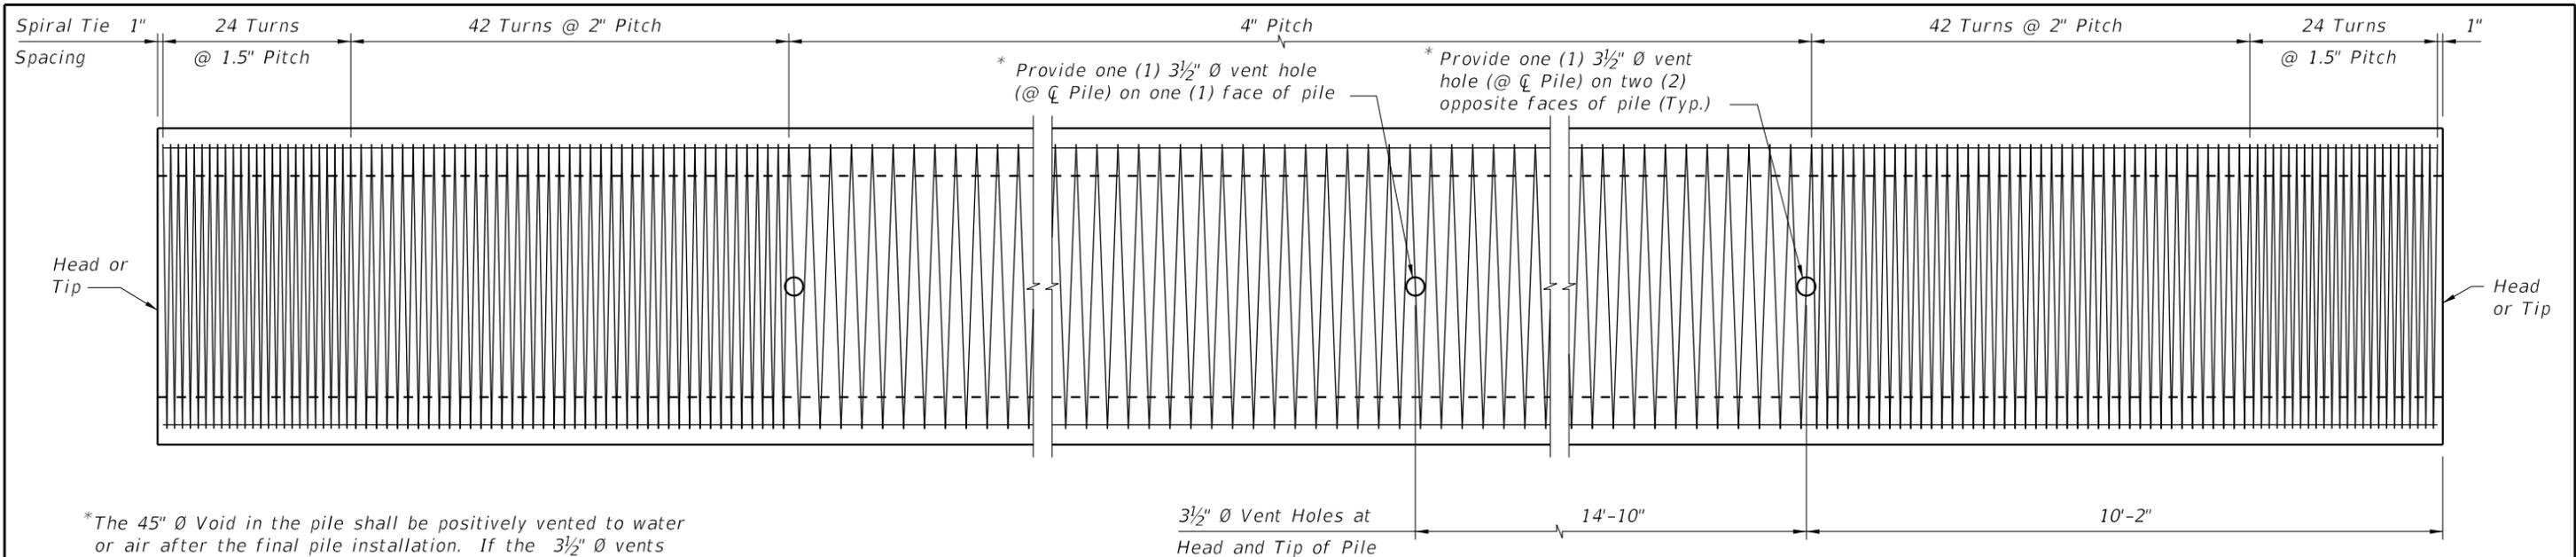

ELEVATION

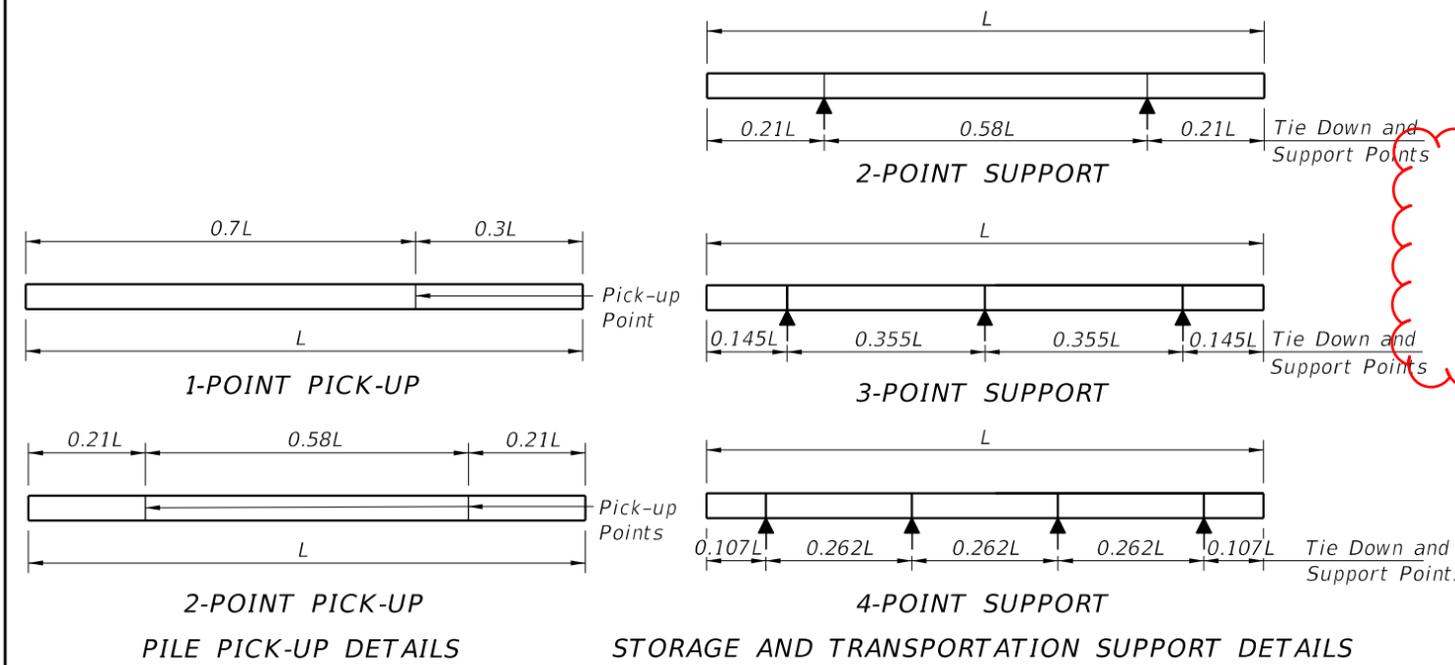

NOTES

- Work this Index with the Pile Data Table in the Structures Plans.
- Concrete:
  - Piles: Class V (Special)
  - Splice Collar: Class IV
  - ~~Silica Fume: See "GENERAL NOTES" in the Structures Plans for locations where the use of silica fume, metakaolin or ultra-fine flyash is required.~~
- Concrete Strength at time of prestress transfer:
  - Piles: 4,000 psi minimum.
- Reinforcing:
  - Bars:
    - Stainless Steel: Meet the requirements of Specification Section 931 for Type 304, Grade 75.
    - Carbon FRP: Meet the requirements of Specification Section 932.
  - Prestressing Strands:
    - Stainless Steel: Seven-wire HSSS, UNS S32205 (Type 2205) or UNS S31803 strand, meeting the requirements of Specification Section 933.
    - Carbon FRP: Meet the requirements of Specification Section 933.
  - Spiral Ties:
    - One half turn is required for carbon steel spiral splice.
    - One full turn is required at the pile head and tip.
- Pile Splices:
  - Epoxy: Type AB Epoxy Compound or Epoxy Mortar must meet the requirements of Specification Section 926.
    - Use a Type AB Epoxy Bonding Compound or Epoxy Mortar, as recommended by the Manufacturer, to form the joint between pile sections
    - Use a Type AB Epoxy Bonding Compound as a bonding agent on internal pile surfaces.
  - Splices: Resume pile driving after the splice concrete reaches a minimum strength of 5,500 psi.
- Mark piles at the pick-up points to indicate the proper points for attaching handling lines.

Highly Reactive Pozzolans

Maximum Pile Length (Feet)	Required Storage and Transportation Detail	Pick-Up Detail
122	2, 3, or 4 point	1 Point
174	2, 3, or 4 point	2 Point

10/29/2019 2:59:05 PM

20

LAST REVISION 11/01/16	DESCRIPTION:
---------------------------	--------------




FY 2020-21  
STANDARD PLANS

60" PRESTRESSED CFRP & SS CONCRETE  
CYLINDER PILE


INDEX  
455-160

SHEET  
1 of 3

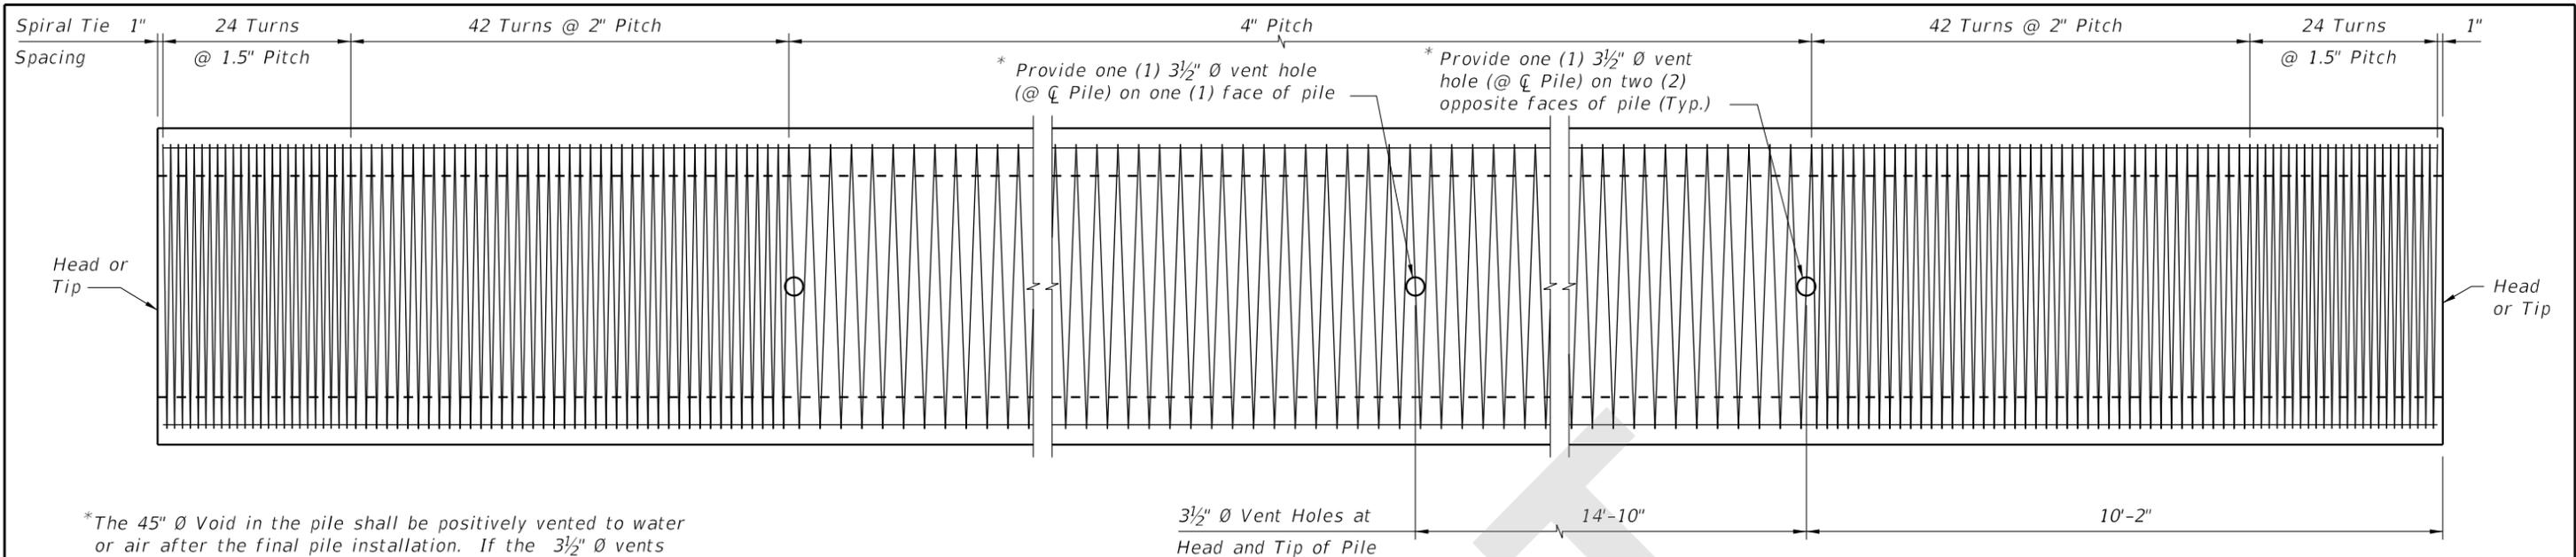

ELEVATION

\*The 45"  $\emptyset$  Void in the pile shall be positively vented to water or air after the final pile installation. If the 3 1/2"  $\emptyset$  vents are included in the pile cut-off section, then venting shall be provided by the use of a 1"  $\emptyset$  PVC conduit through the substructure cap or column.

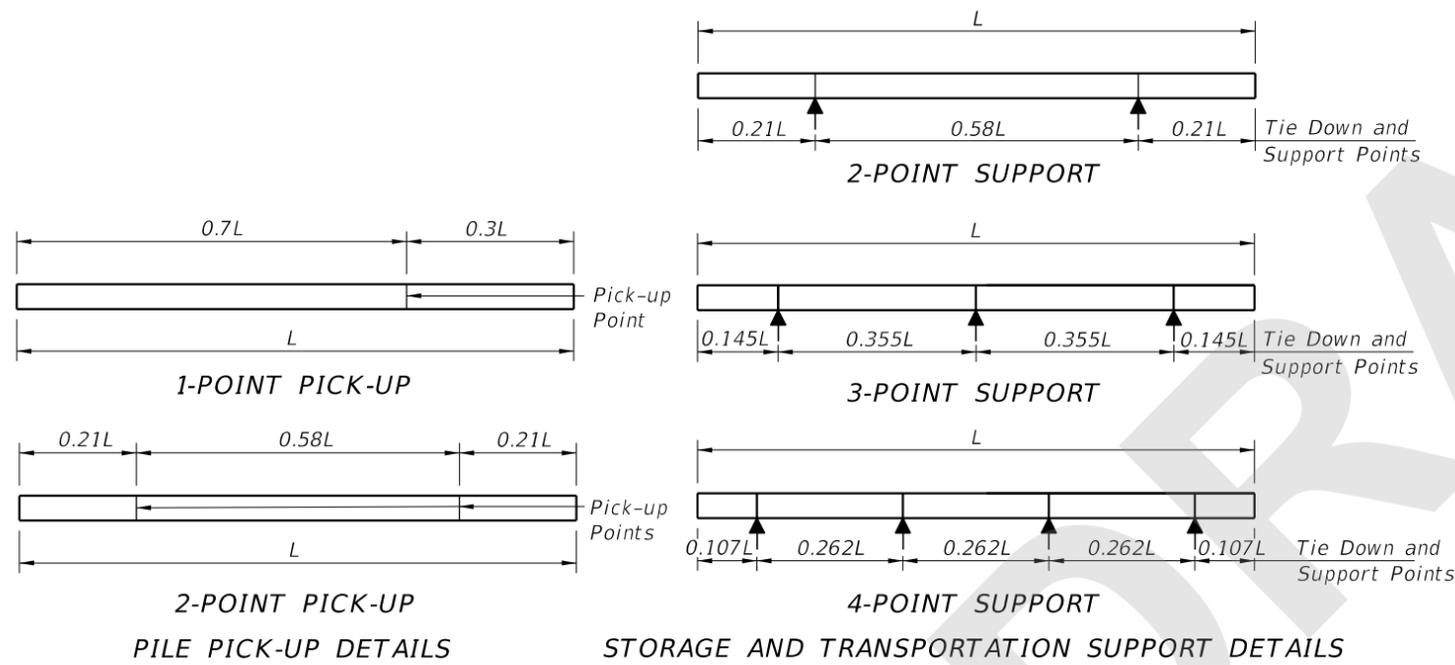

NOTES

1. Work this Index with the Pile Data Table in the Structures Plans.
2. Concrete:
  - A. Piles: Class V (Special)
  - B. Splice Collar: Class IV
  - C. See "GENERAL NOTES" in the Structures Plans for locations where the use of Highly Reactive Pozzolans is required.
3. Concrete Strength at time of prestress transfer:
  - A. Piles: 4,000 psi minimum.
4. Reinforcing:
  - A. Bars:
    - a. Stainless Steel: Meet the requirements of Specification Section 931 for Type 304, Grade 75.
    - b. Carbon FRP: Meet the requirements of Specification Section 932.
  - B. Prestressing Strands:
    - a. Stainless Steel: Seven-wire HSSS, UNS S32205 (Type 2205) or UNS S31803 strand, meeting the requirements of Specification Section 933.
    - b. Carbon FRP: Meet the requirements of Specification Section 933.
  - C. Spiral Ties:
    - a. One half turn is required for carbon steel spiral splice.
    - b. One full turn is required at the pile head and tip.
5. Pile Splices:
  - A. Epoxy: Type AB Epoxy Compound or Epoxy Mortar must meet the requirements of Specification Section 926.
    - a. Use a Type AB Epoxy Bonding Compound or Epoxy Mortar, as recommended by the Manufacturer, to form the joint between pile sections
    - b. Use a Type AB Epoxy Bonding Compound as a bonding agent on internal pile surfaces.
  - B. Splices: Resume pile driving after the splice concrete reaches a minimum strength of 5,500 psi.
6. Mark piles at the pick-up points to indicate the proper points for attaching handling lines.

TABLE OF MAXIMUM PILE PICK-UP AND SUPPORT LENGTHS		
Maximum Pile Length (Feet)	Required Storage and Transportation Detail	Pick-Up Detail
122	2, 3, or 4 point	1 Point
174	2, 3, or 4 point	2 Point

7/27/2020 3:53:24 PM