

---

## Index 700-102 Special Sign Details

### ORIGINATION

**Date:** June 3, 2020

**Name:** Dana Knox and Derwood Sheppard

**Phone:** (850) 410-5413 / (850) 414-4334

**Email:** dana.knox@dot.state.fl.us / d erwood.sheppard@dot.state.fl.us

### COMMENTARY

Sheet 5: Deleted: FTP-26-06.

Sheet 6: Shifted Sings on sheet.

Sheet 7: Shifted Sings on sheet.

Sheet 8: Shifted Sings on sheet; Changed signs FTP-66-06 and FTP-67-06; Changed FTP-66 and FTP-67 Logo; Added new sign FTP-68C-21.

Sheet 11: Added signs Mot-20-21, Mot-21-21, and Mot 23-21.

### COMMENTS AND RESPONSES

**BLACK** = Internal Review Comments    **RED** = Standard Plans Response

**Name:** Malcolm Tomatani

**Date:** August 17, 2020

**COMMENT:**

Sheet 8: For FTP-68C-21, the background should not be construction orange. None of the fonts are 3". The origination form has a typo: "FTP-6C-21".

**RESPONSE:** Agreed.

**Changes made to the Index and Origination Form:** Changed the background to white. Changed to series D Legend. Changed the Origination Form to say FTP-68C-21.

**Date:** 8/18/2020


**Continue to next page:**

**Name:** Dana Knox

**Date:** August 20, 2020

**COMMENT:** Three edits needed. Two edits for the 48x60. One edit for the 66x72.

For the 48x60:

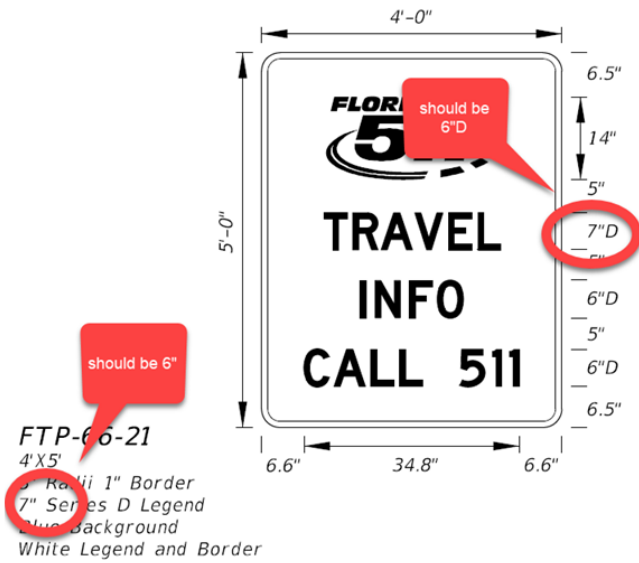


For the 66x72:




**RESPONSE:** Agreed.

**Changes made to the Index and Origination Form:** Updated Series D Legends for both signs per markup. Changed dimension from 7"D to 6"D per markup.


**Date:** 8/28/2020

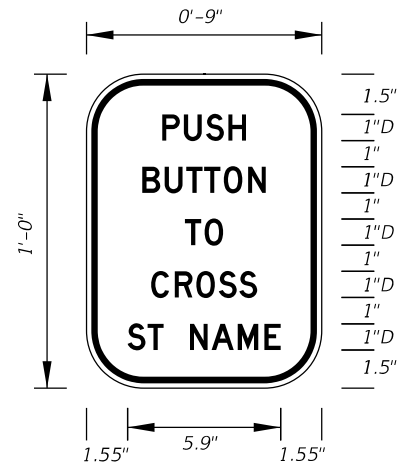


**FTP-25-06**  
 9" X 1'-0"  
 2" Radii 3/8" Border  
 1" Series D Legend  
 White Background  
 Black Legend and Border

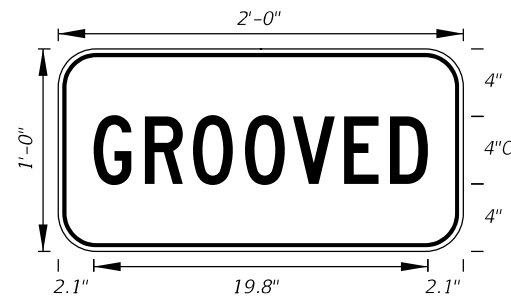


**FTP-29-06**  
 2'-0" X 1'-0"  
 2" Radii 5/8" Border  
 4" Series C Legend  
 Yellow Background  
 Black Legend and Border

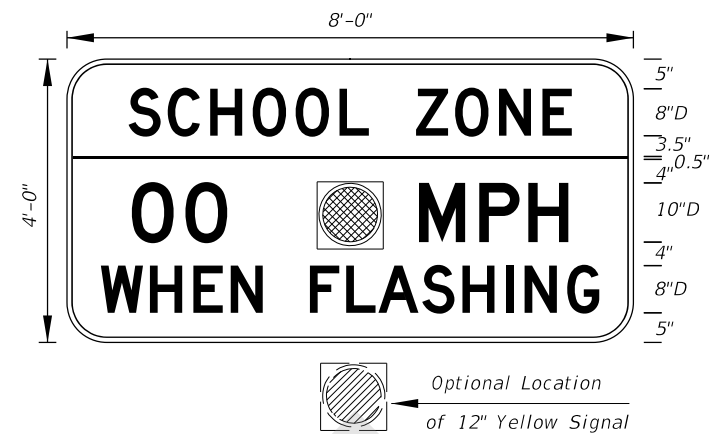


**FTP-31-06**  
 8' X 4'  
 6" Radii 3/4" Border  
 Series D Legend  
 Fluorescent Yellow-Green Background Top  
 White Background Bottom  
 Black Legend and Border

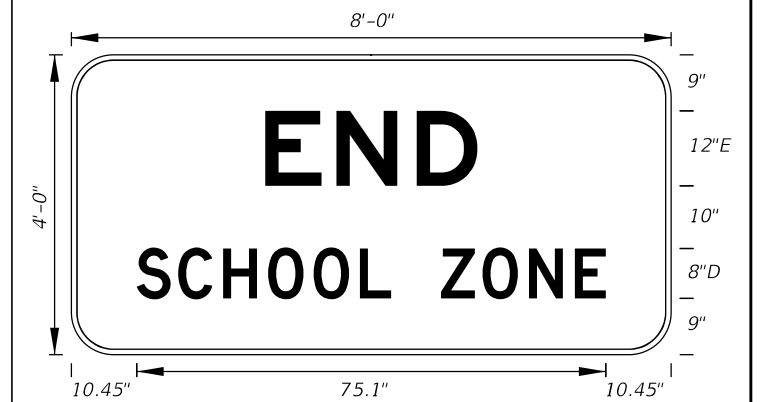


**FTP-32-06**  
 8' X 4'  
 6" Radii 3/4" Border  
 12" Series E and 8" Series D Legend  
 White Background  
 Black Legend and Border

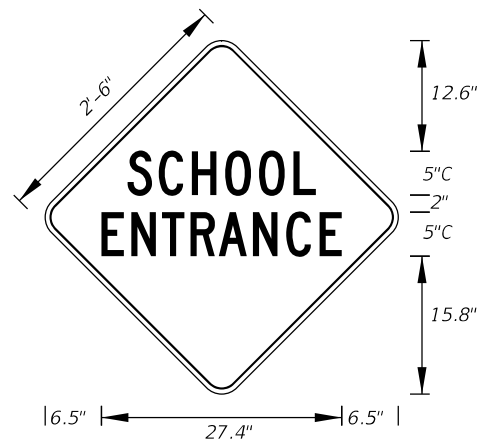


**FTP-33-06**  
 2'-6" X 2'-6"  
 2" Radii 3/4" Border  
 5" Series C Legend  
 Fluorescent Yellow-Green Background  
 Black Legend and Border

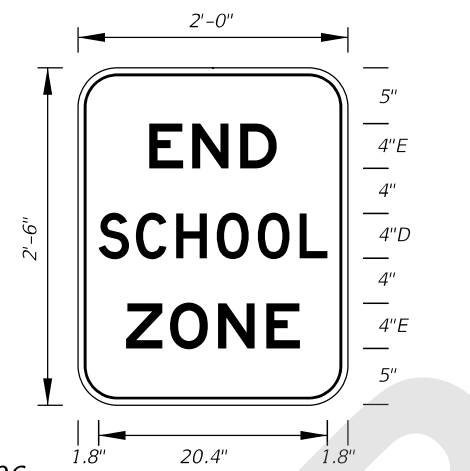


**FTP-34-06**  
 2' X 2'-6"  
 3" Radii 5/8" Border  
 4" Series D and E Legend  
 White Background  
 Black Legend and Border

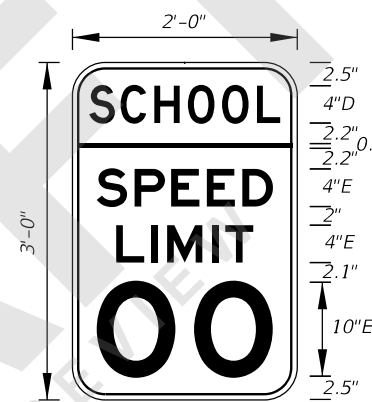


**FTP-35-06**  
 2' X 3'  
 3" Radii 5/8" Border  
 Top 4" Series D Legend  
 Bottom 4" and 10" Series E Legend  
 Fluorescent Yellow-Green Background Top  
 White Background Bottom  
 Black Legend and Border

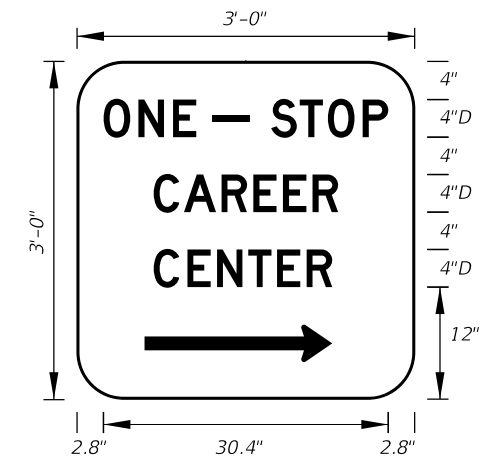


**FTP-36-06**  
 3' X 3'  
 5" Radii  
 4" Series D Legend  
 Green Background  
 White Legend and Border

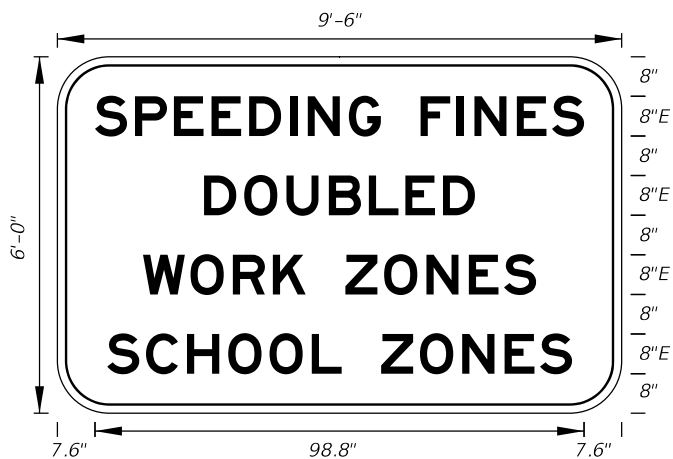


**FTP-37-06**  
 9'-6" X 6'  
 9" Radii 2" Border  
 8" Series E Legend  
 White Background  
 Black Legend and Border  
 State Line Sign

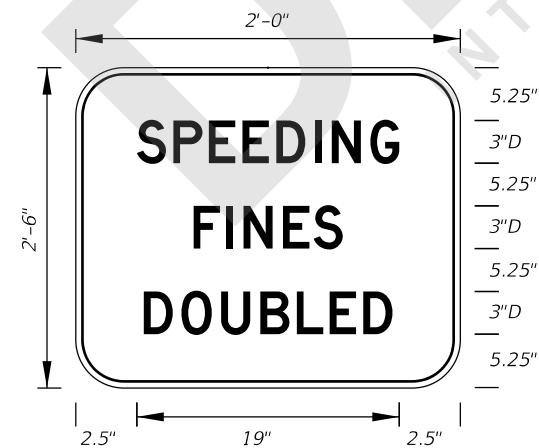

**FTP-38-06**  
 2' X 2'-6"  
 4" Radii 3/4" Border  
 3" Series D Legend  
 White Background  
 Black Legend and Border

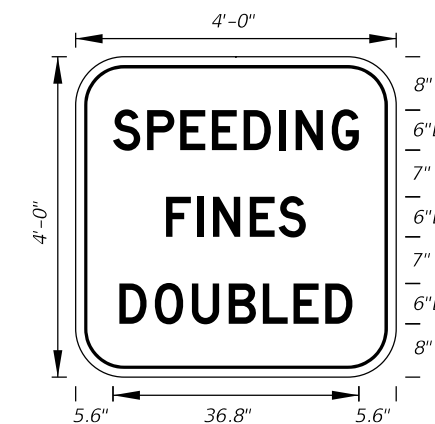

**FTP-39-06**  
 4' X 4'  
 6" Radii 3/4" Border  
 6" Series D Legend  
 White Background  
 Black Legend and Border  
 Freeway Sign

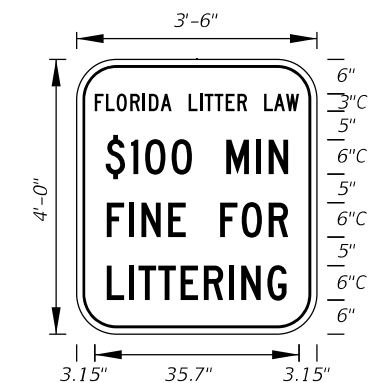

**FTP-40-06**  
 3'-6" X 4'  
 6" Radii 3/4" Border  
 3" and 6" Series C Legend  
 White Background  
 Black Legend and Border

8/28/2020 6:34:24 AM

LAST REVISION	DESCRIPTION:
11/01/20	



FY 2021-22  
 STANDARD PLANS

SPECIAL SIGN DETAILS

INDEX  
 700-102


SHEET  
 5 of 11



**FTP-41-06**  
2'-6" X 3'  
4" Radii 3/4" Border  
2" and 4" Series C Legend  
White Background  
Black Legend and Border



**FTP-42-06**  
4' X 2'-6"  
3" Radii  
Top 4" Series C Legend  
Bottom 2" Series EM Legend  
White Background  
Blue Legend and Border

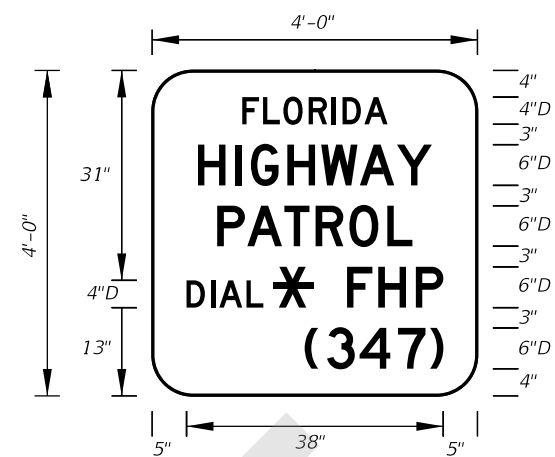


**FTP-43-06**  
4' X 4'  
6" Radii 1" Border  
Top 4" Series D Legend  
Bottom 6" Series D Legend  
Blue Background  
White Legend and Border




**FTP-44-06**  
9' X 6'  
9" Radii 3/4" Border  
8" Series D Legend  
White Background  
Black Legend and Border




**FTP-45-06**  
4' X 3'  
5" Radii 3/4" Border  
4" Series C Legend  
White Background  
Black Legend and Border

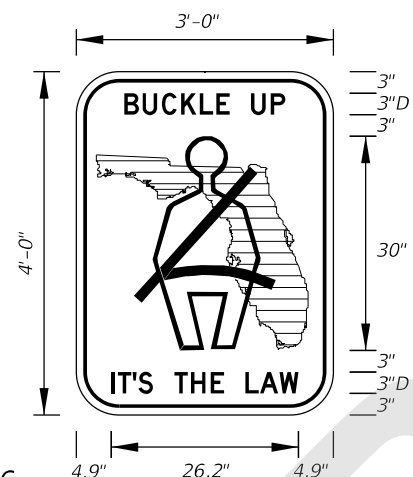


**FTP-46-06**  
3' X 4'  
5" Radii 3/4" Border  
3" Series D Legend  
White Background  
Green Florida Symbol  
Black Legend, Border and Man Belt Symbol

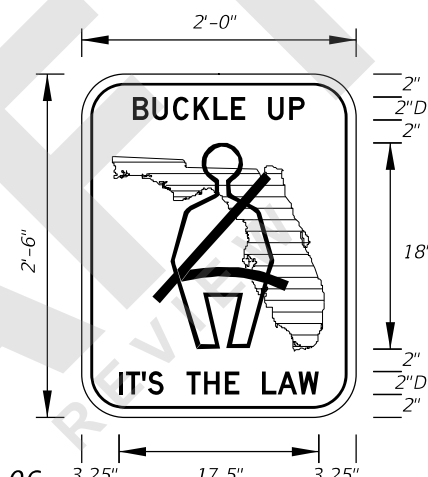


**FTP-47-06**  
2' X 2'-6"  
3" Radii 5/8" Border  
2" Series D Legend  
White Background  
Green Florida Symbol  
Black Legend, Border and Man Belt Symbol

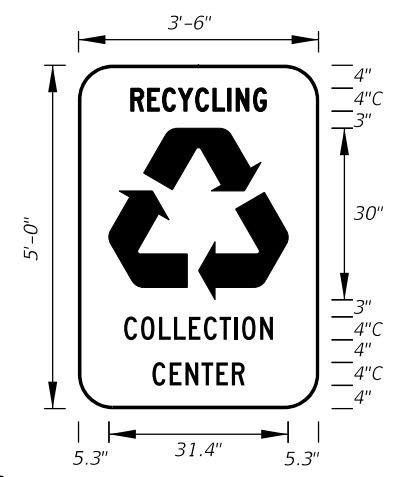


**FTP-48-06**  
3'-6" X 5'  
6" Radii  
4" Series C Legend  
Green Background  
White Legend, Border and Symbol

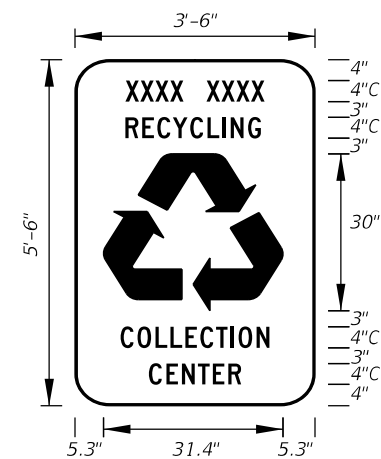


**FTP-49-06**  
3'-6" X 5'-6"  
6" Radii  
4" Series C Legend  
Green Background  
White Legend, Border and Symbol  
Municipality Name Optional

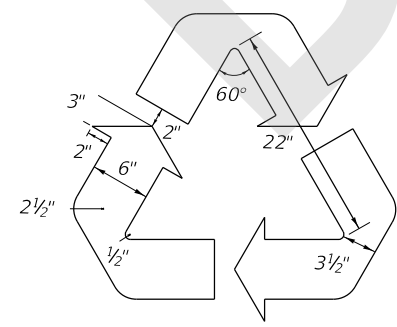

Detail for **FTP-48-06** and **FTP-49-06**

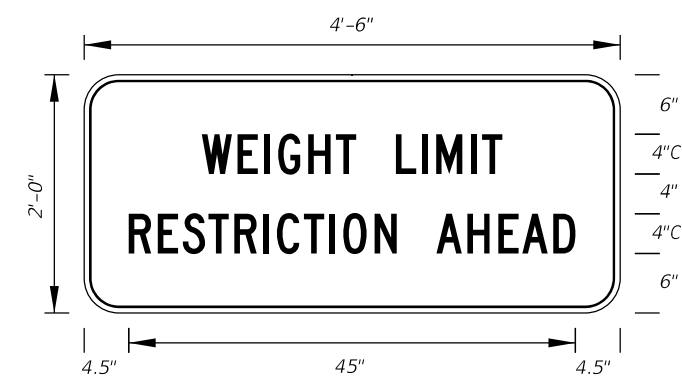


**FTP-50-06**  
4'-6" X 2'  
3" Radii 3/4" Border  
4" Series C Legend  
Yellow Background  
Black Legend and Border

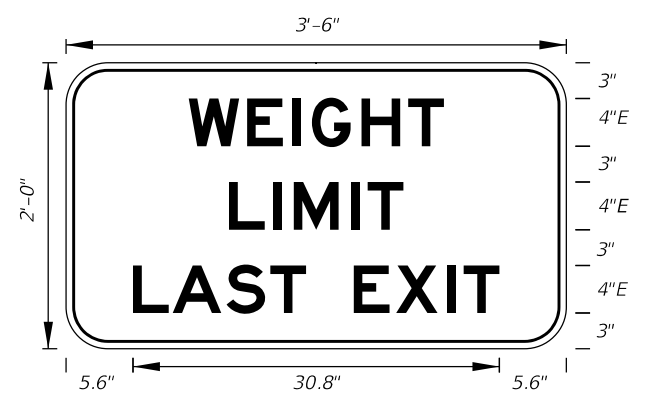


**FTP-51-06**  
3' X 2'  
3" Radii 3/4" Border  
4" Series E Legend  
White Background  
Black Legend and Border

8/28/2020 6:34:26 AM


LAST REVISION	DESCRIPTION:
11/01/20	

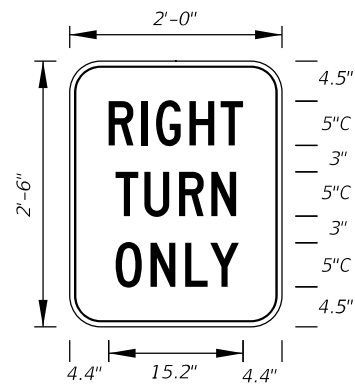


**FTP-52-06**  
2' X 2'-6"  
3" Radii 5/8" Border  
5" Series C Legend  
White Background  
Black Legend and Border

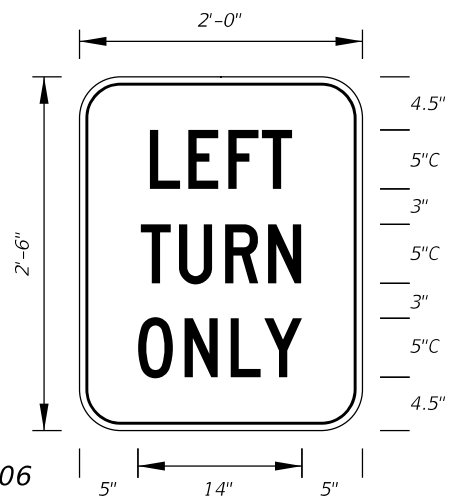


**FTP-53-06**  
2' X 2'-6"  
3" Radii 5/8" Border  
5" Series C Legend  
White Background  
Black Legend and Border

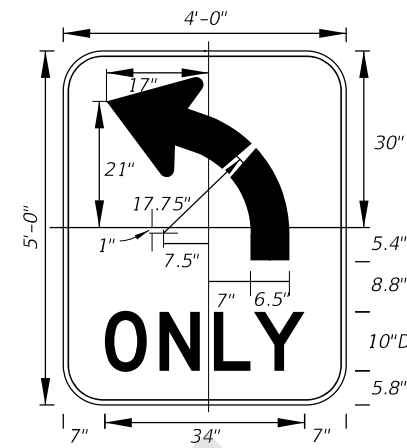

**FTP-54L-06**  
4' X 5'  
6" Radii 3/4" Border  
10" Series D Legend  
White Background  
Black Legend and Border  
FTP-54R-06 for (Right Turn Arrow)

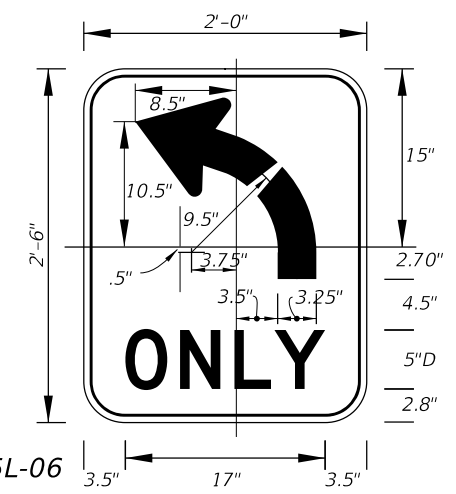


**FTP-55L-06**  
2' X 2'-6"  
3" Radii 3/8" Border  
5" Series D Legend  
White Background  
Black Legend and Border  
FTP-55R-06 for (Right Turn Arrow)

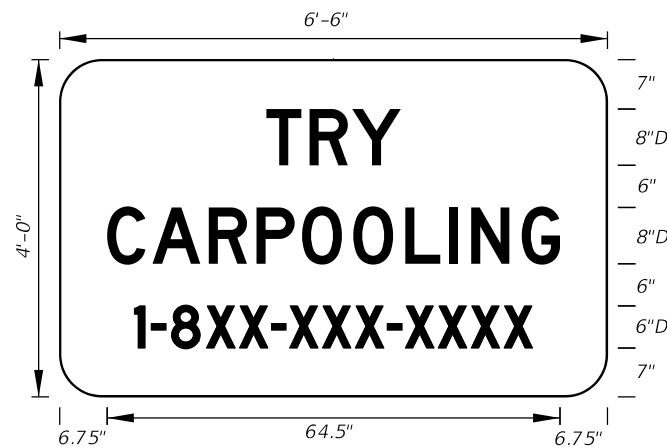


**FTP-56-06**  
6'-6" X 4'  
6" Radii 3/4" Border  
8" and 6" Series D Legend  
Blue Background  
White Legend and Border  
Design Project Manager or Transit Administrator will supply correct 1-8XX number.




**FTP-56A-06**  
3' X 2'  
3" Radii  
4" and 3" Series C Legend  
Blue Background  
White Legend and Border  
Design Project Manager or Transit Administrator will supply correct 1-8XX number.

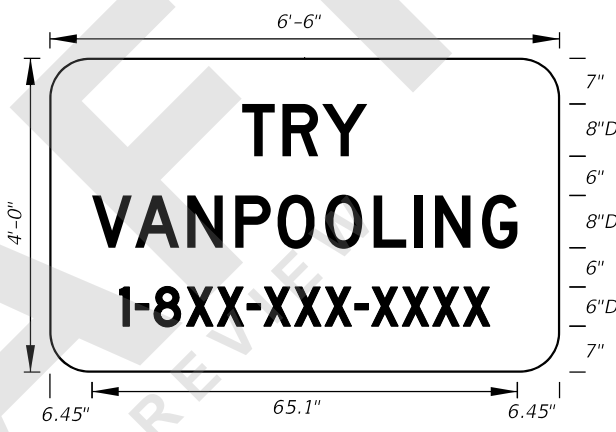


**FTP-57-06**  
6'-6" X 4'  
6" Radii  
8" and 6" Series D Legend  
Blue Background  
White Legend and Border  
Design Project Manager or Transit Administrator will supply correct 1-8XX number.

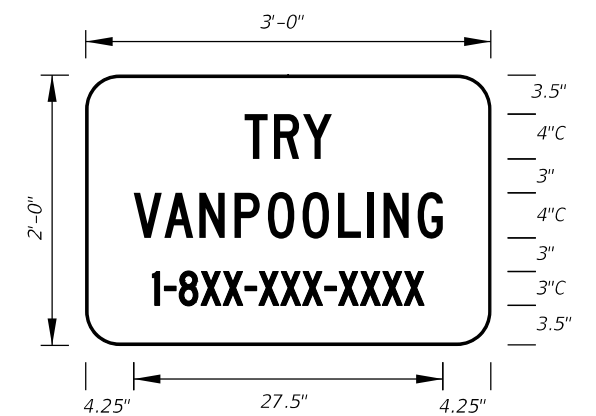

**FTP-58-06**  
3' X 2'  
3" Radii  
4" and 3" Series C Legend  
Blue Background  
White Legend and Border  
Design Project Manager or Transit Administrator will supply correct 1-8XX number.

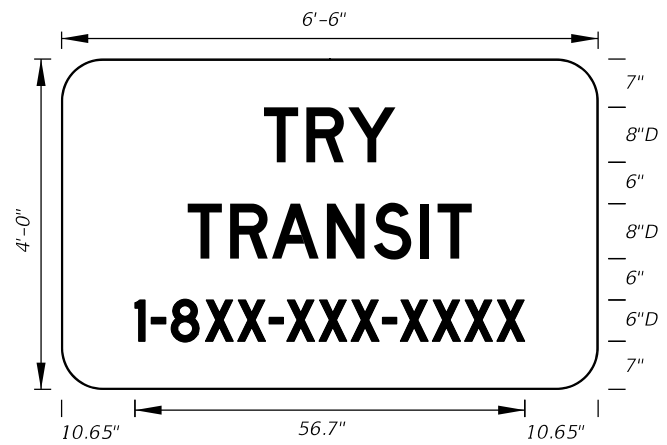


**FTP-59-06**  
6'-6" X 4'  
6" Radii  
8" and 6" Series D Legend  
Blue Background  
White Legend and Border  
Design Project Manager or Transit Administrator will supply correct 1-8XX number.

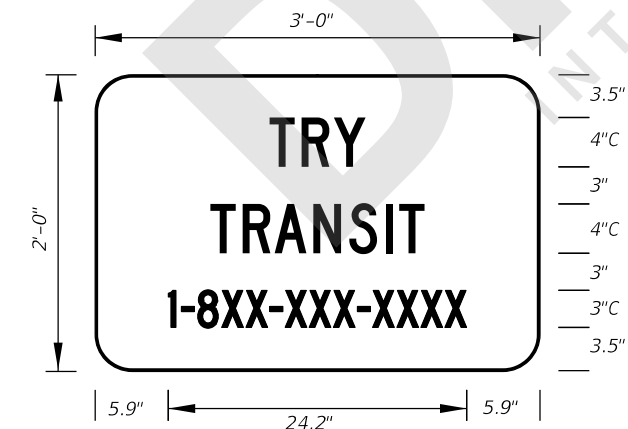

**FTP-60-06**  
3' X 2'  
3" Radii  
4" and 3" Series C Legend  
Blue Background  
White Legend and Border  
Design Project Manager or Transit Administrator will supply correct 1-8XX number.




**FTP-61-06**  
3' X 2'  
3" Radii 3/4" Border  
4" and 3" Series C Legend  
Yellow Background  
Black Legend and Border

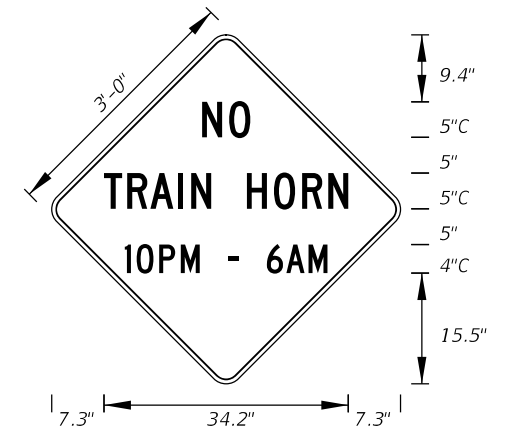


**FTP-62-06**  
3' X 3'  
2" Radii 3/4" Border 4" and 5" Series C Legend  
Yellow Background Black Legend and Border

6/28/2020 6:34:28 AM

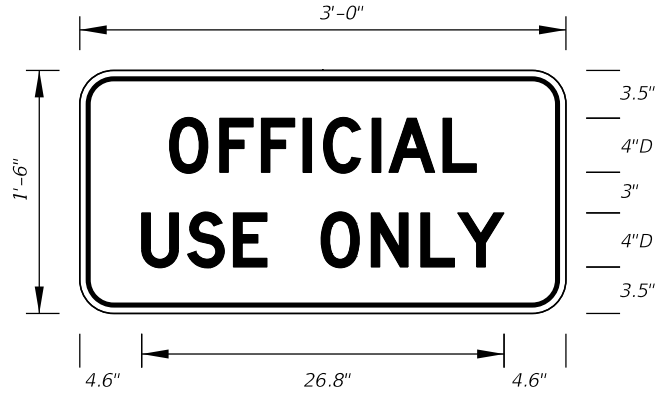

**FTP-65-06**  
 3' X 1'-6"  
 2" Radii 3/4" Border  
 4" Series D Legend  
 White Background  
 Black Legend and Border

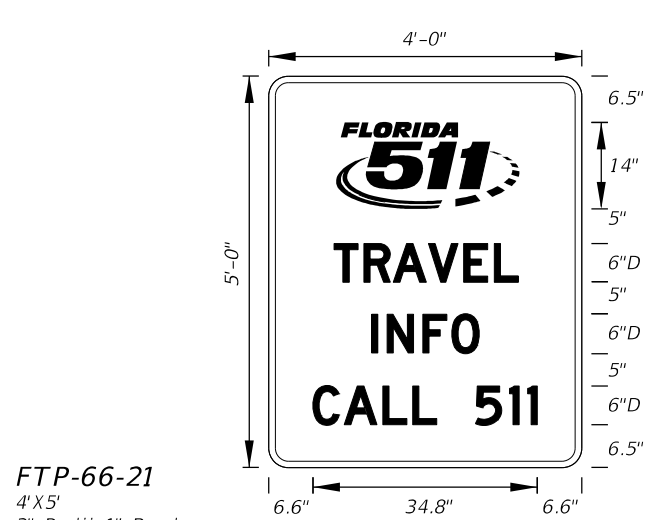

**FTP-66-21**  
 4' X 5'  
 3" Radii 1" Border  
 6" Series D Legend  
 Blue Background  
 White Legend and Border




**FTP-67-21**  
 5.5' X 6'  
 3" Radii 1" Border  
 8" Series D Legend  
 Blue Background  
 White Legend and Border



DETAIL for **FTP-66** AND **FTP-67**


Sign Mounting Holes Can Be Punched Or Field Drilled With No Obstruction To Text Or Symbols From Holes Or Bolts.

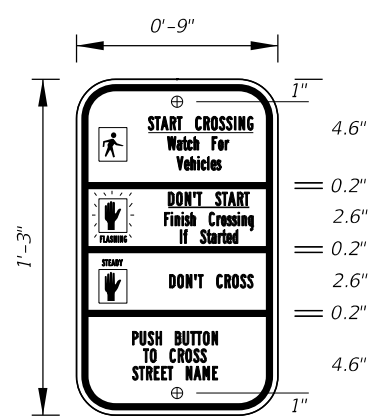

**FTP-68A-06**  
 9" X 1'-3"  
 1.5" Radii 3/4" Border  
 Series B Legend  
 White Background  
 Black Legend and Border


See Standard Highway Signs Manual, Sign R10-3b For Letter Size Spacing And Symbol Sizes.

Sign Mounting Holes Can Be Punched Or Field Drilled With No Obstruction To Text Or Symbols From Holes Or Bolts.

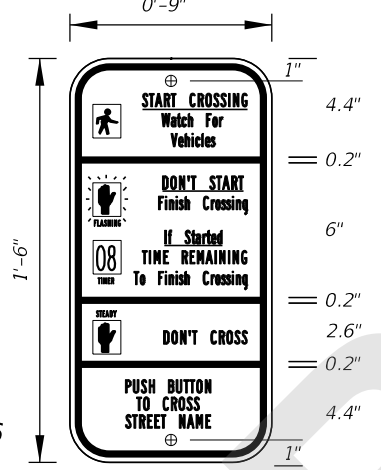


**FTP-68B-06**  
 9" X 1'-6"  
 1.5" Radii 3/4" Border  
 Series B Legend  
 White Background  
 Black Legend and Border

See Standard Highway Signs Manual, Sign R10-3b For Letter Size Spacing And Symbol Sizes.

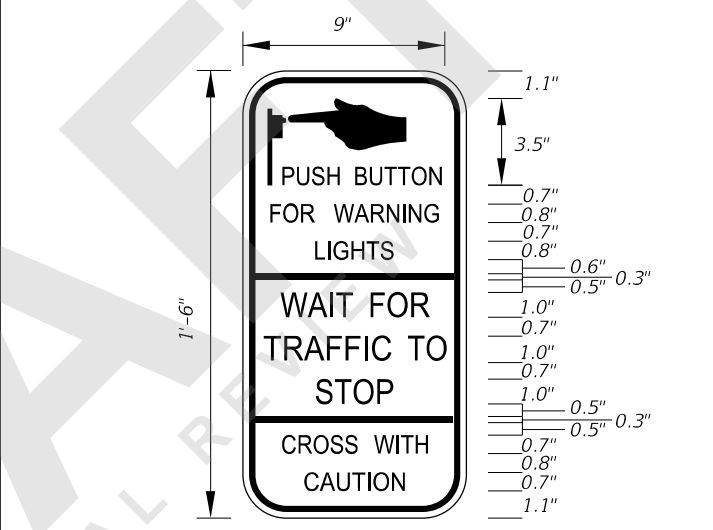


**FTP-68C-21**  
 1'-6" X 9"  
 1.5" Radii 1/4" Border

Series D Legend  
 White Background  
 Black Legend and Border

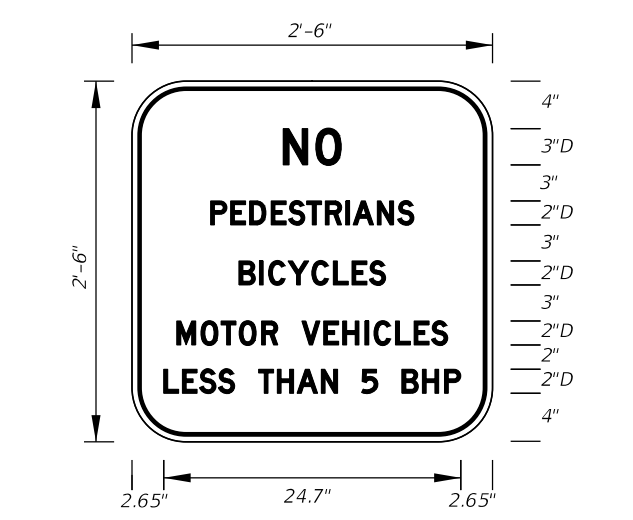


**FTP-69-06**  
 2'-6" X 2'-6"  
 4" Radii 3/4" Border

2" and 3" Series D Legend  
 White Background  
 Black Legend and Border

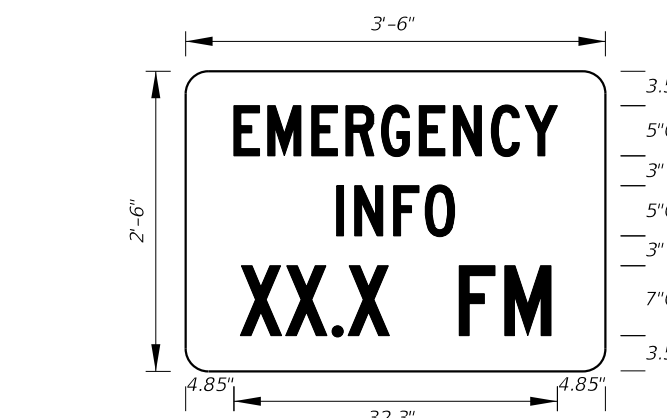

**FTP-70-06**  
 3'-6" X 2'-6"  
 2.25" Radii 3/4" Border  
 5" Series C and 7" Series C Legend  
 Blue Background  
 White Legend and Border

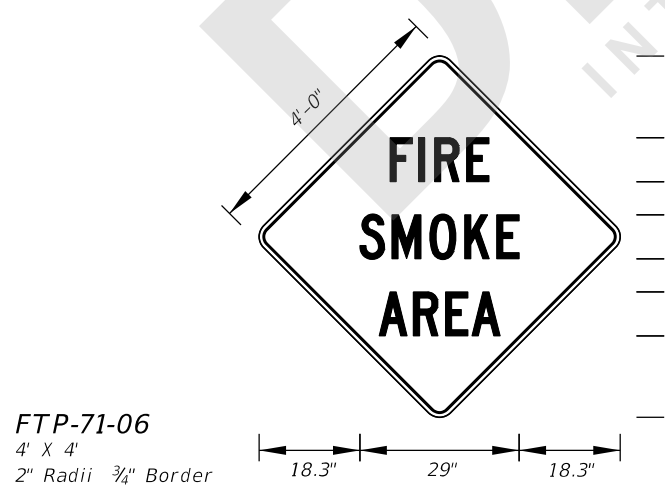


**FTP-71-06**  
 4' X 4'  
 2" Radii 3/4" Border  
 8" Series C Legend  
 Yellow Background  
 Black Legend and Border



**FTP-72-06**  
 3' X 3'  
 2" Radii 3/4" Border

6" Series C Legend  
 Yellow Background  
 Black Legend and Border

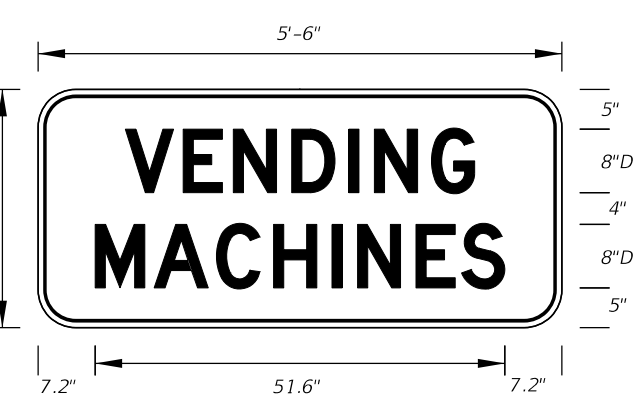


**FTP-73-06**  
 5'-6" X 2'-6"  
 4" Radii 3/4" Border

8" Series D Legend  
 Blue Background  
 White Legend and Border


8/28/2020 6:34:30 AM




**FTP-74-06**  
 5'-6" X 2'-6"  
 4" Radii 3/4" Border  
 6" Series D Legend  
 Blue Background  
 White Legend and Border

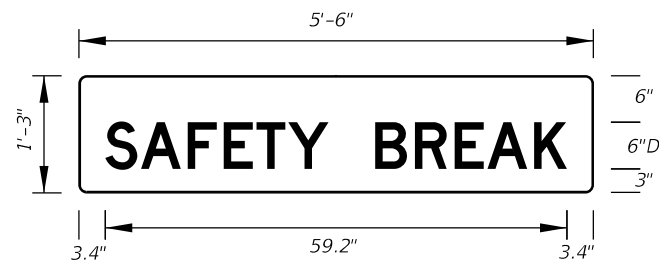


**FTP-75-06**  
 5'-6" X 1'-3"  
 1" Radii  
 6" Series D Legend  
 Blue Background  
 White Legend

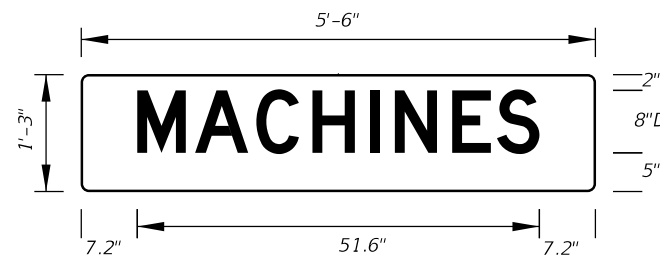


**FTP-76-06**  
 5'-6" X 1'-3"  
 1" Radii  
 8" Series D Legend  
 Blue Background  
 White Legend

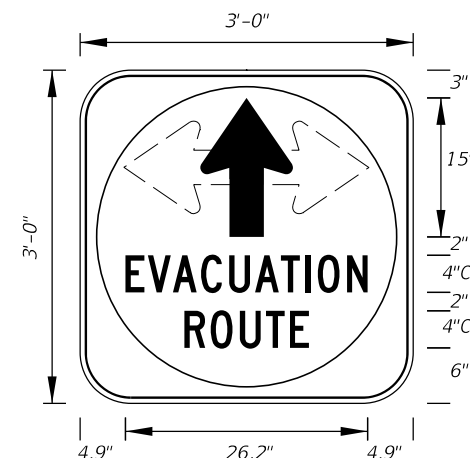


**FTP-77-06**  
 3' X 3'  
 5" Radii 3/4" Border  
 4" Series C Legend  
 White Background with Blue Circle Background  
 White Legend and Black Border

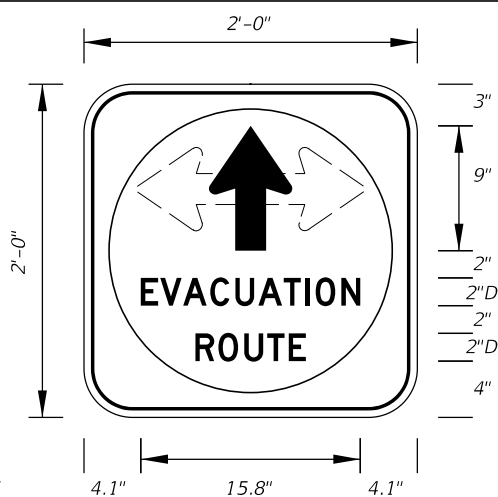


**FTP-78-06**  
 2' X 2'  
 3" Radii 3/4" Border  
 2" Series D Legend  
 White Background with Blue Circle Background  
 White Legend and Black Border

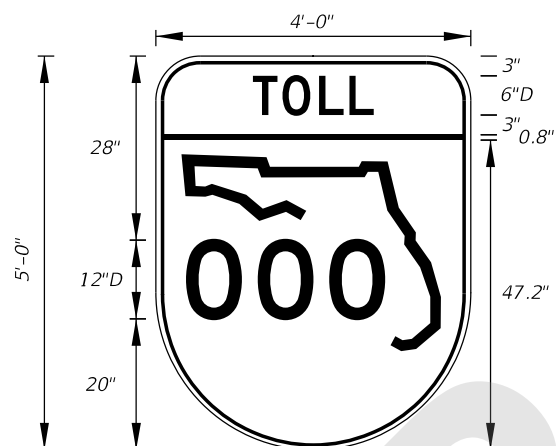


**FTP-79-06**  
 4' X 5'  
 6" Radii 3/4" Border  
 6" and 12" Series D Legend  
 Top Yellow Background with Black Legend and Black Border  
 Bottom White Background with Black Legend and Border

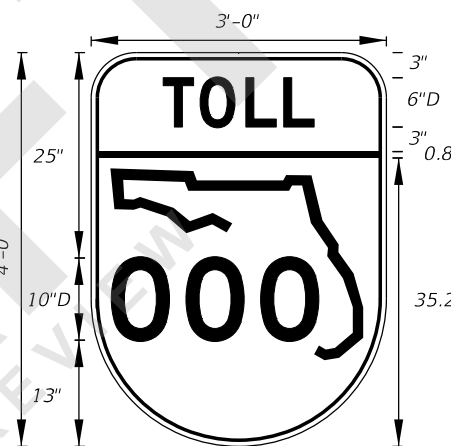


**FTP-80-06**  
 3' X 4'  
 5" Radii 3/4" Border  
 6" and 10" Series D Legend  
 Top Yellow Background with Black Legend and Black Border  
 Bottom White Background with Black Legend and Border

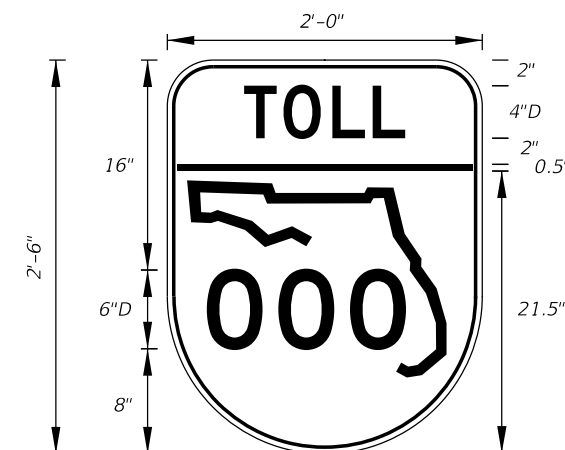

**FTP-81-06**  
 2' X 2'-6"  
 3" Radii 3/4" Border  
 4" and 6" Series D Legend  
 Top Yellow Background with Black Legend and Black Border  
 Bottom White Background with Black Legend and Border

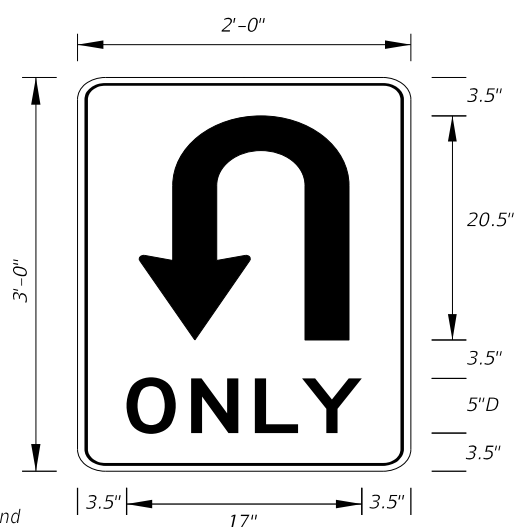


**FTP-82-08**  
 2' X 3'  
 1.5" Radii  
 5" Series D Legend  
 White Background  
 Black Legend and Border

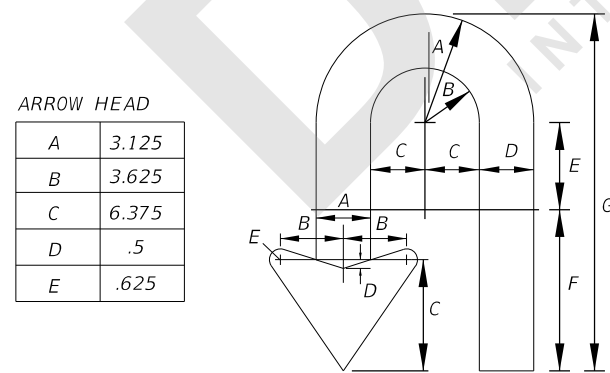


ARROW BODY						
A	B	C	D	E	F	G
6.25	3.125	3.125	3.125	5	9.25	20.5

**FTP-82-08**  
 Details

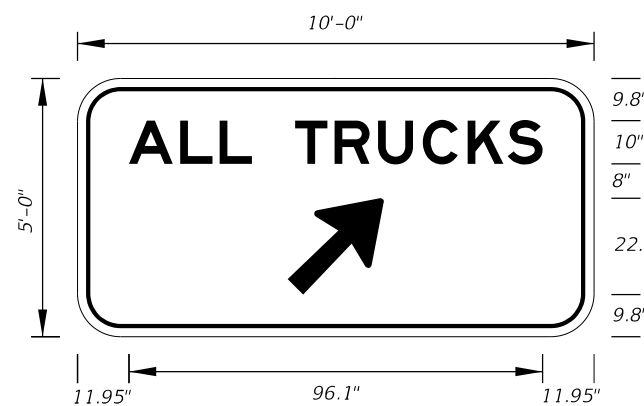

**FTP-83-08**  
 10'-0" X 5'-0"  
 8" Radii  
 10" Series E Legend  
 Green Background  
 White Legend

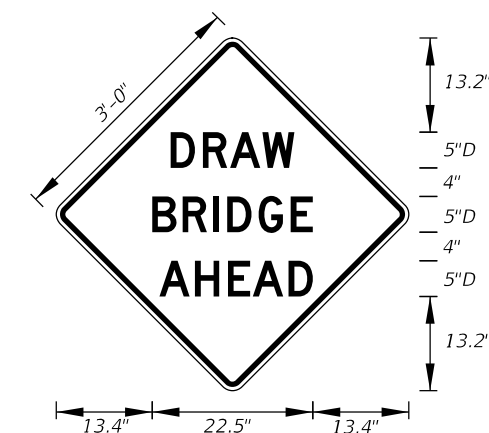

**FTP-84-09**  
 3' X 3'  
 1.5" Radii  
 5" Series D Legend  
 Yellow Background  
 Black Legend and Border

6:34:44 AM  
8/28/2020


LAST REVISION	DESCRIPTION:
11/01/20	




FY 2021-22  
 STANDARD PLANS

SPECIAL SIGN DETAILS


INDEX	SHEET
700-102	9 of 11

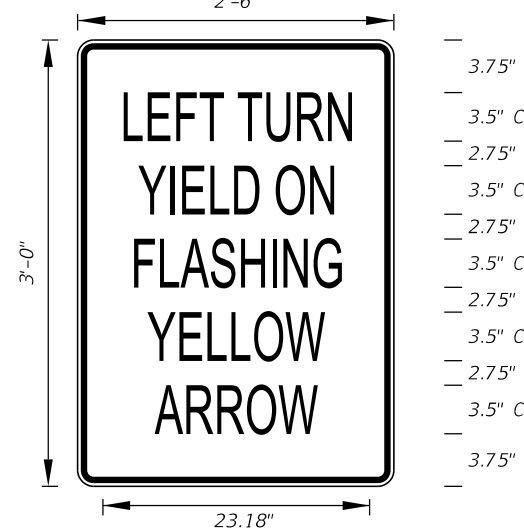


**FTP-85-13**  
3' X 2'-6"  
1.875" Radii 3/4" Border  
3.5" Series C Legend  
White Background  
Black Legend and Border

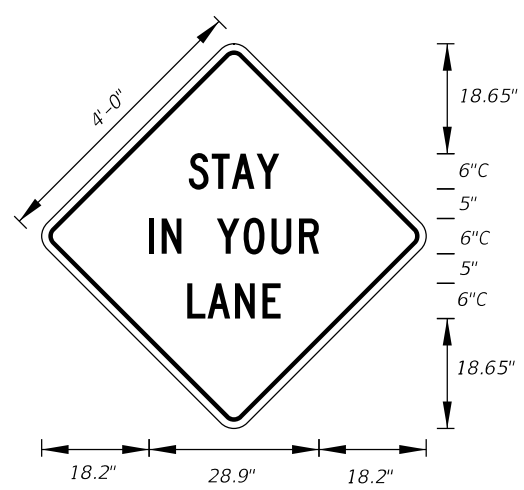


**MOT-1-06**  
4' X 4'  
2" Radii 3/4" Border  
6" Series C Legend  
Orange Background  
Black Legend and Border

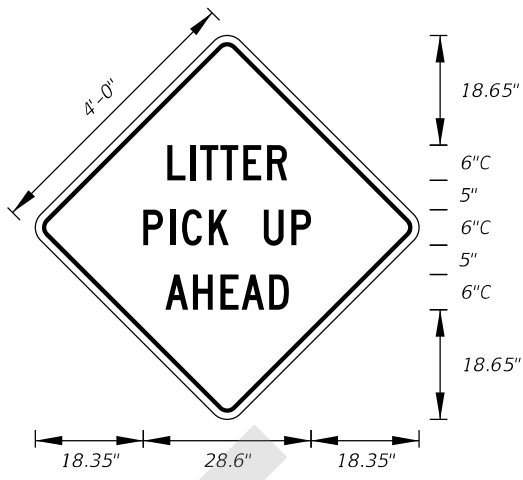


**MOT-4-06**  
4' X 4'  
2" Radii 3/4" Border  
6" Series C Legend  
Orange Background  
Black Legend and Border

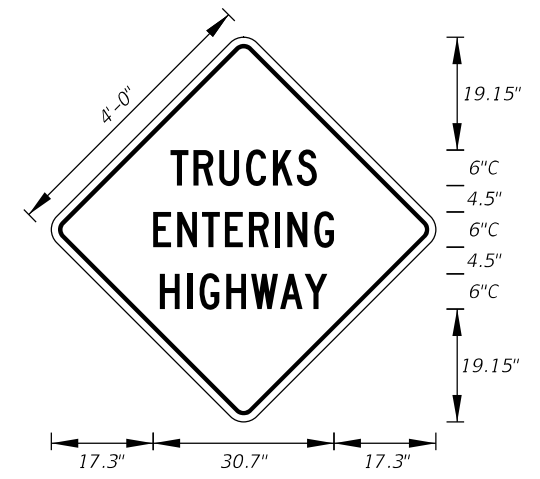


**MOT-5-06**  
4' X 4'  
2" Radii 3/4" Border  
6" Series C Legend  
Orange Background  
Black Legend and Border

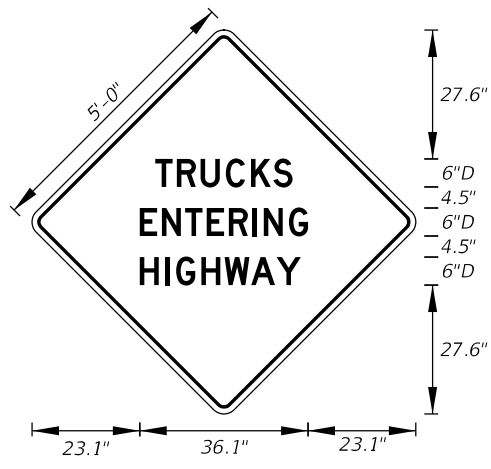


**MOT-6-06**  
5' X 5'  
2" Radii 3/4" Border  
6" Series D Legend  
Orange Background  
Black Legend and Border

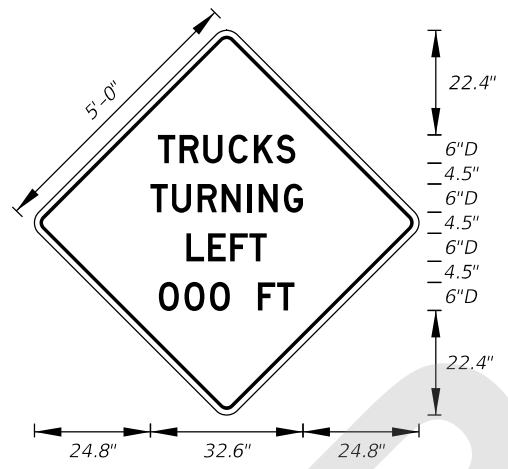


**MOT-7-06**  
5' X 5'  
2" Radii 3/4" Border  
6" Series D Legend  
Orange Background  
Black Legend and Border

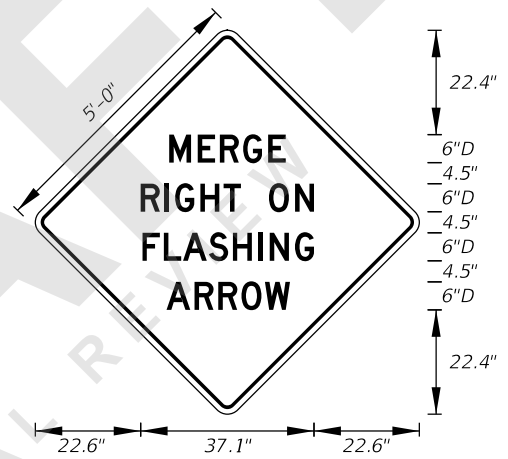


**MOT-8-06**  
5' X 5'  
2" Radii 3/4" Border  
6" Series D Legend  
Orange Background  
Black Legend and Border

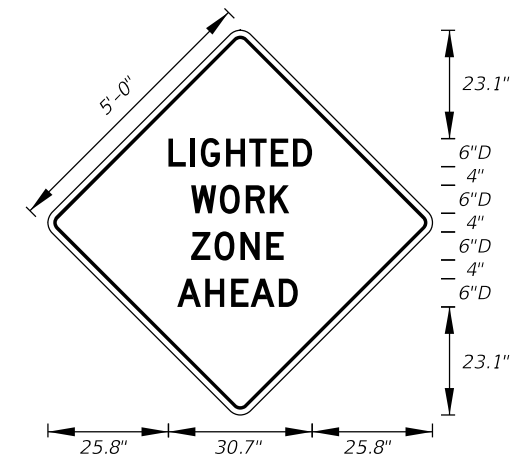


**MOT-9-06**  
5' X 5'  
2" Radii 3/4" Border  
6" Series D Legend  
Orange Background  
Black Legend and Border

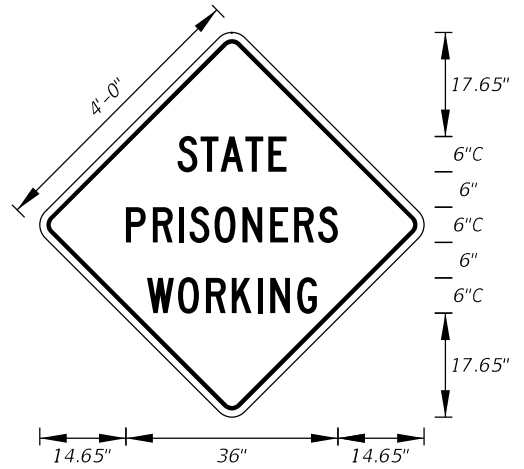


**MOT-10-06**  
4' X 4'  
2" Radii 3/4" Border  
6" Series C Legend  
Orange Background  
Black Legend and Border

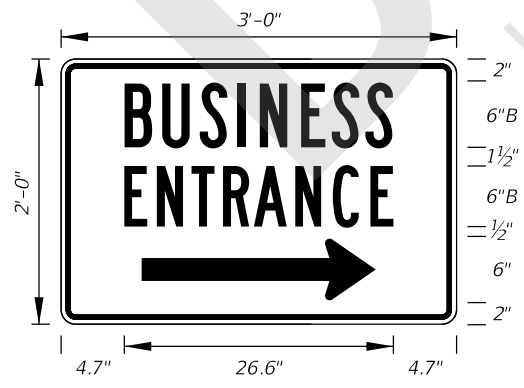

**MOT-11-06**  
3' X 2'  
2" Radii 3/4" Border  
6" Series B Legend  
Blue Background  
White Legend and Border

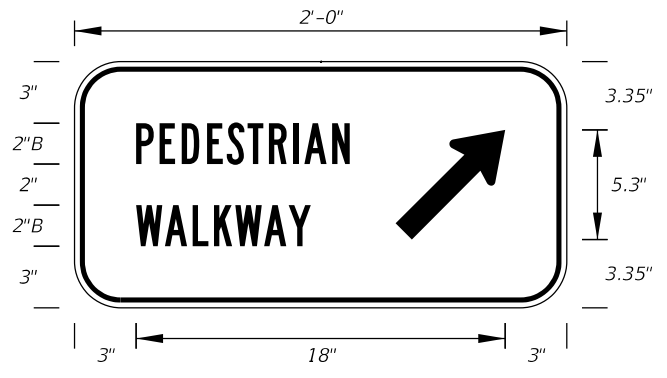


**MOT-12R-06**  
2' X 1'  
2" Radii 3/4" Border  
2" Series B Legend  
White Background  
Black Legend and Border  
**MOT-12L-06**  
For Diversion to the left

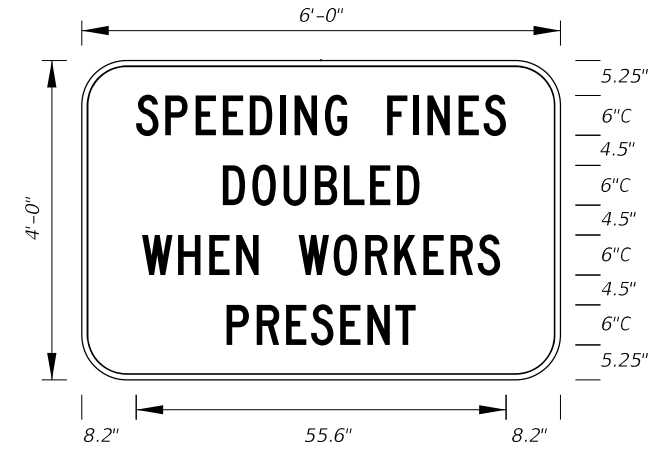

**MOT-13-06**  
Freeway Sign  
6' X 4'  
6" Radii 3/4" Border  
6" Series C Legend  
White Background  
Black Legend and Border


8/28/2020 6:34:50 AM



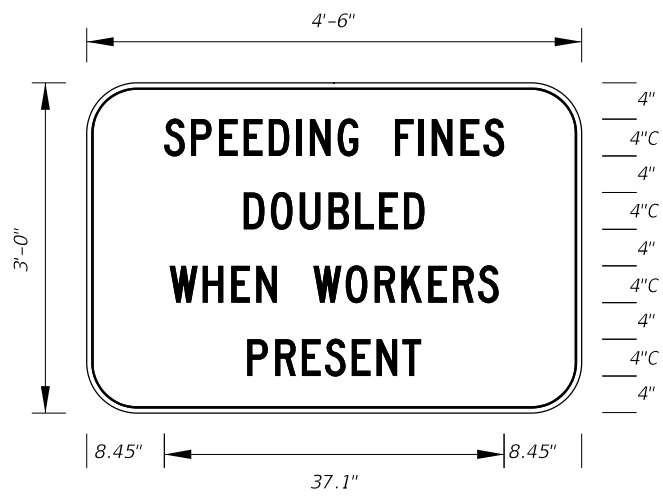


**MOT-14-06**  
Arterial Sign  
4'-6" X 3'  
5" Radii 3/4" Border

4" Series C Legend  
White Background  
Black Legend and Border

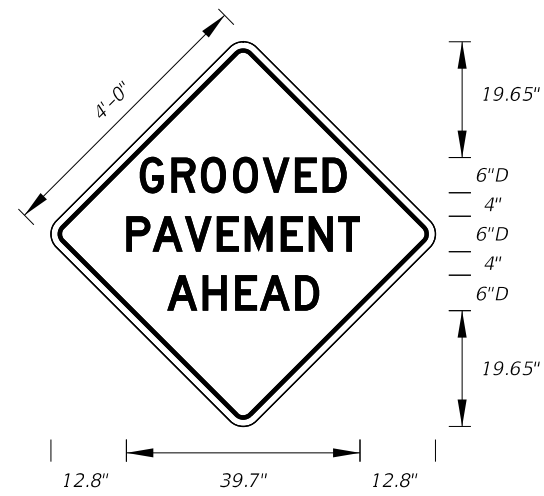


**MOT-15-06**  
4' X 4'  
2" Radii 3/4" Border

6" Series D Legend  
Orange Background  
Black Legend and Border

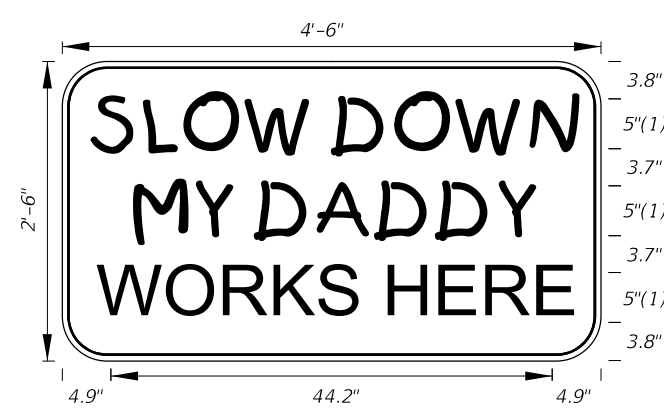


**MOT-16-06**  
4'-6" X 2'-6"  
4" Radii 3/4" Border

5" Kids Series Legend  
Orange Background  
Black Legend and Border

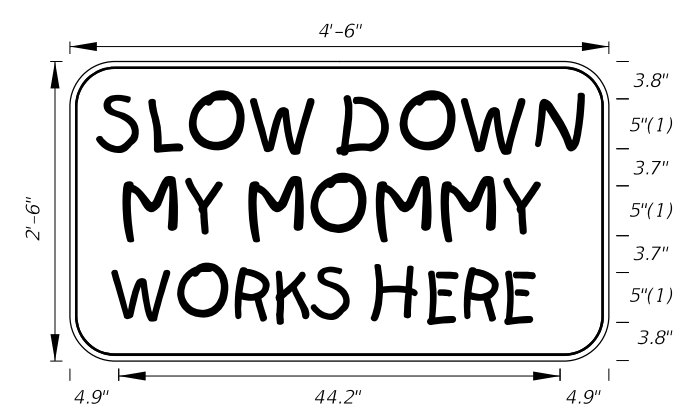


**MOT-17-06**  
4'-6" X 2'-6"  
4" Radii 3/4" Border

5" Kids Series Legend  
Orange Background  
Black Legend and Border

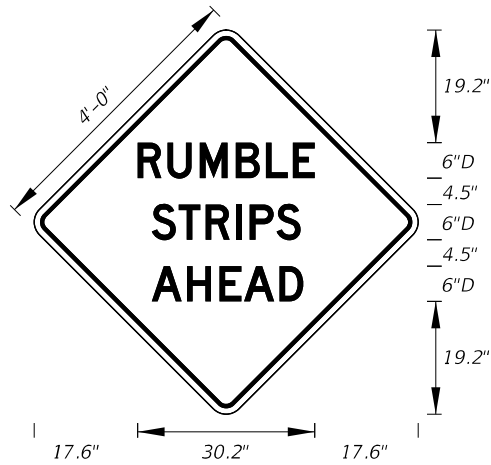


**MOT-18-10**  
4' X 4'  
2" Radii 3/4" Border

6" Series D Legend  
Orange Background  
Black Legend and Border

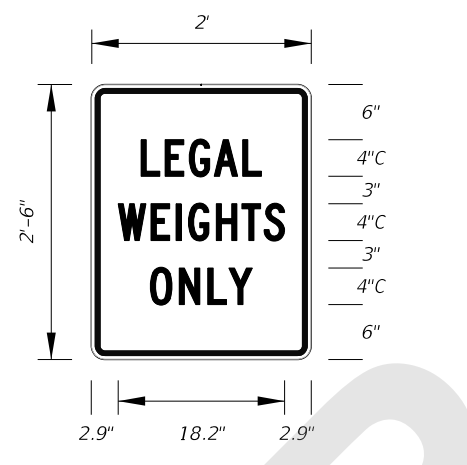


**MOT-19-11**  
2' X 2'-6"  
1.13" Radii 3/4" Border

4" Series C Legend  
White Background  
Red Legend and Border

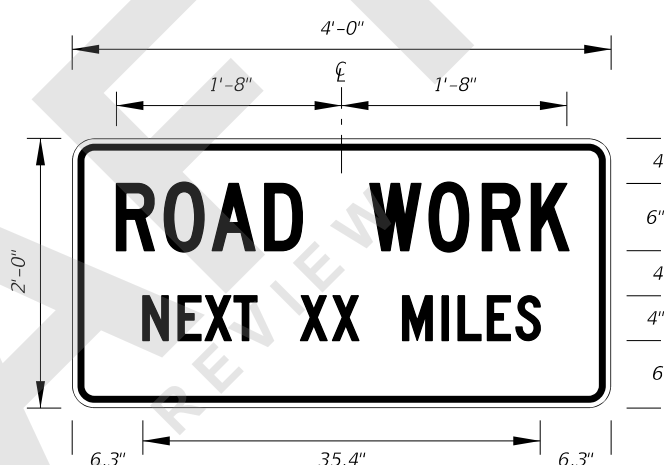


**G20-1**  
2' X 4'  
1.5" Radii 3/4" Border

Orange Background  
Black Legend and Border

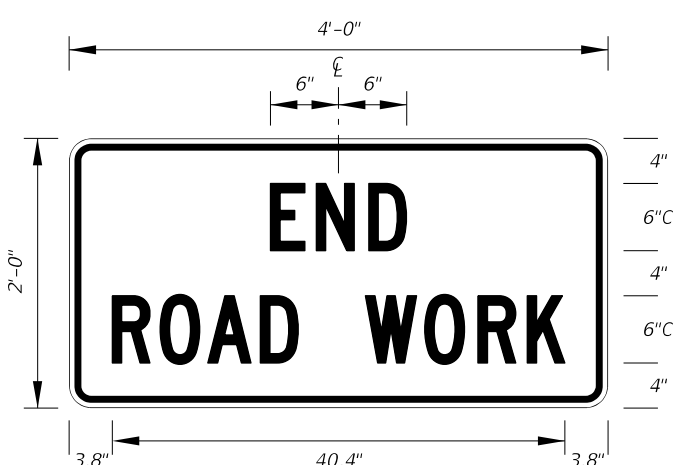


**G20-2**  
2' X 4'  
1.5" Radii 3/4" Border

Orange Background  
Black Legend and Border

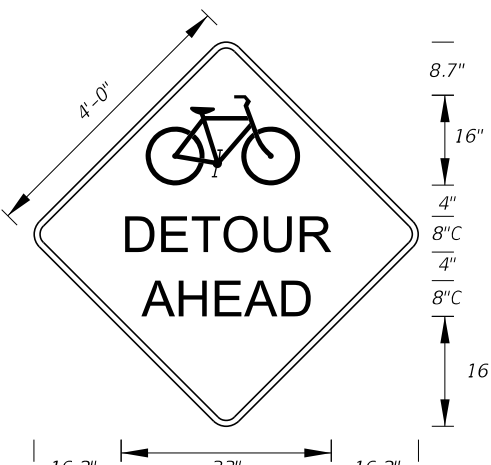


**MOT-20-21**  
4' X 4'  
3" Radii 3/4" Border

8" Series C Legend  
Orange Background  
Black Legend and Border

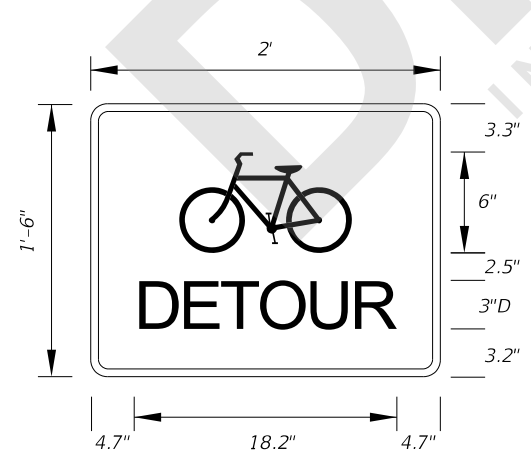


**MOT-21-21**  
2' X 1'-6"  
1.5" Radii 1/2" Border

3" Series D Legend  
Orange Background  
Black Legend and Border

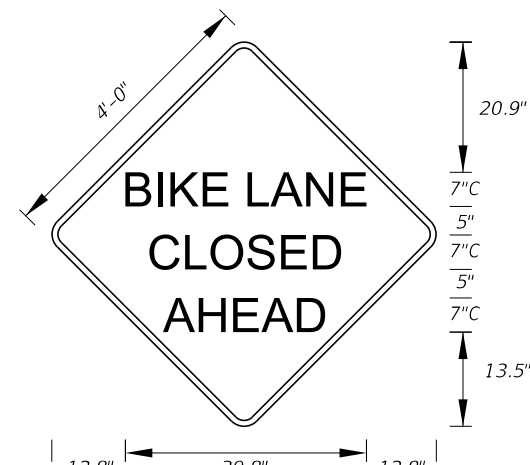

**MOT-22-21**  
4' X 4'  
3" Radii 3/4" Border

7" Series C Legend  
Orange Background  
Black Legend and Border

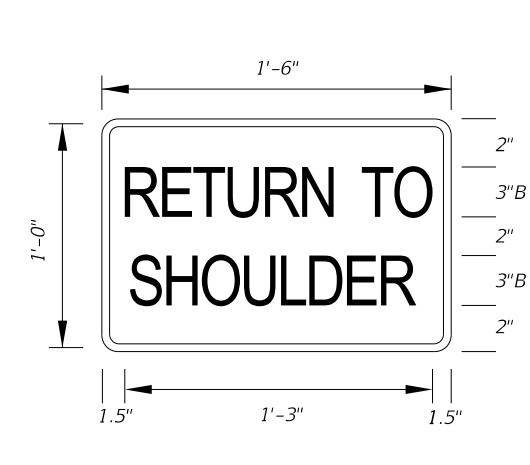

**MOT-23-21**  
1'-6" x 1'-0"  
1.5" Radii 1/4" Border

3" Series B Legend  
Orange Background  
Black Legend and Border

8/28/2020 6:34:52 AM

LAST REVISION	11/01/20	REVISION	DESCRIPTION:
---------------	----------	----------	--------------