

---

## ORIGINATION FORM

---

Proposed Revisions to a Standard Plans Index  
(Please provide all information — Incomplete forms will be returned)

**Contact Information:**

Date: July 26, 2020  
Originator: Richard Stepp  
Phone: (850) 414-4313  
Email: richard.stepp@dot.state.fl.us

**Standard Plans:**

Index Number: 715-002  
Sheet Number (s): 1  
Index Title: Conventional Lighting

**Summary of the changes:**

Sheet 2: Clarified that lower luminaire mounting heights of 20' and 25' are for wildlife-sensitive only

**Commentary / Background:**

Clarification added due to consultant question on recently added mounting heights

**Other Affected Offices / Documents:** (Provide name of person contacted)

Yes	No	
<input type="checkbox"/>	<input checked="" type="checkbox"/>	Other Standard Plans –
<input type="checkbox"/>	<input checked="" type="checkbox"/>	FDOT Design Manual –
<input type="checkbox"/>	<input checked="" type="checkbox"/>	Basis of Estimates Manual –
<input type="checkbox"/>	<input checked="" type="checkbox"/>	Standard Specifications –
<input type="checkbox"/>	<input checked="" type="checkbox"/>	Approved Product List –
<input type="checkbox"/>	<input checked="" type="checkbox"/>	Construction –
<input type="checkbox"/>	<input checked="" type="checkbox"/>	Maintenance –

**Origination Package Includes:**

(Email or hand deliver package to Rick Jenkins)

Yes	N/A	
<input checked="" type="checkbox"/>	<input type="checkbox"/>	Redline Mark-ups
<input type="checkbox"/>	<input type="checkbox"/>	Proposed Standard Plan Instruction (SPI)
<input type="checkbox"/>	<input type="checkbox"/>	Revised SPI
<input type="checkbox"/>	<input type="checkbox"/>	Other Support Documents


**Implementation:**

<input type="checkbox"/>	Design Bulletin (Interim)
<input type="checkbox"/>	DCE Memo
<input type="checkbox"/>	Program Mgmt. Bulletin
<input checked="" type="checkbox"/>	FY-Standard Plans (Next Release)

---

Contact the Roadway Design Office for assistance in completing this form


---

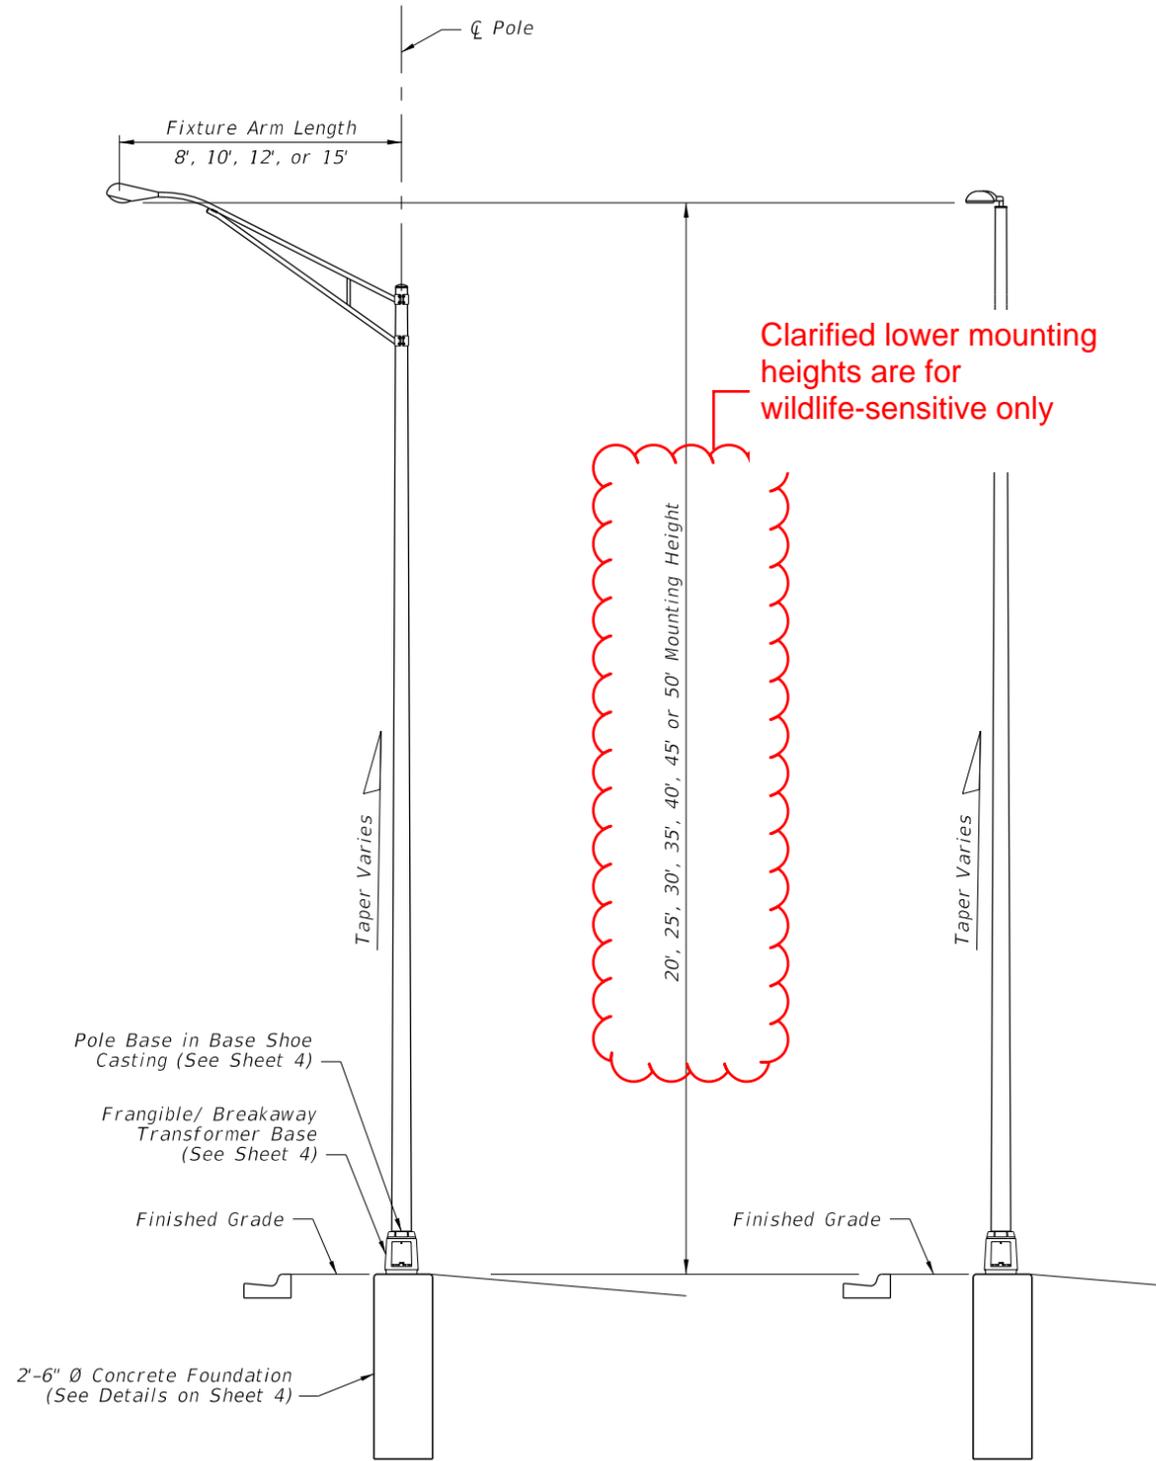


STANDARD ROADWAY ALUMINUM LIGHT POLE W/ARM

Clarified lower mounting heights are for wildlife-sensitive only

20', 25', 30', 35', 40', 45' or 50' Mounting Height

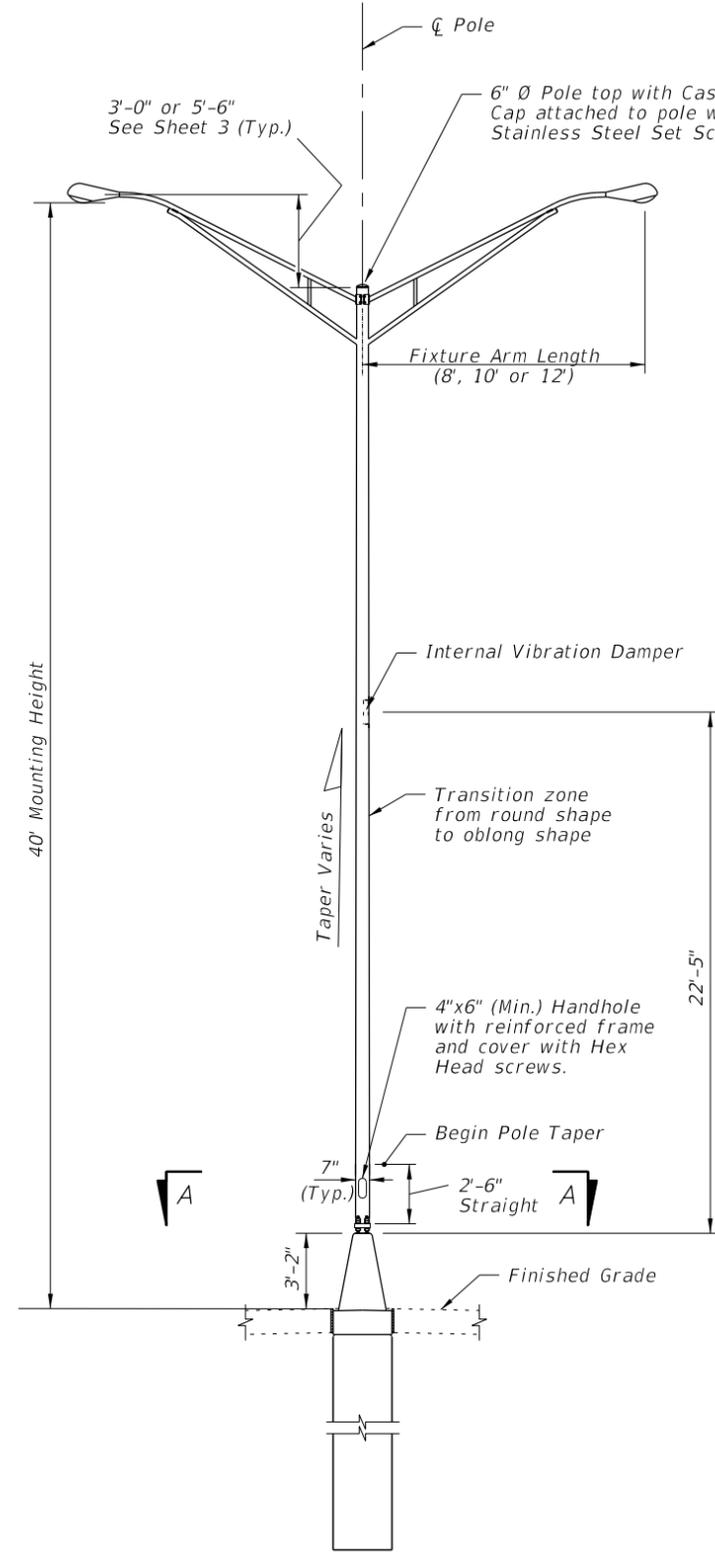


MEDIAN BARRIER MOUNTED ALUMINUM LIGHT POLE ON CYLINDRICAL FOUNDATION

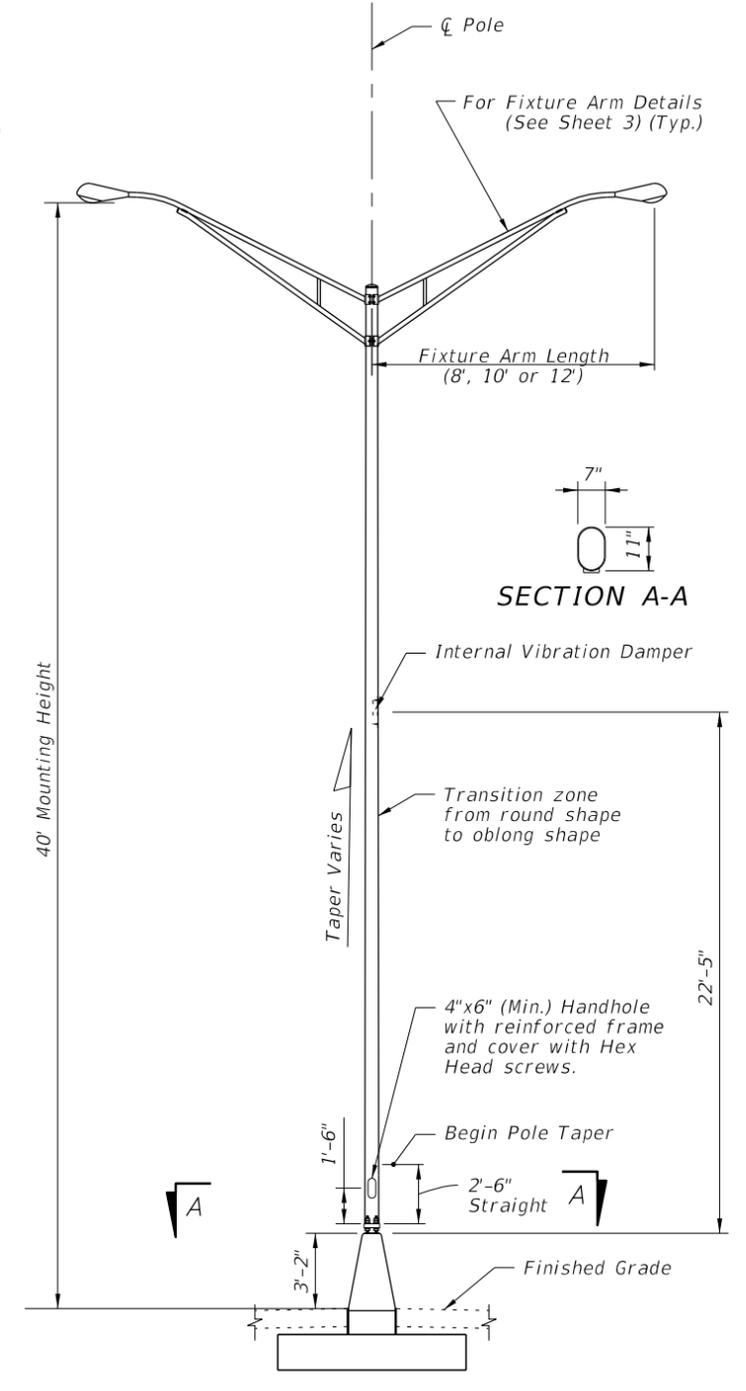

MEDIAN BARRIER MOUNTED ALUMINUM LIGHT POLE ON SPREAD FOOTING FOUNDATION

SECTION A-A

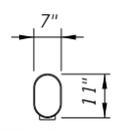

ELEVATIONS


10/14/2019 2:49:14 PM

LAST REVISION	DESCRIPTION:
<del>11/01/19</del>	11/01/20



 FY 2020-21  
 STANDARD PLANS

STANDARD ALUMINUM LIGHTING


INDEX	SHEET
715-002	2 of 8

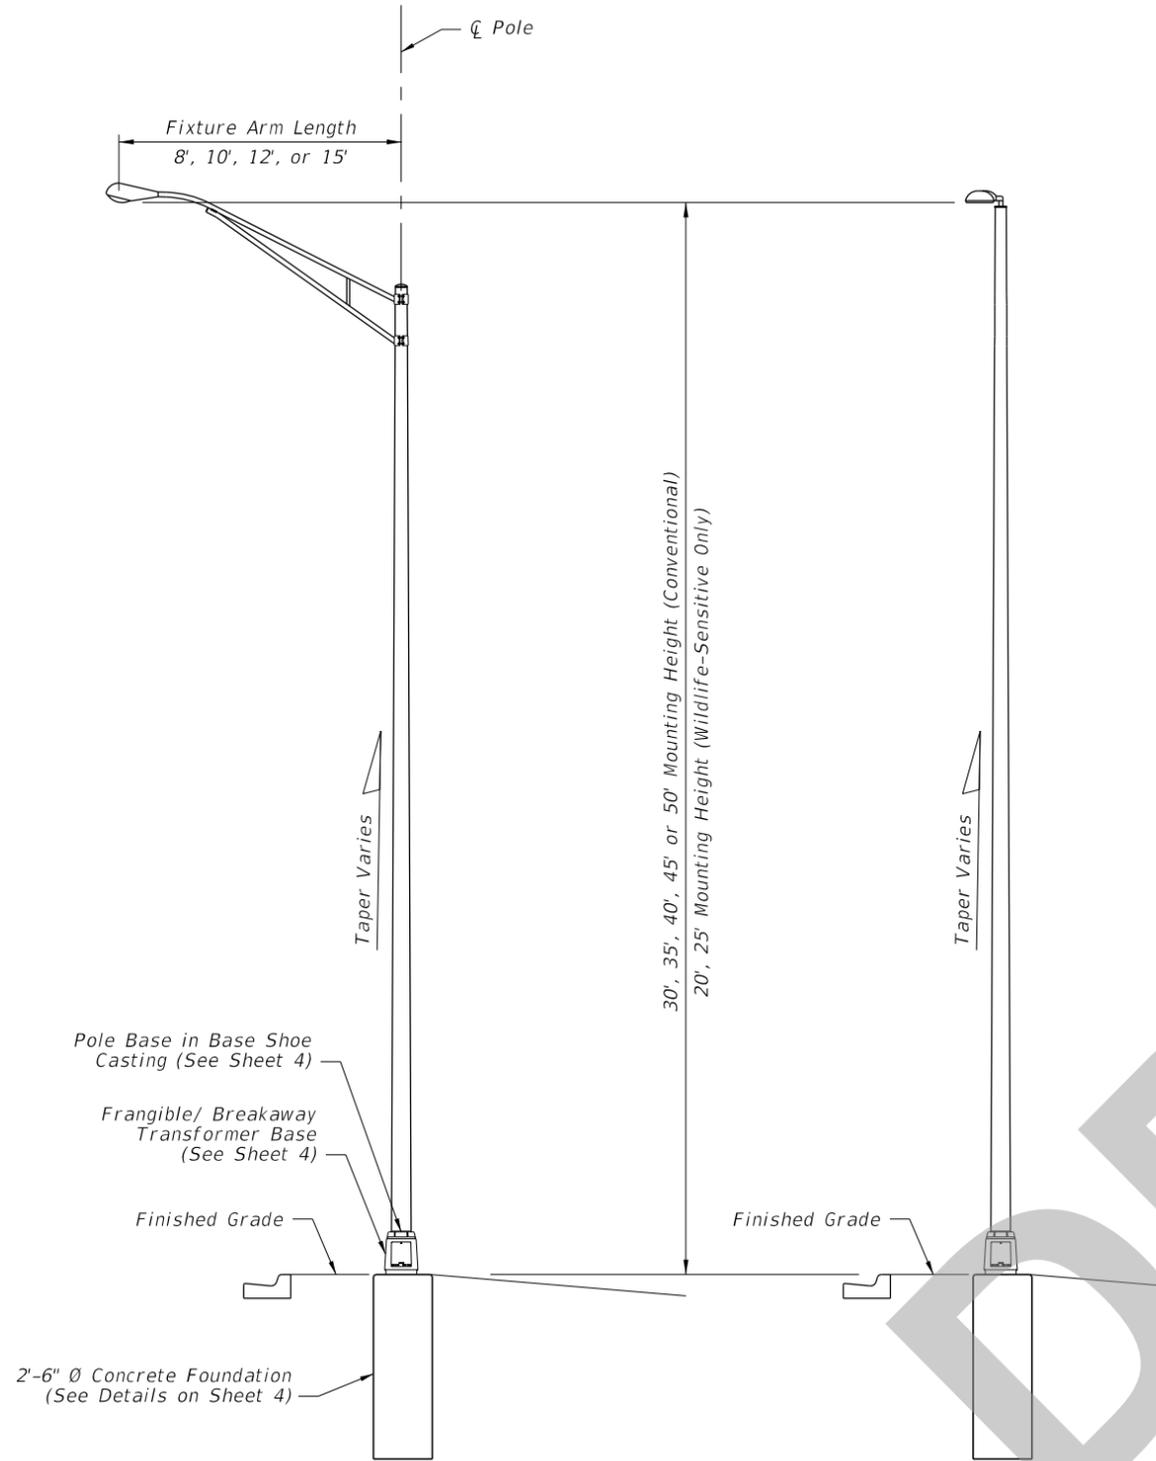

STANDARD ROADWAY  
ALUMINUM LIGHT POLE  
W/ARM

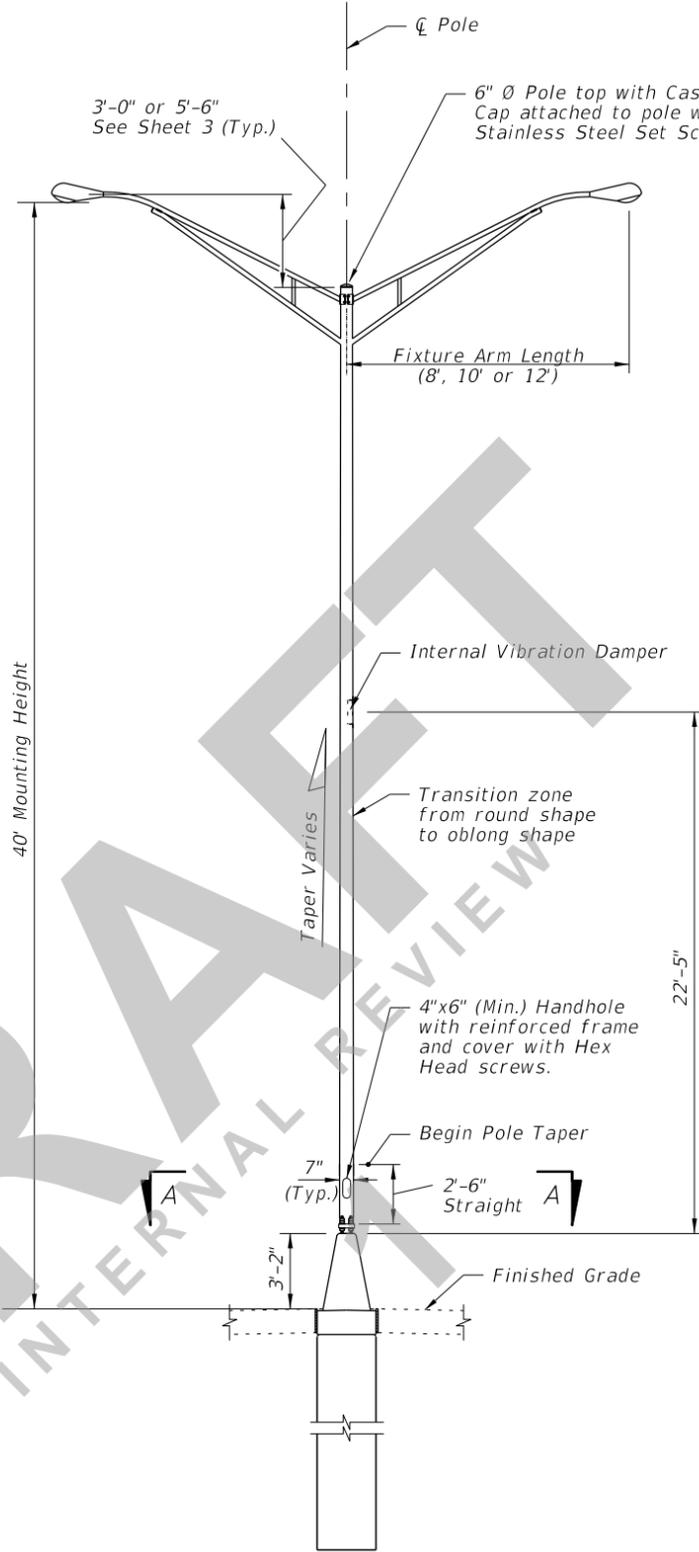


STANDARD ROADWAY  
ALUMINUM LIGHT POLE  
W/TOP MOUNT

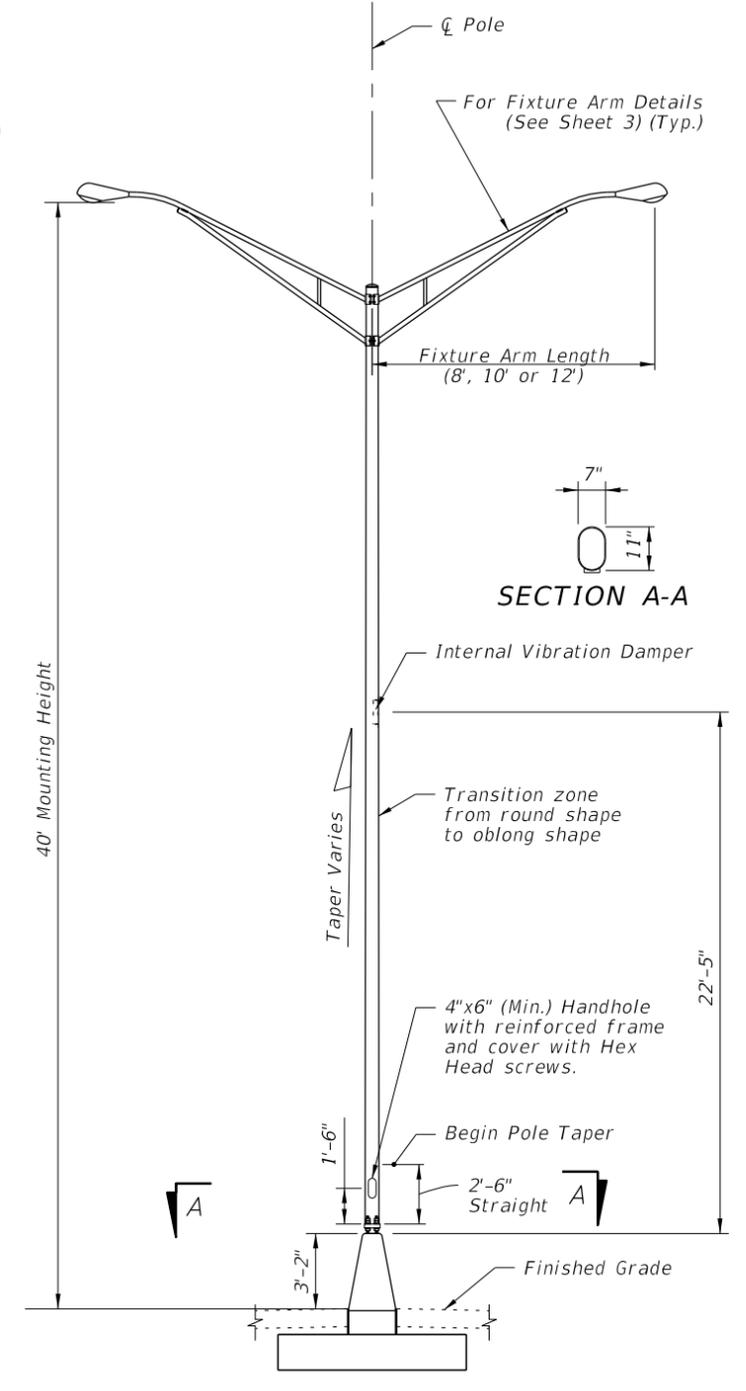

MEDIAN BARRIER MOUNTED ALUMINUM LIGHT POLE  
ON CYLINDRICAL FOUNDATION

MEDIAN BARRIER MOUNTED ALUMINUM LIGHT POLE  
ON SPREAD FOOTING FOUNDATION

SECTION A-A

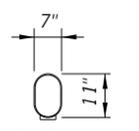

8/7/2020 6:35:53 PM

LAST REVISION 11/01/20	DESCRIPTION:
---------------------------	--------------


**FY 2021-22  
STANDARD PLANS**

**STANDARD ALUMINUM LIGHTING**

INDEX 715-002	SHEET 2 of 8
------------------	-----------------

**ELEVATIONS**