
ORIGINATION FORM

Proposed Revisions to a Standard Plans Index
(Please provide all information — Incomplete forms will be returned)

Contact Information:

Date: July 20, 2020
Originator: Cheryl Hudson & Ge Wan
Phone: 414-5332
Email: Cheryl.hudson@dot.state.fl.us

Standard Plans:

Index Number: 715-010
Sheet Number (s): 3
Index Title: High Mast Light Pole

Summary of the changes:

Change weld on Handhole

Commentary / Background:

Change weld to meet current criteria as requested by industry.

Other Affected Offices / Documents: (Provide name of person contacted)

Yes	No	
☐	☒	Other Standard Plans –
☐	☒	FDOT Design Manual –
☐	☒	Basis of Estimates Manual –
☐	☒	Standard Specifications –
☐	☒	Approved Product List –
☐	☒	Construction –
☐	☒	Maintenance –

Origination Package Includes:

(Email or hand deliver package to Rick Jenkins)









Yes	N/A	
☒	☐	Redline Mark-ups
☐	☐	Proposed Standard Plan Instruction (SPI)
☐	☐	Revised SPI
☐	☐	Other Support Documents

Implementation:

☐ Design Bulletin (Interim)
☐ DCE Memo
☐ Program Mgmt. Bulletin
☒ FY-Standard Plans (Next Release)









Contact the Roadway Design Office for assistance in completing this form

10/14/2019 2:49:44 PM

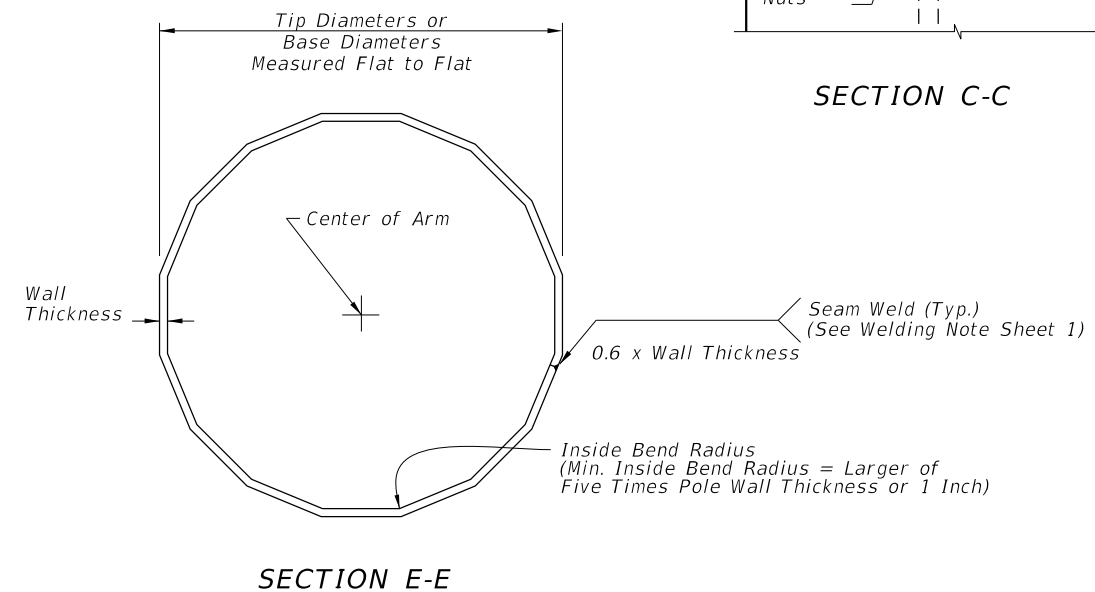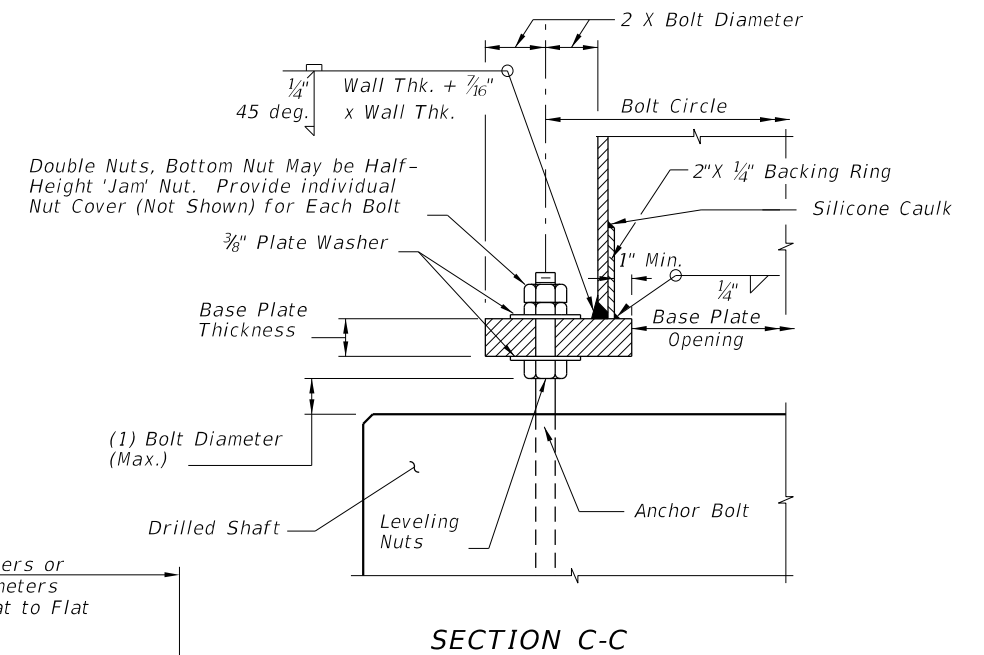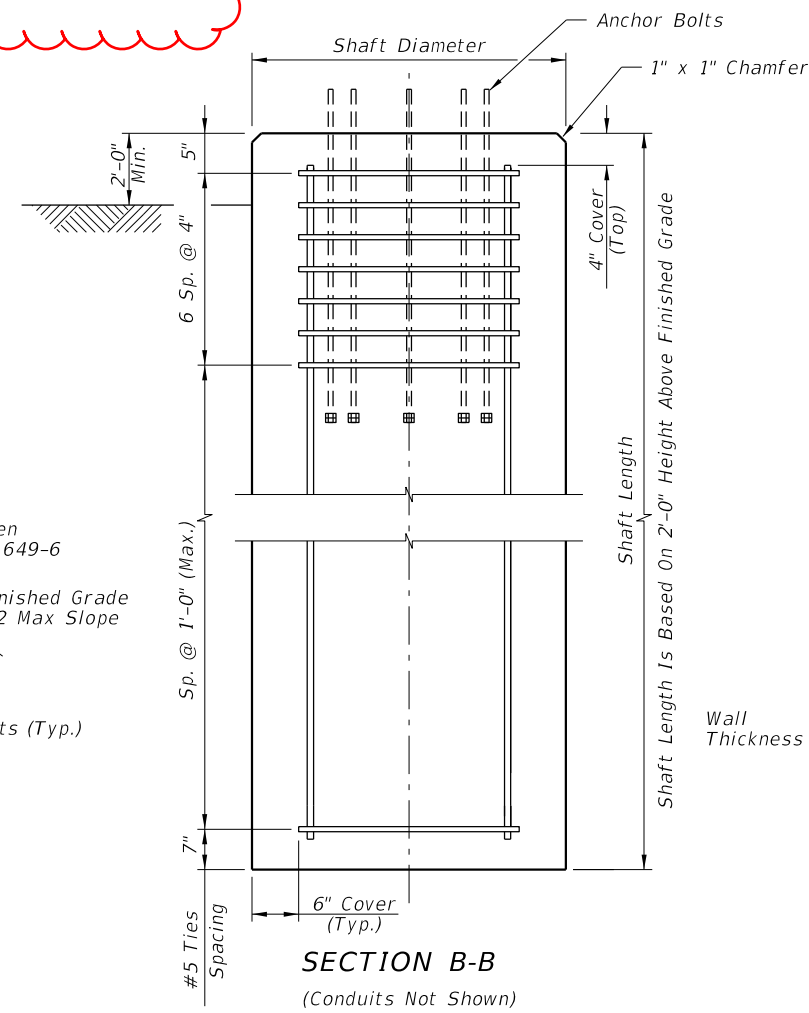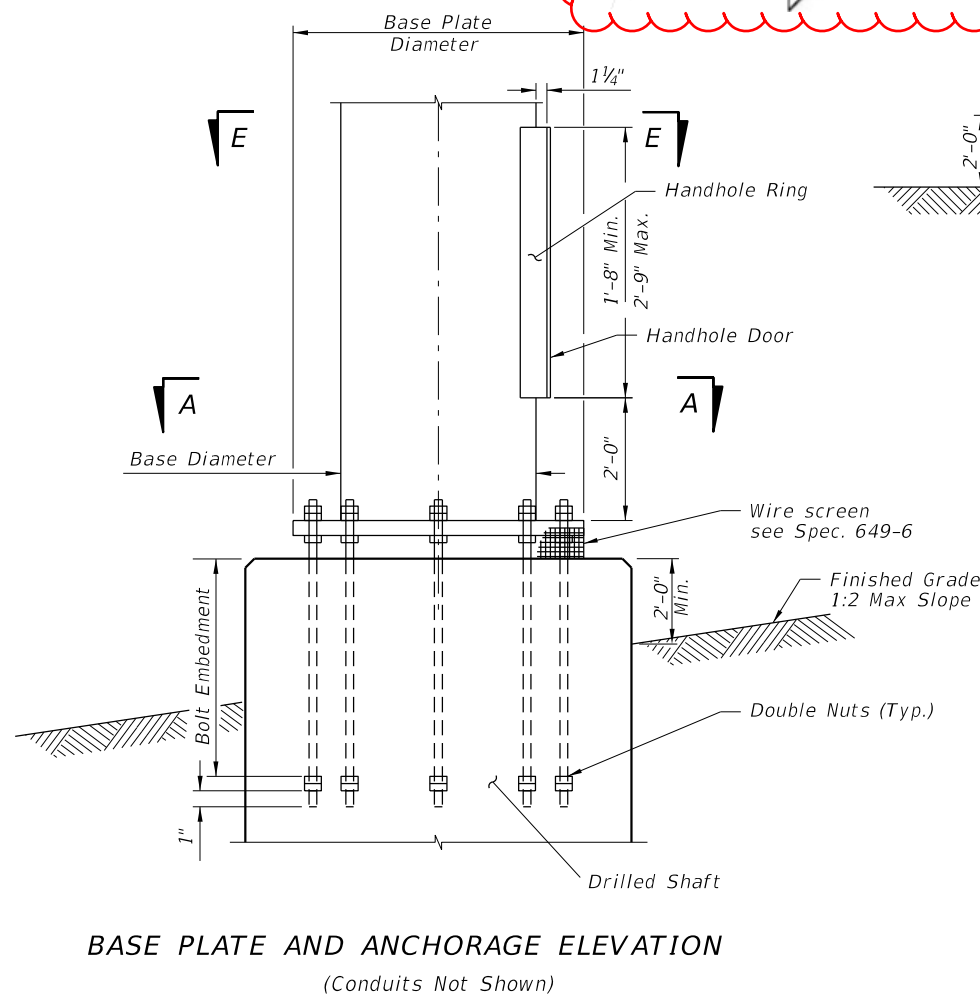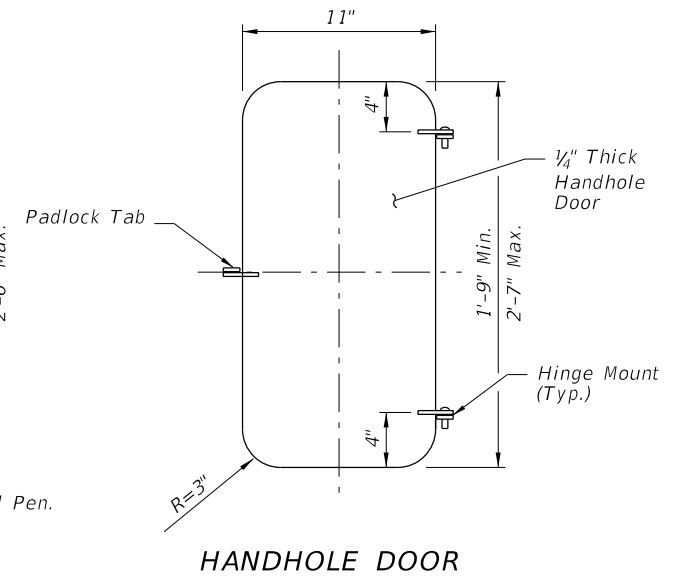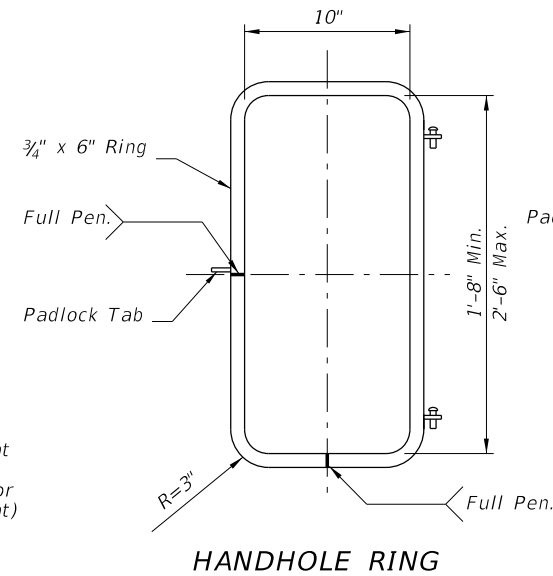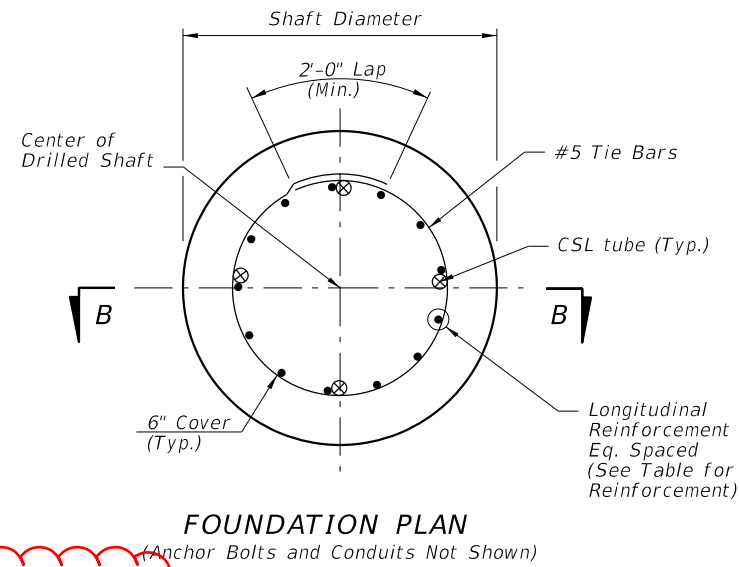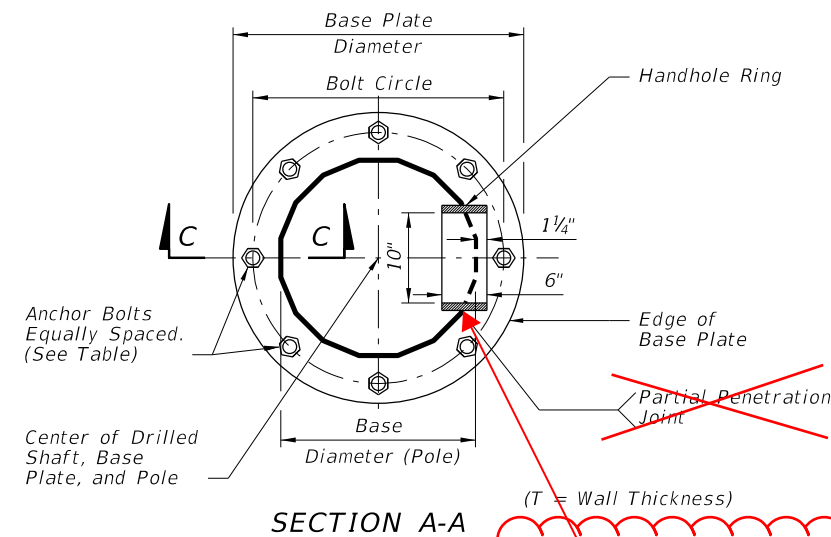

POLE FOUNDATION

LAST REVISION	DESCRIPTION:	FY 2020-21 STANDARD PLANS	HIGH MAST LIGHTING	INDEX	SHEET
11/01/19				715-010	3 of 6

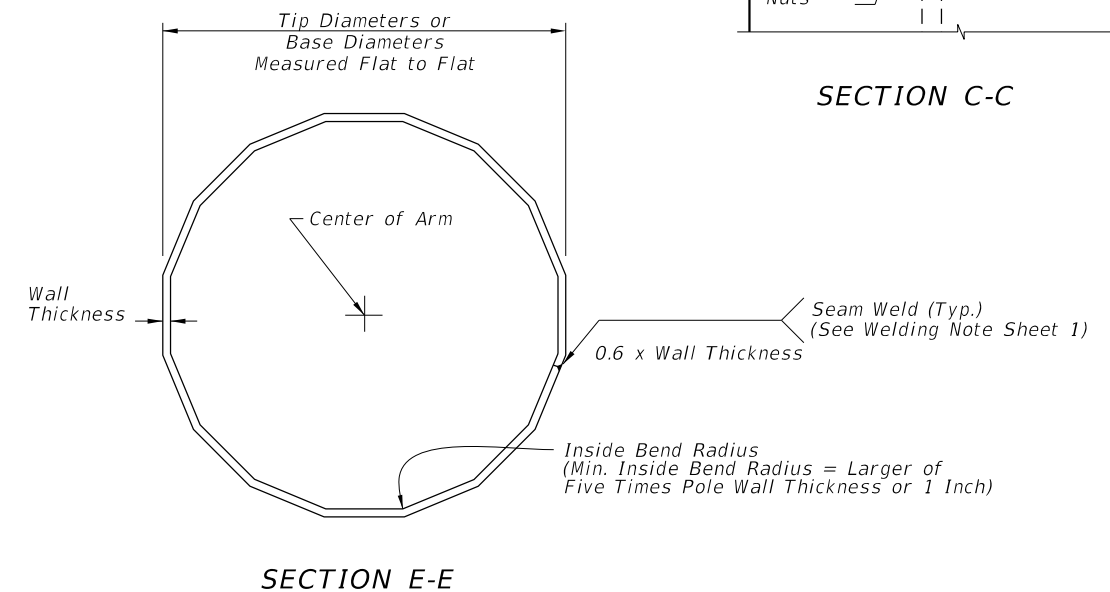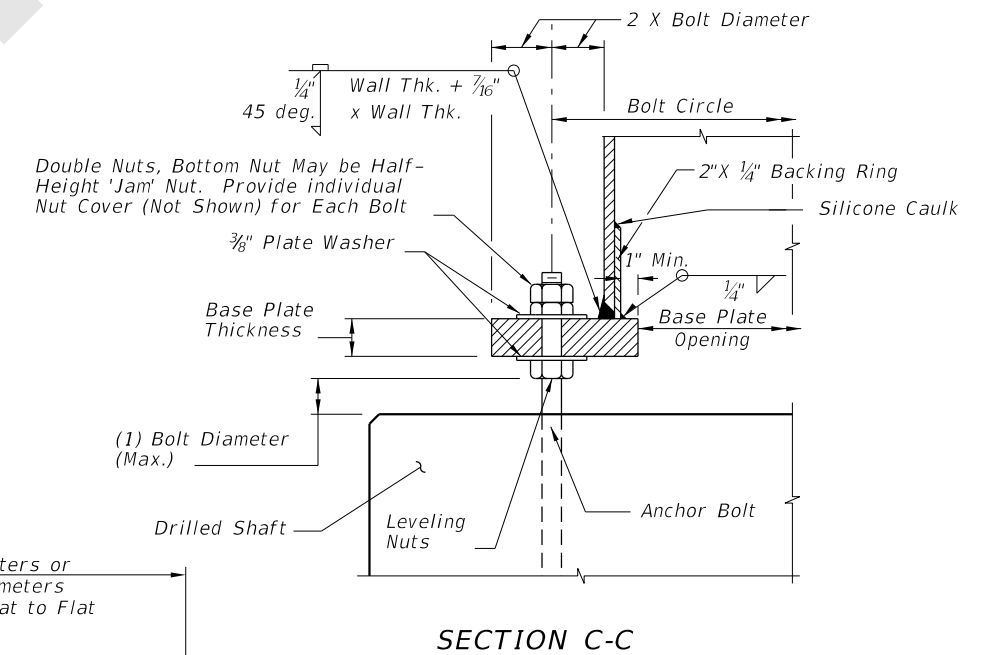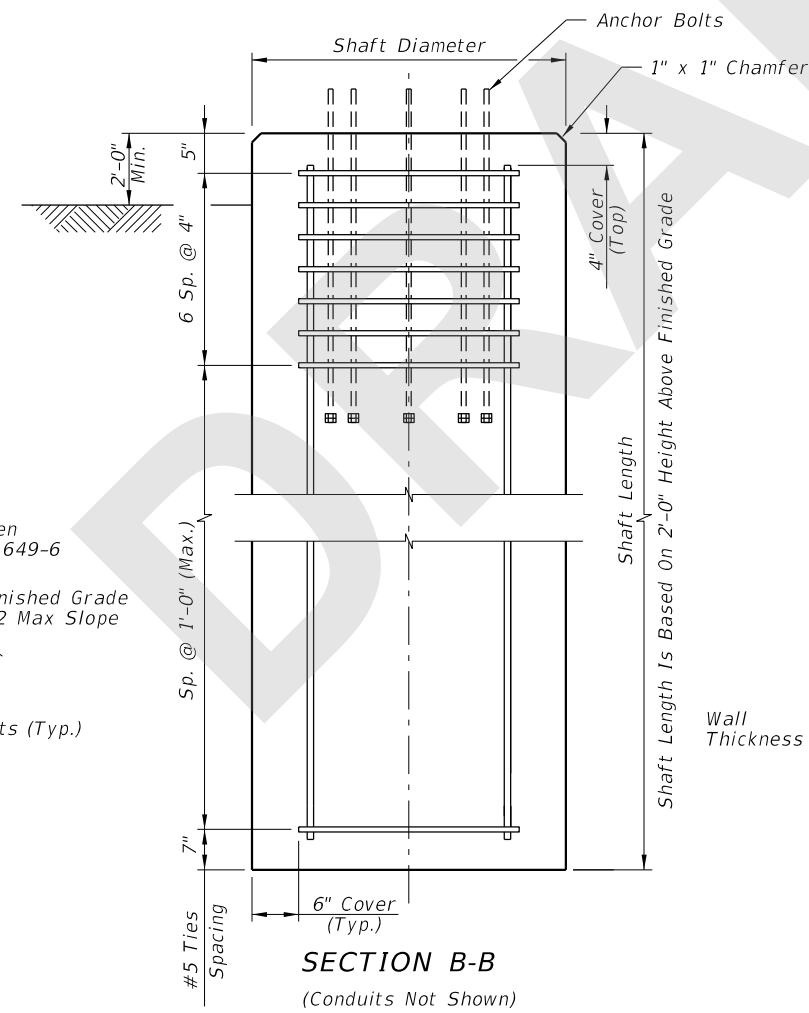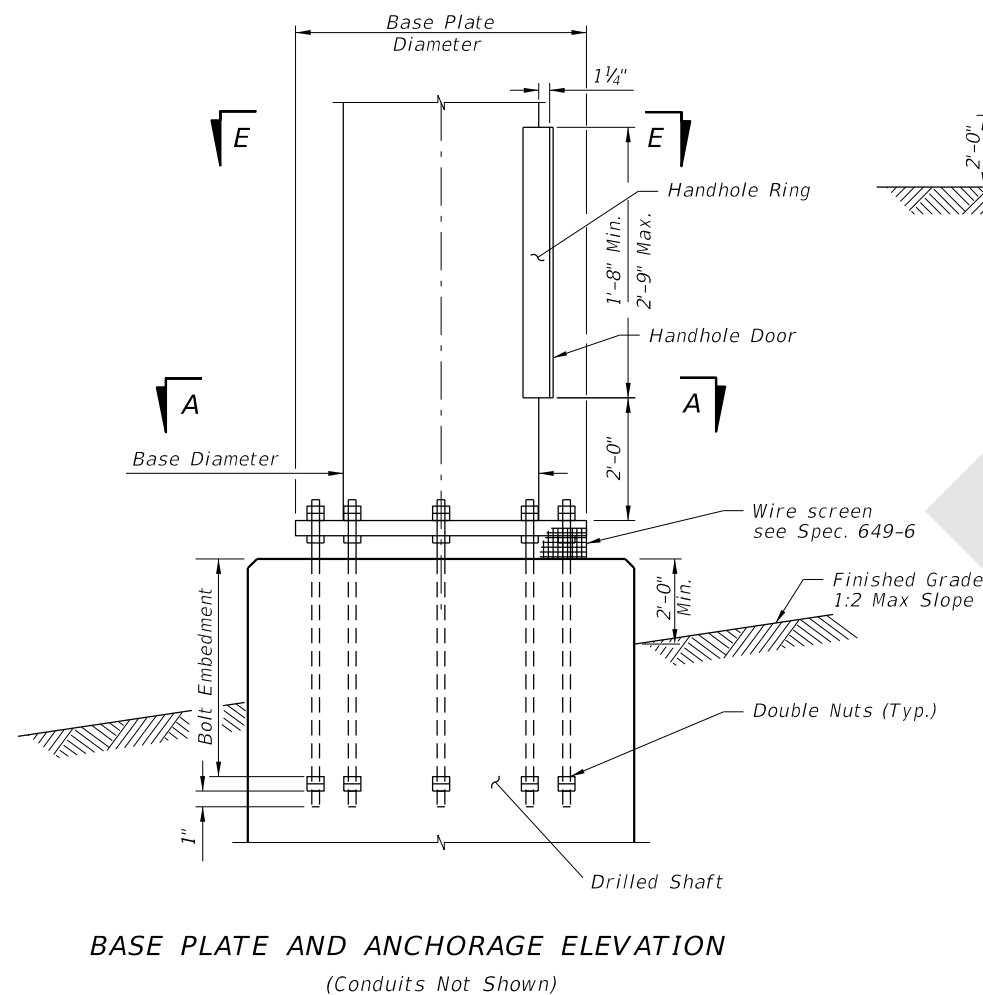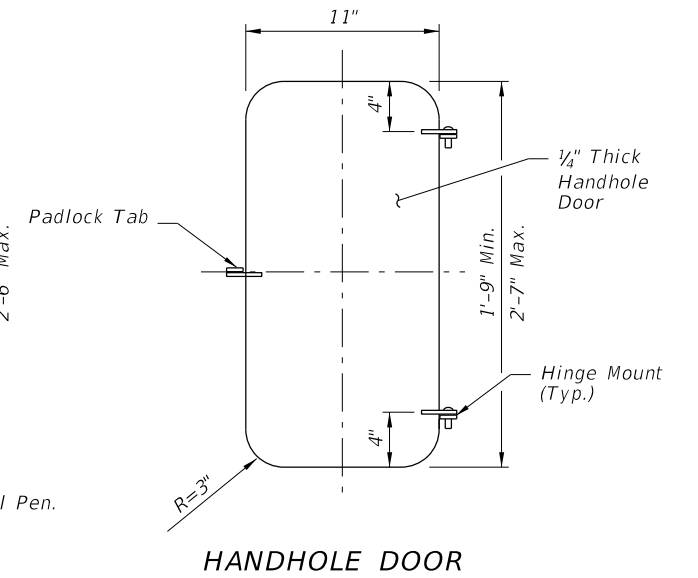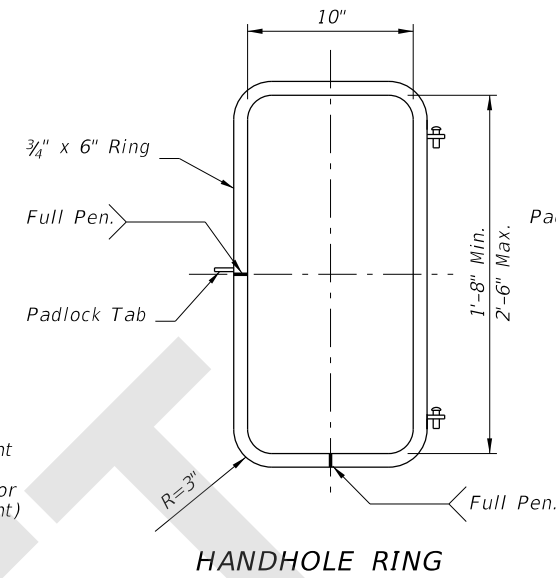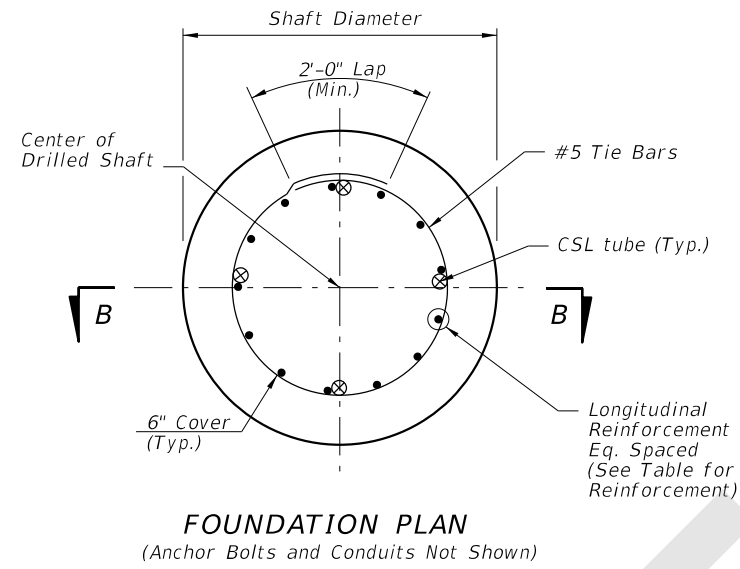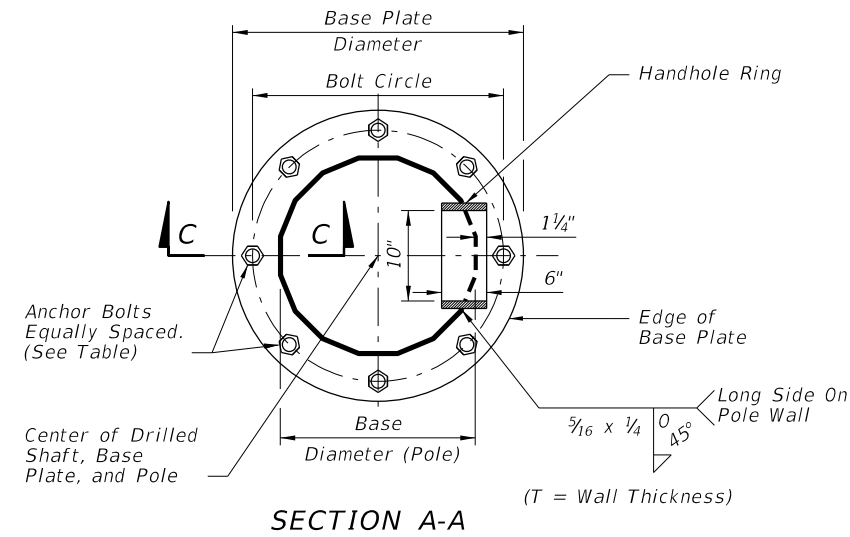

POLE FOUNDATION

7/31/2020 9:13:00 AM

LAST REVISION	DESCRIPTION:	FY 2021-22 STANDARD PLANS	HIGH MAST LIGHTING	INDEX	SHEET
11/01/20				715-010	3 of 6