ORIGINATION FORM -

Proposed Revisions to a Standard Plans Index


(Please provide all information — Incomplete forms will be returned)


Contact Information: Standard Plans: Index Number: 425-070 Date: November 1, 2019 Sheet Number (s): ALL Originator: Rick Jenkins Index Title: Skimmer for Outlet Control Structures Phone: (850) 414-4355 Email: Rick.Jenkins@dot.state.fl.us **Summary of the changes:** Reorganized Index, Added additional Sheets. Sheet 1: General Notes Sheet 2: Panel and Flat Bar Details Sheet 3: Installation Details **Commentary / Background:** Reorganized Details and Sheets to declutter Index. Moved information from detail callouts to Notes in order to decrease clutter of the drawing. Moved design information to SPI. Other Affected Offices / Documents: (Provide name of person contacted) Yes No Other Standard Plans – FDOT Design Manual -Basis of Estimates Manual -Standard Specifications -Approved Product List -Construction -Maintenance -**Origination Package Includes: Implementation:** Design Bulletin (Interim) (Email or hand deliver package to Rick Jenkins) ☐ DCE Memo Yes N/A \square Program Mgmt. Bulletin Redline Mark-ups FY-Standard Plans (Next Release) Proposed Standard Plan Instruction (SPI) **Revised SPI**


Contact the Roadway Design Office for assistance in completing this form

Other Support Documents


NEW SHEET ADDED GENERAL NOTES AND OVERVIEW

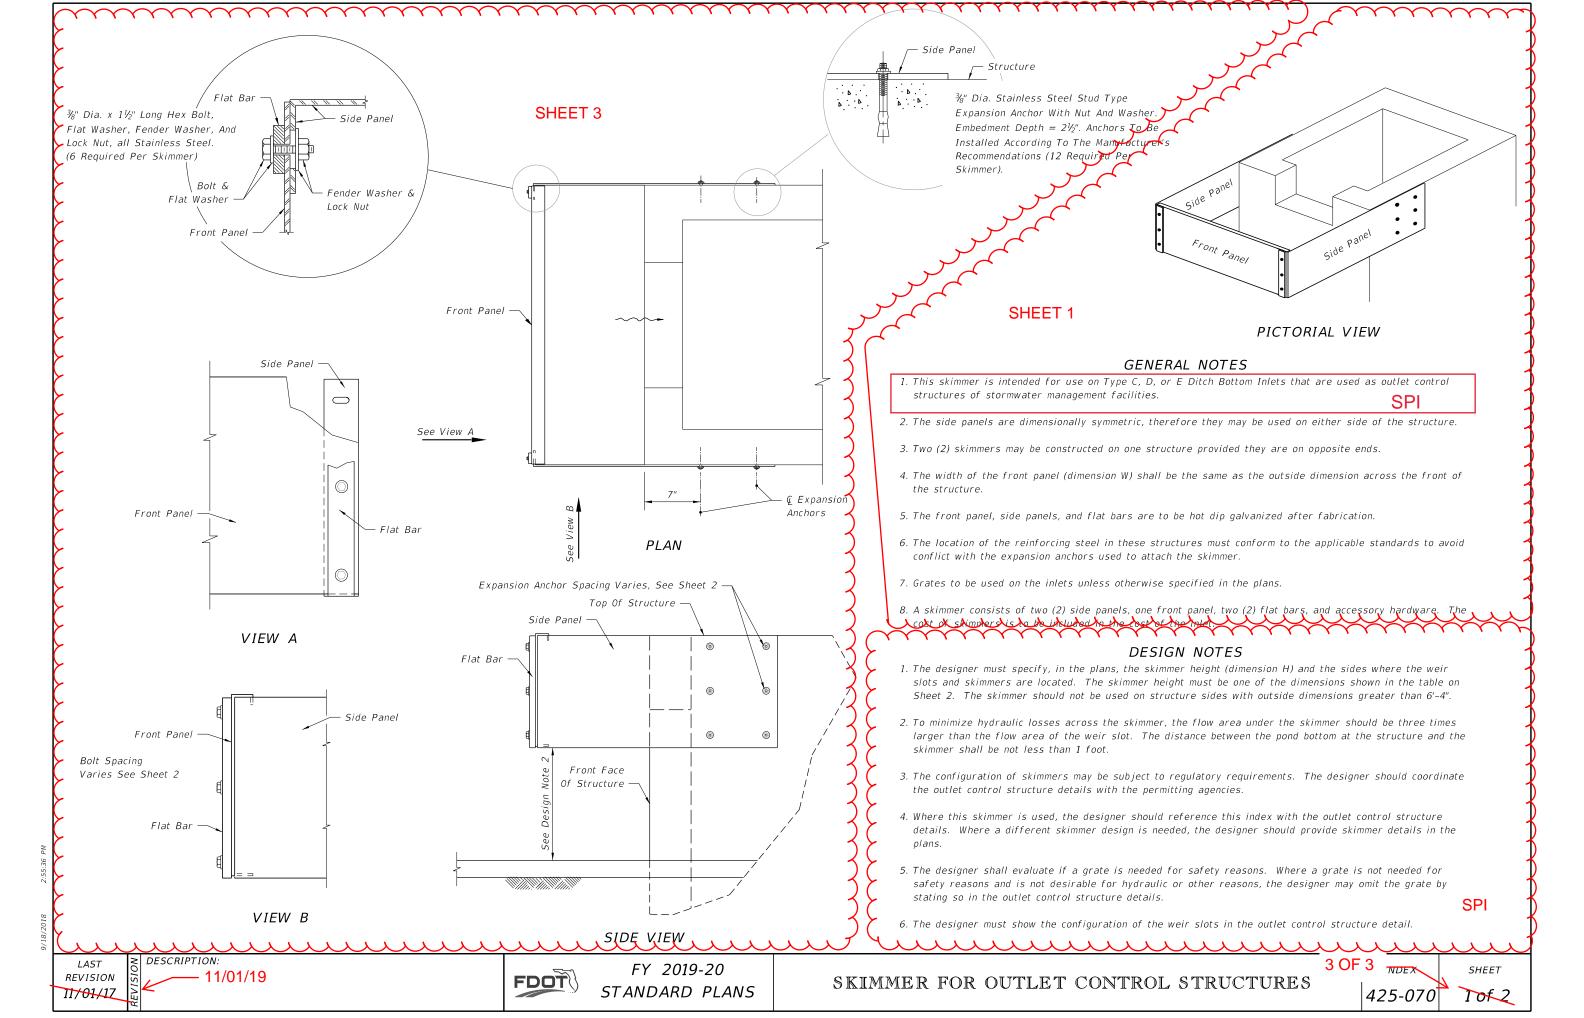

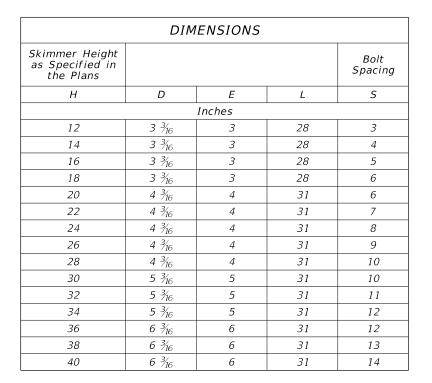


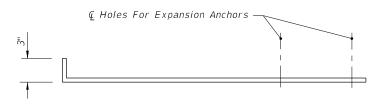

TOP VIEW

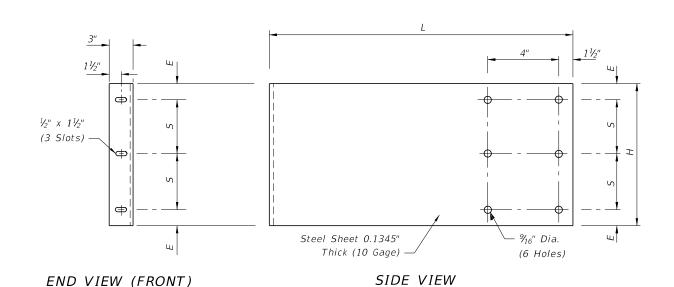


SIDE PANEL

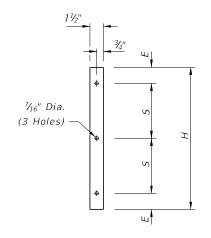

½" Thick x 1½" Wide

FLAT BAR

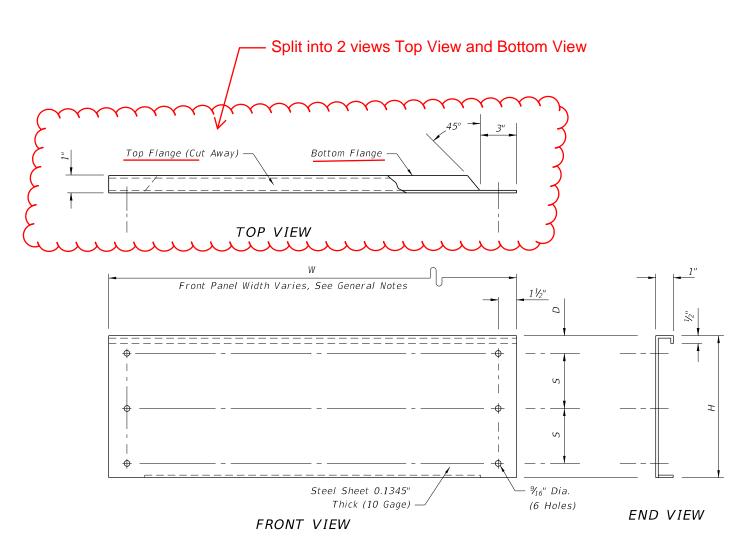

FRONT PANEL

Sheet 2 of 3

DESCRIPTION: REVISION - 11/01/19 11/01/17

FDOT

FY 2019-20 STANDARD PLANS

SKIMMER FOR OUTLET CONTROL STRUCTURES


INDEX 425-070

SHEET 2 of 2

GENERAL NOTES:

- 1. The side panels are dimensionally symmetric, and may be used on either side of the structure.
- 2. Two (2) skimmers may be installed on a single structure provided they are constructed on opposite ends.
- 3. The width of the front panel (dimension W) is equal to the same as the outside dimension across the front of the structure.
- 4. Hot dip galvanize the front panel, side panels, and flat bars after fabrication.
- 5. The location of the reinforcing steel in these structures must conform to the Index 425-052 to avoid conflict with the expansion anchors used to attach the skimmer.
- 6. Use grates on the inlets unless otherwise specified in the Plans.
- 7. A skimmer consists of two (2) side panels, one front panel, two (2) flat bars, and accessory hardware.


TABLE OF CONTENTS:	
Sheet	Description
1	General Notes and Contents
2	Panel and Flat Bar Details
3	Installation Details

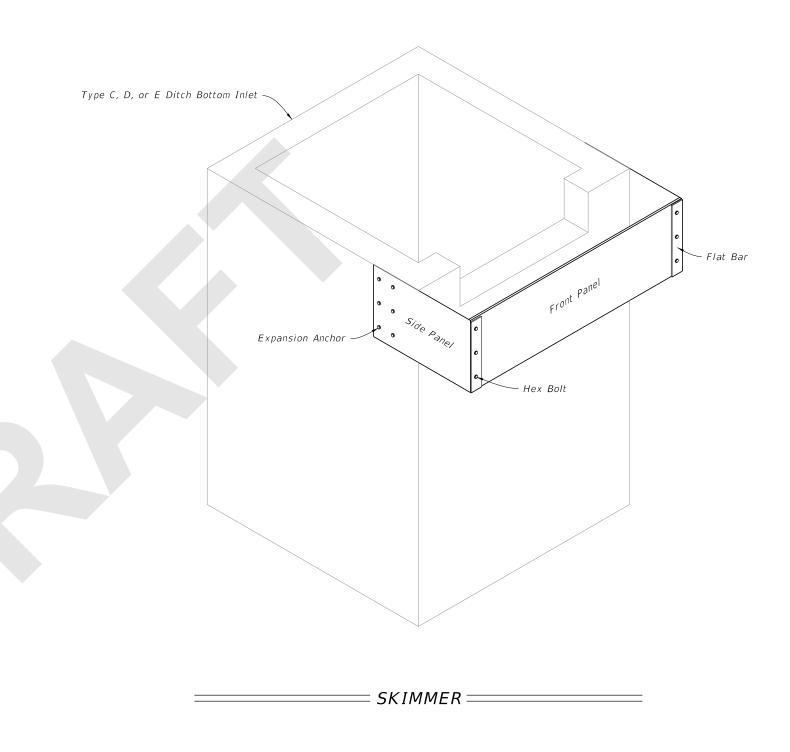


6:55:26 AM

LAST REVISION 11/01/20

≥ DESCRIPTION:

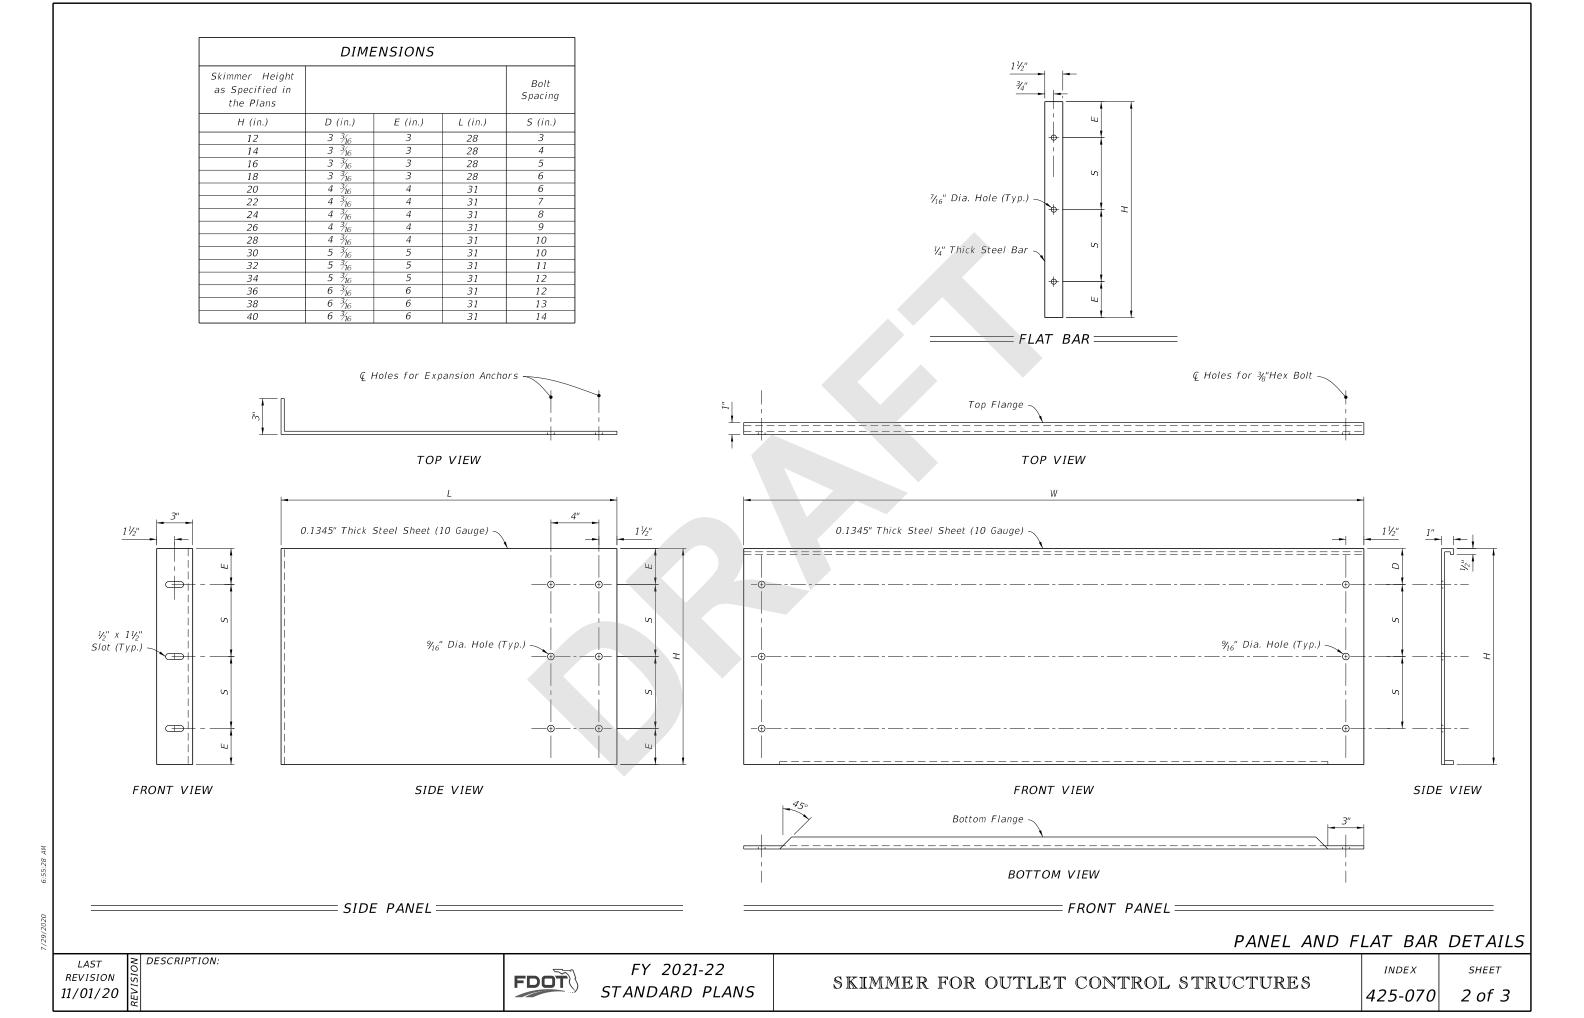

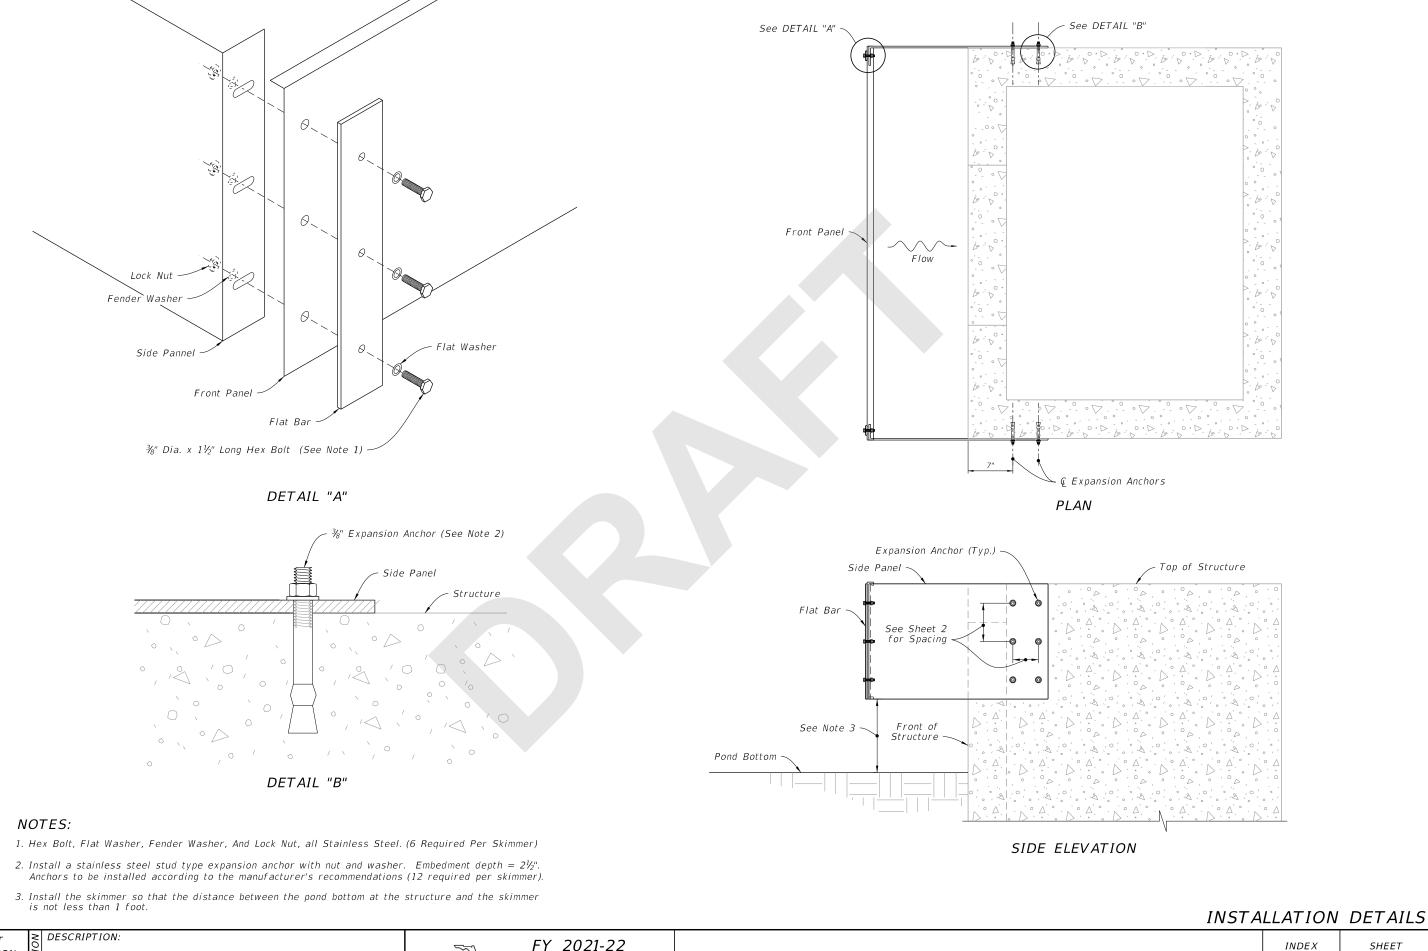

LAST REVISION 11/01/20