

---

## ORIGINATION FORM

---

### Proposed Revisions to a Standard Plans Index (Please provide all information — Incomplete forms will be returned)

**Contact Information:**

Date: July 10, 2020

Originator: Malcolm Tomatani

Phone: (850) 921-7305

Email: malcolm.tomatani@dot.state.fl.us

**Standard Plans:**

Index Number: 641-020

Sheet Number (s): 5 of 5

Index Title: Concrete CCTV Pole

**Summary of the changes:**

Sheet 5: Deleted the "Pole Plate With Stainless Steel Band" and Added new "Cabinet Adapter Bracket" shown in DETAIL "D" and the POLE MOUNTED CABINET detail.

The following subarticle will be added in the January 2021 SSRBC:

"676-2.5.9 Adapter Bracket: If shown in the plans, provide an adapter bracket for pole mounted cabinets that is slotted or otherwise designed to allow banding straps to be installed to avoid pole handholes."

Standard Index 641-020 will also reference the adapter bracket.

**Commentary / Background:**

The CCTV pole hand hole had been vertically elongated, however, the CCTV cabinet bracket locations remained the same. As a result, when mounted, the CCTV cabinet mounting straps partially cover the CCTV pole hand holes.

**Other Affected Offices / Documents:** (Provide name of person contacted)

Yes	No	
<input checked="" type="checkbox"/>	<input type="checkbox"/>	Other Standard Plans – Rick Jenkins
<input type="checkbox"/>	<input checked="" type="checkbox"/>	FDOT Design Manual –
<input type="checkbox"/>	<input checked="" type="checkbox"/>	Basis of Estimates Manual –
<input checked="" type="checkbox"/>	<input type="checkbox"/>	Standard Specifications – Daniel Strickland
<input type="checkbox"/>	<input checked="" type="checkbox"/>	Approved Product List –
<input type="checkbox"/>	<input checked="" type="checkbox"/>	Construction –
<input type="checkbox"/>	<input checked="" type="checkbox"/>	Maintenance –

**Origination Package Includes:**

(Email or hand deliver package to Rick Jenkins)

Yes	N/A	
<input checked="" type="checkbox"/>	<input type="checkbox"/>	Redline Mark-ups
<input type="checkbox"/>	<input checked="" type="checkbox"/>	Proposed Standard Plan Instruction (SPI)
<input type="checkbox"/>	<input checked="" type="checkbox"/>	Revised SPI
<input type="checkbox"/>	<input checked="" type="checkbox"/>	Other Support Documents








**Implementation:**

- Design Bulletin (Interim)
- DCE Memo
- Program Mgmt. Bulletin
- FY-Standard Plans (Next Release)

---



Contact the Roadway Design Office for assistance in completing this form

---

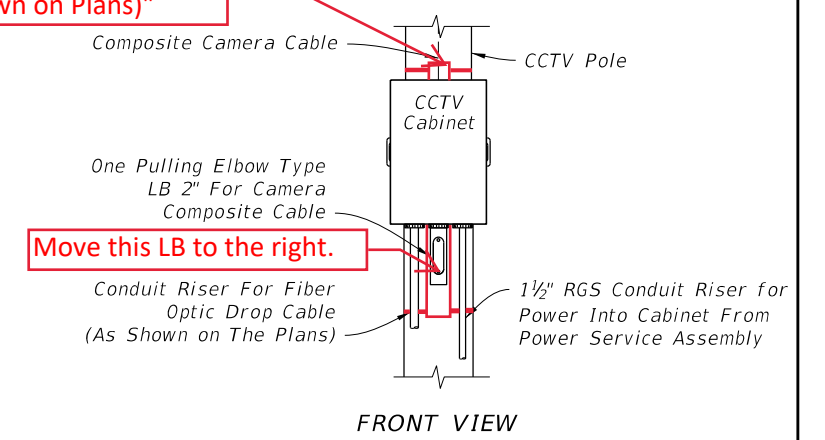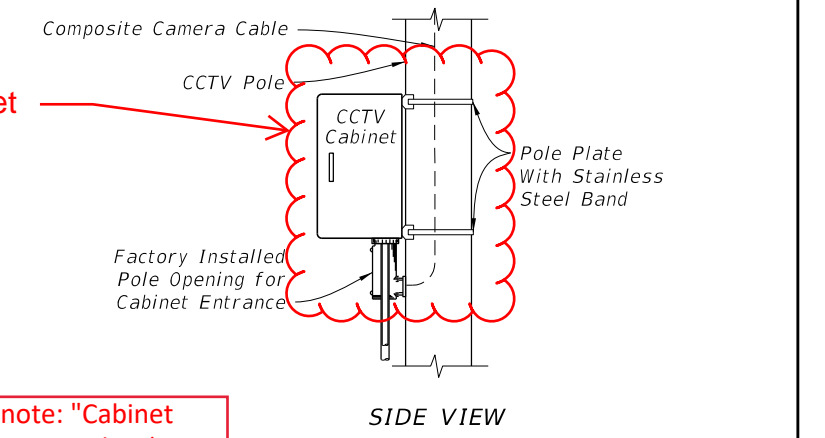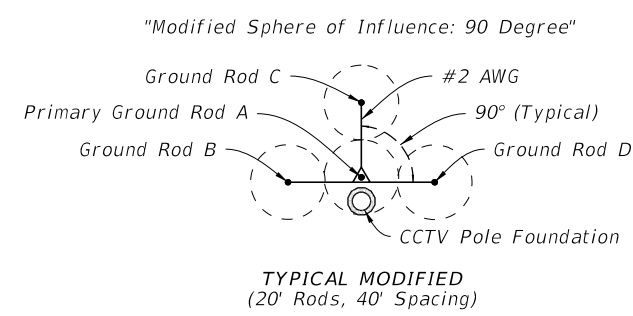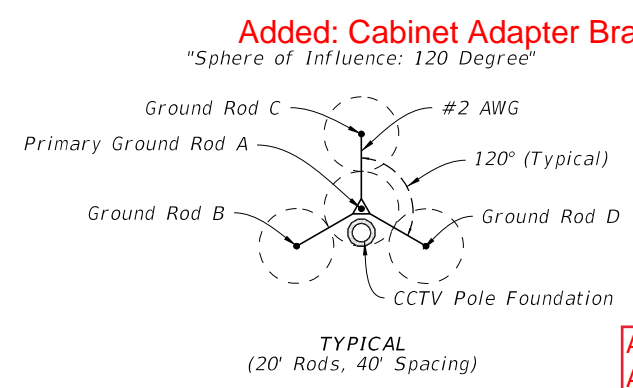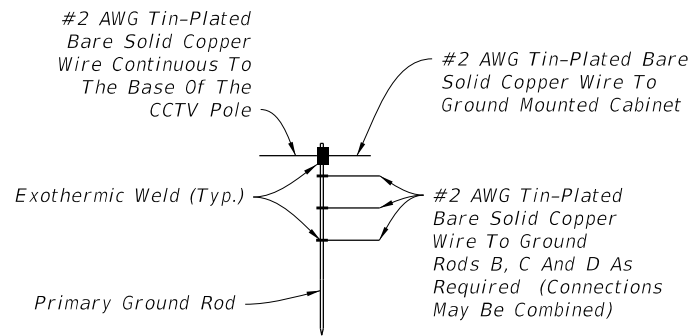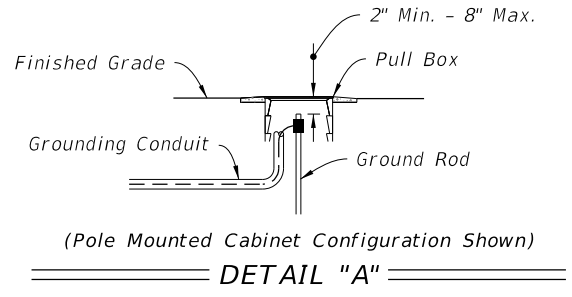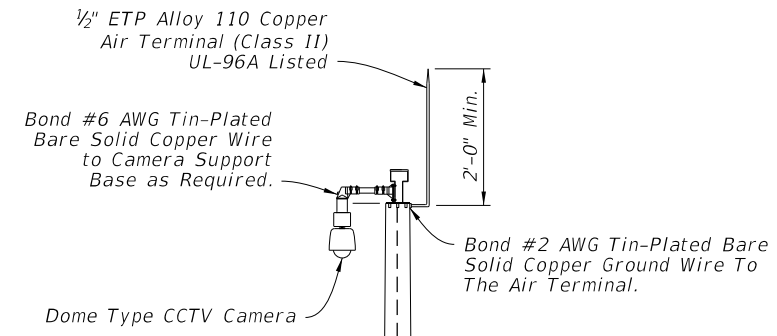

CCTV Pole (See Sheet 3)

#2 Wire may be Routed Internally or Externally In Accordance With The Plans

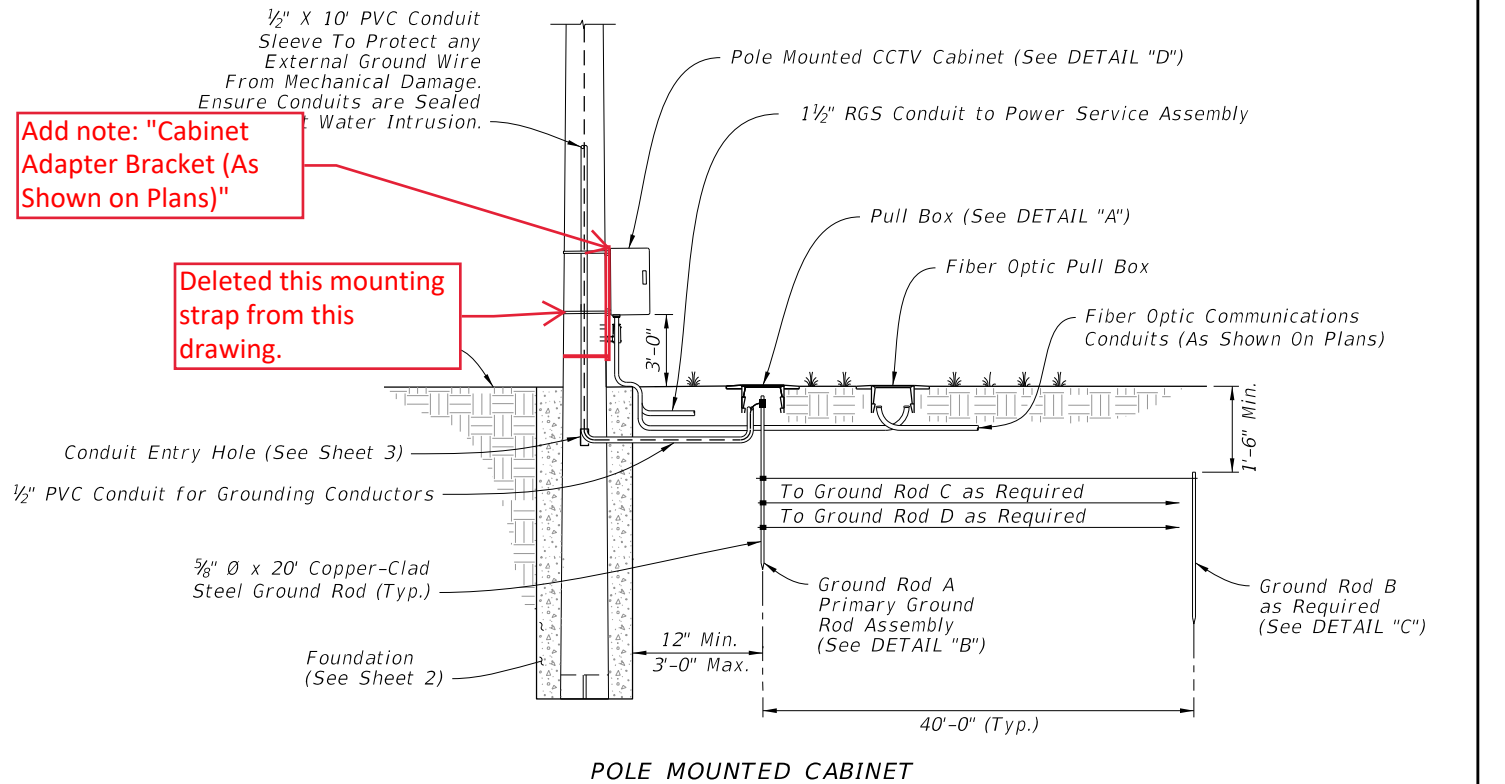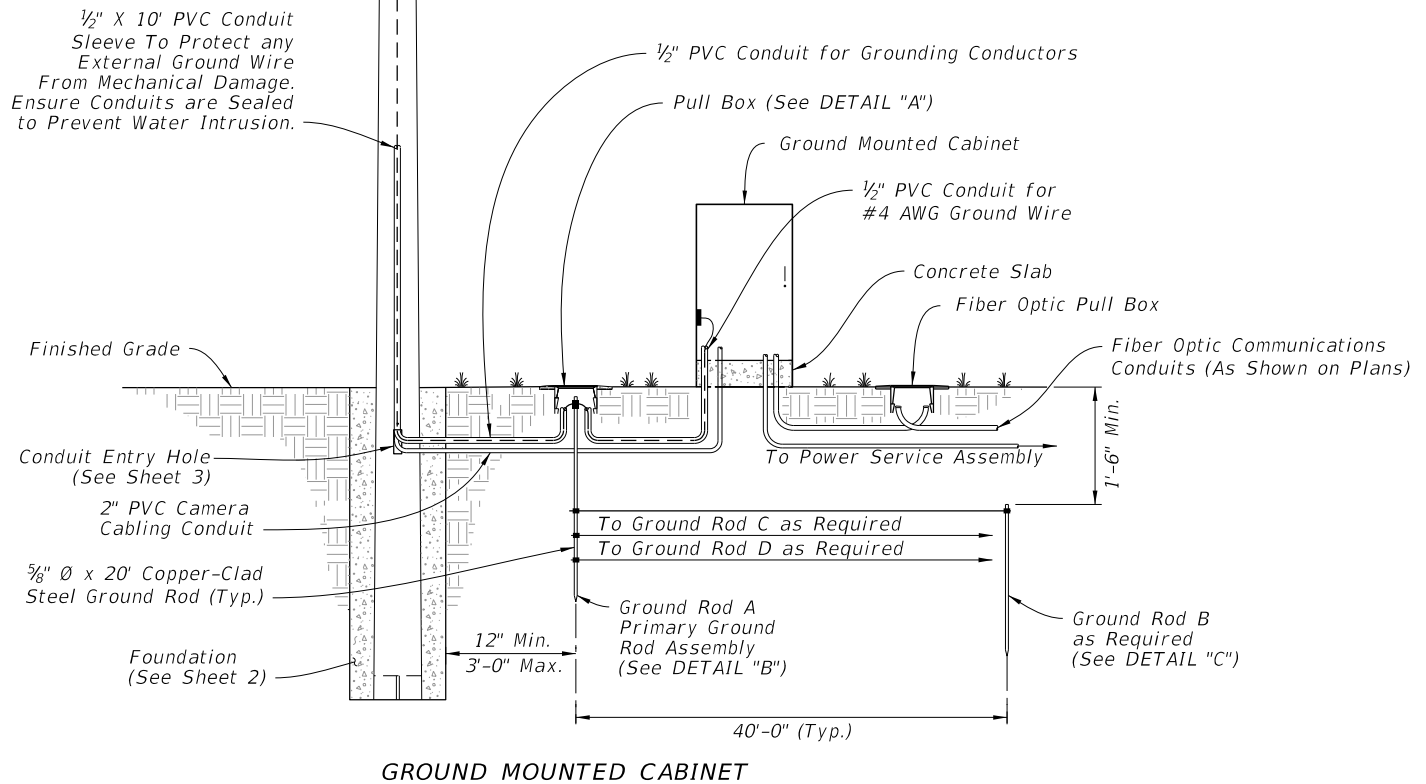

**Added note: "Cabinet Adapter Bracket (As Shown on Plans)"**









**Deleted this mounting strap from this drawing.**

**Add note: "Cabinet Adapter Bracket (As Shown on Plans)"**

**Move this LB to the right.**

LAST REVISION	DESCRIPTION:
11/01/17	11/01/20

10/14/2019 2:15:39 PM

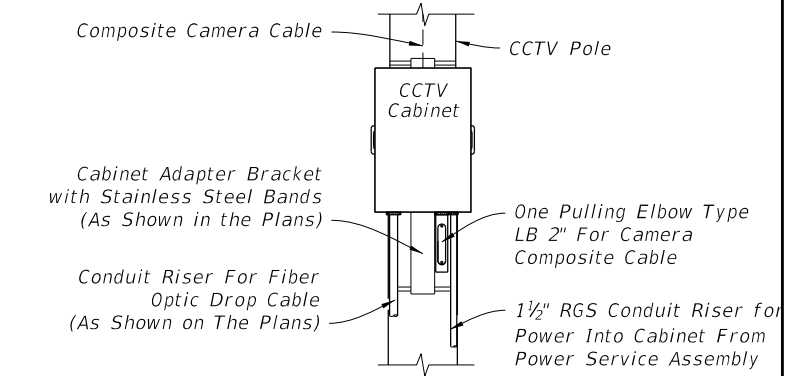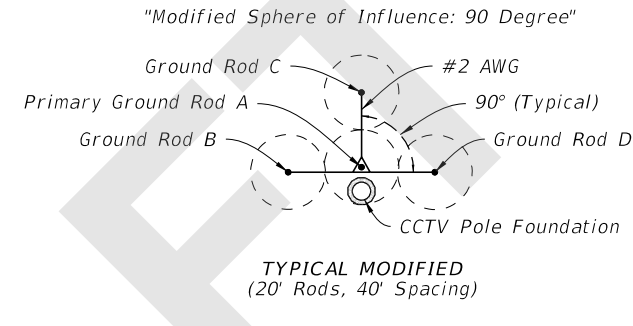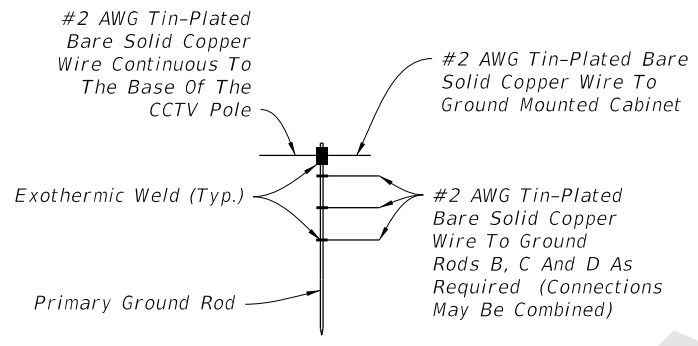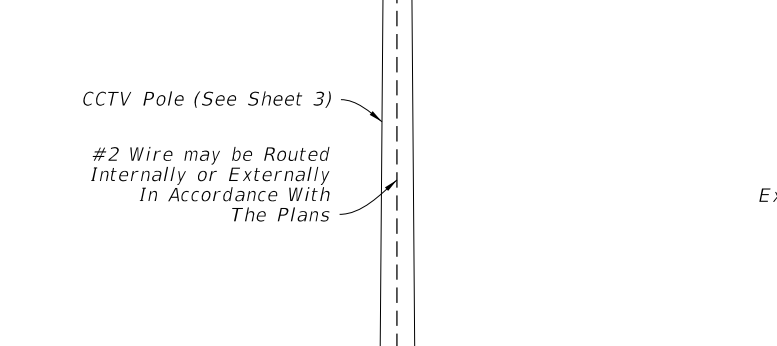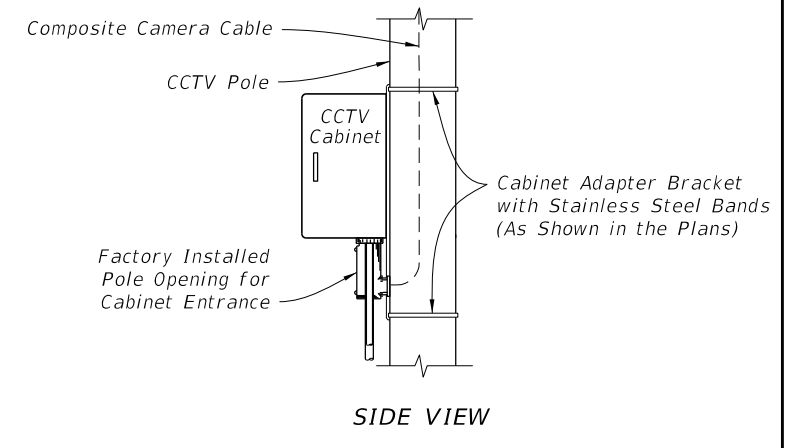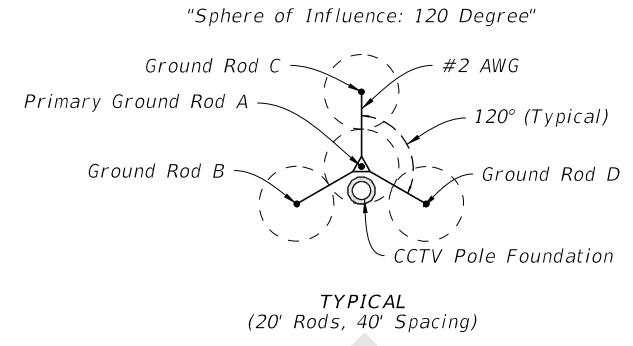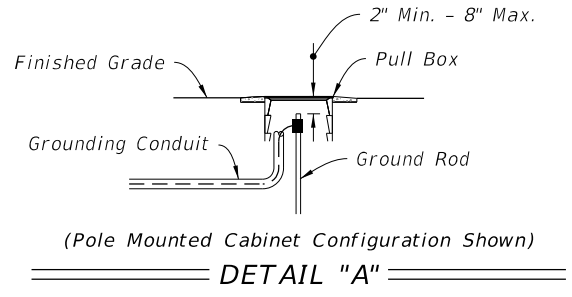
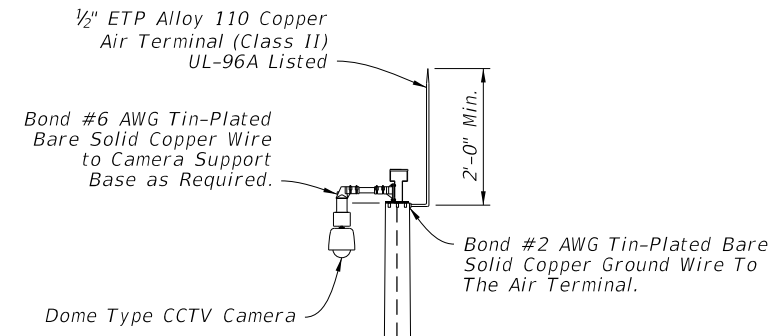


GROUND ROD ARRAY PLACEMENT

DETAIL "B"

DETAIL "C"

DETAIL "D"

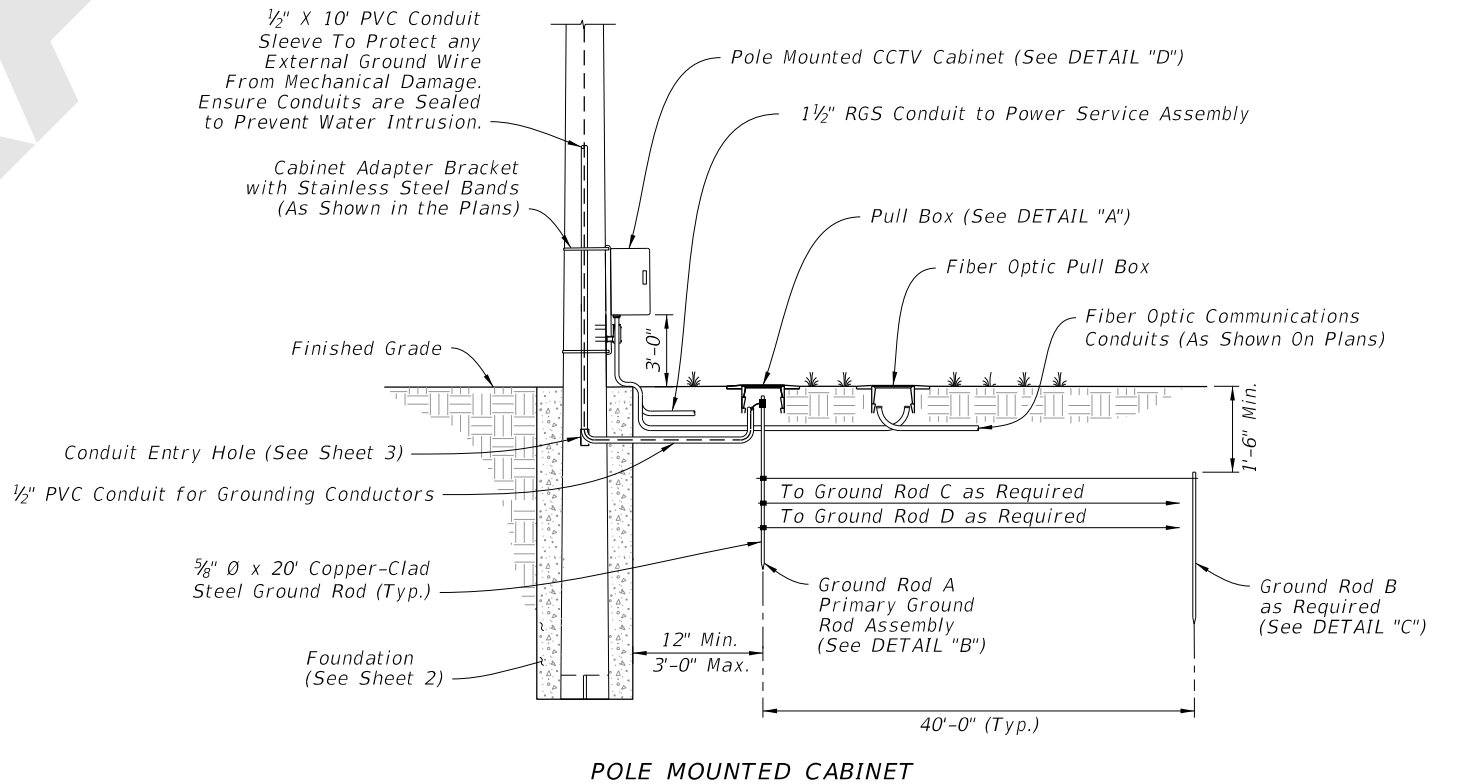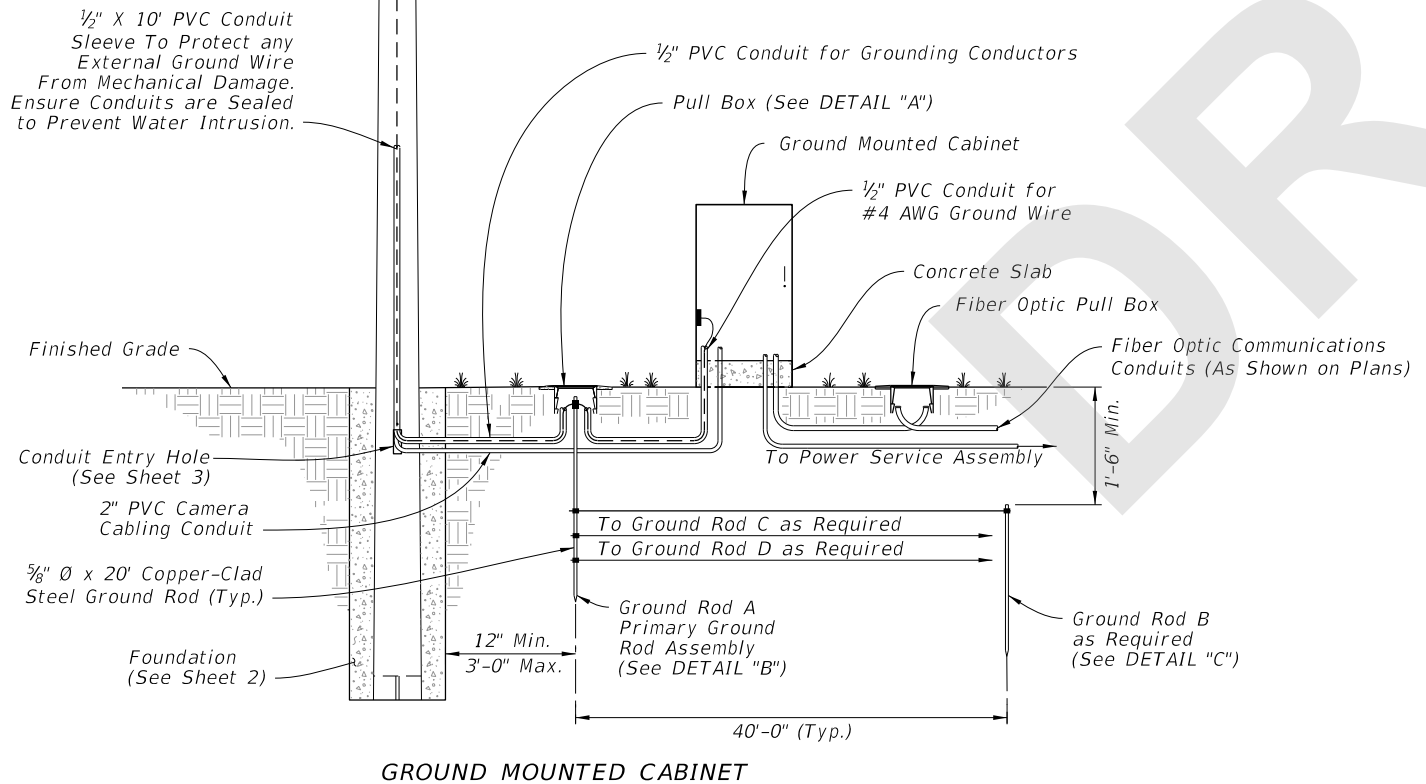

CONCRETE CCTV POLE GROUNDING

8/10/2020 8:48:04 AM

LAST REVISION	11/01/20	DESCRIPTION:		FY 2021-22 STANDARD PLANS	CONCRETE CCTV POLE	INDEX 641-020	SHEET 5 of 5
---------------	----------	--------------	--	------------------------------	--------------------	------------------	-----------------