

---

## ORIGINATION FORM

---

Proposed Revisions to a Standard Plans Index  
(Please provide all information — Incomplete forms will be returned)

**Contact Information:**

Date: August 11, 2020  
Originator: Rick Jenkins/Derwood Sheppard  
Phone: (850) 414-4355  
Email: rick.jenkins@dot.state.fl.us

**Standard Plans:**

Index Number: 711-003  
Sheet Number (s): all  
Index Title: Interchange Markings

**Summary of the changes:**

General cleanup to notes and details. Moved General Notes to new sheet 1. Added gore chevron markings to exit ramps. Added lane line extensions to exit ramps. Created individual sheets for entrance ramps and exit ramps. Added two lane entrance option.

**Commentary / Background:**

The request came from Traffic Operations to make these changes. The chevrons were previously in the Standard Plans but were removed a few years ago. Coordinated all changes with Traffic Operations.

**Other Affected Offices / Documents:** (Provide name of person contacted)

- | Yes                      | No                                  |                             |
|--------------------------|-------------------------------------|-----------------------------|
| <input type="checkbox"/> | <input checked="" type="checkbox"/> | Other Standard Plans –      |
| <input type="checkbox"/> | <input checked="" type="checkbox"/> | FDOT Design Manual –        |
| <input type="checkbox"/> | <input checked="" type="checkbox"/> | Basis of Estimates Manual – |
| <input type="checkbox"/> | <input checked="" type="checkbox"/> | Standard Specifications –   |
| <input type="checkbox"/> | <input checked="" type="checkbox"/> | Approved Product List –     |
| <input type="checkbox"/> | <input checked="" type="checkbox"/> | Construction –              |
| <input type="checkbox"/> | <input checked="" type="checkbox"/> | Maintenance –               |

**Origination Package Includes:**

(Email or hand deliver package to Rick Jenkins)

- | Yes                                 | N/A                      |  |
|-------------------------------------|--------------------------|--|
| <input checked="" type="checkbox"/> | <input type="checkbox"/> | Redline Mark-ups                         |
| <input type="checkbox"/>            | <input type="checkbox"/> | Proposed Standard Plan Instruction (SPI) |
| <input type="checkbox"/>            | <input type="checkbox"/> | Revised SPI                              |
| <input type="checkbox"/>            | <input type="checkbox"/> | Other Support Documents                  |


**Implementation:**

- |                                     |                                  |
|-------------------------------------|----------------------------------|
| <input type="checkbox"/>            | Design Bulletin (Interim)        |
| <input type="checkbox"/>            | DCE Memo                         |
| <input type="checkbox"/>            | Program Mgmt. Bulletin           |
| <input checked="" type="checkbox"/> | FY-Standard Plans (Next Release) |

---


Contact the Roadway Design Office for assistance in completing this form

---

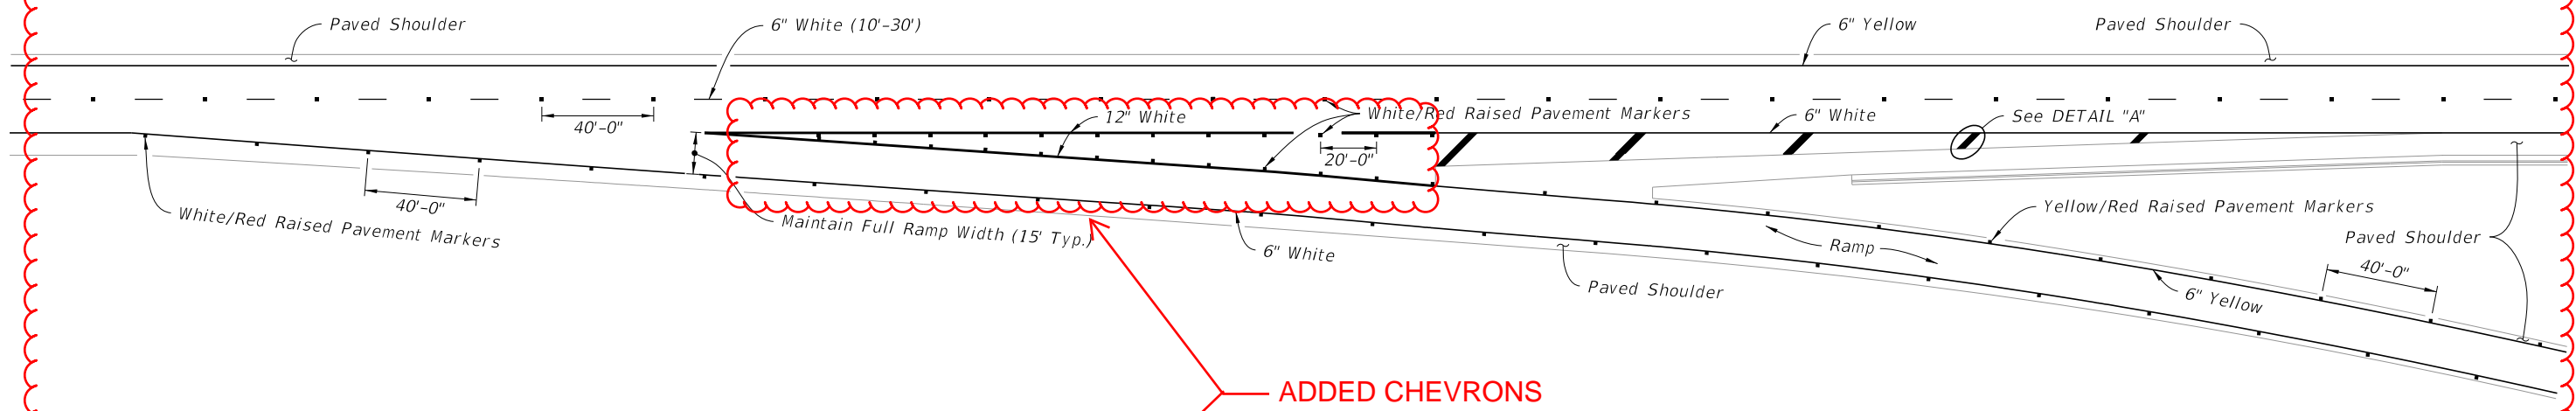


TWO THRU LANES

**MOVED TO SHEET 3**

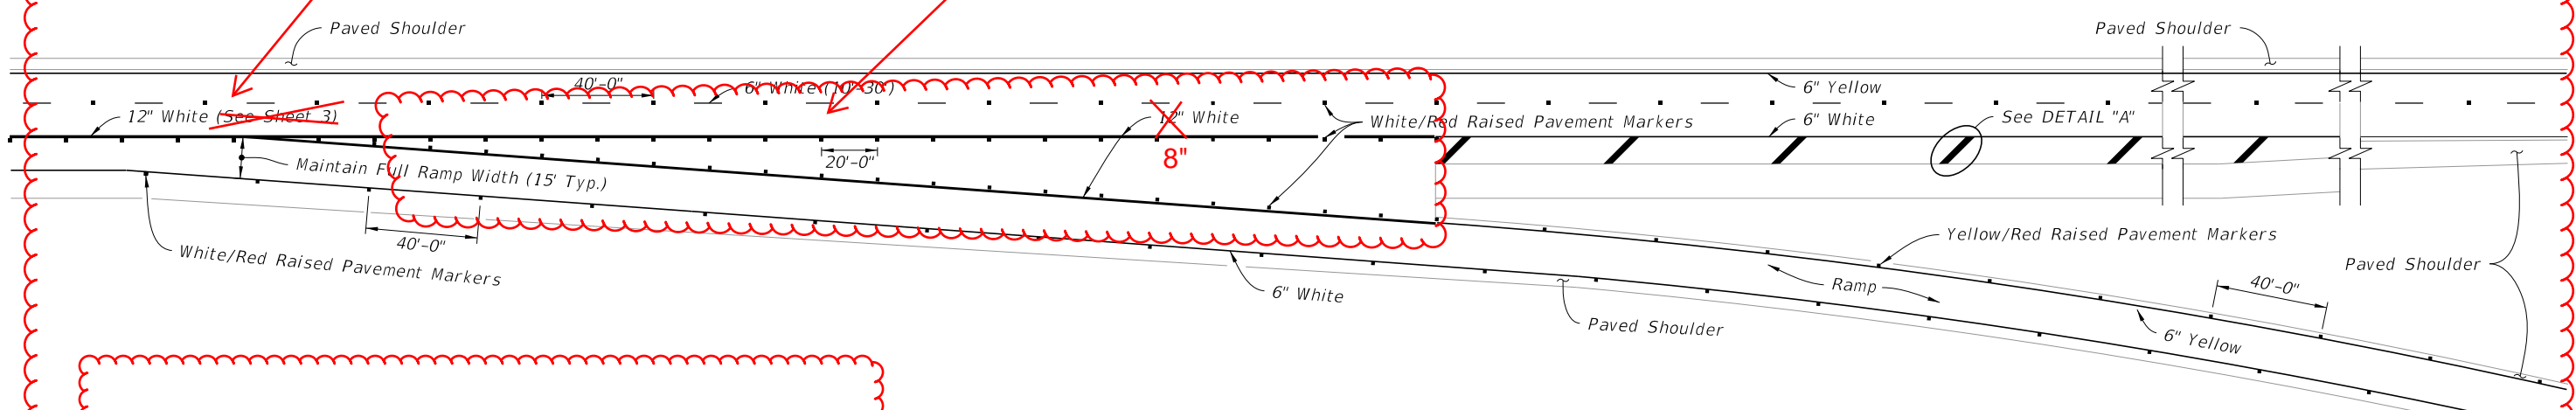

THREE APPROACH LANES - TWO THRU LANES

Added Note: Extend 12" White One-Fourth The Length of the Acceleration Lane From The Theoretical Gore.

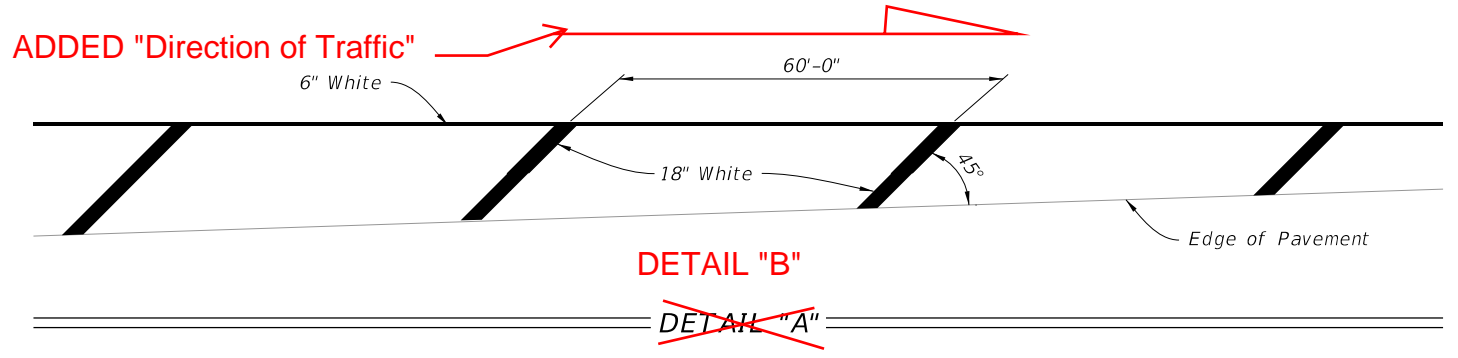

**ADDED  
DETAIL "A"**

- GENERAL NOTES:**
1. Make the traffic face of the raised pavement marker (RPM) the same color as the pavement marking that it is supplementing.
  2. See Index 706-001 for additional information on RPMs.

Updated Note and move Gen notes to new sheet 1

SINGLE LANE RAMPS - EXIT TERMINALS

10/14/2019 2:48:17 PM

LAST REVISION	DESCRIPTION:
11/01/17	11/01/20



**FY 2020-21  
STANDARD PLANS**

**INTERCHANGE MARKINGS**

INDEX	3 OF 8
711-003	<del>1 of 7</del>


NEW SHEET 2  
Typical Pavement Markings at Entrance Ramps

SINGLE LANE RAMPS-EXIT TERMINAL

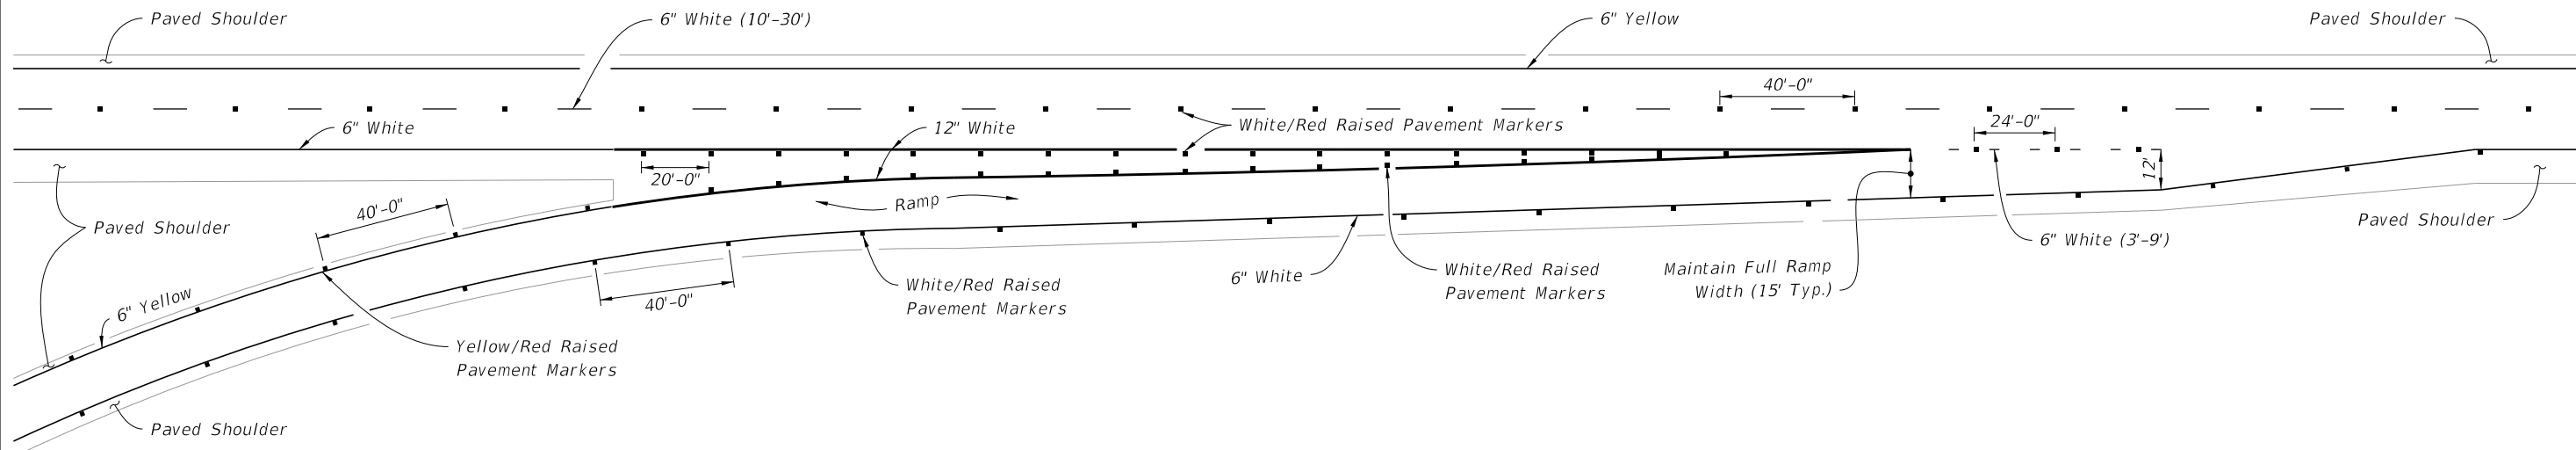

TAPER - TYPE ENTRANCE

NEW SHEET 1

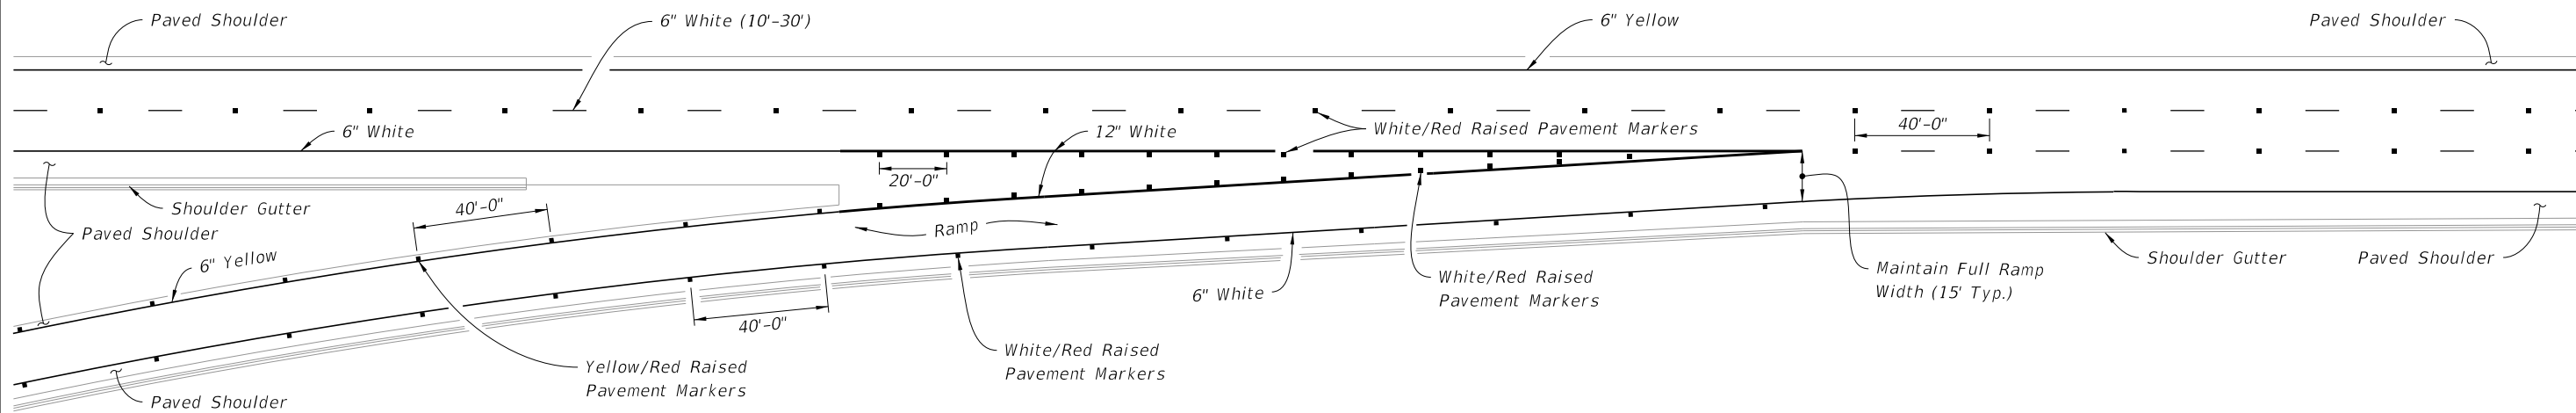

PARALLEL - TYPE ENTRANCE

GENERAL NOTES

Added Title →

10/14/2019 2:48:18 PM

LAST REVISION	<del>11/01/17</del>	REVISION	<del>11/01/17</del>	DESCRIPTION:	11/01/20
---------------	---------------------	----------	---------------------	--------------	----------

FY 2020-21  
 STANDARD PLANS

INTERCHANGE MARKINGS

INDEX	711-003	1 OF 8	<del>2 OF 7</del>
-------	---------	--------	-------------------

NEW SHEET 3


MOVED EXIT RAMP DRAWING FROM SHEET 1

SINGLE LANE RAMPS-EXIT TERMINAL


**MOVED TO SHEET 2**

**Moved to Notes**

12" White Shall Extend One-Fourth The Length of the Acceleration Lane From The Theoretical Gore.

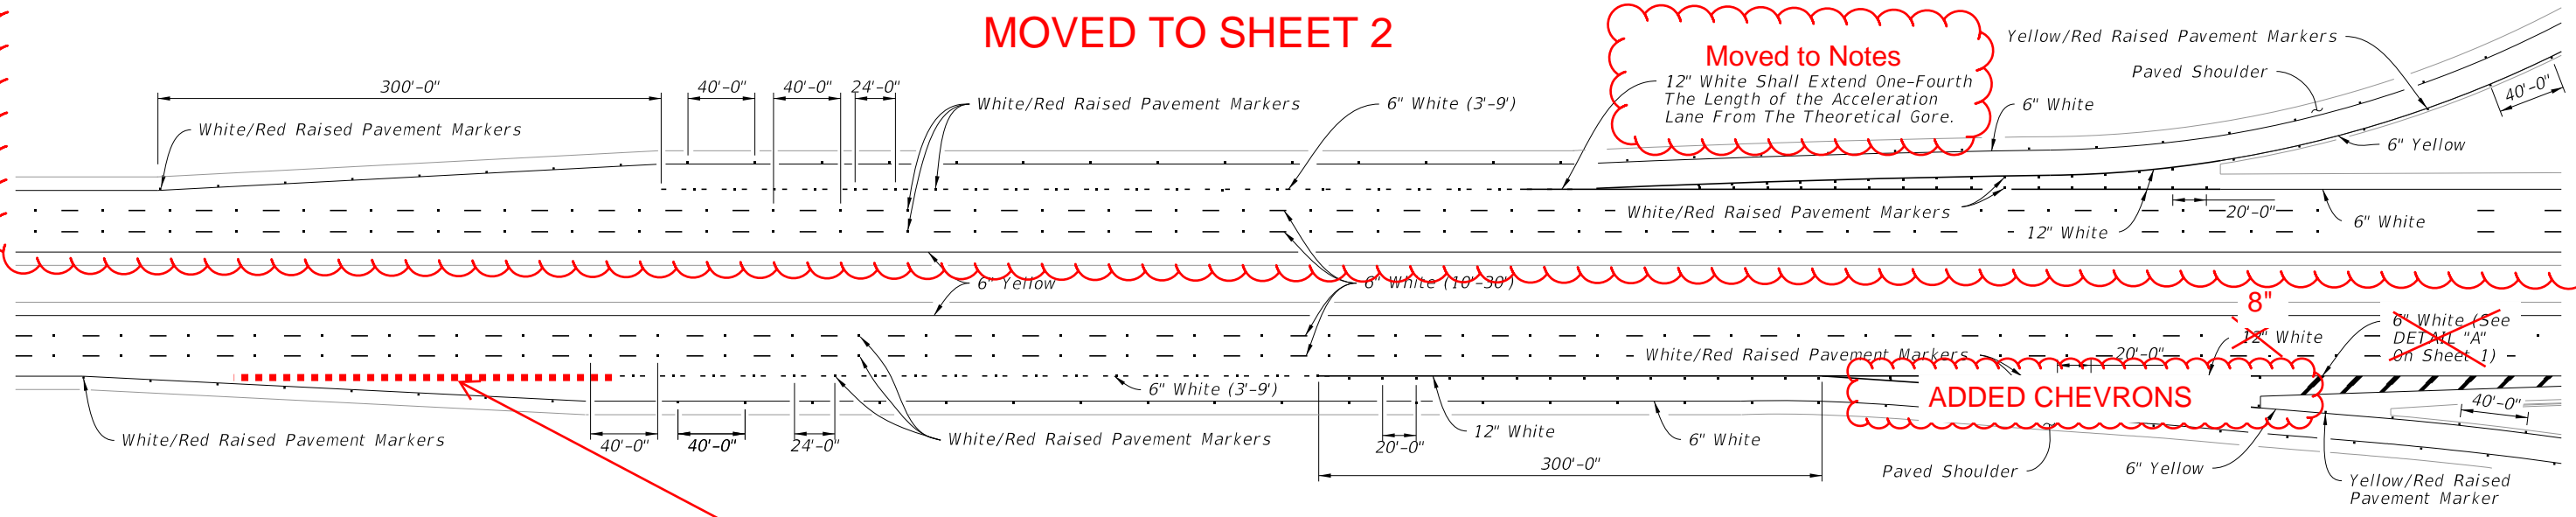


**PARALLEL ACCELERATION AND DECELERATION LANE**

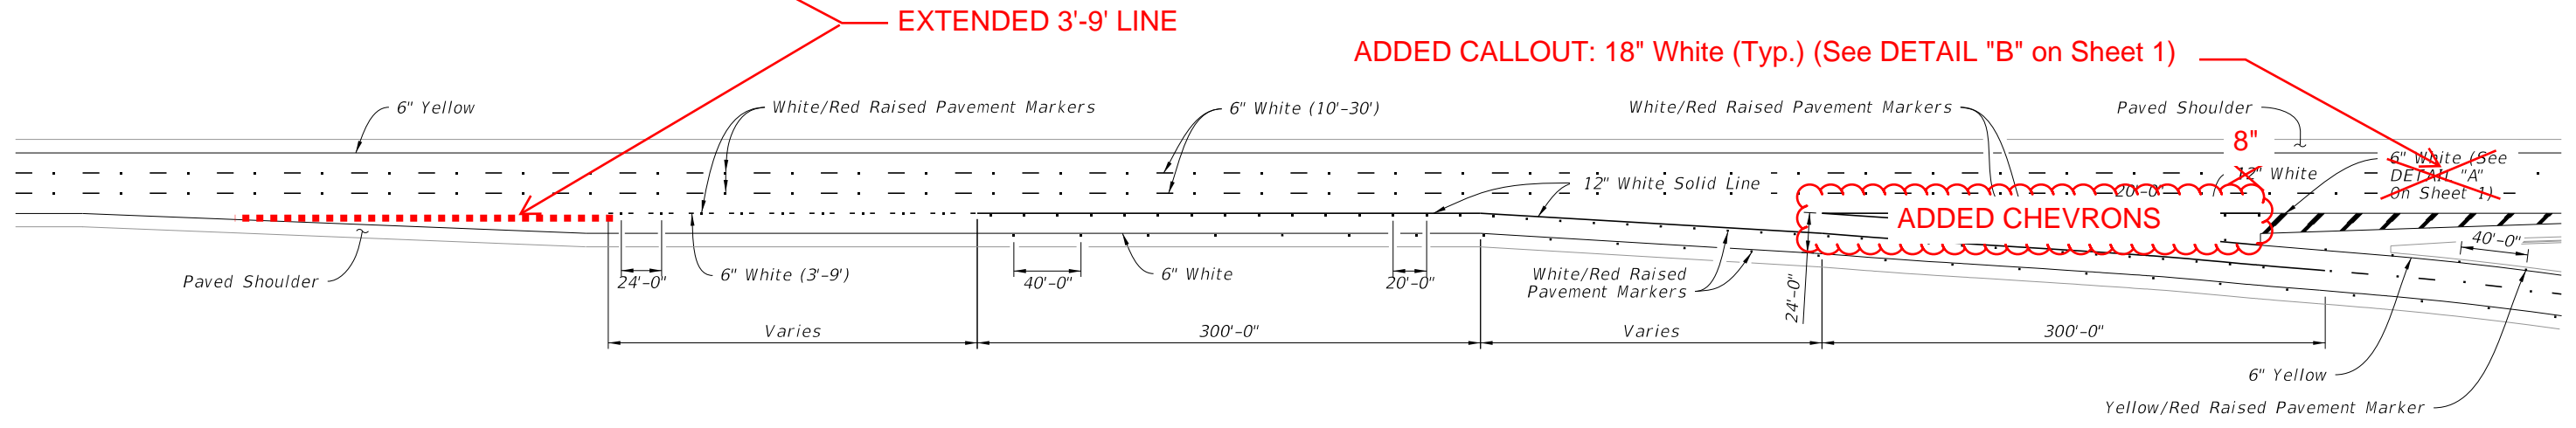

**TYPICAL MARKINGS AT DUAL LANE EXITS**

**NEW SHEET 4**

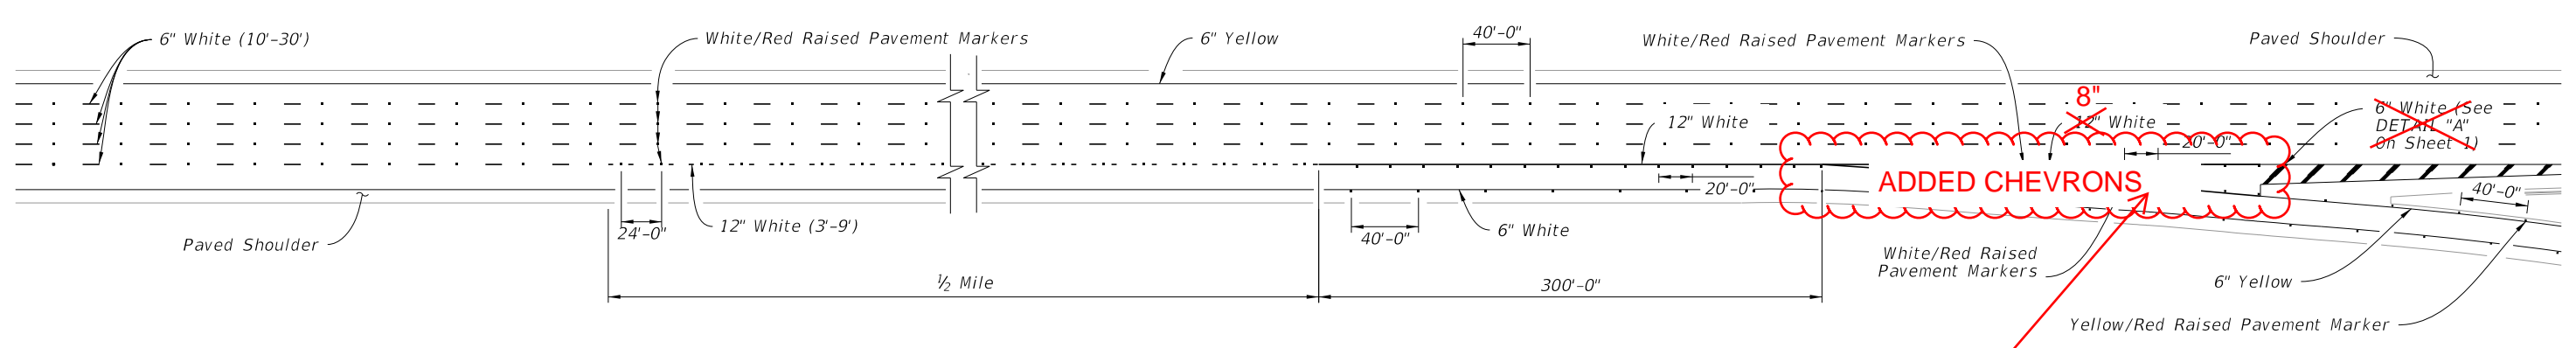

**TYPICAL LANE DROP MARKINGS AT EXIT RAMP**

**ADDED CALLOUT: 18" White (Typ.) (See DETAIL "A" on Sheet 1)**

**Added Title**

**4 of 8**



10/14/2019 2:48:18 PM

LAST REVISION	DESCRIPTION:
<del>11/01/17</del>	11/01/20

**FDOT** FY 2020-21 STANDARD PLANS

**INTERCHANGE MARKINGS**

INDEX	SHEET
711-003	<del>3 of 7</del>

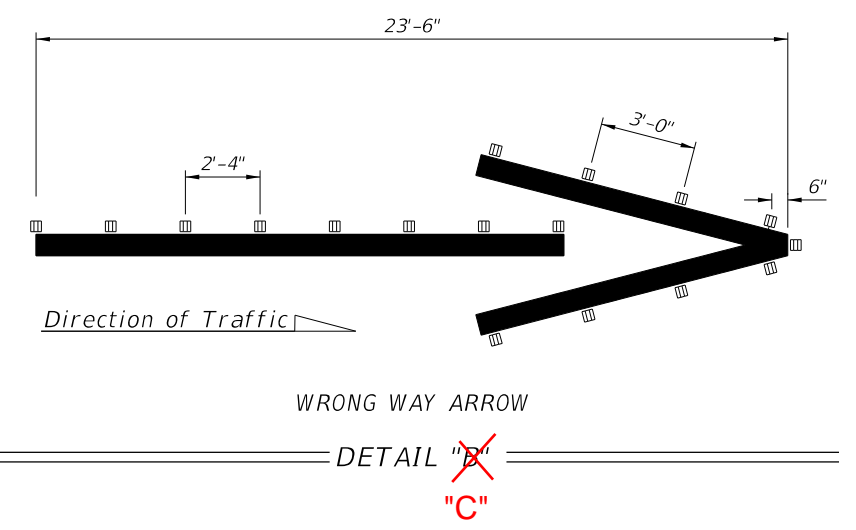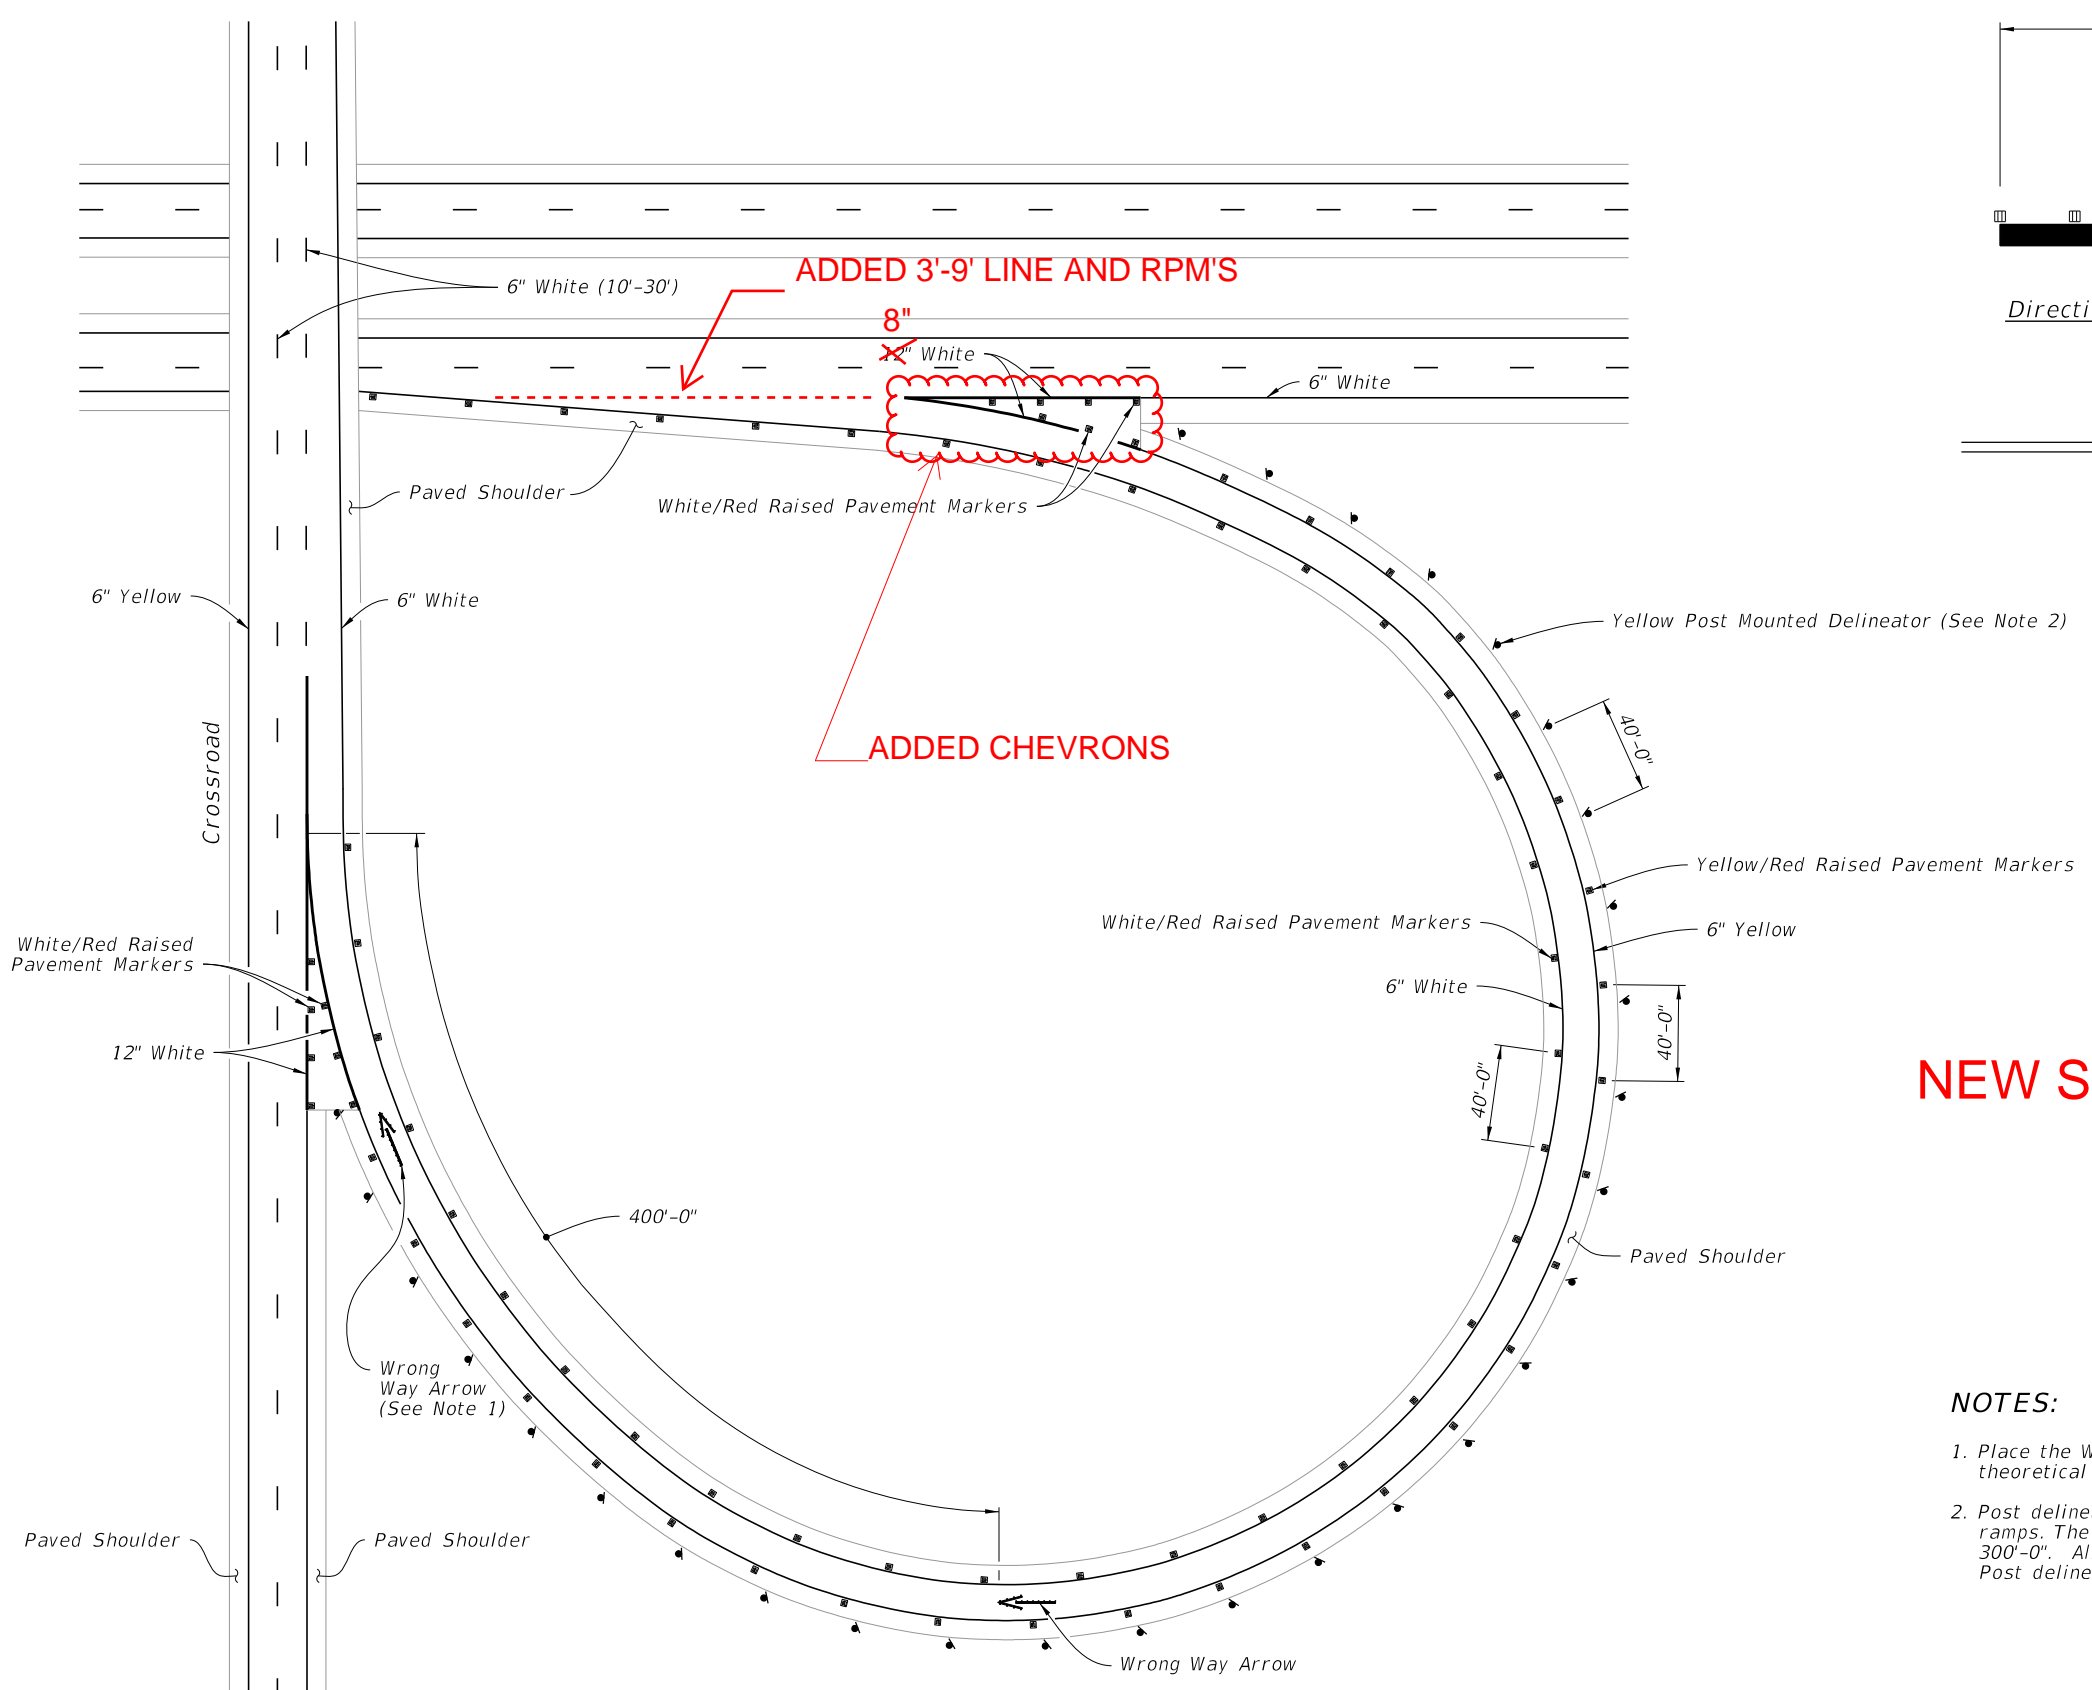

**NEW SHEET 5**

**NOTES:**


1. Place the Wrong Way Arrow at the physical gore or 100'-0" from the theoretical gore.
2. Post delineators spaced at 40' on curves of the entrance and exit of ramps. The spacing on the tangent portion of the ramp section is 300'-0". All delineators are to be setback 4' from shoulder break. Post delineators should not be discontinued in sections with guardrail.

TYPICAL CURVED EXIT RAMP

Added Title

10/14/2019 2:48:19 PM

LAST REVISION <del>11/01/17</del>	DESCRIPTION: 11/01/20	FY 2020-21 STANDARD PLANS	INTERCHANGE MARKINGS	INDEX 711-003	<del>4 of 7</del> 5 of 8
--------------------------------------	--------------------------	------------------------------	----------------------	------------------	-----------------------------

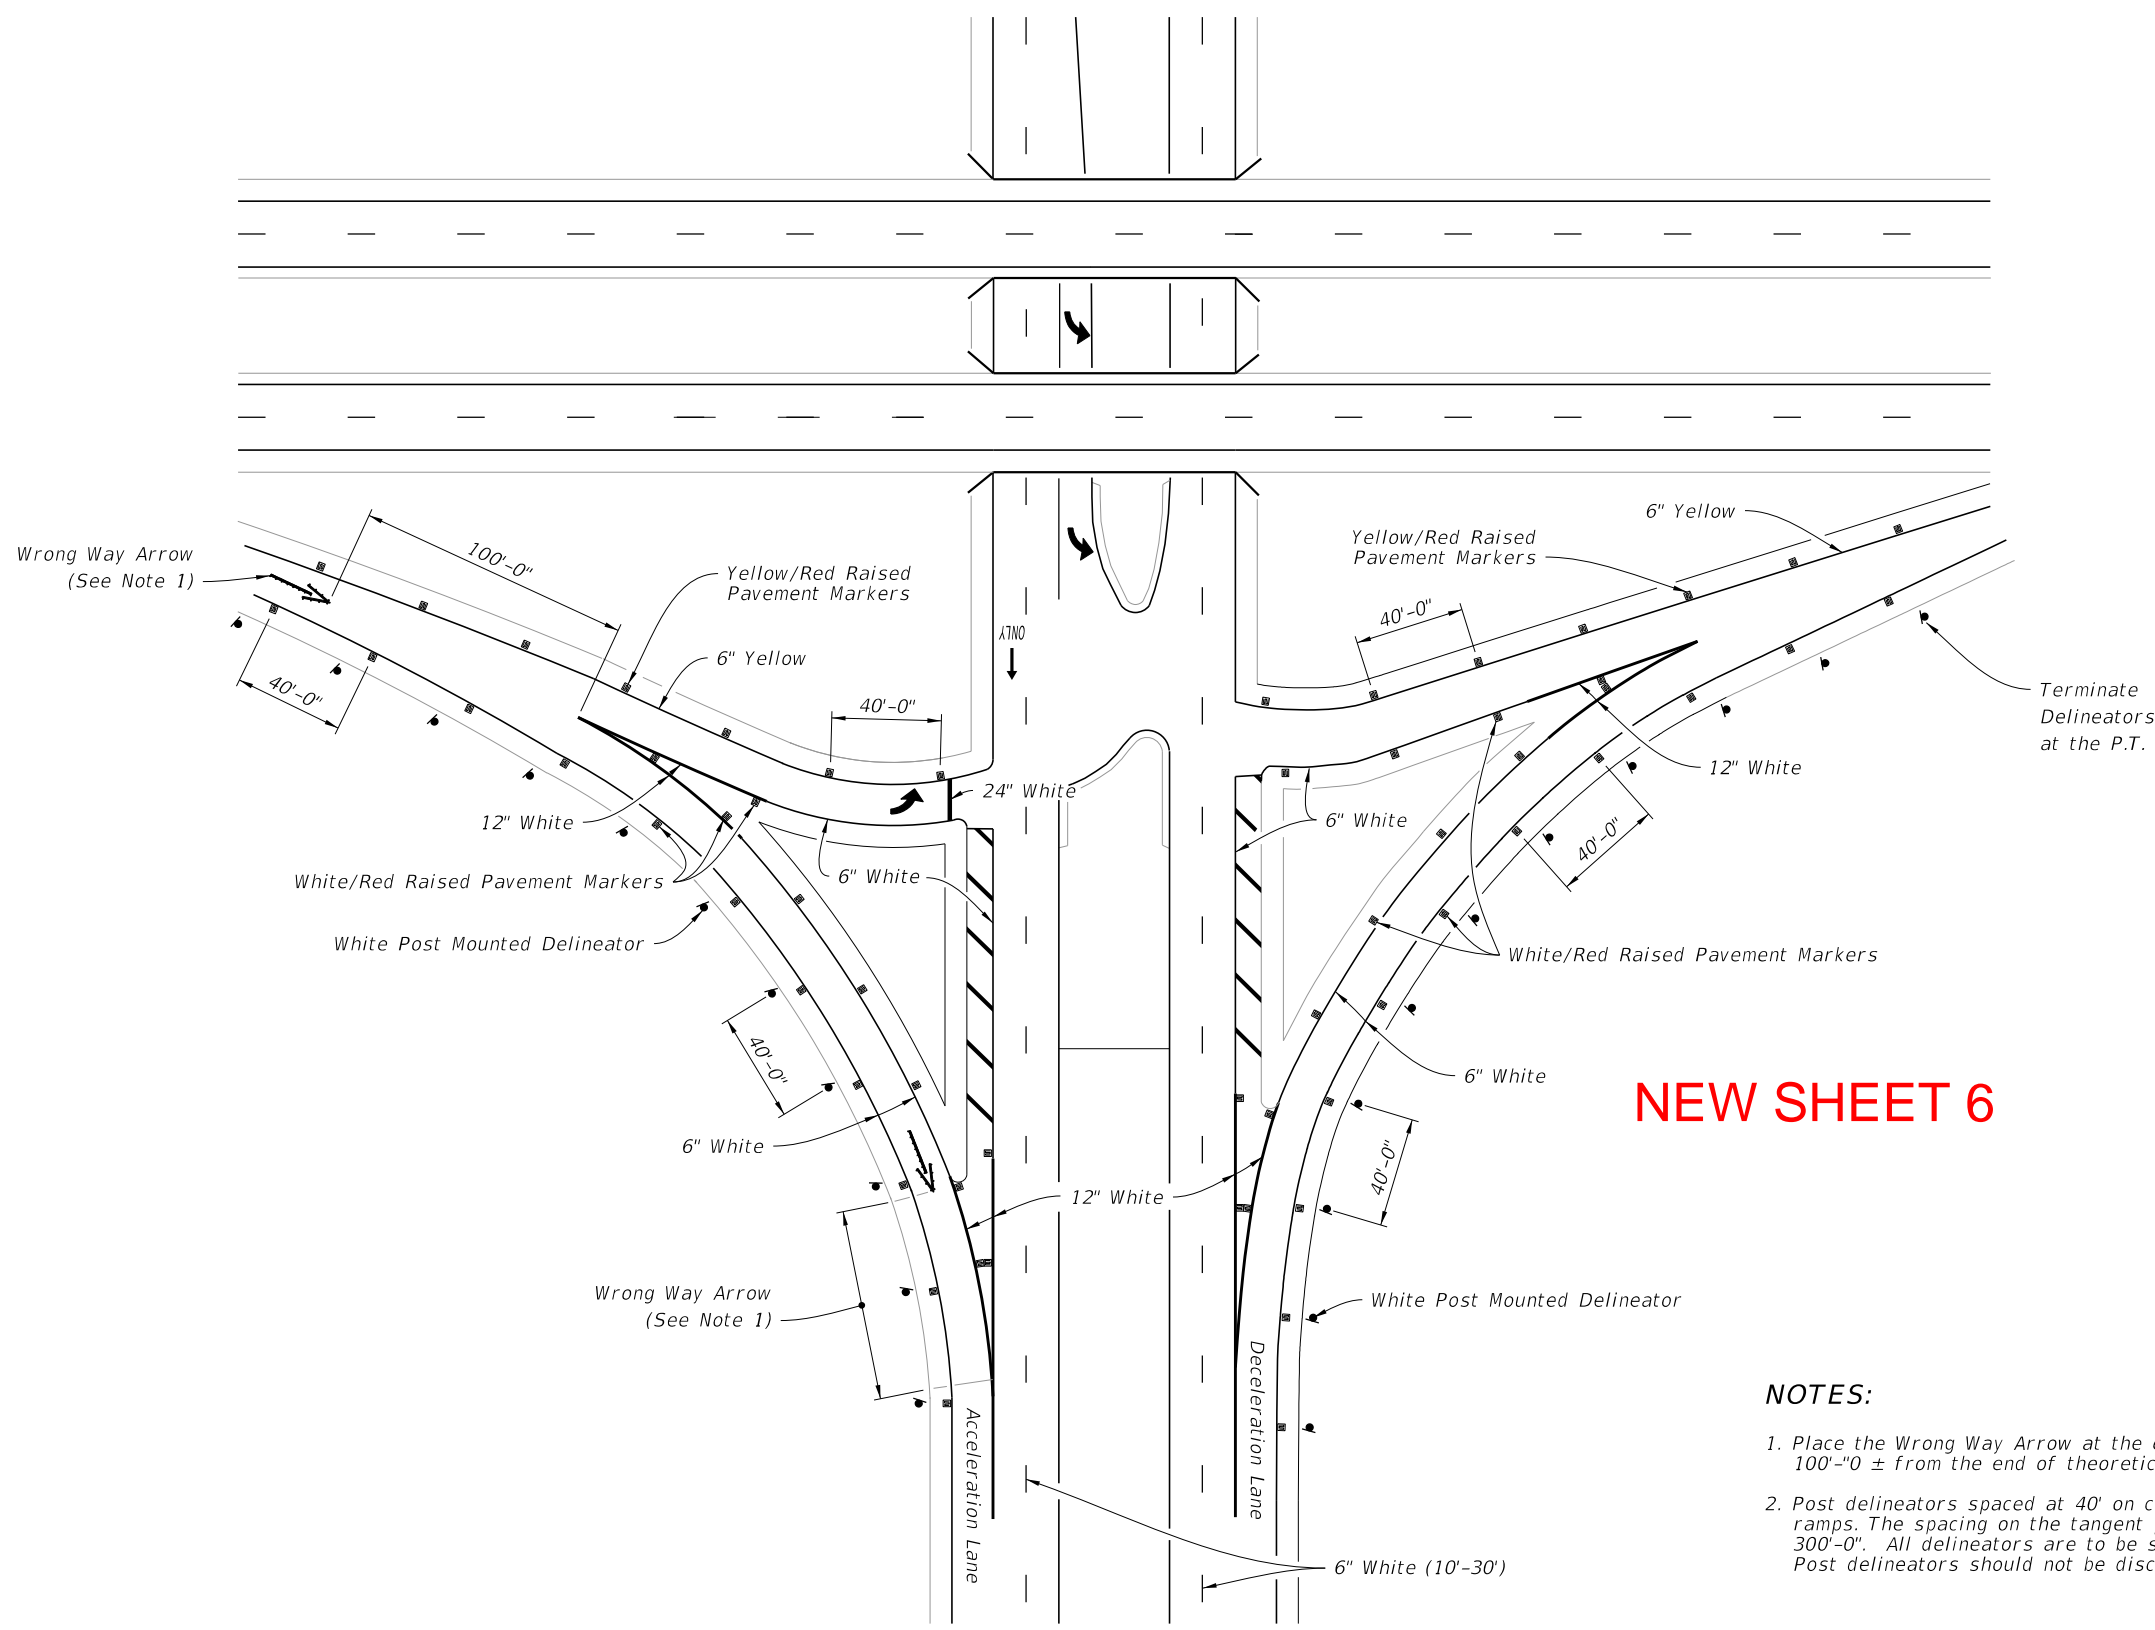

**NEW SHEET 6**

**NOTES:**

1. Place the Wrong Way Arrow at the end of the physical gore or 100'-0" ± from the end of theoretical gore.
2. Post delineators spaced at 40' on curves of the entrance and exit of ramps. The spacing on the tangent portion of the ramp section is 300'-0". All delineators are to be setback 4' from shoulder break. Post delineators should not be discontinued in sections with guardrail.

~~TYPICAL INTERSECTION~~

Added Title




6 of 8

10/14/2019 2:48:20 PM

LAST REVISION <del>11/01/17</del>	DESCRIPTION: <del>11/01/17</del> → 11/01/20	 FY 2020-21 STANDARD PLANS	INTERCHANGE MARKINGS	INDEX 711-003	SHEET <del>5 of 7</del>
--------------------------------------	--	---	----------------------	------------------	----------------------------



10/14/2019 2:48:20 PM

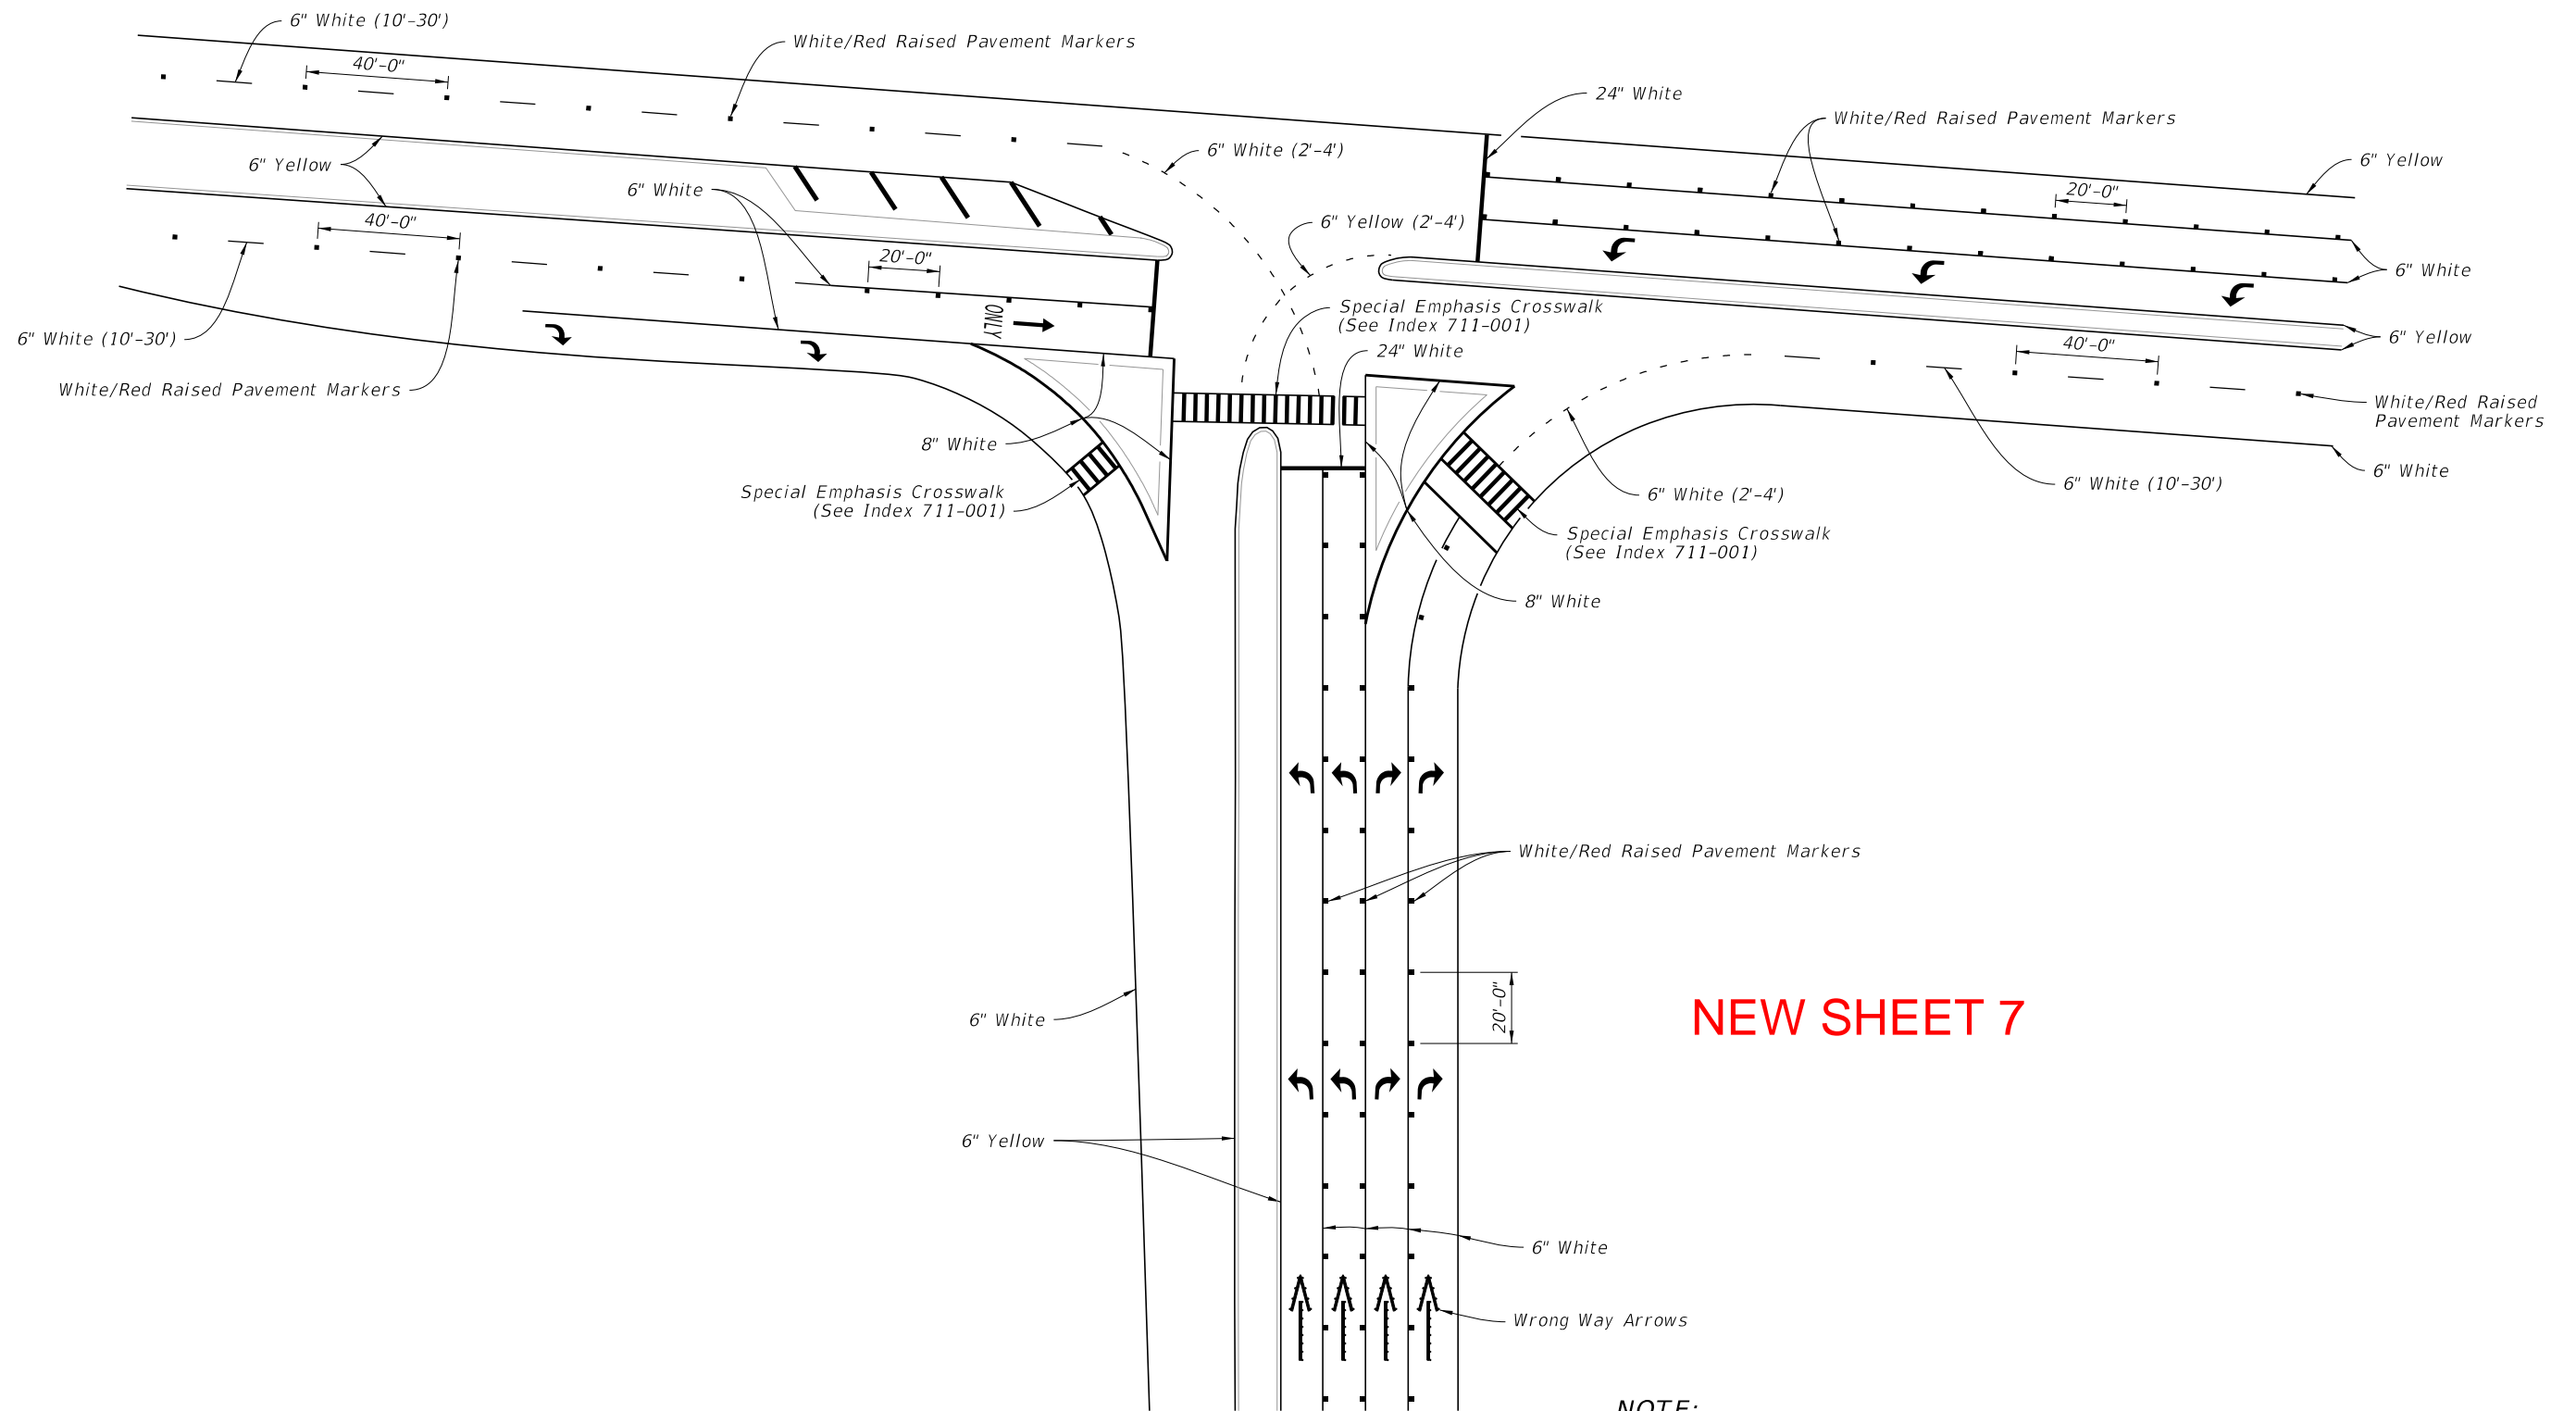

**NEW SHEET 7**

**NOTE:**

Do not place wrong way arrows in between consecutive directional arrows.

~~TYPICAL PARTIAL CLOVERLEAF/TRUMPET EXIT RAMP~~

Added Title

7 of 8


LAST REVISION <del>11/01/17</del>	DESCRIPTION: 11/01/20
--------------------------------------	--------------------------

**FDOT** FY 2020-21 STANDARD PLANS


INTERCHANGE MARKINGS

INDEX  
711-003

SHEET  
~~6 of 7~~

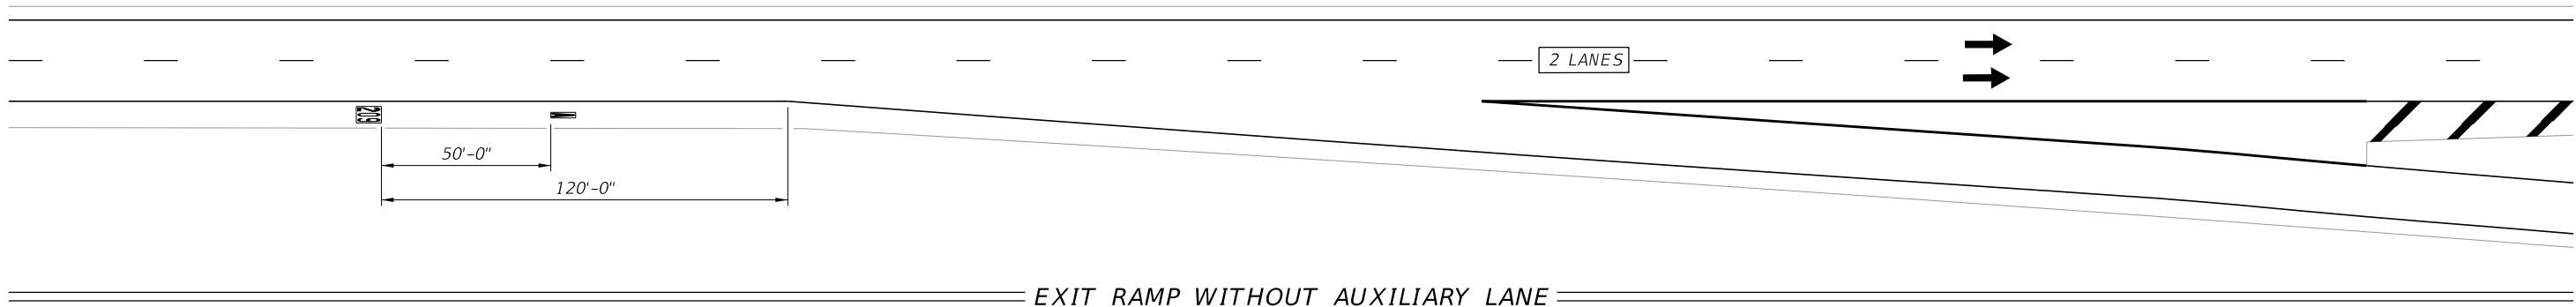


EXIT RAMP WITHOUT AUXILIARY LANE

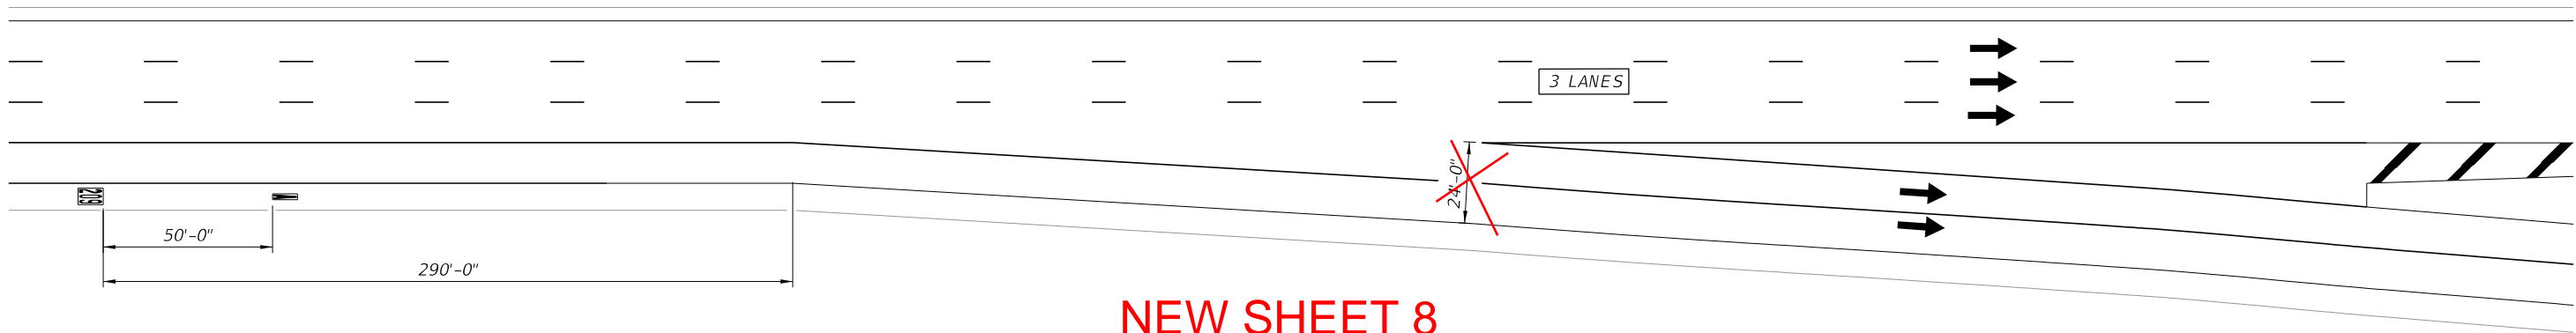


EXIT RAMP WITH AUXILIARY LANE

**NEW SHEET 8**

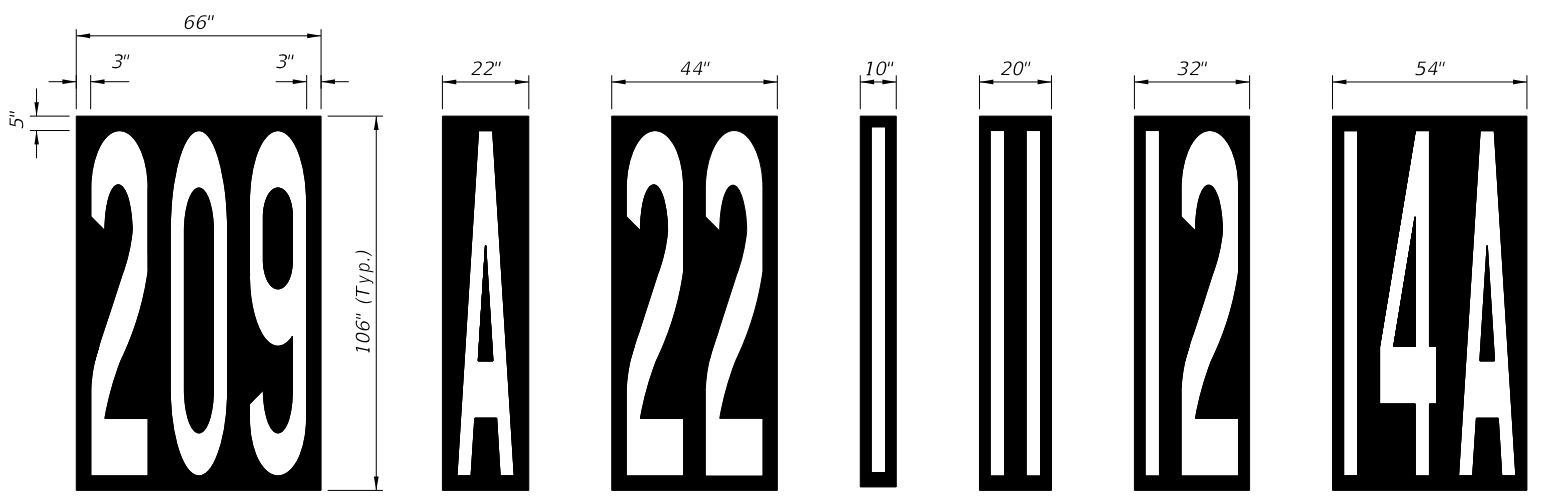

MAT DIMENSIONS

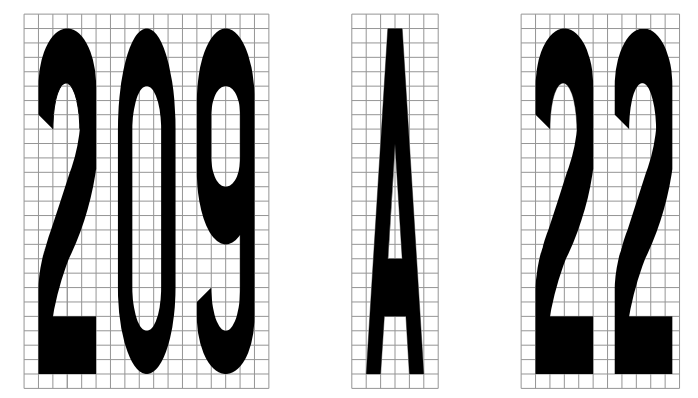

MESSAGE SIZE AND SPACING

- NOTES:**
1. This Index shows layouts for 1, 2, and 3 digit numbers and letters.
  2. The message consist of white letters and numbers with black contrasting material.
  3. The "EXIT NUMBER" position remains the same distance from the beginning of taper regardless of the number of lines of information.
  4. All Grids are 4" x4".

Added Title 8 of 8


10/14/2019 2:48:21 PM

LAST REVISION <del>11/01/17</del>	DESCRIPTION: 11/01/20
--------------------------------------	--------------------------




INTERCHANGE MARKINGS

INDEX 711-003	SHEET <del>7 of 7</del> 8 of 8
------------------	--------------------------------------

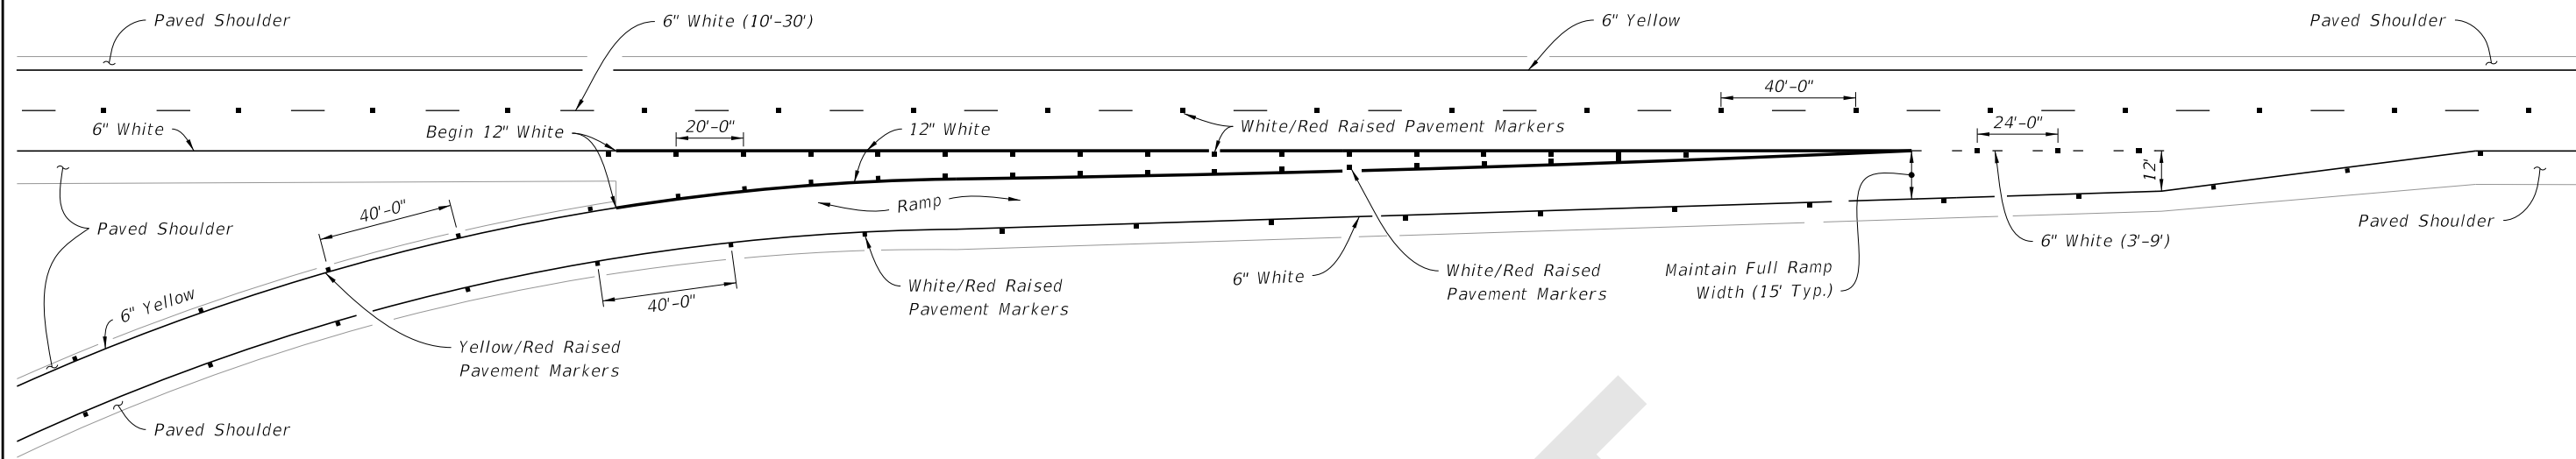

TAPER - TYPE ENTRANCE

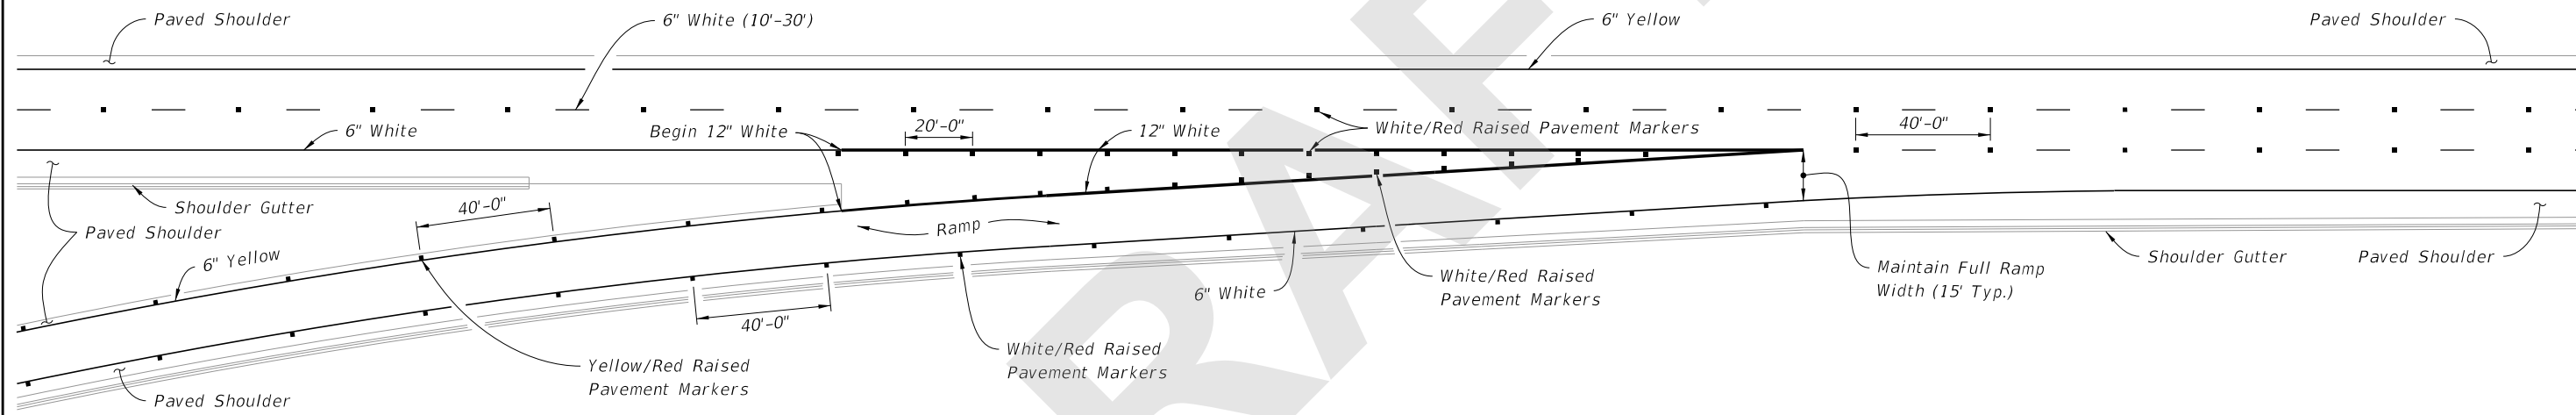


PARALLEL - TYPE ENTRANCE


GENERAL NOTES:

1. Make the traffic face of the raised pavement marker (RPM) the same color as the pavement marking that it is supplementing.
2. See Index 706-001 for additional Raised Pavement Markers (RPM) requirements.


8/10/2020 9:25:50 AM

SINGLE LANE RAMPS - ENTRANCE TERMINALS


LAST REVISION 11/01/20	REVISION	DESCRIPTION:	 FY 2021-22 STANDARD PLANS	INTERCHANGE MARKINGS	INDEX 711-003	SHEET 1 of 8
---------------------------	----------	--------------	---	----------------------	------------------	-----------------

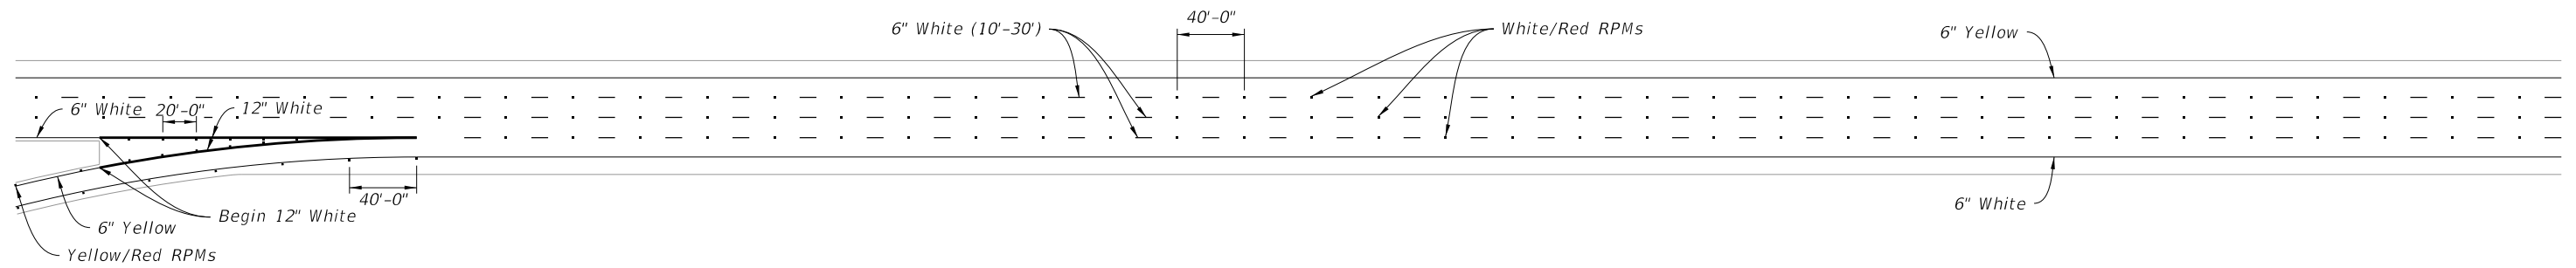

PARALLEL-TYPE ENTRANCE WITH ADDED LANE

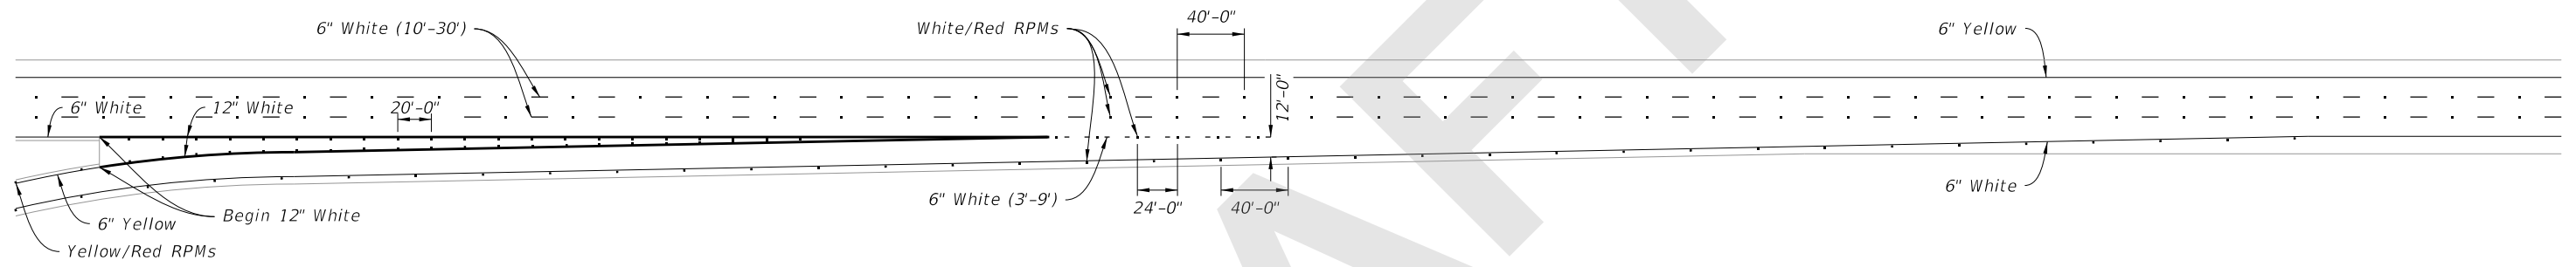

TAPER-TYPE ENTRANCE

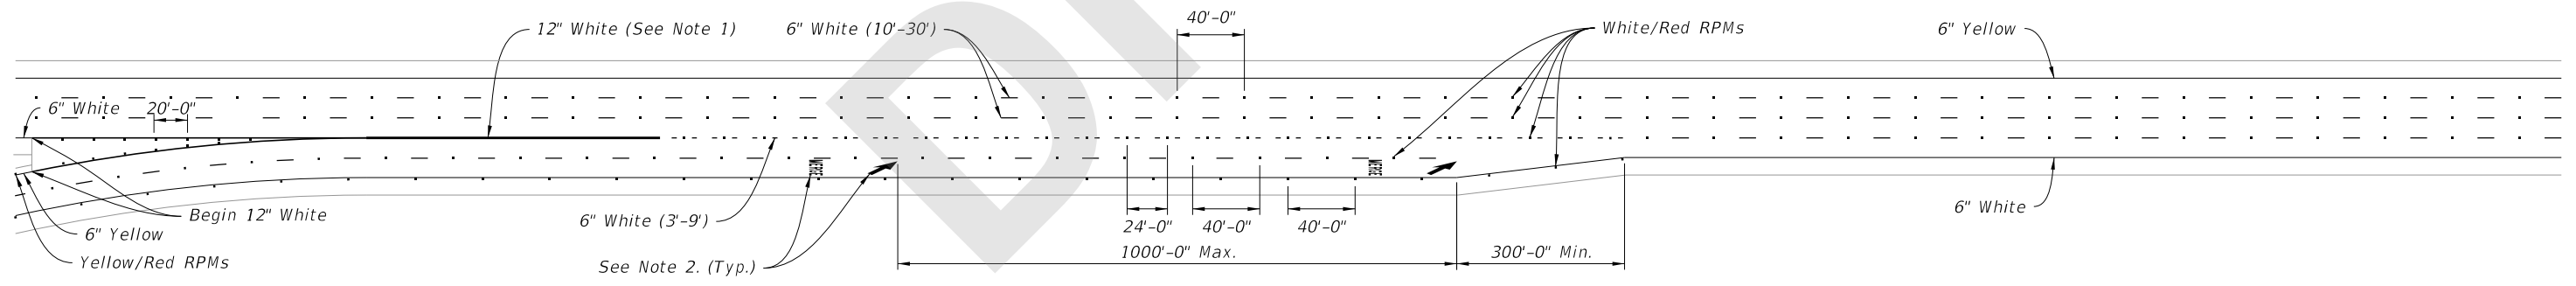

TWO-LANE PARALLEL-TYPE ENTRANCE WITH ADDED LANE


**NOTES:**

1. Extend this 12" white Pavement Marker one-fourth the length of the acceleration lane from the gore markings.
2. See Index 711-001 for pavement message dimensions and details.


8/10/2020 9:25:51 AM

**TYPICAL PAVEMENT MARKINGS AT ENTRANCE RAMPS**


LAST REVISION 11/01/20	REVISION	DESCRIPTION:	 FY 2021-22 STANDARD PLANS	INTERCHANGE MARKINGS	INDEX 711-003	SHEET 2 of 8
---------------------------	----------	--------------	--	----------------------	------------------	-----------------

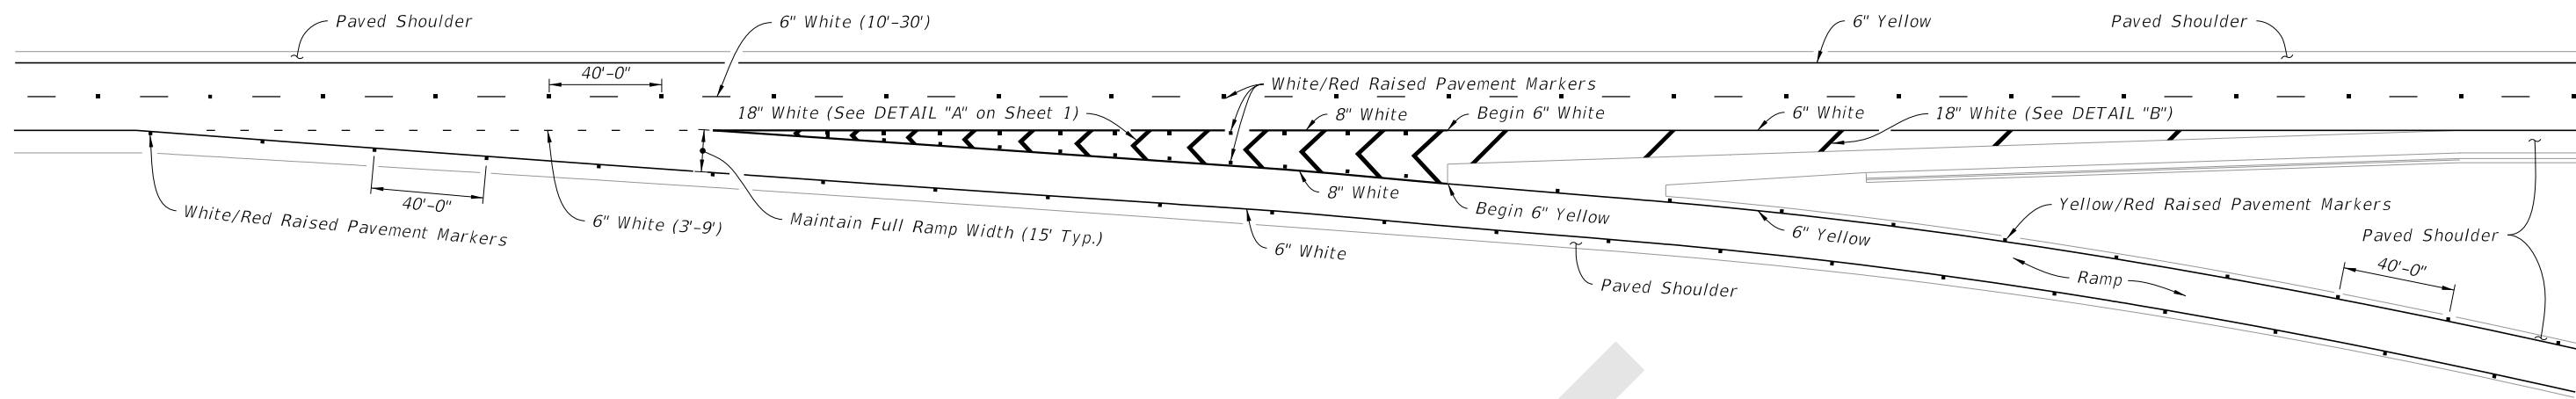


TWO THRU LANES

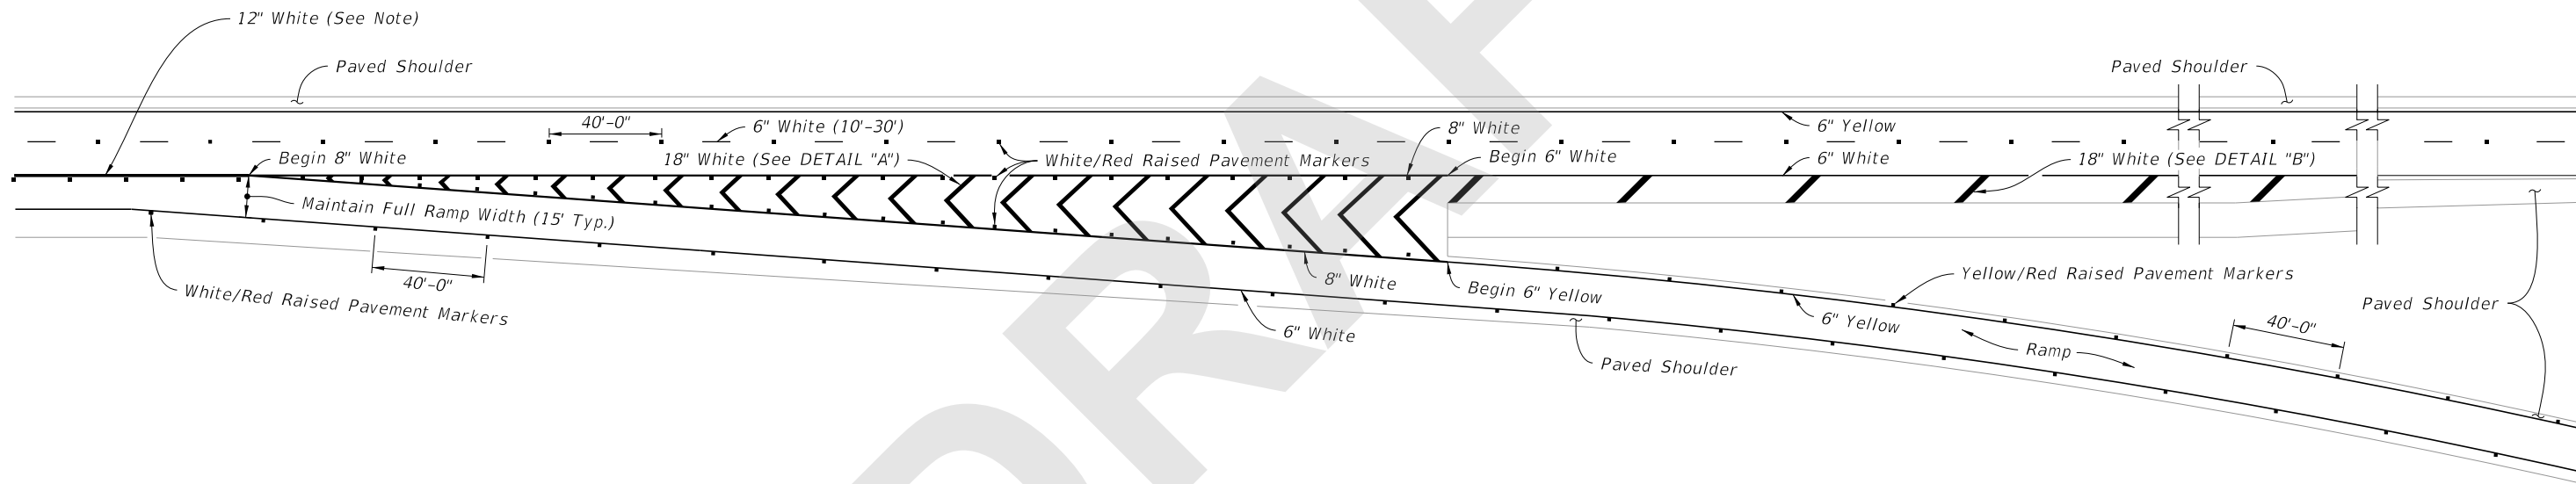

THREE APPROACH LANES - TWO THRU LANES

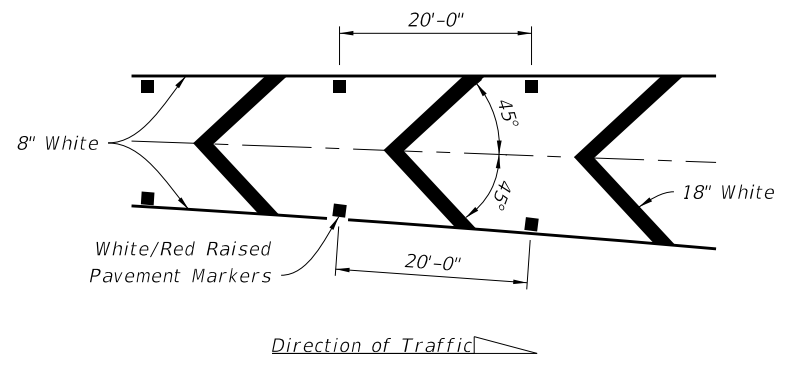

DETAIL "A"

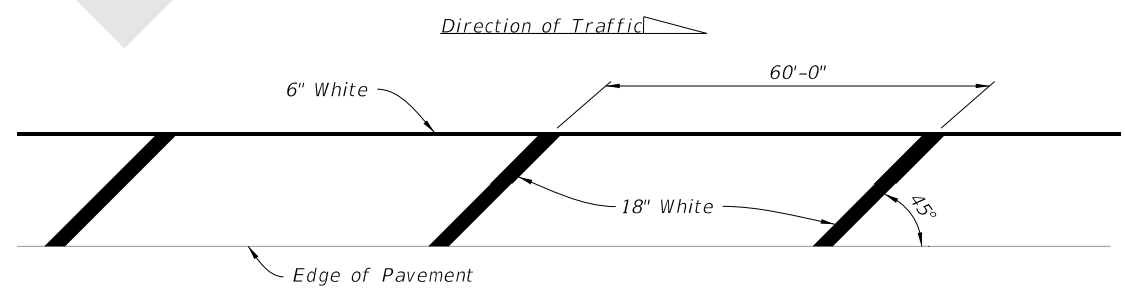

DETAIL "B"

**NOTE:**  
Extend 12" White 300' from the gore markings.

SINGLE LANE RAMPS - EXIT TERMINALS


8/10/2020 9:25:54 AM

LAST REVISION 11/01/20	DESCRIPTION:
---------------------------	--------------



 FY 2021-22  
 STANDARD PLANS

INTERCHANGE MARKINGS


INDEX 711-003	SHEET 3 of 8
------------------	-----------------

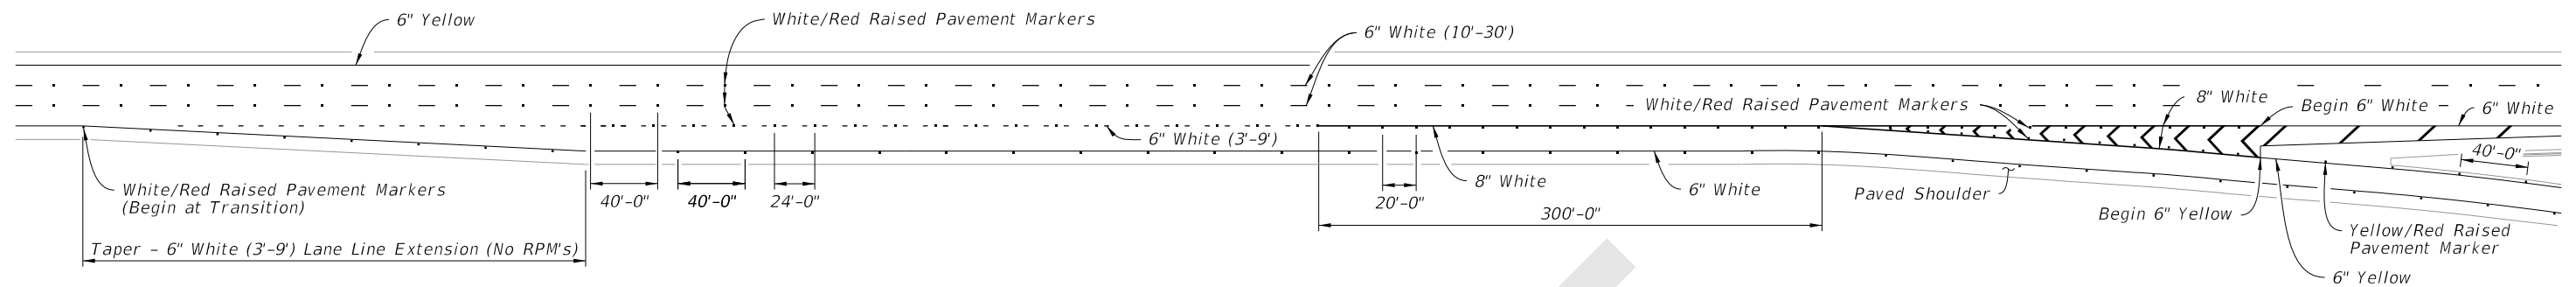

PARALLEL DECELERATION LANE

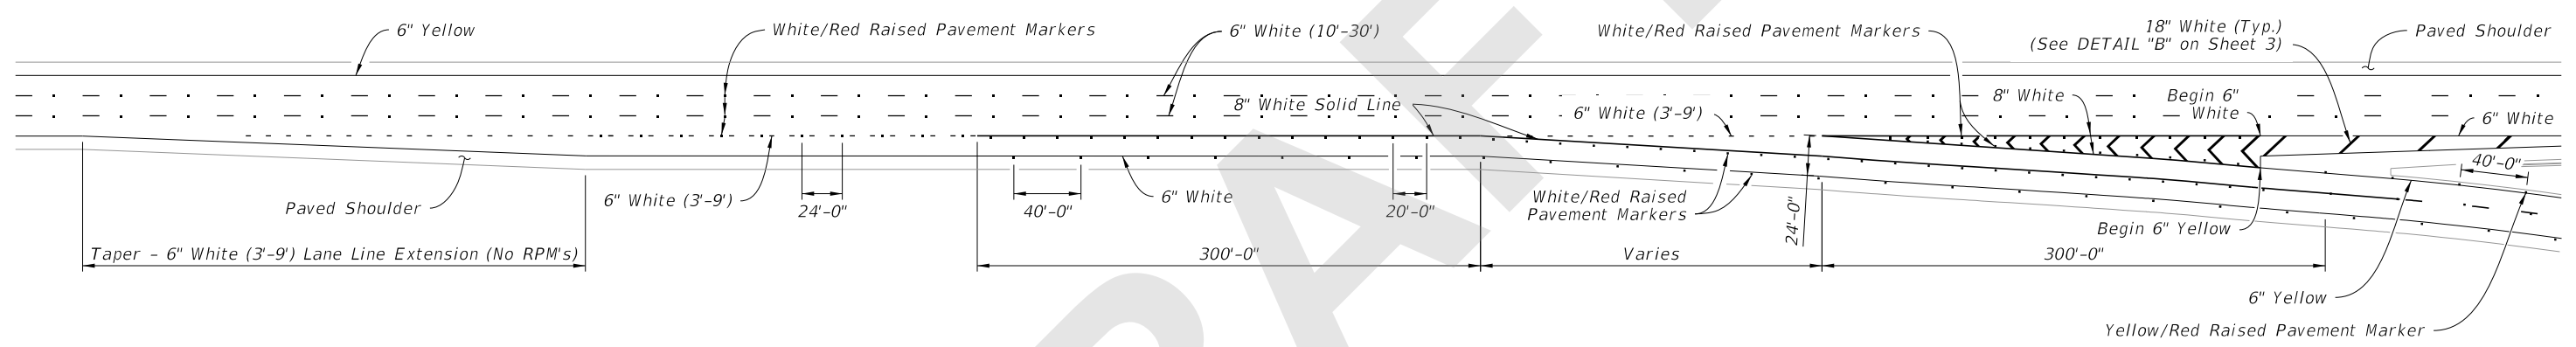

MARKINGS AT DUAL LANE EXITS

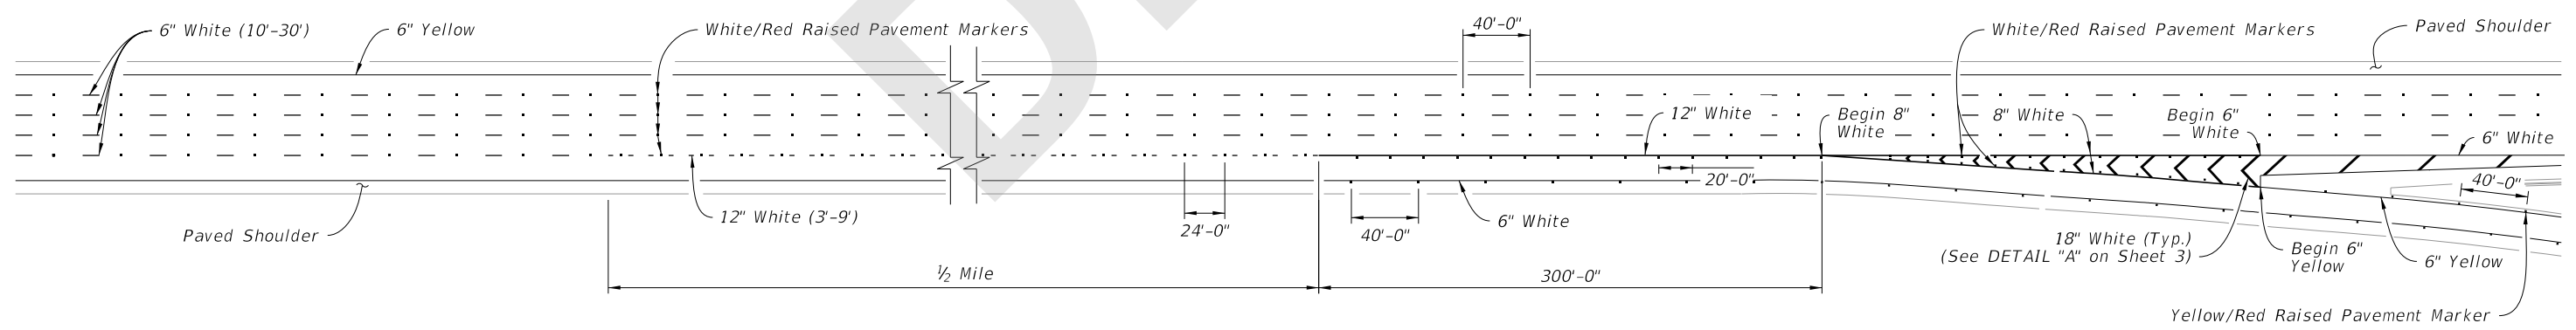



LANE DROP MARKINGS AT EXIT RAMP

TYPICAL PAVEMENT MARKINGS AT EXIT RAMP

8/10/2020 9:26:29 AM

LAST REVISION 11/01/20	REVISION	DESCRIPTION:	 FY 2021-22 STANDARD PLANS	INTERCHANGE MARKINGS	INDEX 711-003	SHEET 4 of 8
---------------------------	----------	--------------	---	----------------------	------------------	-----------------

8/10/2020 9:27:04 AM

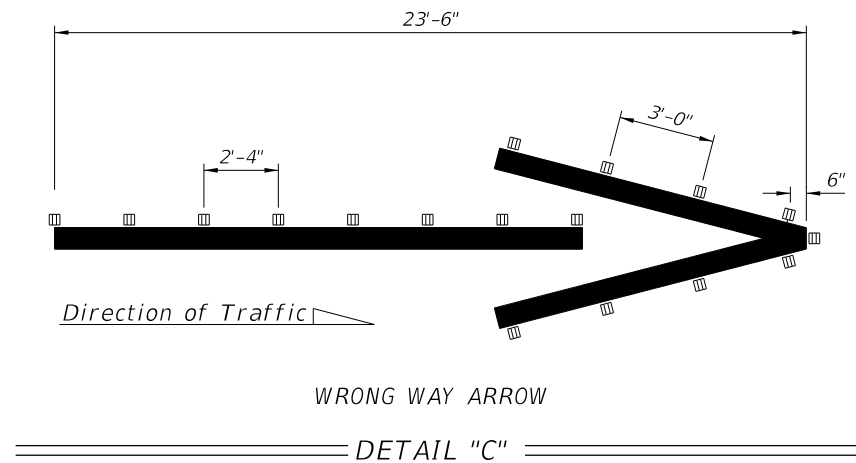
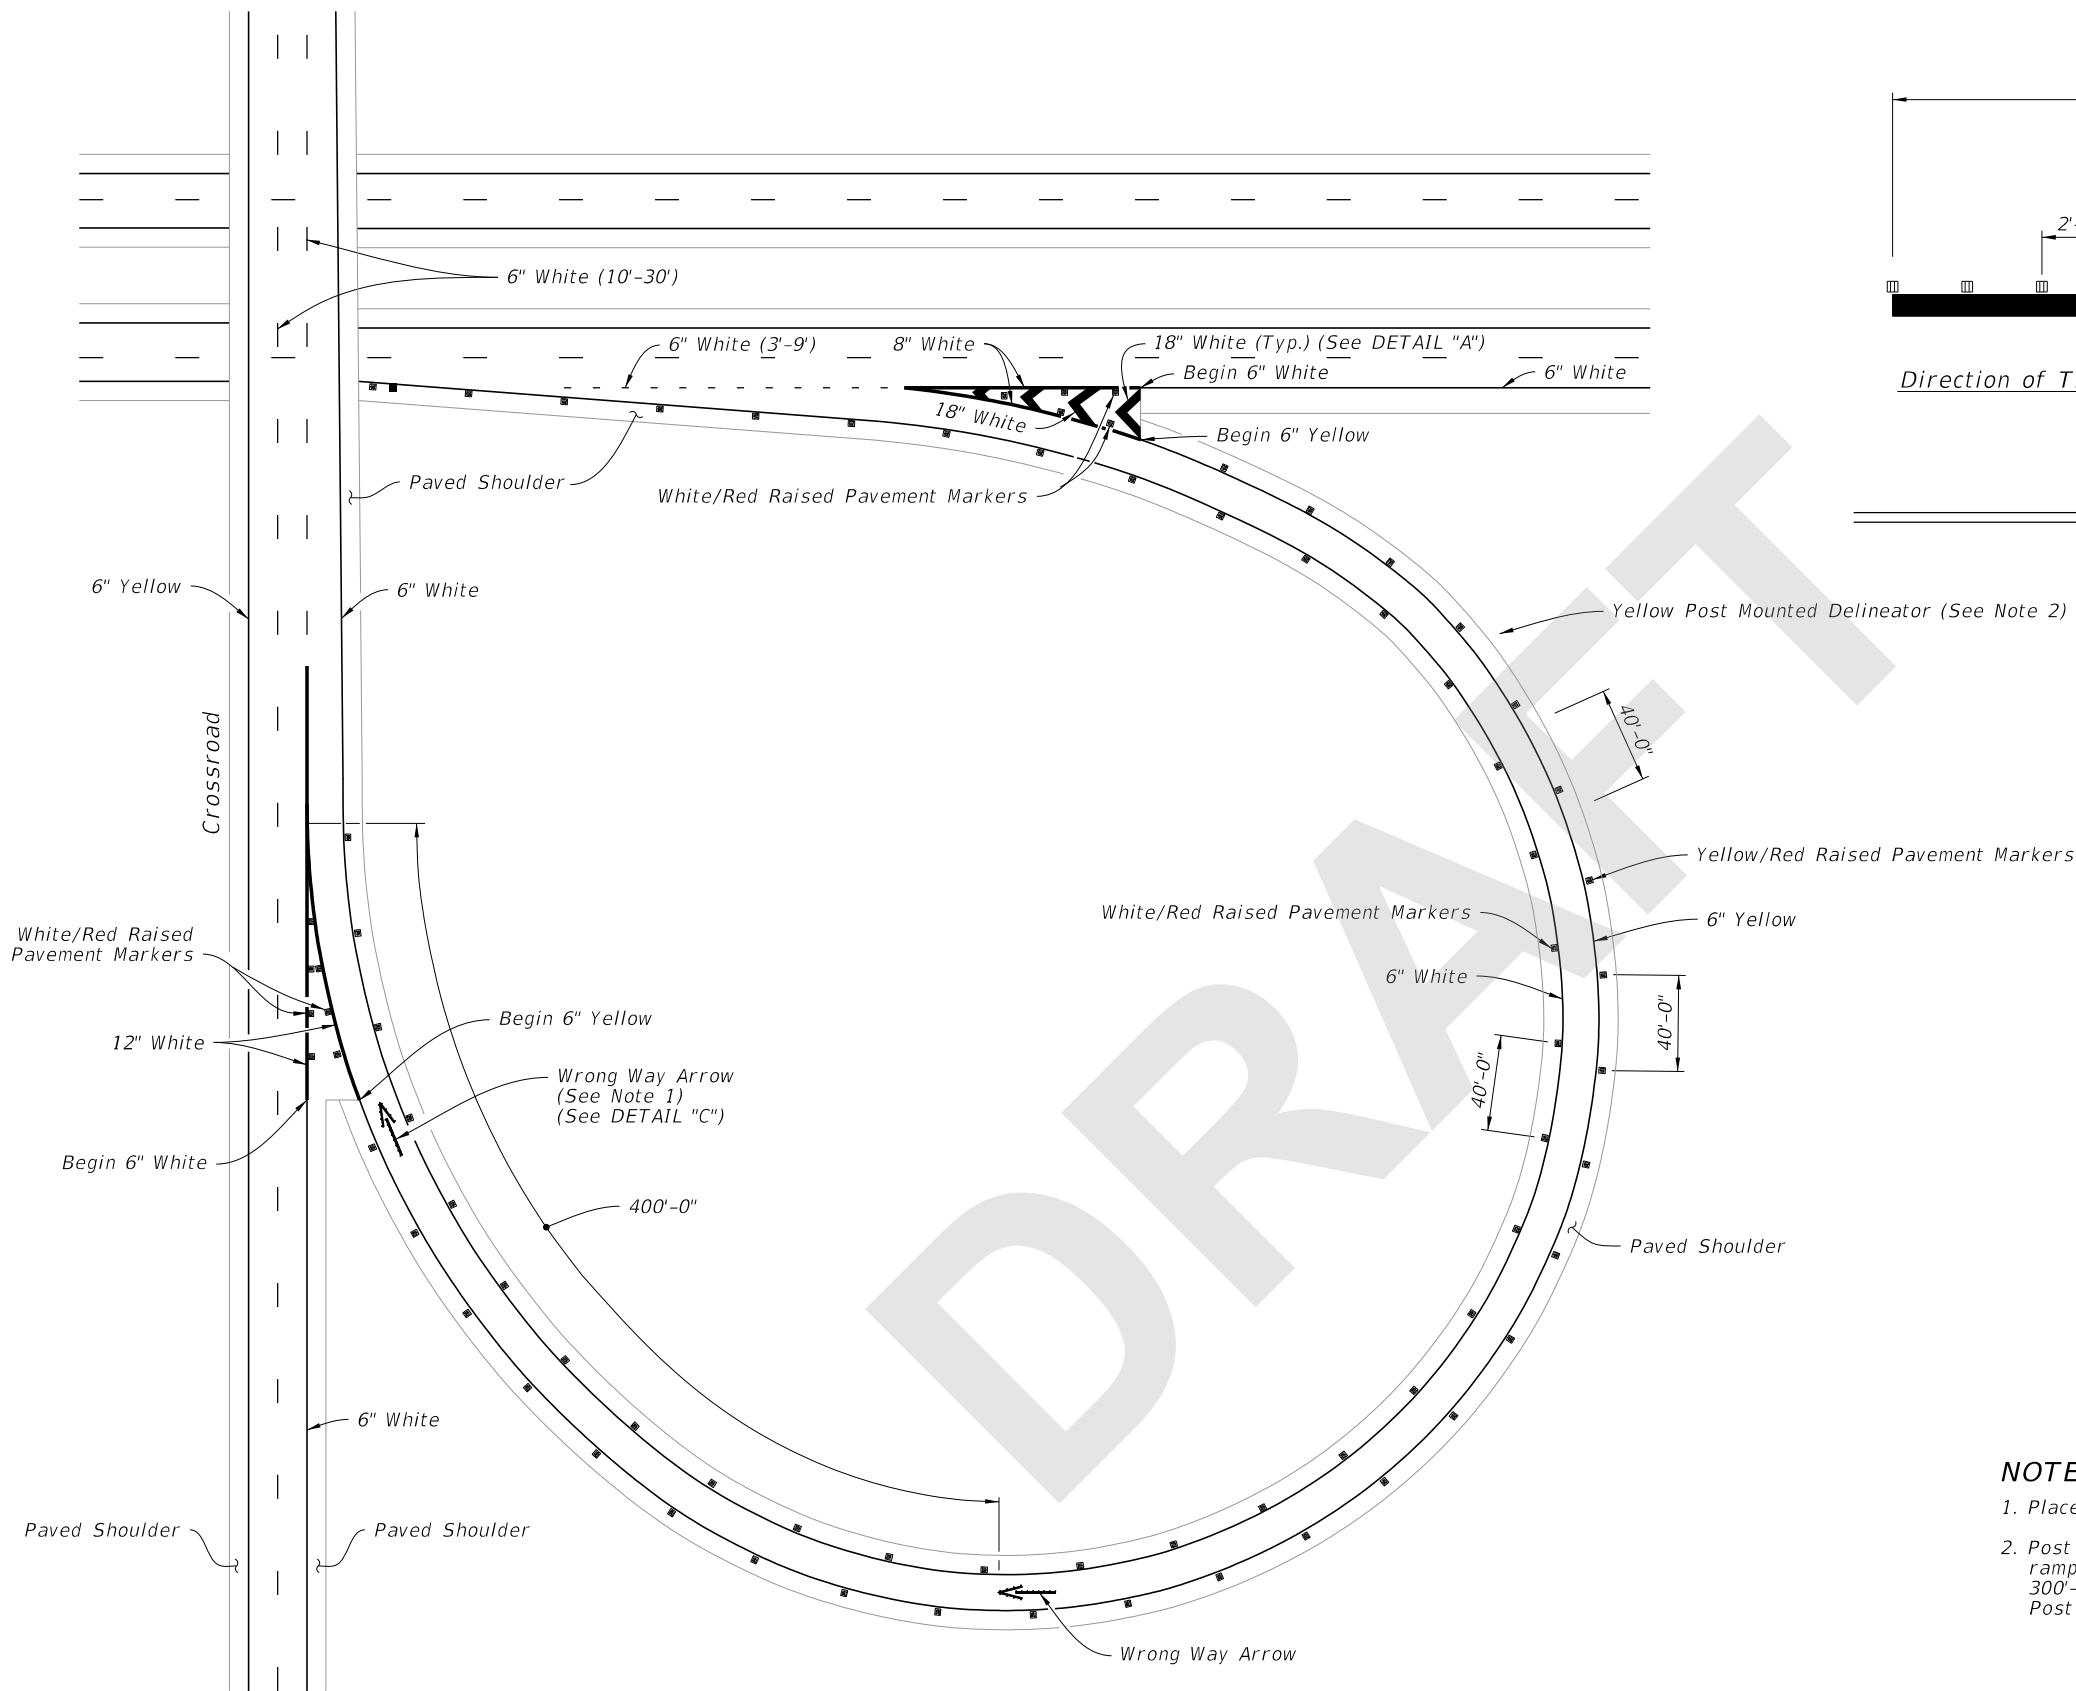


TYPICAL CURVED EXIT RAMP

- NOTES:**
1. Place the Wrong Way Arrow at the gore.
  2. Post delineators spaced at 40' on curves of the entrance and exit of ramps. The spacing on the tangent portion of the ramp section is 300'-0". All delineators are to be setback 4' from shoulder break. Post delineators should not be discontinued in sections with guardrail.

TYPICAL CURVED EXIT RAMP AND WRONG WAY ARROW


LAST REVISION 11/01/20	DESCRIPTION:
---------------------------	--------------

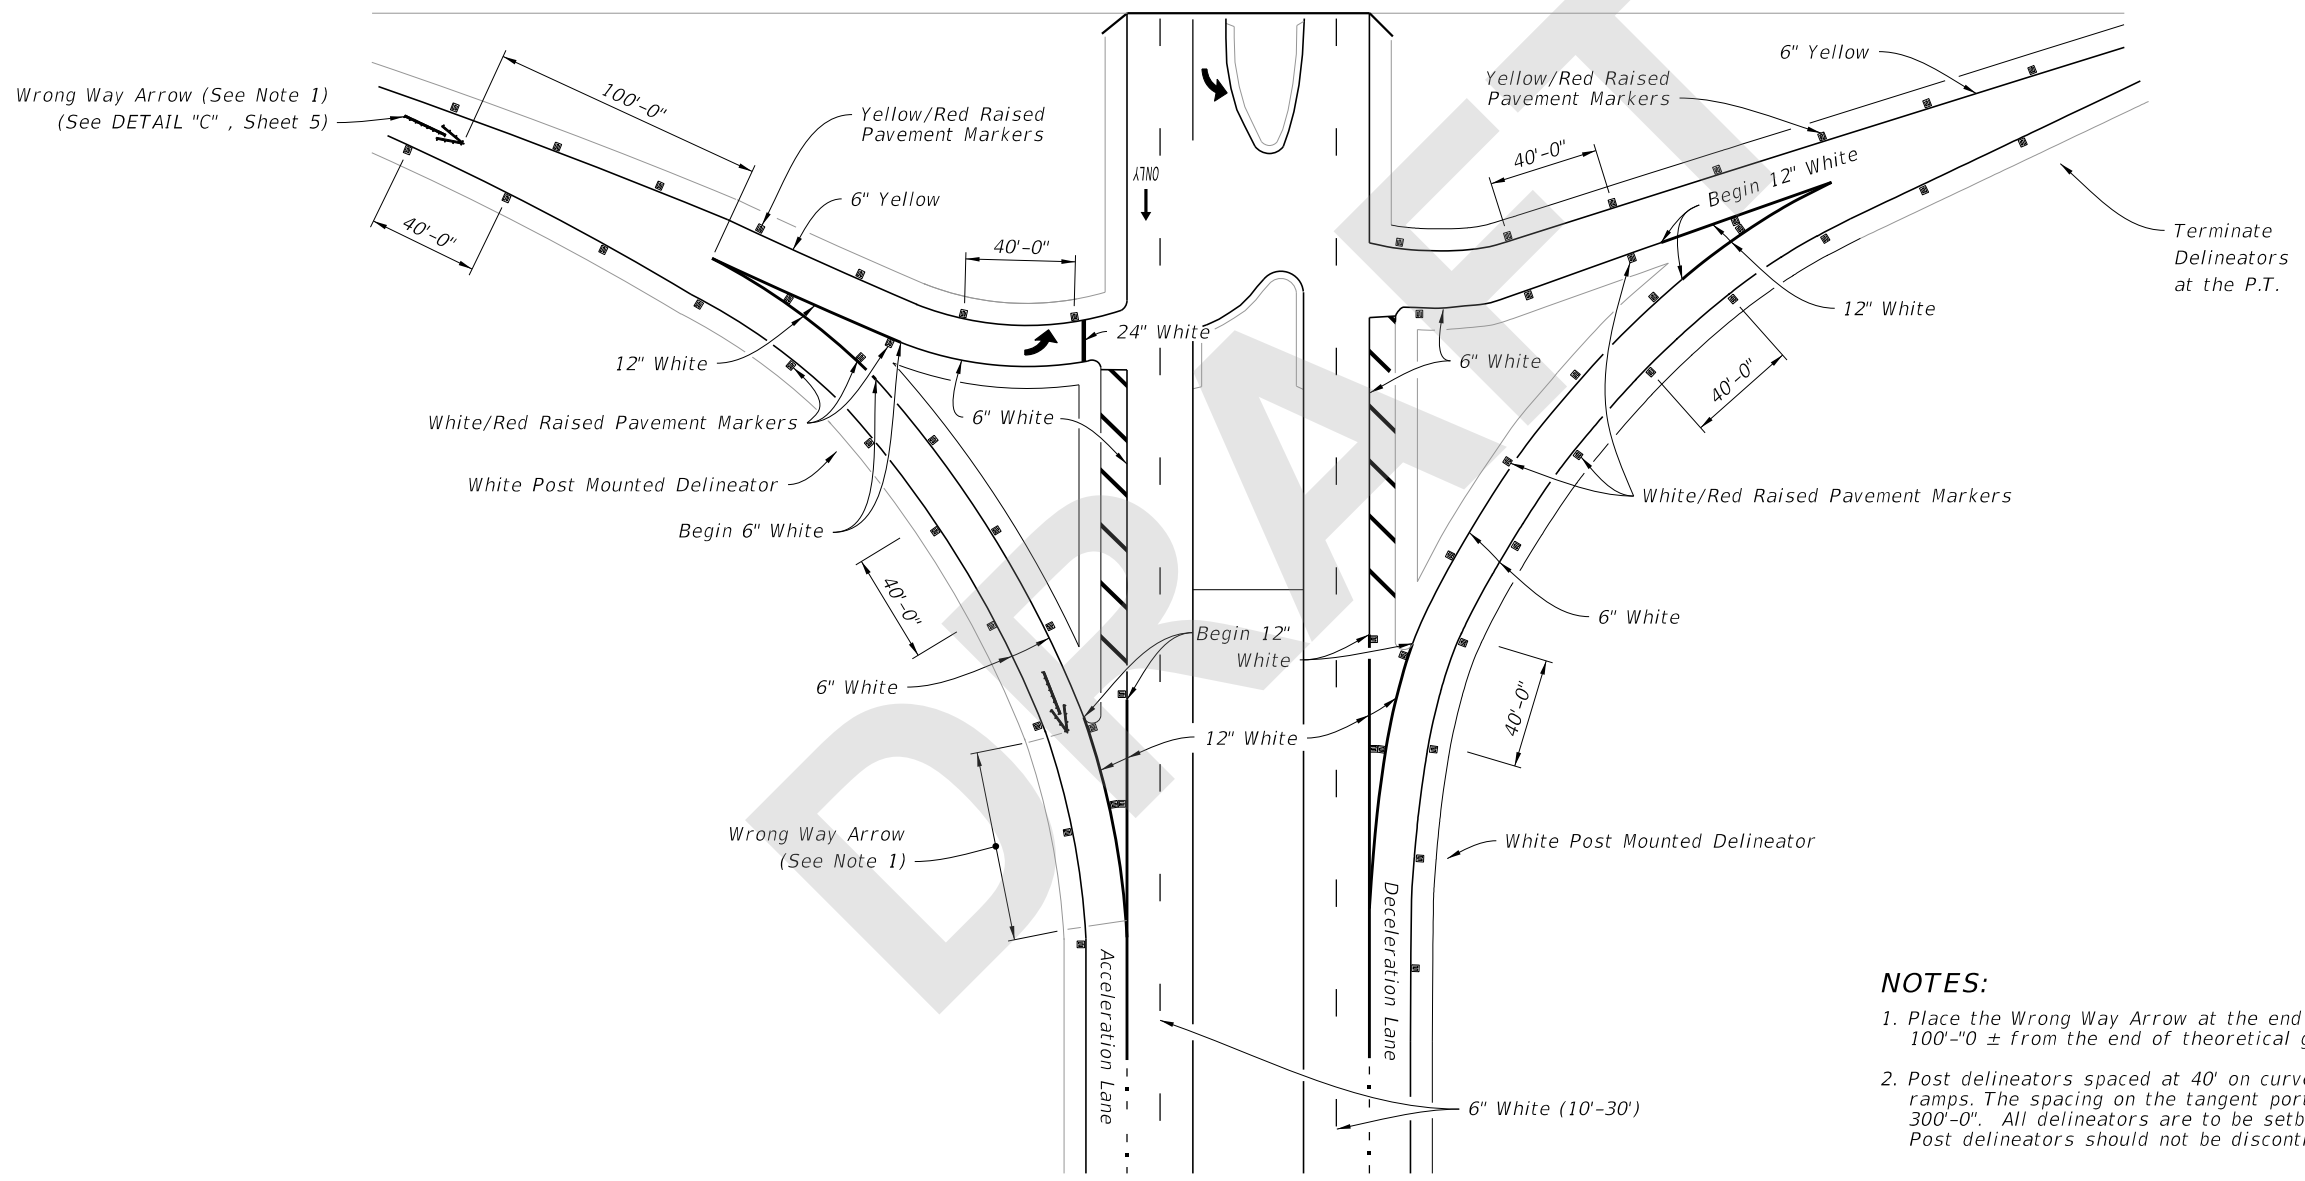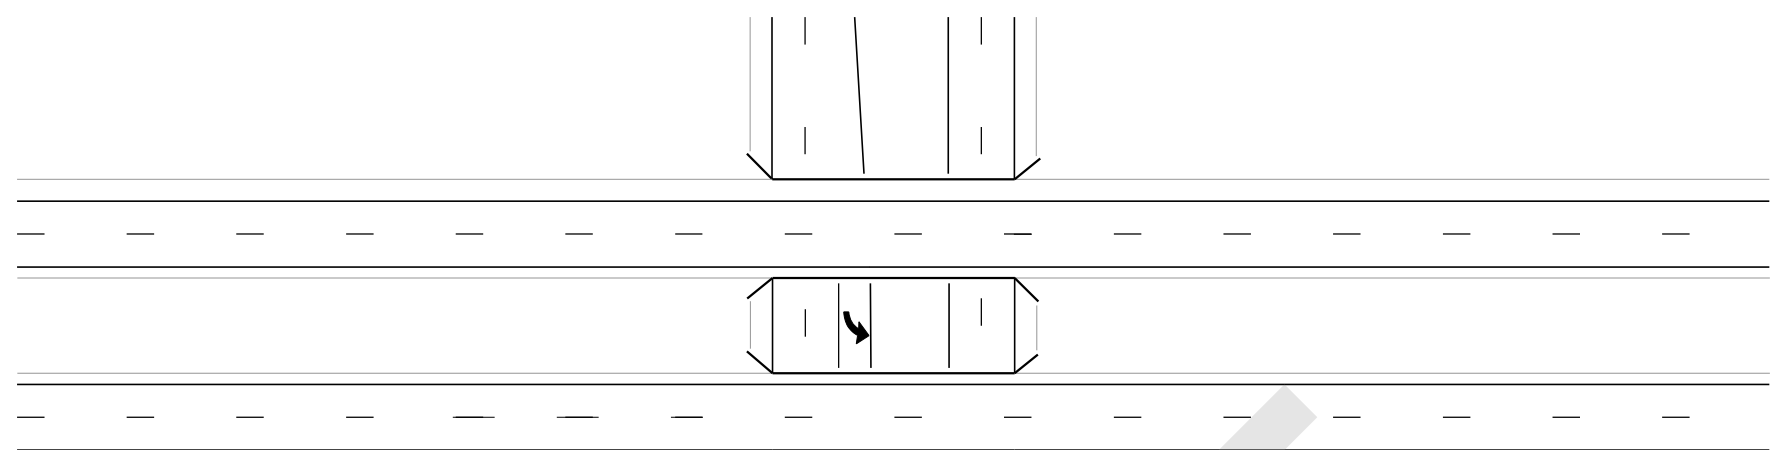

- NOTES:**
1. Place the Wrong Way Arrow at the end of the physical gore or 100'-0" ± from the end of theoretical gore.
  2. Post delineators spaced at 40' on curves of the entrance and exit of ramps. The spacing on the tangent portion of the ramp section is 300'-0". All delineators are to be setback 4' from shoulder break. Post delineators should not be discontinued in sections with guardrail.


8/10/2020 9:27:38 AM

**TYPICAL INTERSECTION**

LAST REVISION 11/01/20	REVISION	DESCRIPTION:	 <b>FY 2021-22 STANDARD PLANS</b>	<b>INTERCHANGE MARKINGS</b>	INDEX 711-003	SHEET 6 of 8
---------------------------	----------	--------------	--	-----------------------------	------------------	-----------------



8/10/2020 9:27:40 AM

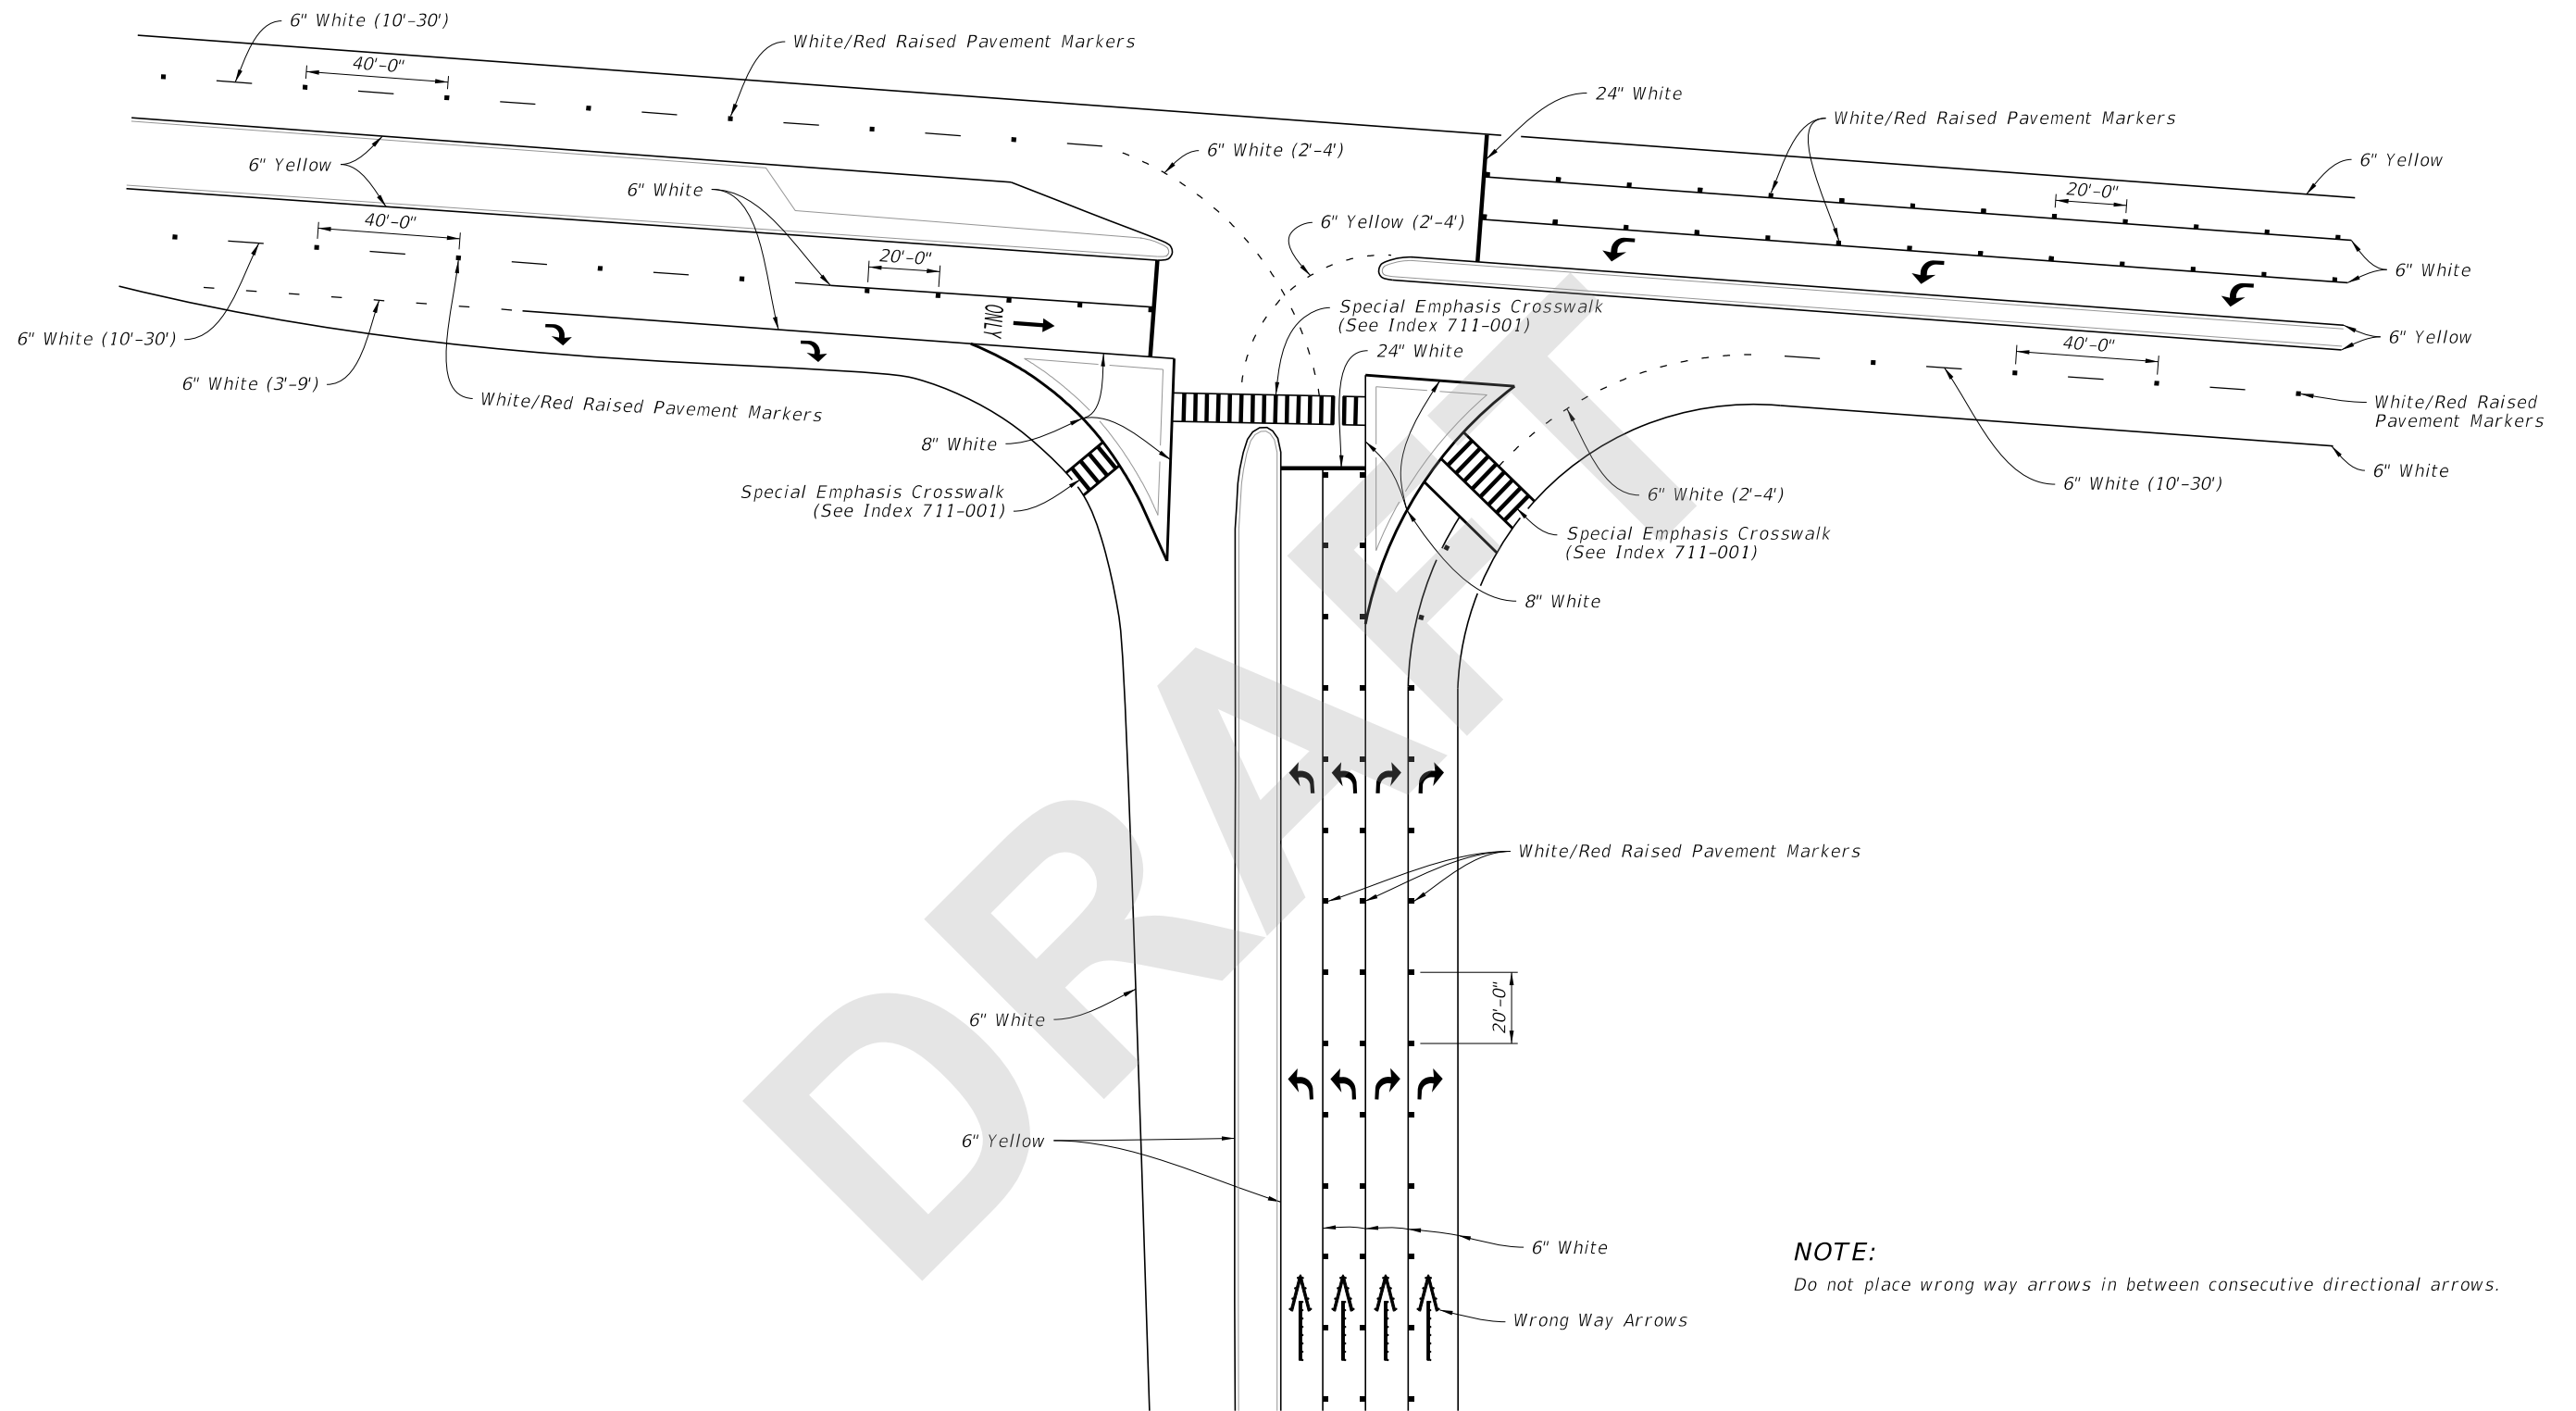

**NOTE:**  
Do not place wrong way arrows in between consecutive directional arrows.


TYPICAL PARTIAL CLOVERLEAF/TRUMPET EXIT RAMP

LAST REVISION 11/01/20	REVISION	DESCRIPTION:
---------------------------	----------	--------------


**FY 2021-22  
STANDARD PLANS**

INTERCHANGE MARKINGS


INDEX 711-003	SHEET 7 of 8
------------------	-----------------

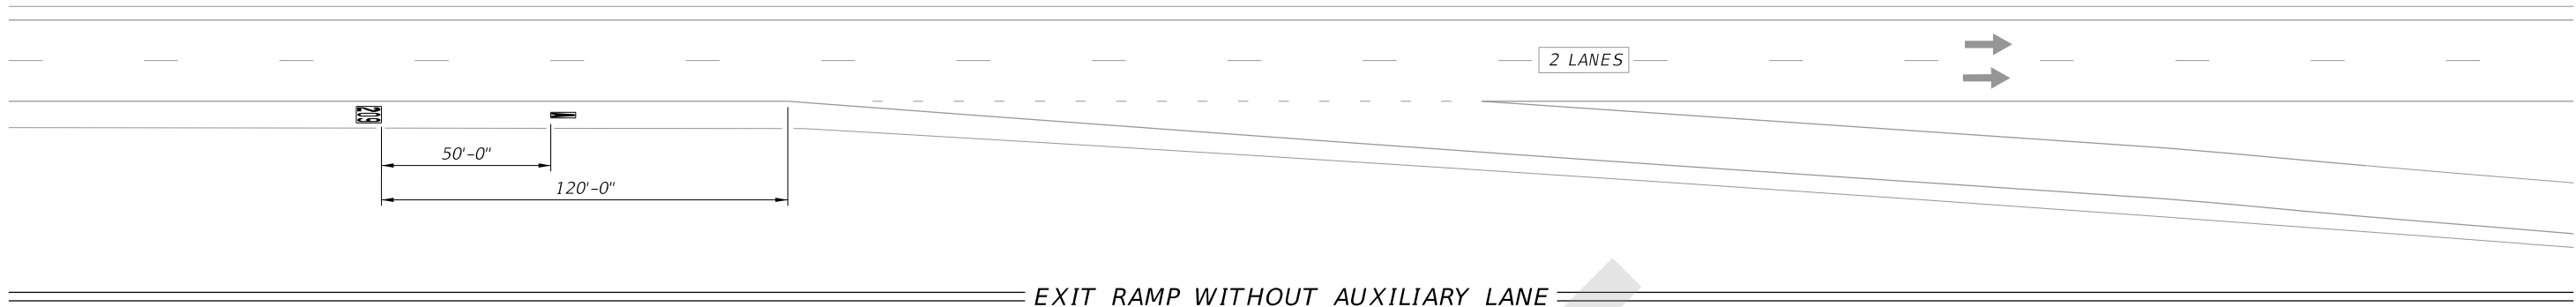

EXIT RAMP WITHOUT AUXILIARY LANE



EXIT RAMP WITH AUXILIARY LANE

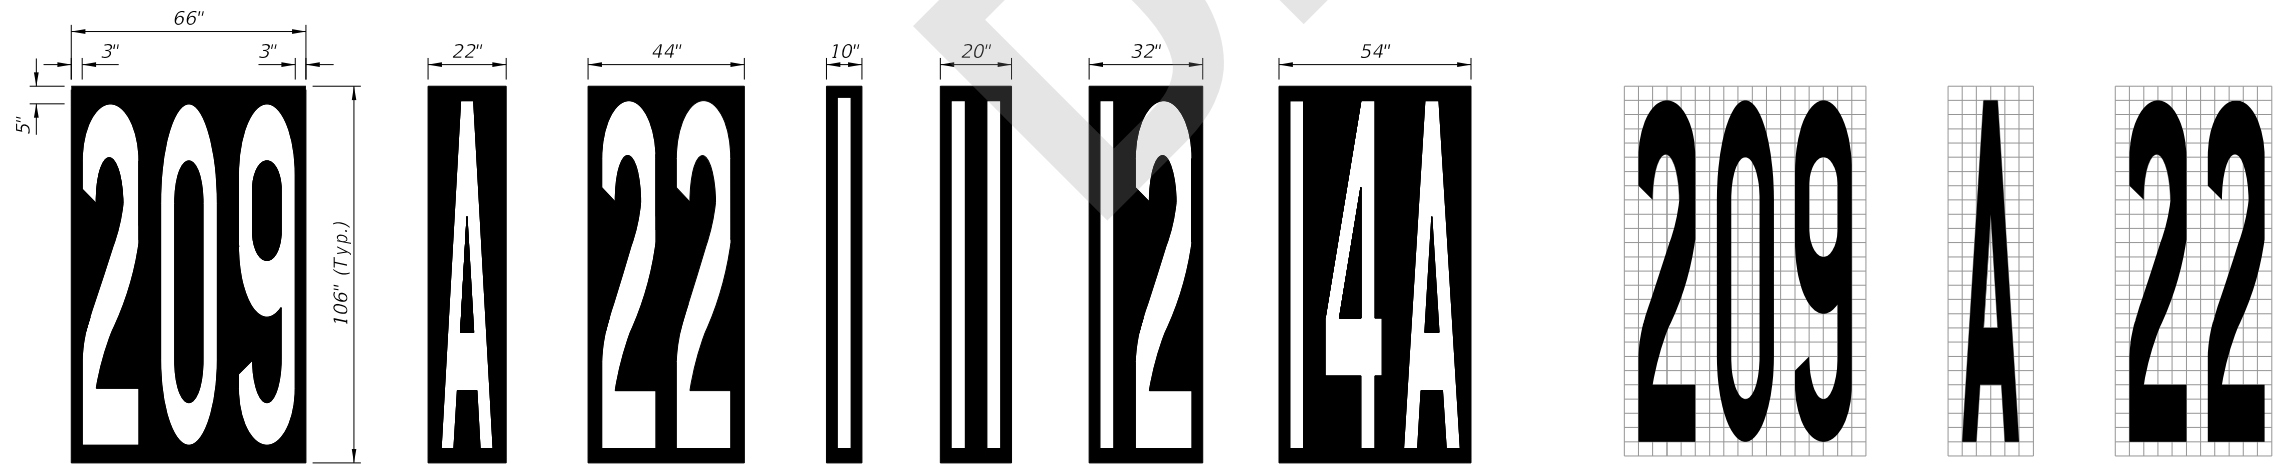

MAT DIMENSIONS

MESSAGE SIZE AND SPACING

- NOTES:**
1. This Index shows layouts for 1, 2, and 3 digit numbers and letters.
  2. The message consist of white letters and numbers with black contrasting material.
  3. The "EXIT NUMBER" position remains the same distance from the beginning of taper regardless of the number of lines of information.
  4. All Grids are 4" x4".

AUXILIARY LANE MESSAGING

8/10/2020 9:27:43 AM

LAST REVISION 11/01/20	REVISION	DESCRIPTION:	 FY 2021-22 STANDARD PLANS	INTERCHANGE MARKINGS	INDEX 711-003	SHEET 8 of 8
---------------------------	----------	--------------	--	----------------------	------------------	-----------------