

---

## ORIGINATION FORM

---

### Proposed Revisions to a Standard Plans Index (Please provide all information — Incomplete forms will be returned)

**Contact Information:**

Date: January 27, 2021

Originator: Ben Gerrell

Phone: (850) 414-4318

Email: benjamin.gerrell@dot.state.fl.us

**Standard Plans:**

Index Number: 000-510

Sheet Number (s): 1 and 2

Index Title: Superelevation Transitions - High Speed  
Roadways**Summary of the changes:**

Sheet 1: Added directional arrows to SECTION AA; Updated the Table to match FDM; added 2-Lane option to pavement with median to be consistent with FDM.

**Commentary / Background:**

These revisions to the Superelevation Transition Indexes are proposed to make the Standard Plans more consistent with the FDOT Design Manual and Table 210.9.3. Added arrows to SECTION AA to be consistent with the arrows included in Standard Plans Index 000-511.

**Other Affected Offices / Documents:** (Provide name of person contacted)

- | Yes                                 | No                                  |                                     |
|-------------------------------------|-------------------------------------|-------------------------------------|
| <input checked="" type="checkbox"/> | <input type="checkbox"/>            | Other Standard Plans – Rick Jenkins |
| <input checked="" type="checkbox"/> | <input type="checkbox"/>            | FDOT Design Manual – Ben Gerrell    |
| <input type="checkbox"/>            | <input checked="" type="checkbox"/> | Basis of Estimates Manual –         |
| <input type="checkbox"/>            | <input checked="" type="checkbox"/> | Standard Specifications –           |
| <input type="checkbox"/>            | <input checked="" type="checkbox"/> | Approved Product List –             |
| <input type="checkbox"/>            | <input checked="" type="checkbox"/> | Construction –                      |
| <input type="checkbox"/>            | <input checked="" type="checkbox"/> | Maintenance –                       |

**Origination Package Includes:**

(Email or hand deliver package to Rick Jenkins)

- | Yes                                 | N/A                      |  |
|-------------------------------------|--------------------------|--|
| <input checked="" type="checkbox"/> | <input type="checkbox"/> | Redline Mark-ups                         |
| <input type="checkbox"/>            | <input type="checkbox"/> | Proposed Standard Plan Instruction (SPI) |
| <input type="checkbox"/>            | <input type="checkbox"/> | Revised SPI                              |
| <input type="checkbox"/>            | <input type="checkbox"/> | Other Support Documents                  |


**Implementation:**

- |                                     |                                  |
|-------------------------------------|----------------------------------|
| <input type="checkbox"/>            | Design Bulletin (Interim)        |
| <input type="checkbox"/>            | DCE Memo                         |
| <input type="checkbox"/>            | Program Mgmt. Bulletin           |
| <input checked="" type="checkbox"/> | FY-Standard Plans (Next Release) |

---

Contact the Roadway Design Office for assistance in completing this form

---

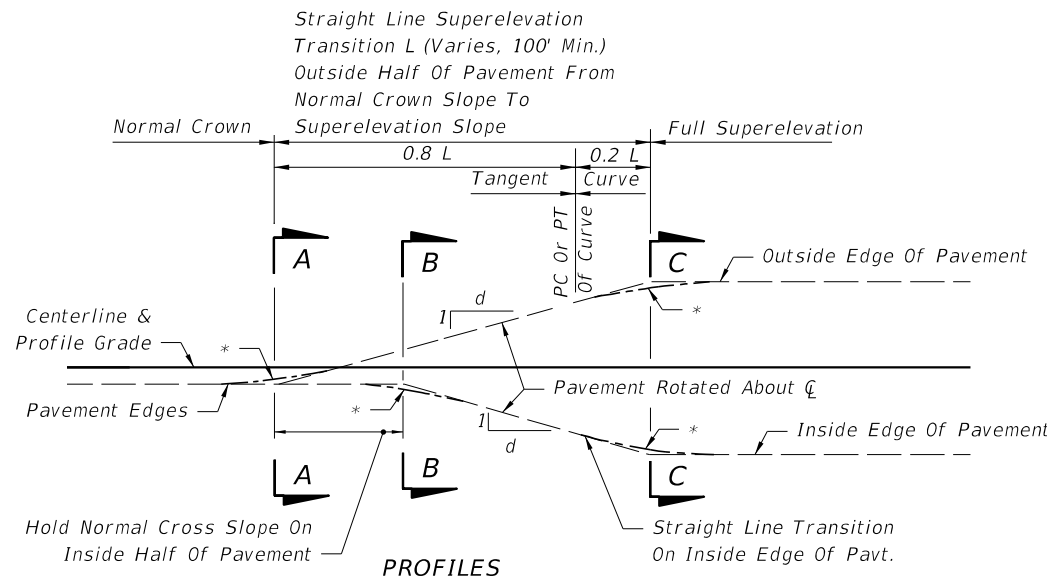



**SLOPE RATIOS FOR SUPERELEVATION TRANSITIONS**

SECTION	DESIGN SPEED, MPH		
	45-50	55-60	65-70
2 Lane & 4 Lane	1:200	1:225	1:250
6 Lane	1:160	1:180	1:200
8 Lane	1:150	1:170	1:190

The length of superelevation transition is to be determined by the relative slope between the travel way edge of pavement and the profile grade, except that the minimum length of transition shall be 100 ft.

\* Short Vertical Curves Are To Be Used On Construction To Avoid Angular Breaks In Edge Profiles


**UPDATED TABLE**

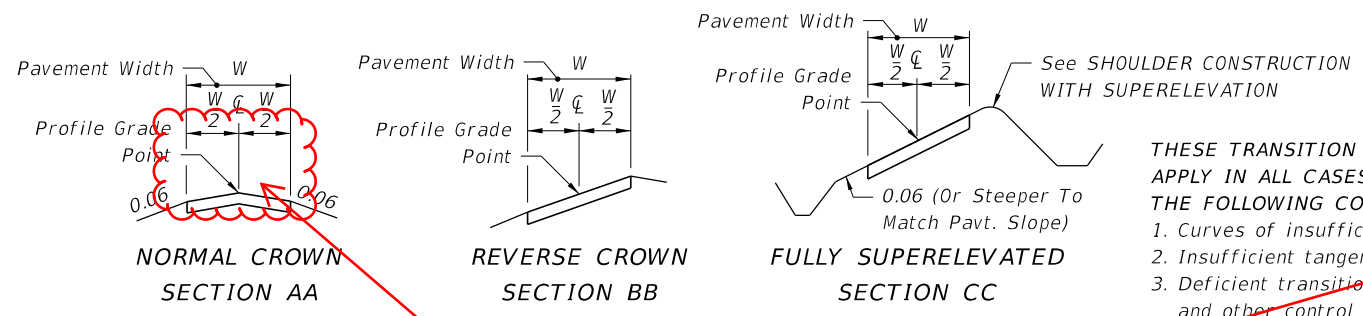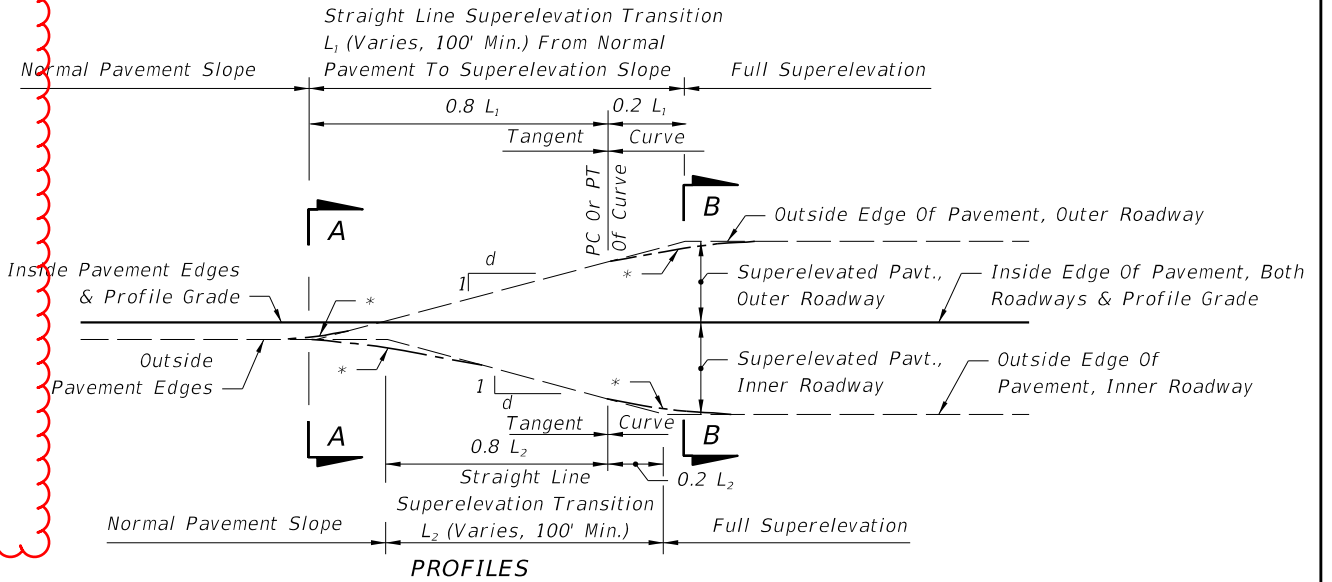

THESE TRANSITION DETAILS ARE TO APPLY IN ALL CASES, EXCEPT UNDER THE FOLLOWING CONDITIONS:

1. Curves of insufficient length.
2. Insufficient tangent length between curves.
3. Deficient transition distance between a curve and other control point(s).
4. At PCC's or PRC's (Runoff rates are applicable).

Transitions for these exceptions are to be as detailed in the plans.

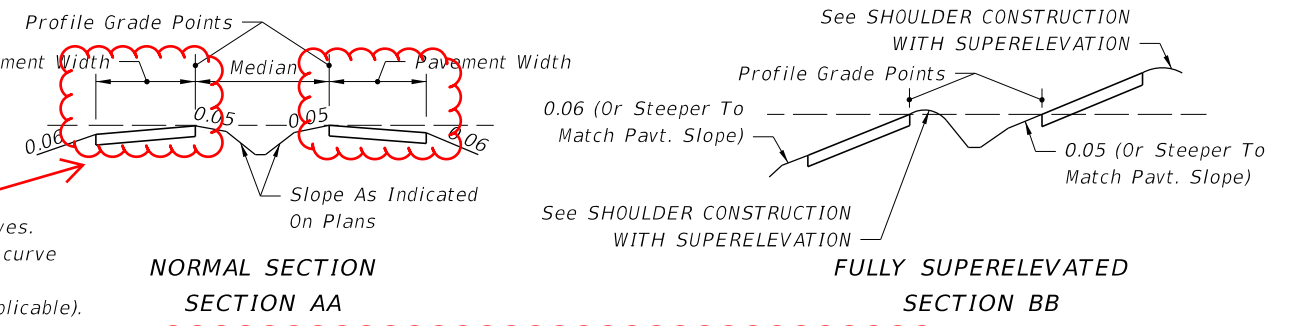


2-LANE, 4-LANE OR 6-LANE PAVEMENT, NO MEDIAN

2-LANE, 4-LANE OR 6-LANE PAVEMENT WITH MEDIAN

**NOTES:**


1. These details apply to both paved and grassed shoulders. For median shoulders use 0.05 in lieu of 0.06.
2. SHOULDER ON HIGH SIDE: A shoulder slope of 0.06 downward from the edge of travel way will be maintained until a 0.07 break in slope at the pavement edge is reached due to superelevation of the pavement. As the pavement superelevation increases, the 0.07 break in slope will be maintained and the shoulder flattened until the shoulder slope reaches the minimum of 0.02 downward from the edge of travel way. Any further increase in pavement superelevation will necessitate sloping the inside half of the shoulder toward the travel way and the outer half outward, both at 0.02 for superelevations 0.06-0.09 and both at 0.03 for superelevation 0.10. For shoulders with paved widths 5 feet or less see Special Shoulder Break Over Details on Sheet 2 of 2.
3. SHOULDER ON LOW SIDE: Maintain 0.06 cross slope across shoulder until pavement cross slope reaches 0.06. For pavement cross slopes greater than 0.06, shoulder to have same slope as pavement. See SHOULDER SLOPES ON SUPERELEVATION SECTION (Sheet 2).

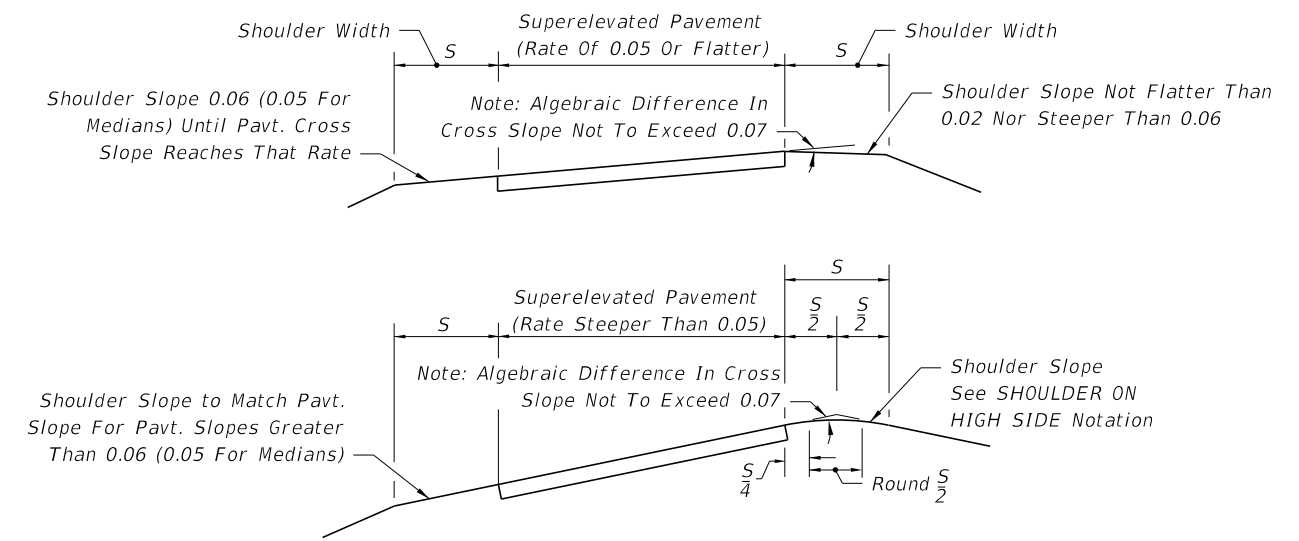

**SHOULDER CONSTRUCTION WITH SUPERELEVATION**

10/9/2020 1:07:10 PM

11/01/21


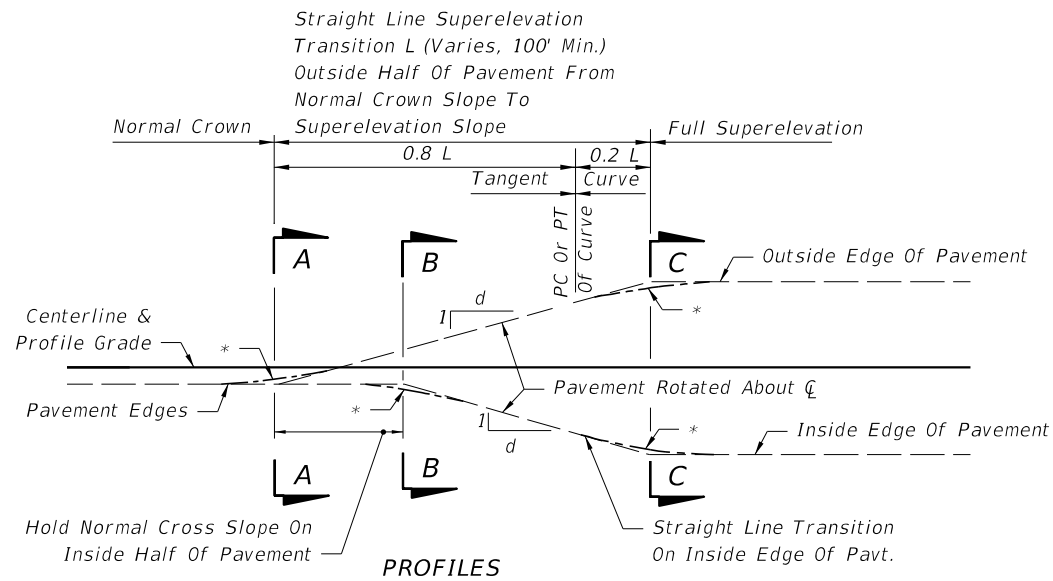


**SLOPE RATIOS FOR SUPERELEVATION TRANSITIONS**

NUMBER OF LANES IN ONE DIRECTION	DESIGN SPEED, MPH			
	25-40	45-50	55-60	65-70
	1 : d			
1 Lane & 2 Lane	1:175	1:200	1:225	1:250
3 Lane	--	1:160	1:180	1:200
4 Lane or More	--	1:170	1:170	1:190

The length of superelevation transition is to be determined by the relative slope between the travel way edge of pavement and the profile grade, except that the minimum length of transition shall be 100 ft.


\* Short Vertical Curves Are To Be Used On Construction To Avoid Angular Breaks In Edge Profiles

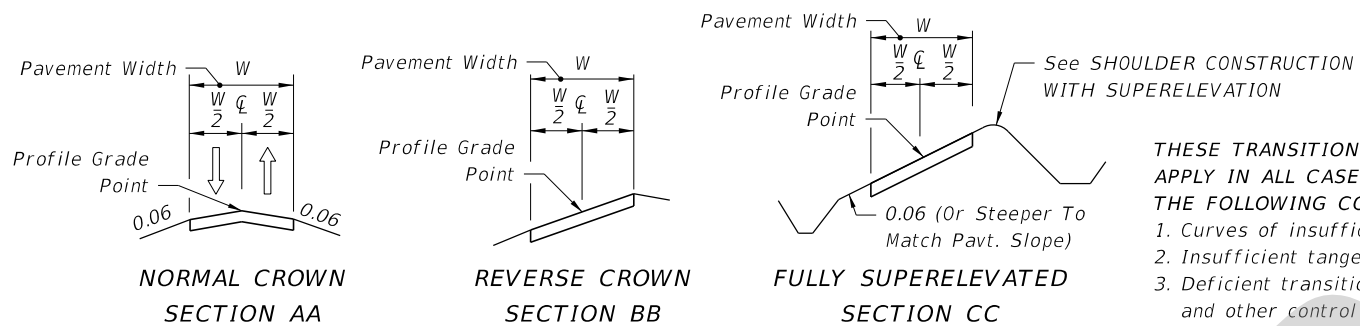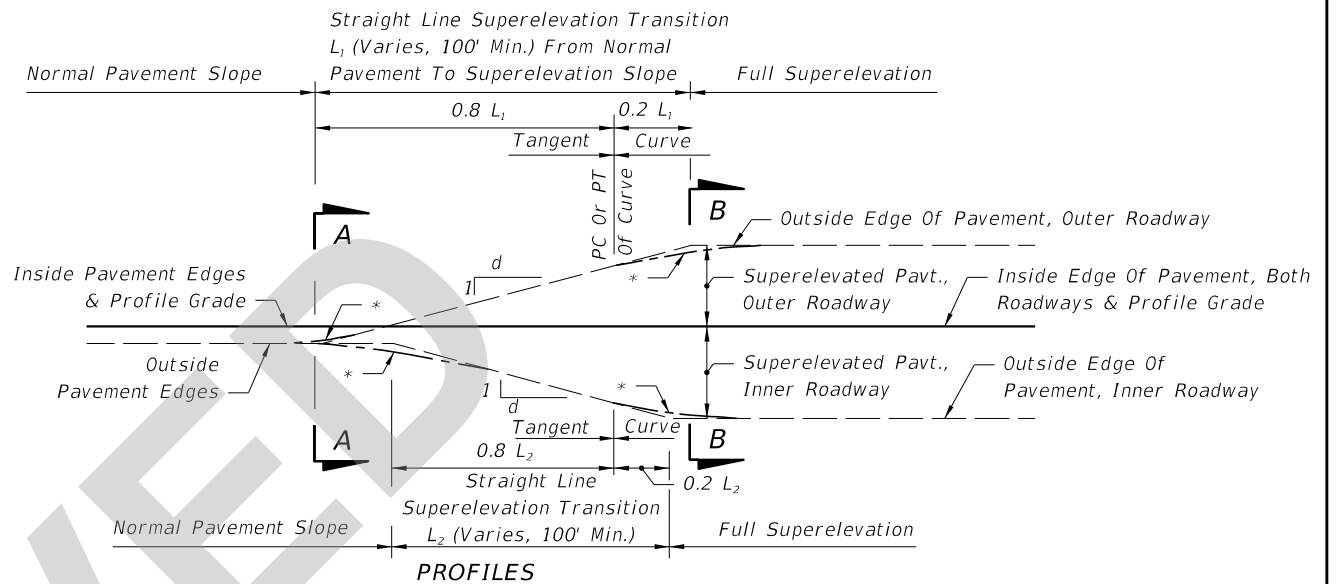

2-LANE, 4-LANE OR 6-LANE PAVEMENT, NO MEDIAN

- THESE TRANSITION DETAILS ARE TO APPLY IN ALL CASES, EXCEPT UNDER THE FOLLOWING CONDITIONS:
1. Curves of insufficient length.
  2. Insufficient tangent length between curves.
  3. Deficient transition distance between a curve and other control point(s).
  4. At PCC's or PRC's (Runoff rates are applicable).

Transitions for these exceptions are to be as detailed in the plans.

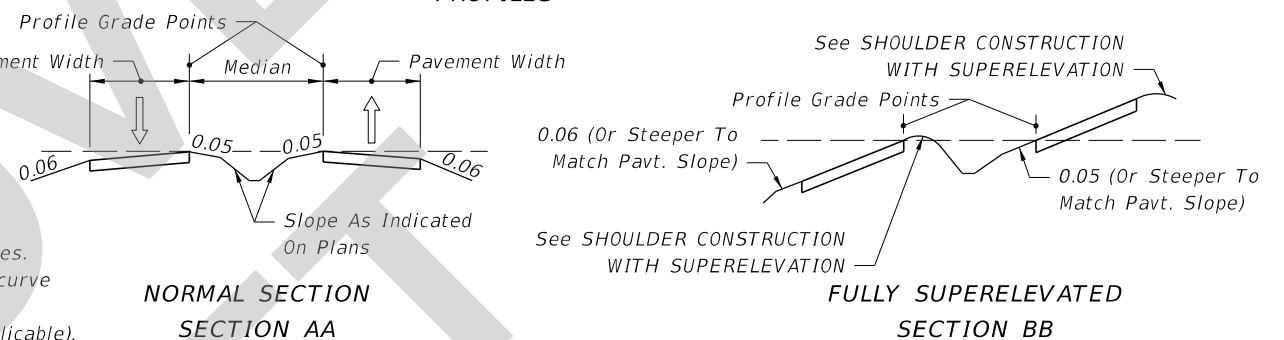

2-LANE, 4-LANE OR 6-LANE PAVEMENT WITH MEDIAN


**SUPERELEVATION TRANSITIONS**

**SYMBOL:**

→ Direction of Traffic

**NOTES:**

1. These details apply to both paved and grassed shoulders. For median shoulders use 0.05 in lieu of 0.06.
2. **SHOULDER ON HIGH SIDE:** A shoulder slope of 0.06 downward from the edge of travel way will be maintained until a 0.07 break in slope at the pavement edge is reached due to superlevation of the pavement. As the pavement superlevation increases, the 0.07 break in slope will be maintained and the shoulder flattened until the shoulder slope reaches the minimum of 0.02 downward from the edge of travel way. Any further increase in pavement superlevation will necessitate sloping the inside half of the shoulder toward the travel way and the outer half outward, both at 0.02 for superelevations 0.06-0.09 and both at 0.03 for superlevation 0.10. For shoulders with paved widths 5 feet or less see Special Shoulder Break Over Details on Sheet 2 of 2.
3. **SHOULDER ON LOW SIDE:** Maintain 0.06 cross slope across shoulder until pavement cross slope reaches 0.06. For pavement cross slopes greater than 0.06, shoulder to have same slope as pavement. See SHOULDER SLOPES ON SUPERELEVATION SECTION (Sheet 2).

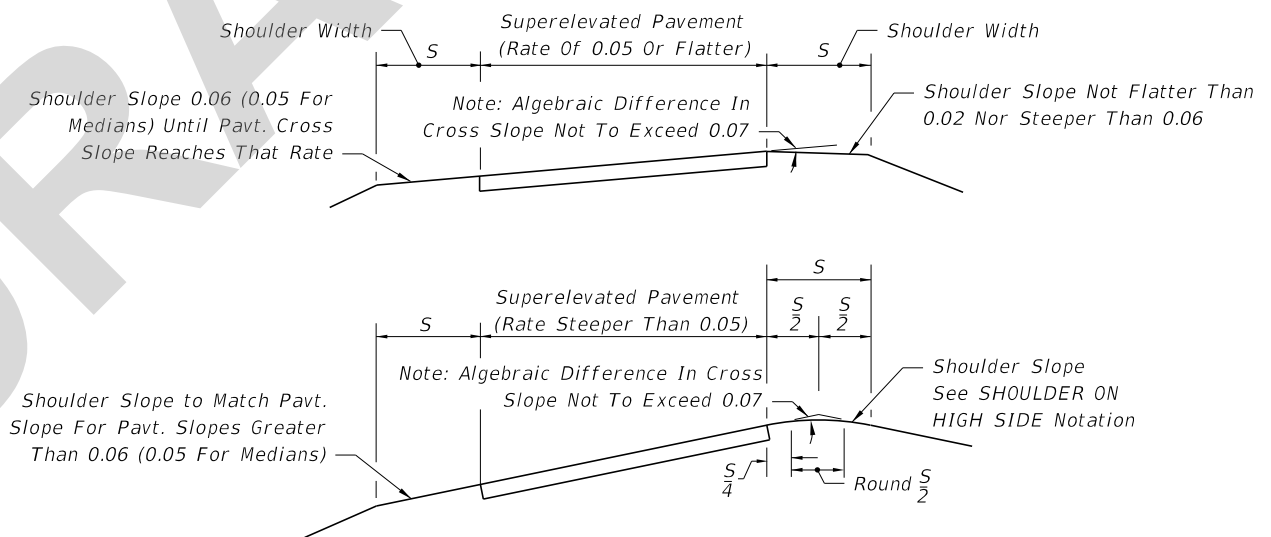

**SHOULDER CONSTRUCTION WITH SUPERELEVATION**

5/3/2021 9:59:33 AM

LAST REVISION 11/01/21	REVISION	DESCRIPTION:		FY 2022-23 STANDARD PLANS	SUPERELEVATION TRANSITIONS - HIGH SPEED ROADWAYS	INDEX 000-510	SHEET 1 of 2
---------------------------	----------	--------------	--	------------------------------	---	------------------	-----------------