

## Index 520-001 Curb and Gutter

### ORIGINATION

**Date:** 1-27-21

**Name:** Rick Jenkins

**Phone:** (850) 414-4355

**Email:** Rick.Jenkins@dot.state.fl.us

### COMMENTARY

Redeveloped index. Moved General Notes to new sheet 1 and created isometric views to stay consistent with other indexes.

### COMMENTS AND RESPONSES


**BLACK** = Industry Review Comments    **RED** = Standard Plans Response    **GREEN** = Change Made to Index

**Name:** K.C. Jose

**Date:** 8/31/2021

**COMMENT:** Draft page 3/3:- Contraction joints- Depth of saw cut for type E, F curbs on the front side show 5" max and 0" minimum is confusing. Please consider to depict the depth of saw cut by not showing the 0" minimum .

Screen shot-

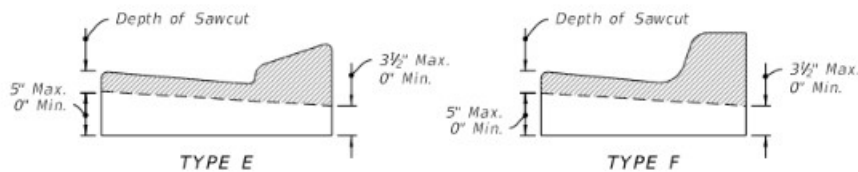

**RESPONSE:** This comment will be considered for a future revision.

**No Change Made**

**Date:** 9/2/2021