
ORIGINATION FORM

Proposed Revisions to a Standard Plans Index
(Please provide all information — Incomplete forms will be returned)

Contact Information:

Date: July 27, 2021
Originator: Rick Jenkins
Phone: (850) 414-4355
Email: rick.jenkins@dot.state.fl.us

Standard Plans:

Index Number: 520-005
Sheet Number (s): All
Index Title: Concrete Shoulder Gutter Spillway

Summary of the changes:

Deleted notes; redrew details.

Commentary / Background:

Redeveloped Index and deleted notes that are now covered in the SPI.

Other Affected Offices / Documents: (Provide name of person contacted)

Yes	No	
☐	☒	Other Standard Plans –
☐	☒	FDOT Design Manual –
☐	☒	Basis of Estimates Manual –
☐	☒	Standard Specifications –
☐	☒	Approved Product List –
☐	☒	Construction –
☐	☒	Maintenance –

Origination Package Includes:


(Email or hand deliver package to Rick Jenkins)

Yes	N/A	
☒	☐	Redline Mark-ups
☐	☐	Proposed Standard Plan Instruction (SPI)
☐	☐	Revised SPI
☐	☐	Other Support Documents

Implementation:

☐ Design Bulletin (Interim)
☐ DCE Memo
☐ Program Mgmt. Bulletin
☒ FY-Standard Plans (Next Release)

Contact the Roadway Design Office for assistance in completing this form

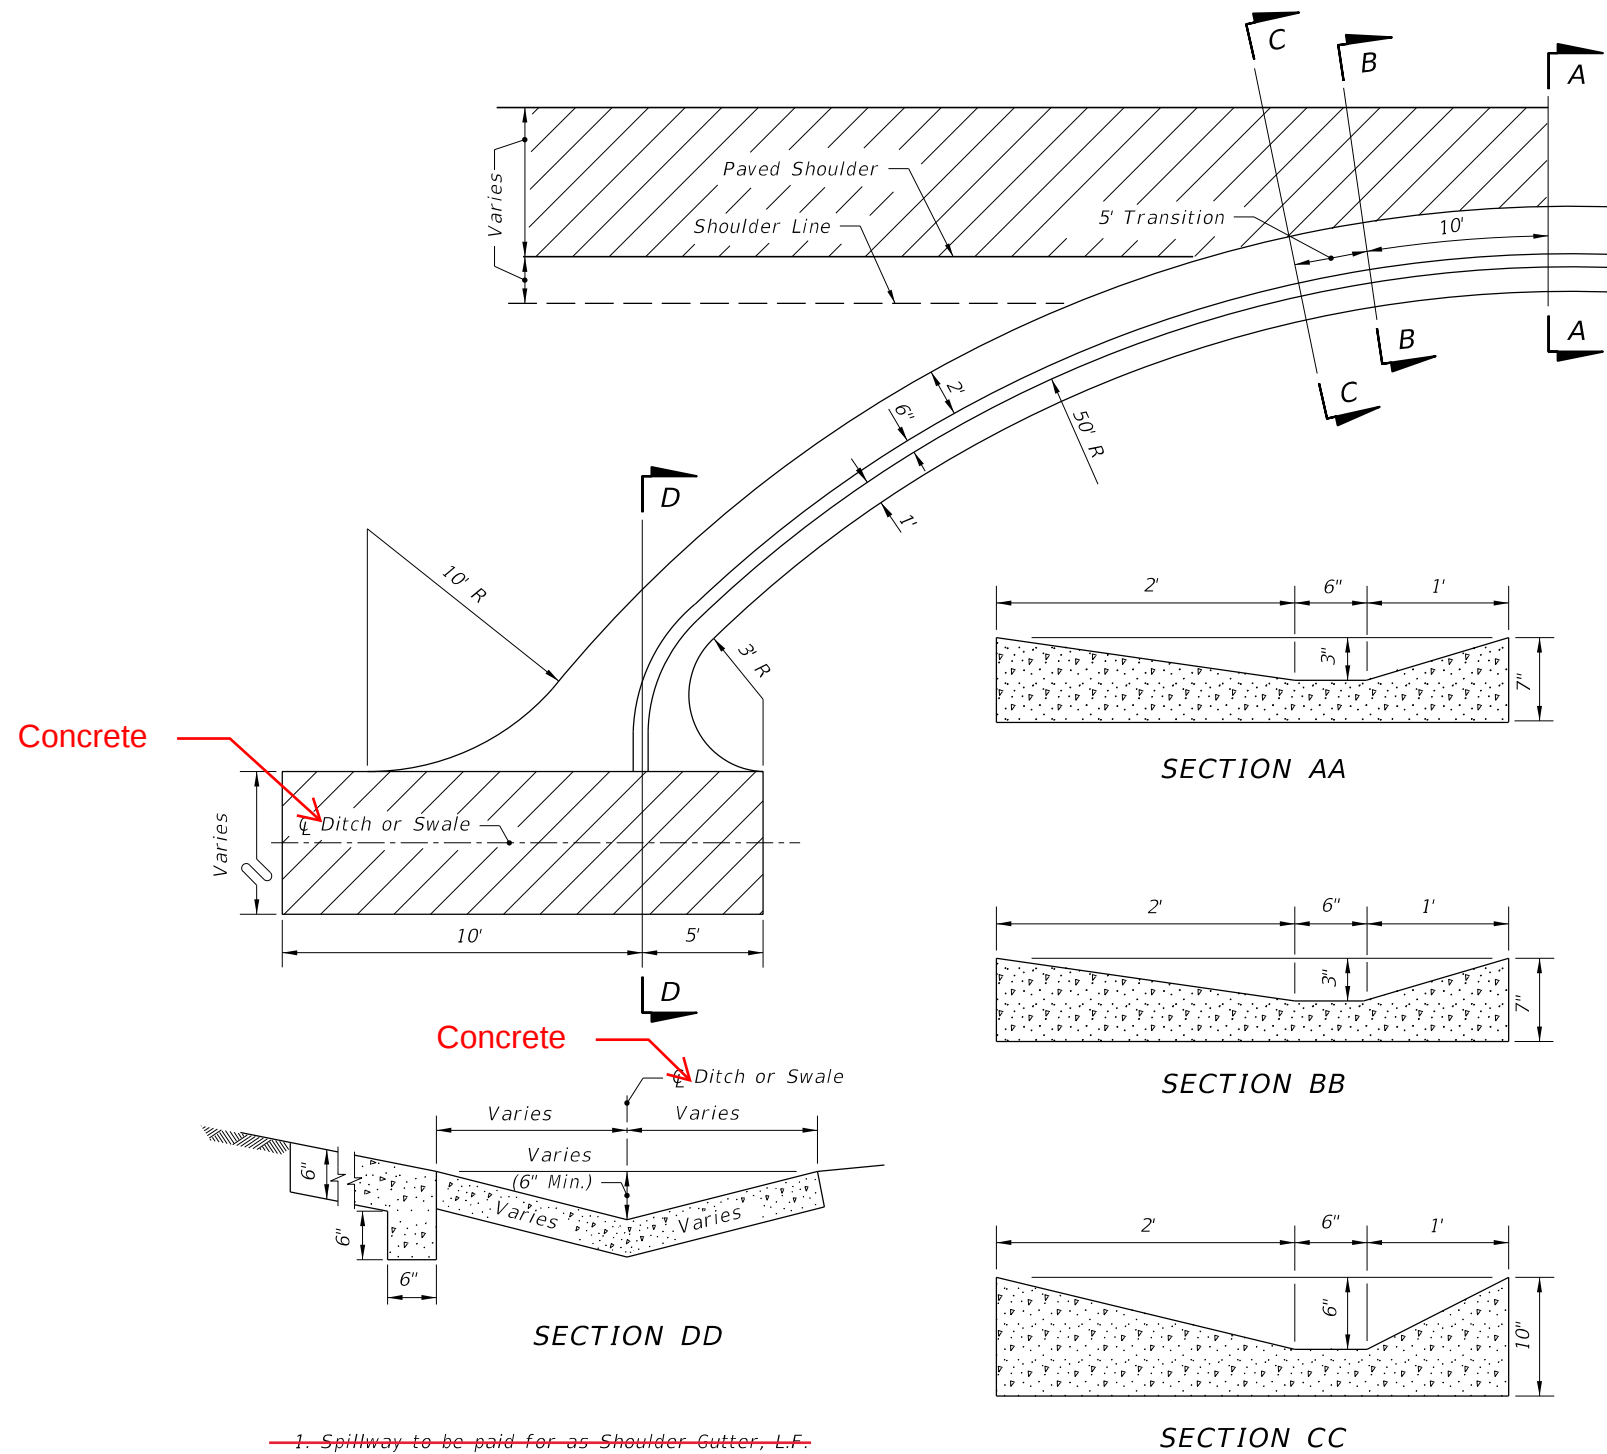

- ~~1. Spillway to be paid for as Shoulder Gutter, L.F.~~
- ~~2. If spillway empties into an unpaved ditch, the detail should be modified as necessary.~~

DETAIL OF CONCRETE SPILLWAY AT END OF SHOULDER GUTTER
~~(TO BE USED WHERE INLETS, PIPES & ENDWALLS ARE IMPRACTICAL)~~

10/12/2020 7:32:17 AM

LAST REVISION	DESCRIPTION:
11/01/17	
11/01/21	





FY 2021-22
STANDARD PLANS


CONCRETE SHOULDER GUTTER SPILLWAY

INDEX
520-005


SHEET
1 of 1

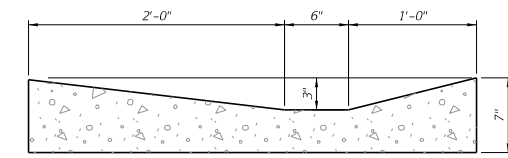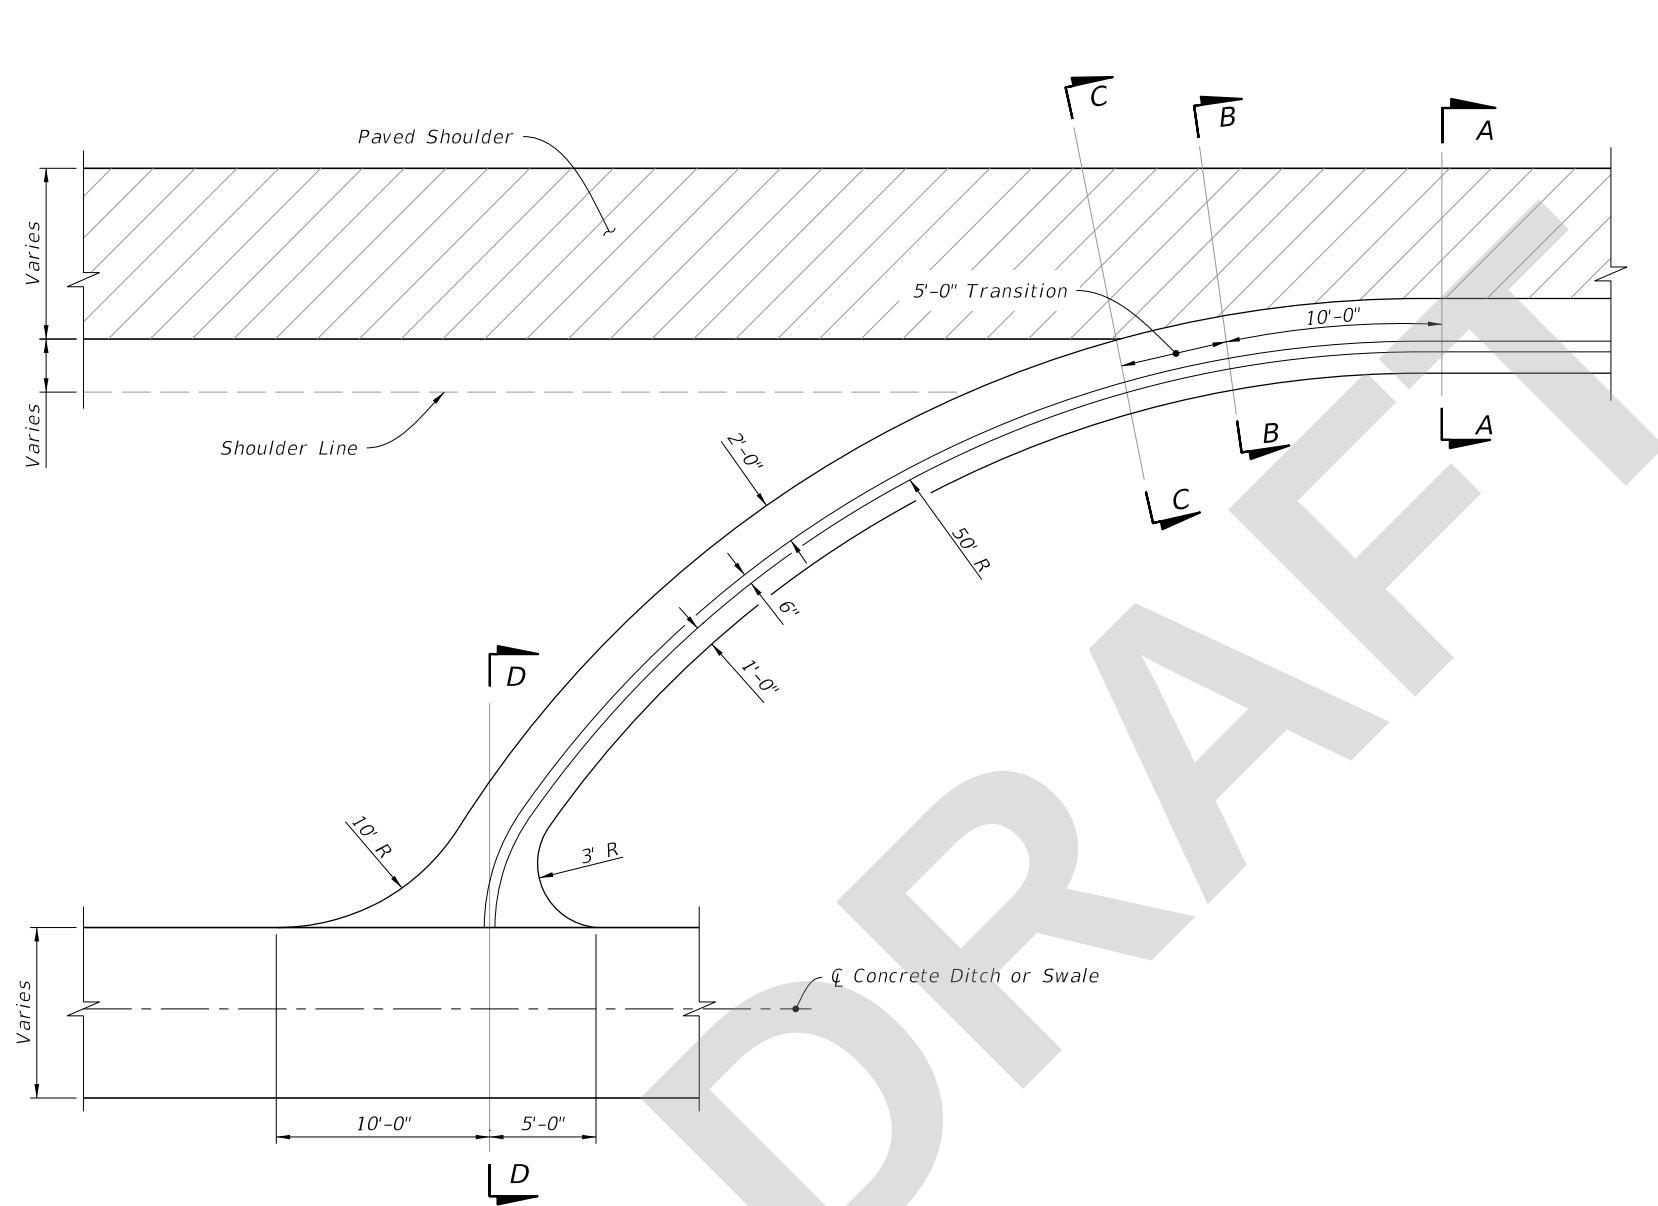


SECTION AA

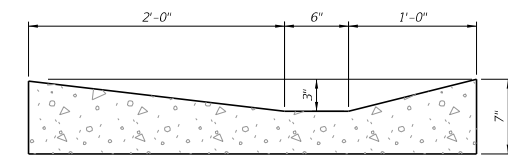

SECTION BB

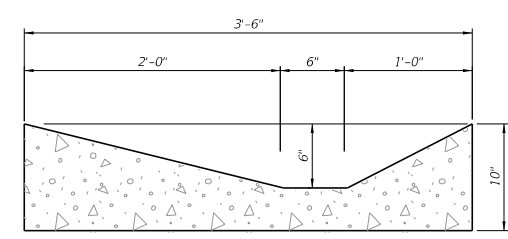

SECTION CC

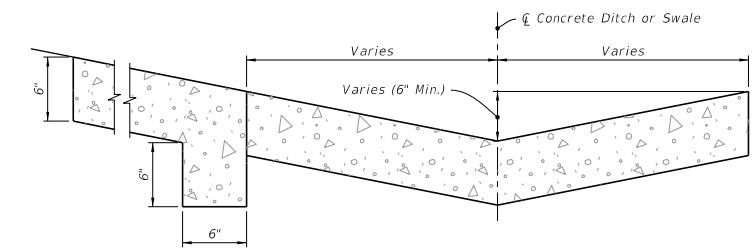

SECTION DD

CONCRETE SPILLWAY AT END OF SHOULDER GUTTER DETAILS

8/6/2021 1:55:06 PM

LAST REVISION 11/01/21	REVISION	DESCRIPTION:	 FY 2022-23 STANDARD PLANS	CONCRETE SHOULDER GUTTER SPILLWAY	INDEX 520-005	SHEET 1 of 1
------------------------------	----------	--------------	--	-----------------------------------	------------------	-----------------