

---

## ORIGINATION FORM

---

Proposed Revisions to a Standard Plans Index  
(Please provide all information — Incomplete forms will be returned)

**Contact Information:**

Date: July 27, 2021  
Originator: Rick Jenkins  
Phone: (850) 414-4355  
Email: rick.jenkins@dot.state.fl.us

**Standard Plans:**

Index Number: 520-005  
Sheet Number (s): All  
Index Title: Concrete Shoulder Gutter Spillway

**Summary of the changes:**

Deleted notes; redrew details.

**Commentary / Background:**

Redeveloped Index and deleted notes that are now covered in the SPI.

**Other Affected Offices / Documents:** (Provide name of person contacted)

Yes	No	
<input type="checkbox"/>	<input checked="" type="checkbox"/>	Other Standard Plans –
<input type="checkbox"/>	<input checked="" type="checkbox"/>	FDOT Design Manual –
<input type="checkbox"/>	<input checked="" type="checkbox"/>	Basis of Estimates Manual –
<input type="checkbox"/>	<input checked="" type="checkbox"/>	Standard Specifications –
<input type="checkbox"/>	<input checked="" type="checkbox"/>	Approved Product List –
<input type="checkbox"/>	<input checked="" type="checkbox"/>	Construction –
<input type="checkbox"/>	<input checked="" type="checkbox"/>	Maintenance –

**Origination Package Includes:**

(Email or hand deliver package to Rick Jenkins)

Yes	N/A	
<input checked="" type="checkbox"/>	<input type="checkbox"/>	Redline Mark-ups
<input type="checkbox"/>	<input type="checkbox"/>	Proposed Standard Plan Instruction (SPI)
<input type="checkbox"/>	<input type="checkbox"/>	Revised SPI
<input type="checkbox"/>	<input type="checkbox"/>	Other Support Documents


**Implementation:**

Design Bulletin (Interim)  
 DCE Memo  
 Program Mgmt. Bulletin  
 FY-Standard Plans (Next Release)

---

Contact the Roadway Design Office for assistance in completing this form

---

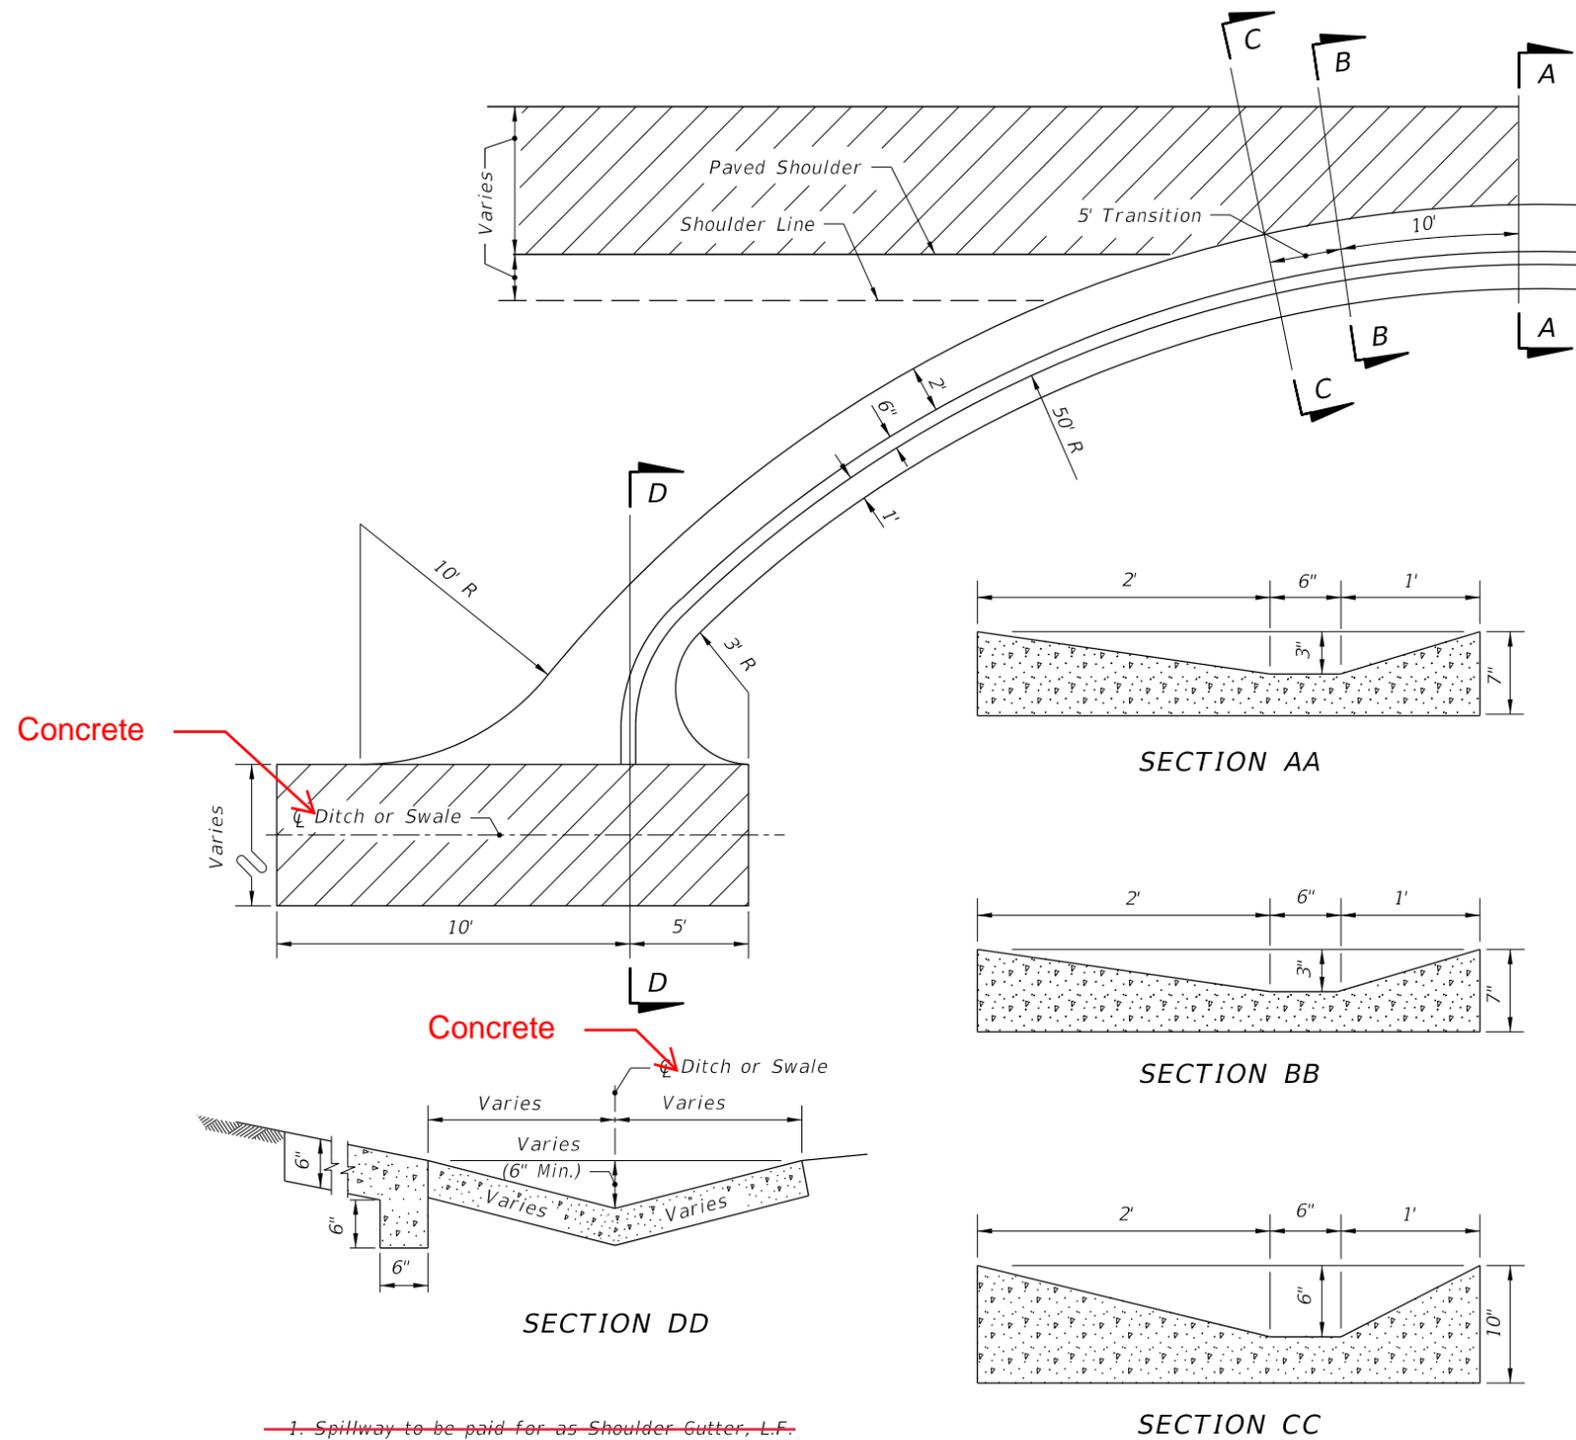

REDEVELOPED INDEX

- ~~1. Spillway to be paid for as Shoulder Gutter, L.F.~~
- ~~2. If spillway empties into an unpaved ditch, the detail should be modified as necessary.~~

DETAIL OF CONCRETE SPILLWAY AT END OF SHOULDER GUTTER  
 (TO BE USED WHERE INLETS, PIPES & ENDWALLS ARE IMPRACTICAL)

10/12/2020 7:32:17 AM

LAST REVISION	DESCRIPTION:
11/01/17	
REVISION	
	11/01/21





FY 2021-22  
STANDARD PLANS


CONCRETE SHOULDER GUTTER SPILLWAY

INDEX  
520-005


SHEET  
1 of 1

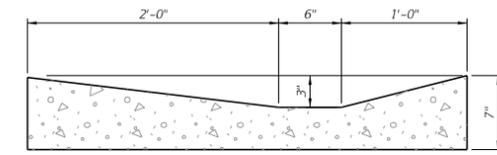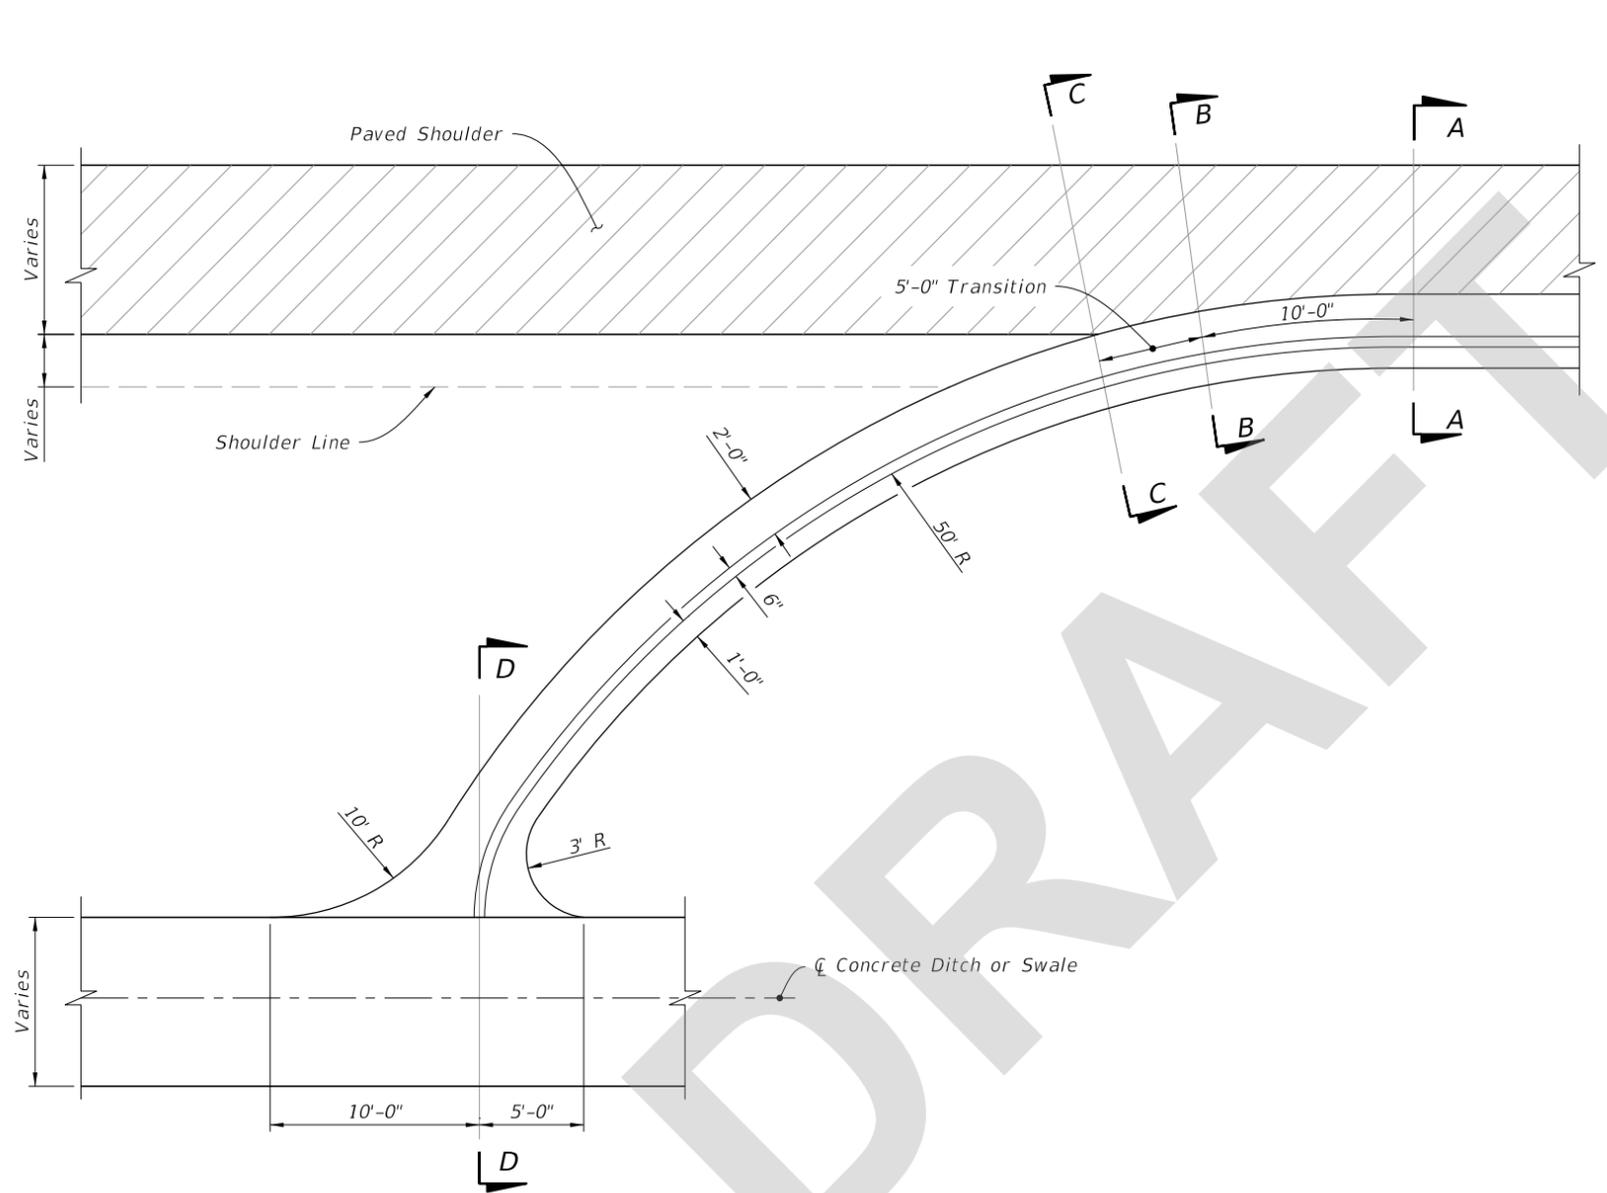


SECTION AA

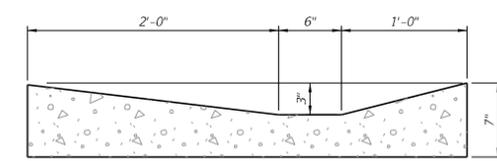

SECTION BB

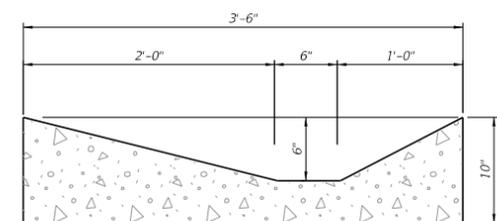

SECTION CC

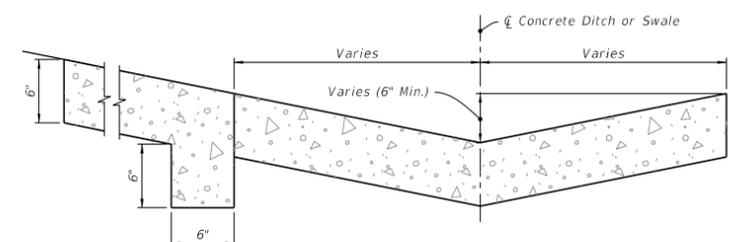

SECTION DD

CONCRETE SPILLWAY AT END OF SHOULDER GUTTER DETAILS

8/6/2021 1:55:06 PM

LAST REVISION 11/01/21	REVISION	DESCRIPTION:	 FY 2022-23 STANDARD PLANS	CONCRETE SHOULDER GUTTER SPILLWAY	INDEX 520-005	SHEET 1 of 1
---------------------------	----------	--------------	--	-----------------------------------	------------------	-----------------