

---

## ORIGINATION FORM

---

Proposed Revisions to a Standard Plans Index  
(Please provide all information — Incomplete forms will be returned)

**Contact Information:**

Date: May 12, 2021  
Originator: Brad Bradley  
Phone: (850) 414-4295  
Email: Brad.Bradley@dot.state.fl.us

**Standard Plans:**

Index Number: 522-002  
Sheet Number (s): 1 and 4 of 7  
Index Title: Detectable Warnings and Sidewalk Curb Ramps

**Summary of the changes:**

- Sheet 1: Added Note 2.C.
  
- Sheet 4: Changed back of sidewalk in CR-D detail to accommodate 4'-0" minimum dimension.

**Commentary / Background:**

CR-D is essentially half of a CR-C. The CR-C ramp currently shows the 4'-0" minimum dimension at the back of sidewalk to provide a large-enough level landing footprint for wheelchair maneuverability. The CR-D, as currently depicted in the Standard Plans, does not provide an optimal configuration for users of mobility devices. See next page for additional information.

**Other Affected Offices / Documents:** (Provide name of person contacted)

- | Yes                      | No                                  |                             |
|--------------------------|-------------------------------------|-----------------------------|
| <input type="checkbox"/> | <input checked="" type="checkbox"/> | Other Standard Plans –      |
| <input type="checkbox"/> | <input checked="" type="checkbox"/> | FDOT Design Manual –        |
| <input type="checkbox"/> | <input checked="" type="checkbox"/> | Basis of Estimates Manual – |
| <input type="checkbox"/> | <input checked="" type="checkbox"/> | Standard Specifications –   |
| <input type="checkbox"/> | <input checked="" type="checkbox"/> | Approved Product List –     |
| <input type="checkbox"/> | <input checked="" type="checkbox"/> | Construction –              |
| <input type="checkbox"/> | <input checked="" type="checkbox"/> | Maintenance –               |

**Origination Package Includes:**

(Email or hand deliver package to Rick Jenkins)

- | Yes                                 | N/A                      |  |
|-------------------------------------|--------------------------|--|
| <input checked="" type="checkbox"/> | <input type="checkbox"/> | Redline Mark-ups                         |
| <input type="checkbox"/>            | <input type="checkbox"/> | Proposed Standard Plan Instruction (SPI) |
| <input type="checkbox"/>            | <input type="checkbox"/> | Revised SPI                              |
| <input type="checkbox"/>            | <input type="checkbox"/> | Other Support Documents                  |

**Implementation:**

- Design Bulletin (Interim)
- DCE Memo
- Program Mgmt. Bulletin
- FY-Standard Plans (Next Release)

---

Contact the Roadway Design Office for assistance in completing this form

---

Email to: Rick Jenkins [rick.jenkins@dot.state.fl.us](mailto:rick.jenkins@dot.state.fl.us) and Darren Martin [darren.martin@dot.state.fl.us](mailto:darren.martin@dot.state.fl.us)

---

## ORIGINATION FORM

---

Proposed Revisions to a Standard Plans Index  
(Please provide all information — Incomplete forms will be returned)

**Contact Information:**

Date: May 12, 2021

Originator: Brad Bradley

Phone: (850) 414-4295

Email: Brad.Bradley@dot.state.fl.us

**Standard Plans:**

Index Number: 522-002

Sheet Number (s): 1 and 4 of 7

Index Title:

Detectable Warnings and Sidewalk Curb Ramps

**Additional Information, as needed:**

For CR-D, provide 5'-0" standard (4'-0" minimum) dimension at back of sidewalk for the level landing at the bottom of the curb ramp (see figure). This provides the necessary plan area footprint for the level landing to allow for wheelchair maneuverability and change of direction. Otherwise, the footrest of a wheel chair would contact the curb face while the rear wheels are still on the ramp's sloped surface -- potentially resulting in an unstable/tip-over condition.

Ideally, the resulting curb return would remain parallel to and in alignment with the direction of the crossing, and that is why 5' standard is proposed with a 4' minimum.

**GENERAL NOTES:**

1. Cross Slopes and Grades:

- A. Sidewalk, ramp, and landing slopes (i.e. 0.02, 0.05, and 1:12) shown in this Index are maximums. With approval of the Engineer, provide the minimum feasible slope where the requirements cannot be met.
- B. Landings must have cross-slopes less than or equal to 0.02 in any direction.
- C. Maintain a single longitudinal slope along each side of the curb ramp. Ramp slopes are not required to exceed 15 feet in length.
- D. Joints permitted at the location of Slope Breaks. Otherwise locate joints in accordance with Index 522-001. No joints are permitted within the ramp portion of the Curb Ramp.

2. Curb, Curb and Gutter and/or Sidewalk:

- A. Refer to Index 522-001 for concrete thickness and sidewalk details.
- B. Remove any existing curb, curb and gutter, or sidewalk to the nearest joint beyond the curb transition or to the extent that no remaining section is less than 5 feet long.


3. Curb Ramp Alpha-Identification:

- A. Sidewalk curb ramp alpha-identifications (e.g. CR-A) are provided for reference purposes in the Plans.
- B. Alpha-identifications CR-I and CR-J are intentionally omitted.

4. Detectable Warnings:


- A. Install detectable warnings in accordance with Specification 527.
- B. Place detectable warnings across the full width of the ramp or landing, to a minimum depth of 2 feet measured perpendicular to the curb line and no greater than 5 feet from the back of the curb or edge of pavement.
- C. If detectable warnings are shown in the Plans on slopes greater than 5%, align the truncated domes with the centerline of the ramp; otherwise, the truncated domes are not required to be aligned.


**ADDED NOTE 2.C:**  
Width of Curb Ramp is 4'-0" minimum. Match sidewalk or Shared Use Path width as shown in the Plans.

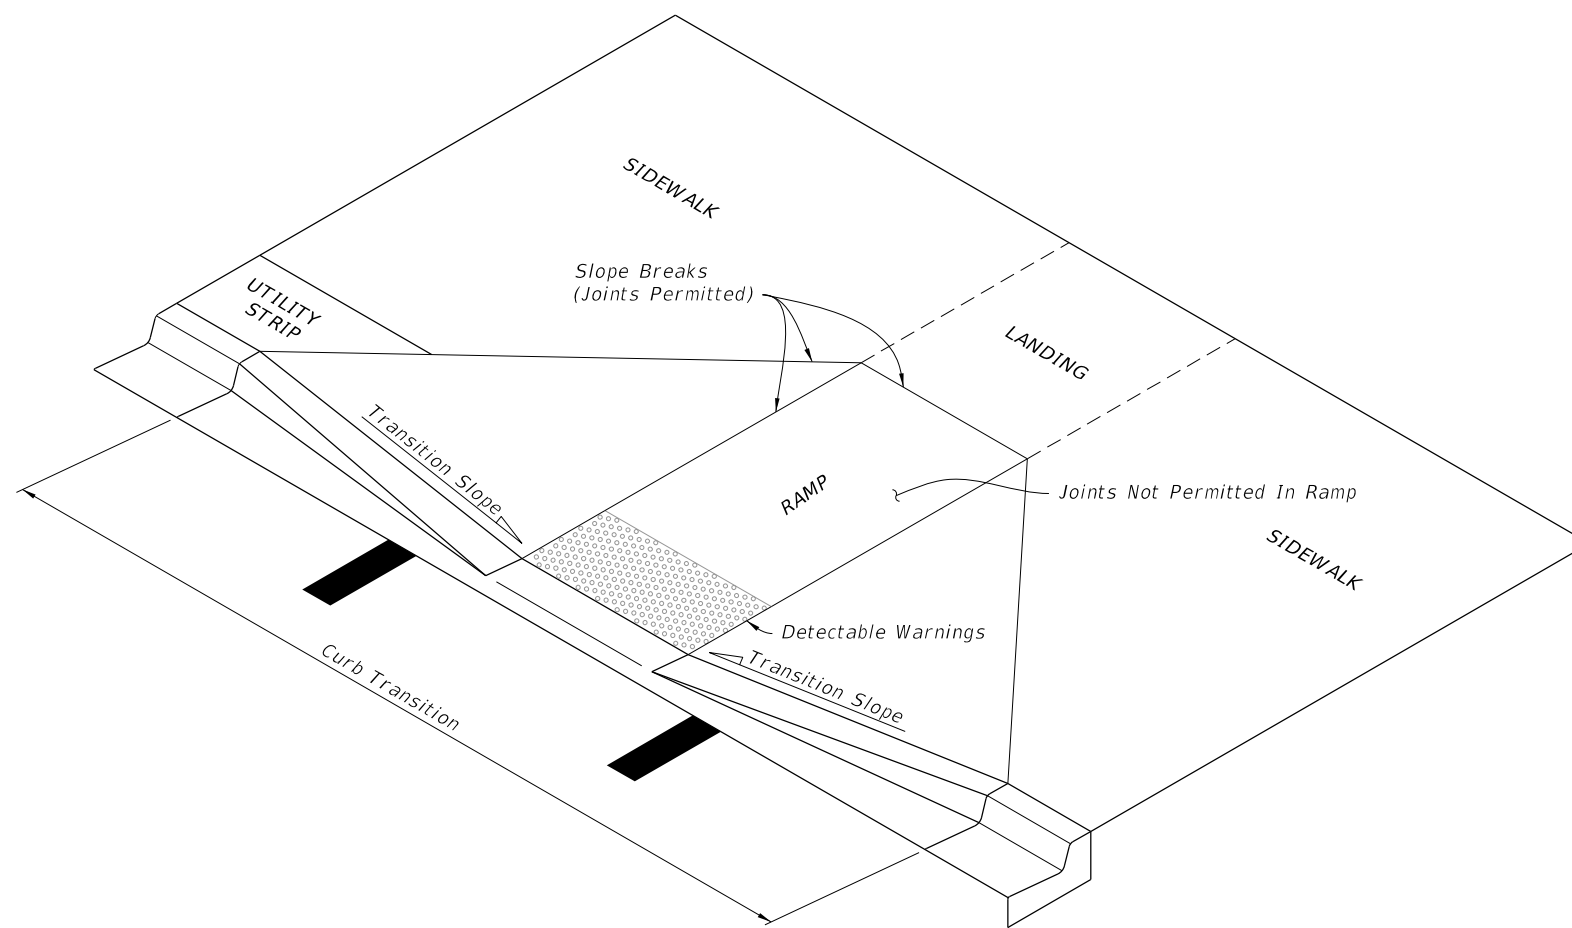


==== CURB RAMP NOMENCLATURE ====

10/12/2020 7:58:31 AM


|                           |          |              |   |   |                  |                 |
|---------------------------|----------|--------------|---|---|------------------|-----------------|
| LAST REVISION<br>11/01/20 | REVISION | DESCRIPTION: | <br>FY 2021-22<br>STANDARD PLANS | DETECTABLE WARNINGS AND SIDEWALK CURB RAMPS | INDEX<br>522-002 | SHEET<br>1 of 7 |
|---------------------------|----------|--------------|---|---|------------------|-----------------|

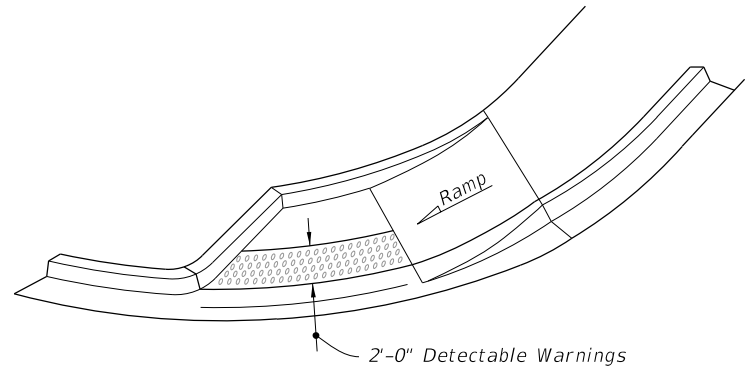


ISOMETRIC VIEW

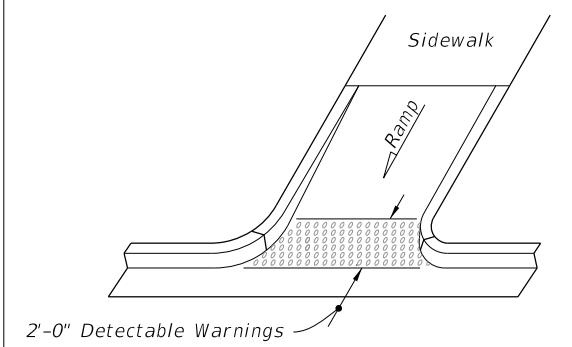


OPTION A

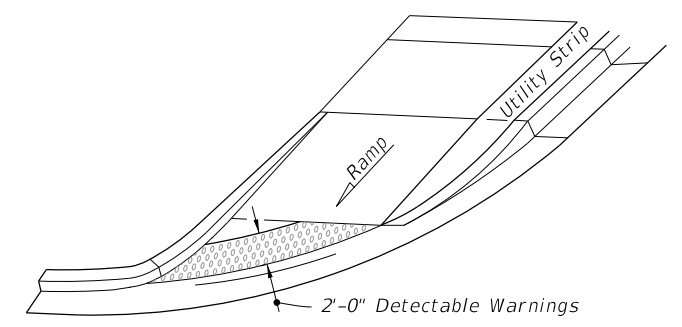


OPTION A

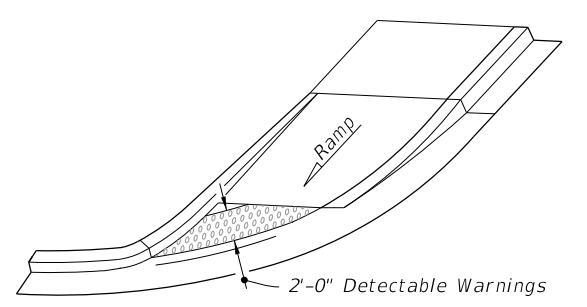


OPTION A

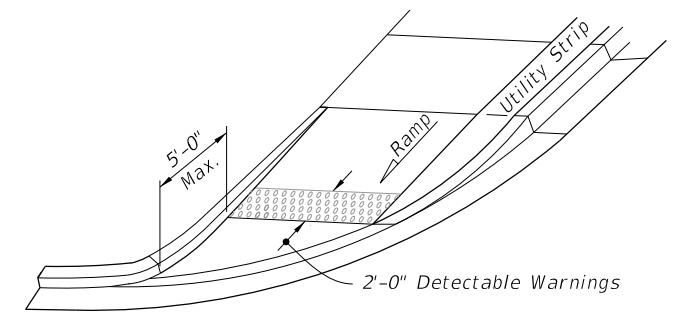

OPTION B

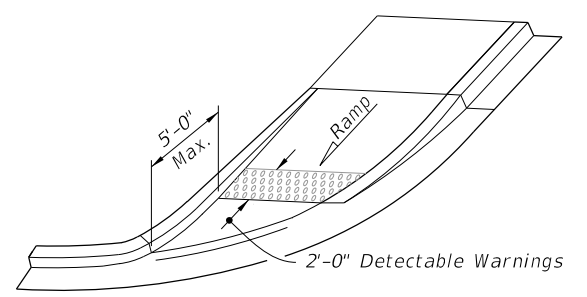


OPTION B

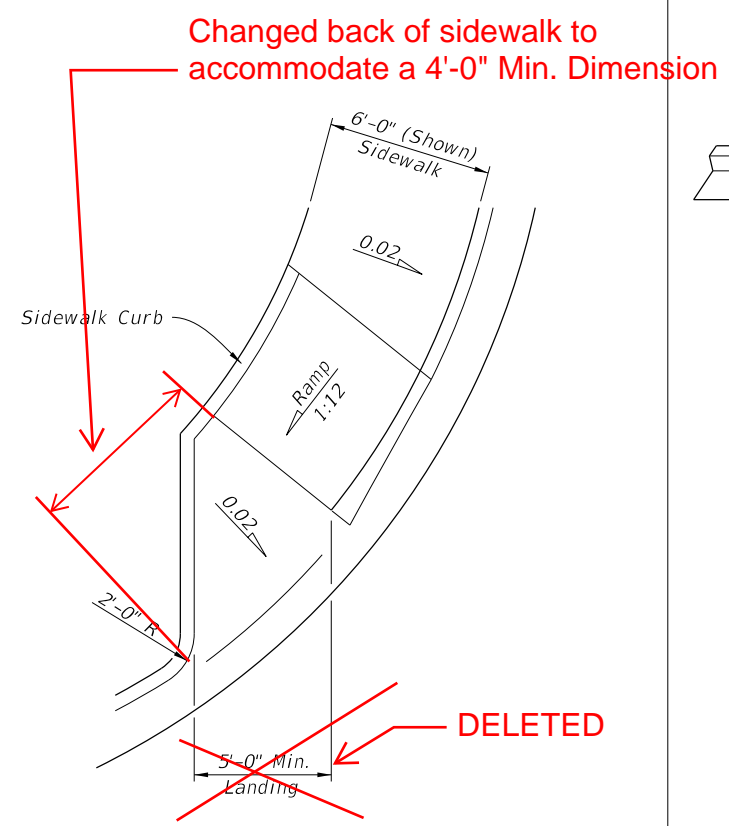


PLAN VIEW

CR-D

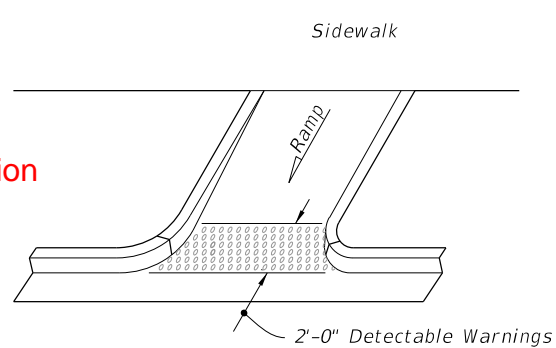


OPTION B  
ISOMETRIC VIEW

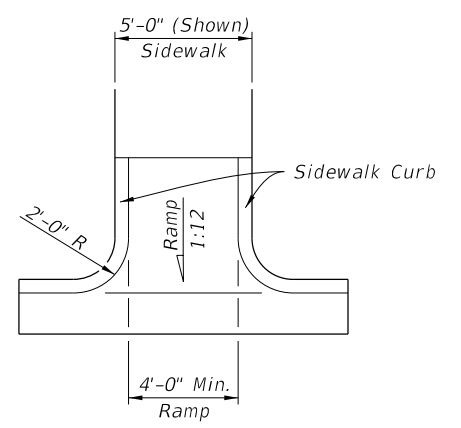


PLAN VIEW

CR-E

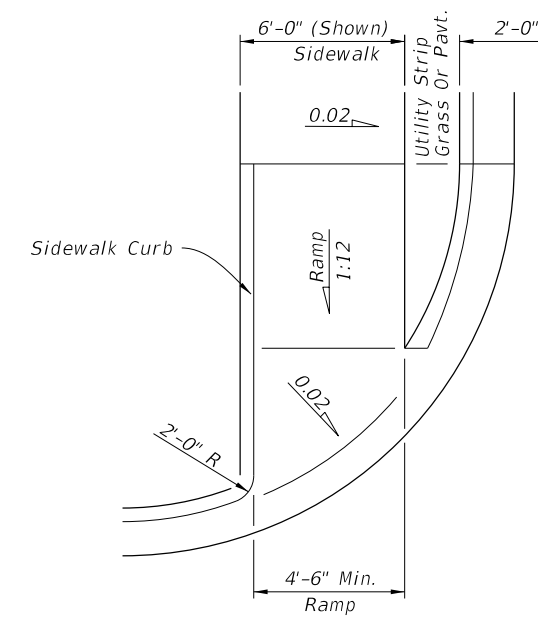

PLAN VIEW

CR-F

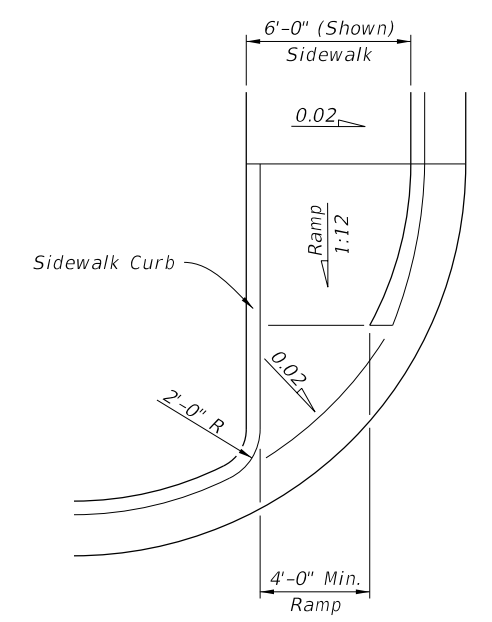

PLAN VIEW

CR-G

SIDEWALK CURB RAMPS CR-D, CR-E, CR-F & CR-G

10/12/2020 7:58:37 AM

|               |              |
|---------------|--------------|
| LAST REVISION | DESCRIPTION: |
| 11/01/2020    | 11/01/21     |

FY 2021-22  
 STANDARD PLANS

DETECTABLE WARNINGS AND SIDEWALK CURB RAMPS

|         |        |
|---------|--------|
| INDEX   | SHEET  |
| 522-002 | 4 of 7 |

**GENERAL NOTES:**

**1. Cross Slopes and Grades:**

- A. Sidewalk, ramp, and landing slopes (i.e. 0.02, 0.05, and 1:12) shown in this Index are maximums. With approval of the Engineer, provide the minimum feasible slope where the requirements cannot be met.
- B. Landings must have cross-slopes less than or equal to 0.02 in any direction.
- C. Maintain a single longitudinal slope along each side of the curb ramp. Ramp slopes are not required to exceed 15 feet in length.
- D. Joints permitted at the location of Slope Breaks. Otherwise locate joints in accordance with Index 522-001. No joints are permitted within the ramp portion of the Curb Ramp.

**2. Curb, Curb and Gutter and/or Sidewalk:**


- A. Refer to Index 522-001 for concrete thickness and sidewalk details.
- B. Remove any existing curb, curb and gutter, or sidewalk to the nearest joint beyond the curb transition or to the extent that no remaining section is less than 5 feet long.
- C. Width of Curb Ramp is 4'-0" minimum. Match sidewalk or Shared Use Path width as shown in the Plans.

**3. Curb Ramp Alpha-Identification:**

- A. Sidewalk curb ramp alpha-identifications (e.g. CR-A) are provided for reference purposes in the Plans.
- B. Alpha-identifications CR-I and CR-J are intentionally omitted.


**4. Detectable Warnings:**


- A. Install detectable warnings in accordance with Specification 527.
- B. Place detectable warnings across the full width of the ramp or landing, to a minimum depth of 2 feet measured perpendicular to the curb line and no greater than 5 feet from the back of the curb or edge of pavement.
- C. If detectable warnings are shown in the Plans on slopes greater than 5%, align the truncated domes with the centerline of the ramp; otherwise, the truncated domes are not required to be aligned.

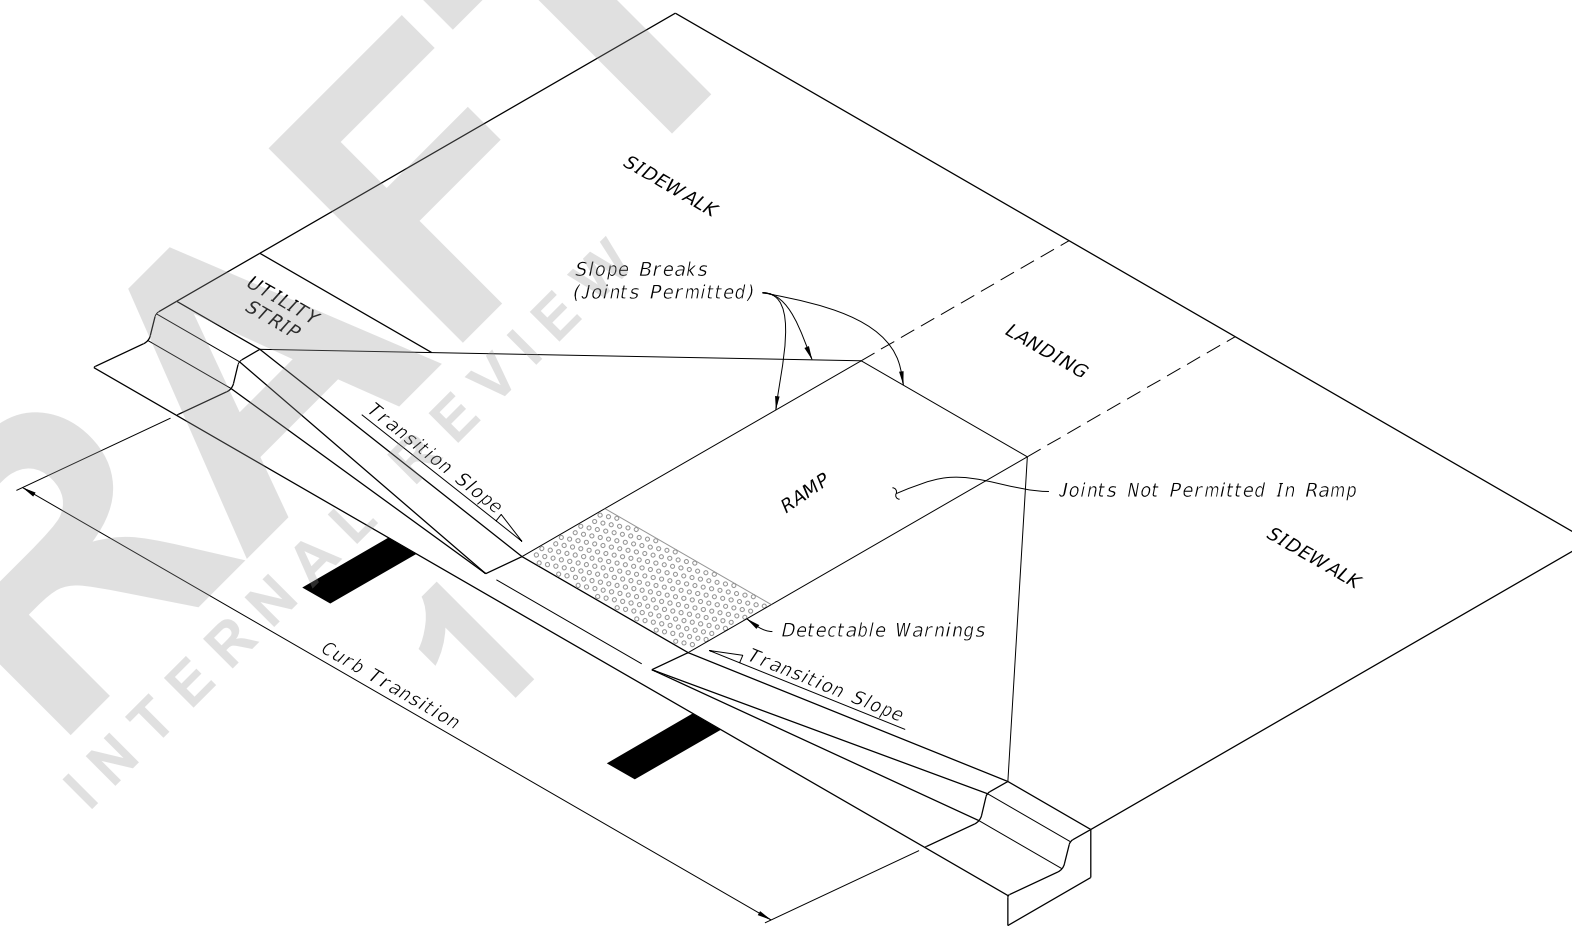


**CURB RAMP NOMENCLATURE**

7/19/2021 1:11:16 PM

|                           |          |              |   |  |                         |                        |
|---------------------------|----------|--------------|---|--|-------------------------|------------------------|
| LAST REVISION<br>11/01/21 | REVISION | DESCRIPTION: | <br><b>FY 2022-23<br/>STANDARD PLANS</b> | <b>DETECTABLE WARNINGS AND SIDEWALK CURB RAMPS</b> | INDEX<br><b>522-002</b> | SHEET<br><b>1 of 7</b> |
|---------------------------|----------|--------------|---|--|-------------------------|------------------------|

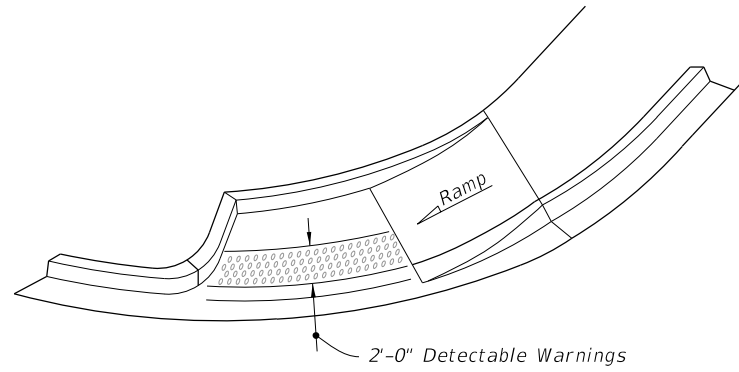


ISOMETRIC VIEW

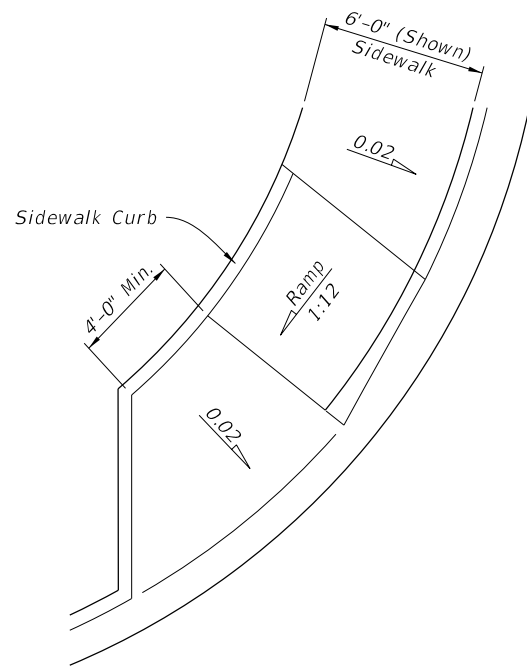


PLAN VIEW


CR-D

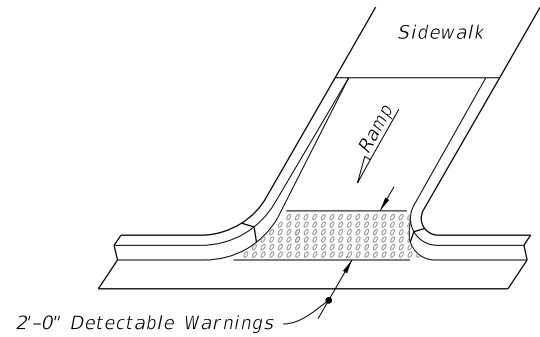

OPTION A

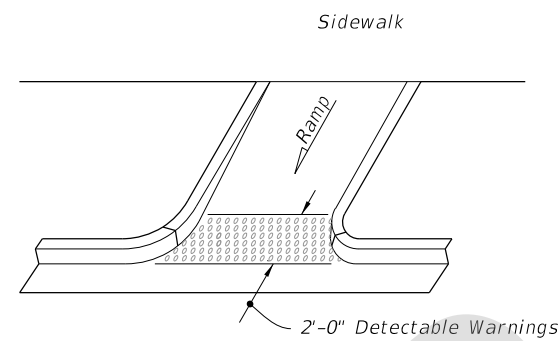


OPTION B  
ISOMETRIC VIEW

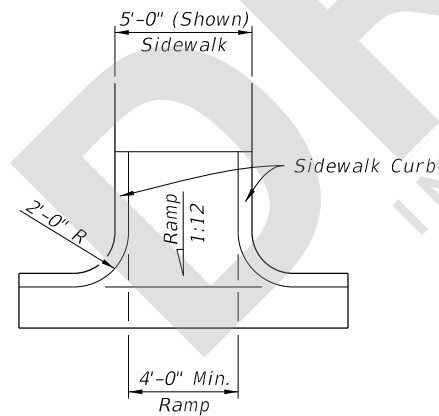


PLAN VIEW


CR-E

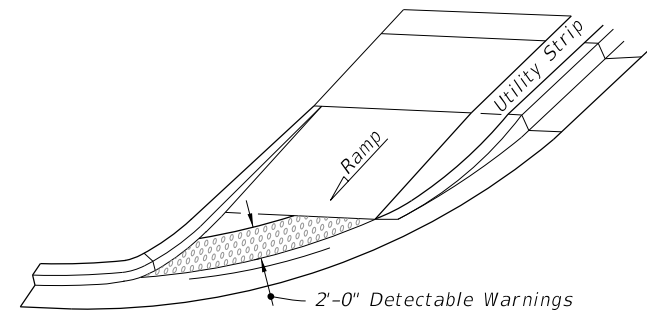

OPTION A

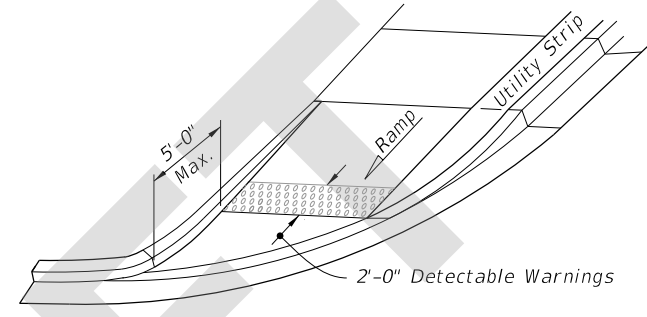


OPTION B  
ISOMETRIC VIEW

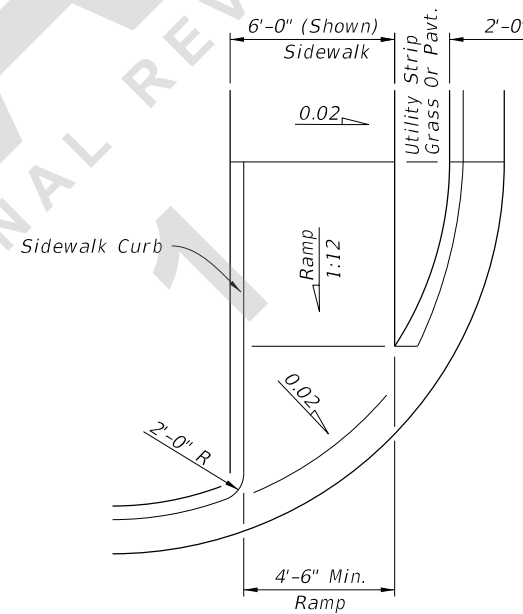


PLAN VIEW


CR-F

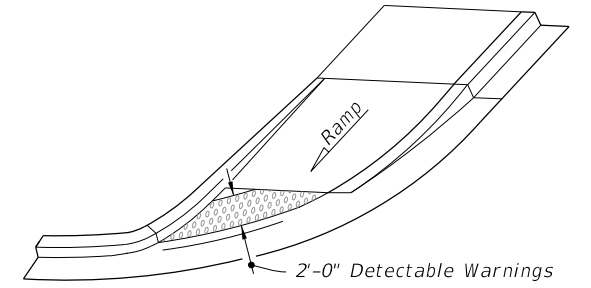

OPTION A

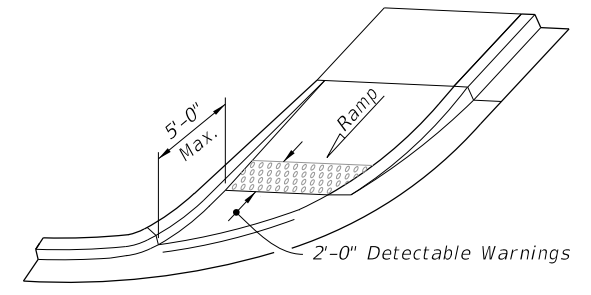

OPTION B  
ISOMETRIC VIEW

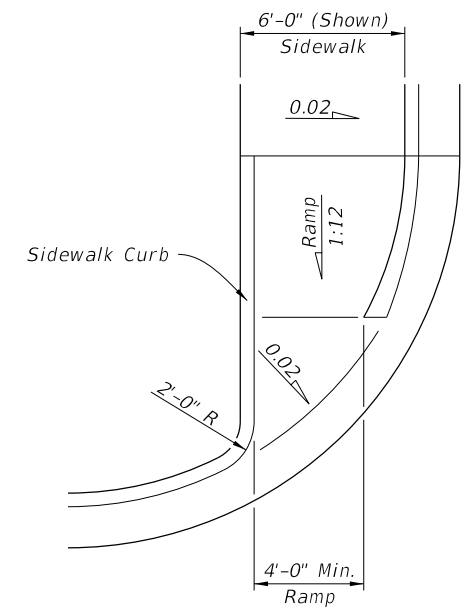

PLAN VIEW

CR-G

SIDEWALK CURB RAMPS CR-D, CR-E, CR-F & CR-G

7/19/2021 1:11:19 PM

|                           |              |
|---------------------------|--------------|
| LAST REVISION<br>11/01/21 | DESCRIPTION: |
|---------------------------|--------------|

FY 2022-23  
 STANDARD PLANS

DETECTABLE WARNINGS AND SIDEWALK CURB RAMPS

|                  |                 |
|------------------|-----------------|
| INDEX<br>522-002 | SHEET<br>4 of 7 |
|------------------|-----------------|