
ORIGINATION FORM

Proposed Revisions to a Standard Plans Index
(Please provide all information — Incomplete forms will be returned)

Contact Information:

Date: January 15, 2021

Originator: Malcolm Tomatani

Phone: (850) 921-7305

Email: malcolm.tomatani@dot.state.fl.us

Standard Plans:

Index Number: 649-020

Sheet Number (s): All Sheets

Index Title: Steel CCTV Pole

Summary of the changes:

Sheet 1: Added Note 3 to the General Notes to stay consistent with 641-020; Added Note D and E to new Note 6; Added the Cabinet Adapter Bracket and dashed the handhole in the STEEL CCTV POLE ASSEMBLY detail.
Sheet 2: Updated the Assembly detail to match Sheet 1; Dashed the handhole in the ELEVATION detail.
Sheet 3: Updated the Assembly detail to match Sheet 1.
Sheet 4: Updated the Assembly detail to match Sheet 1.
Sheet 5: Updated the Assembly detail to match Sheet 1.
Sheet 6: Dashed the handhole in the CONCRETE CCTV POLE GROUNDING detail and added the handhole to DETAIL "E"-SIDE VIEW detail.

Commentary / Background:

The handhole should be located downstream of the traffic so all details and notes will be updated for the proper representation. Also added notes to make Index consistent with Standard Plans Index 641-020.

Other Affected Offices / Documents: (Provide name of person contacted)

Yes	No	
<input checked="" type="checkbox"/>	<input type="checkbox"/>	Other Standard Plans – 641-020 Rick Jenkins
<input type="checkbox"/>	<input checked="" type="checkbox"/>	FDOT Design Manual –
<input type="checkbox"/>	<input checked="" type="checkbox"/>	Basis of Estimates Manual –
<input type="checkbox"/>	<input checked="" type="checkbox"/>	Standard Specifications –
<input type="checkbox"/>	<input checked="" type="checkbox"/>	Approved Product List –
<input type="checkbox"/>	<input checked="" type="checkbox"/>	Construction –
<input type="checkbox"/>	<input checked="" type="checkbox"/>	Maintenance –

Origination Package Includes:

(Email or hand deliver package to Rick Jenkins)

Yes	N/A	
<input checked="" type="checkbox"/>	<input type="checkbox"/>	Redline Mark-ups
<input type="checkbox"/>	<input checked="" type="checkbox"/>	Proposed Standard Plan Instruction (SPI)
<input type="checkbox"/>	<input checked="" type="checkbox"/>	Revised SPI
<input type="checkbox"/>	<input checked="" type="checkbox"/>	Other Support Documents

Implementation:

<input type="checkbox"/>	Design Bulletin (Interim)
<input type="checkbox"/>	DCE Memo
<input type="checkbox"/>	Program Mgmt. Bulletin
<input type="checkbox"/>	FY-Standard Plans (Next Release)

Contact the Roadway Design Office for assistance in completing this form

GENERAL NOTES:

1. Work this Index with Specification 649.
2. This Index is considered fully detailed; only submit shop drawings for minor modifications not detailed in the Plans.
3. ~~Materials:~~
4. A. Pole: ASTM A1011 Grade 50, 55, 60 or 65 (less than 1/4") or ASTM A572 Grade 50, 60 or 65 (greater than or equal to 1/4") or ASTM A595 Grade A (55 ksi yield) or Grade B (60 ksi yield).
 B. Steel Plates and Pole Cap: ASTM A36 or ASTM A709 Grade 50.
 C. Weld Metal: E70XX.
 D. Bolts: ASTM F3125, Grade A325, Type 1.
 Nuts: ASTM A563.
 Washers: ASTM F-436.
 E. Anchor Bolts: ASTM F1554 Grade 55 with ASTM A563 Grade A heavy-hex nuts and ASTM A36 plate washers.
 F. Handhole Frame: ASTM A709 Grade 36 or ASTM A36.
 G. Handhole Cover: ASTM A1011 Grade 50, 55, 60 or 65.
 H. Stainless Steel Screws: AISI Type 316.
 I. Reinforcing Steel: ASTM A615 Grade 60.
 J. Galvanization: Bolts, nuts and washers: ASTM F2329 All other steel including plate washer: ASTM A123
 K. Concrete: Class IV (Drilled Shaft) for all environment classifications.

Added New Note 3:
See Index 635-001
for additional details
for Pull Boxes.

5. ~~Fabrication:~~
- A. Welding:
 - a. Specification 460-6.4 and
 - b. AASHTO RFD Specification for Structural Supports for Highway Signs, Luminaires, and Traffic Signals Section 14.4.4.
- B. Poles:
 - a. Round or 16-sided (Min.)
 - b. Taper pole diameter at 0.14 inches per foot
 - c. Fabricate Pole longitudinal seam welds (2 maximum) with 60 percent minimum penetration or fusion welds except as follows:
 1. Use a full-penetration groove weld within 6 inches of the circumferential tube-to-plate connection and
 2. Use full-penetration groove welds on the female end section of telescopic (i.e., slip type) field splices for a minimum length of one and one-half times the inside diameter of the female section plus 6 inches.
 - d. Pole shaft may be either one or two sections (with telescopic field splice)
 - e. Circumferentially welded pole shafts and laminated pole shafts are not permitted
- C. Identification Tag: (Submit details for approval)
 - a. 2"x 4" (Max.) aluminum tag
 - b. Locate on the inside of the pole and visible from the handhole
 - c. Secure with 1/8" diameter stainless steel rivets or screws.
 - d. Include the following information on the ID Tag:
 1. Financial Project ID
 2. Pole Type
 3. Pole Height
 4. Manufacturers' Name
 5. Yield Strength (Fy of Steel)
 6. Base Wall Thickness
- D. Except for Anchor Bolts, bolt hole diameters are bolt diameter plus 1/16" and anchor bolt holes are bolt diameter plus 1/2" (Max) prior to galvanizing.

6. ~~Pole Installation:~~
- A. Do not install additional wire access holes (not shown in this Index) with a diameter that exceeds 1 1/2" in diameter.
- B. Install Anchor Bolts in accordance with Specification 649-5
- C. Cable Supports: Electrical Cable Guides and Eyebolts.
 - a. Locate top and bottom cable guides within the pole aligned with each other.
 - b. Position one cable guide 2" below the handhole.
 - c. Position other cable guide 1" directly below the top of the tenon.
 - d. Position Park Stands 2" below the top of the handhole.


Added Note New D:
Install Pole with the
handhole located
away from
approaching traffic.

7. ~~Cabinet Installation:~~
- A. Splice fiber optic cables in cabinet to preterminated patch panel.
- B. Furnish and install Surge Protection Devices (SPDs) on all cabling in cabinet.
- C. Furnish and install secondary SPDs protection on outlets for equipment in cabinet.
- D. Ensure that all electronic equipment power is protected and conditioned with SPDs.
- E. Ensure that equipment cabinet is bonded to CCTV pole grounding system.
- F. Install the pole mounted cabinet with the hinges next to the pole.
- G. Sizes and types of conduits and inner ducts for network communications between the pullbox and cabinet are stated in the Contract Documents.

Added Note E:
Install the Pole
plumb.

8. ~~Lowering Device Installation:~~
- A. Place the lowering cable that moves within the pole in an interior conduit to prevent it from tangling or interfering with any electrical wire that is in the pole. Ensure that any electrical wire within the pole is routed securely and free from slack.
- B. Mount lowering device perpendicular to the roadway or as shown in the plans. Position CC TV pole so that the camera can be safely lowered without requiring lane closures.
- C. Coordinate all lowering device hardware requirements (including Tenon, Tenon mounting plates, parking stands, etc.) with lowering device manufacturer.

11/01/21

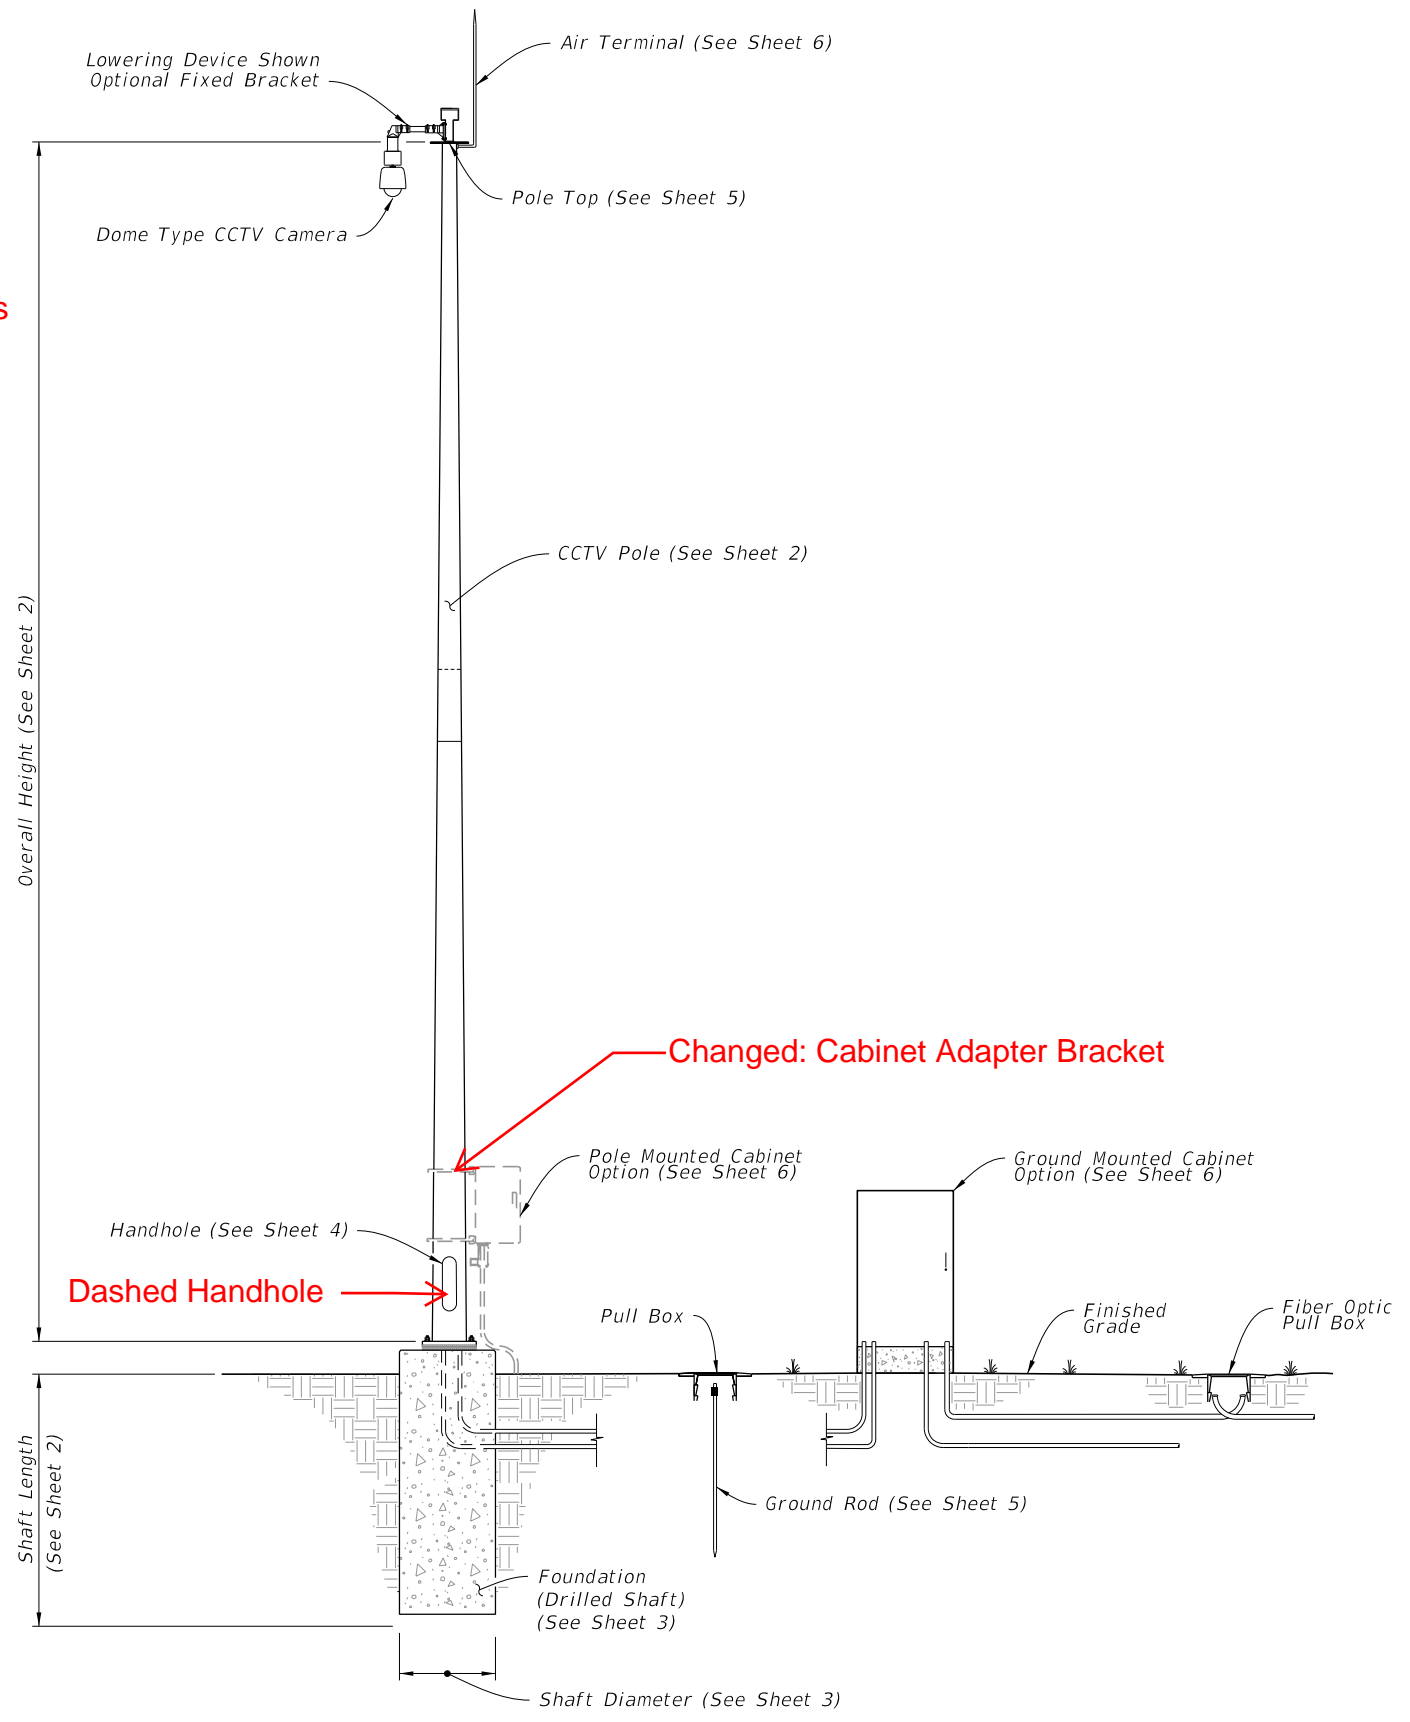


Changed: Cabinet Adapter Bracket

STEEL CCTV POLE ASSEMBLY

10/12/2020 8:21:04 AM

LAST REVISION 11/01/18	REVISION	DESCRIPTION:	 FY 2021-22 STANDARD PLANS	STEEL CCTV POLE	INDEX 649-020	SHEET 1 of 6
--------------------------------------	----------	--------------	--	-----------------	------------------	-----------------

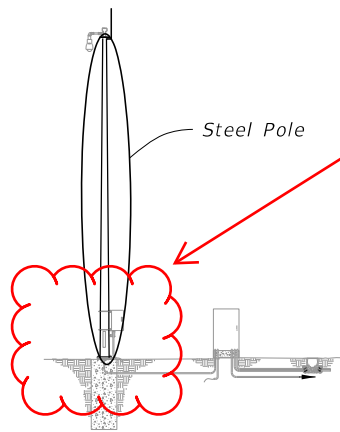

Updated Detail to match Sheet 1

SHAFT DESIGN TABLE			
Pole Overall Height (ft)	Shaft Diameter	Shaft Length	Longitudinal Reinforcement
50	4'-0"	11'-0"	(14) #11
55	4'-0"	12'-0"	(14) #11
60	4'-6"	13'-0"	(16) #11
65	4'-6"	13'-0"	(16) #11
70	5'-0"	14'-0"	(18) #11


ADDITIONAL SHAFT DEPTH DUE TO GROUND SLOPE		
Ground Slope	4'-0" Shaft Diameter	5'-0" Shaft Diameter
1:5	3'-0"	4'-0"
1:4	4'-0"	5'-0"
1:3	5'-0"	6'-0"
1:2	7'-0"	9'-0"

FOUNDATION NOTES:

1. Shaft Length is based on 1'-0" height above the finished grade.
2. Shaft Design Table Shaft Length is based on level ground (flatter than 1:5). Increase the shaft depth in accordance with the Additional Shaft Depth Due To Ground Slope table for foundations with slopes 1:5 and steeper. Use the higher value for slope or diameter values that fall between those shown on the table.

BASE PLATE AND ANCHOR BOLT DESIGN TABLE							
Pole Overall Height (ft)	Base Plate Diameter (in.)	Base Plate Thickness (in.)	Anchor Bolt Circle (in.)	Number of Bolts	Anchor Bolt Diameter (in.)	Anchor Bolt Embedment (in.)	Minimum Anchor Bolt Projection (in.)
50	27	2.5	22	6	1.25	31	8.5
55	28	2.5	23	6	1.25	33	8.5
60	33	2.5	27	6	1.50	34	9.5
65	35	2.5	29	6	1.50	35	9.5
70	40	2.5	33	6	1.75	38	10.5

Pole Overall Height (ft)	Section 1 (Top)			Section 2 (Bottom)			Joint
	Length	Wall Thickness (in.)	Base Diameter (in.)	Length	Wall Thickness (in.)	Base Diameter (in.)	Minimum Splice Length (in.)
50	---	---	---	50'-0"	0.25	17	---
55	25'-0"	0.25	14	28'-0"	0.25	17	27
60	30'-0"	0.25	15	28'-0"	0.3125	18	30
65	35'-0"	0.25	18	29'-0"	0.3125	21	33
70	33'-0"	0.25	19	36'-0"	0.3125	23	33
	38'-0"	0.25	22	36'-0"	0.3125	26	39

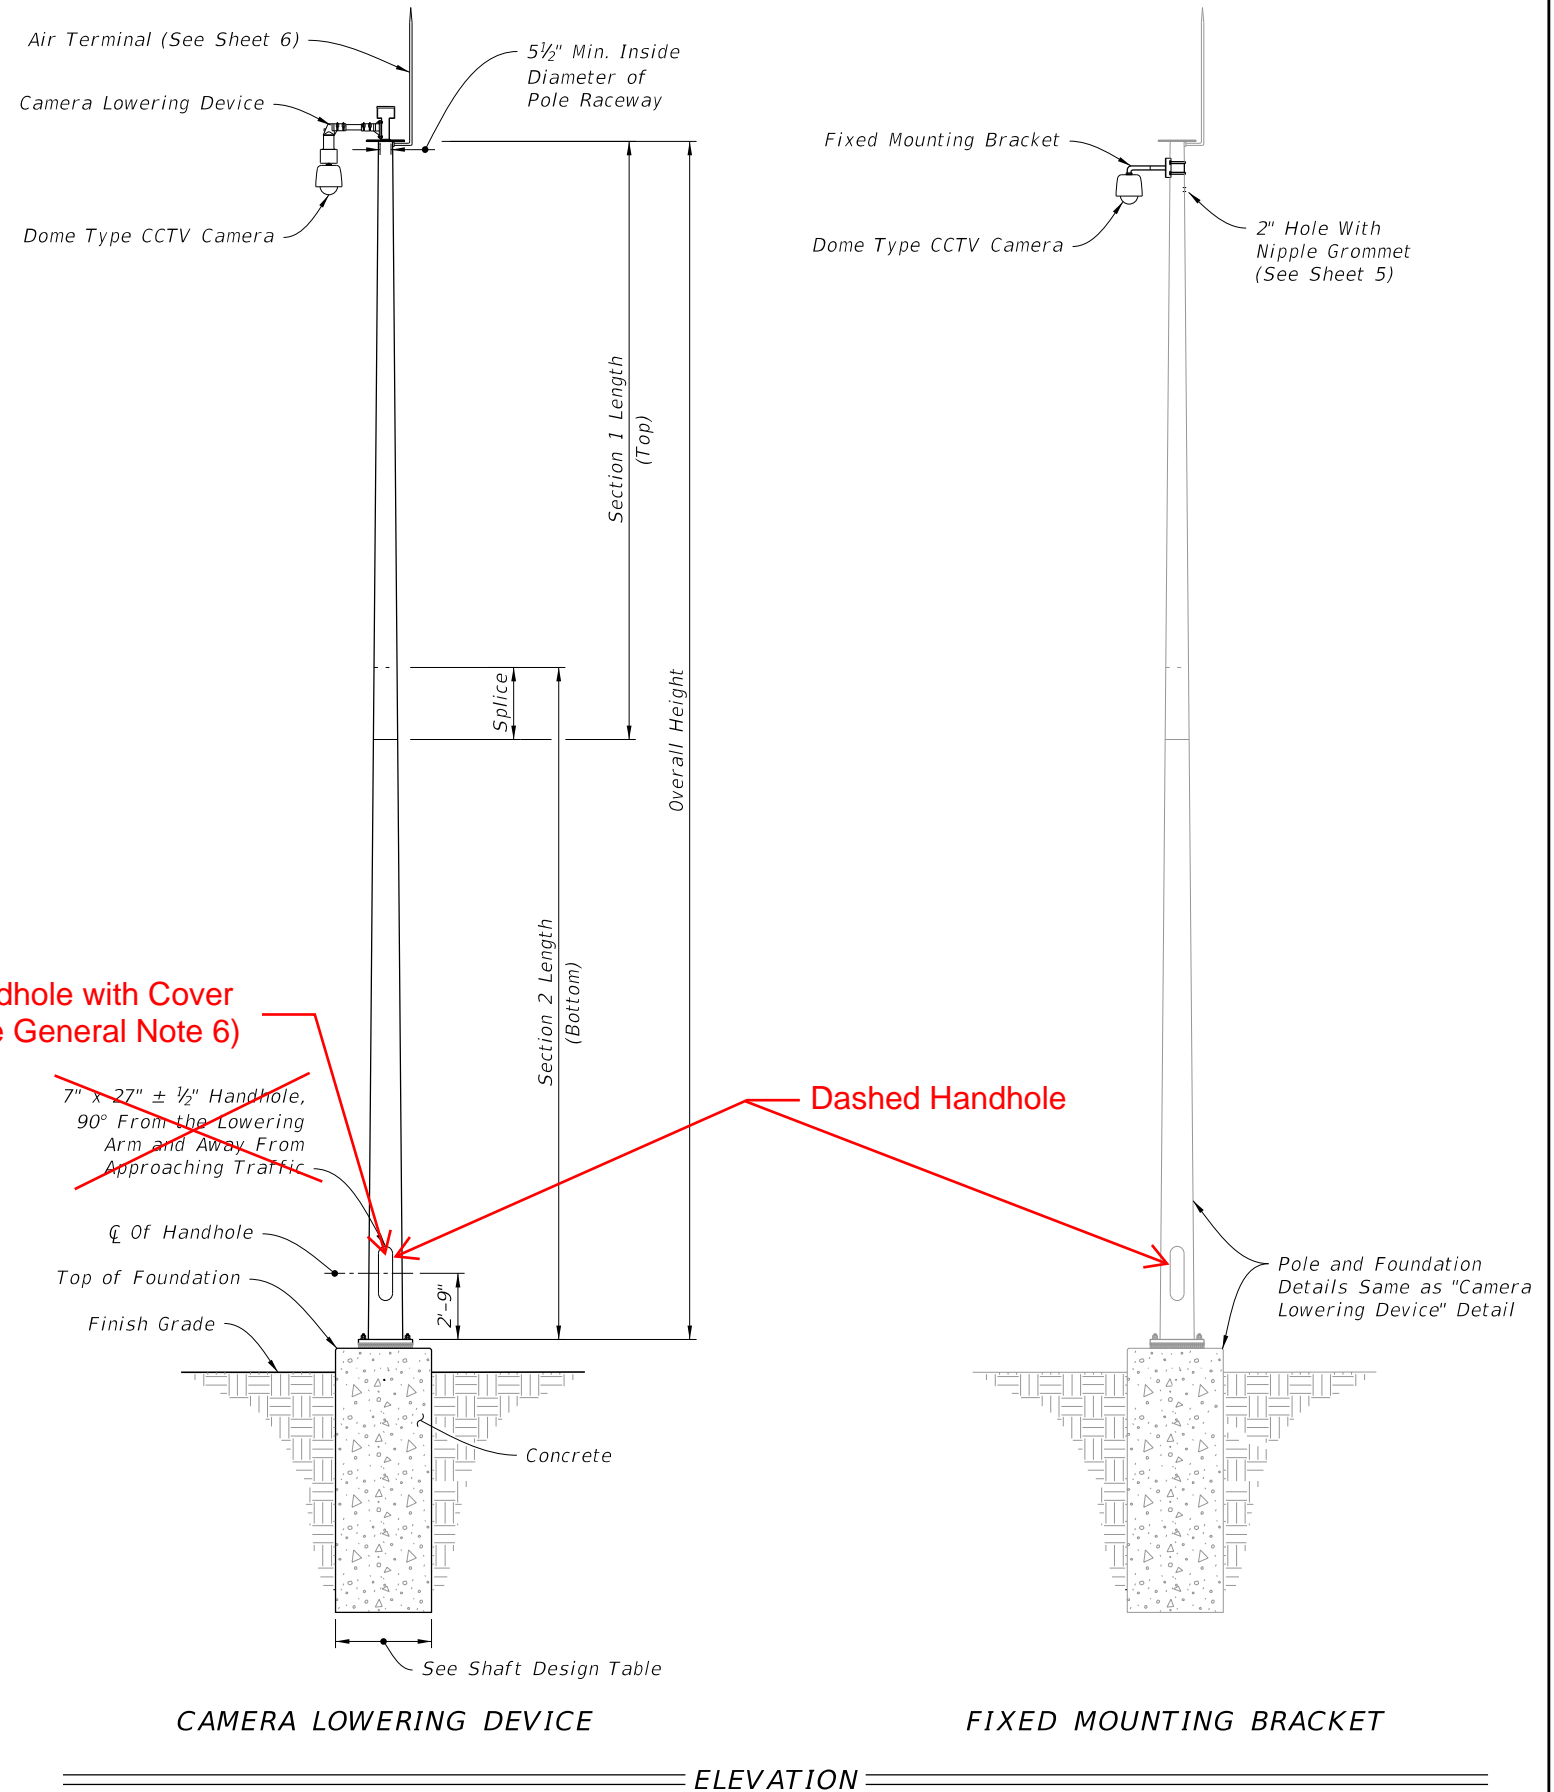


10/12/2020 8:21:06 AM

LAST REVISION	DESCRIPTION:
11/01/17	
	11/01/21

FY 2021-22
STANDARD PLANS

STEEL CCTV POLE



INDEX	SHEET
649-020	2 of 6

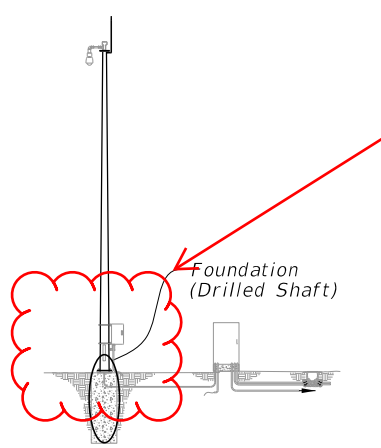



Updated Detail to match Sheet 1

ASSEMBLY


- NOTES:**
1. Shaft Length is based on 1'-0" height above the finished grade.
 2. Double Nuts: Bottom nut may be half-height 'jam' nut. Provide individual nut covers (not shown) for each bolt.
 3. Conduit and CSL Tubes not shown for clarity.
 4. Work these details with Data Table on Sheet 2.

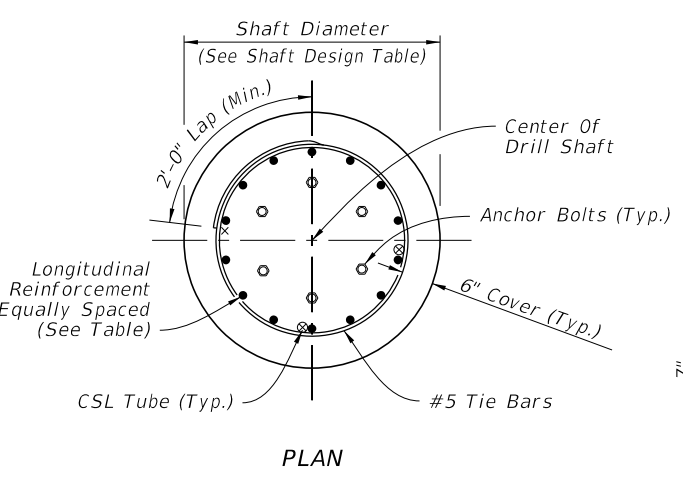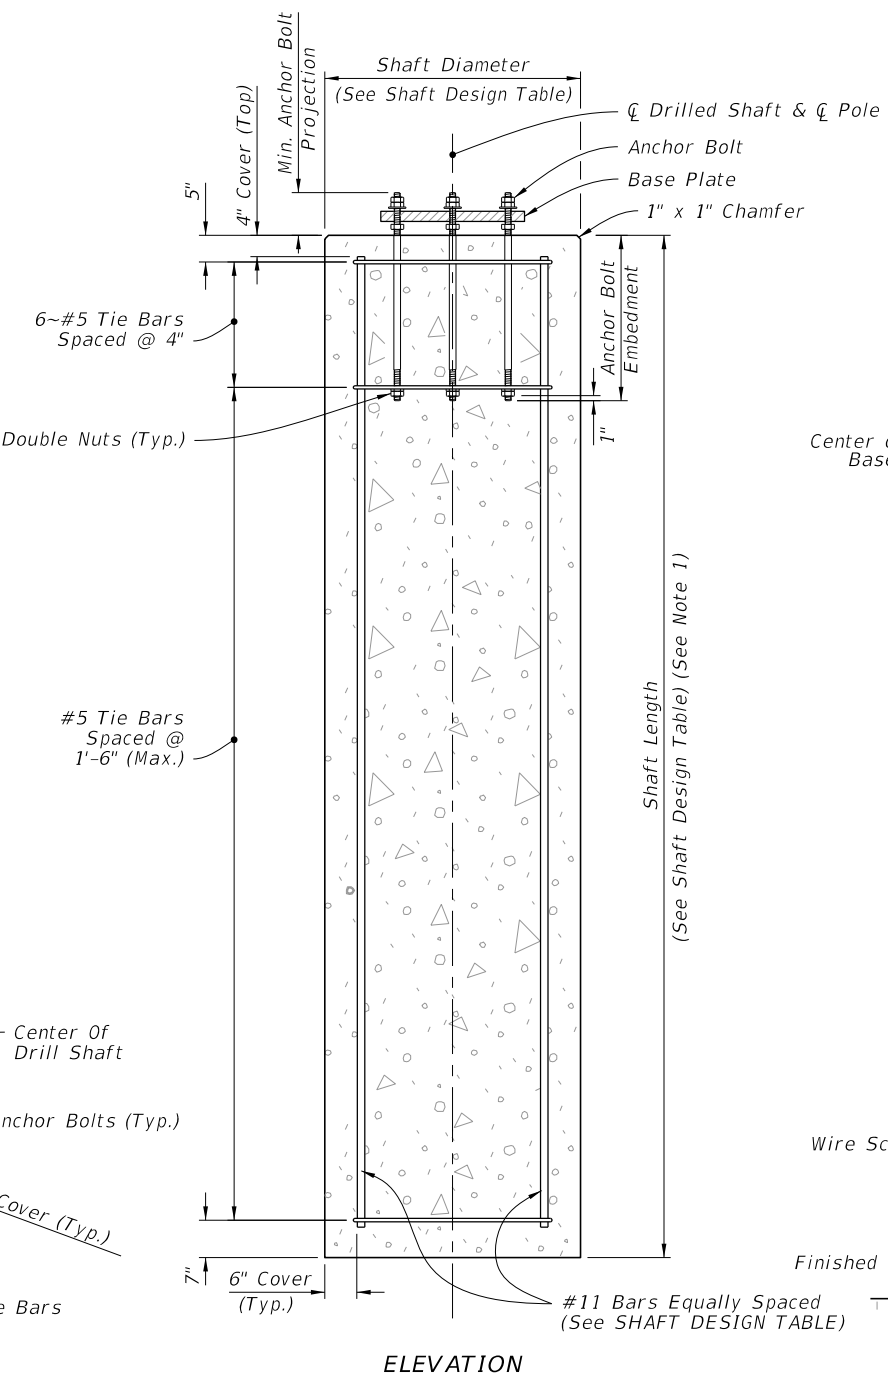


FOUNDATION

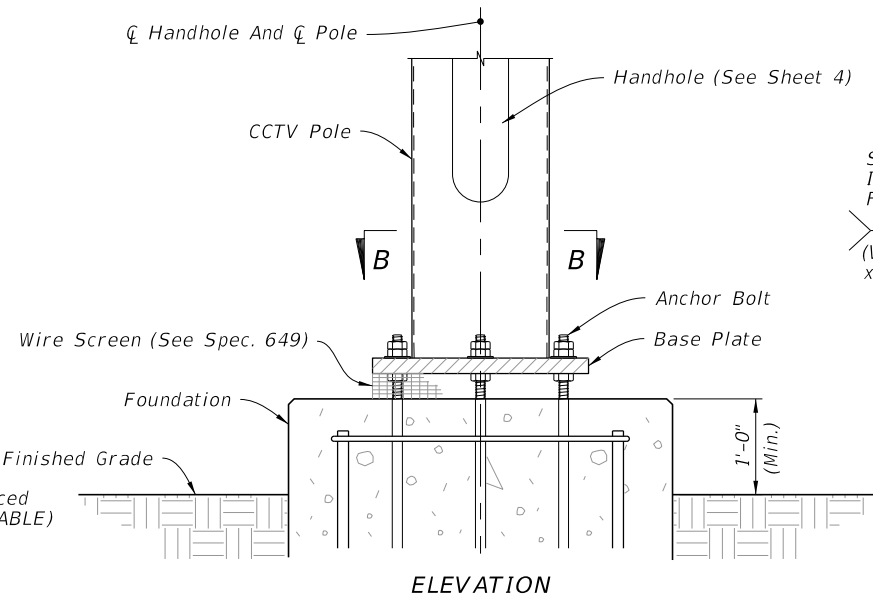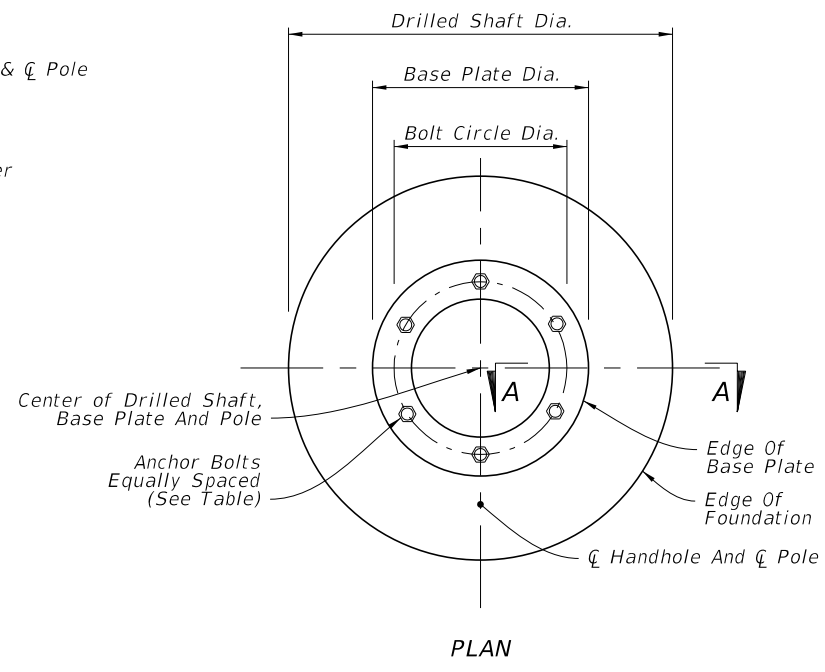


BASE PLATE

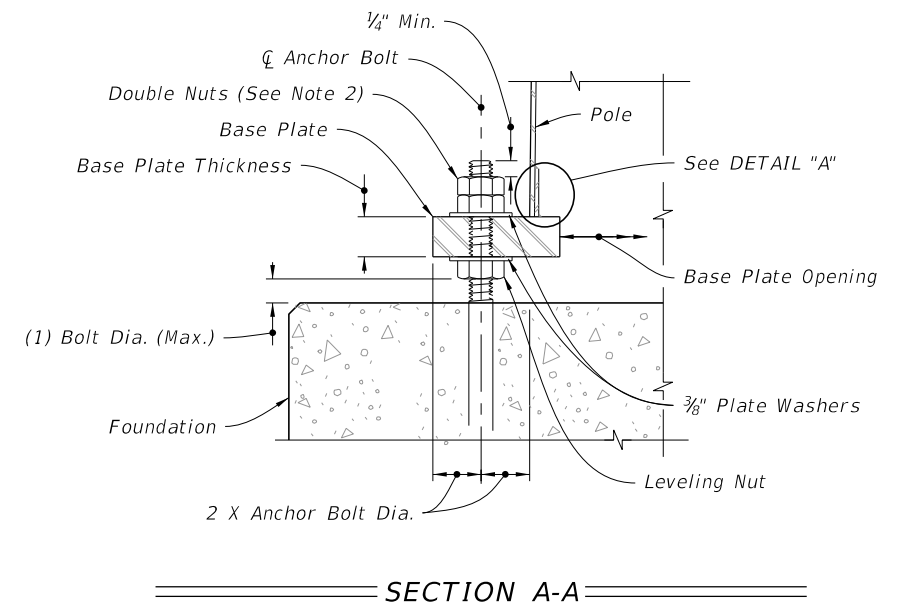

SECTION A-A

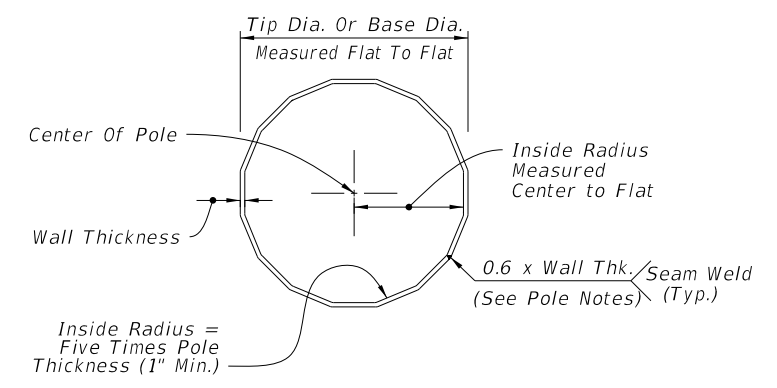

SECTION B-B

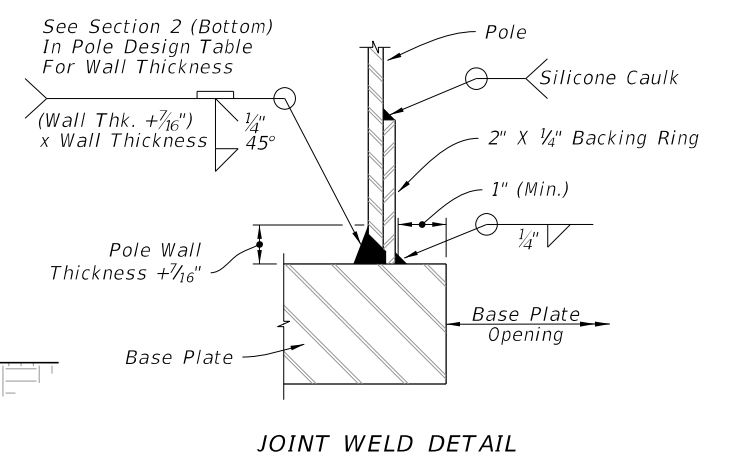

DETAIL "A"

10/12/2020 8:21:09 AM


11/01/21

LAST REVISION	DESCRIPTION:
11/01/18	
11/01/21	



FDOT FY 2021-22 STANDARD PLANS

STEEL CCTV POLE


INDEX	SHEET
649-020	3 of 6

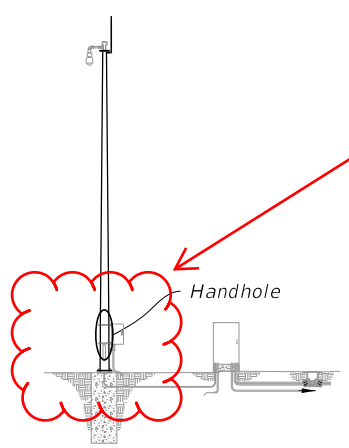



ASSEMBLY

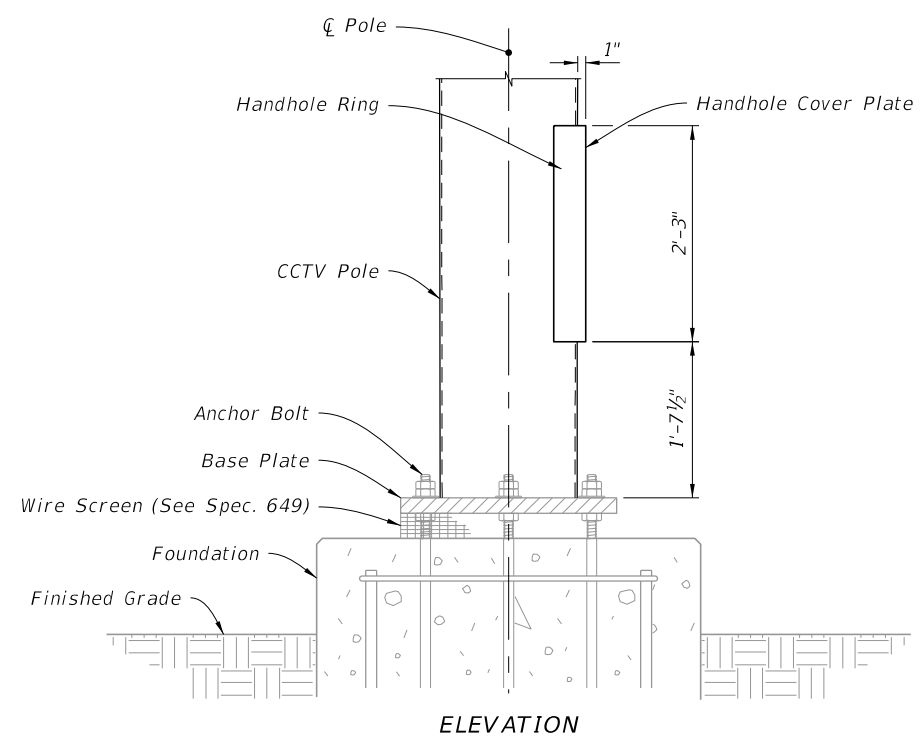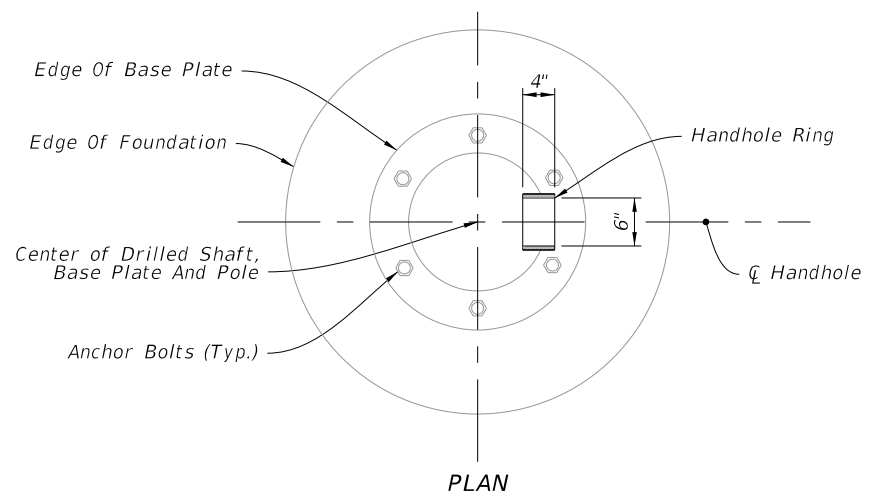



HANDHOLE LOCATION

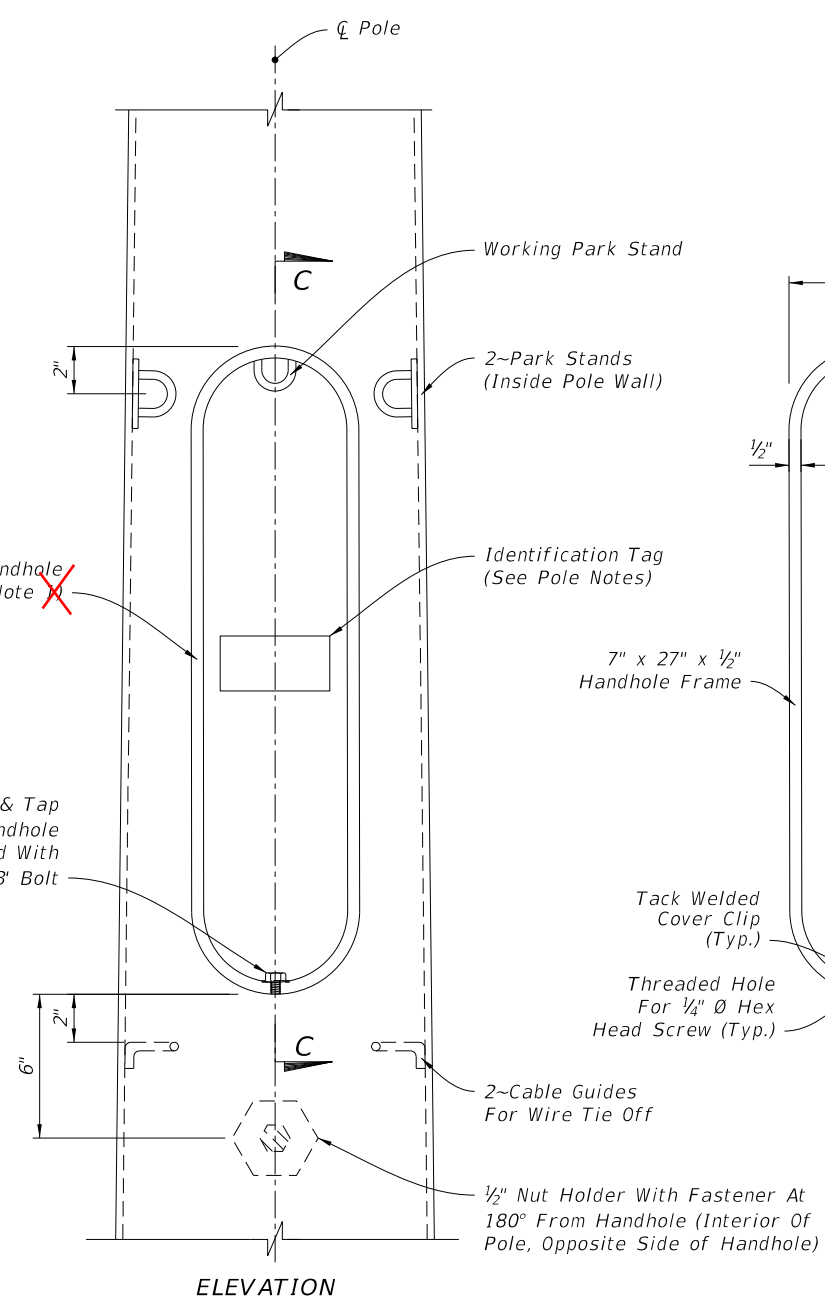


HANDHOLE DETAIL

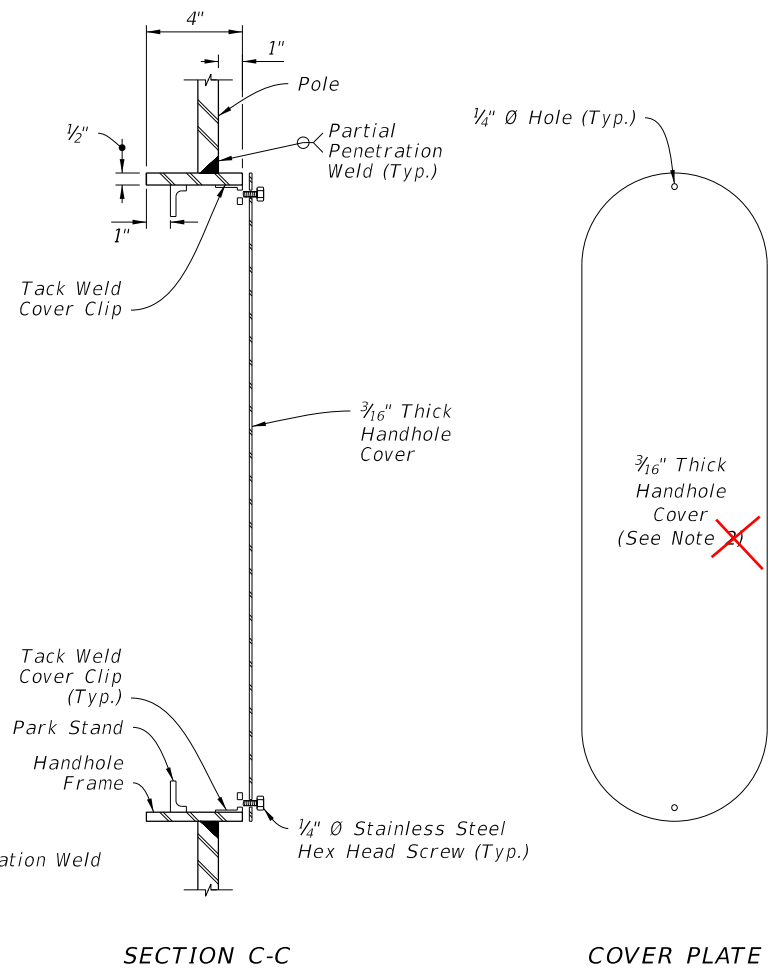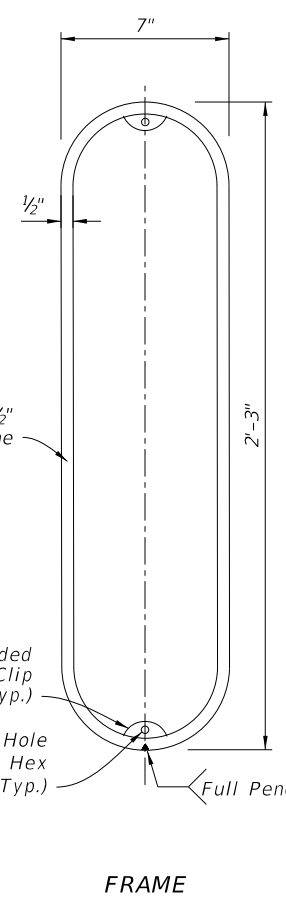

NOTE:
To secure the cover plate, install a steel chain from the cover to the pole or by mounting the cover with hinges and install a pad lock tab.

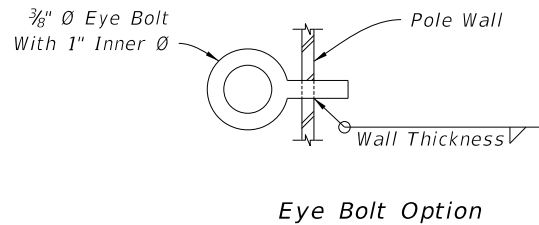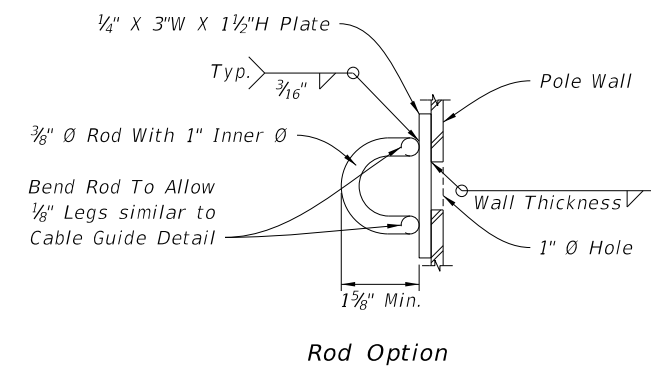


PARK STAND DETAILS

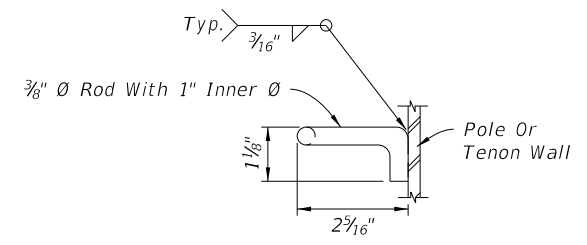

CABLE GUIDE DETAIL


10/12/2020 8:21:12 AM

LAST REVISION	DESCRIPTION:
11/01/17	11/01/21

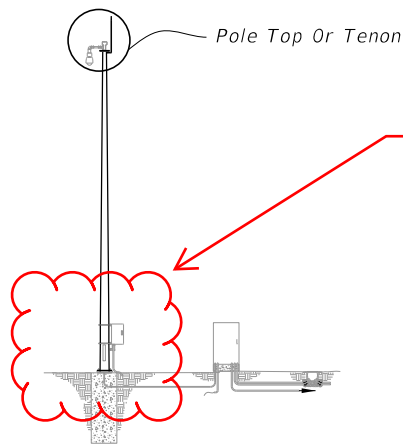


Updated Detail to match Sheet 1

ASSEMBLY

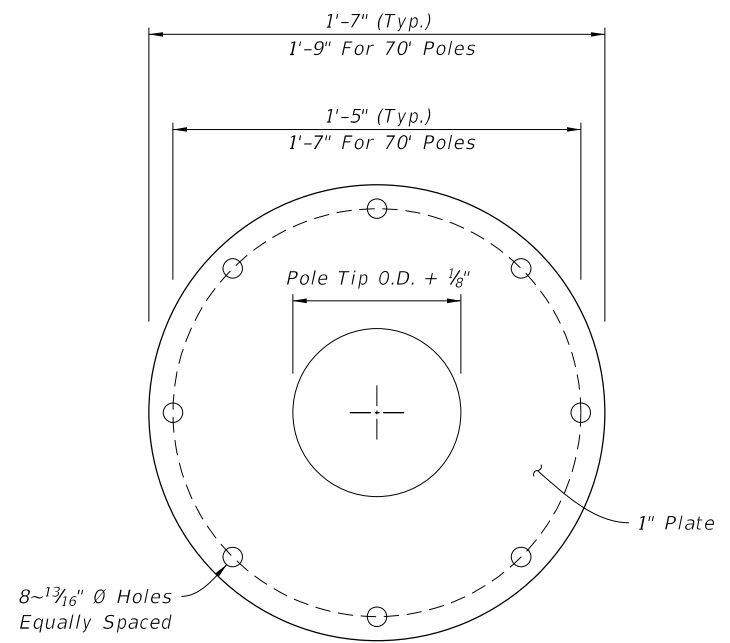


PLAN VIEW

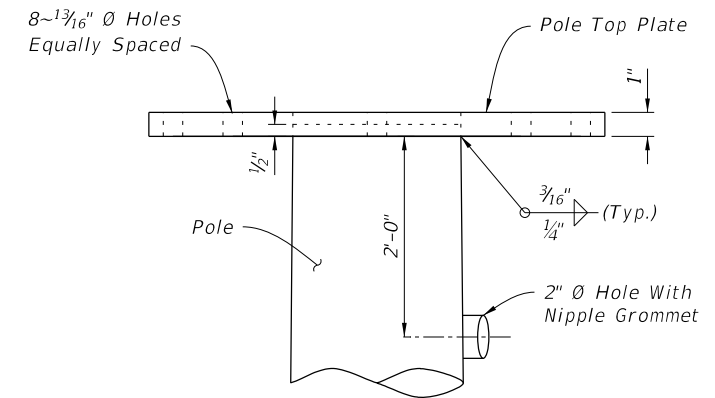


ELEVATION

POLE TOP PLATE

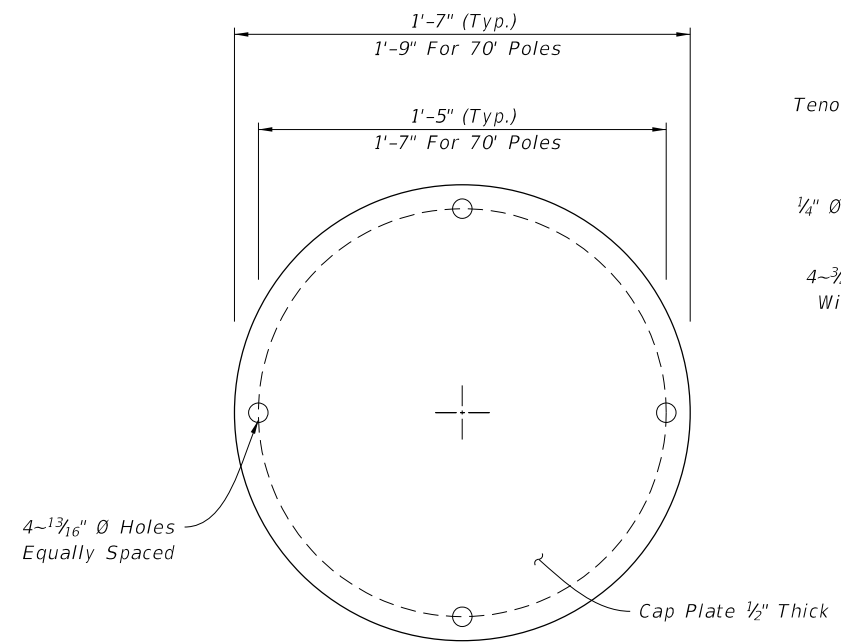


PLAN VIEW

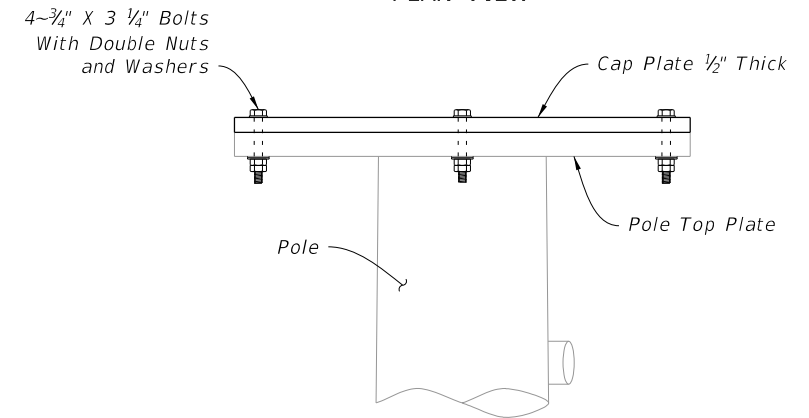


ELEVATION

POLE TOP DETAIL

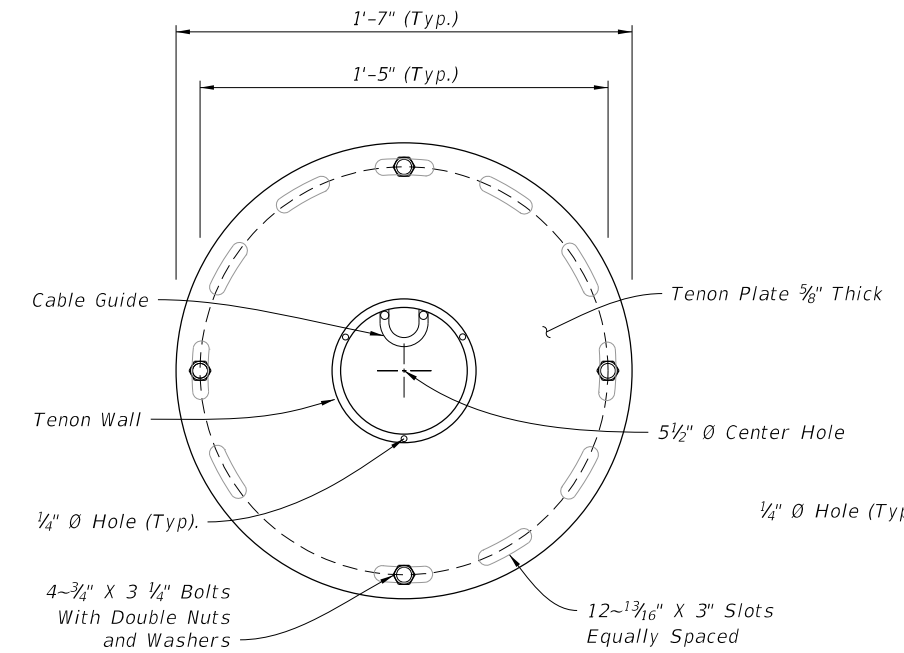


PLAN VIEW

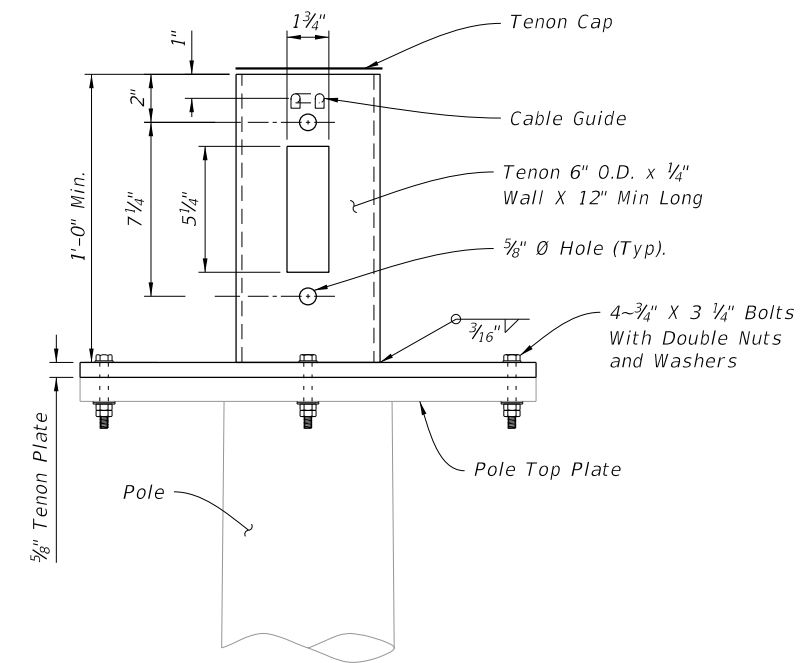


ELEVATION


LOWERING DEVICE TENON

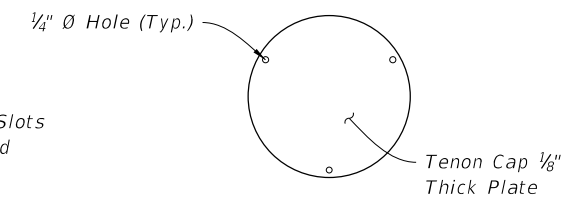

TENON CAP

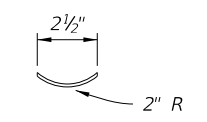

PLAN VIEW

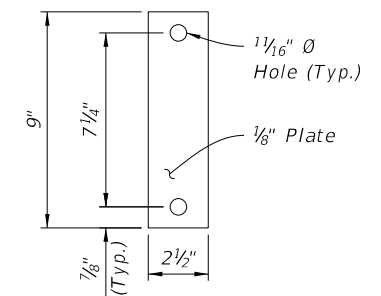

ELEVATION

TENON COVER

10/12/2020 8:21:16 AM


LAST REVISION	DESCRIPTION:
11/01/17	
	11/01/21

Bond #6 AWG Tin-Plated Bare Solid Copper Wire to Camera Support Base as Required.


Dome Type CCTV Camera

1/2" ETP Alloy 110 Copper Air Terminal (Class II) UL-96A Listed Surface Base of 8 Square Inches Minimum Contact Area Per NFPA 780-4.16.3


2'-0" Min.

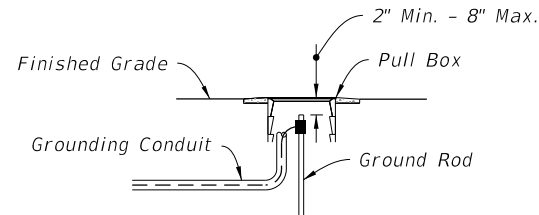


(Pole Mounted Cabinet Configuration Shown)
DETAIL "B"

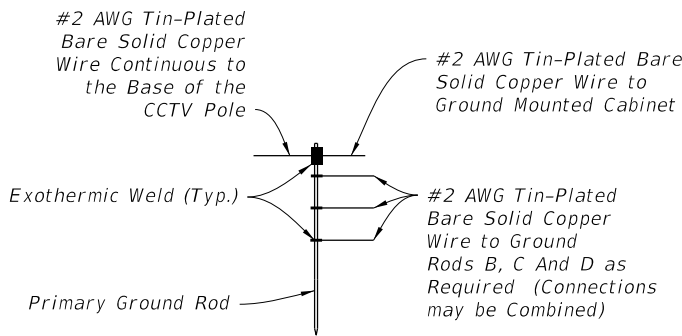

DETAIL "C"

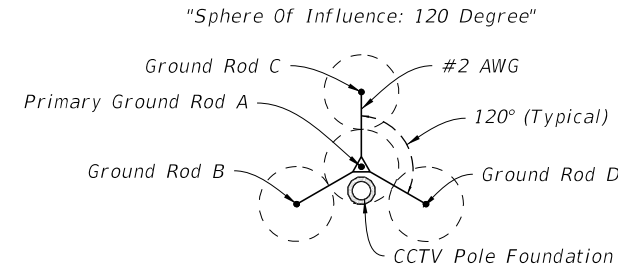


TYPICAL
(20' Rods, 40' Spacing)

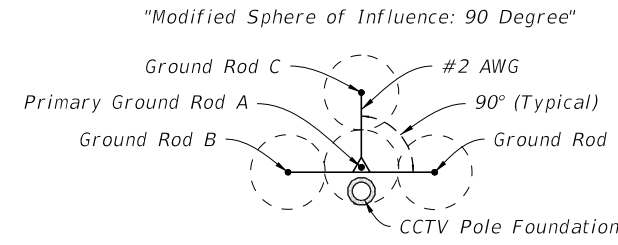


TYPICAL MODIFIED
(20' Rods, 40' Spacing)

GROUND ROD ARRAY PLACEMENT

DETAIL "D"

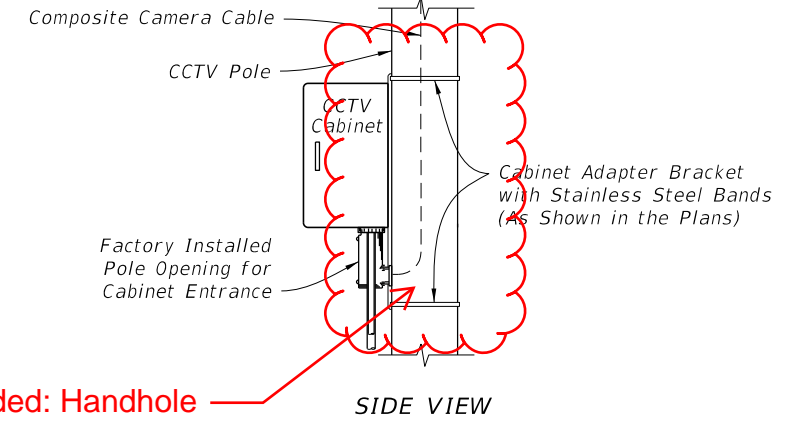


Added: Handhole SIDE VIEW

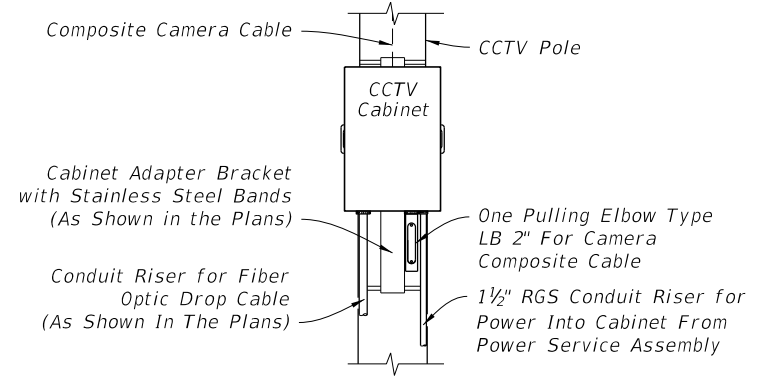


FRONT VIEW

DETAIL "E"

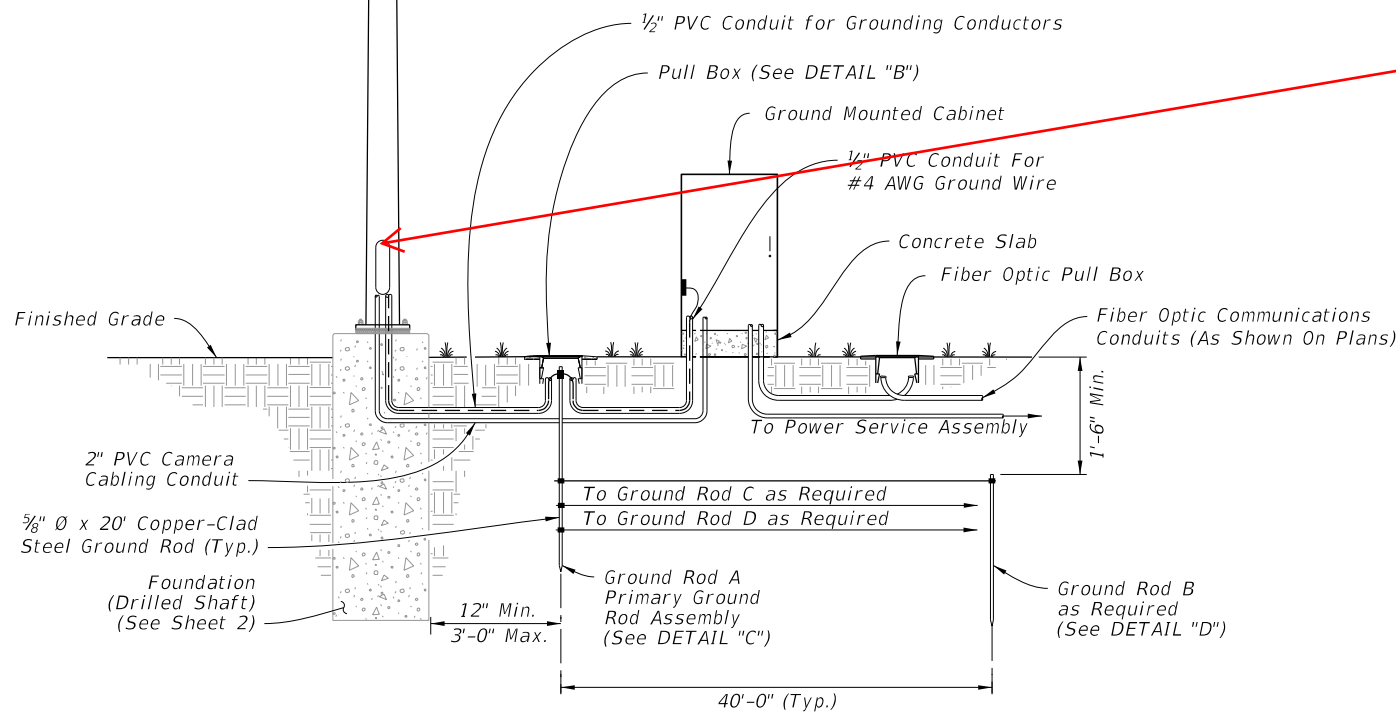

GROUND MOUNTED CABINET

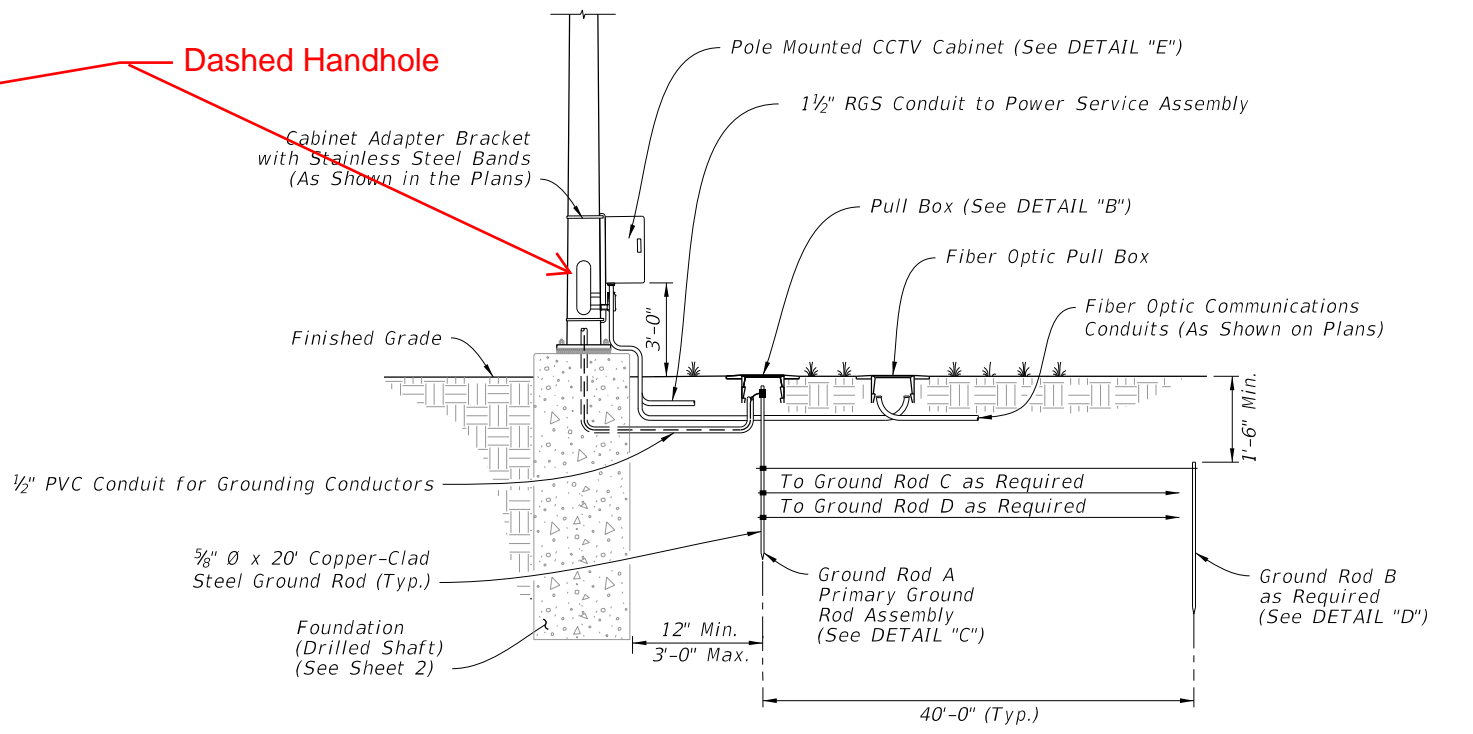

POLE MOUNTED CABINET

STEEL CCTV POLE GROUNDING

10/12/2020 8:21:19 AM

11/01/21

LAST REVISION	DESCRIPTION:
11/01/20	
11/01/21	



FY 2021-22
STANDARD PLANS

STEEL CCTV POLE

INDEX
649-020

SHEET
6 of 6

GENERAL NOTES:


1. Work this Index with Specification 649.
2. This Index is considered fully detailed; only submit shop drawings for minor modifications not detailed in the Plans.
3. See Index 635-001 for additional details for Pull Boxes.
4. Materials:
 - A. Pole: ASTM A1011 Grade 50, 55, 60 or 65 (less than 1/4") or ASTM A572 Grade 50, 60 or 65 (greater than or equal to 1/4") or ASTM A595 Grade A (55 ksi yield) or Grade B (60 ksi yield).
 - B. Steel Plates and Pole Cap: ASTM A36 or ASTM A709 Grade 50.
 - C. Weld Metal: E70XX.
 - D. Bolts: ASTM F3125, Grade A325, Type 1.
Nuts: ASTM A563.
Washers: ASTM F-436.
 - E. Anchor Bolts: ASTM F1554 Grade 55 with ASTM A563 Grade A heavy-hex nuts and ASTM A36 plate washers.
 - F. Handhole Frame: ASTM A709 Grade 36 or ASTM A36.
 - G. Handhole Cover: ASTM A1011 Grade 50, 55, 60 or 65.
 - H. Stainless Steel Screws: AISI Type 316.
 - I. Reinforcing Steel: ASTM A615 Grade 60.
 - J. Galvanization: Bolts, nuts and washers: ASTM F2329 All other steel including plate washer: ASTM A123
 - K. Concrete: Class IV (Drilled Shaft) for all environment classifications.

5. Fabrication:
 - A. Welding:
 - a. Specification 460-6.4 and
 - b. AASHTO RFD Specification for Structural Supports for Highway Signs, Luminaires, and Traffic Signals Section 14.4.4.
 - B. Poles:
 - a. Round or 16-sided (Min.)
 - b. Taper pole diameter at 0.14 inches per foot
 - c. Fabricate Pole longitudinal seam welds (2 maximum) with 60 percent minimum penetration or fusion welds except as follows:
 1. Use a full-penetration groove weld within 6 inches of the circumferential tube-to-plate connection and
 2. Use full-penetration groove welds on the female end section of telescopic (i.e., slip type) field splices for a minimum length of one and one-half times the inside diameter of the female section plus 6 inches.
 - d. Pole shaft may be either one or two sections (with telescopic field splice)
 - e. Circumferentially welded pole shafts and laminated pole shafts are not permitted
 - C. Identification Tag: (Submit details for approval)
 - a. 2"x 4" (Max.) aluminum tag
 - b. Locate on the inside of the pole and visible from the handhole
 - c. Secure with 1/8" diameter stainless steel rivets or screws.
 - d. Include the following information on the ID Tag:
 1. Financial Project ID
 2. Pole Type
 3. Pole Height
 4. Manufacturers' Name
 5. Yield Strength (Fy of Steel)
 6. Base Wall Thickness
 - D. Except for Anchor Bolts, bolt hole diameters are bolt diameter plus 1/16" and anchor bolt holes are bolt diameter plus 1/2" (Max) prior to galvanizing.

6. Pole Installation:
 - A. Do not install additional wire access holes (not shown in this Index) with a diameter that exceeds 1 1/2" in diameter.
 - B. Install Anchor Bolts in accordance with Specification 649-5.
 - C. Cable Supports: Electrical Cable Guides and Eyebolts.
 - a. Locate top and bottom cable guides within the pole aligned with each other.
 - b. Position one cable guide 2" below the handhole.
 - c. Position other cable guide 1" directly below the top of the tenon.
 - d. Position Park Stands 2" below the top of the handhole.
 - D. Install Pole with the handhole located away from approaching traffic.
 - E. Install the Pole plumb.


7. Cabinet Installation:
 - A. Splice fiber optic cables in cabinet to preterminated patch panel.
 - B. Furnish and install Surge Protection Devices (SPDs) on all cabling in cabinet.
 - C. Furnish and install secondary SPDs protection on outlets for equipment in cabinet.
 - D. Ensure that all electronic equipment power is protected and conditioned with SPDs.
 - E. Ensure that equipment cabinet is bonded to CCTV pole grounding system.
 - F. Install the pole mounted cabinet with the hinges next to the pole.
 - G. Sizes and types of conduits and inner ducts for network communications between the pullbox and cabinet are stated in the Contract Documents.


8. Lowering Device Installation:
 - A. Place the lowering cable that moves within the pole in an interior conduit to prevent it from tangling or interfering with any electrical wire that is in the pole. Ensure that any electrical wire within the pole is routed securely and free from slack.
 - B. Mount lowering device perpendicular to the roadway or as shown in the plans. Position CC TV pole so that the camera can be safely lowered without requiring lane closures.
 - C. Coordinate all lowering device hardware requirements (including Tenon, Tenon mounting plates, parking stands, etc.) with lowering device manufacturer.

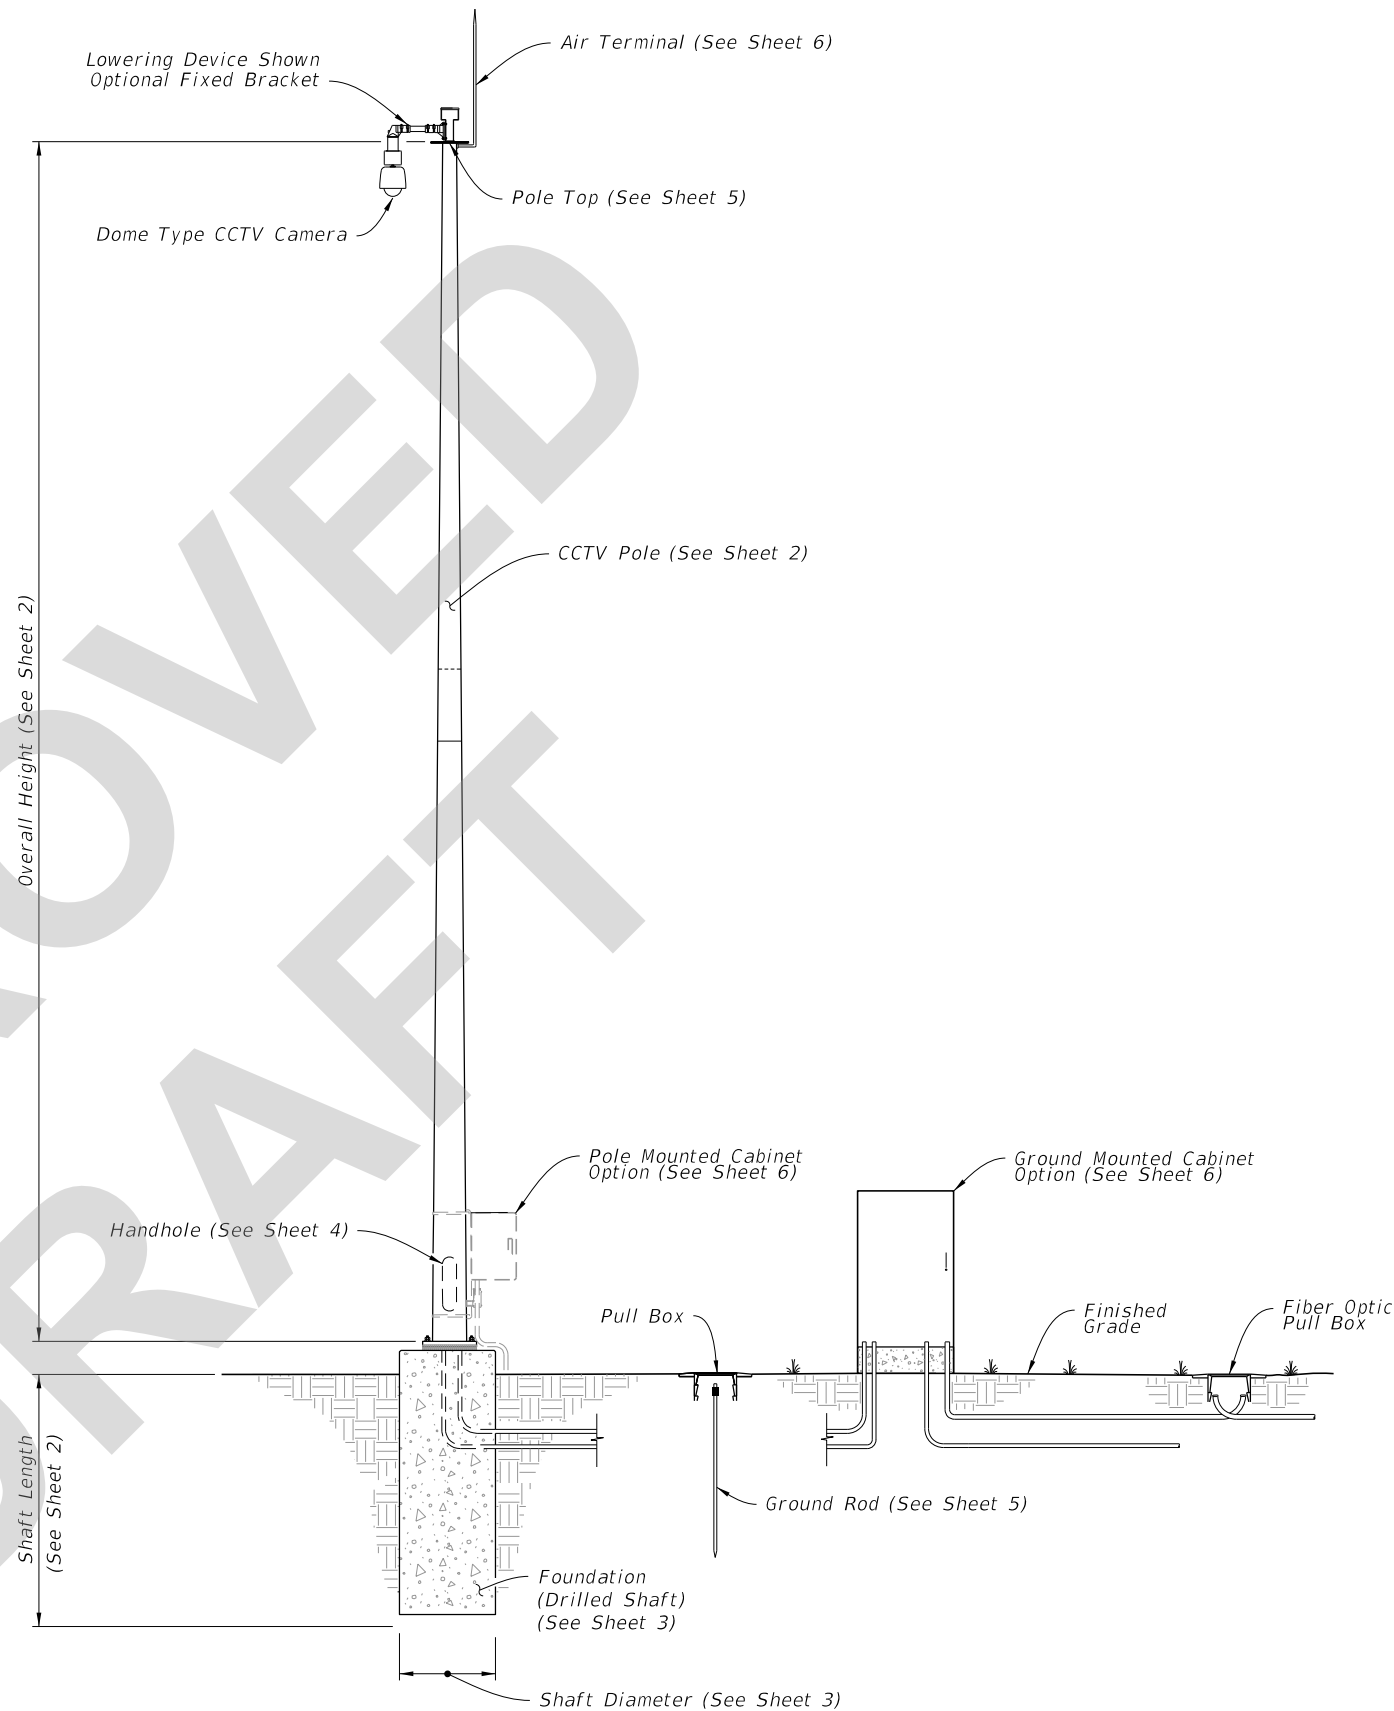

STEEL CCTV POLE ASSEMBLY

5/5/2021 1:39:00 PM

LAST REVISION 11/01/21	REVISION	DESCRIPTION:	 FY 2022-23 STANDARD PLANS	STEEL CCTV POLE	INDEX 649-020	SHEET 1 of 6
---------------------------	----------	--------------	--	-----------------	------------------	-----------------

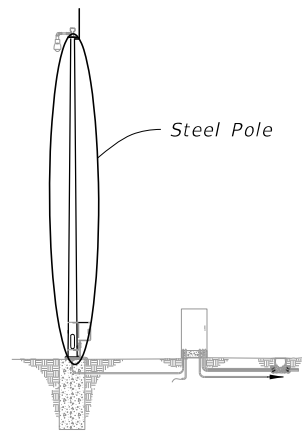

Steel Pole

SHAFT DESIGN TABLE			
Pole Overall Height (ft)	Shaft Diameter	Shaft Length	Longitudinal Reinforcement
50	4'-0"	11'-0"	(14) #11
55	4'-0"	12'-0"	(14) #11
60	4'-6"	13'-0"	(16) #11
65	4'-6"	13'-0"	(16) #11
70	5'-0"	14'-0"	(18) #11



ADDITIONAL SHAFT DEPTH DUE TO GROUND SLOPE		
Ground Slope	4'-0" Shaft Diameter	5'-0" Shaft Diameter
1:5	3'-0"	4'-0"
1:4	4'-0"	5'-0"
1:3	5'-0"	6'-0"
1:2	7'-0"	9'-0"

FOUNDATION NOTES:

1. Shaft Length is based on 1'-0" height above the finished grade.
2. Shaft Design Table Shaft Length is based on level ground (flatter than 1:5). Increase the shaft depth in accordance with the Additional Shaft Depth Due To Ground Slope table for foundations with slopes 1:5 and steeper. Use the higher value for slope or diameter values that fall between those shown on the table.

BASE PLATE AND ANCHOR BOLT DESIGN TABLE							
Pole Overall Height (ft)	Base Plate Diameter (in.)	Base Plate Thickness (in.)	Anchor Bolt Circle (in.)	Number of Bolts	Anchor Bolt Diameter (in.)	Anchor Bolt Embedment (in.)	Minimum Anchor Bolt Projection (in.)
50	27	2.5	22	6	1.25	31	8.5
55	28	2.5	23	6	1.25	33	8.5
60	33	2.5	27	6	1.50	34	9.5
65	35	2.5	29	6	1.50	35	9.5
70	40	2.5	33	6	1.75	38	10.5

POLE DESIGN TABLE							
Pole Overall Height (ft)	Section 1 (Top)			Section 2 (Bottom)			Joint
	Length	Wall Thickness (in.)	Base Diameter (in.)	Length	Wall Thickness (in.)	Base Diameter (in.)	Minimum Splice Length (in.)
50	---	---	---	50'-0"	0.25	17	---
	25'-0"	0.25	14	28'-0"	0.25	17	27
55	30'-0"	0.25	15	28'-0"	0.3125	18	30
60	35'-0"	0.25	18	29'-0"	0.3125	21	33
65	33'-0"	0.25	19	36'-0"	0.3125	23	33
70	38'-0"	0.25	22	36'-0"	0.3125	26	39

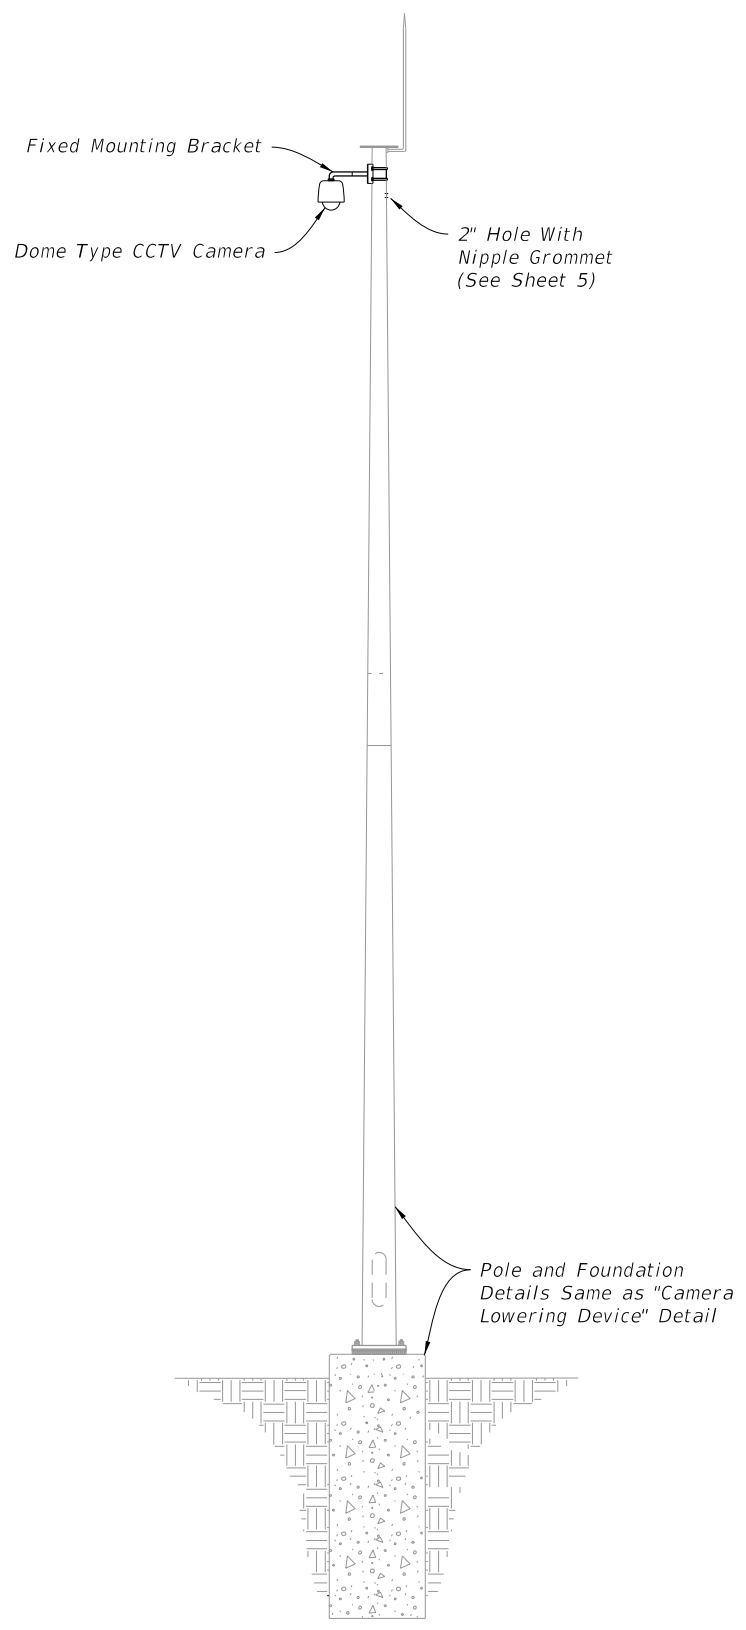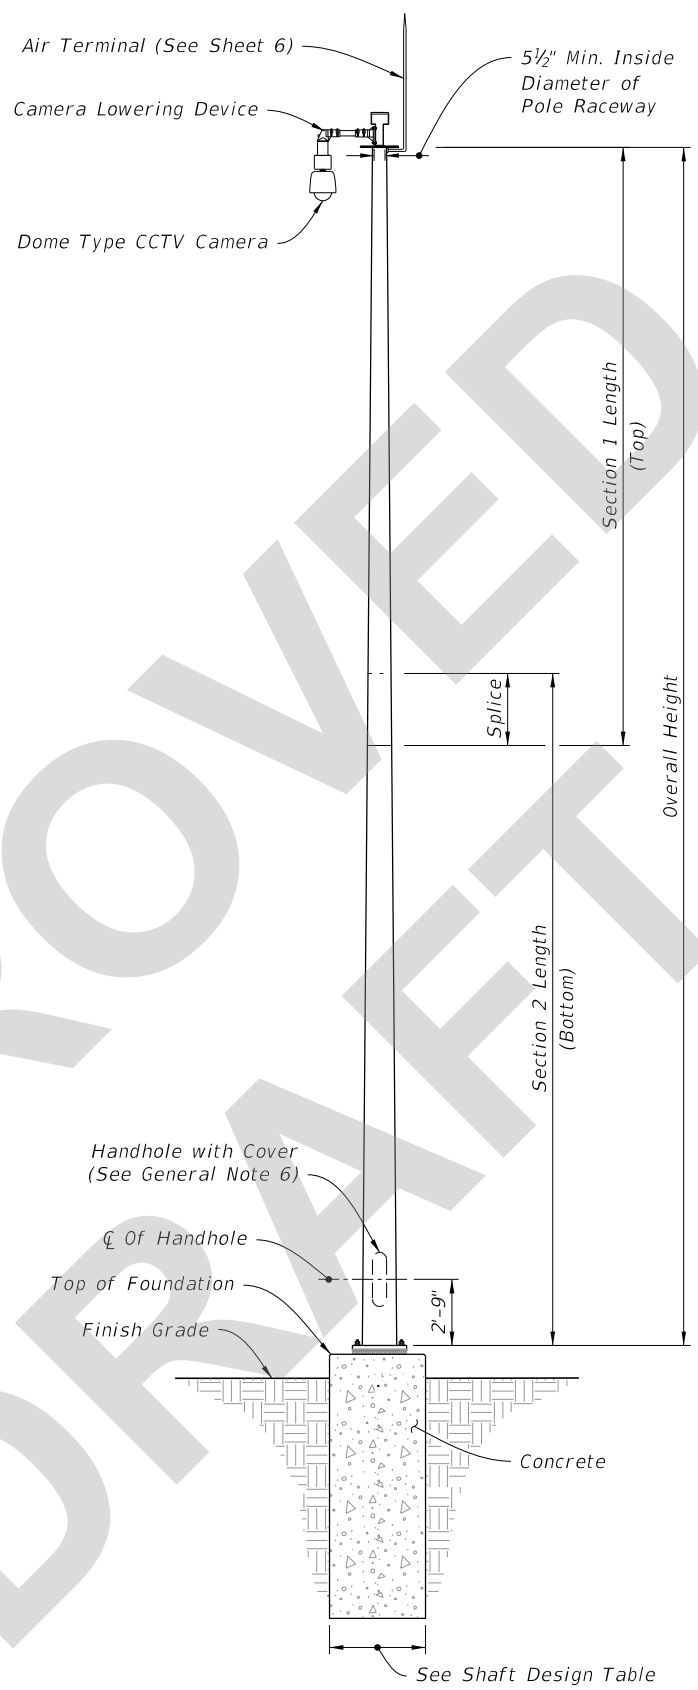


CAMERA LOWERING DEVICE

FIXED MOUNTING BRACKET



ELEVATION

5/3/2021 9:58:18 AM

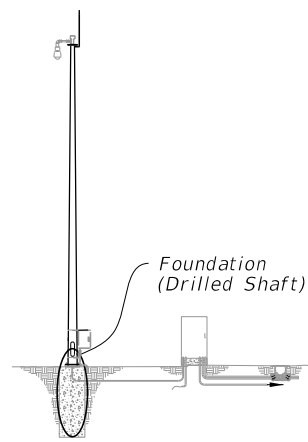


ASSEMBLY


- NOTES:**
1. Shaft Length is based on 1'-0" height above the finished grade.
 2. Double Nuts: Bottom nut may be half-height 'jam' nut. Provide individual nut covers (not shown) for each bolt.
 3. Conduit and CSL Tubes not shown for clarity.
 4. Work these details with Data Table on Sheet 2.

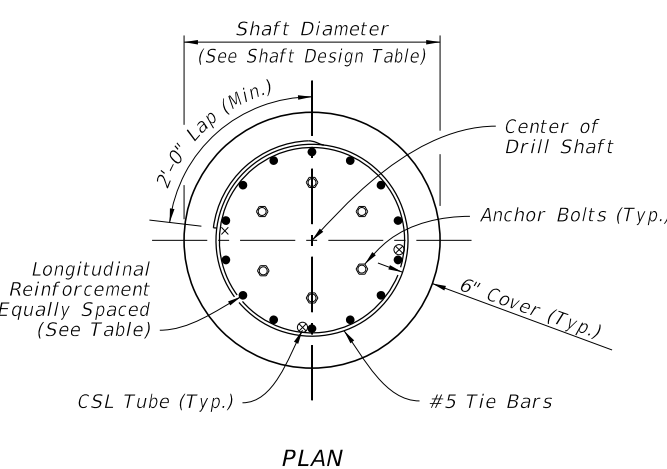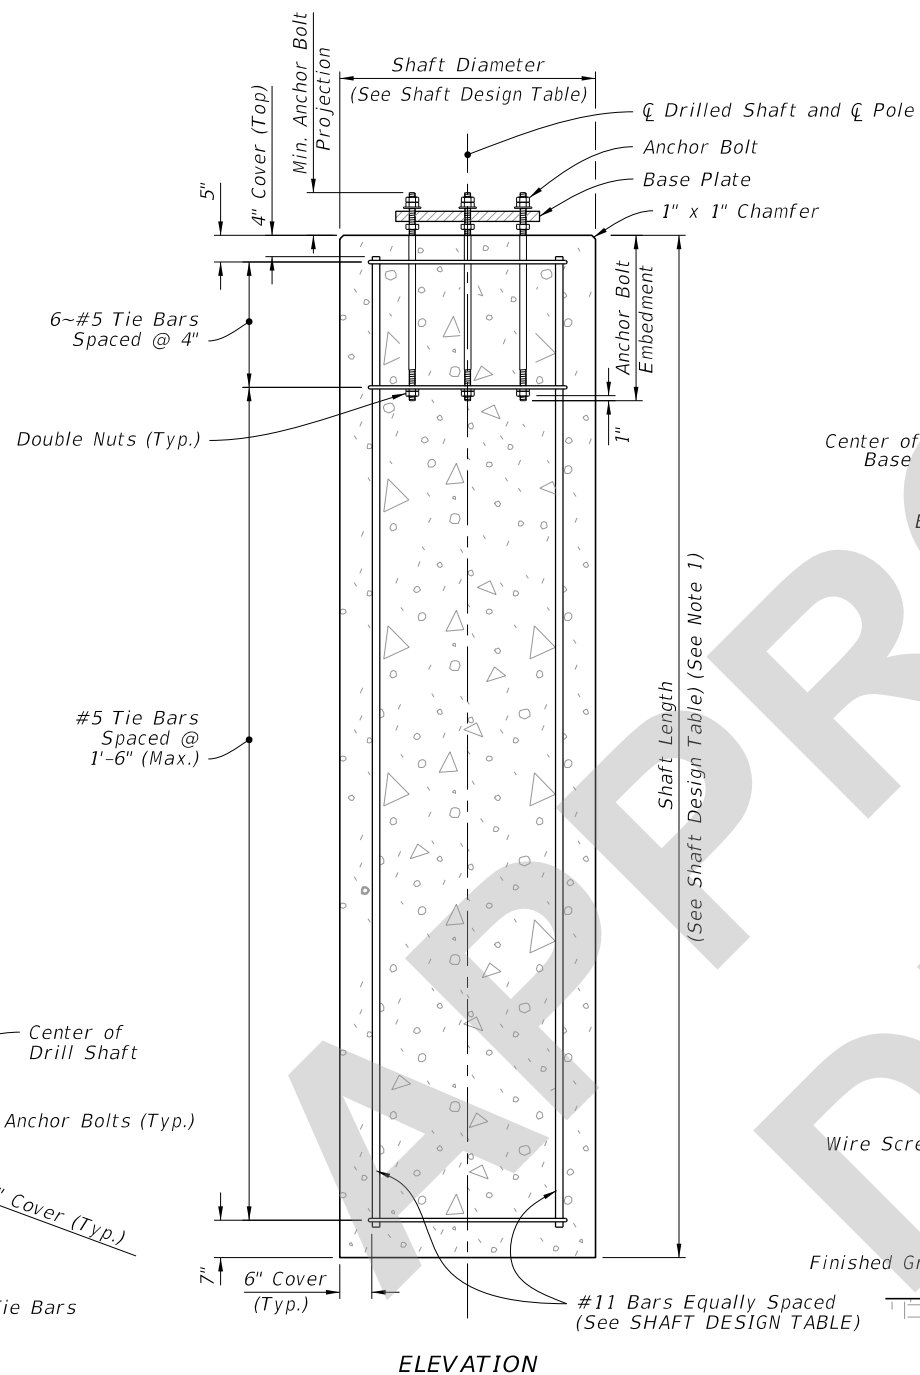


PLAN

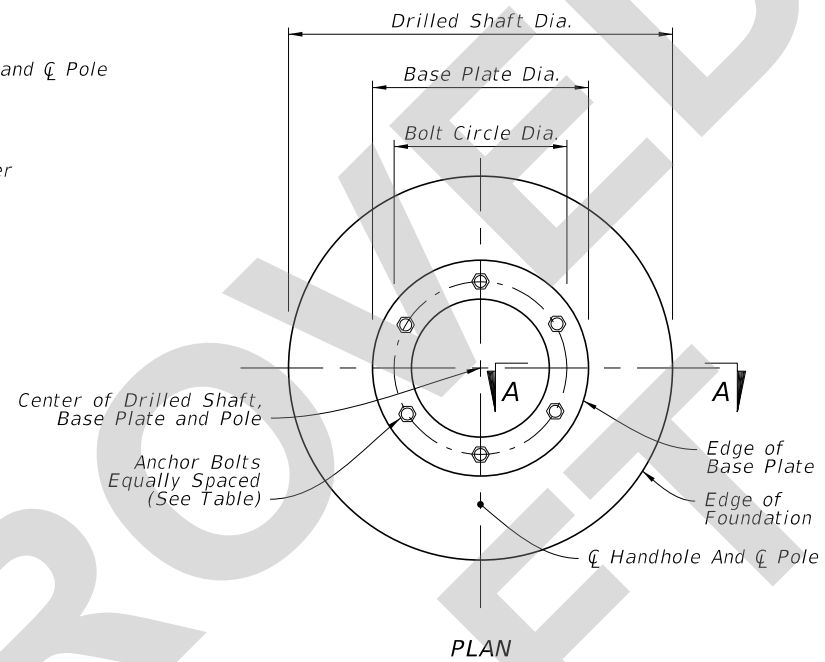


PLAN

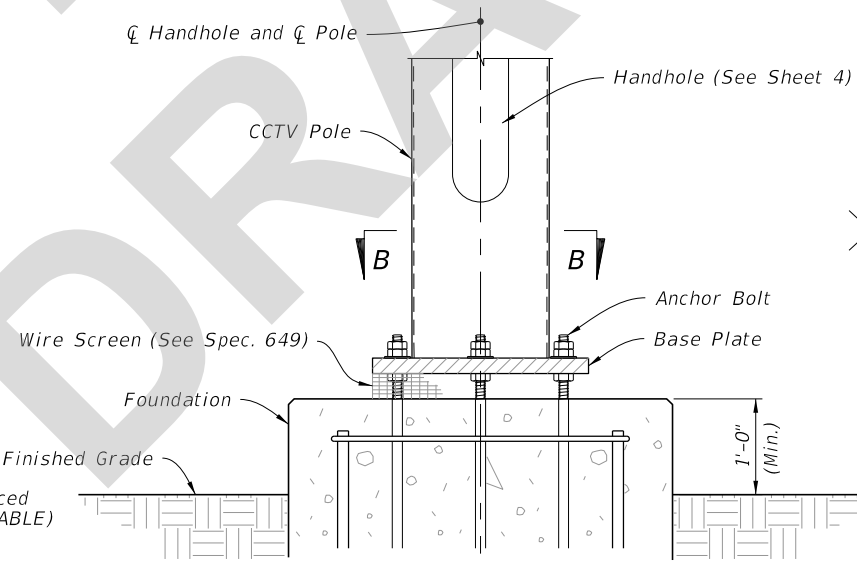


ELEVATION

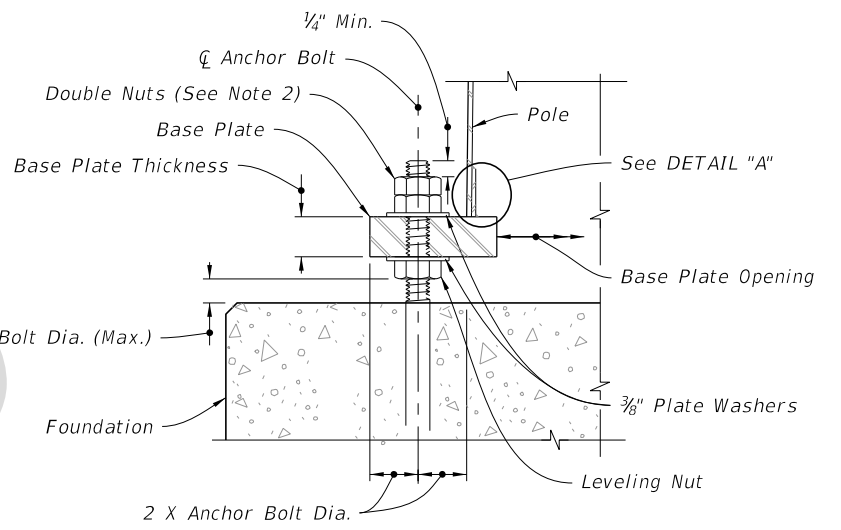

SECTION A-A

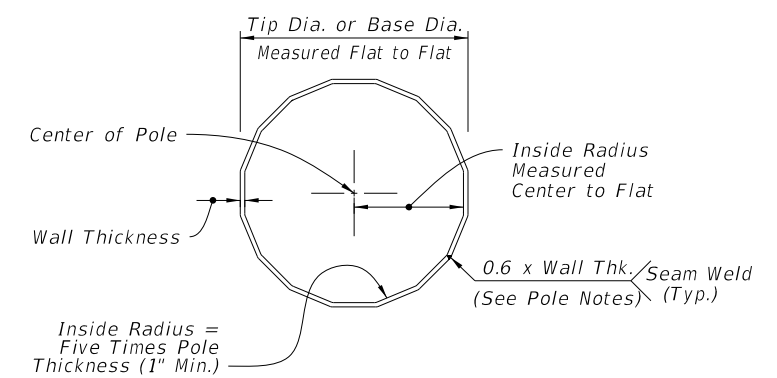

SECTION B-B

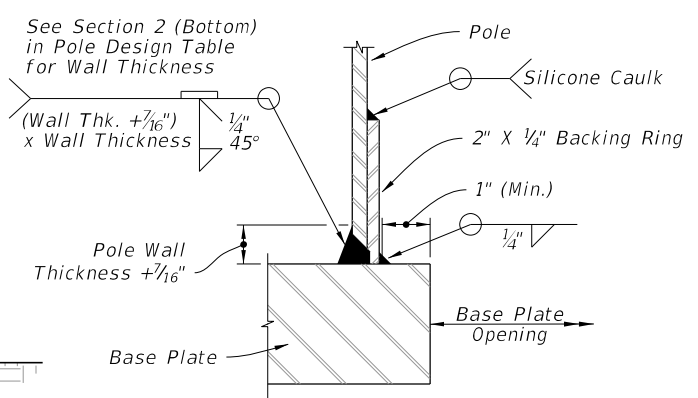

JOINT WELD DETAIL


FOUNDATION

BASE PLATE


DETAIL "A"

5/3/2021 9:58:21 AM


LAST REVISION 11/01/21	REVISION	DESCRIPTION:		FY 2022-23 STANDARD PLANS	STEEL CCTV POLE	INDEX 649-020	SHEET 3 of 6
---------------------------	----------	--------------	--	------------------------------	-----------------	------------------	-----------------

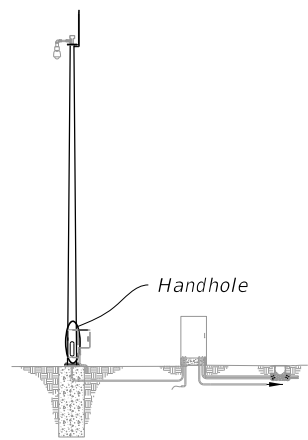

ASSEMBLY

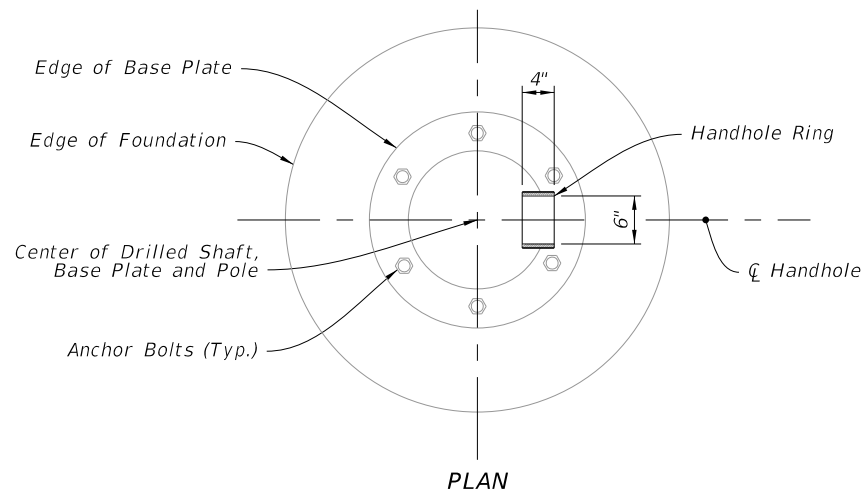


PLAN

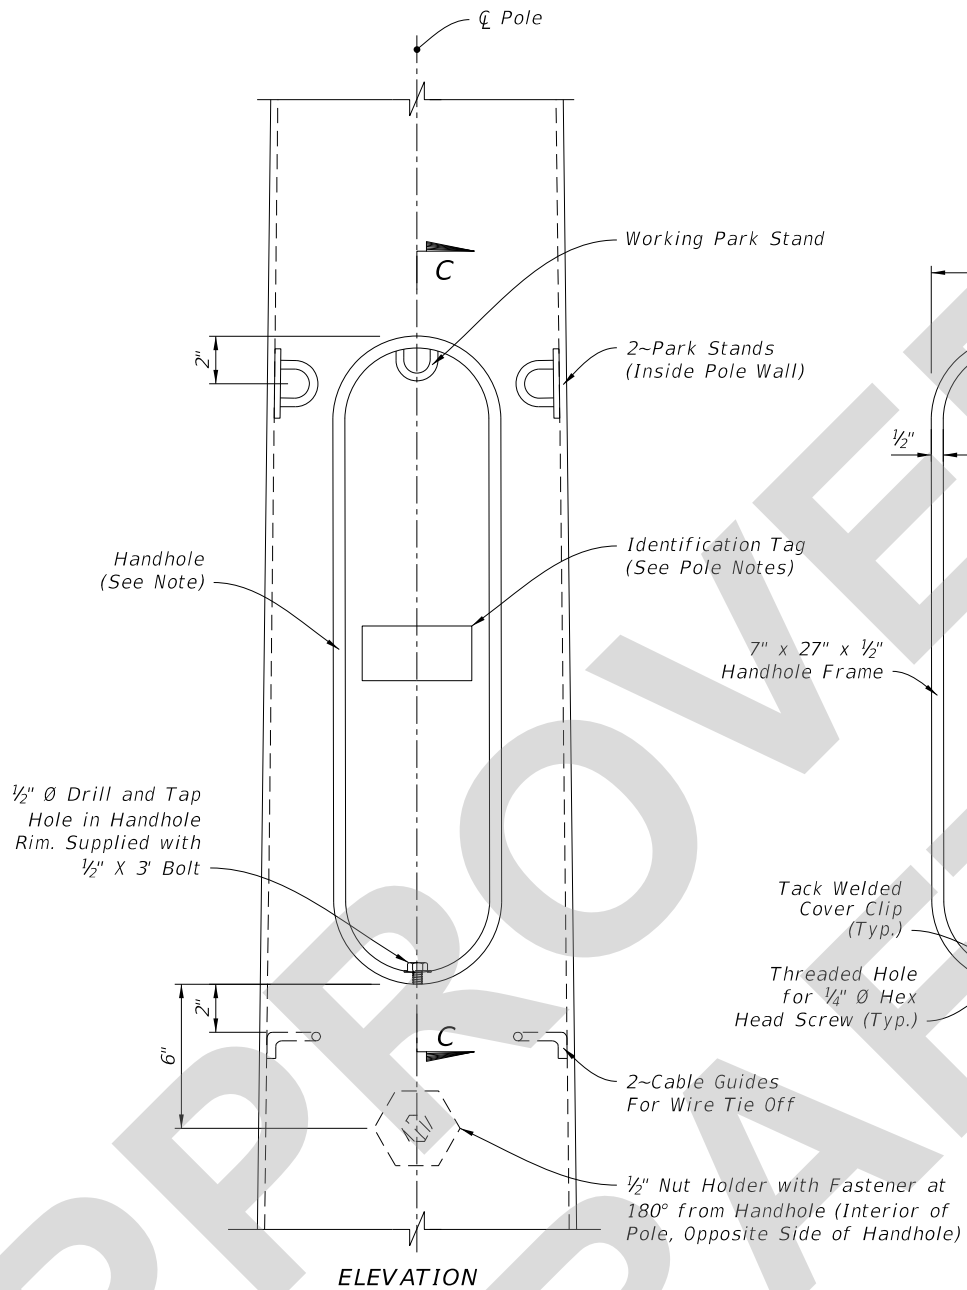

ELEVATION

FRAME

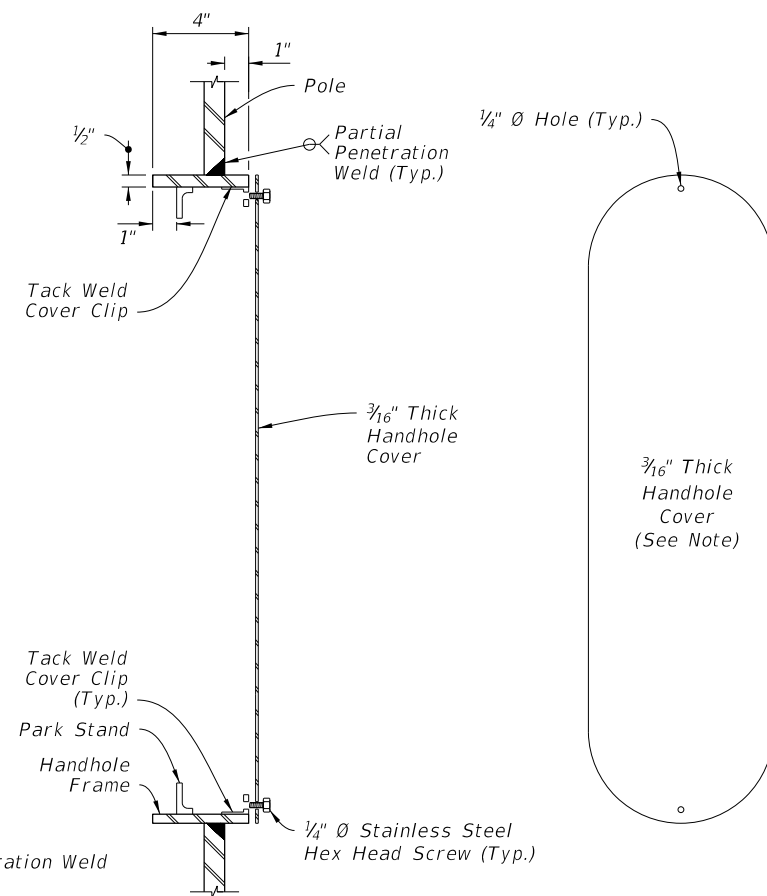


SECTION C-C

COVER PLATE


NOTE:

To secure the cover plate, install a steel chain from the cover to the pole or by mounting the cover with hinges and install a pad lock tab.

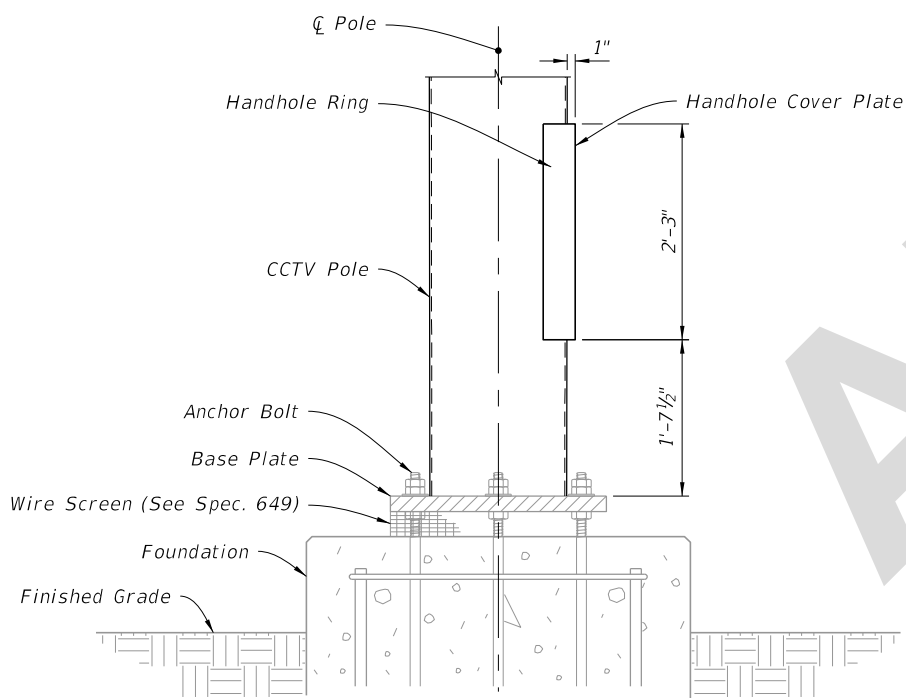


ELEVATION


HANDHOLE LOCATION

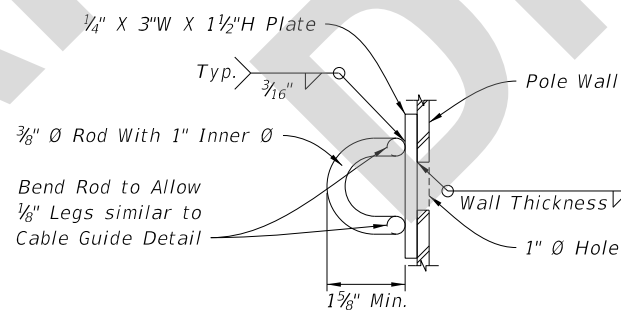

Rod Option

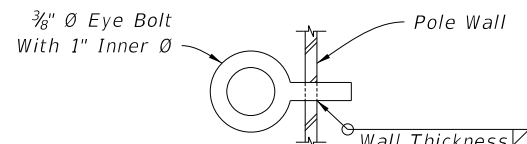

Eye Bolt Option

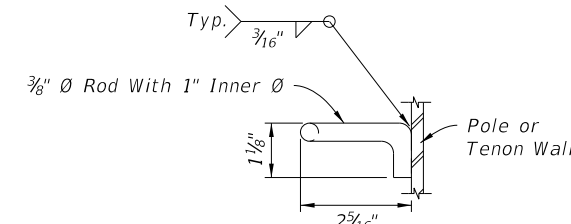

CABLE GUIDE DETAIL

HANDHOLE DETAIL

PARK STAND DETAILS

6/14/2021 11:54:28 AM

LAST REVISION	DESCRIPTION:
11/01/21	




FY 2022-23
STANDARD PLANS


STEEL CCTV POLE

INDEX
649-020


SHEET
4 of 6

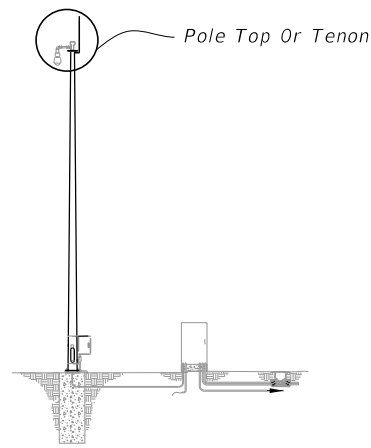

ASSEMBLY

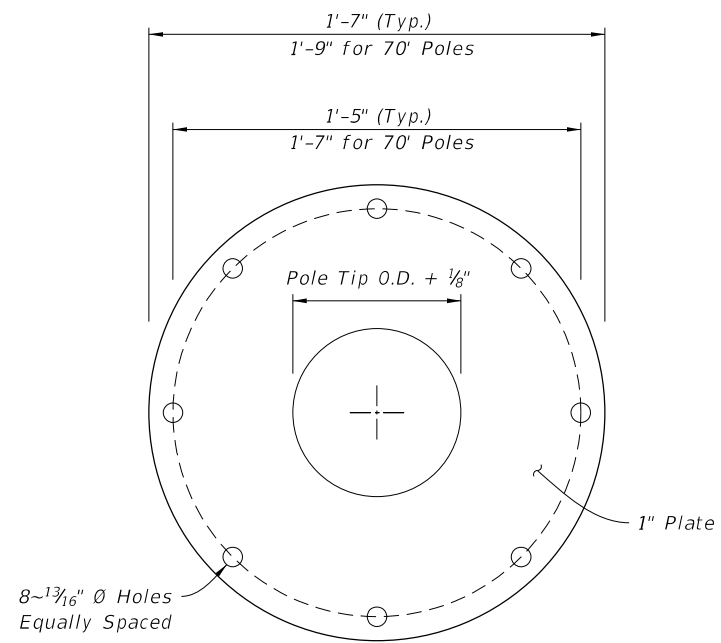


PLAN VIEW

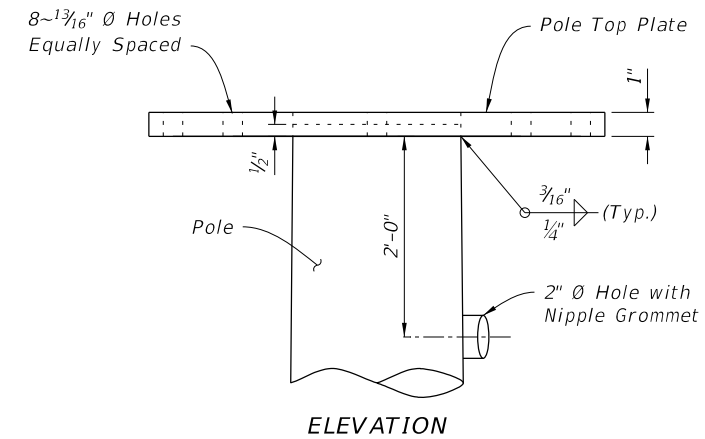


ELEVATION

POLE TOP PLATE

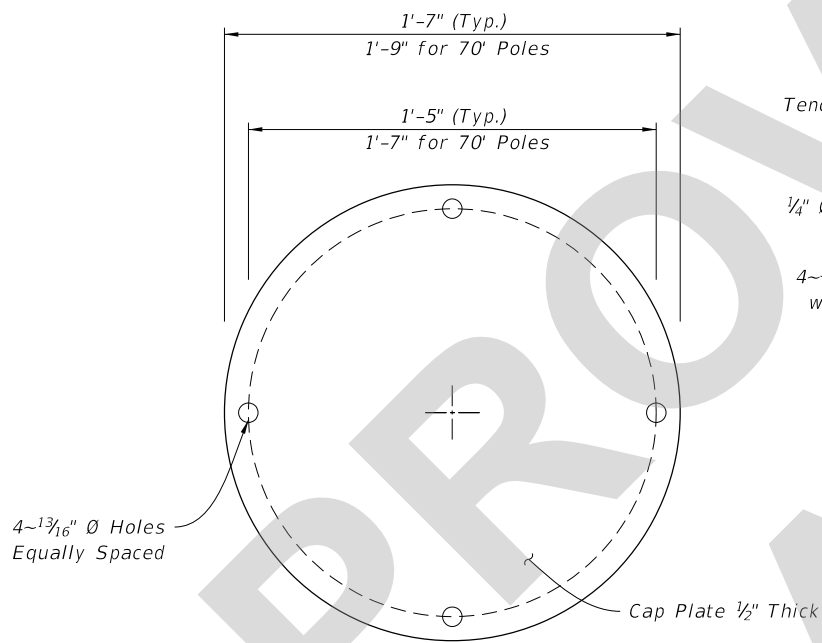


PLAN VIEW

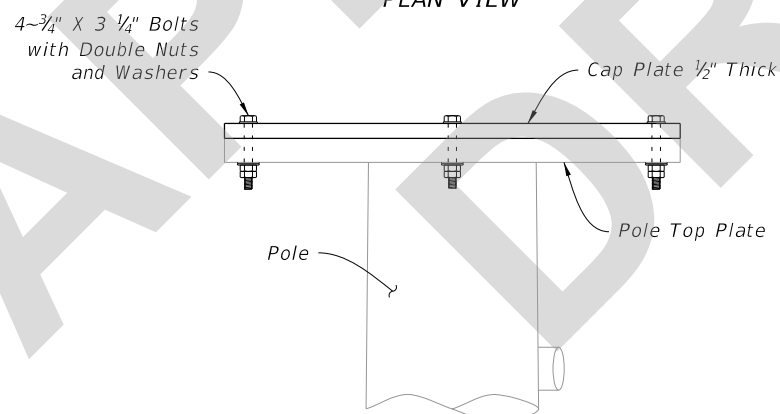


ELEVATION

CAP PLATE DETAIL

POLE TOP DETAIL

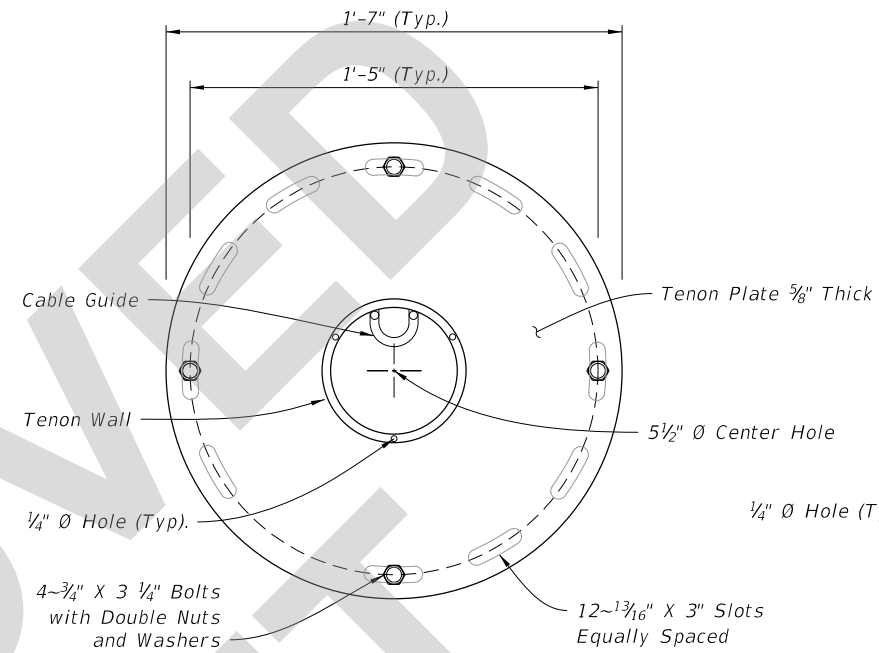


PLAN VIEW

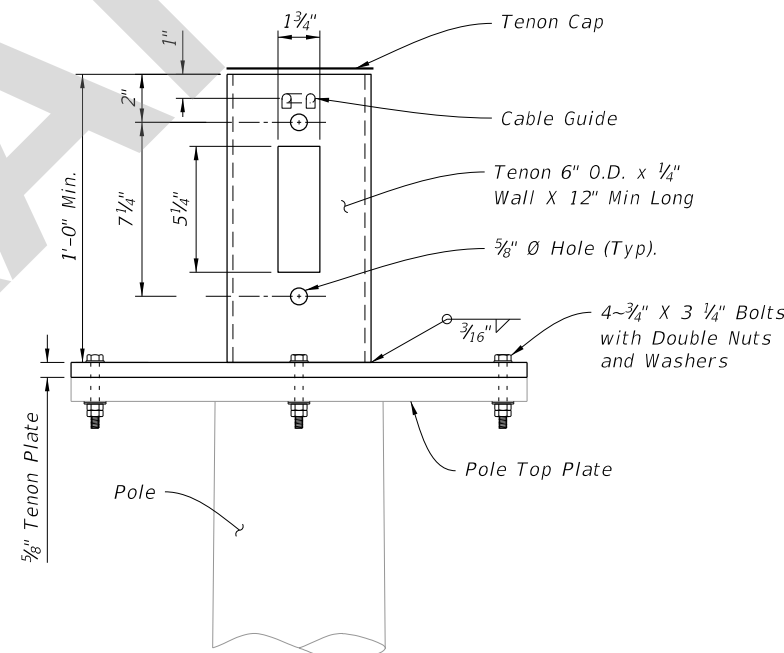


ELEVATION


LOWERING DEVICE TENON

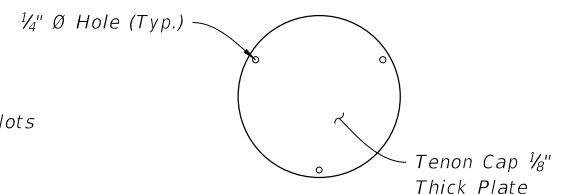

TENON CAP

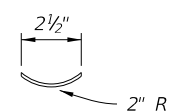

PLAN VIEW

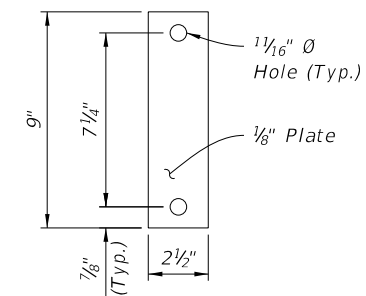

ELEVATION

TENON COVER

5/3/2021 9:58:28 AM

LAST REVISION 11/01/21	REVISION	DESCRIPTION:
---------------------------	----------	--------------

FY 2022-23
STANDARD PLANS

STEEL CCTV POLE


INDEX 649-020	SHEET 5 of 6
------------------	-----------------

Bond #6 AWG Tin-Plated Bare Solid Copper Wire to Camera Support Base as Required.


Dome Type CCTV Camera

1/2" ETP Alloy 110 Copper Air Terminal (Class II) UL-96A Listed Surface Base of 8 Square Inches Minimum Contact Area Per NFPA 780-4.16.3


2'-0" Min.

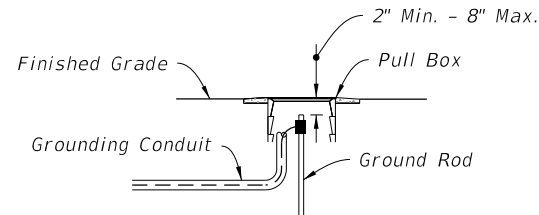


(Pole Mounted Cabinet Configuration Shown)
DETAIL "B"

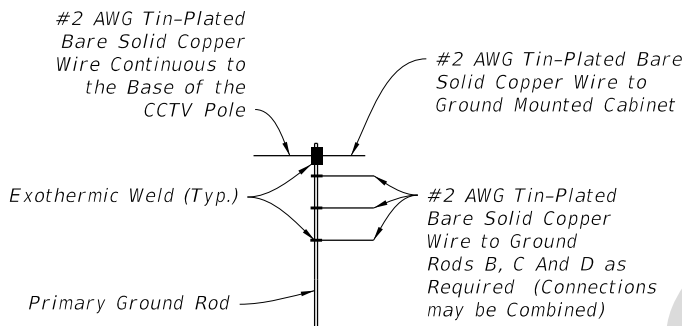

DETAIL "C"

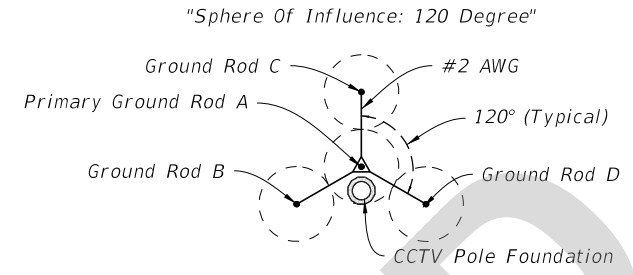


TYPICAL
(20' Rods, 40' Spacing)

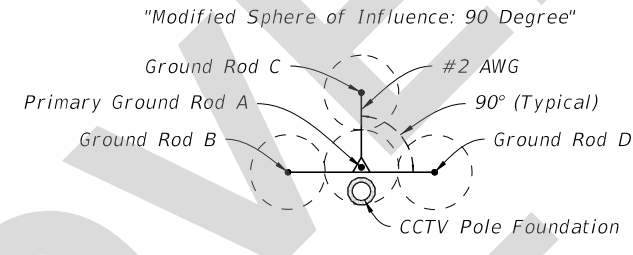


TYPICAL MODIFIED
(20' Rods, 40' Spacing)

GROUND ROD ARRAY PLACEMENT

DETAIL "D"

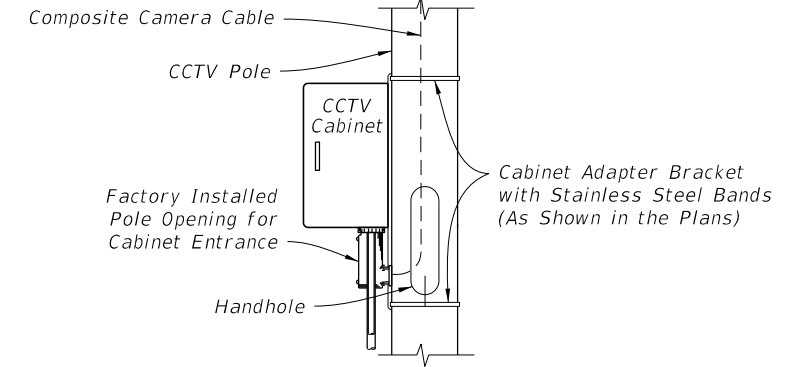


SIDE VIEW

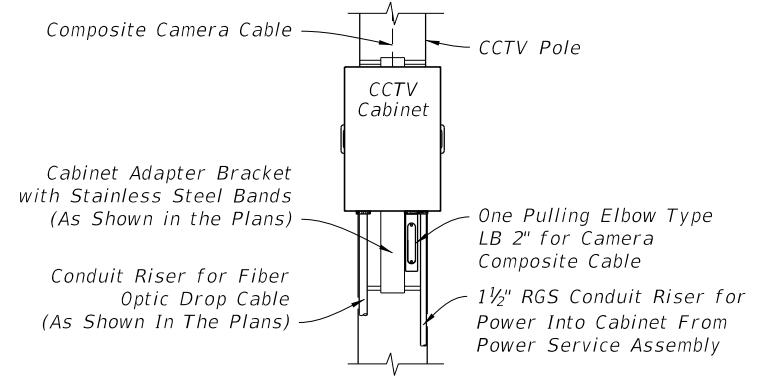


FRONT VIEW

DETAIL "E"

CCTV Pole (See Sheet 2)

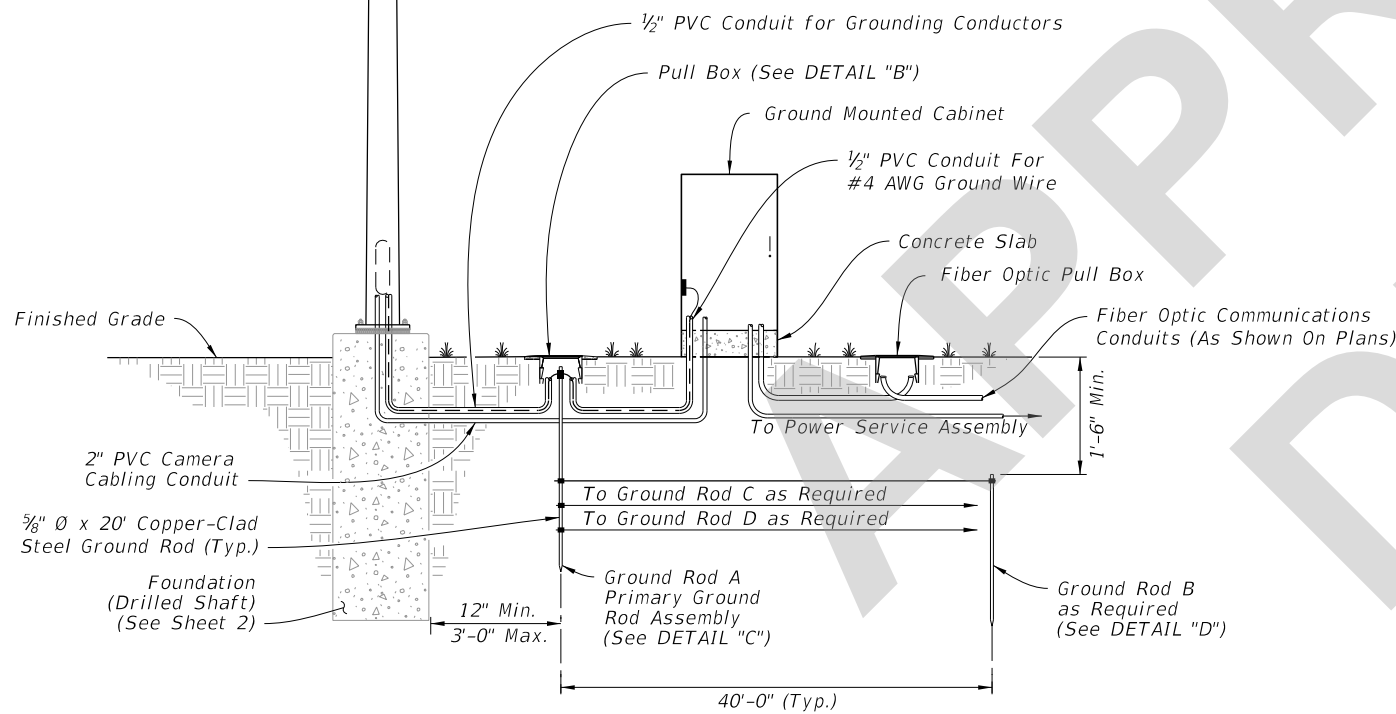

GROUND MOUNTED CABINET

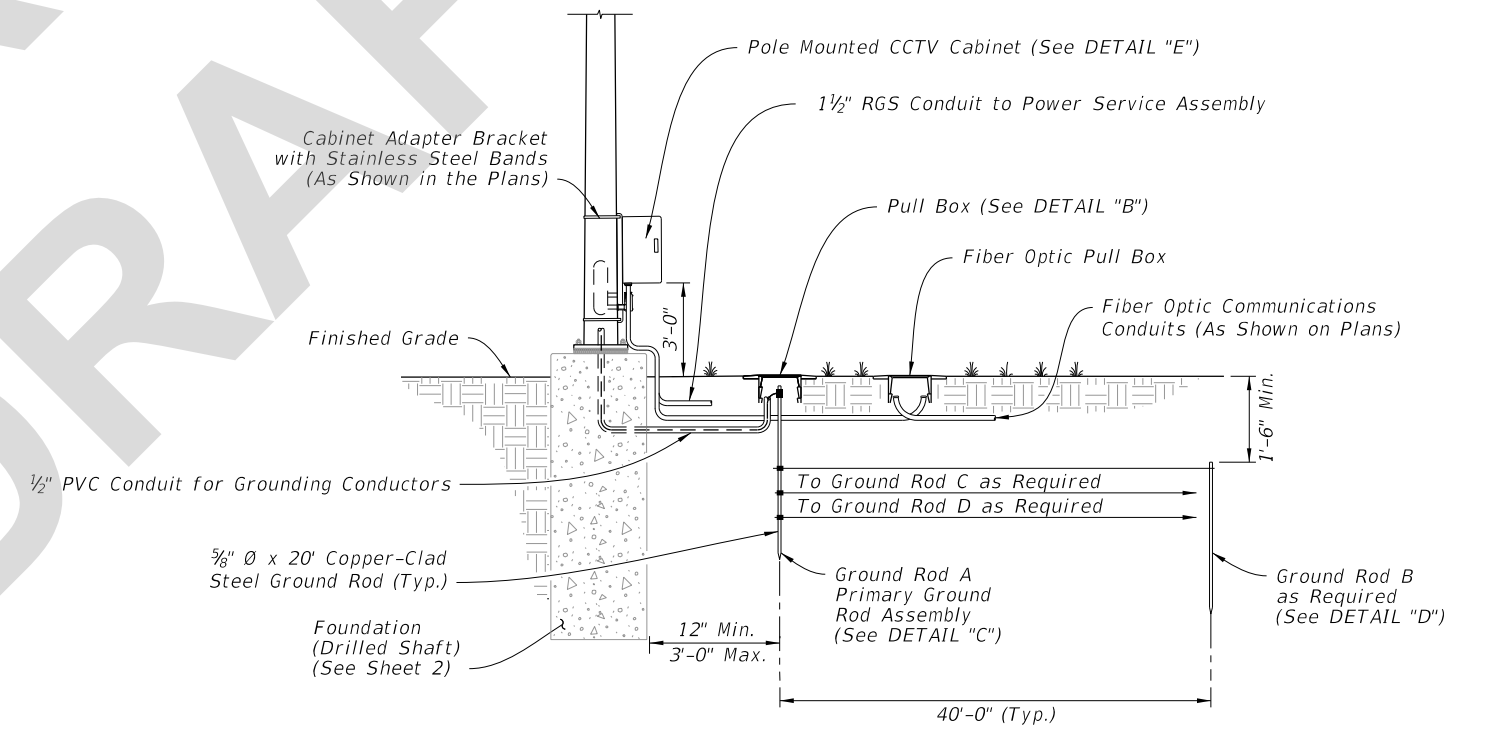

POLE MOUNTED CABINET

STEEL CCTV POLE GROUNDING

5/3/2021 9:58:31 AM

LAST REVISION 11/01/21	REVISION	DESCRIPTION:	 FY 2022-23 STANDARD PLANS	STEEL CCTV POLE	INDEX 649-020	SHEET 6 of 6
---------------------------	----------	--------------	--	------------------------	------------------	-----------------