# ORIGINATION FORM •

Proposed Revisions to a Standard Plans Index

(Please provide all information — Incomplete forms will be returned)

#### **Contact Information:**

Date: November 23, 2020

Originator: Joshua Turley

Phone: 414-5332

Email: Joshua.Turley@dot.state.fl.us

## Summary of the changes:

Sheet 1: Note 4I added optional other materials. Sheet 2: Added Note 4.

Sheet 3 & 4: Added bolt as option for splice connection.

Sheet 6: Clarified that a domed shape top cap is permissible.

# **Standard Plans:**

Index Number: 649-031 Sheet Number (s): 1, 2, 3, 4, and 6 of 6 Index Title: Mast Arm Assemblies


## Commentary / Background:

Changes are added because of repeated shop drawing comments that need to be approved everytime. Purpose is to prevent shop drawings from being rejected due to these changes, and to reduce the number of shop drawings related to the items clarified.


### Other Affected Offices / Documents: (Provide name of person contacted)


Yes		Other Standard Plans – FDOT Design Manual – Basis of Estimates Manual – Standard Specifications – Approved Product List – Construction –	
	$\checkmark$	Maintenance –	
		nn Package Includes: nd deliver package to Rick Jenkins) Redline Mark-ups Proposed Standard Plan Instruction (SPI) Revised SPI Other Support Documents	Implementation:✓ Design Bulletin (Interim)□ DCE Memo□ Program Mgmt. Bulletin□ FY-Standard Plans (Next Release)

Contact the Roadway Design Office for assistance in completing this form -

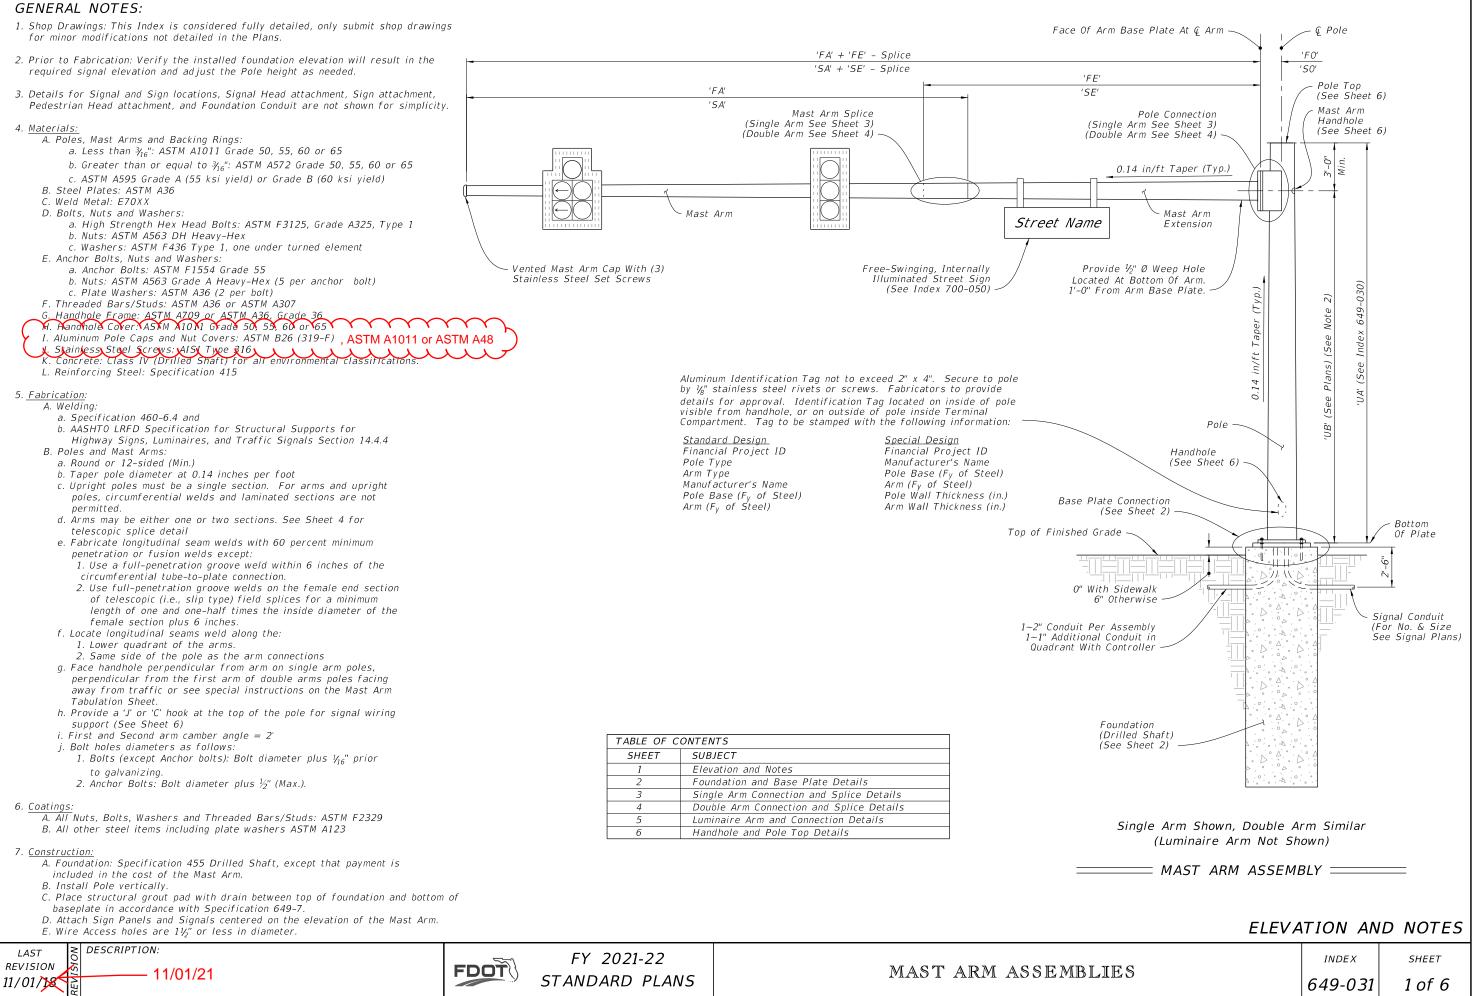





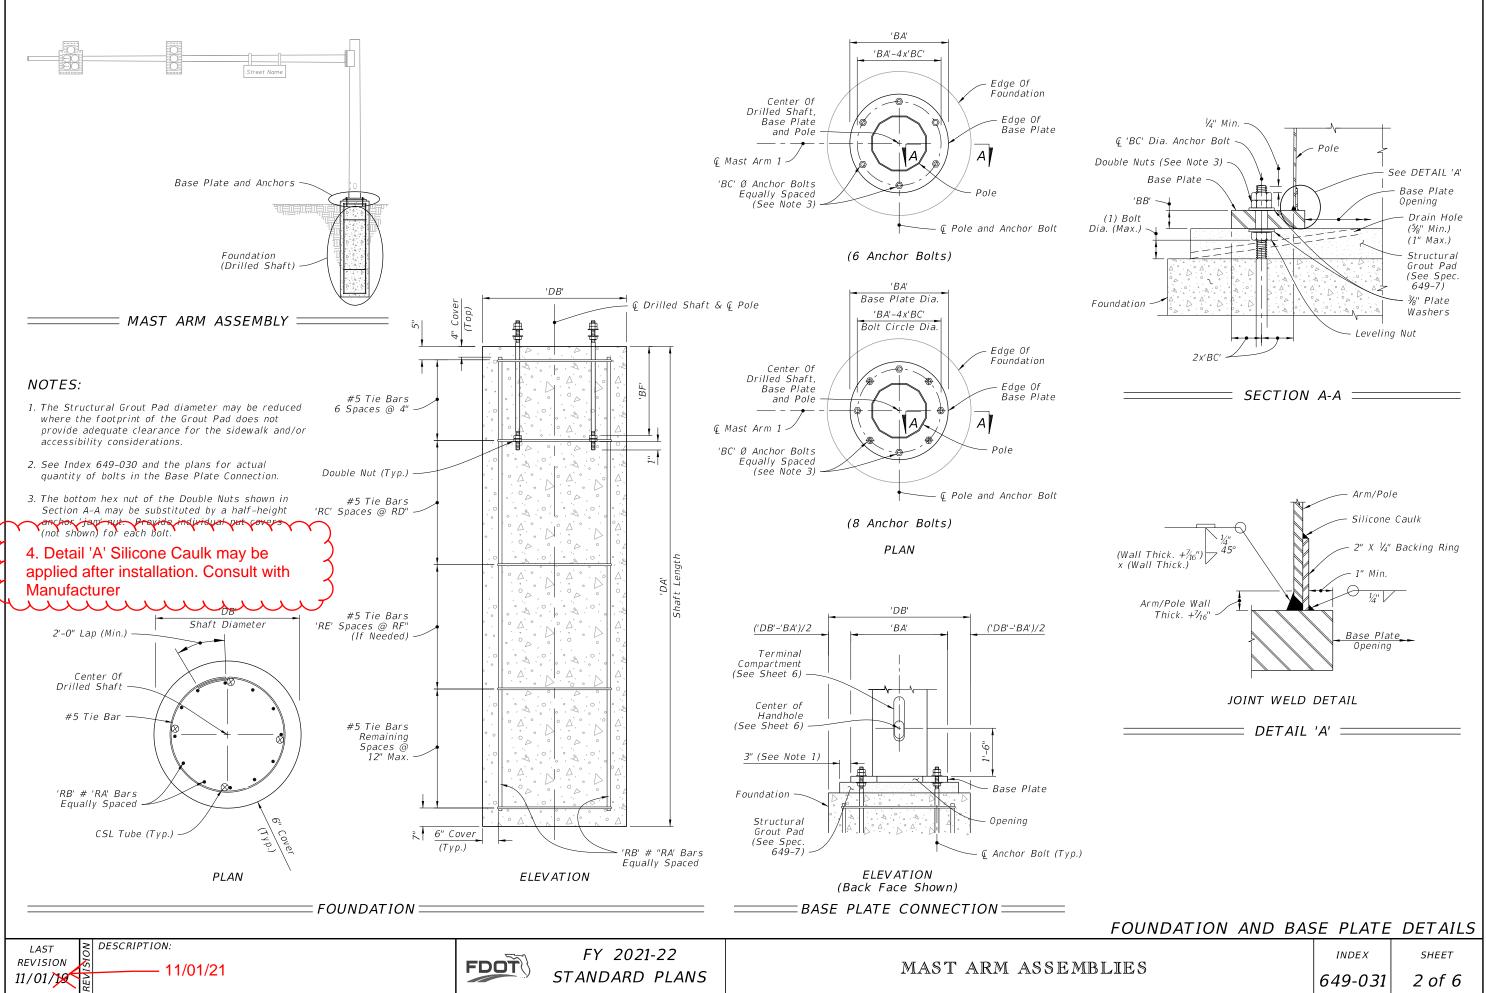


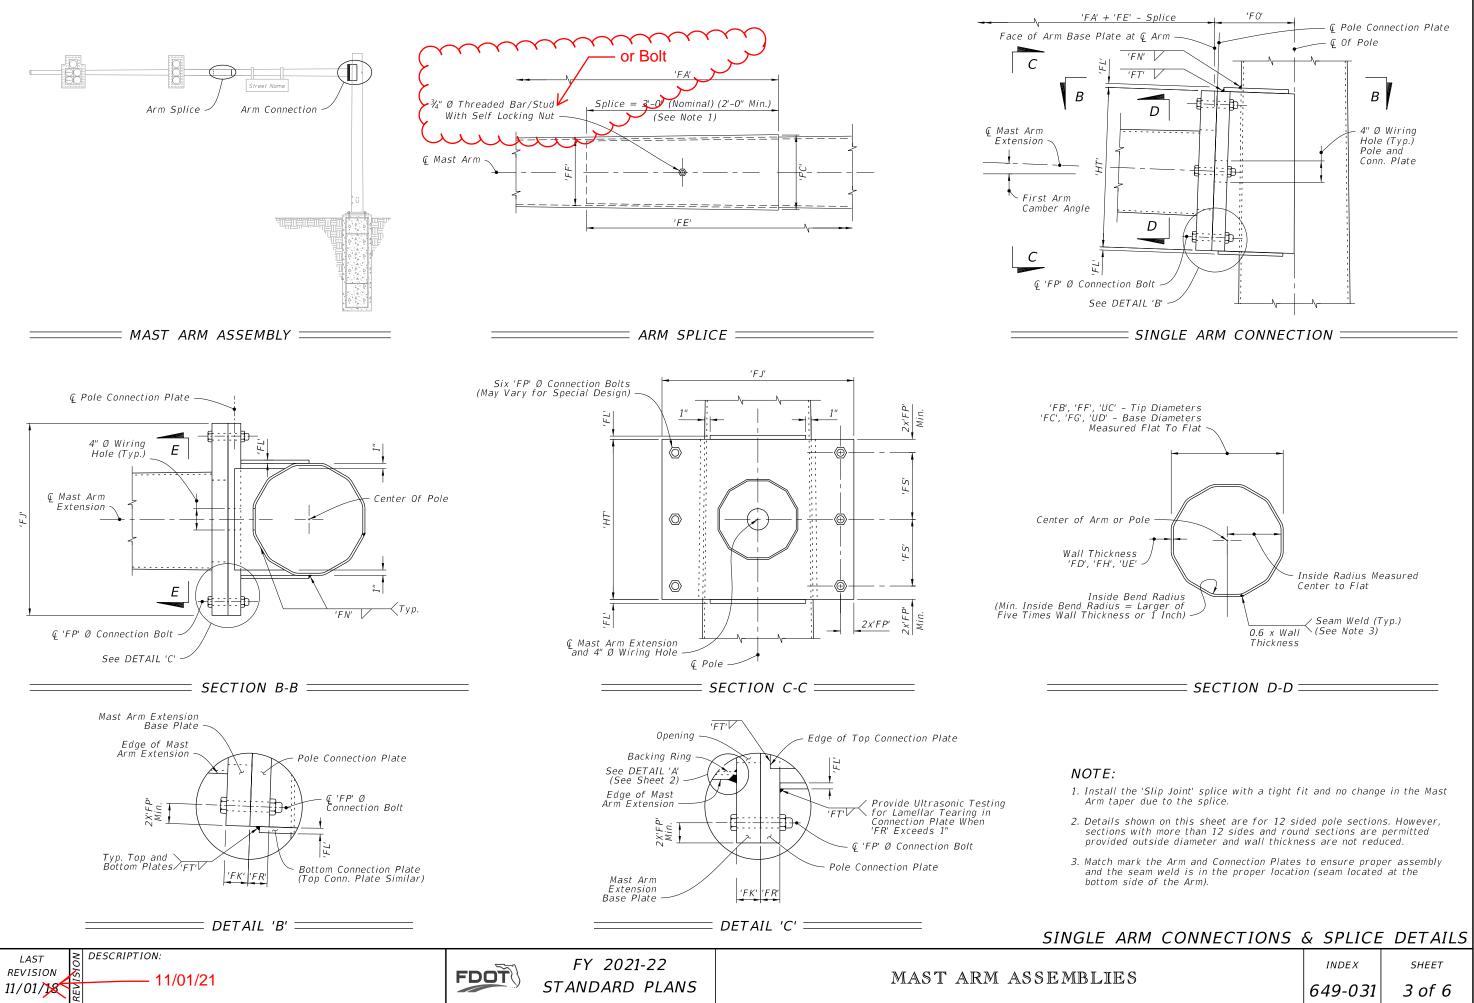



M CONNECTIONS	& SPLICE	DETAILS
	INDEX	SHEET
	649-031	3 of 6

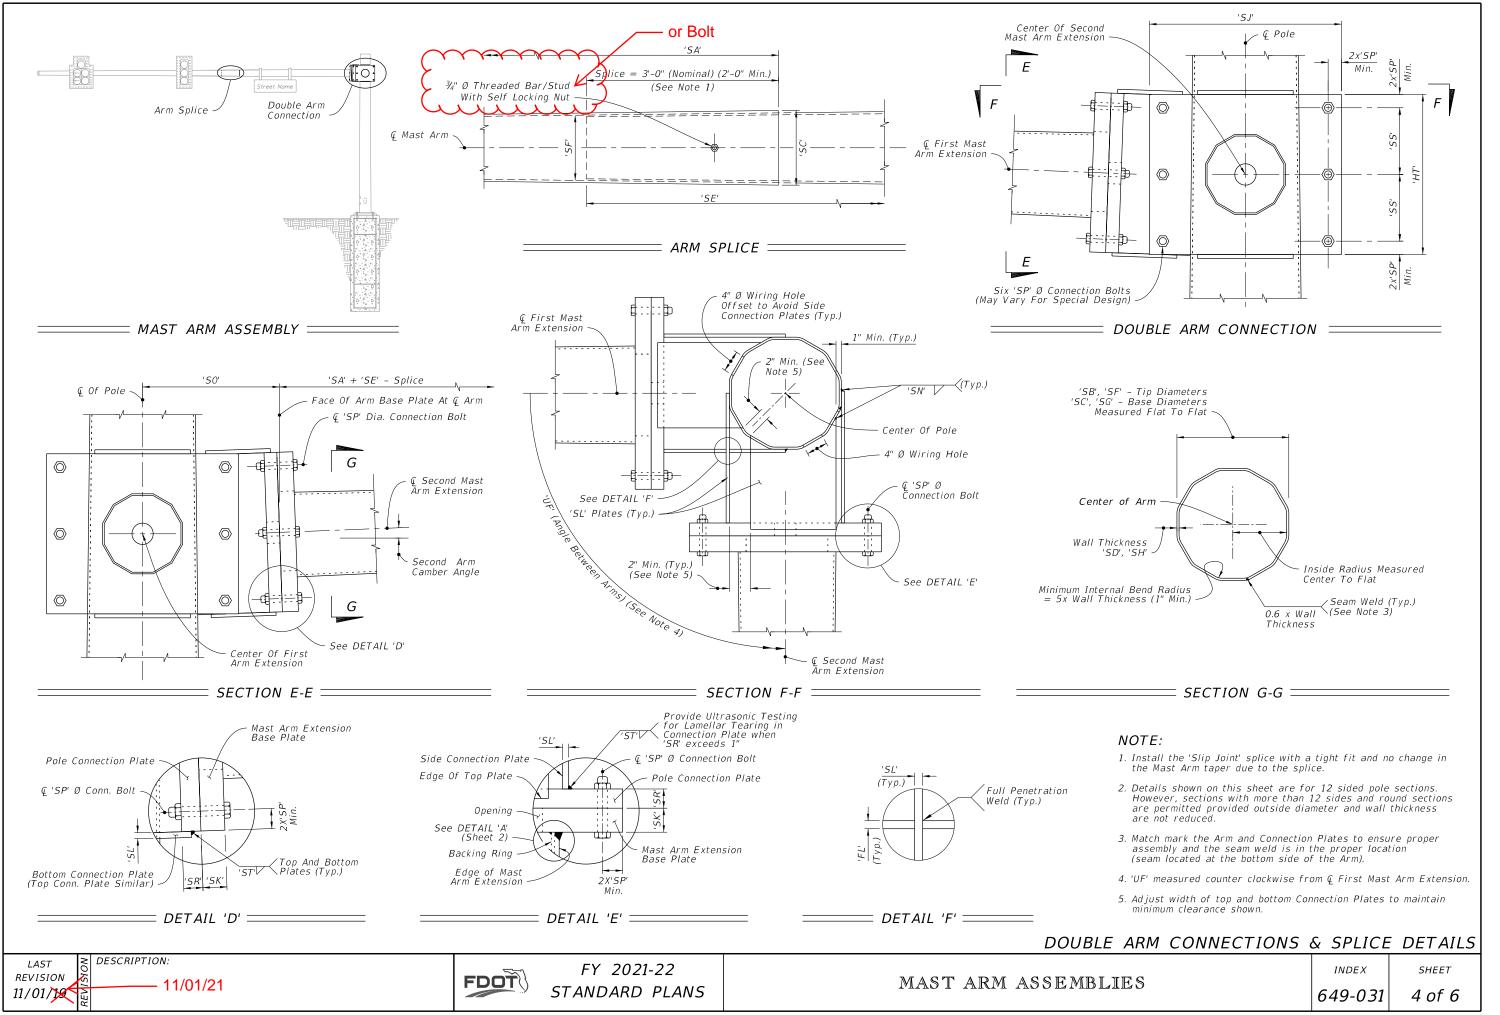

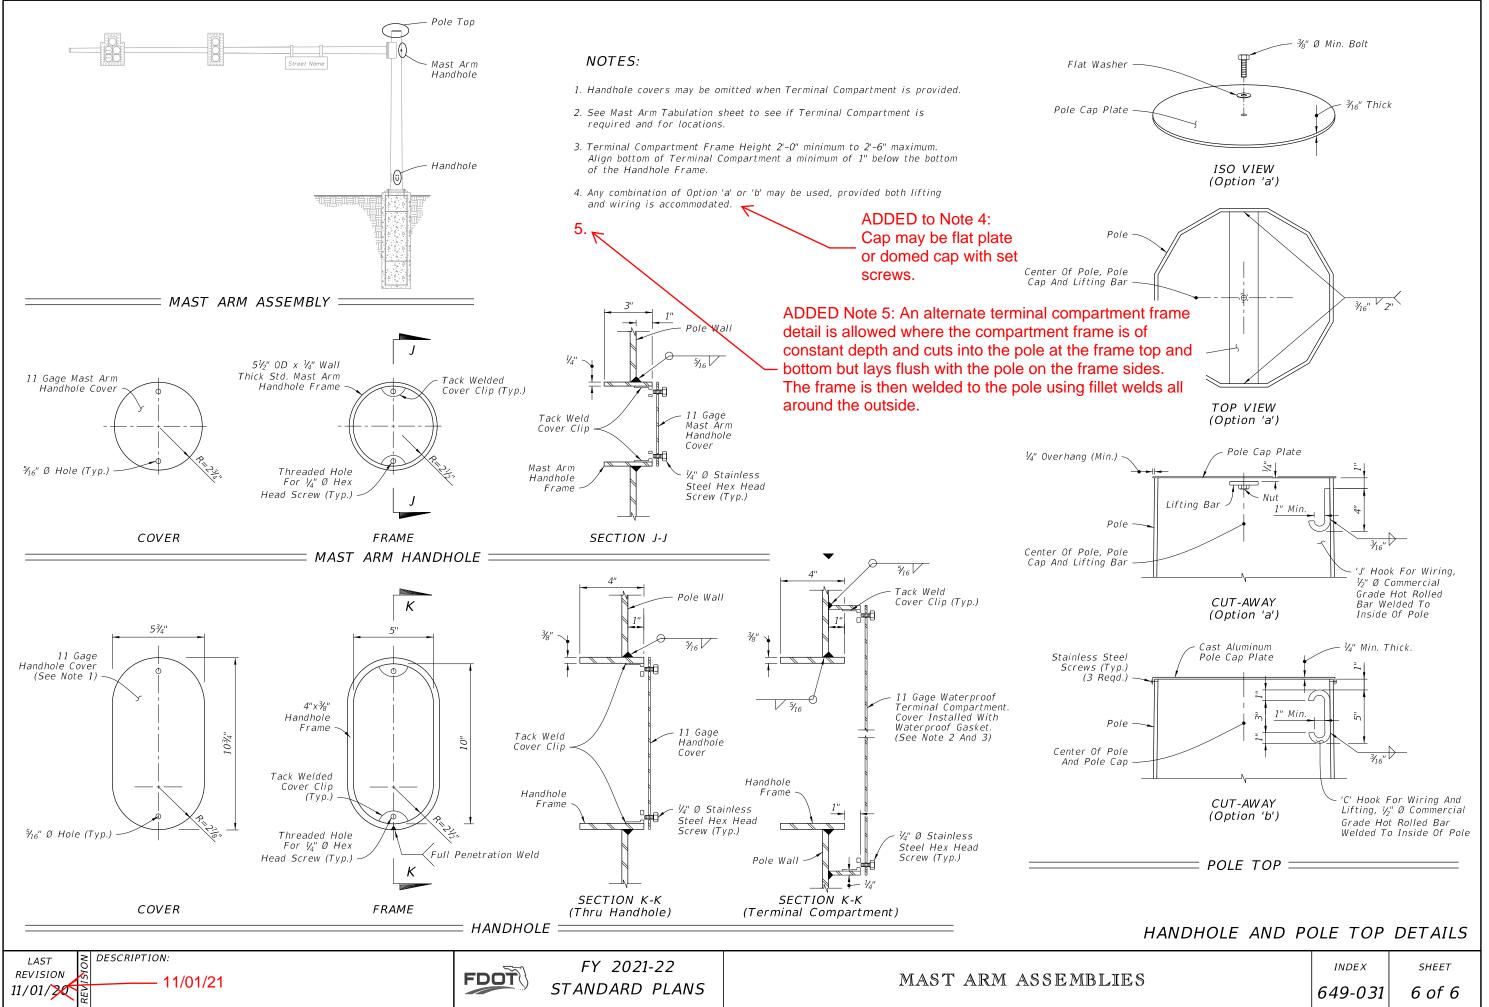

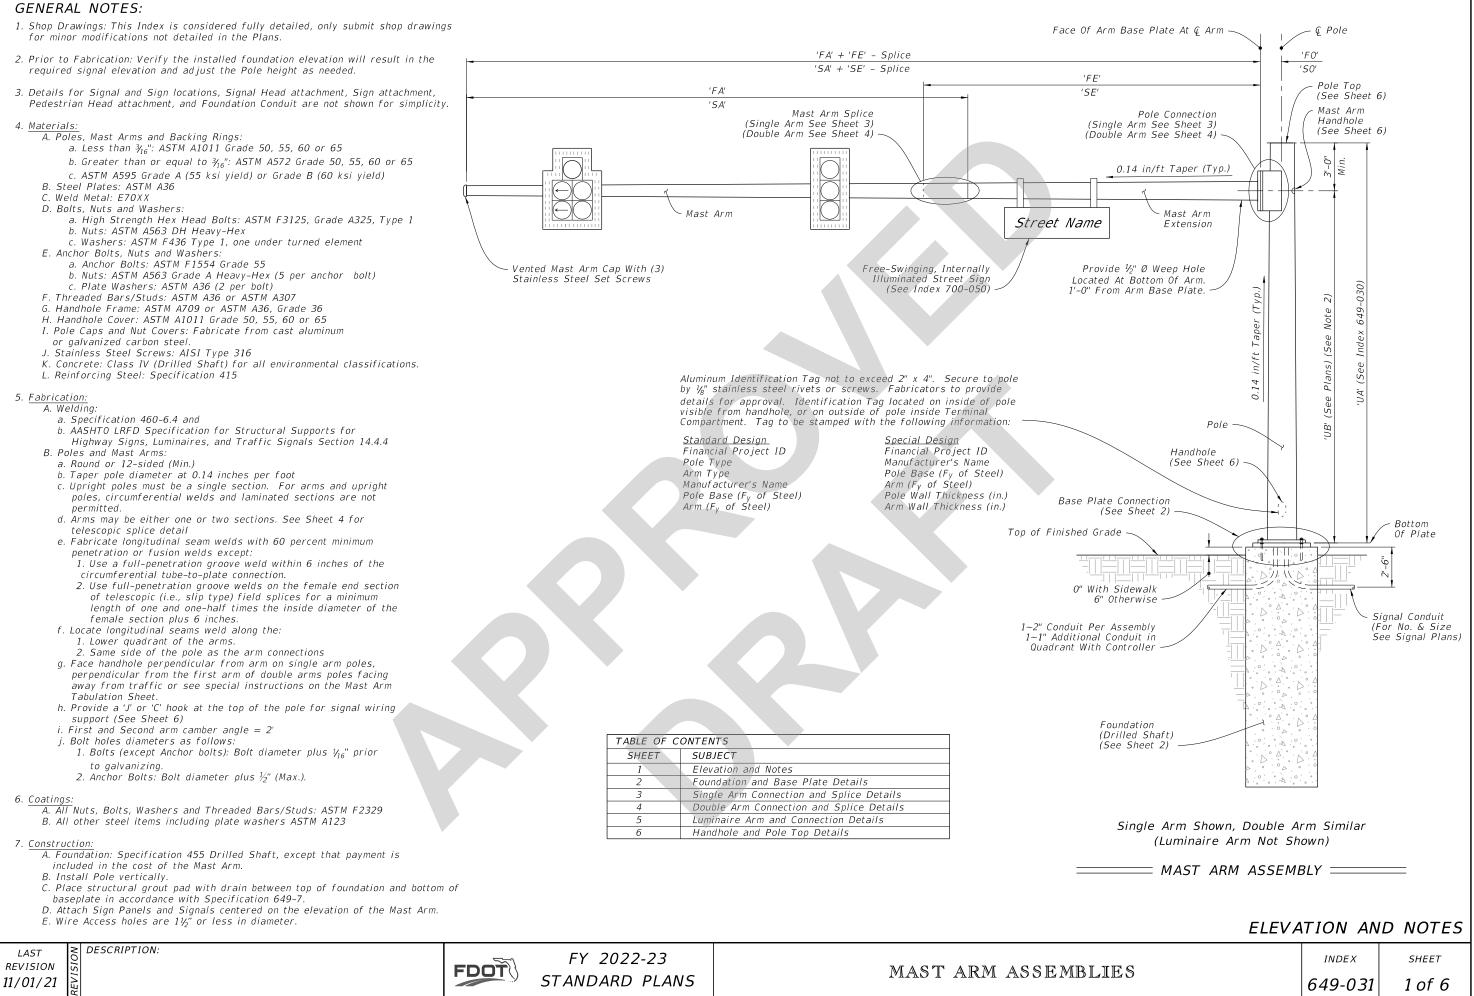

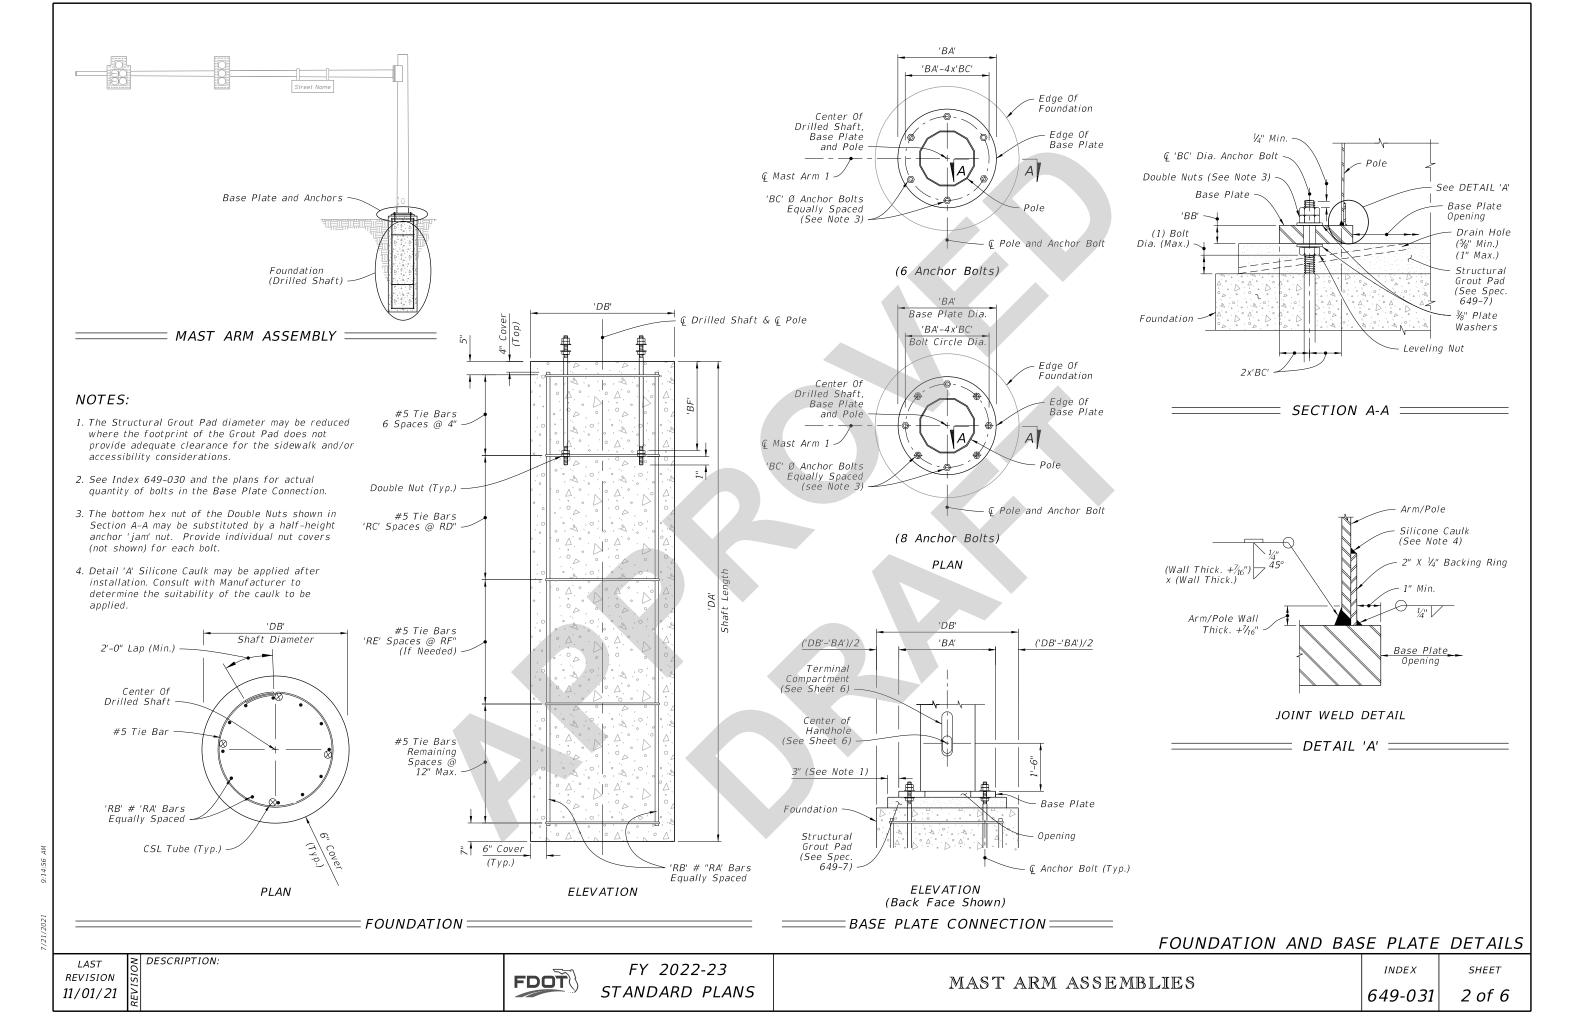

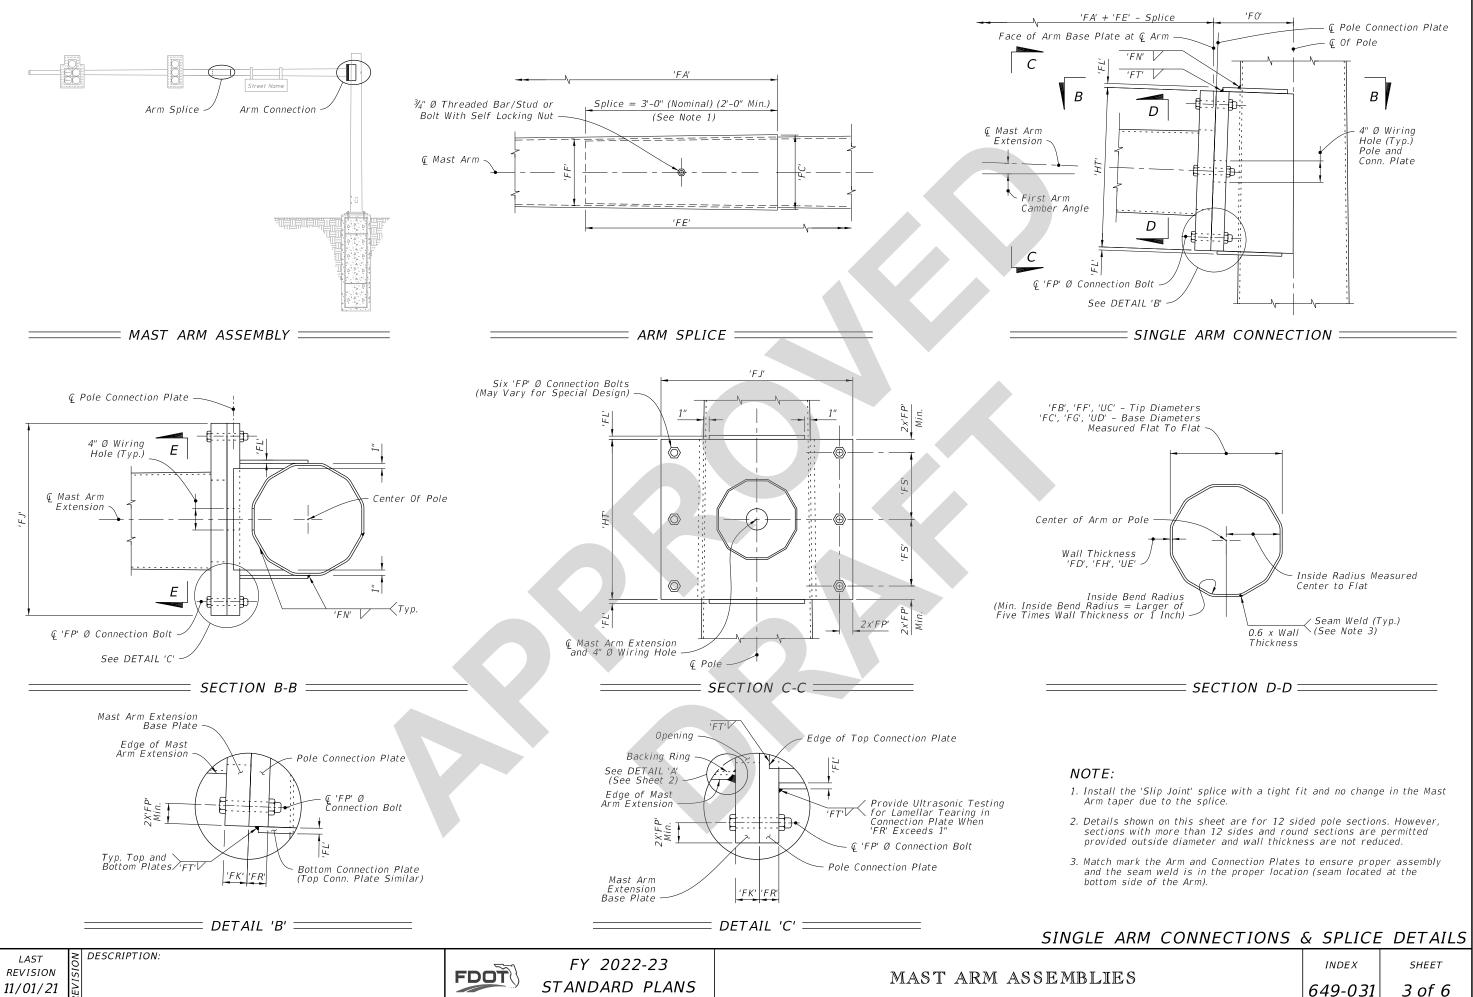

M CONNECTIONS	& SPLICE	DETAILS
	INDEX	SHEET
	649-031	3 of 6

