

---

## ORIGINATION FORM

---

Proposed Revisions to a Standard Plans Index  
(Please provide all information — Incomplete forms will be returned)

**Contact Information:**

Date: April 7, 2021  
Originator: Rick Jenkins  
Phone: (850) 414-4355  
Email: rick.jenkins@dot.state.fl.us

**Standard Plans:**

Index Number: 700-101  
Sheet Number (s): 1 of 1  
Index Title: Typical Sections for Placement of Single and Multi-Column Signs



**Summary of the changes:**

Added offset from median or Island nose to Case VIII Detail.

**Commentary / Background:**

Request came from District 4 to standardize the 6' offset from median nose, which they have tried to implement as a D4 practice.

**Other Affected Offices / Documents:** (Provide name of person contacted)

- | Yes                      | No                                  |                             |
|--------------------------|-------------------------------------|-----------------------------|
| <input type="checkbox"/> | <input checked="" type="checkbox"/> | Other Standard Plans –      |
| <input type="checkbox"/> | <input type="checkbox"/>            | FDOT Design Manual –        |
| <input type="checkbox"/> | <input type="checkbox"/>            | Basis of Estimates Manual – |
| <input type="checkbox"/> | <input type="checkbox"/>            | Standard Specifications –   |
| <input type="checkbox"/> | <input type="checkbox"/>            | Approved Product List –     |
| <input type="checkbox"/> | <input type="checkbox"/>            | Construction –              |
| <input type="checkbox"/> | <input type="checkbox"/>            | Maintenance –               |

**Origination Package Includes:**

(Email or hand deliver package to Rick Jenkins)

- | Yes                                 | N/A                      |  |
|-------------------------------------|--------------------------|--|
| <input checked="" type="checkbox"/> | <input type="checkbox"/> | Redline Mark-ups                         |
| <input type="checkbox"/>            | <input type="checkbox"/> | Proposed Standard Plan Instruction (SPI) |
| <input type="checkbox"/>            | <input type="checkbox"/> | Revised SPI                              |
| <input type="checkbox"/>            | <input type="checkbox"/> | Other Support Documents                  |


**Implementation:**

- Design Bulletin (Interim)
- DCE Memo
- Program Mgmt. Bulletin
- FY-Standard Plans (Next Release)

---

Contact the Roadway Design Office for assistance in completing this form


---

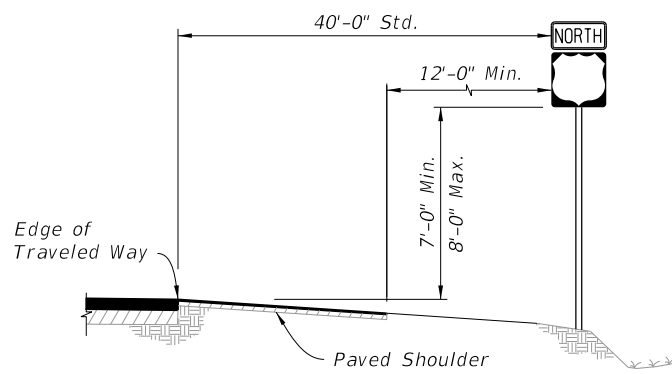

**NOTE:**  
If median width does not allow standard offset from both roadway, center sign in median.


**CASE I**

Use on Limited Access Roadways

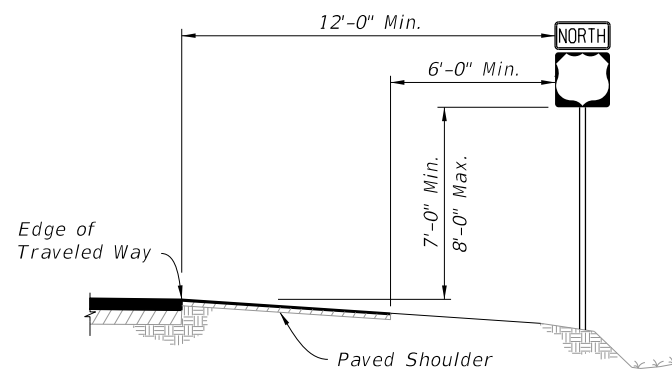

**CASE II**

Use on Arterial and Collector Roadways, and Limited Access Ramps

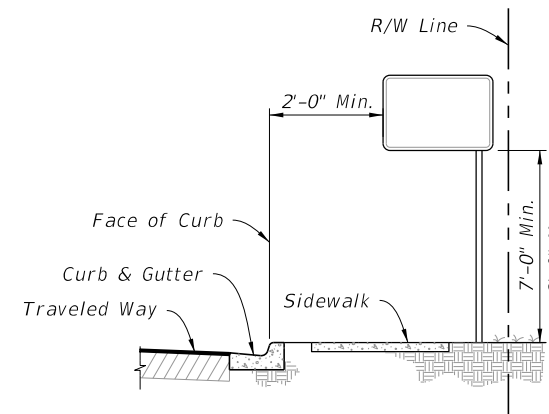


**CASE III**

Use on Arterial and Collector Roadways

**GENERAL NOTES:**

1. Single-Column Signs Shown, Multi-Column Signs similar. These typical sections serve as a guide for locating the traffic signs required under various roadside conditions. For size and details of sign construction and footing, refer to the appropriate Index and Plans.
2. Verify the length of sign supports in the field prior to fabrication.
3. Install ground signs at an angle of 1 to 4 degrees away from the traffic flow (see illustration). Install shoulder mounted signs rotated counterclockwise and median mounted signs rotated clockwise. Install signs on a curve as noted above from the perpendicular to the motorist line of sight.

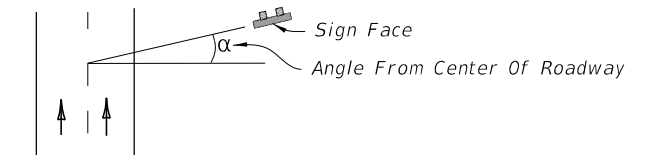

4. The setback for Stop and Yield signs may be reduced to 3' minimum from the Edge of Traveled Way if required for visibility in business or residential sections with no curb and speeds of 30 MPH or less.

5. The mounting heights are measured from the bottom of the sign panel to a horizontal line extended from the Edge of Traveled Way or from the ground surface at the back of curb. If the standard heights cannot be met, the minimum heights are as follows:

Limited Access Roadways - 7'

Arterial and Collector Roadways:

- 5' - Rural
- 7' - Urban (including residential with parking and/or pedestrian activity)

Limited Access Roadways:

If a secondary sign is mounted below the major sign, mount the major sign so that the bottom of the sign is at least 8' above the edge of the traveled way and the secondary sign at least 5' above the edge of the traveled way.


Arterial and Collector Roadways:

- Rural, mount the secondary sign at least 5' above the edge of the traveled way.
- Urban, mount the secondary sign at least 7' above the edge of the traveled way.

6. Do not install sign supports in the bottom of ditches.


7. Install sign supports so they do not reduce the accessible width of Sidewalks or Shared Use Paths to less than 4' min. clear width.

8. CASE X sign placement is for Interstate Exit Ramps only. Use CASE I through Case VIII as appropriate for all other Wrong Way signs.

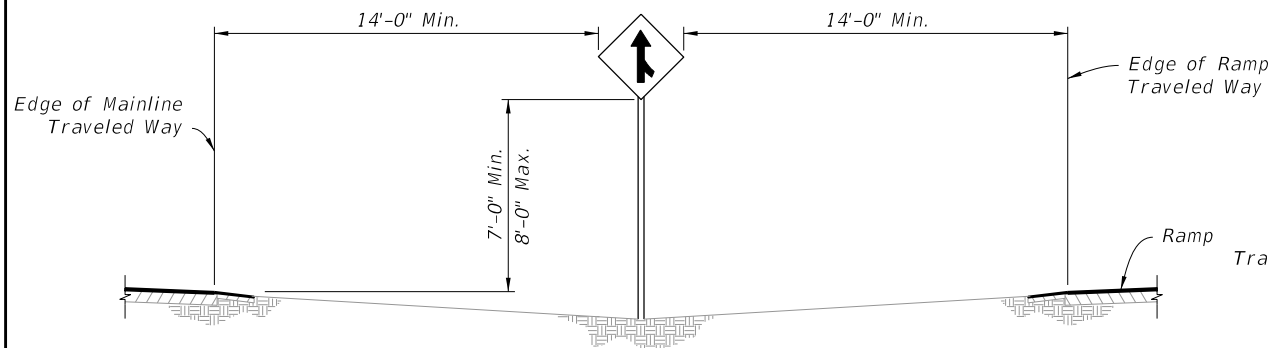


**CASE IV**

Use on Limited Access Roadways

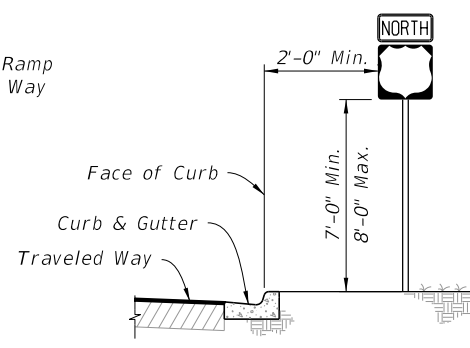


**CASE V**

Use in Business or Residential Areas Only

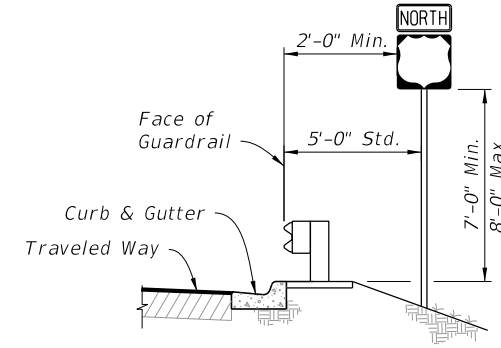


**CASE VI**

Use on Roadways With Signs Behind Guardrail

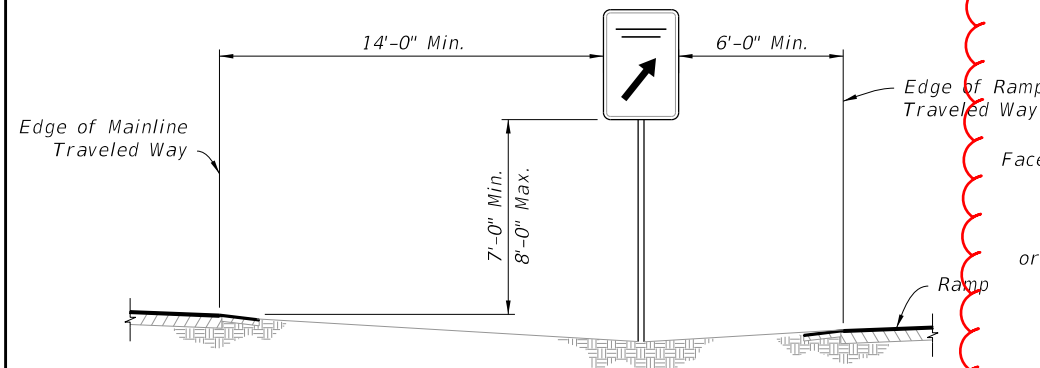


**CASE VII**

REST AREA AND EXIT GORE SIGNS  
Use on Limited Access Roadways

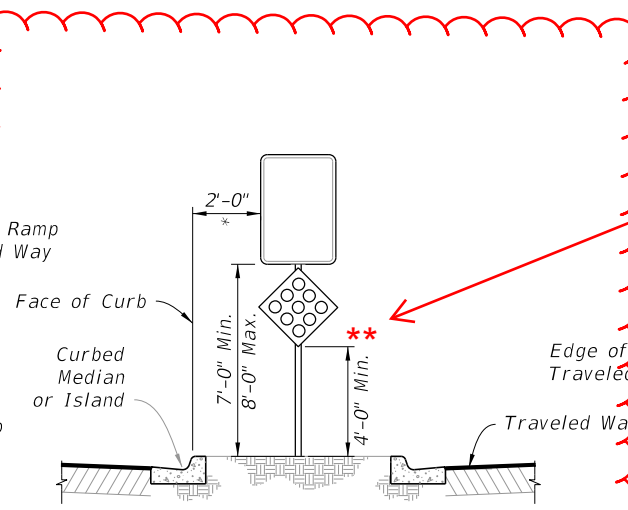

**CASE VIII**


Use on Island or Curbed Median

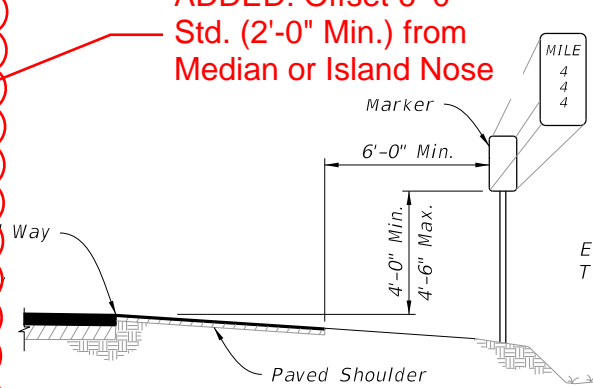

**NOTE:**  
For more information refer to Section 2H of the MUTCD.

**CASE IX**

MILE POST MARKER  
Use on Limited Access Roadways

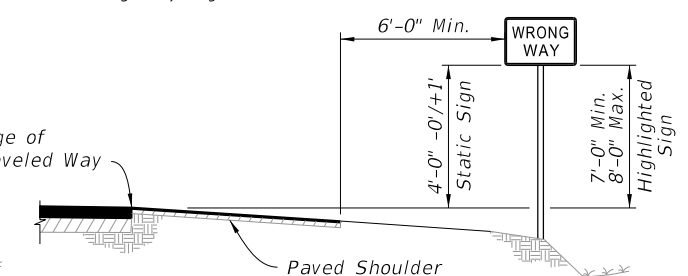

**CASE X**


WRONG WAY SIGNS  
(See Note 8)

\* For separators <6'-0", center the sign within the separator, center sign column on island  
\*\* Added note

**ADDED: Offset 6'-0" Std. (2'-0" Min.) from Median or Island Nose**

11/20/2020 10:05:29 AM


LAST REVISION	DESCRIPTION:
11/01/19	11/01/21

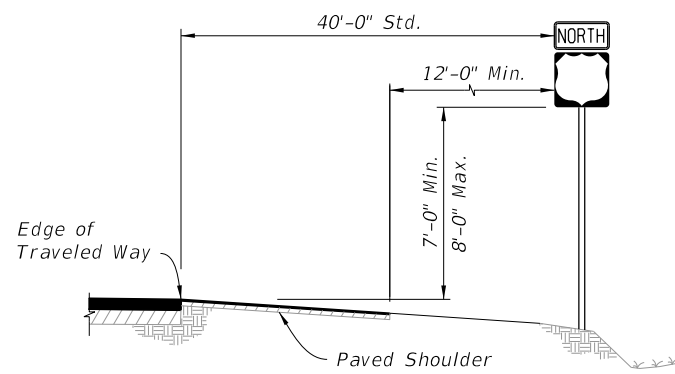

**NOTE:**  
If median width does not allow standard offset from both roadway, center sign in median.


**CASE I**

Use on Limited Access Roadways

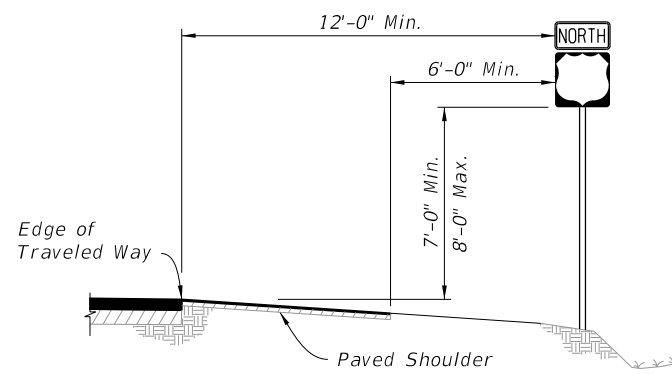


**CASE II**

Use on Arterial and Collector Roadways, and Limited Access Ramps

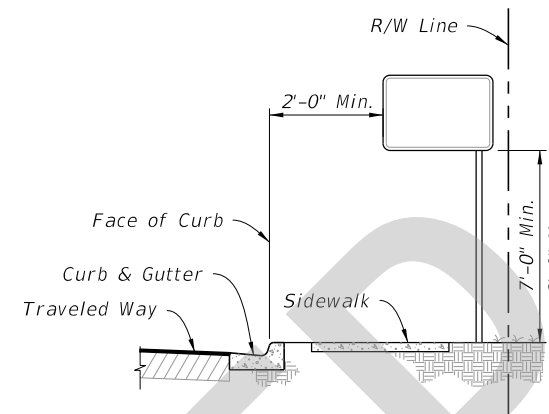


**CASE III**

Use on Arterial and Collector Roadways

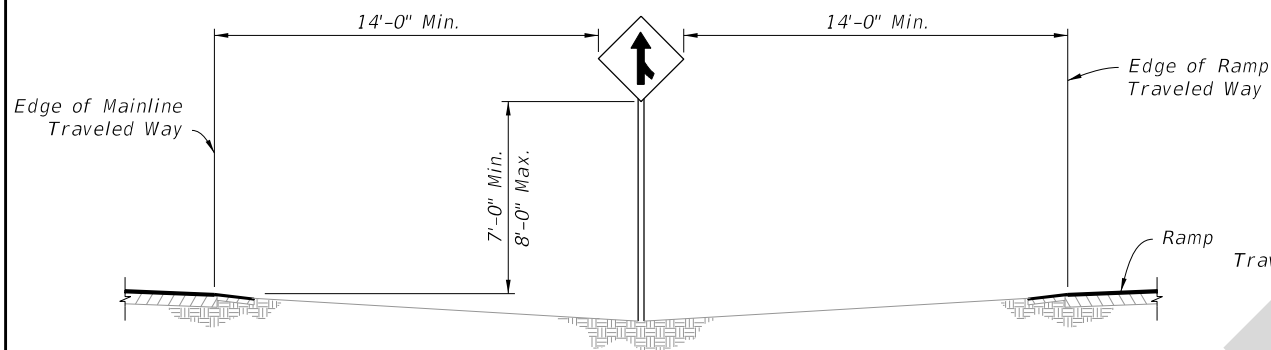


**CASE IV**

Use on Limited Access Roadways

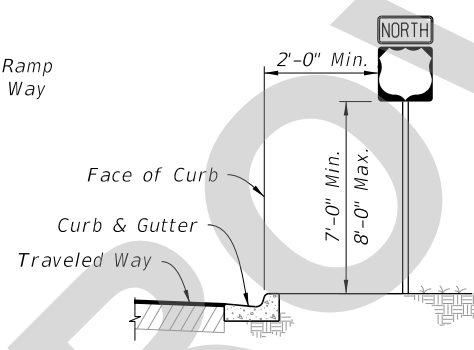


**CASE V**

Use in Business or Residential Areas Only

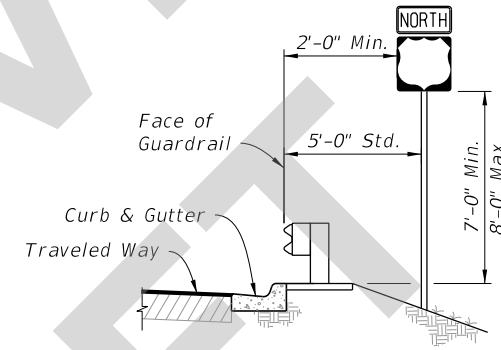


**CASE VI**

Use on Roadways With Signs Behind Guardrail

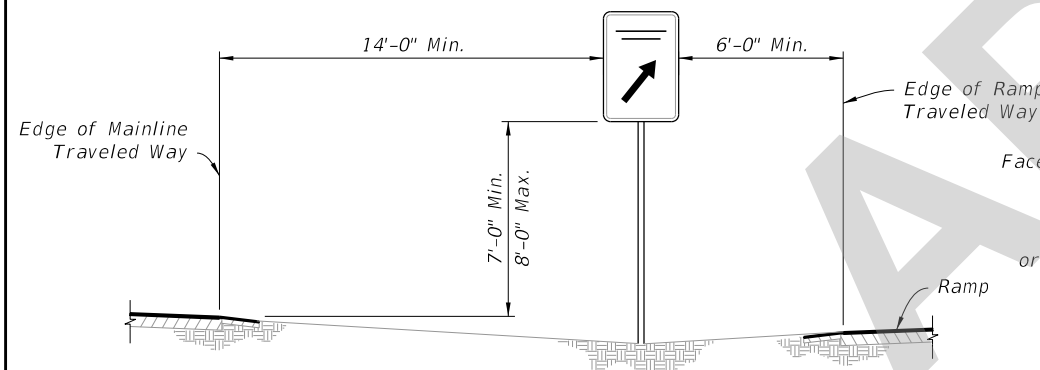


**CASE VII**

REST AREA AND EXIT GORE SIGNS  
Use on Limited Access Roadways

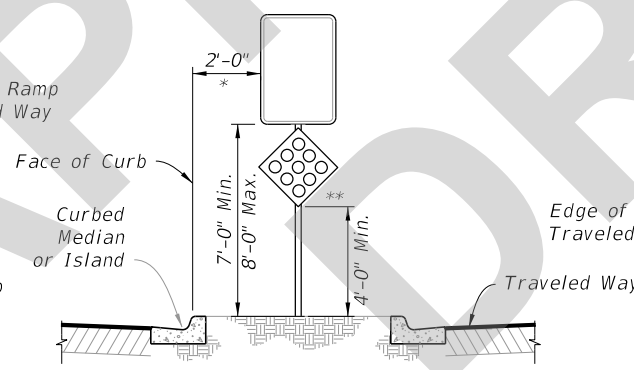

**CASE VIII**


Use on Island or Curbed Median

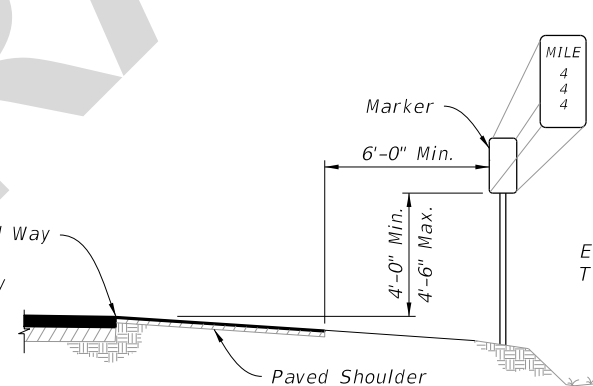

**NOTE:**  
For more information refer to Section 2H of the MUTCD.

**CASE IX**

MILE POST MARKER  
Use on Limited Access Roadways

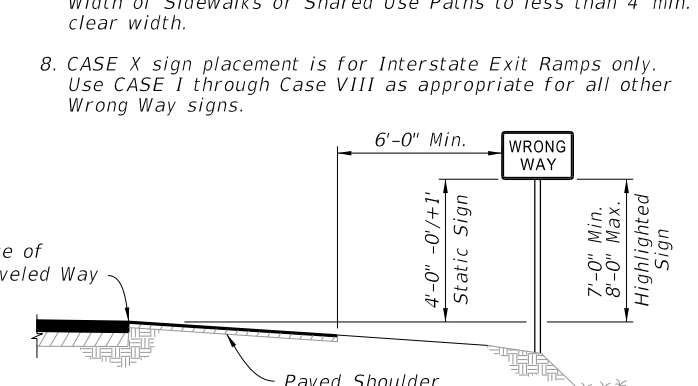


**CASE X**

WRONG WAY SIGNS  
(See Note 8)

**GENERAL NOTES:**

1. Single-Column Signs Shown, Multi-Column Signs similar. These typical sections serve as a guide for locating the traffic signs required under various roadside conditions. For size and details of sign construction and footing, refer to the appropriate Index and Plans.
2. Verify the length of sign supports in the field prior to fabrication.
3. Install ground signs at an angle of 1 to 4 degrees away from the traffic flow (see illustration). Install shoulder mounted signs rotated counterclockwise and median mounted signs rotated clockwise. Install signs on a curve as noted above from the perpendicular to the motorist line of sight.

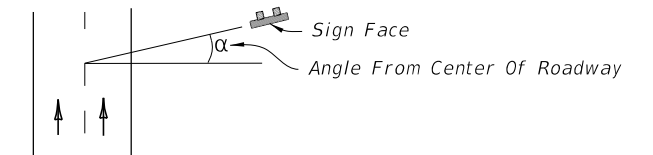

4. The setback for Stop and Yield signs may be reduced to 3' minimum from the Edge of Traveled Way if required for visibility in business or residential sections with no curb and speeds of 30 MPH or less.

5. The mounting heights are measured from the bottom of the sign panel to a horizontal line extended from the Edge of Traveled Way or from the ground surface at the back of curb. If the standard heights cannot be met, the minimum heights are as follows:

Limited Access Roadways - 7'

Arterial and Collector Roadways:

- 5' - Rural
- 7' - Urban (including residential with parking and/or pedestrian activity)

Limited Access Roadways:

If a secondary sign is mounted below the major sign, mount the major sign so that the bottom of the sign is at least 8' above the edge of the traveled way and the secondary sign at least 5' above the edge of the traveled way.

Arterial and Collector Roadways:

- Rural, mount the secondary sign at least 5' above the edge of the traveled way.
- Urban, mount the secondary sign at least 7' above the edge of the traveled way.

6. Do not install sign supports in the bottom of ditches.
7. Install sign supports so they do not reduce the accessible width of Sidewalks or Shared Use Paths to less than 4' min. clear width.
8. CASE X sign placement is for Interstate Exit Ramps only. Use CASE I through Case VIII as appropriate for all other Wrong Way signs.

4/13/2021 7:07:52 AM

LAST REVISION 11/01/21	REVISION	DESCRIPTION:		FY 2022-23 STANDARD PLANS	TYPICAL SECTIONS FOR PLACEMENT OF SINGLE AND MULTI-COLUMN SIGNS	INDEX 700-101	SHEET 1 of 1
---------------------------	----------	--------------	--	------------------------------	--	------------------	-----------------