
ORIGINATION FORM

Proposed Revisions to a Standard Plans Index
(Please provide all information — Incomplete forms will be returned)

Contact Information:

Date: June 16, 2021
Originator: Derwood Sheppard
Phone: (850) 414-4334
Email: Derwood.Sheppard@dot.state.fl.us

Standard Plans:

Index Number: 700-109
Sheet Number (s): 1 of 1
Index Title: Traffic Controls for Street Terminations

Summary of the changes:

Delete Index.

Commentary / Background:

Most of the information in this index was moved to FDM 230 with Roadway Design Bulletin 21-07. Specification 705 will be revised to state that object markers will be installed in accordance with Index 700-010.

Other Affected Offices / Documents: (Provide name of person contacted)

- | Yes | No | |
|-------------------------------------|-------------------------------------|-------------------------------|
| <input type="checkbox"/> | <input checked="" type="checkbox"/> | Other Standard Plans – |
| <input type="checkbox"/> | <input type="checkbox"/> | FDOT Design Manual – |
| <input type="checkbox"/> | <input type="checkbox"/> | Basis of Estimates Manual – |
| <input checked="" type="checkbox"/> | <input type="checkbox"/> | Standard Specifications – 705 |
| <input type="checkbox"/> | <input type="checkbox"/> | Approved Product List – |
| <input type="checkbox"/> | <input type="checkbox"/> | Construction – |
| <input type="checkbox"/> | <input type="checkbox"/> | Maintenance – |

Origination Package Includes:

(Email or hand deliver package to Rick Jenkins)


- | Yes | N/A | |
|-------------------------------------|--------------------------|------------------------------------------|
| <input checked="" type="checkbox"/> | <input type="checkbox"/> | Redline Mark-ups |
| <input type="checkbox"/> | <input type="checkbox"/> | Proposed Standard Plan Instruction (SPI) |
| <input type="checkbox"/> | <input type="checkbox"/> | Revised SPI |
| <input type="checkbox"/> | <input type="checkbox"/> | Other Support Documents |

Implementation:

- | | |
|-------------------------------------|----------------------------------|
| <input type="checkbox"/> | Design Bulletin (Interim) |
| <input type="checkbox"/> | DCE Memo |
| <input type="checkbox"/> | Program Mgmt. Bulletin |
| <input checked="" type="checkbox"/> | FY-Standard Plans (Next Release) |



Contact the Roadway Design Office for assistance in completing this form

Email to: Rick Jenkins rick.jenkins@dot.state.fl.us and Darren Martin darren.martin@dot.state.fl.us

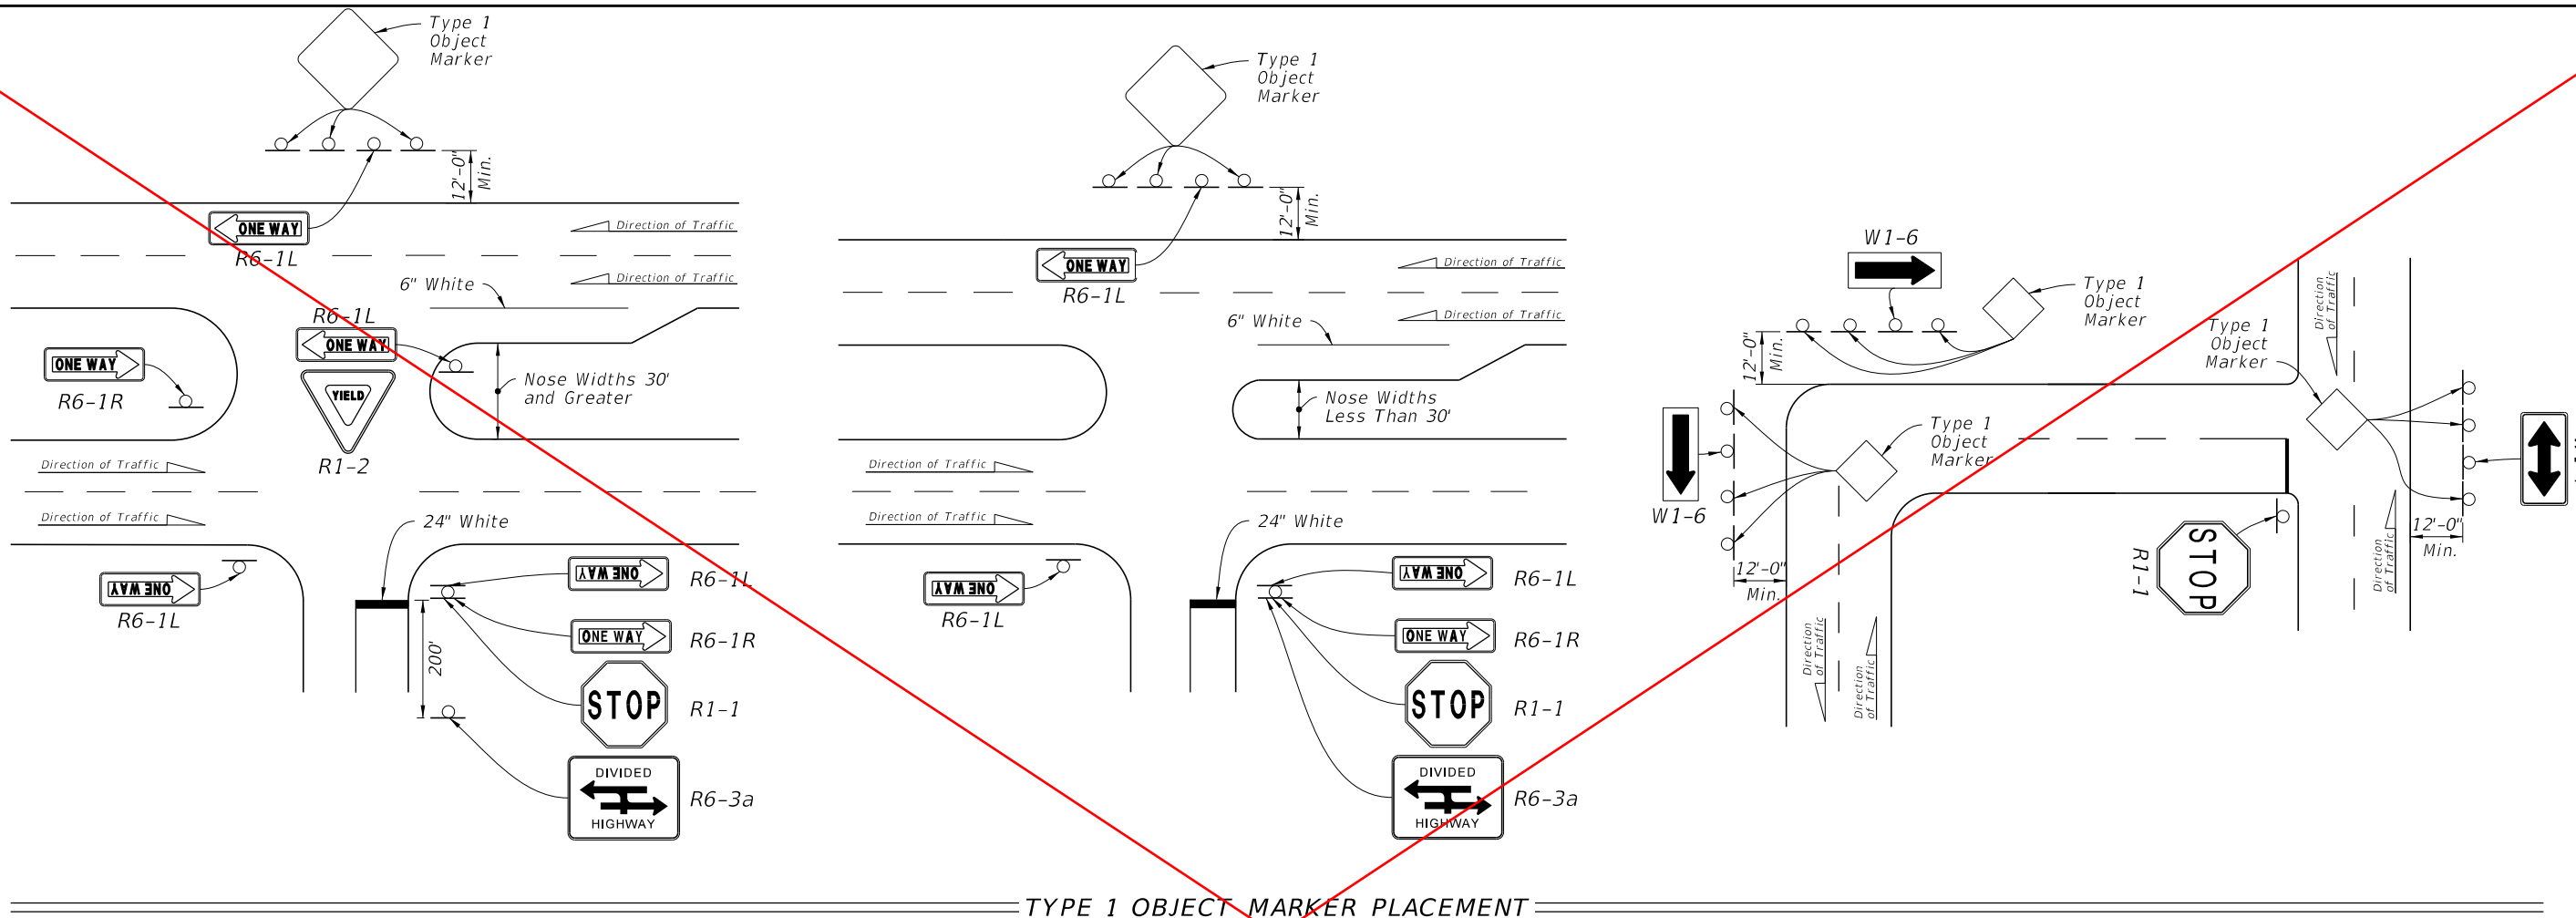

DELETED INDEX

- NOTES:**
1. Index applicable to residential and minor streets only. Major streets to be evaluated on a case-by-case basis.
 2. Install Object Markers in accordance with Index 700-010
 3. See Index 711-001 for pavement markings.
 4. Provide sheeting on signs and object markers in accordance with Specification 993.

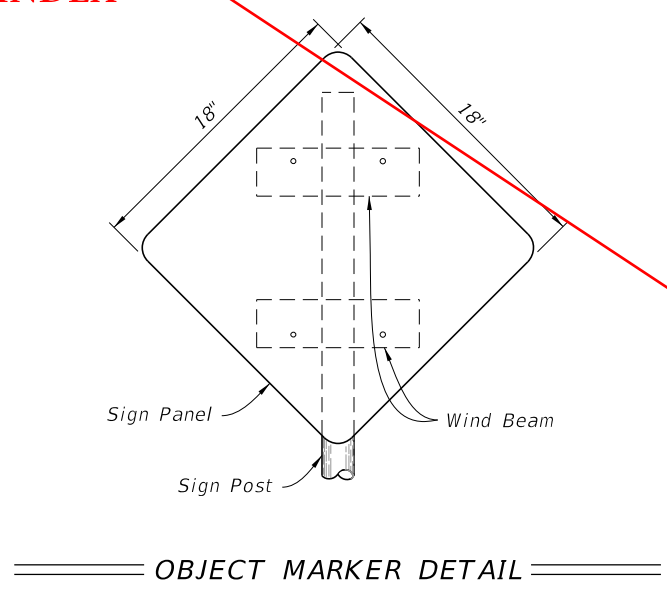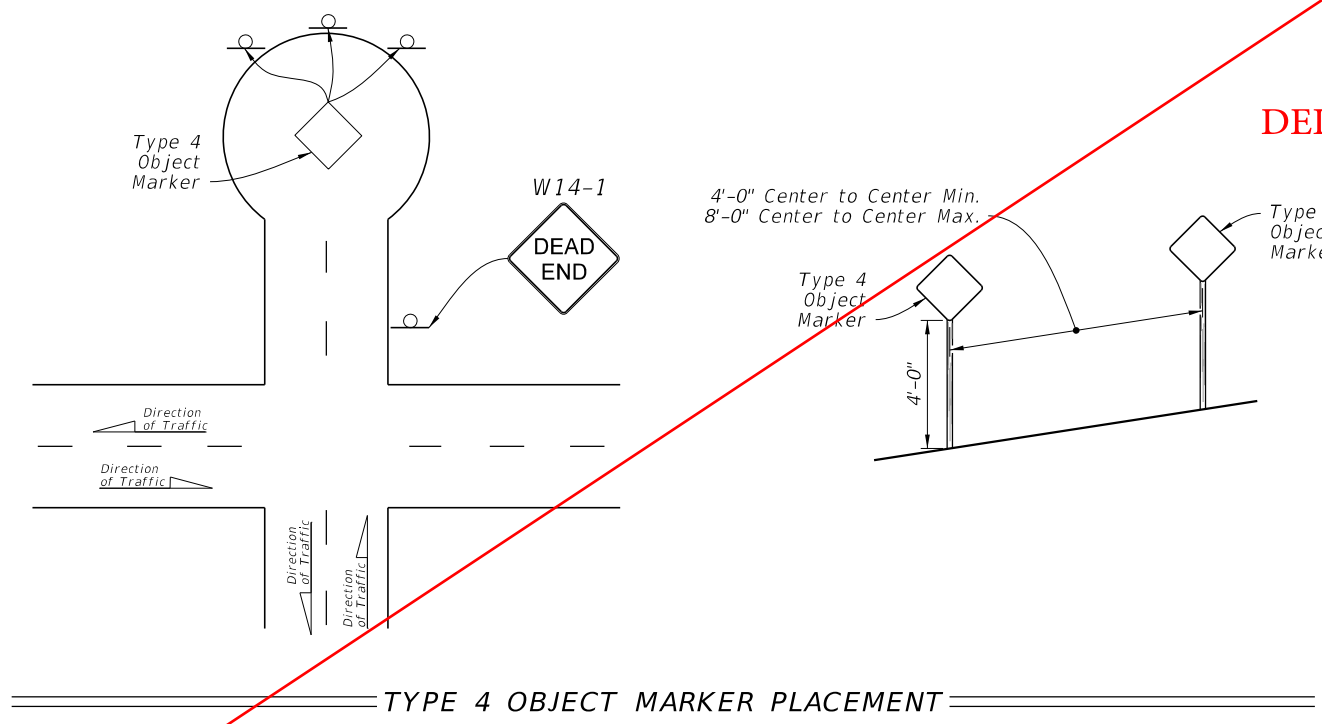

10/12/2020 9:08:02 AM

| | | | | | | |
|---------------------------|----------|--------------|------------------------------|------------------------------------------|------------------|-----------------|
| LAST REVISION 11/01/20 | REVISION | DESCRIPTION: | FY 2021-22 STANDARD PLANS | TRAFFIC CONTROLS FOR STREET TERMINATIONS | INDEX 700-109 | SHEET 1 of 1 |
|---------------------------|----------|--------------|------------------------------|------------------------------------------|------------------|-----------------|