

---

## ORIGINATION FORM

---

Proposed Revisions to a Standard Plans Index  
(Please provide all information — Incomplete forms will be returned)

**Contact Information:**

Date: May 14, 2021  
Originator: Derwood Sheppard  
Phone: (850) 414-4334  
Email: [derwood.sheppard@dot.state.fl.us](mailto:derwood.sheppard@dot.state.fl.us)

**Standard Plans:**

Index Number: 711-001  
Sheet Number (s): 1,8,9, and 11  
Index Title: Pavement Markings

**Summary of the changes:**

- All: Renumbered
- Sheet 1: Deleted Note 1 for Pavement Messages; Deleted Pavement Message Spacing Table; Deleted the General Notes.
- Sheet 2: Moved the MARKING FOR MERGE detail from Sheet 8.
- Sheet 8: Deleted Right Turn Lane Drop and Island Details and DETAIL "C" from Index. Moved to the FDM, Combined with Signing Details shown in 230-5; Deleted the Traffic Channelization At Gore detail Note; Moved the Instructions associated with the TWO WAY LEFT TURN LANE details to the SPI.
- Sheet 9: Deleted Schemes for Transition details and DETAIL "D" from Index. Moved to FDM, Combined with Signing Details shown in Exhibit 230-05; Changed Detail "E" to "Markings For Merge" and Deleted the NOTE; Moved Details to Sheet 2; Moved the "Markings For Traffic Separation" to Sheet 8; Deleted Sheet 9.
- Sheet 11: New Sheet 10: Revert back to FY 2018-19 Index and delete redundant information shown in FDM Exhibit 212-1.

**Commentary / Background:**

Changes are required to make the Index consistent with the FDM. Duplicate information will be deleted from the Index. Some information deleted from Index will be added to the FDM.

**Other Affected Offices / Documents:** (Provide name of person contacted)

- | Yes                      | No                                  |                             |
|--------------------------|-------------------------------------|-----------------------------|
| <input type="checkbox"/> | <input checked="" type="checkbox"/> | Other Standard Plans –      |
| <input type="checkbox"/> | <input type="checkbox"/>            | FDOT Design Manual –        |
| <input type="checkbox"/> | <input type="checkbox"/>            | Basis of Estimates Manual – |
| <input type="checkbox"/> | <input type="checkbox"/>            | Standard Specifications –   |
| <input type="checkbox"/> | <input type="checkbox"/>            | Approved Product List –     |
| <input type="checkbox"/> | <input type="checkbox"/>            | Construction –              |
| <input type="checkbox"/> | <input type="checkbox"/>            | Maintenance –               |

**Origination Package Includes:**

(Email or hand deliver package to Rick Jenkins)

- | Yes                                 | N/A                      |  |
|-------------------------------------|--------------------------|--|
| <input checked="" type="checkbox"/> | <input type="checkbox"/> | Redline Mark-ups                         |
| <input type="checkbox"/>            | <input type="checkbox"/> | Proposed Standard Plan Instruction (SPI) |
| <input type="checkbox"/>            | <input type="checkbox"/> | Revised SPI                              |
| <input type="checkbox"/>            | <input type="checkbox"/> | Other Support Documents                  |

**Implementation:**


- Design Bulletin (Interim)
- DCE Memo
- Program Mgmt. Bulletin
- FY-Standard Plans (Next Release)

---


Contact the Roadway Design Office for assistance in completing this form

---


Email to: Rick Jenkins [rick.jenkins@dot.state.fl.us](mailto:rick.jenkins@dot.state.fl.us) and Darren Martin [darren.martin@dot.state.fl.us](mailto:darren.martin@dot.state.fl.us)

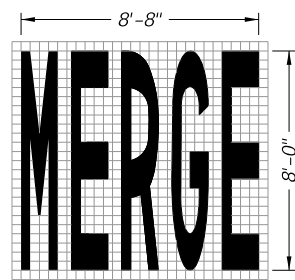


34 S.F.

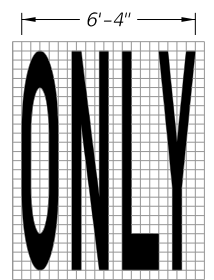


22 S.F.

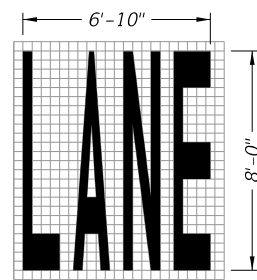


23 S.F.

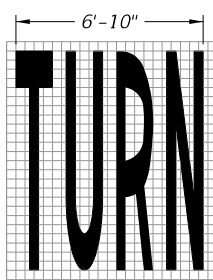


24 S.F.

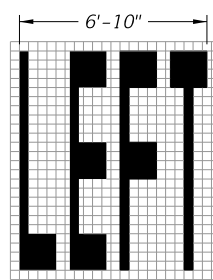

20 S.F.

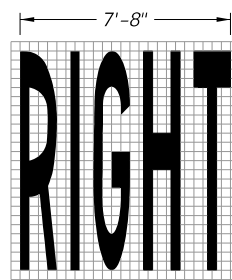


26 S.F.

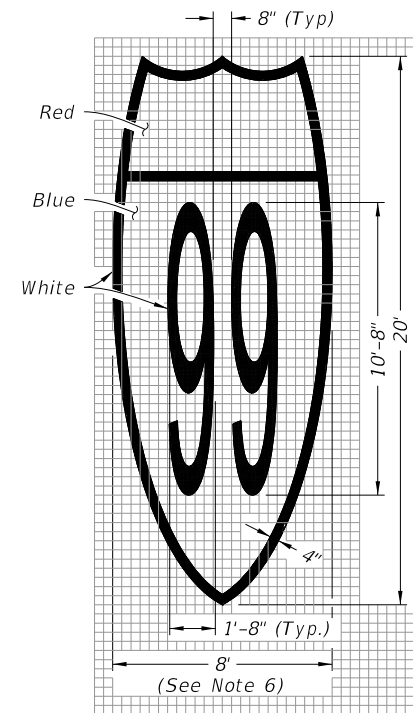


Route Shield for Limited Access Roadways (Interstate Route Shield Shown; U.S. and State Route Shield Similar)

128 S.F.

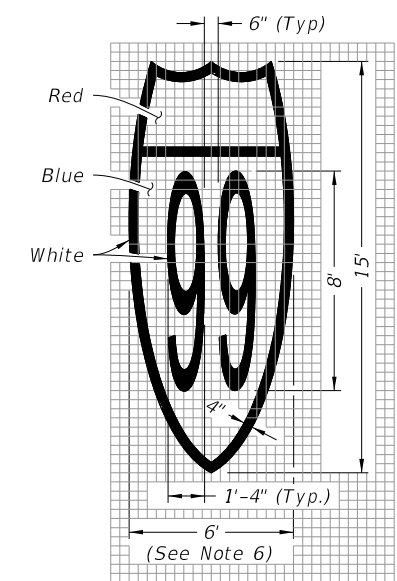


Route Shield for Arterials and Collectors (Interstate Route Shield Shown; U.S. and State Route Shield Similar)


72 S.F.

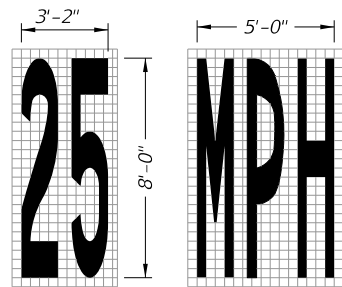


13 S.F.

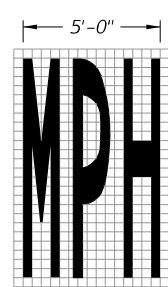


20 S.F.

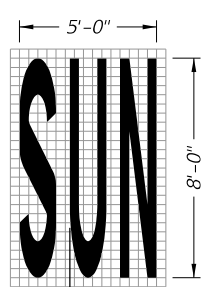


20 S.F.

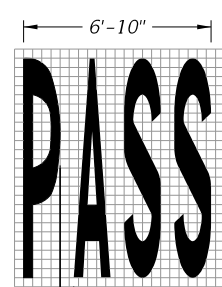


23 S.F.

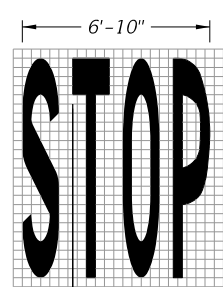


22 S.F.

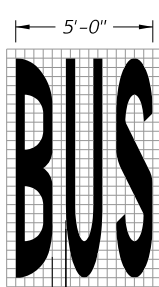


20 S.F.

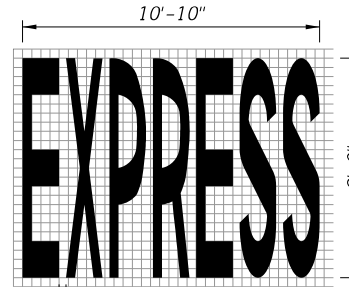


43 S.F.

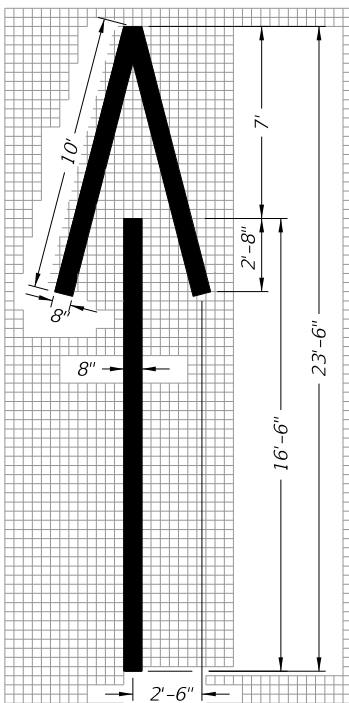


Wrong-Way Arrow 24 S.F.

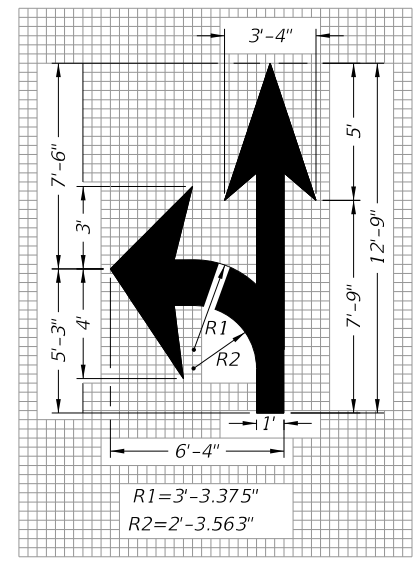


Turn and Through Lane-Use Arrow 29 S.F.

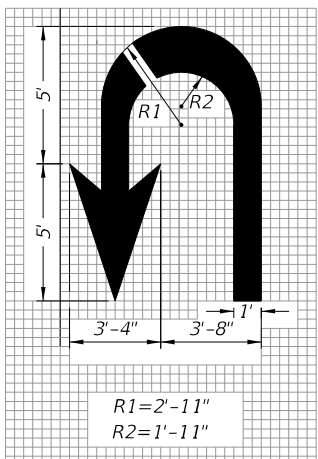


U Turn Lane-Use Arrow 27 S.F.

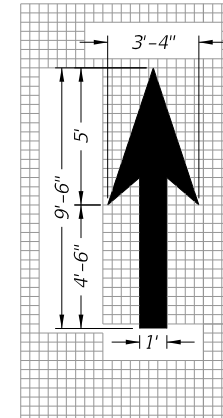


Through Lane-Use Arrow 12 S.F.

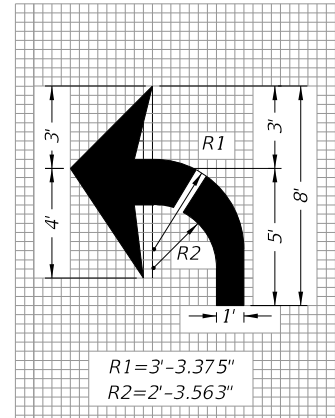

Turn Lane-Use Arrow (Left Turn Shown - Right Turn Similar) 17 S.F.

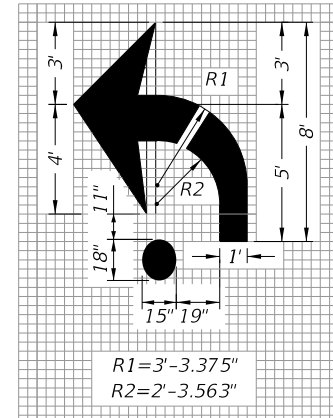

Roundabout Approach Arrow 19 S.F.

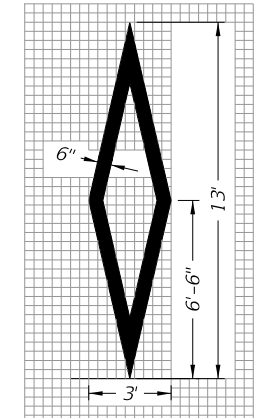

Preferential Lane Symbol 11 S.F.

NOTES FOR PAVEMENT MESSAGES:

- When an arrow or another pavement message is used with a pavement message, maintain a minimum distance of "S" between items, measured from the base of each item. See the Pavement Message Spacing Table for "S" value.
- Place all pavement messages 25' back from the stop line.
- Dimensions are within 1" ±.
- All grids are 4" x 4".
- All pavement messages must be white except route shields.
- Increase width of route shield for routes with three digits.

DELETED

PAVEMENT MESSAGE SPACING TABLE	
Posted Speed (mph)	Distance "S" (feet)
≤ 25	40
30 - 35	56
40 - 45	72
≥ 50	88

PAVEMENT MESSAGE AND ARROW DETAILS

GENERAL NOTE:


- See Index 509-070 for pavement markings at railroad crossings.

Renumbered

2/5/2021 11:53:33 AM


11/01/21

LAST REVISION	DESCRIPTION:
02/05/21	Added railroad pavement marking details.

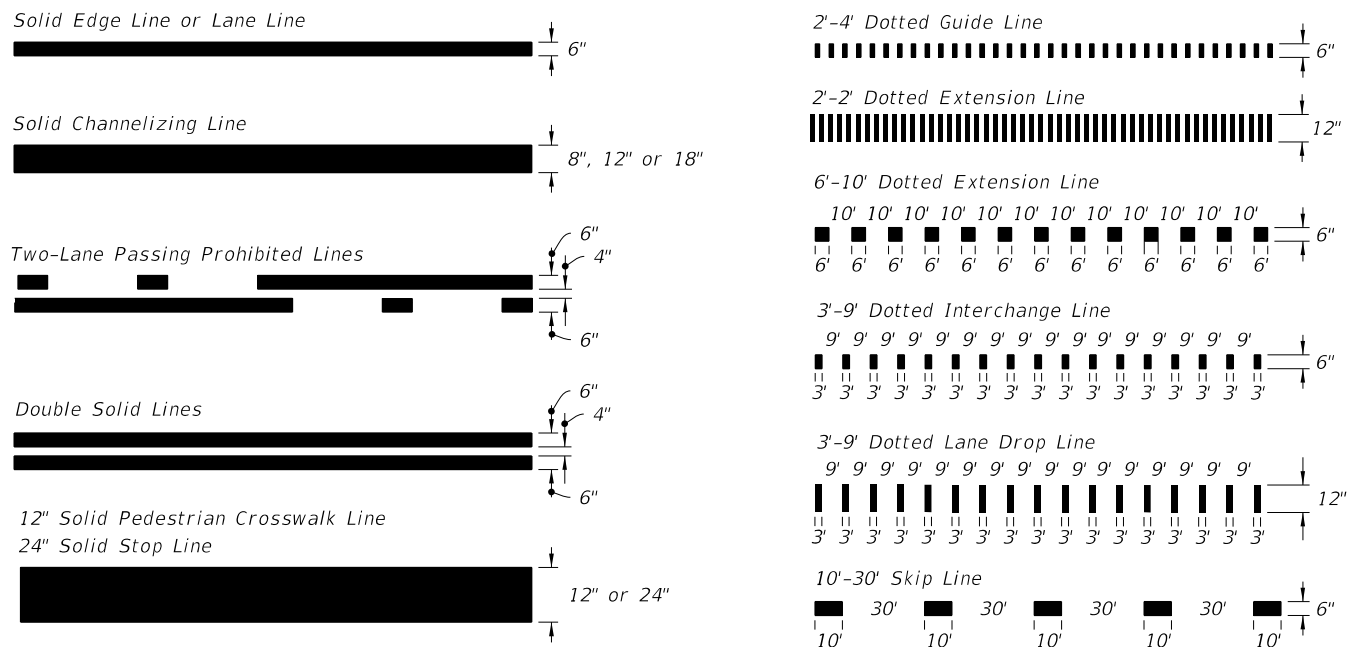


MOVED MARKINGS FOR  
 MERGE FROM SHEET 8


===== PAVEMENT MARKING LINES =====

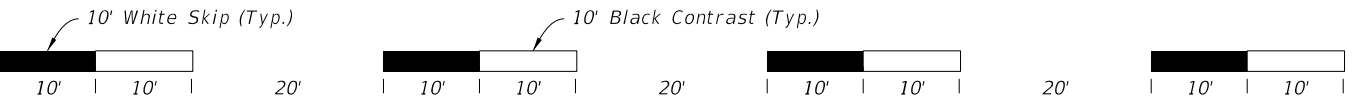

===== 10'-30' SKIP LINE WITH SHADOW MARKINGS =====

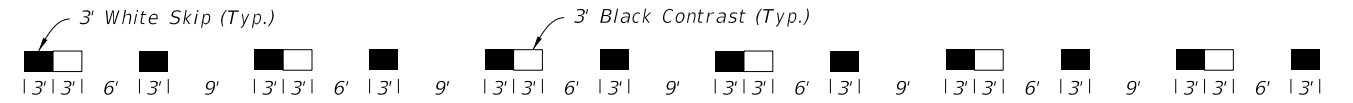

===== DOTTED LINE WITH ALTERNATING SHADOW MARKINGS =====  
 (3'-9' Dotted Line Shown, Other Dotted Lines Similar)

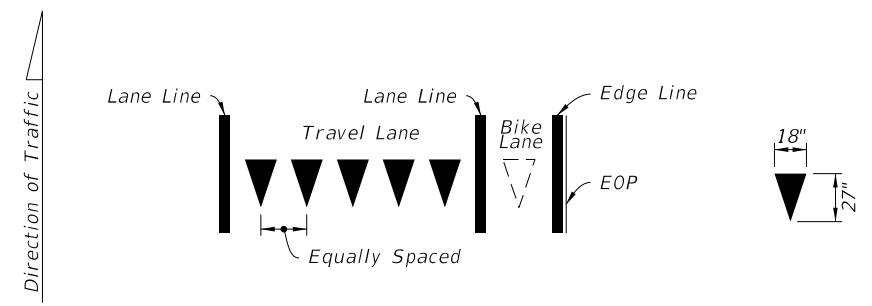


Yield Lines consist of five - 18" X 27" white triangles which face traffic. Equally space triangles within traffic lane. When a bike lane is present, add one additional triangle in the center of the bike lane.

===== YIELD LINES =====


2/5/2021 11:53:37 AM

LAST REVISION	11/01/21	DESCRIPTION: <del>Added railroad pavement marking details.</del>
<del>02/05/21</del>		


Renumbered →

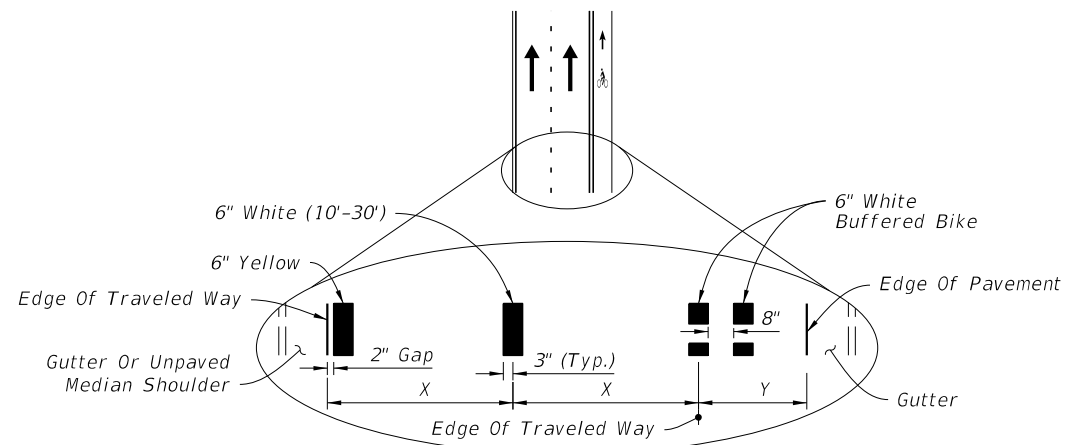

**CURB AND GUTTER**

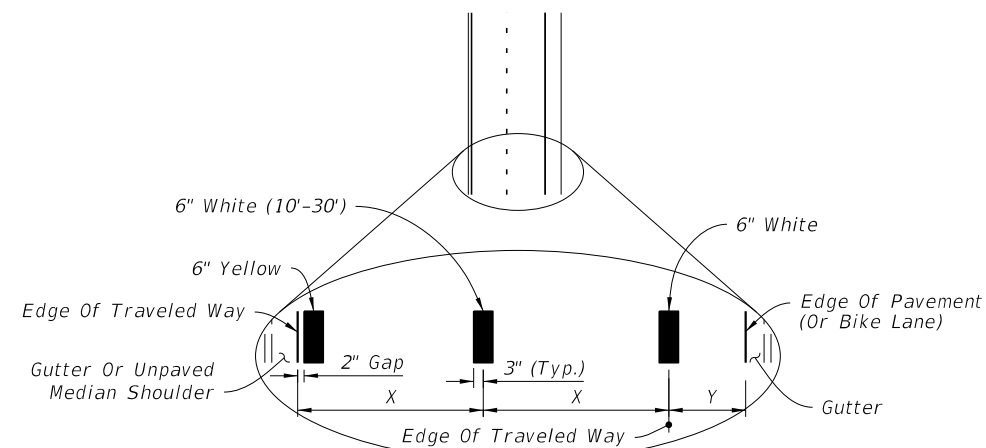


**CURB AND GUTTER**

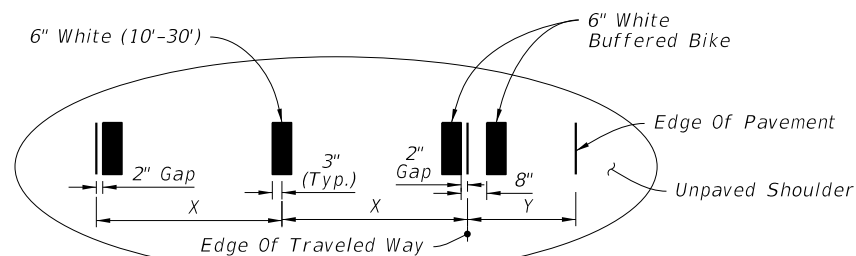

**FLUSH SHOULDER**

X = LANE WIDTH (FT.)  
Y = BUFFERED BIKE LANE WIDTH (FT.)

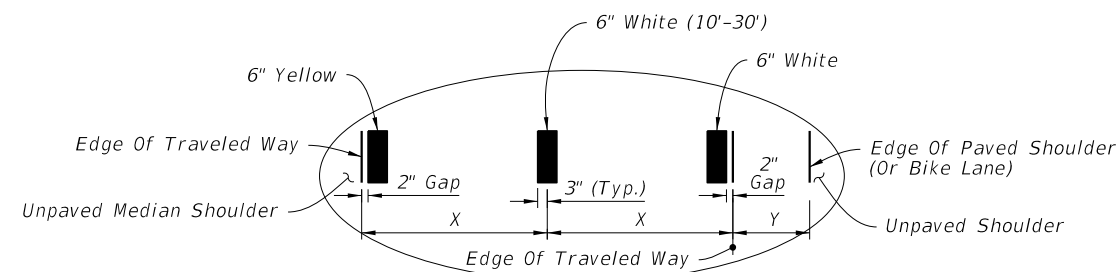


**FLUSH SHOULDER**

X = LANE WIDTH (FT.)  
Y = PAVED SHOULDER / BIKE LANE

=====**STRIPING FOR BUFFERED BIKE LANE**=====

=====**STRIPING WITH SHOULDER OR NON-BUFFERED BIKE LANE**=====

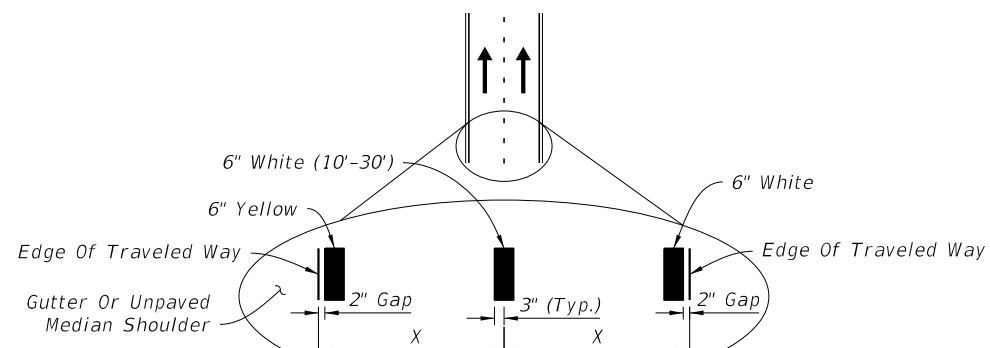

X = LANE WIDTH (FT.)

=====**STRIPING WITH NO SHOULDER OR BIKE LANE**=====

**NOTES:**

1. Lane widths (X) may not be same for each lane in the section.
2. For placement of RPMs, see Index 706-001.

Renumbered

**PLACEMENT OF LONGITUDINAL PAVEMENT MARKINGS**


2/5/2021 11:53:38 AM

LAST REVISION	DESCRIPTION:
<del>02/05/21</del>	<del>Added railroad pavement marking details.</del>
	11/01/21


**FY 2021-22**  
**STANDARD PLANS**

**PAVEMENT MARKINGS**


INDEX	SHEET
711-001	13
	3 of 14

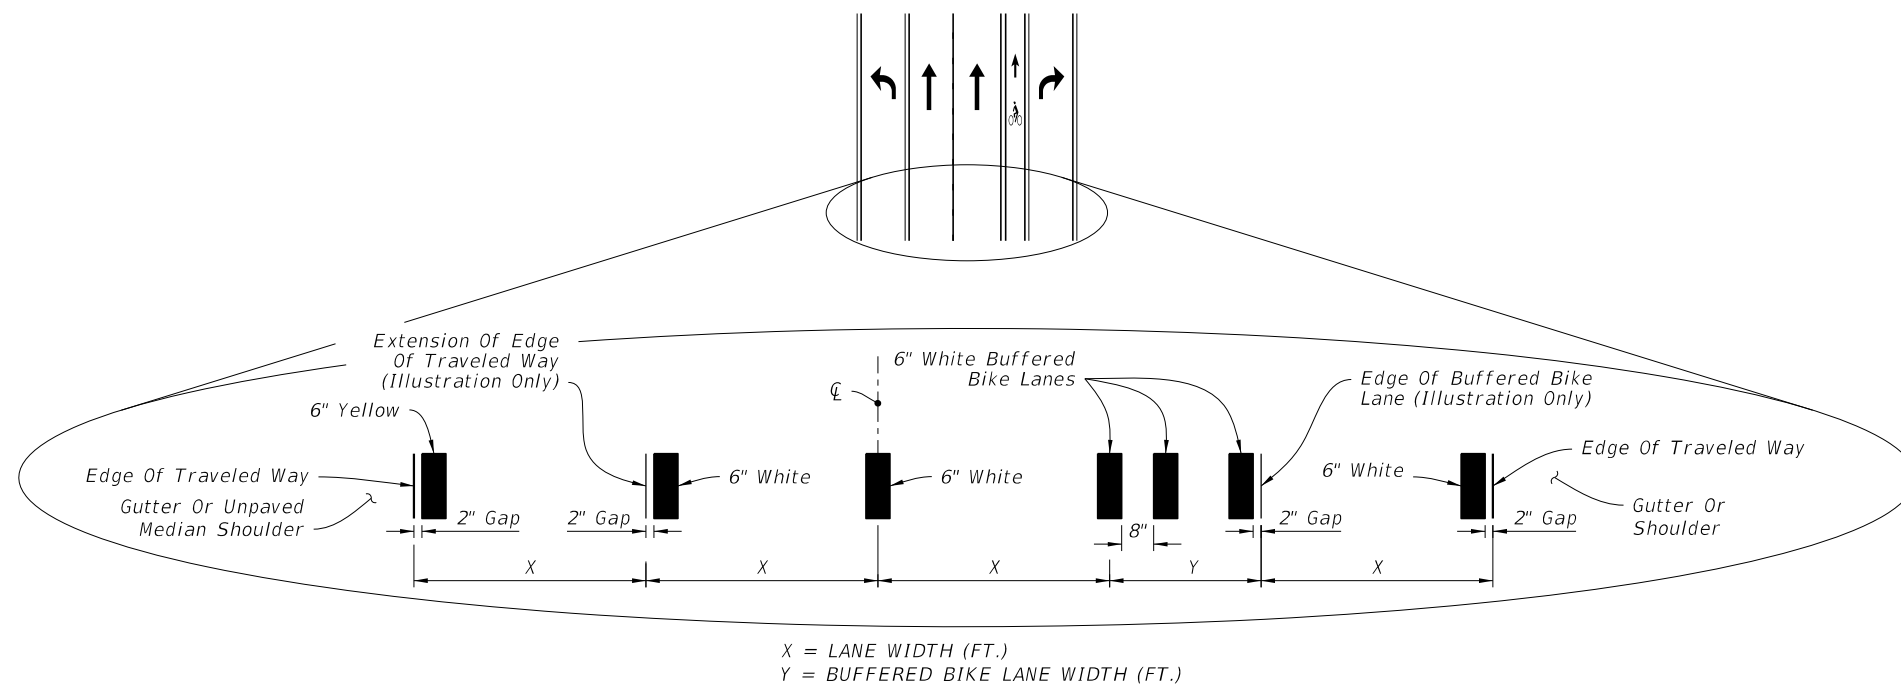

**INTERSECTION APPROACH STRIPING WITH TURN LANES AND BUFFERED BIKE LANE KEY HOLE**

**NOTES:**

1. Lane widths (X) may not be same for each lane in the section.
3. For placement of RPMs, see Index 706-001.
4. For placement of Express Lane markers and associated RPMs, see the Plans.

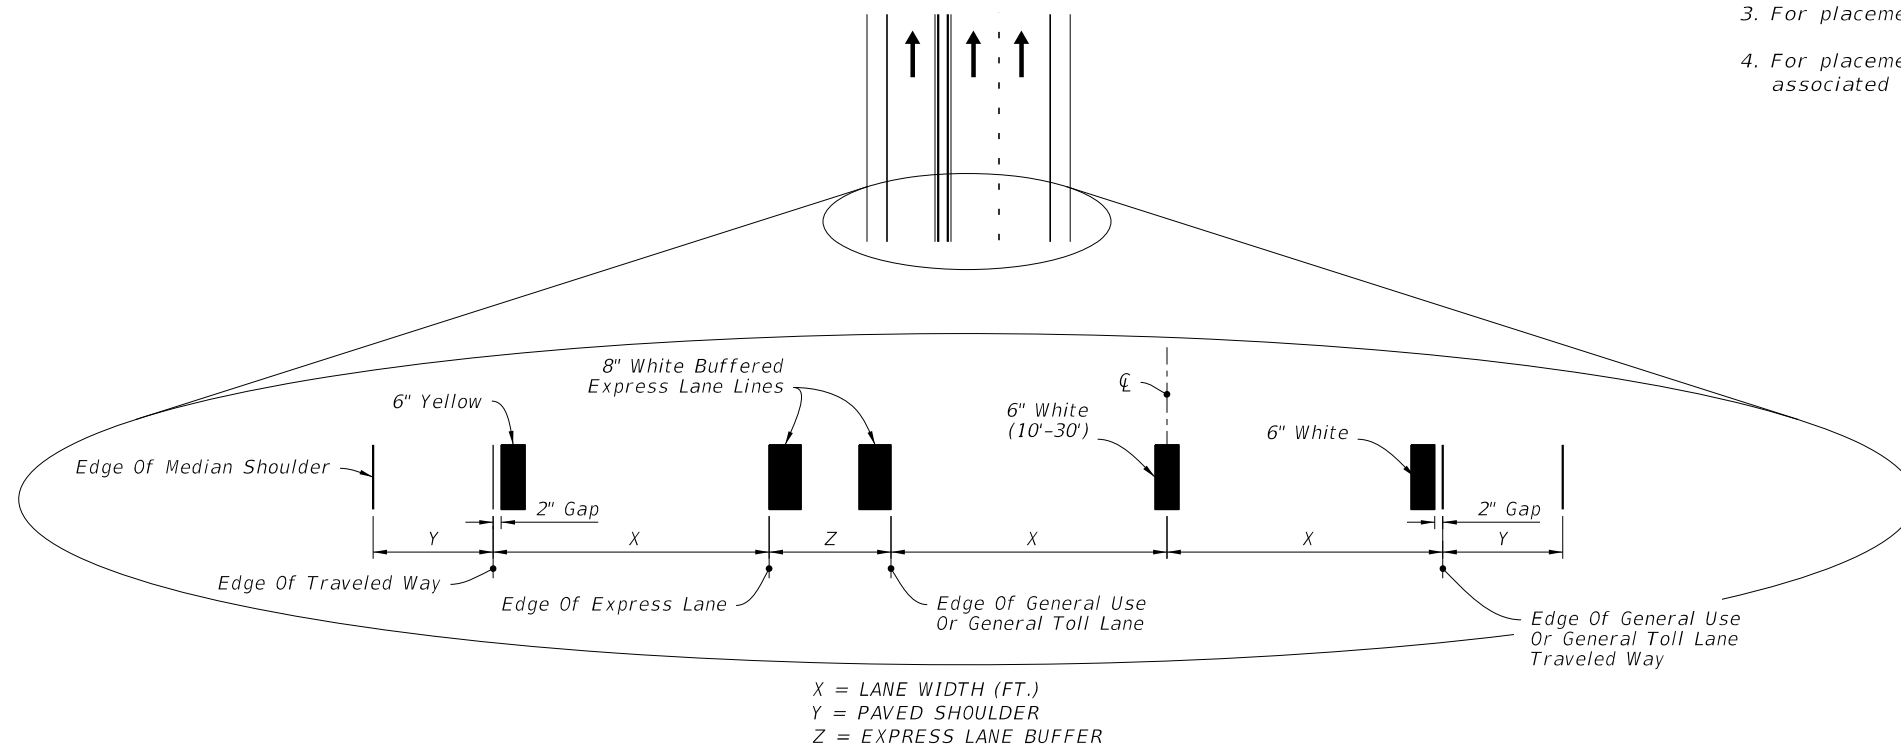

**BUFFERED EXPRESS LANE STRIPING**


Renumbered

**PLACEMENT OF LONGITUDINAL PAVEMENT MARKINGS**

2/5/2021 11:53:40 AM

LAST REVISION <del>02/05/21</del>	REVISION 11/01/21	DESCRIPTION: <del>Added railroad pavement marking details.</del>	<p>FY 2021-22 STANDARD PLANS</p>	PAVEMENT MARKINGS	INDEX 711-001	SHEET 4 of <del>14</del> <b>13</b>
--------------------------------------	----------------------	---	--------------------------------------	-------------------	------------------	---------------------------------------

2/5/2021 11:53:41 AM

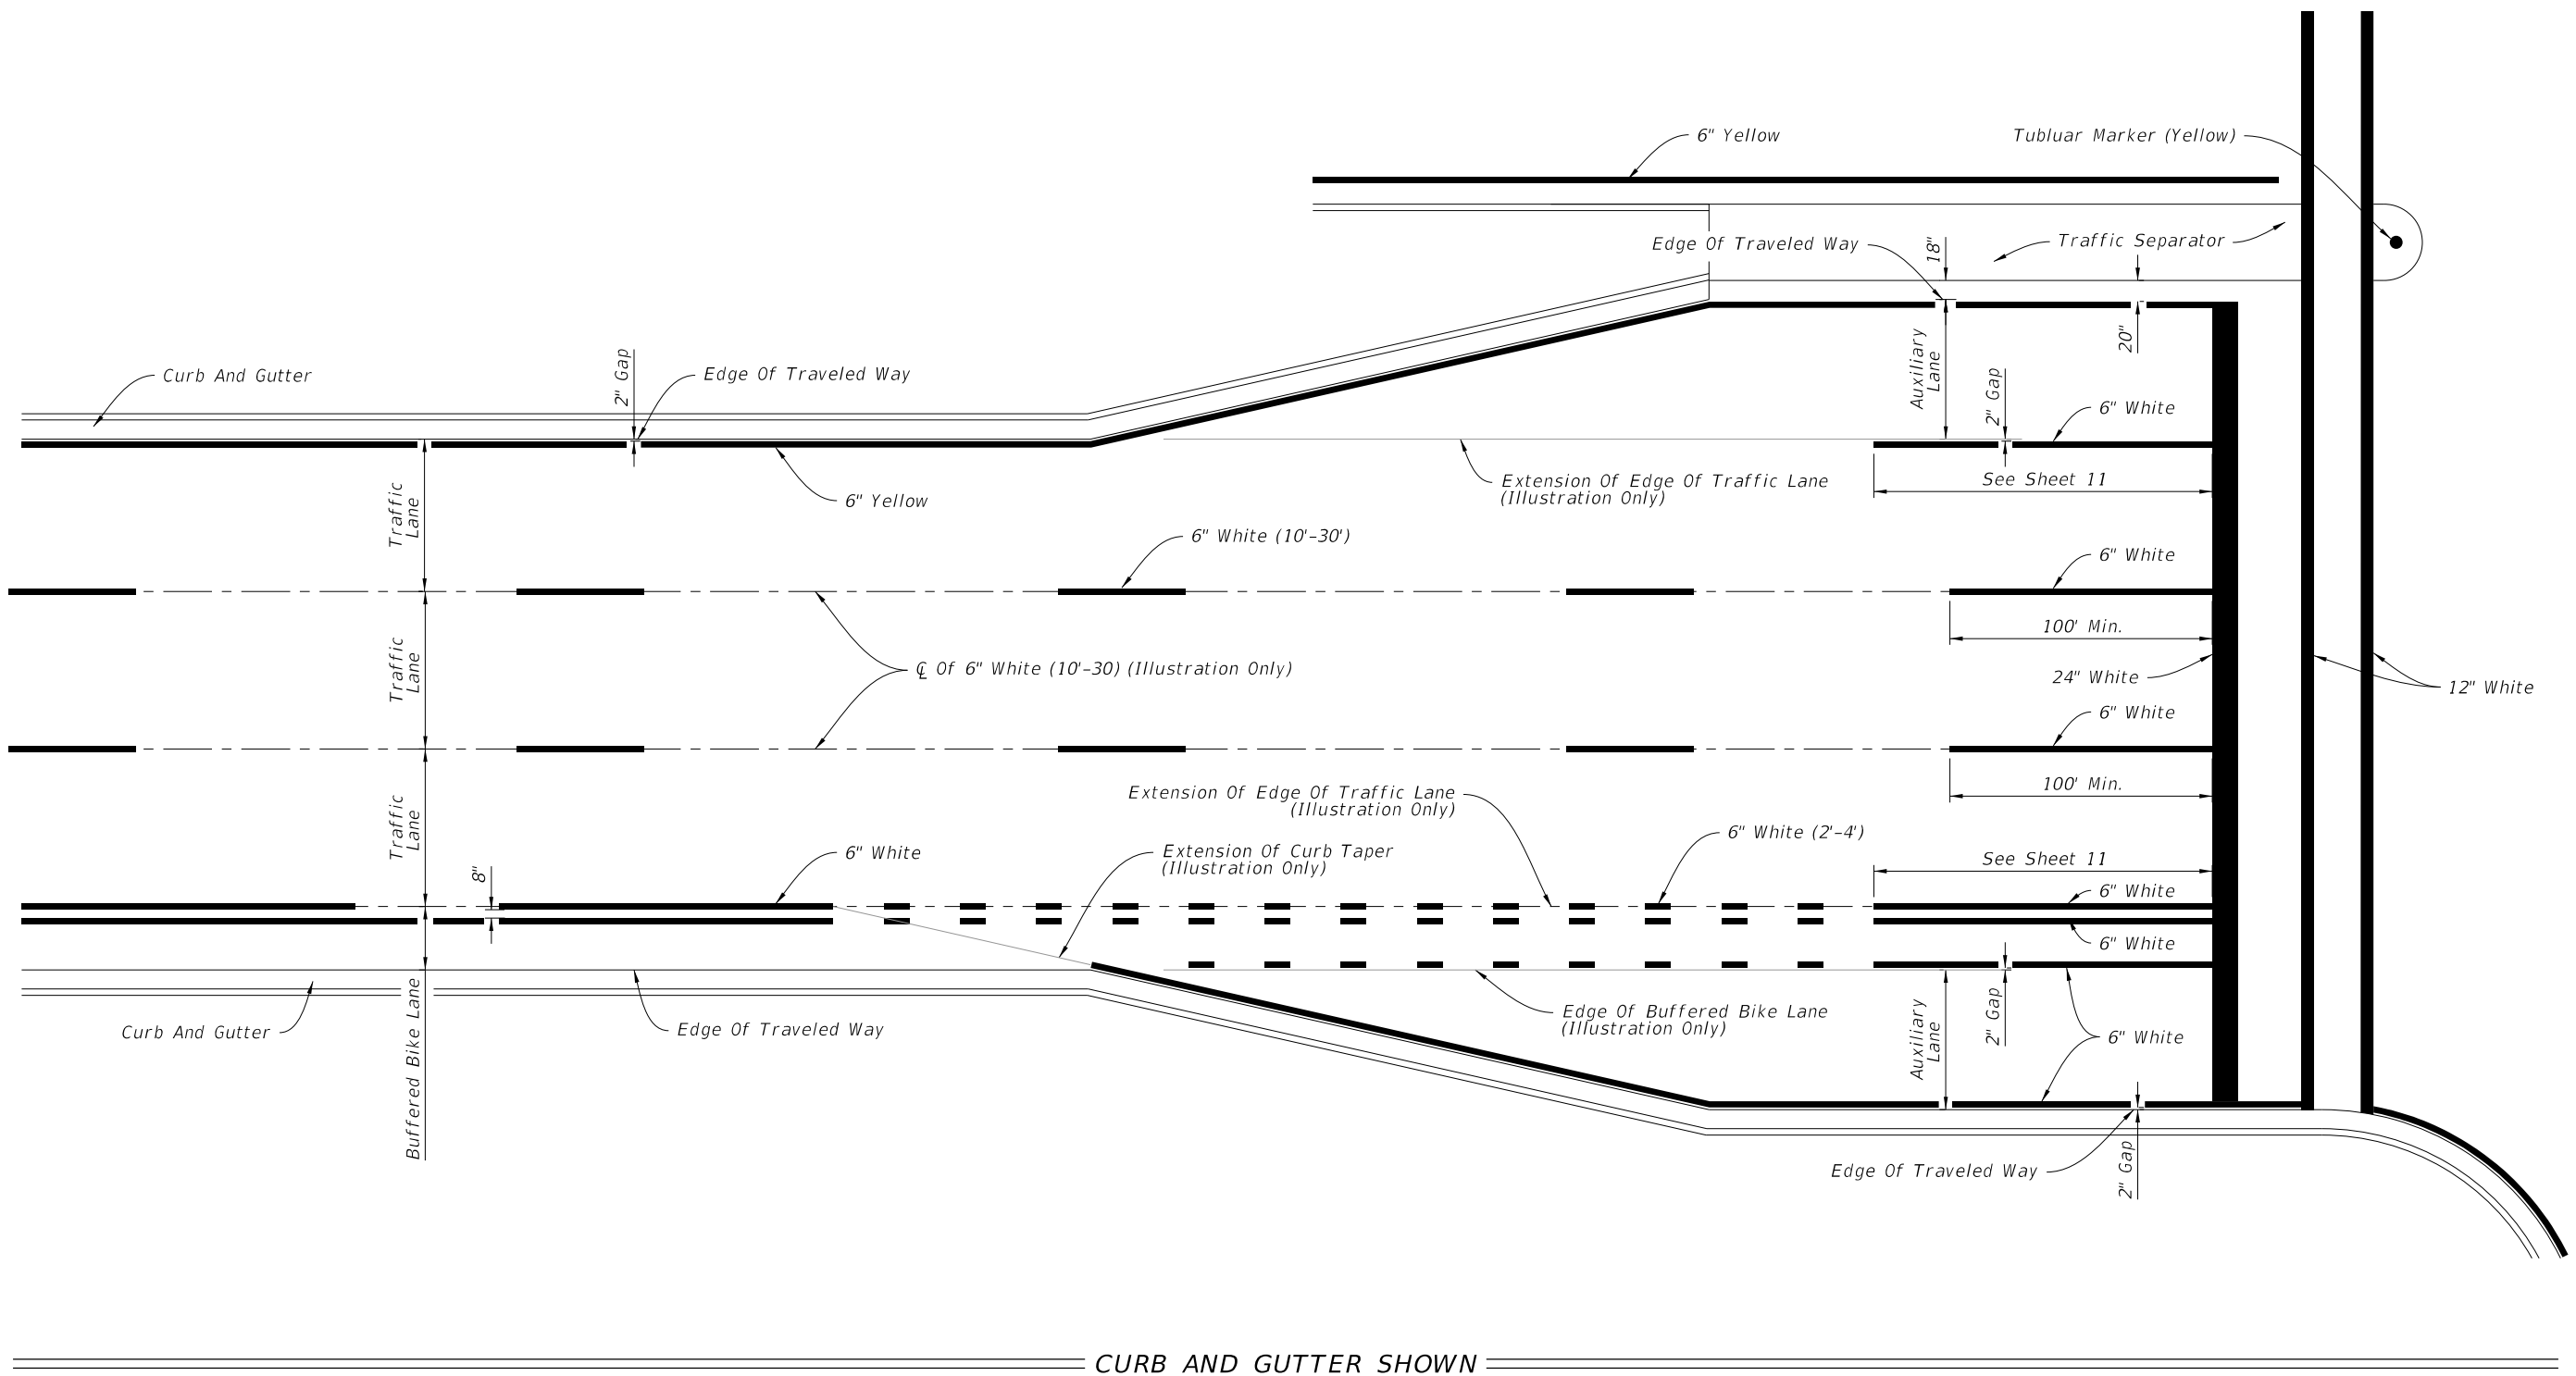

CURB AND GUTTER SHOWN

Renumbered →

PLACEMENT OF LONGITUDINAL PAVEMENT MARKINGS


LAST REVISION	DESCRIPTION:
<del>02/05/21</del>	<del>Added railroad pavement marking details.</del>
REVISION	11/01/21


**FY 2021-22**  
**STANDARD PLANS**

PAVEMENT MARKINGS

INDEX	SHEET
711-001	13
	5 of 14

2/5/2021 11:53:42 AM

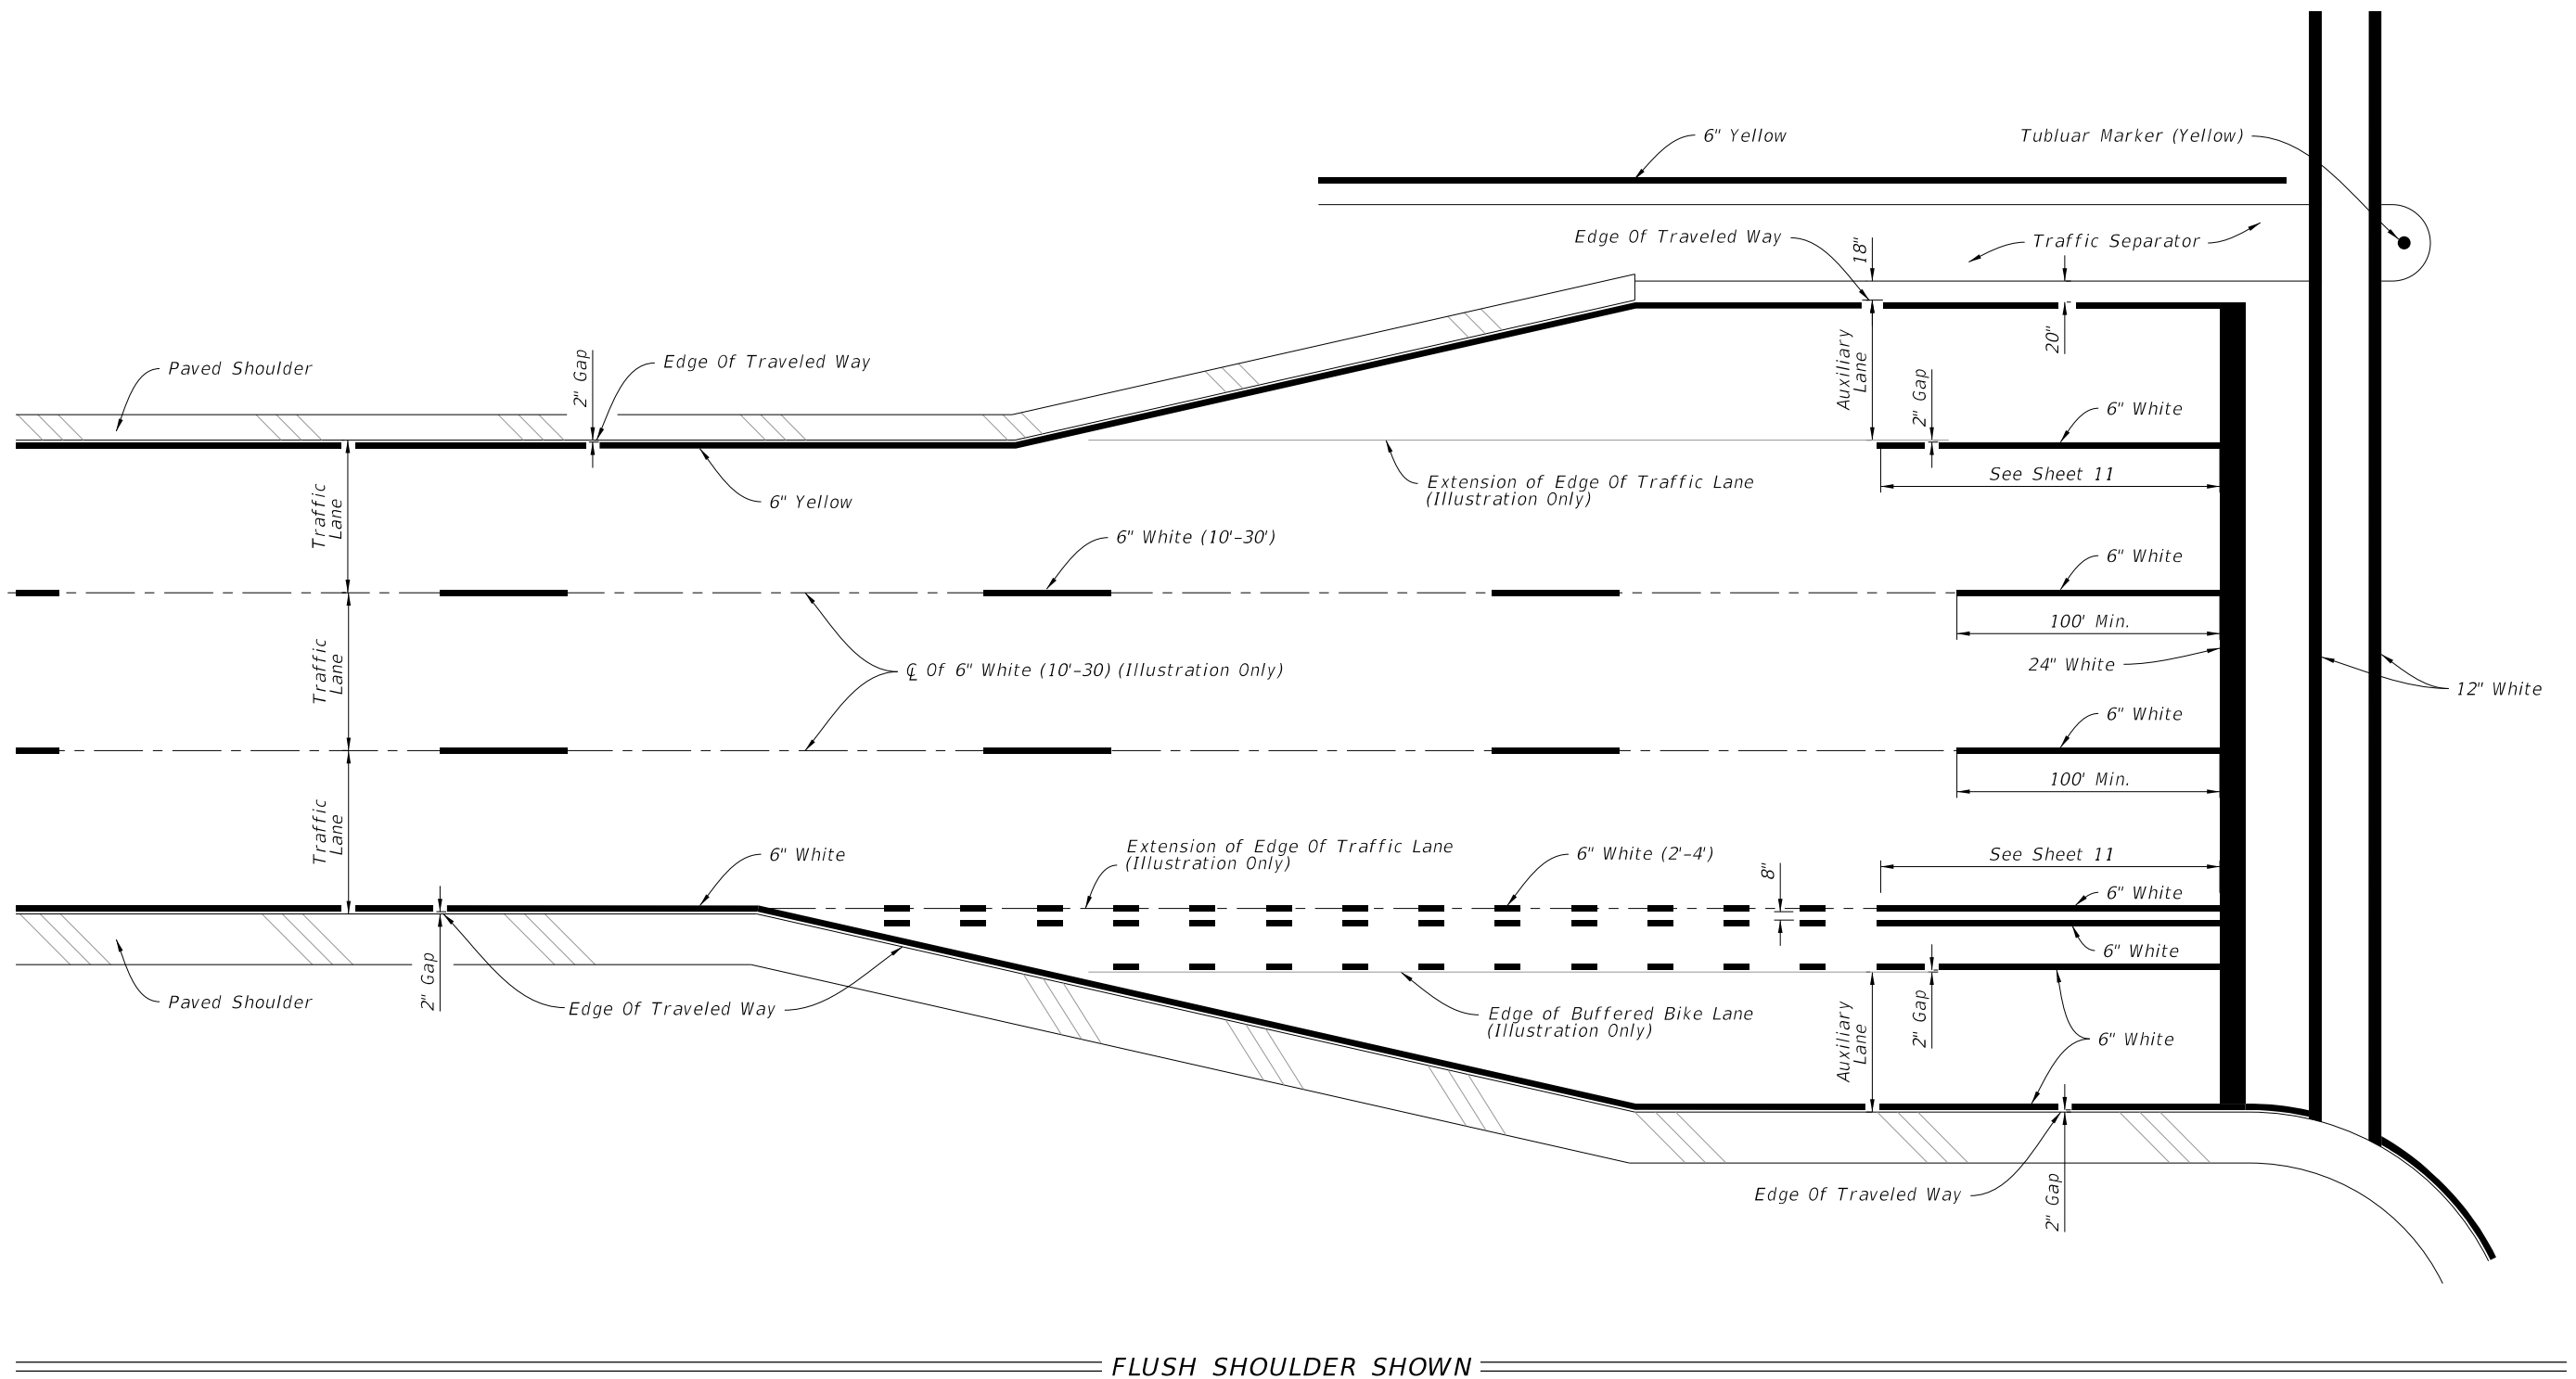

FLUSH SHOULDER SHOWN

11/01/21

Renumbered

PLACEMENT OF LONGITUDINAL PAVEMENT MARKINGS

LAST REVISION	DESCRIPTION:
<del>02/05/21</del>	<del>Added railroad pavement marking details.</del>






FY 2021-22  
STANDARD PLANS

PAVEMENT MARKINGS

INDEX  
711-001


SHEET ~~14~~ 13  
6 of ~~14~~

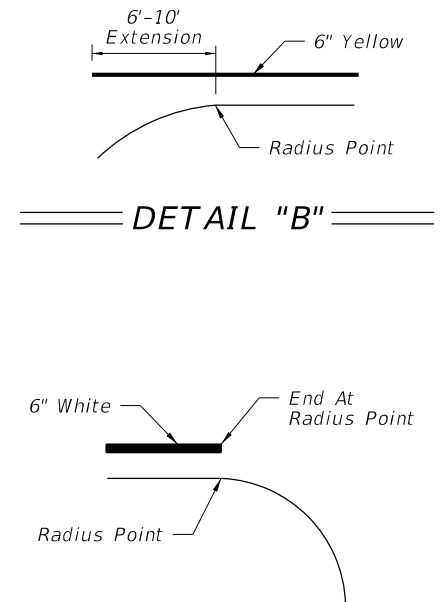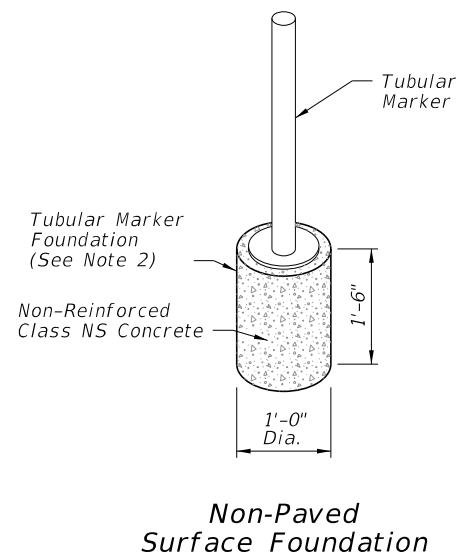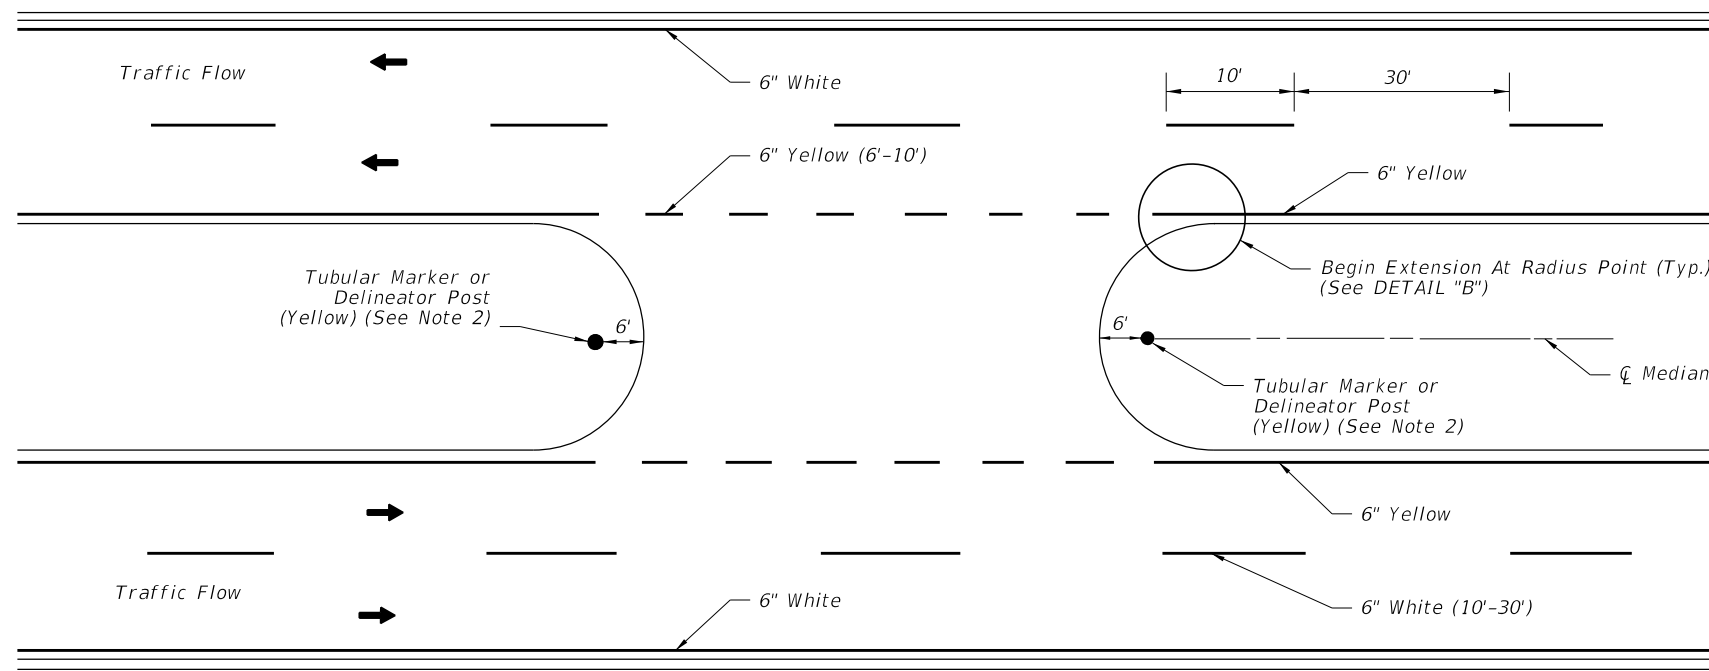

PAVEMENT MARKINGS AND DELINEATORS FOR MEDIAN CROSSOVER

DETAIL "A"

DETAIL "C"

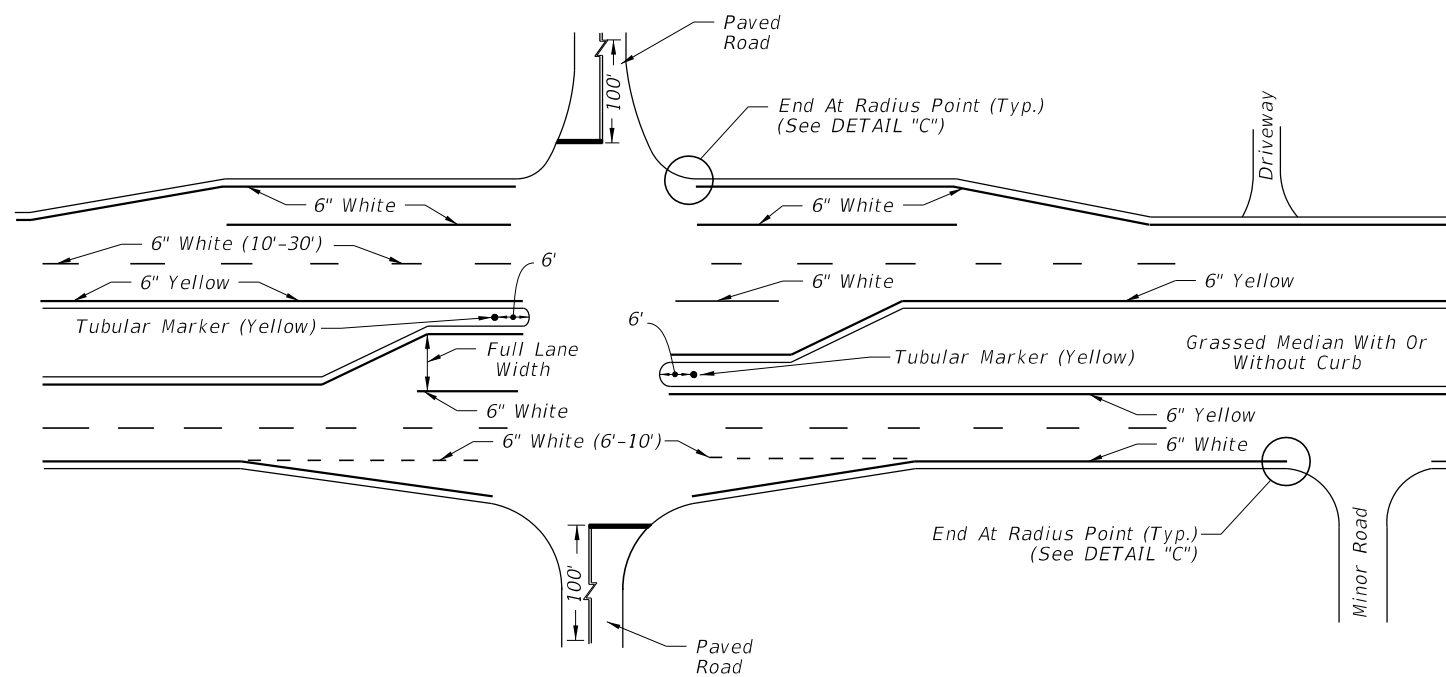

NOTE:

1. Apply yellow reflective paint to the noses of curbed medians, traffic separators, and raised islands. When applying yellow reflective paint in conjunction with Raised Pavement Markers, see Index 706-001.
2. Options for grassed medians:
  - A. Option 1: Tubular Marker (Yellow). Attach Tubular Marker according to manufacturer's instructions. Non-Paved Surface Foundation (See Detail "A") is provided as an option if no other suitable surface is provided. Install Non-Paved Surface Foundation flush with the surrounding ground surface.
  - B. Option 2: Delineator Post. Use yellow retro-reflective sheeting on both sides of the delineator. Install the post so that the top is 4'-0" above the grade at the edge of the pavement.
3. Extend double yellow centerlines 100' back from intersection on all approaches or 50' for unmarked cross roads.

PAVEMENT MARKINGS FOR INTERSECTIONS WITH MAJOR AND MINOR ROADS

2/5/2021 11:53:45 AM

11/01/21

Renumbered

LAST REVISION	DESCRIPTION:
02/05/21	<del>Added railroad pavement marking details.</del>




FY 2021-22  
STANDARD PLANS

PAVEMENT MARKINGS


INDEX  
711-001

SHEET 13  
7 of 14



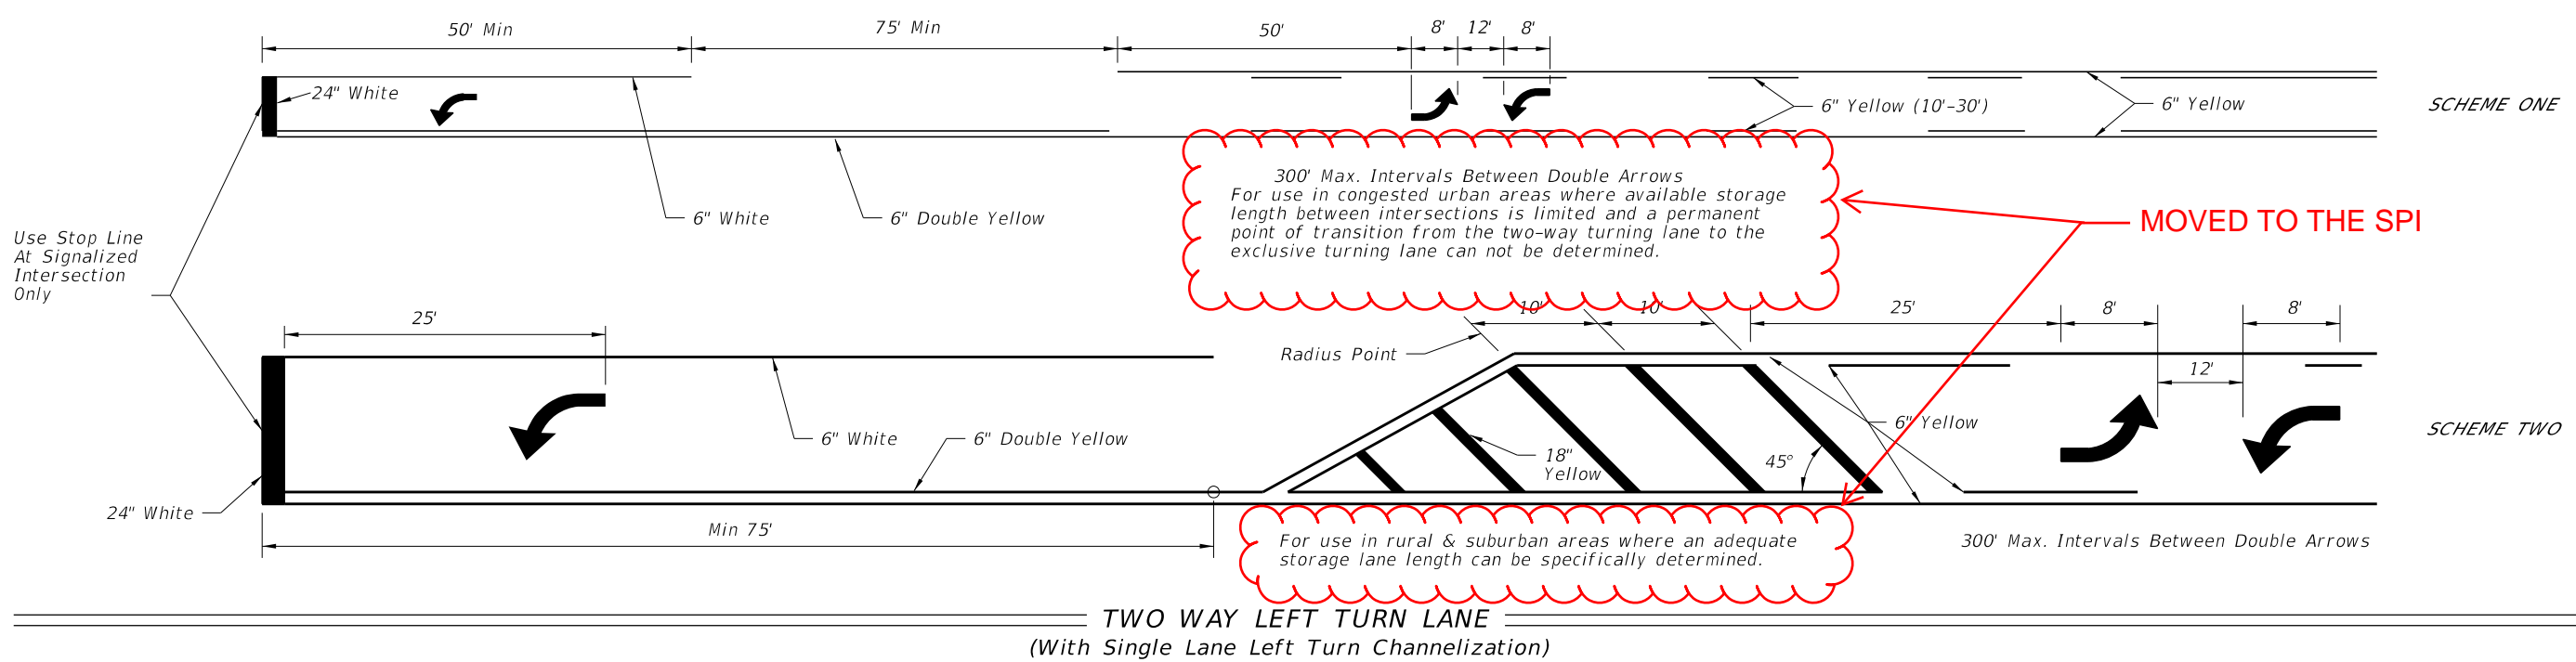


TWO WAY LEFT TURN LANE  
(With Single Lane Left Turn Channelization)

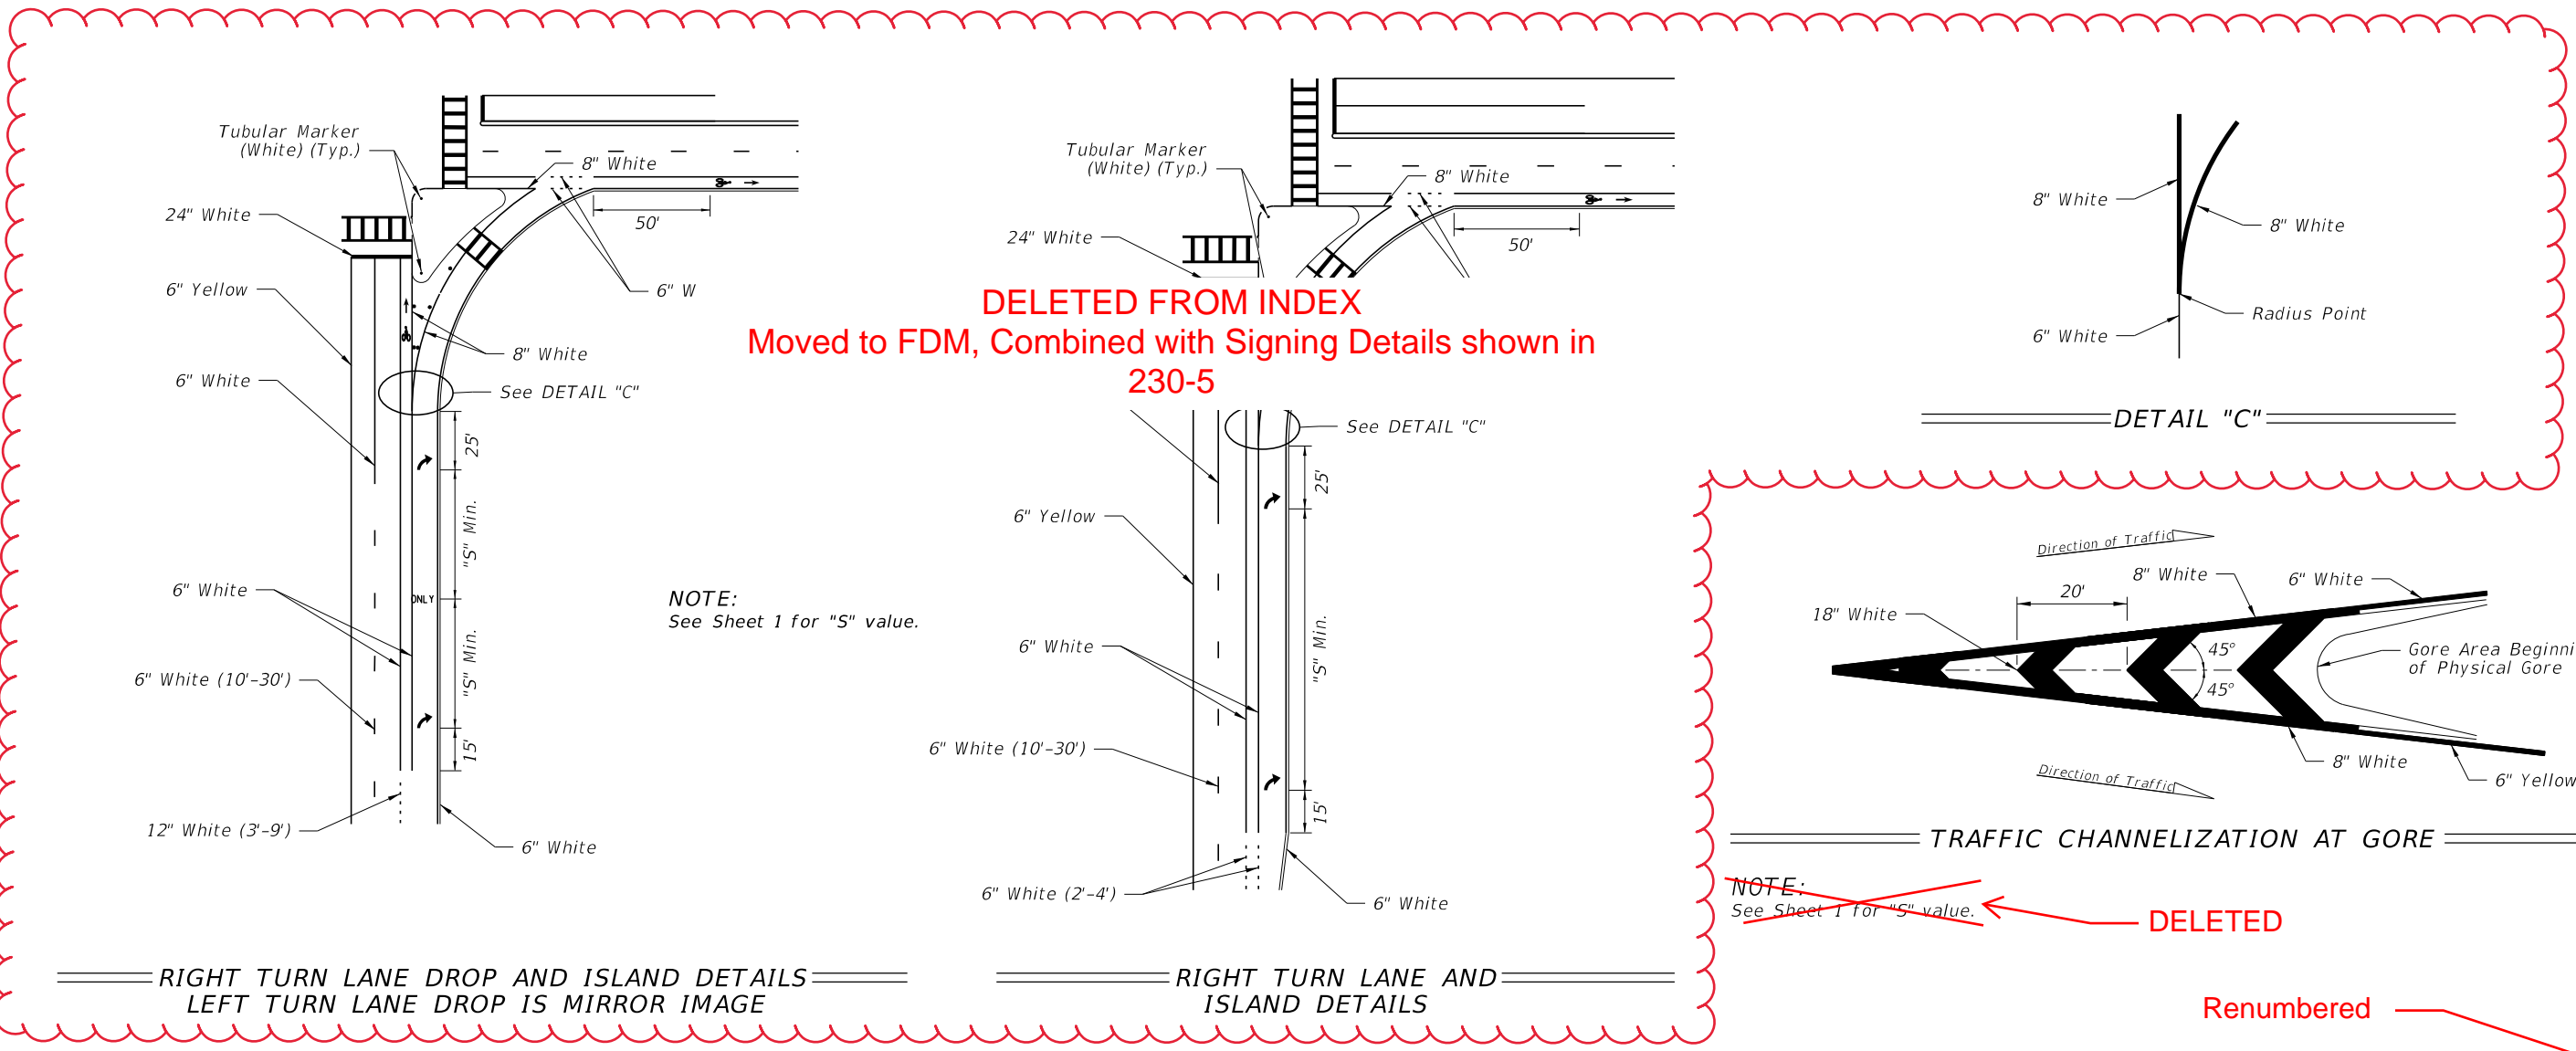

2/5/2021 11:53:47 AM

LAST REVISION <del>02/05/21</del>	DESCRIPTION: <del>Added railroad pavement marking details.</del> 11/01/21		FY 2021-22 STANDARD PLANS	PAVEMENT MARKINGS	INDEX 711-001	SHEET 8 of <del>14</del> <b>13</b>
--------------------------------------	---	--	------------------------------	-------------------	------------------	---------------------------------------

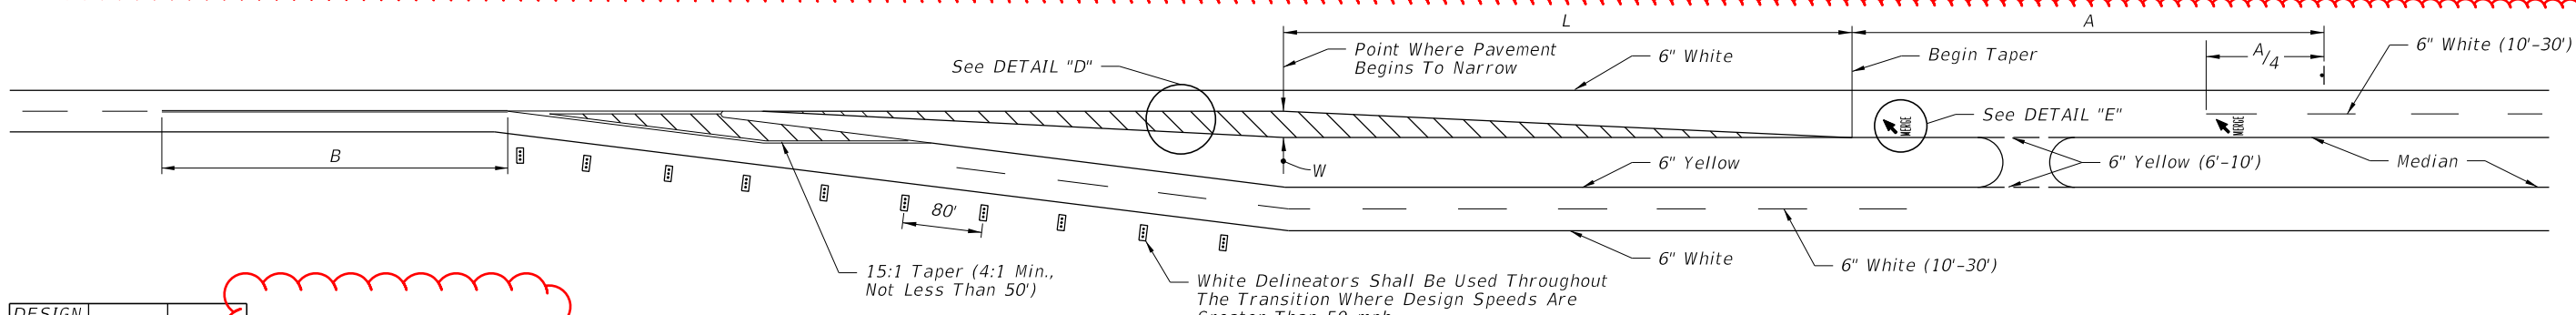


DESIGN SPEED (MPH)	"A" (FT.)	"B" (FT.)
60	---	640
55	950	595
50	850	550
45	750	500
40	650	455
30	450	365

POSTED SPEED LIMIT MPH	"y" (FT.)
30 OR LESS	10
35	20
40	20
45	30
50 OR MORE	40

DESIGN SPEED 'S' (MPH)	Length 'L' (FT.)
40 or Less	$L = WS^2/60$
45 or Greater	$L = WS$

LEFT ROADWAY CENTERED ON EXISTING ROADWAY


**Deleted from Index.**  
**Moved to FDM, Combine with Signing Details shown on 230-5.**

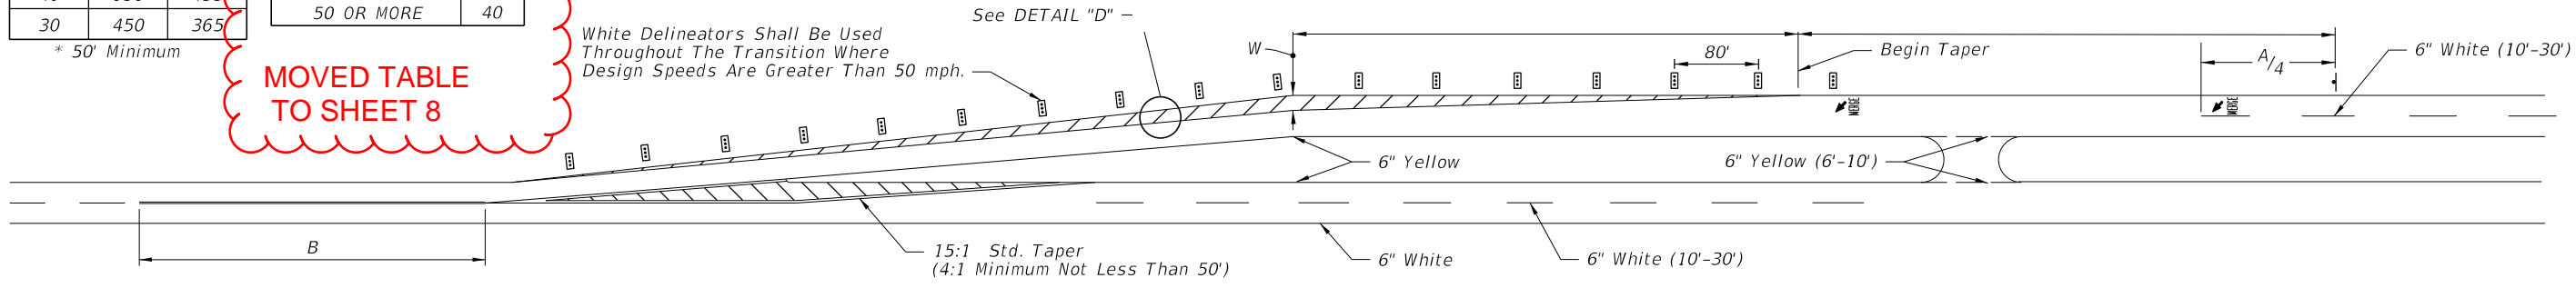

RIGHT ROADWAY CENTERED ON EXISTING ROADWAY

**SCHEMES FOR TRANSITION - 2 LANE / 4 LANE ROADWAY**


**DELETED FROM INDEX**  
**Moved to FDM, Combined with Signing Details shown in 230-5**

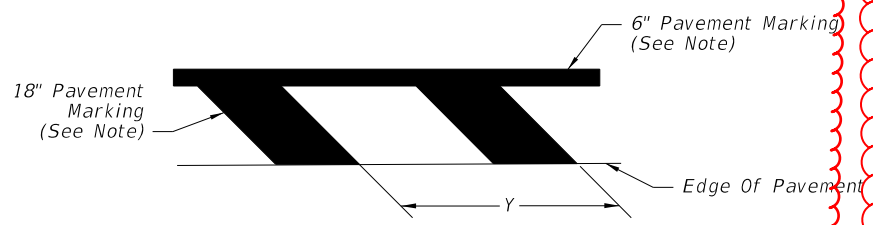

**NOTE:**  
 Make pavement markings yellow for left roadway centered on existing roadway. Right roadway centered on existing roadway is similar with white pavement markings.

**DETAIL "D"**


**MOVED DETAILS TO SHEET 2**

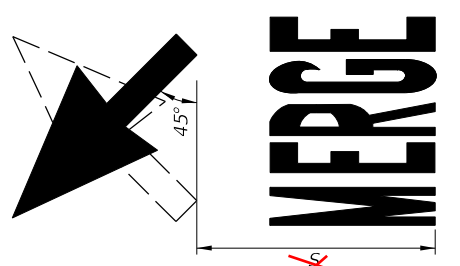

~~NOTE: See Sheet 1 for "S" value.~~

~~DETAIL "E"~~

**MOVED DETAILS TO SHEET 8**

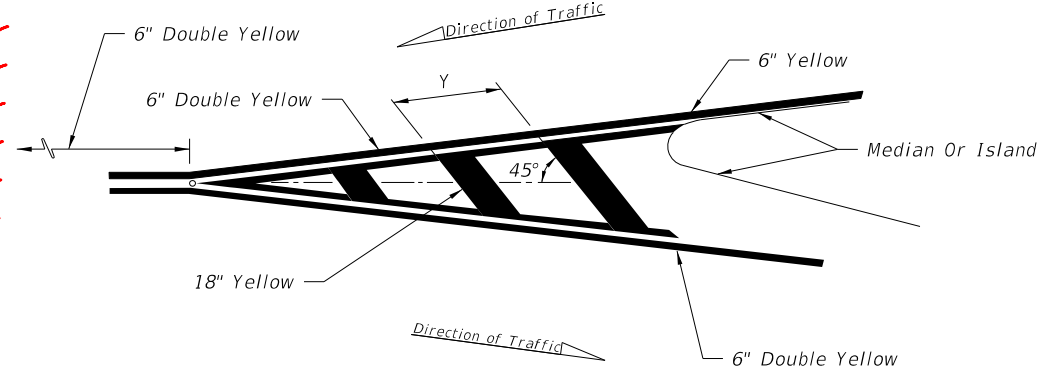


**MARKINGS FOR TRAFFIC SEPARATION**

**CHANGED TO: 25'**


**DELETED NOTE**

**CHANGED TO: Marking for Merge**

2/7/2021 11:35:46 AM

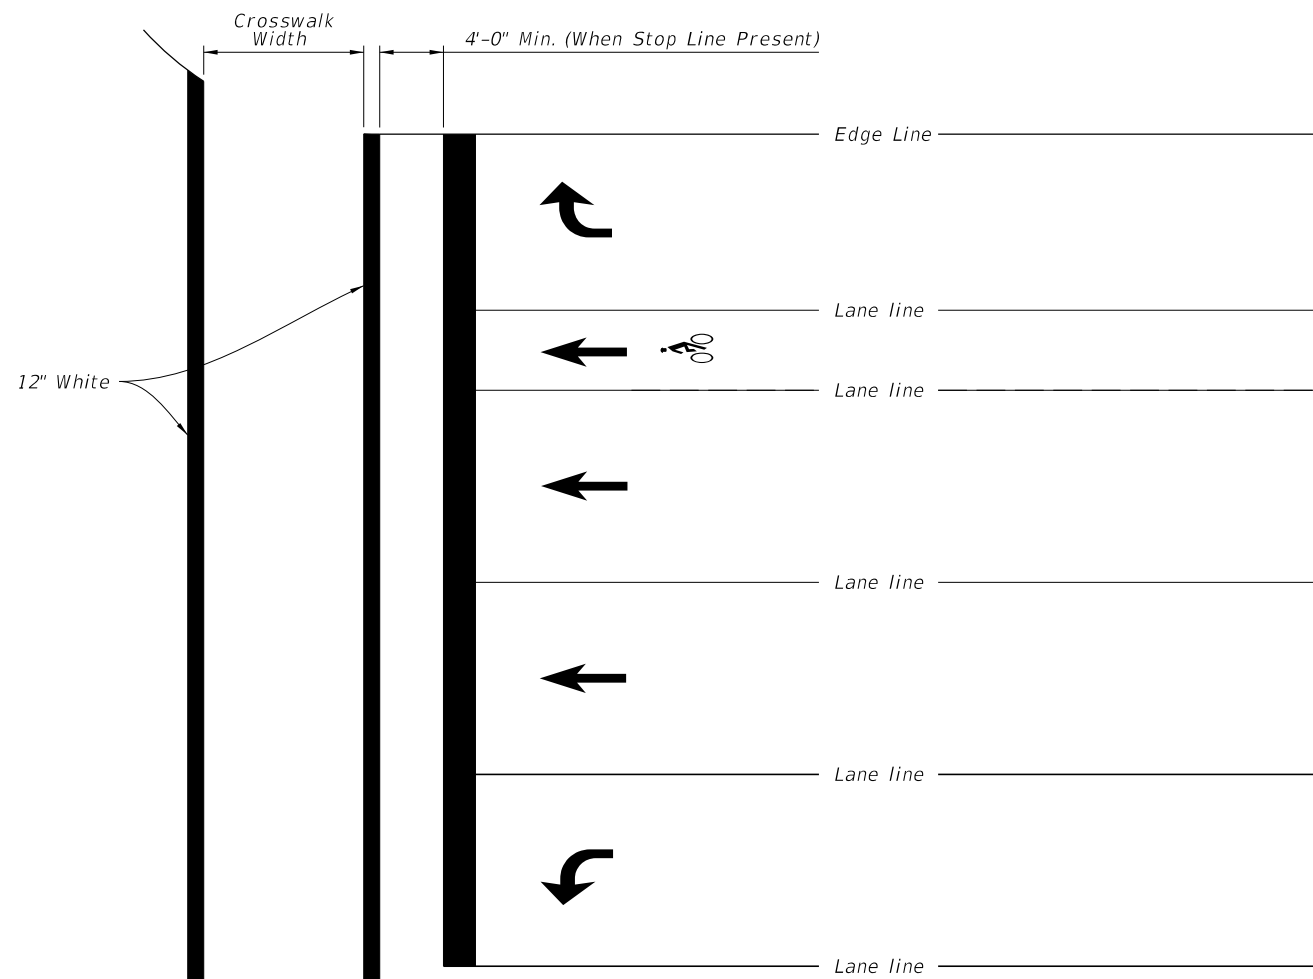

STANDARD CROSSWALK DETAILS

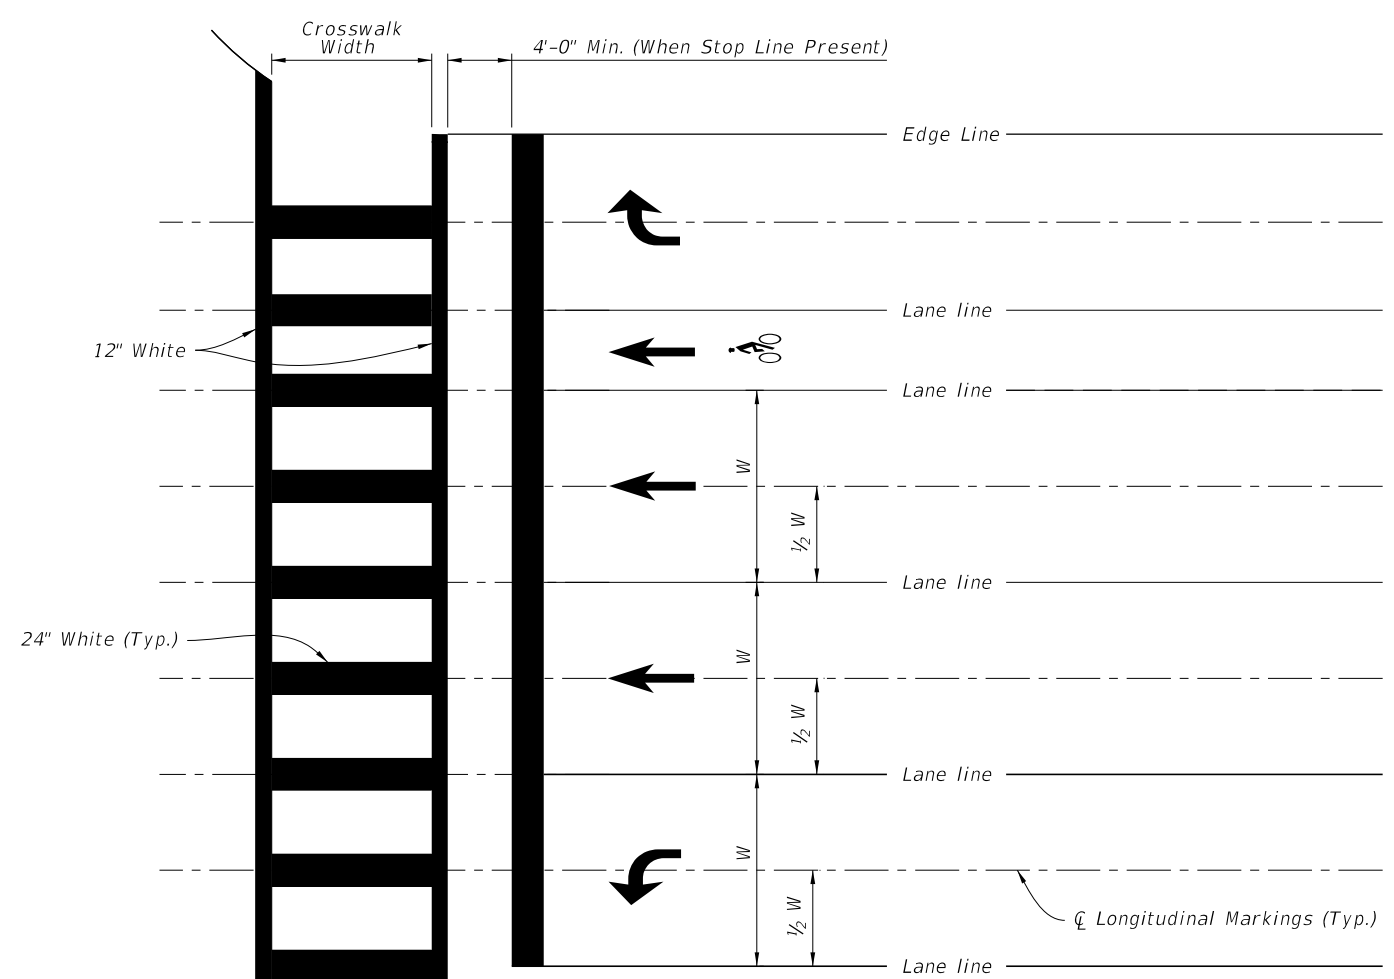

SPECIAL EMPHASIS CROSSWALK DETAILS

**NOTES:**


1. For crosswalk width, exceed width of the adjacent sidewalk, but do not make width less than 6' for intersection crosswalks and 10' for midblock crosswalks. Measure width from the inside of the transverse crosswalk markings.
2. When the Special Emphasis Crosswalk is not perpendicular to the lane lines, make the longitudinal markings parallel to the lane lines.
3. Refer to Index 522-002 when Curb Ramps are present.

2/5/2021 11:53:51 AM


11/01/21

9 of 13

LAST REVISION <del>02/05/21</del>	REVISION DESCRIPTION: <del>Added railroad pavement marking details.</del>	 <b>FY 2021-22</b> <b>STANDARD PLANS</b>	<b>PAVEMENT MARKINGS</b>	INDEX <b>711-001</b>	SHEET <del>10 of 14</del>
--------------------------------------	---	--	--------------------------	-------------------------	------------------------------

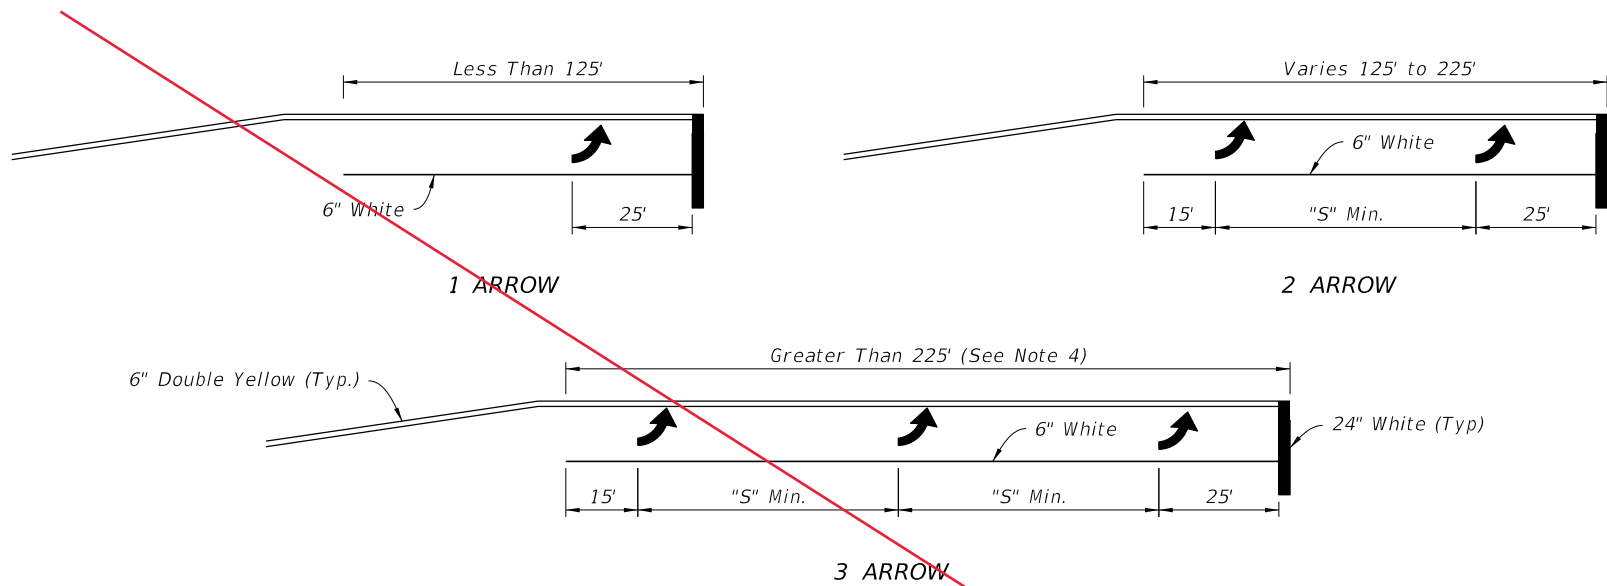


- NOTES:**
1. This Index also applies to right turn lanes.
  2. Make pavement marking yellow for left-turn lanes and white for right-turn lanes.
  3. See Sheet 1 for "S" value.
  4. Space arrows evenly between the first and last arrow with a minimum spacing of "S" between arrows.
  5. For turn lanes greater than 225' in length, use a minimum of three arrows. Use additional arrows in accordance with the Plans or as directed by the Engineer. Space arrows evenly throughout the available length with a minimum spacing of "S" between arrows.

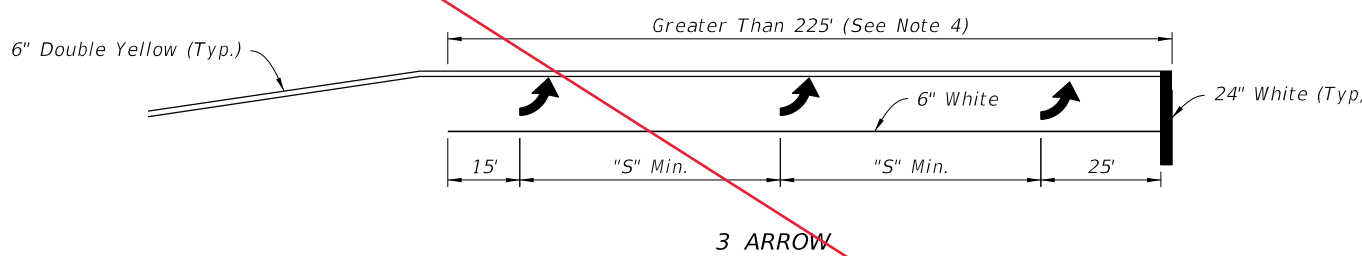


**SINGLE LEFT TURNS**

**Revert Back to previous version, see mark-up of FY 2018-19 Index. (Next Sheet)**

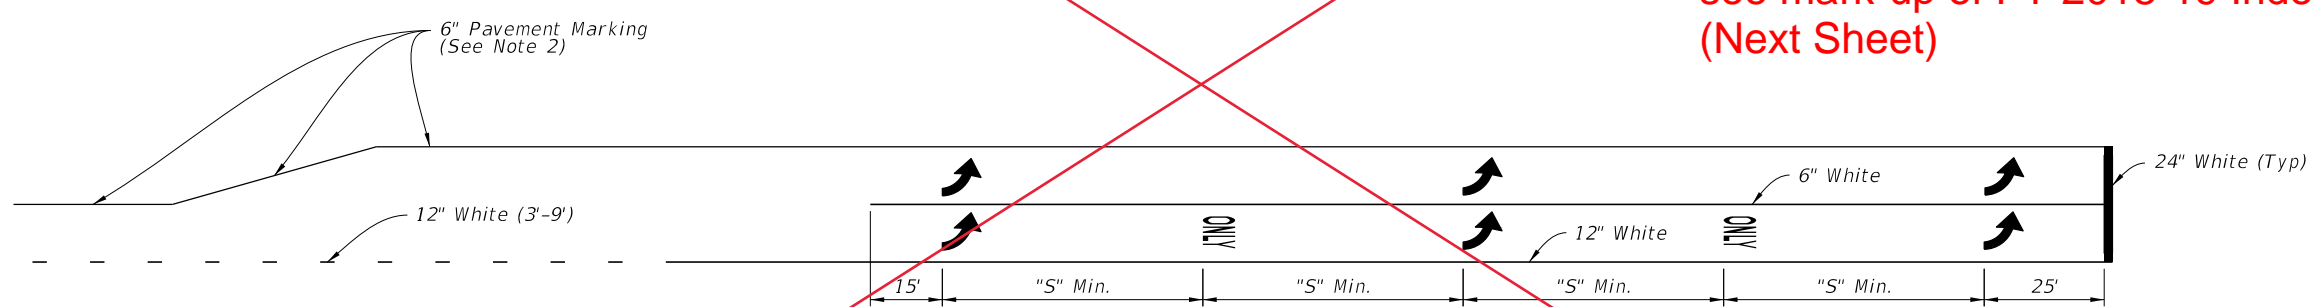

Through Lane Becomes Exclusive Left Turn

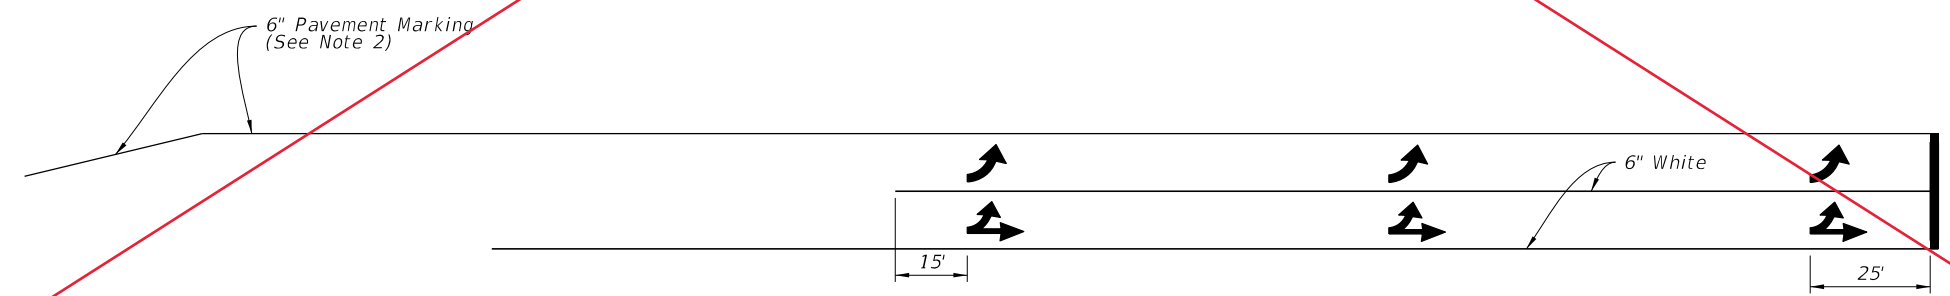

Through Lane Becomes Optional Left Turn


**DOUBLE LEFT TURNS**

2/5/2021 11:53:52 AM

11/01/21

LAST REVISION <del>02/05/21</del>	DESCRIPTION: <del>Added railroad pavement marking details.</del>		FY 2021-22 STANDARD PLANS	PAVEMENT MARKINGS	INDEX	SHEET
					711-001	11 of 14


**TURN LANE MARKINGS**

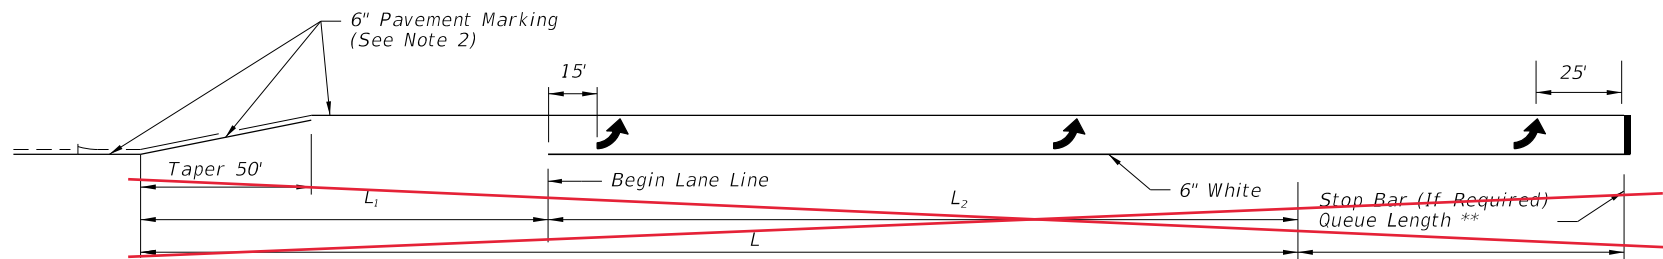


SINGLE LEFT TURNS

\*\* Queue Length Is Measured From The Median Nose Radial Point Or, When A Stop Bar Is Required, From The Stop Bar.


TURN LANES - CURBED AND UNCURBED MEDIANS							
Design Speed (mph)	Clearance Distance	URBAN CONDITIONS			RURAL CONDITIONS		
		Brake To Stop Distance	Total Decel. Distance	Clearance Distance	Brake To Stop Distance	Total Decel. Distance	Clearance Distance
	$L_1$	$L_2$	$L$	$L_3$	$L_2$	$L$	$L_3$
35	70'	75'	145'	110'	---	---	---
40	80'	75'	155'	120'	---	---	---
45	85'	100'	185'	135'	---	---	---
50	105'	135'	240'	160'	185'	290'	160'
55	125'	---	---	---	225'	350'	195'
60	145'	---	---	---	260'	405'	230'
65	170'	---	---	---	290'	460'	270'

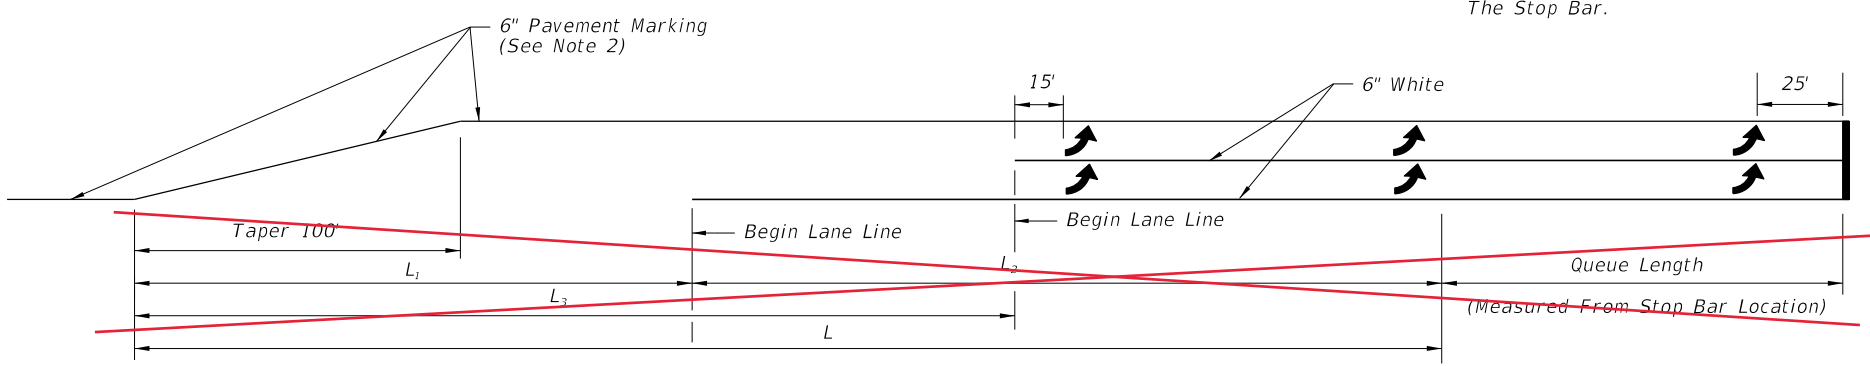

Delete redundant information shown in FDM Exhibit 212-1.

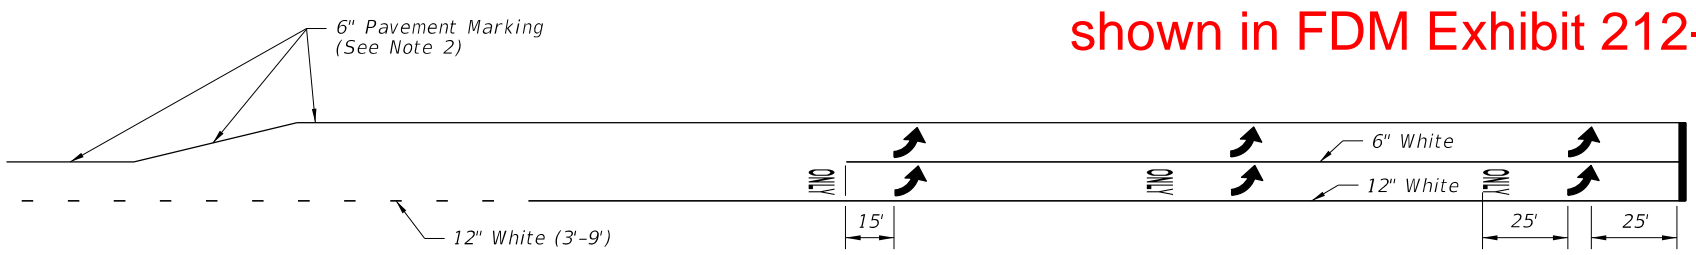


Through Lane Becomes Exclusive Left Turn

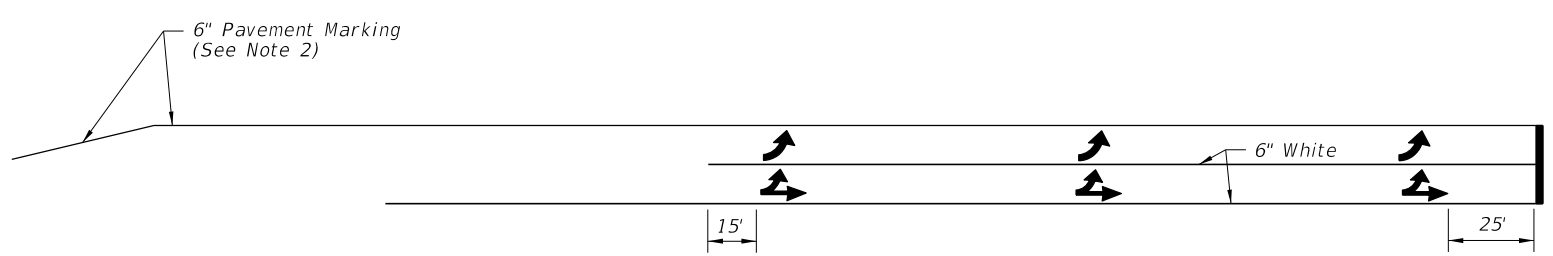

Through Lane Becomes Optional Left Turn

DOUBLE LEFT TURNS

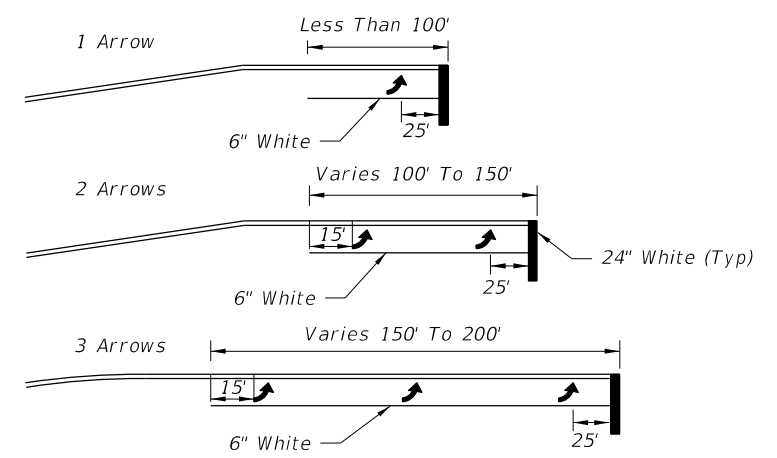

Arrow should be evenly spaced between first and last arrow. Turn lanes longer than 200' add one arrow for each 100' additional length.

ARROW SPACING

NOTES:

- 1. This Index also applies to right turn lanes.
- 2. Make pavement marking yellow for left-turn lanes and white for right-turn lanes.





TURN LANE MARKINGS

Added Title

ARROW SPACING AND TURN LANE MARKINGS

Renumbered

11/1/2017 2:33:16 PM

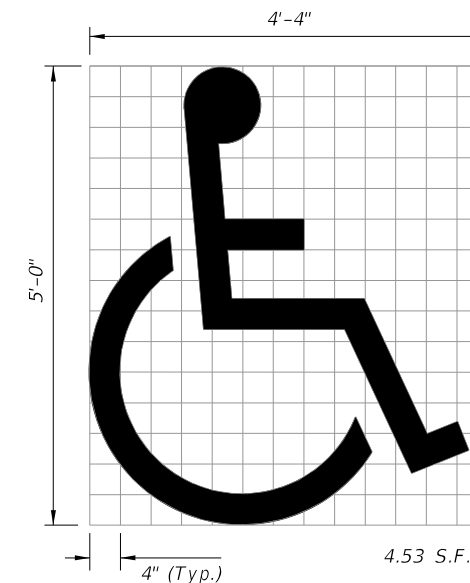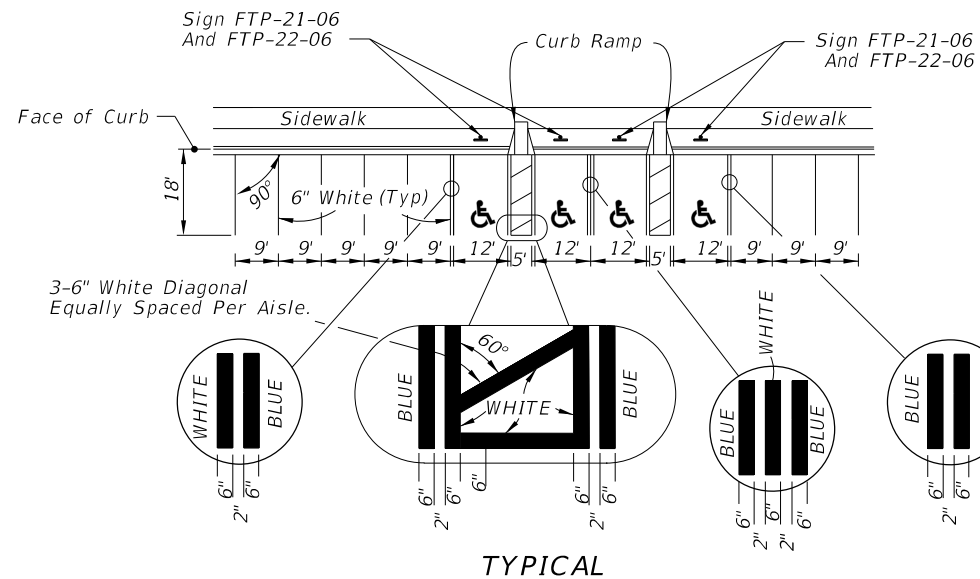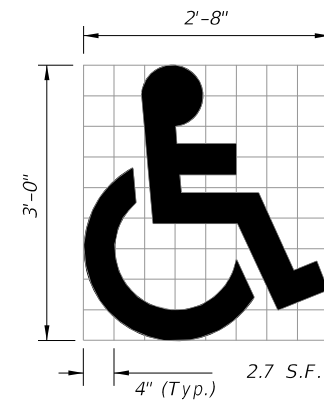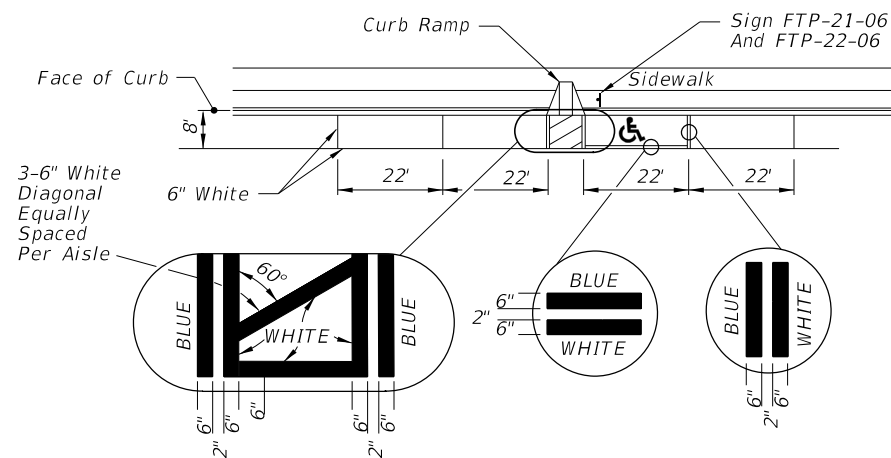


(See Note 6)

UNIVERSAL SYMBOL OF ACCESSIBILITY

NOTES:

1. Dimensions are to the centerline of markings.
2. An Access Aisle is required for each accessible space when angle parking is used.
3. Criteria for pavement markings only, not public sidewalk curb ramp locations. For ramp locations refer to plans.
4. Tint blue pavement markings to match color 15180 of Federal Standards 595a.
5. Mount FTP-22-06 sign below the FTP-21-06 sign.
6. Use of the pavement symbol in accessible parking spaces is optional. When pavement symbol is used, the symbol is either 3'-0" or 5'-0" high and white in color.

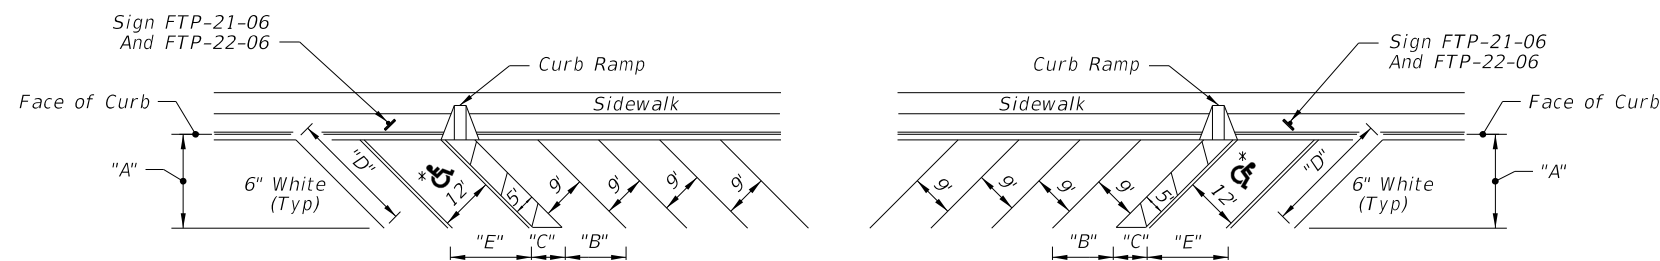

FORWARD-IN PARKING

REVERSE-IN PARKING

\* FOR ACCESSIBLE MARKINGS - SEE ABOVE

DIMENSIONS					
∠ θ	"A"	"B"	"C"	"D"	"E"
45°	17'-0"	12'-9"	7'-0"	24'-0"	17'-0"

PAVEMENT MARKING FOR PARKING

2/5/2021 11:53:53 AM

11/01/21

11 of 13

LAST REVISION	DESCRIPTION:
02/05/21	<del>Added railroad pavement marking details.</del>




FY 2021-22  
STANDARD PLANS

PAVEMENT MARKINGS

INDEX  
711-001

SHEET  
~~12 of 14~~


33 S.F.

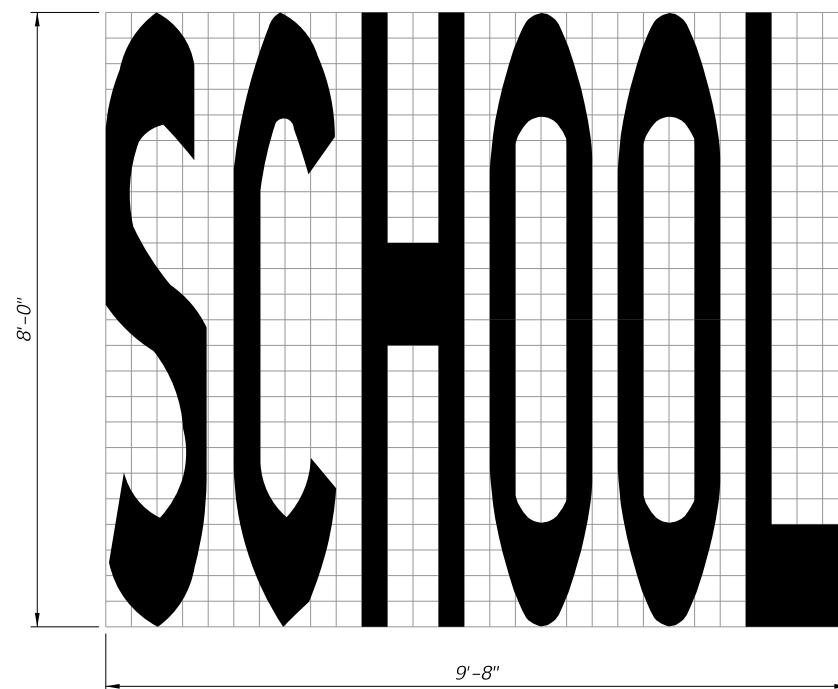


SCHOOL PAVEMENT MARKING

NOTES:


- 1. All grids are 4" x 4".
- 2. Pavement Marking Should Not Extend Into Opposing Lane.
- 3. Center School Pavement Marking in lane.

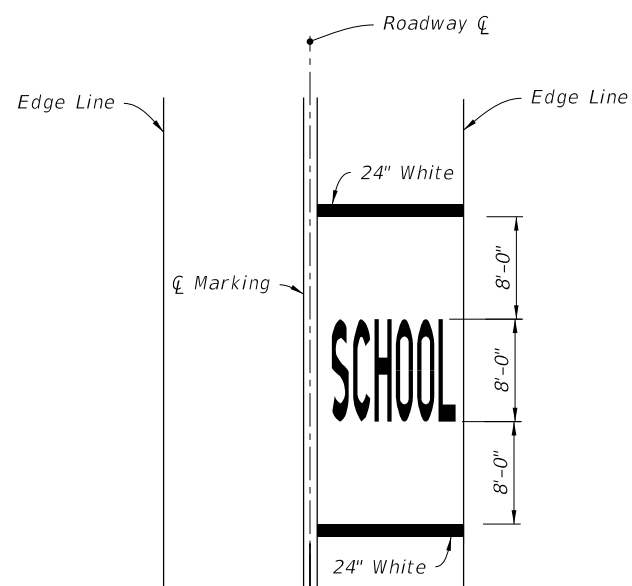

SINGLE-LANE APPROACH

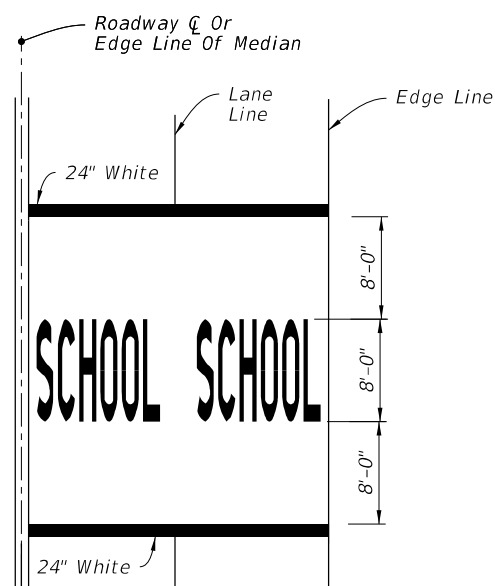

TWO-LANE APPROACH

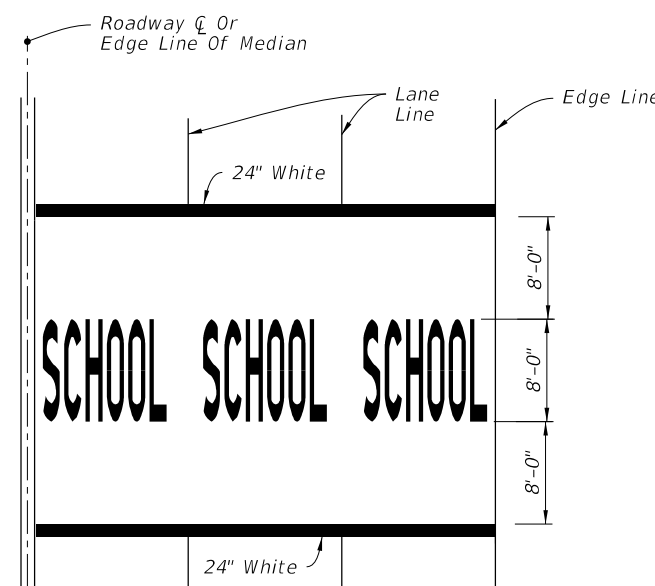

MULTI-LANE APPROACH  
(Three or More)

MARKINGS FOR SCHOOL ZONES

11:53:57 AM

2/5/2021

11/01/21

12 of 13


LAST REVISION <del>02/05/21</del>	REVISION	DESCRIPTION: <del>Added railroad pavement marking details.</del>
--------------------------------------	----------	---


**FY 2021-22**  
**STANDARD PLANS**



PAVEMENT MARKINGS

INDEX 711-001	SHEET <del>13 of 14</del>
------------------	------------------------------

**NOTE:**  
Orient Railroad Dynamic Envelope Marking as shown in the Plans.

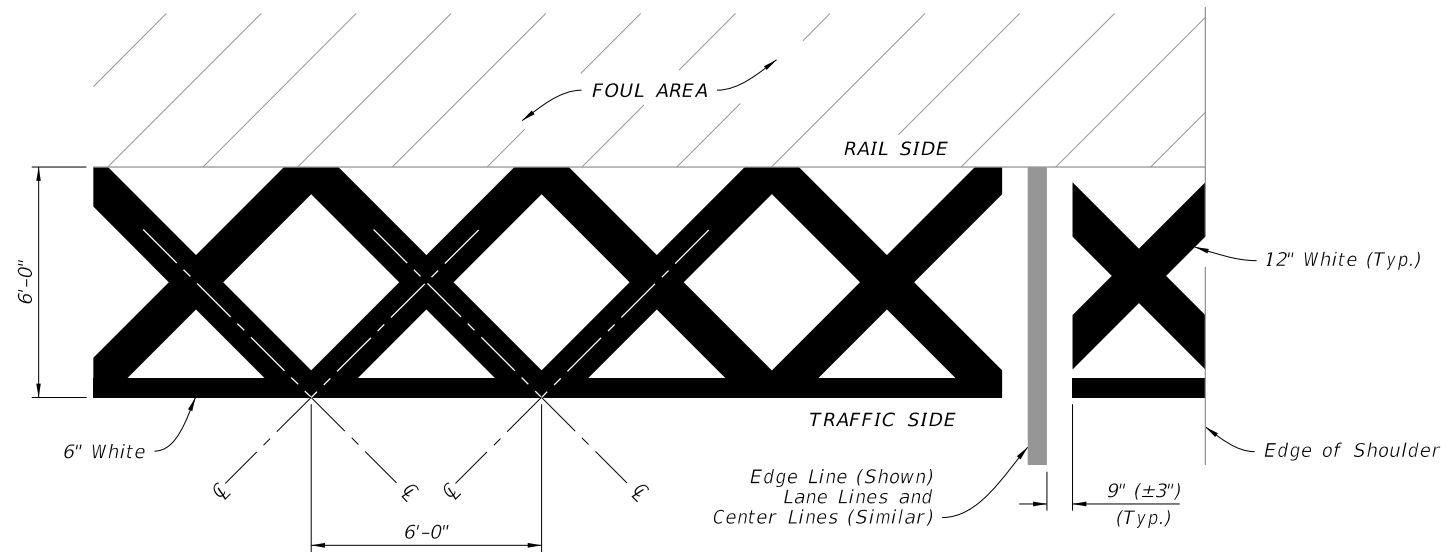

RAILROAD DYNAMIC ENVELOPE (RDE) PAVEMENT MARKING DETAIL

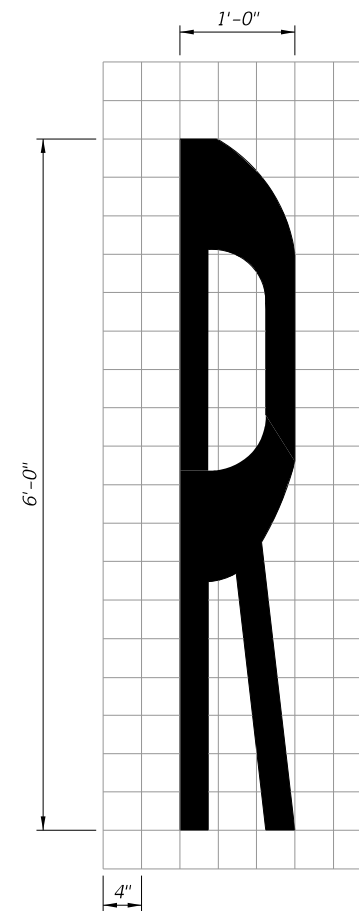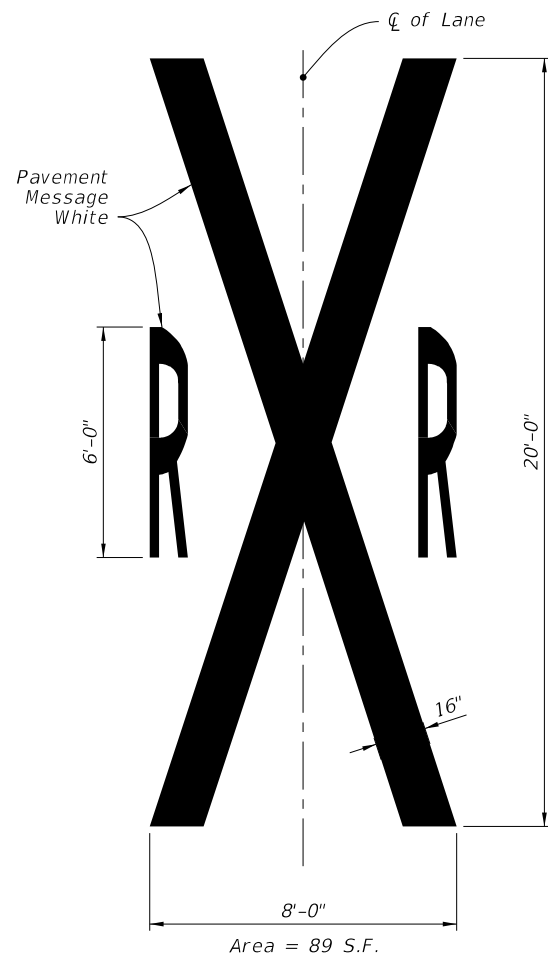


RAILROAD CROSSING PAVEMENT MESSAGE


2/5/2021 11:53:59 AM

11/01/21


13 of 13

LAST REVISION <del>02/05/21</del>	DESCRIPTION: <del>Added railroad pavement marking details.</del>	 FY 2021-22 STANDARD PLANS	PAVEMENT MARKINGS	INDEX 711-001	SHEET <del>14 of 14</del>
--------------------------------------	---	--	-------------------	------------------	------------------------------




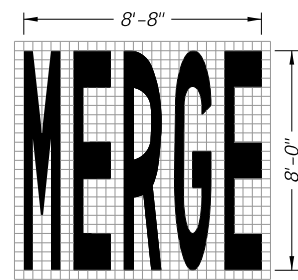


34 S.F.

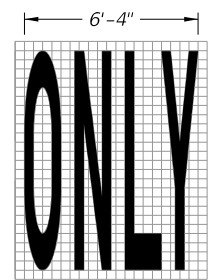


22 S.F.

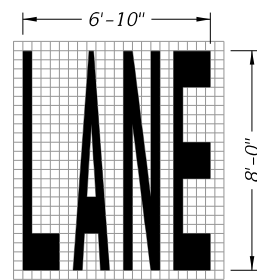


23 S.F.

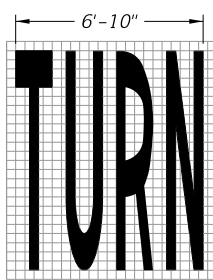


24 S.F.

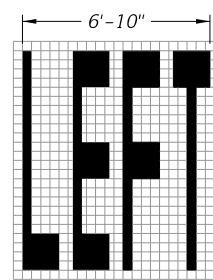

20 S.F.

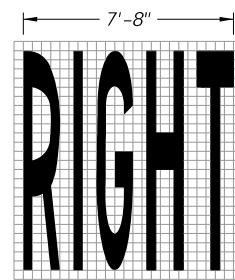


26 S.F.

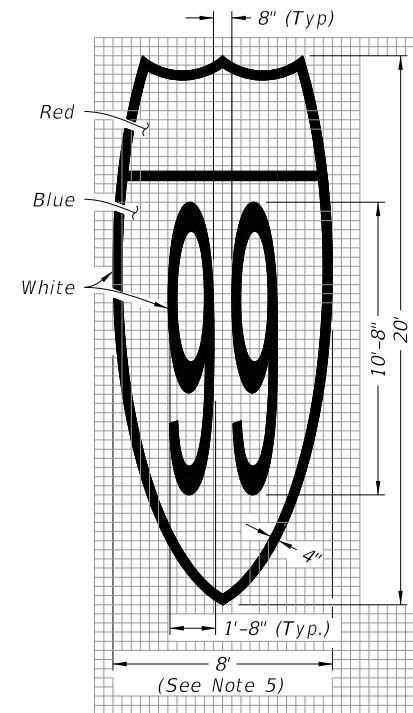


Route Shield for Limited Access Roadways (Interstate Route Shield Shown; U.S. and State Route Shield Similar)

128 S.F.

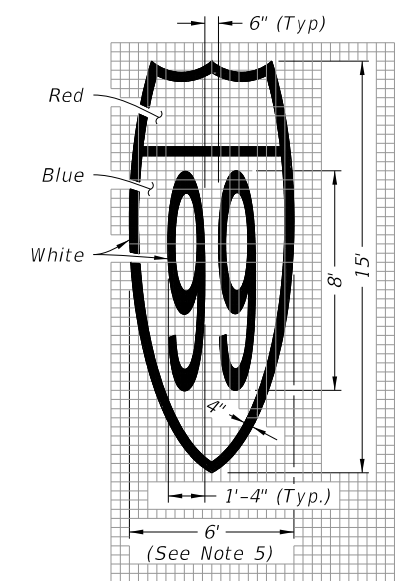


Route Shield for Arterials and Collectors (Interstate Route Shield Shown; U.S. and State Route Shield Similar)


72 S.F.

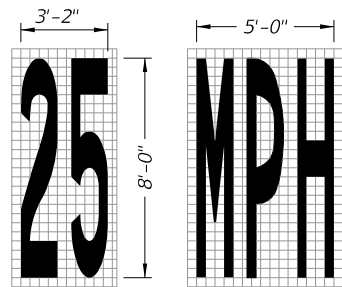


13 S.F.

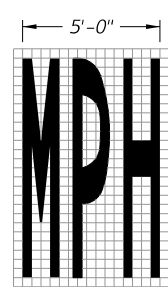


20 S.F.

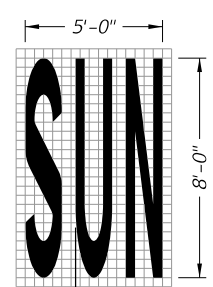


20 S.F.

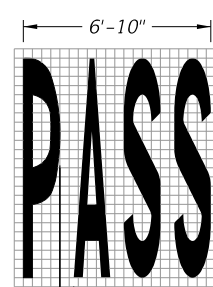


23 S.F.

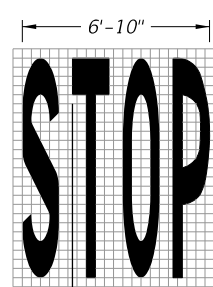


22 S.F.

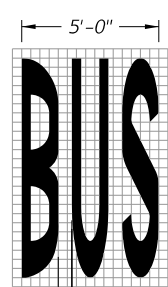


20 S.F.

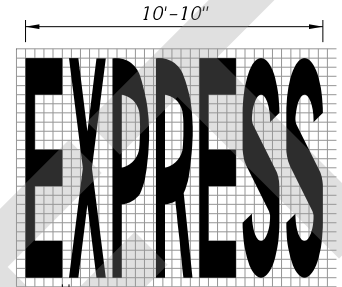


43 S.F.

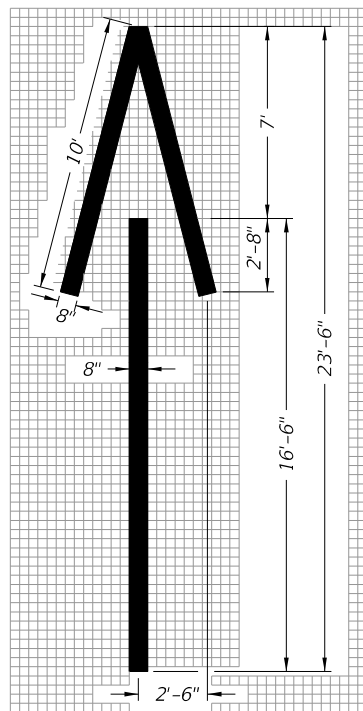

Wrong-Way Arrow 24 S.F.

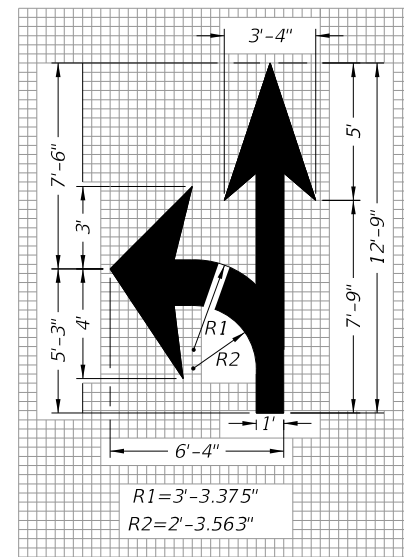


Turn and Through Lane-Use Arrow 29 S.F.

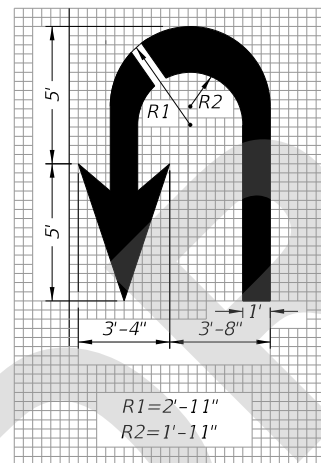


R1=2'-11" R2=1'-11"

U Turn Lane-Use Arrow 27 S.F.

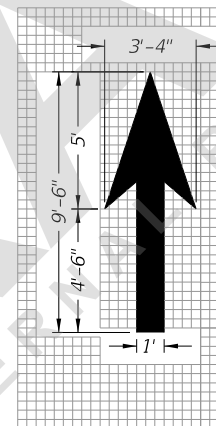


Through Lane-Use Arrow 12 S.F.

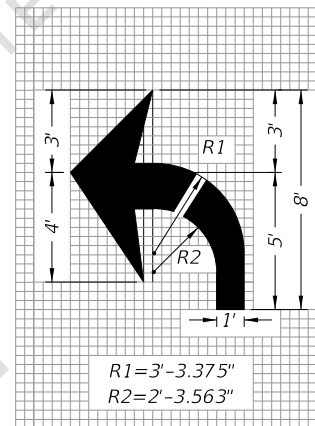


R1=3'-3.375" R2=2'-3.563"

Turn Lane-Use Arrow (Left Turn Shown - Right Turn Similar) 17 S.F.

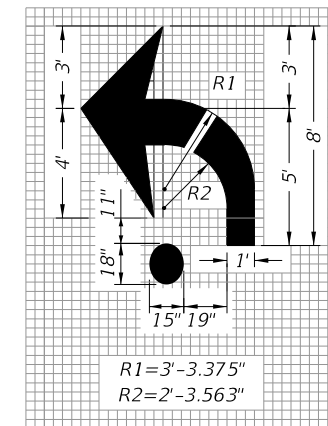

R1=3'-3.375" R2=2'-3.563"

Roundabout Approach Arrow 19 S.F.

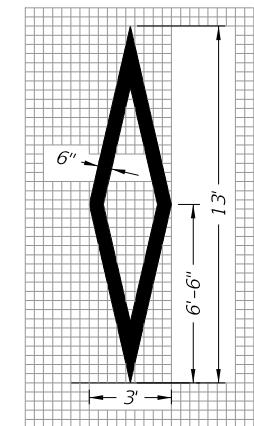

Preferential Lane Symbol 11 S.F.

PAVEMENT MESSAGES NOTES:

1. Place all pavement messages 25' back from the stop line.
2. Dimensions are within 1" ±.
3. All grids are 4" x 4".
4. All pavement messages must be white except route shields.
5. Increase width of route shield for routes with three digits.

PAVEMENT MESSAGE AND ARROW DETAILS




6/30/2021 11:04:29 AM

LAST REVISION 11/01/21	DESCRIPTION:
---------------------------	--------------

FDOT  
FY 2022-23  
STANDARD PLANS

PAVEMENT MARKINGS

INDEX 711-001	SHEET 1 of 13
------------------	------------------

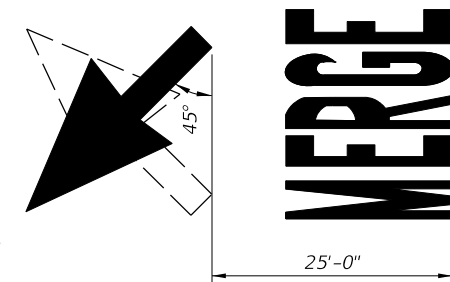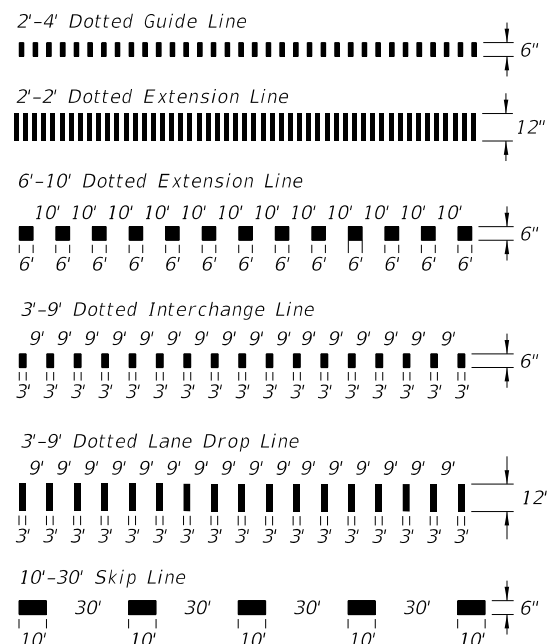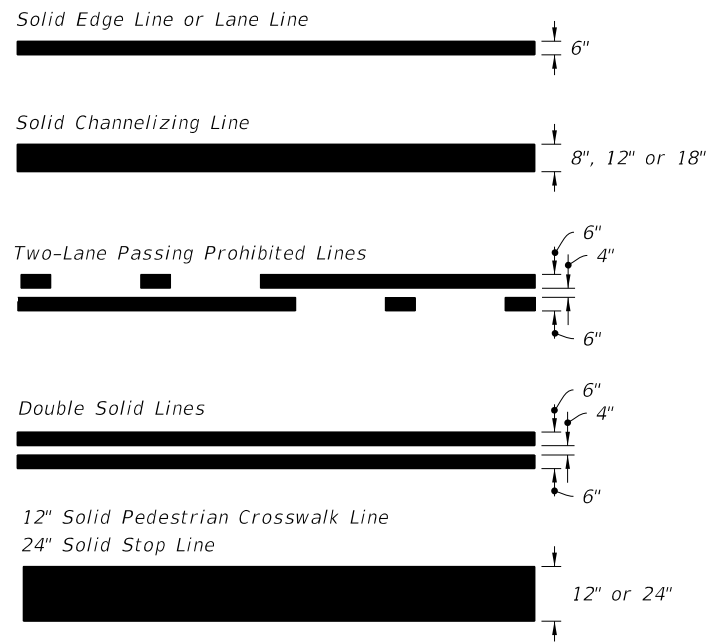


PAVEMENT MARKING LINES


MARKINGS FOR MERGE



10'-30' SKIP LINE WITH SHADOW MARKINGS

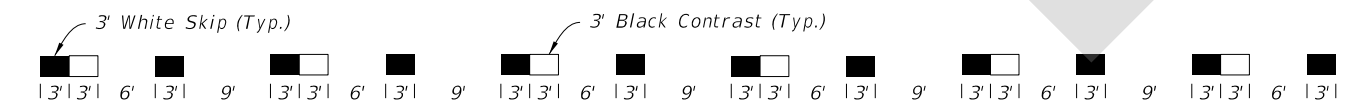

DOTTED LINE WITH ALTERNATING SHADOW MARKINGS  
(3'-9' Dotted Line Shown, Other Dotted Lines Similar)

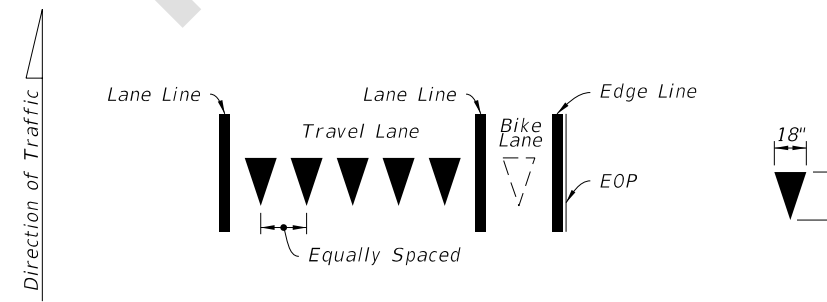

Yield Lines consist of five - 18" X 27" white triangles which face traffic. Equally space triangles within traffic lane. When a bike lane is present, add one additional triangle in the center of the bike lane.

YIELD LINES

6/28/2021 7:39:12 AM

LAST REVISION 11/01/21	DESCRIPTION:
---------------------------	--------------




FY 2022-23  
STANDARD PLANS


PAVEMENT MARKINGS

INDEX  
711-001


SHEET  
2 of 13

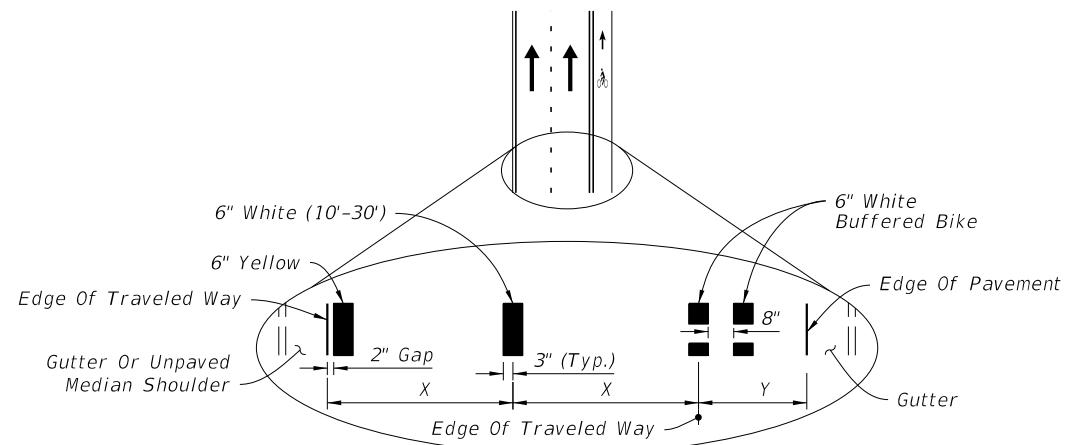

**CURB AND GUTTER**

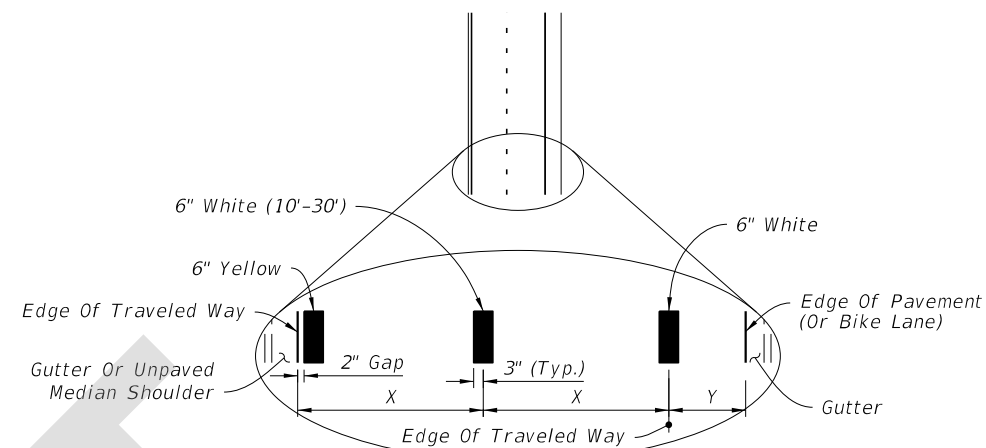


**CURB AND GUTTER**

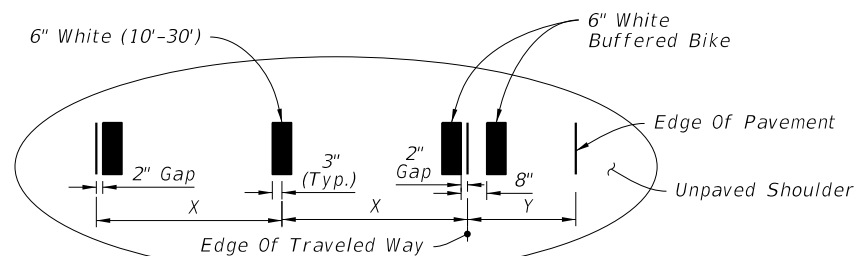

**FLUSH SHOULDER**

X = LANE WIDTH (FT.)  
Y = BUFFERED BIKE LANE WIDTH (FT.)

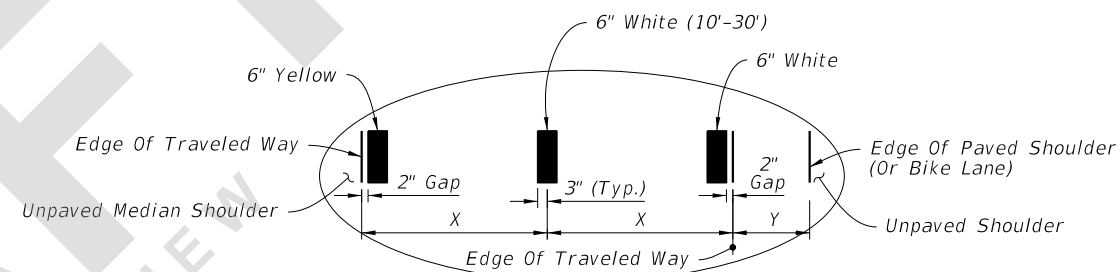


**FLUSH SHOULDER**

X = LANE WIDTH (FT.)  
Y = PAVED SHOULDER / BIKE LANE

==== STRIPING FOR BUFFERED BIKE LANE =====

==== STRIPING WITH SHOULDER OR NON-BUFFERED BIKE LANE =====

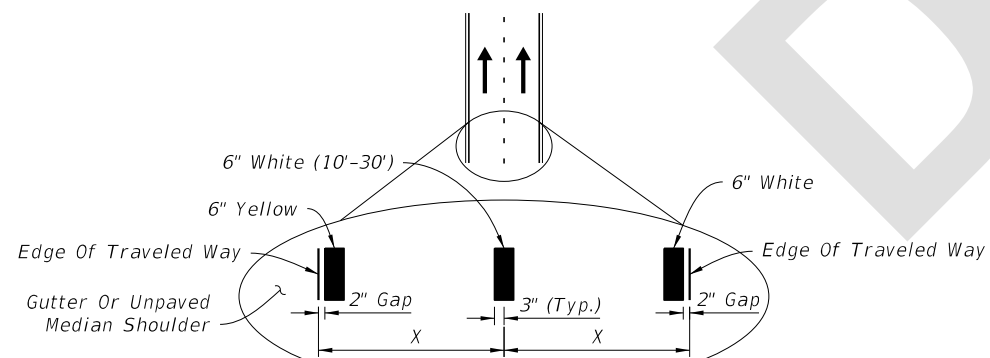

X = LANE WIDTH (FT.)

==== STRIPING WITH NO SHOULDER OR BIKE LANE =====

**NOTES:**

1. Lane widths (X) may not be same for each lane in the section.
2. For placement of RPMs, see Index 706-001.

6/28/2021 7:39:14 AM

LAST REVISION 11/01/21	REVISION	DESCRIPTION:
---------------------------	----------	--------------




FY 2022-23  
STANDARD PLANS

PAVEMENT MARKINGS

INDEX  
711-001

SHEET  
3 of 13


**PLACEMENT OF LONGITUDINAL PAVEMENT MARKINGS**

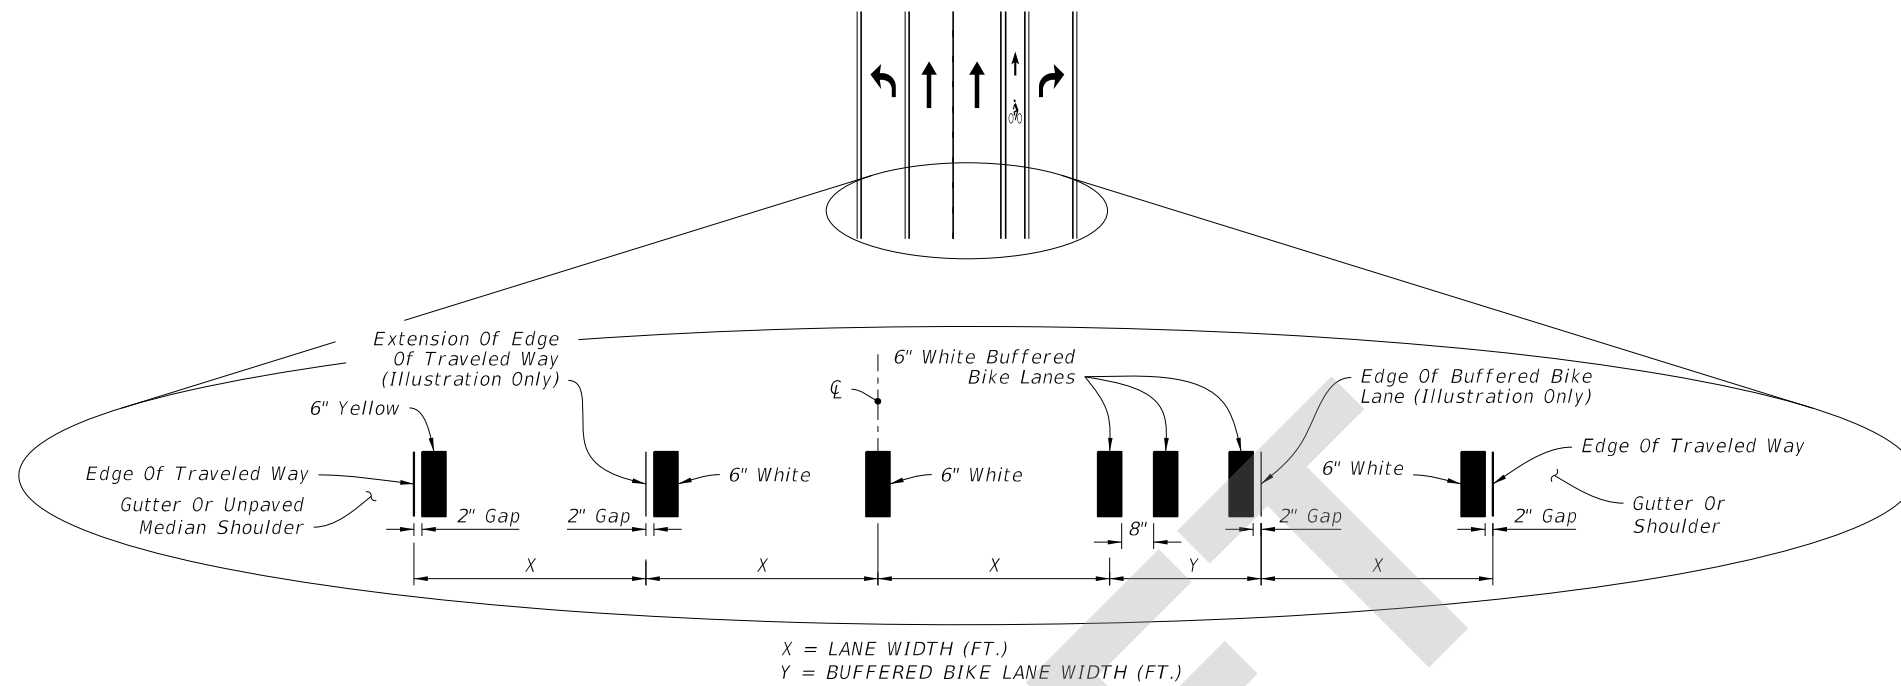

**INTERSECTION APPROACH STRIPING WITH TURN LANES AND BUFFERED BIKE LANE KEY HOLE**

**NOTES:**


1. Lane widths (X) may not be same for each lane in the section.
3. For placement of RPMs, see Index 706-001.
4. For placement of Express Lane markers and associated RPMs, see the Plans.

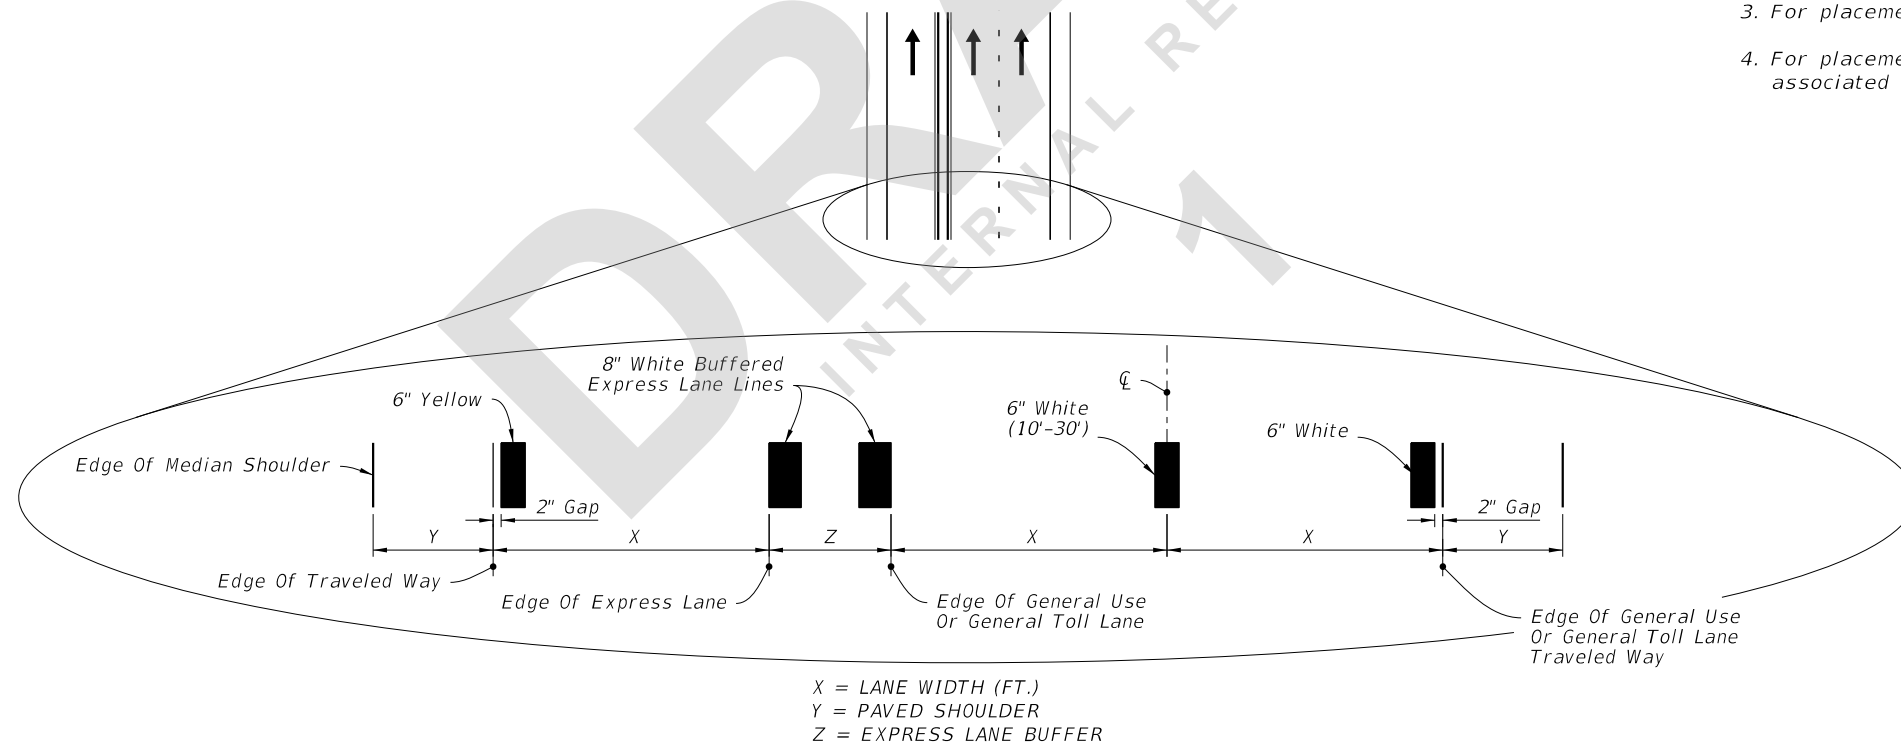


**BUFFERED EXPRESS LANE STRIPING**

**PLACEMENT OF LONGITUDINAL PAVEMENT MARKINGS**

6/28/2021 7:39:16 AM

LAST REVISION 11/01/21	DESCRIPTION:	 FY 2022-23 STANDARD PLANS	PAVEMENT MARKINGS	INDEX 711-001	SHEET 4 of 13
---------------------------	--------------	--	-------------------	------------------	------------------

6/28/2021 7:39:18 AM

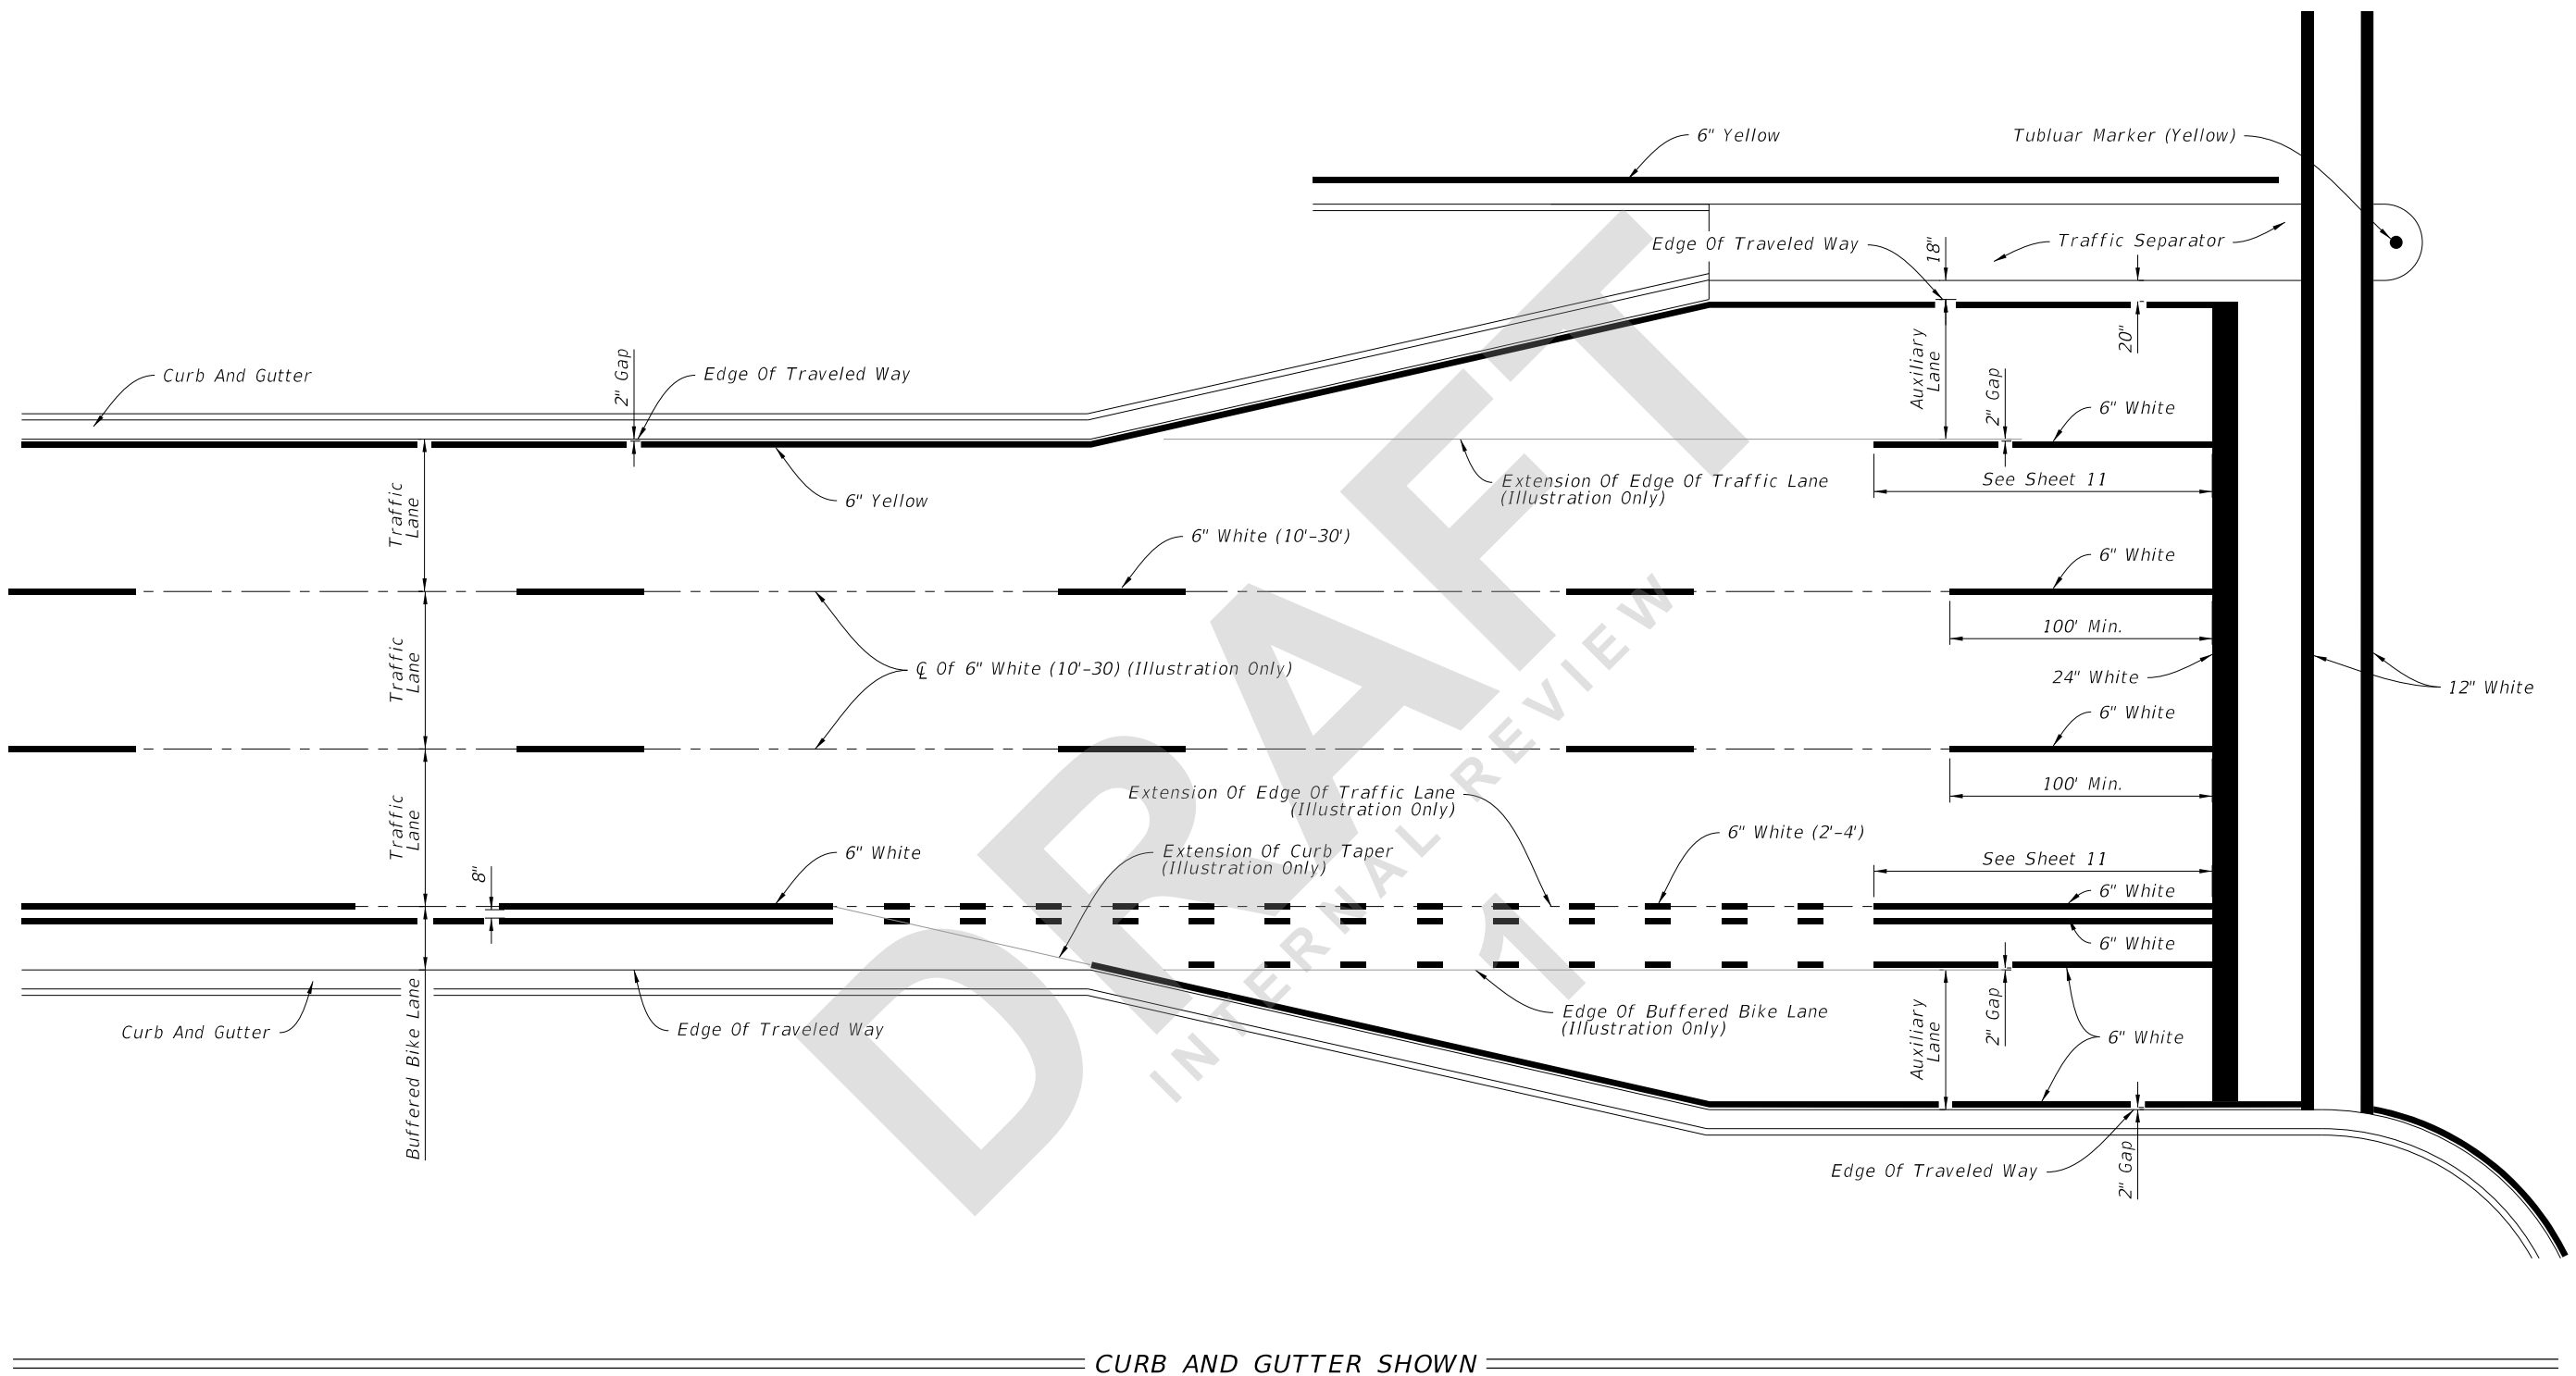

PLACEMENT OF LONGITUDINAL PAVEMENT MARKINGS

LAST REVISION 11/01/21	REVISION	DESCRIPTION:
---------------------------	----------	--------------




FY 2022-23  
STANDARD PLANS

PAVEMENT MARKINGS

INDEX  
711-001

SHEET  
5 of 13

6/28/2021 7:39:20 AM

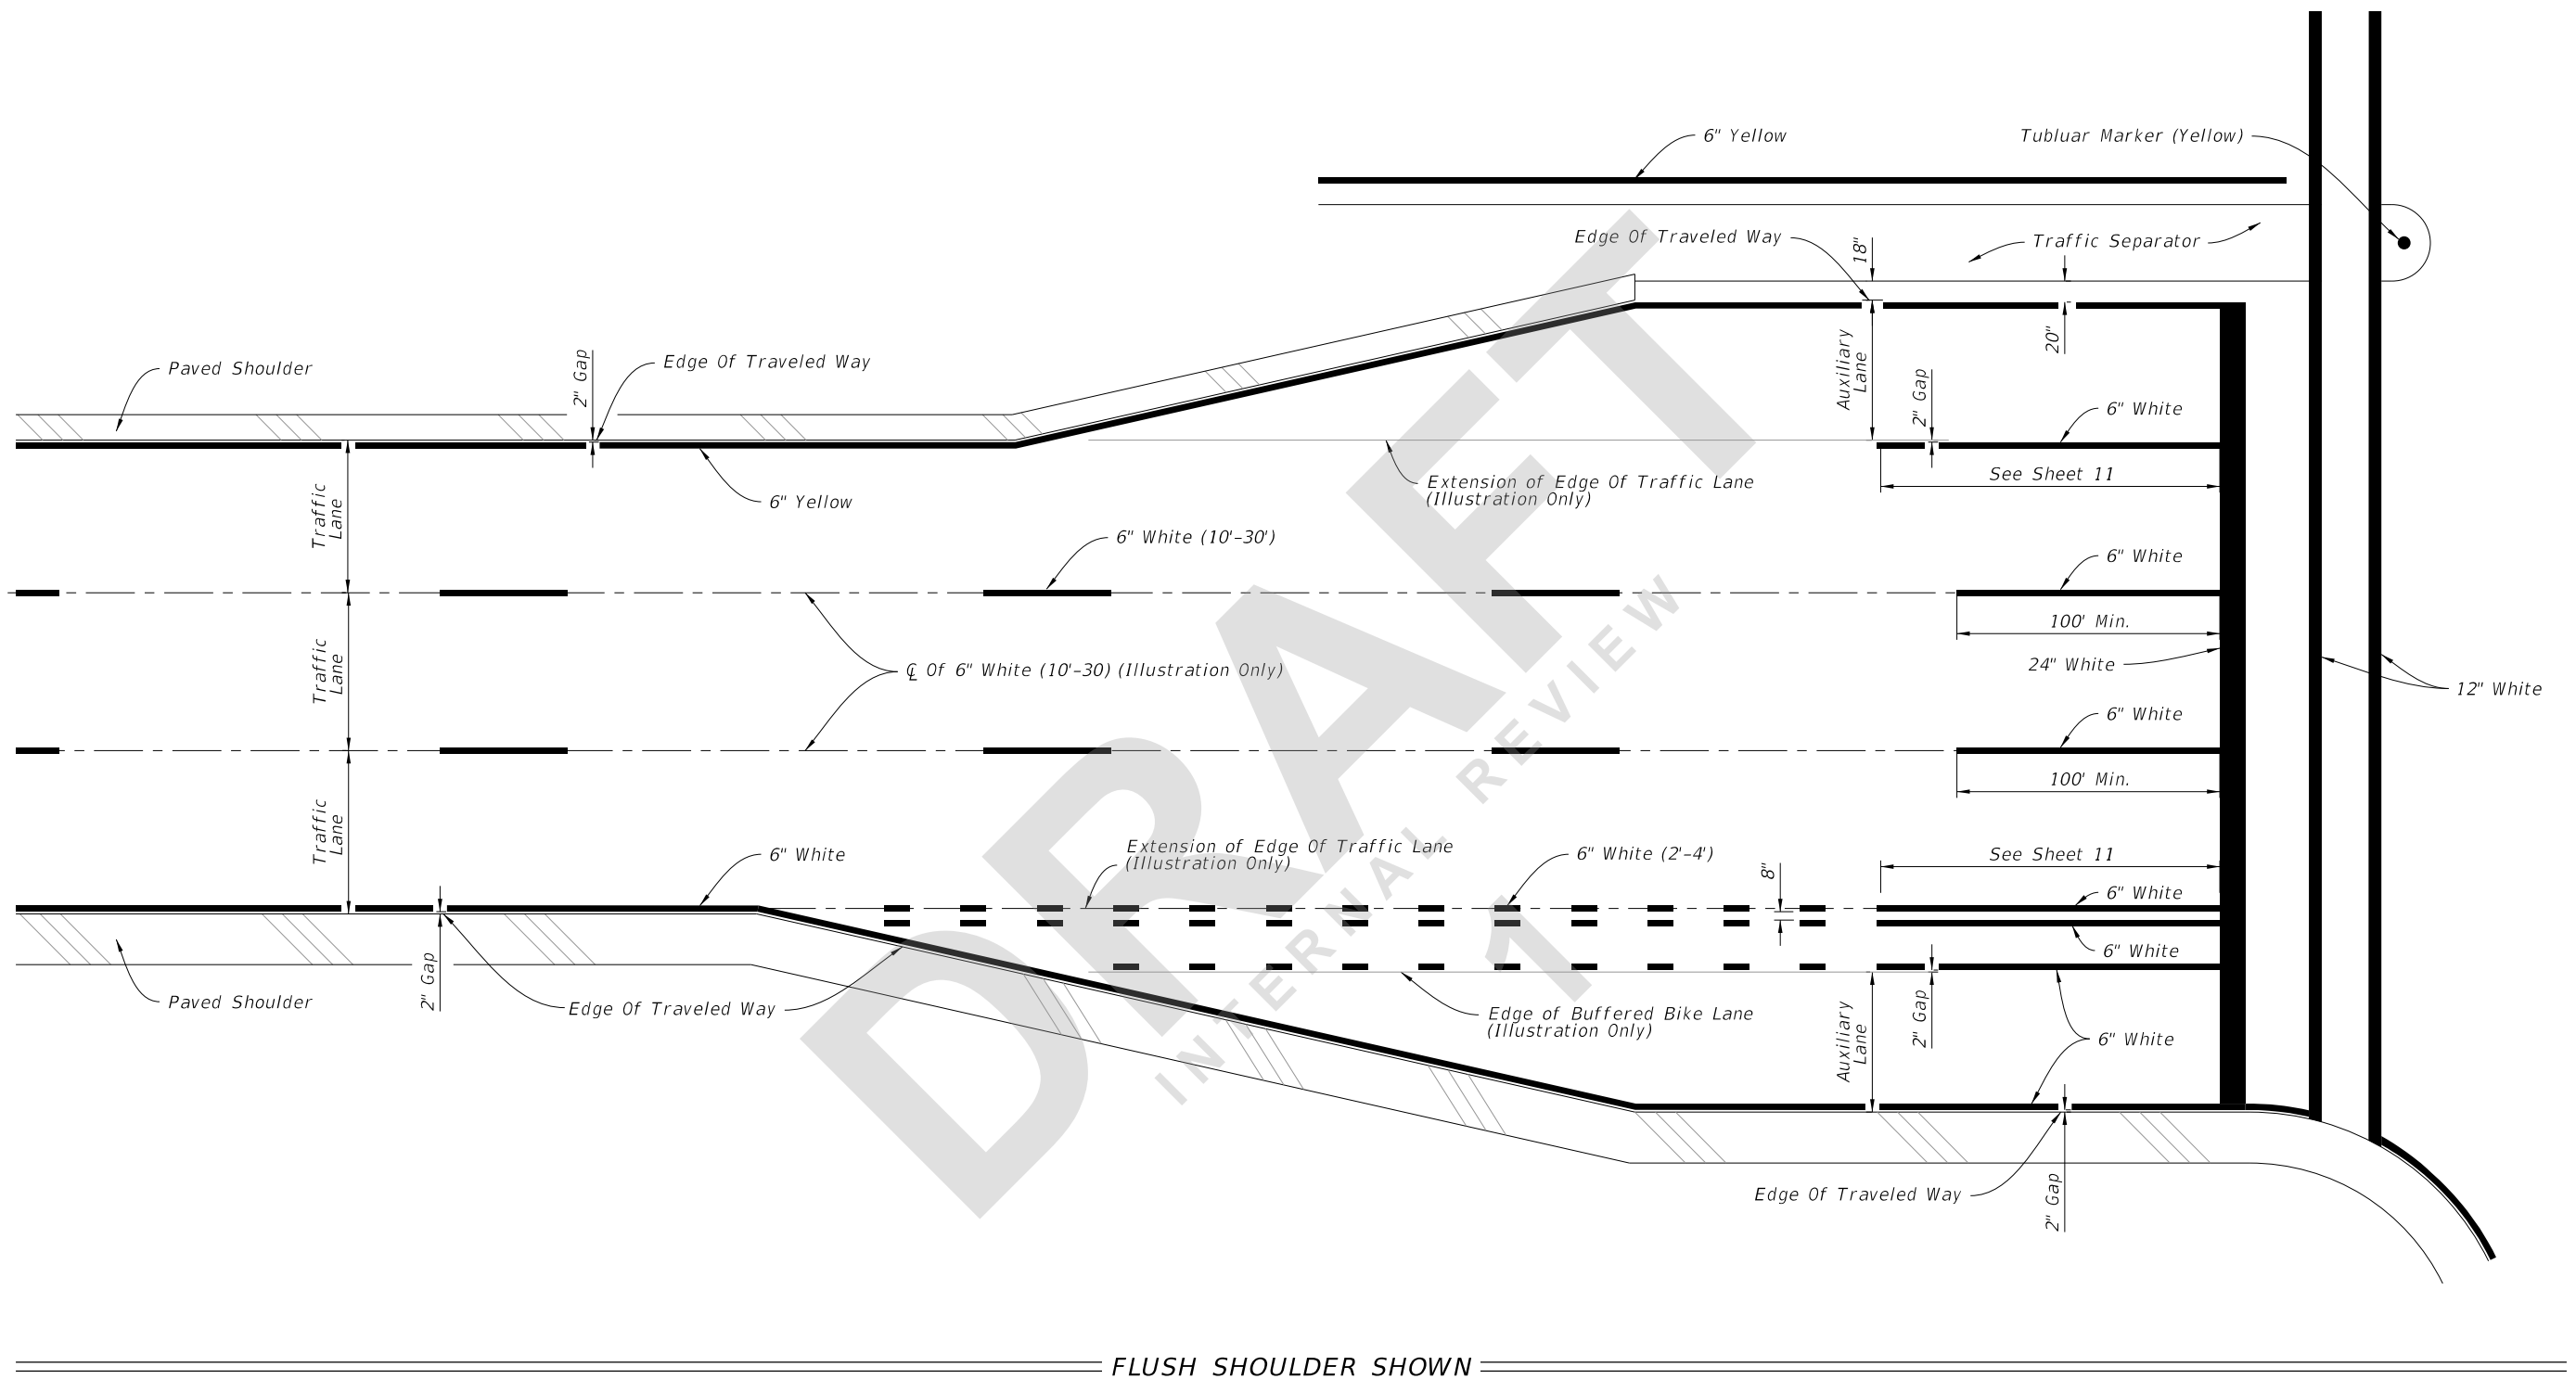

PLACEMENT OF LONGITUDINAL PAVEMENT MARKINGS

LAST REVISION 11/01/21	REVISION	DESCRIPTION:
---------------------------	----------	--------------






FY 2022-23  
STANDARD PLANS

PAVEMENT MARKINGS

INDEX  
711-001


SHEET  
6 of 13

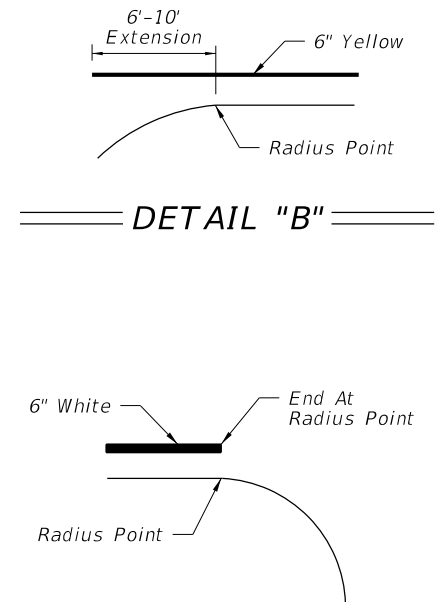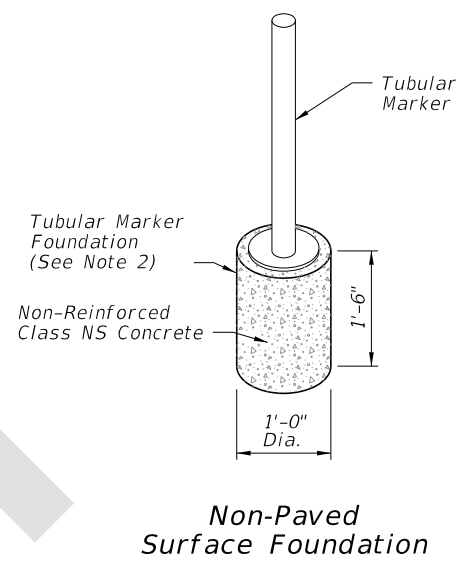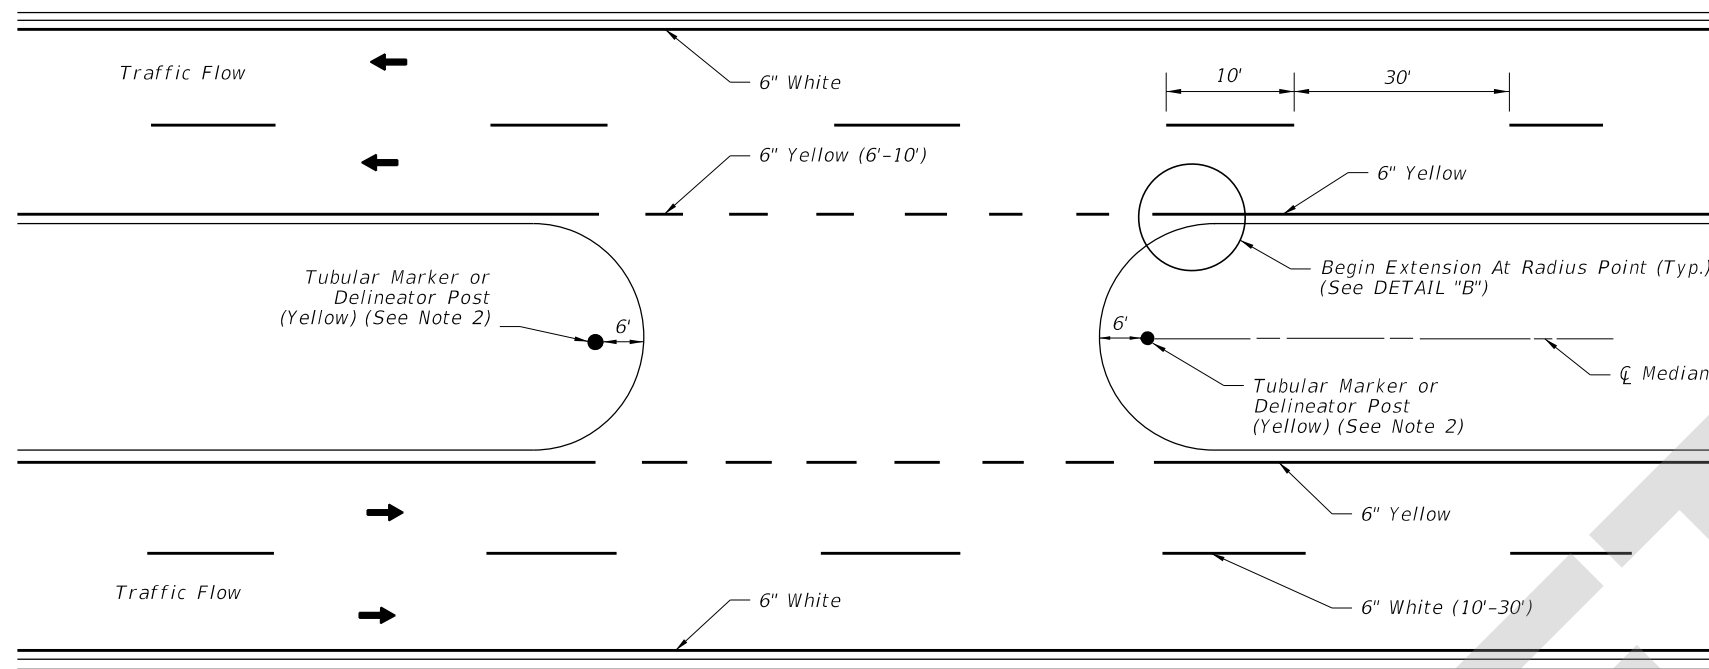

PAVEMENT MARKINGS AND DELINEATORS FOR MEDIAN CROSSOVER

DETAIL "A"

DETAIL "C"

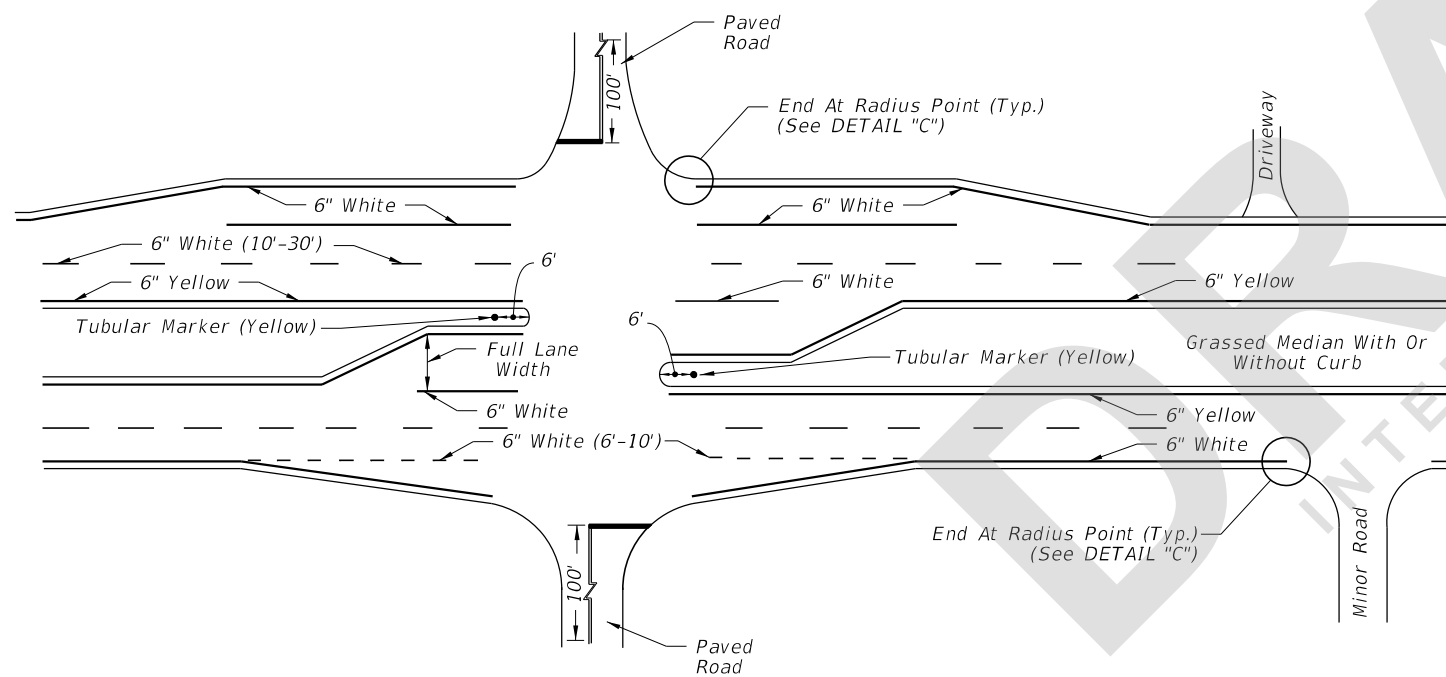

NOTE:


1. Apply yellow reflective paint to the noses of curbed medians, traffic separators, and raised islands. When applying yellow reflective paint in conjunction with Raised Pavement Markers, see Index 706-001.
2. Options for grassed medians:
  - A. Option 1: Tubular Marker (Yellow). Attach Tubular Marker according to manufacturer's instructions. Non-Paved Surface Foundation (See Detail "A") is provided as an option if no other suitable surface is provided. Install Non-Paved Surface Foundation flush with the surrounding ground surface.
  - B. Option 2: Delineator Post. Use yellow retro-reflective sheeting on both sides of the delineator. Install the post so that the top is 4'-0" above the grade at the edge of the pavement.
3. Extend double yellow centerlines 100' back from intersection on all approaches or 50' for unmarked cross roads.

PAVEMENT MARKINGS FOR INTERSECTIONS WITH MAJOR AND MINOR ROADS

6/28/2021 7:39:22 AM


LAST REVISION 11/01/21	REVISION	DESCRIPTION:		FY 2022-23 STANDARD PLANS	PAVEMENT MARKINGS	INDEX 711-001	SHEET 7 of 13
---------------------------	----------	--------------	--	------------------------------	-------------------	------------------	------------------

Use Stop Line  
At Signalized  
Intersection  
Only

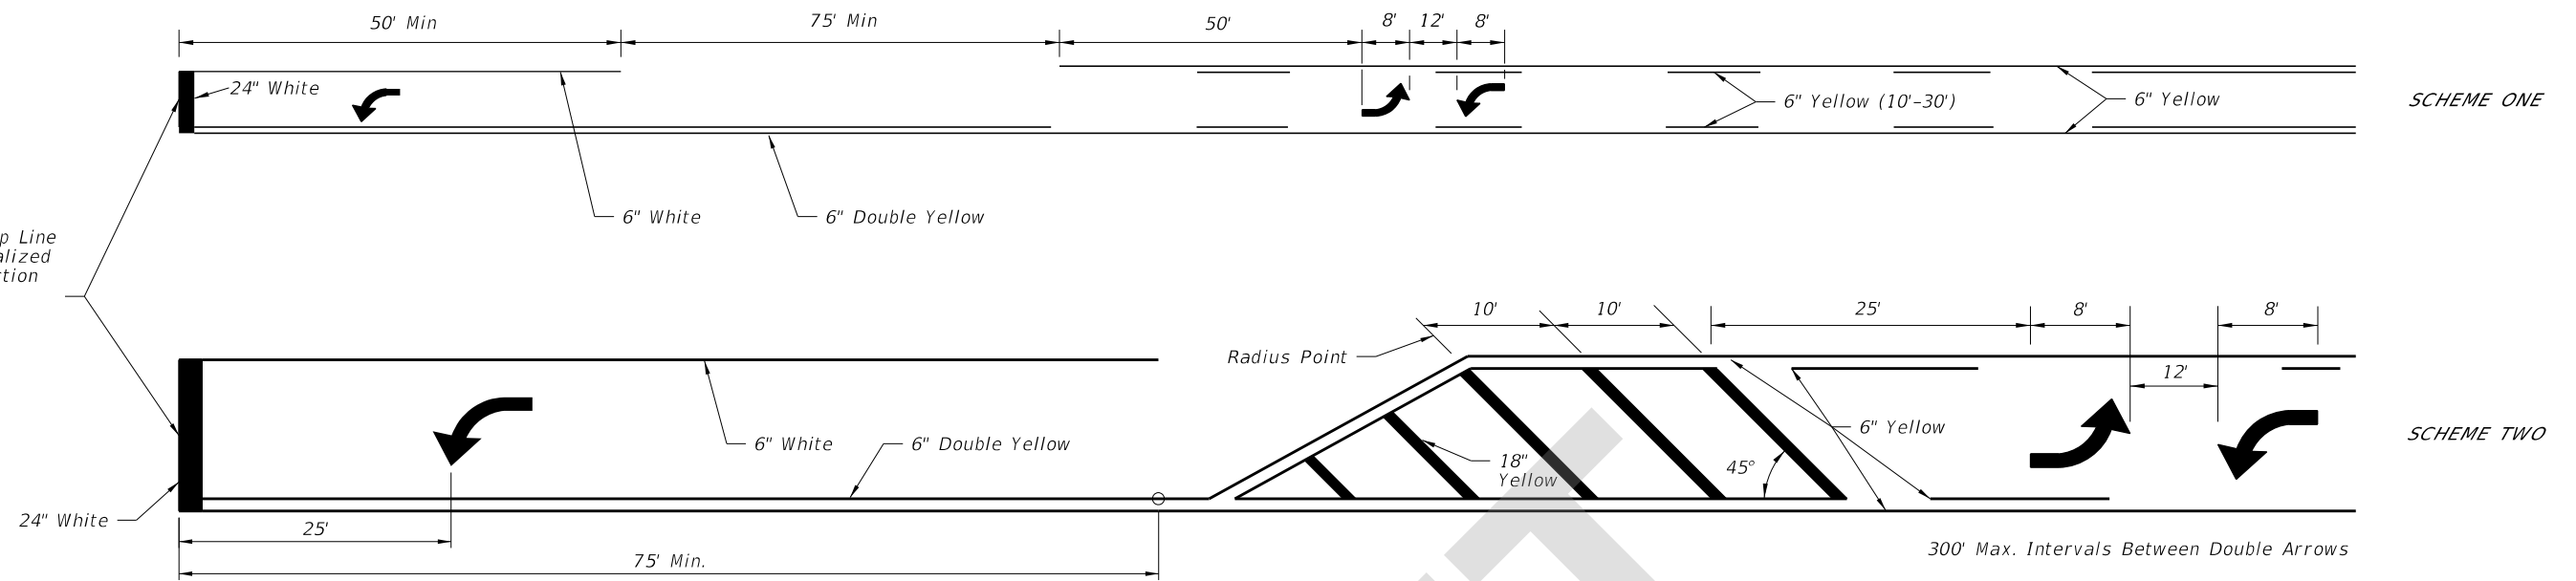


**TWO WAY LEFT TURN LANE**  
(With Single Lane Left Turn Channelization)

POSTED SPEED LIMIT MPH	"Y" (FT.)
30 OR LESS	10
35	20
40	20
45	30
50 OR MORE	40

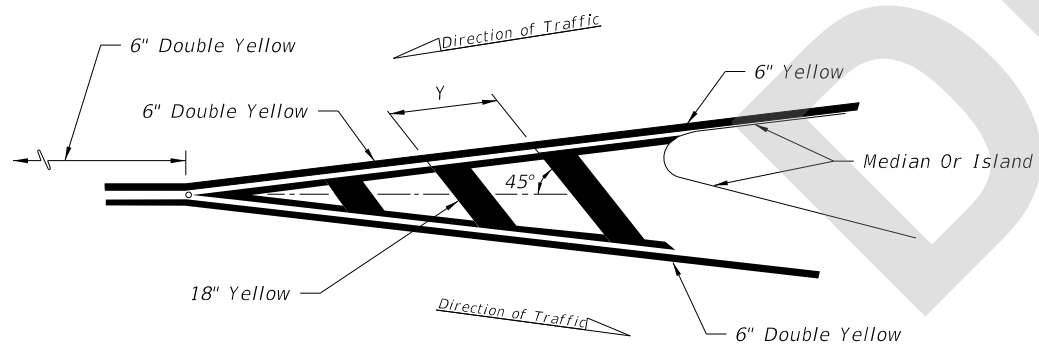

MARKINGS FOR TRAFFIC SEPARATION

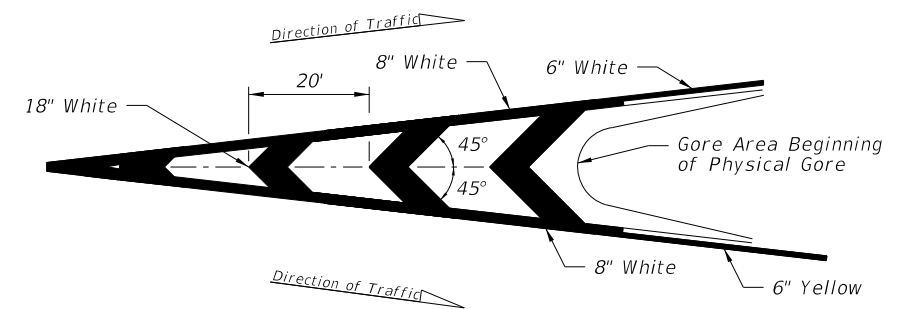

TRAFFIC CHANNELIZATION AT GORE

6/28/2021 7:39:26 AM

LAST REVISION	DESCRIPTION:
11/01/21	




FY 2022-23  
STANDARD PLANS

PAVEMENT MARKINGS


INDEX  
711-001

SHEET  
8 of 13



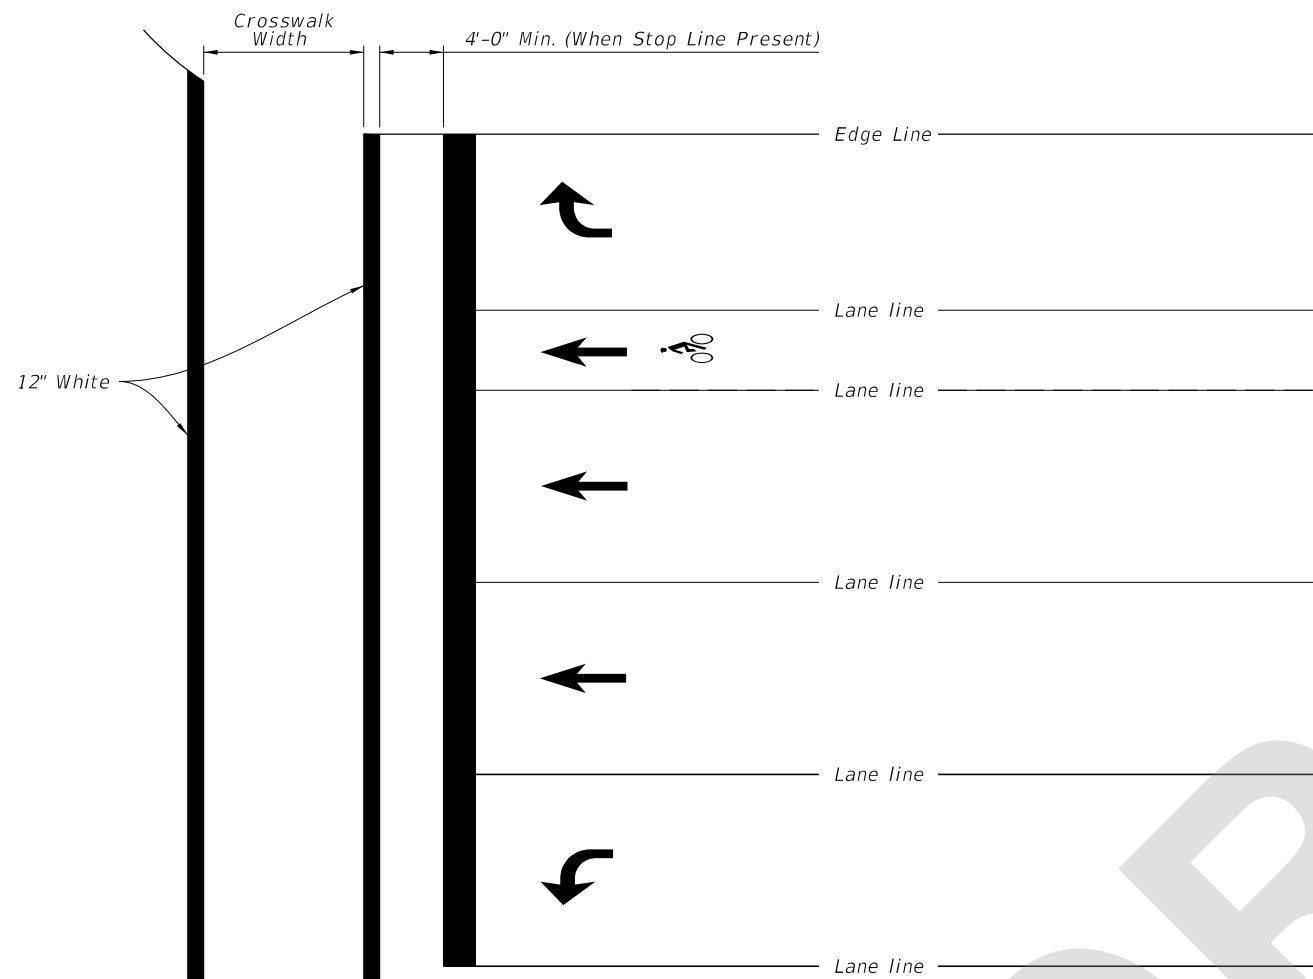

STANDARD CROSSWALK DETAILS

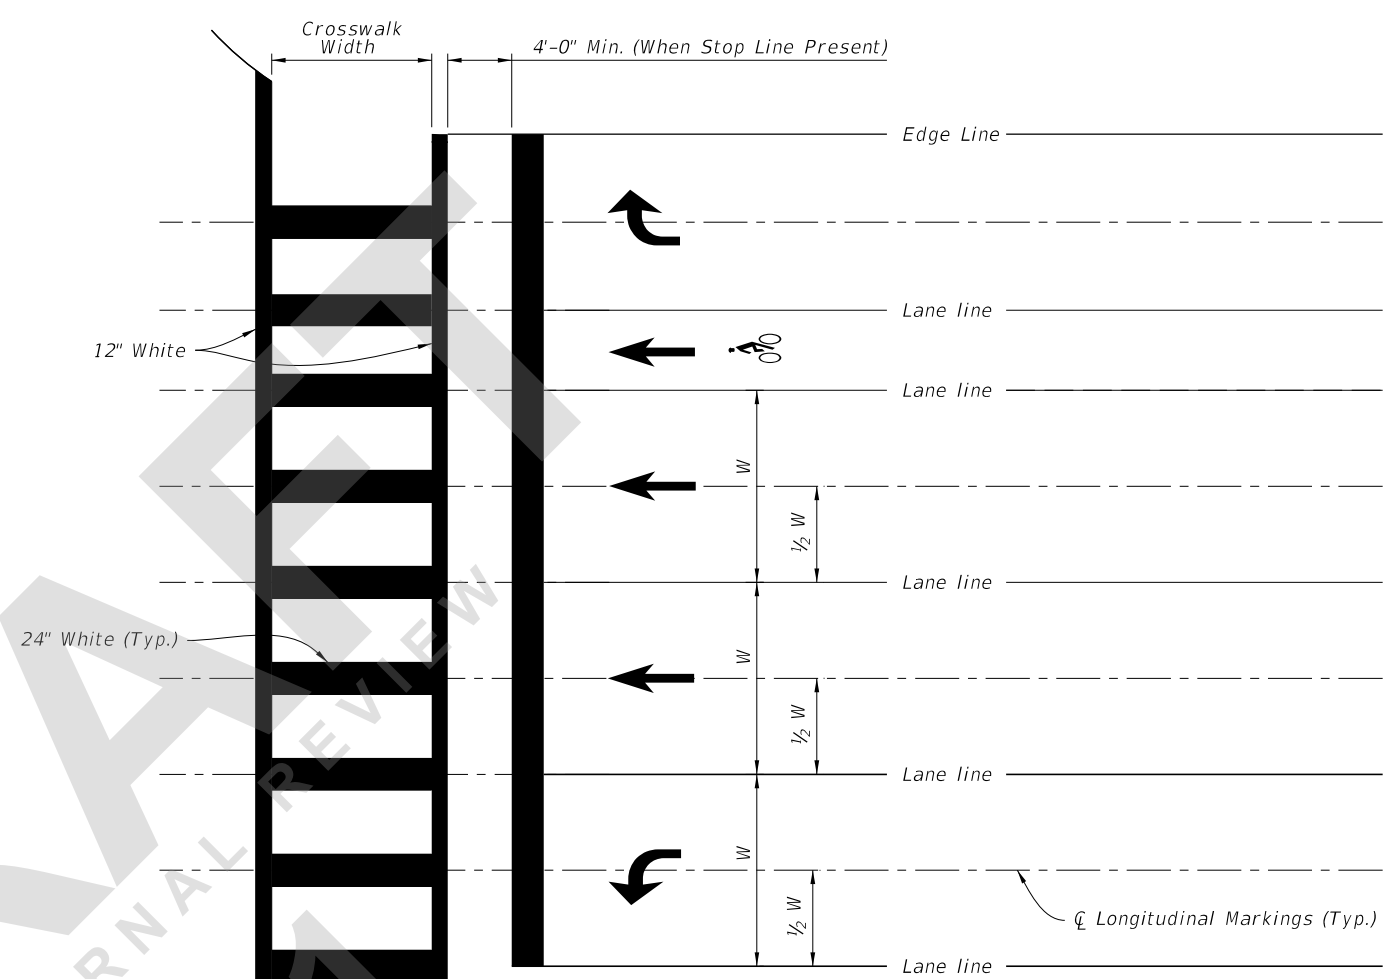


SPECIAL EMPHASIS CROSSWALK DETAILS

**NOTES:**


1. For crosswalk width, exceed width of the adjacent sidewalk, but do not make width less than 6' for intersection crosswalks and 10' for midblock crosswalks. Measure width from the inside of the transverse crosswalk markings.
2. When the Special Emphasis Crosswalk is not perpendicular to the lane lines, make the longitudinal markings parallel to the lane lines.
3. Refer to Index 522-002 when Curb Ramps are present.

6/28/2021 7:39:29 AM


LAST REVISION 11/01/21	REVISION	DESCRIPTION:	 FY 2022-23 STANDARD PLANS	PAVEMENT MARKINGS	INDEX 711-001	SHEET 9 of 13
---------------------------	----------	--------------	---	-------------------	------------------	------------------

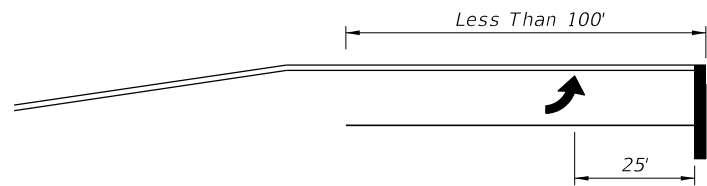

1 ARROW

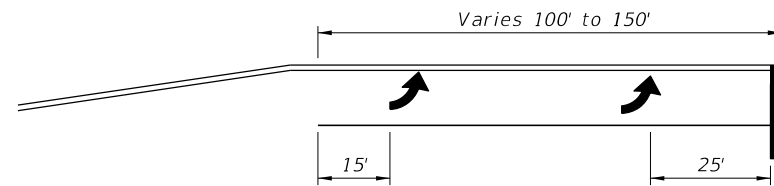


2 ARROW

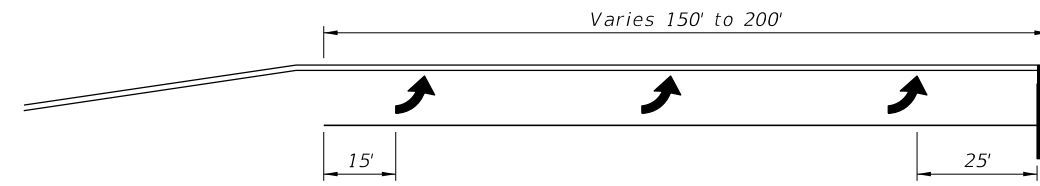


3 ARROW

Arrow should be evenly spaced between first and last arrow. Turn lanes longer than 200' add one arrow for each 100' additional length.

ARROW SPACING

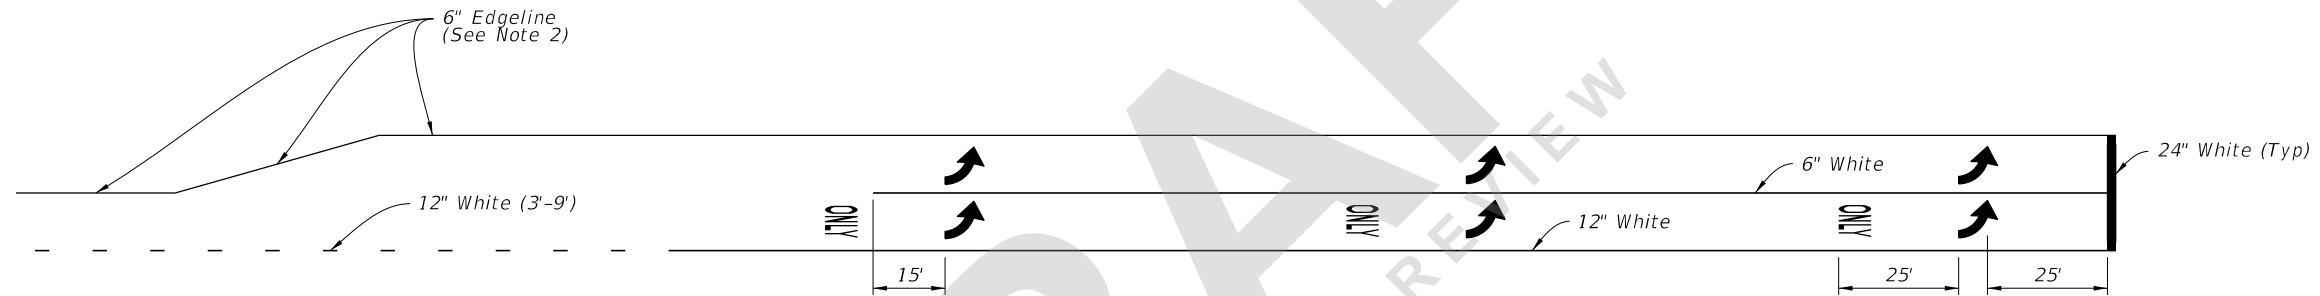

Through Lane Becomes Exclusive Left Turn

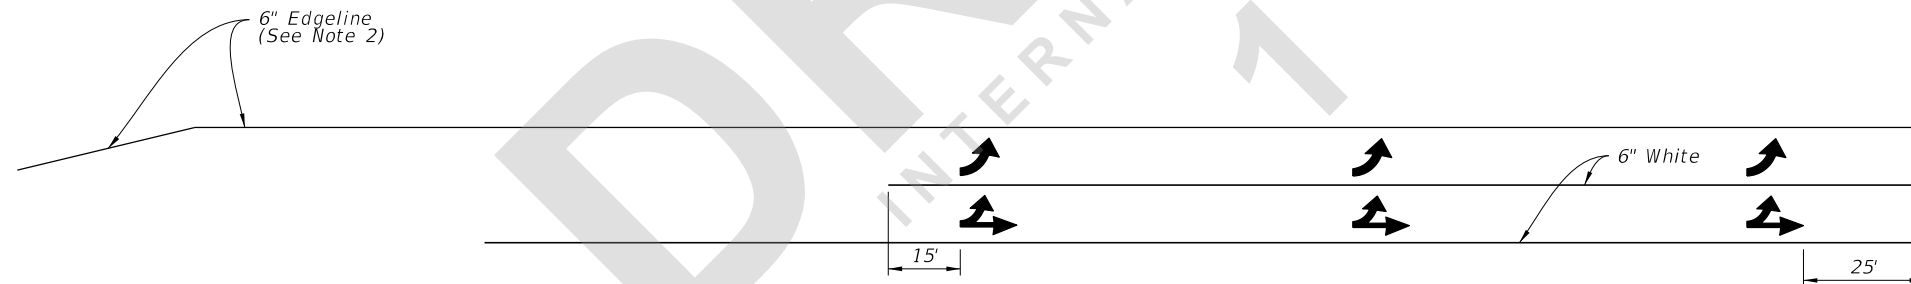

Through Lane Becomes Optional Left Turn (Drop Lane)


TURNS LANE MARKINGS





NOTES:

1. This Index also applies to right turn lanes.
2. Make Edgeline pavement markings yellow for left-turn lanes and white for right-turn lanes.

ARROW SPACING AND TURN LANE MARKINGS

6/29/2021 1:56:43 PM

LAST REVISION 11/01/21	REVISION	DESCRIPTION:	 FY 2022-23 STANDARD PLANS	PAVEMENT MARKINGS	INDEX 711-001	SHEET 10 of 13
---------------------------	----------	--------------	---	-------------------	------------------	-------------------

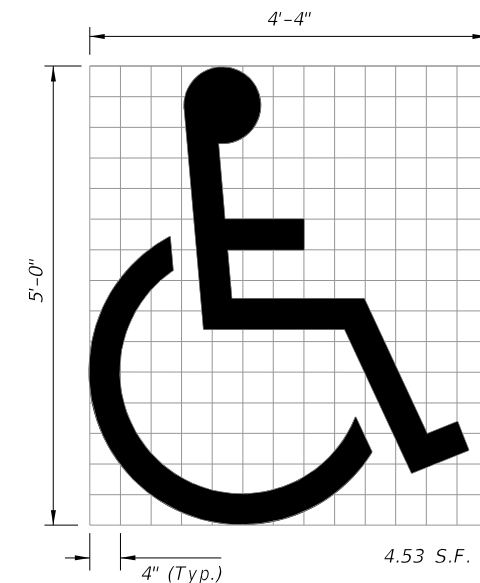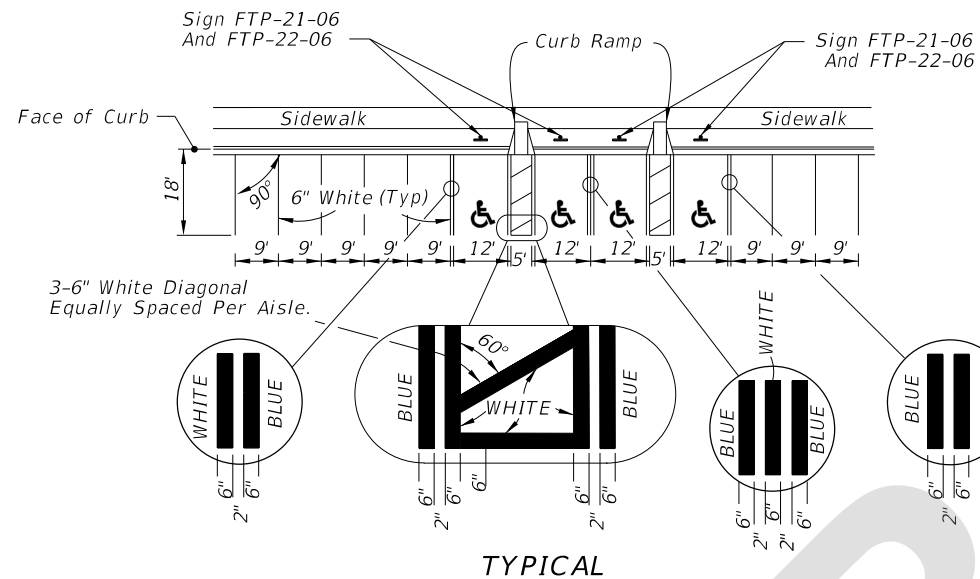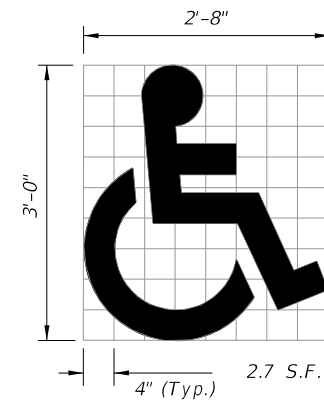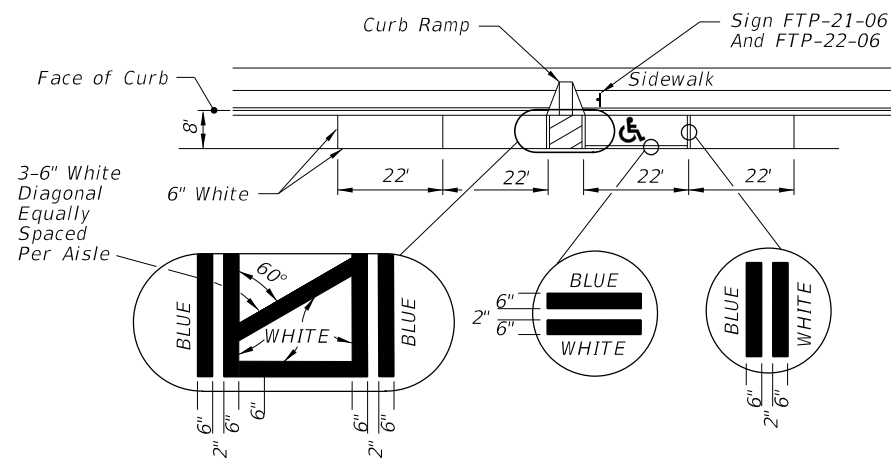


(See Note 6)

UNIVERSAL SYMBOL OF ACCESSIBILITY

NOTES:

1. Dimensions are to the centerline of markings.
2. An Access Aisle is required for each accessible space when angle parking is used.
3. Criteria for pavement markings only, not public sidewalk curb ramp locations. For ramp locations refer to plans.
4. Tint blue pavement markings to match color 15180 of Federal Standards 595a.
5. Mount FTP-22-06 sign below the FTP-21-06 sign.
6. Use of the pavement symbol in accessible parking spaces is optional. When pavement symbol is used, the symbol is either 3'-0" or 5'-0" high and white in color.

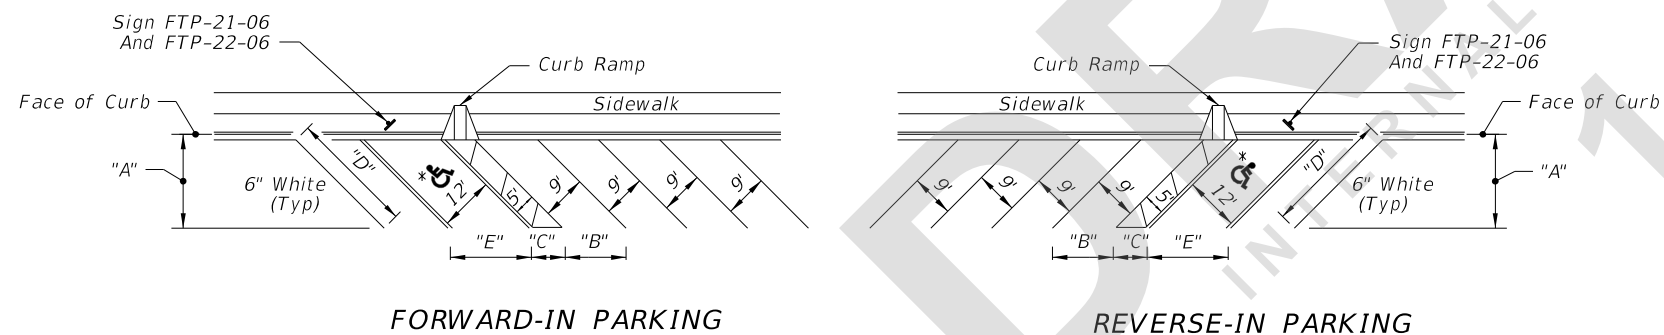

FORWARD-IN PARKING

REVERSE-IN PARKING


\* FOR ACCESSIBLE MARKINGS - SEE ABOVE

DIMENSIONS					
∠ θ	"A"	"B"	"C"	"D"	"E"
45°	17'-0"	12'-9"	7'-0"	24'-0"	17'-0"

PAVEMENT MARKING FOR PARKING

6/28/2021 7:39:35 AM


33 S.F.

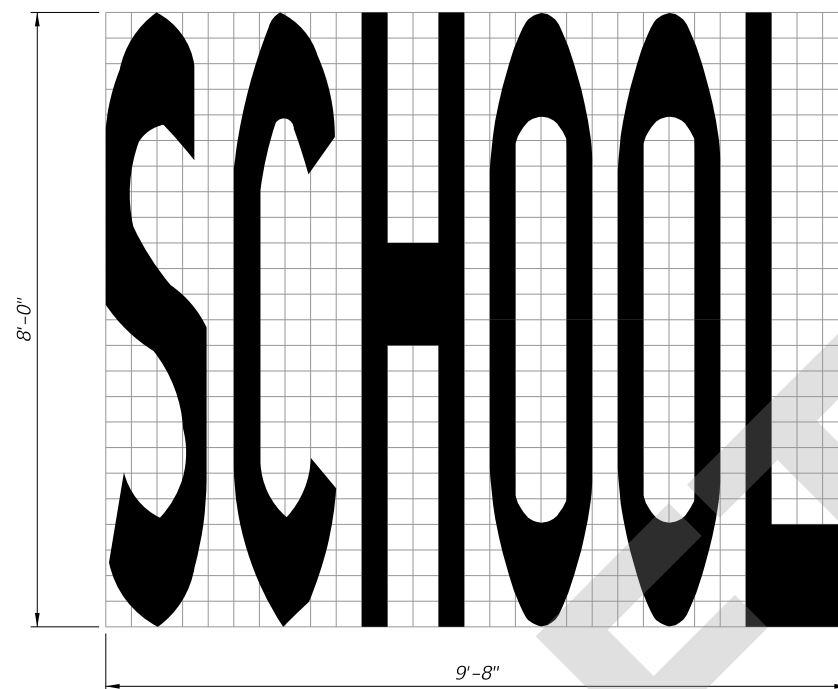


SCHOOL PAVEMENT MARKING

**NOTES:**


1. All grids are 4" x 4".
2. Pavement Marking Should Not Extend Into Opposing Lane.
3. Center School Pavement Marking in lane.

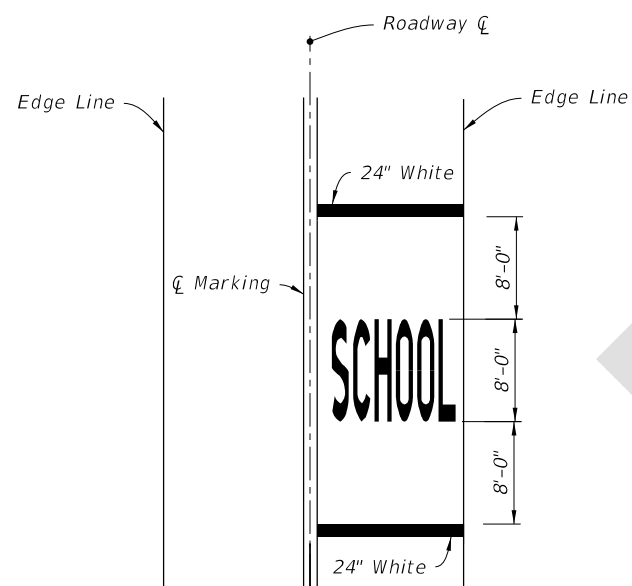

SINGLE-LANE APPROACH

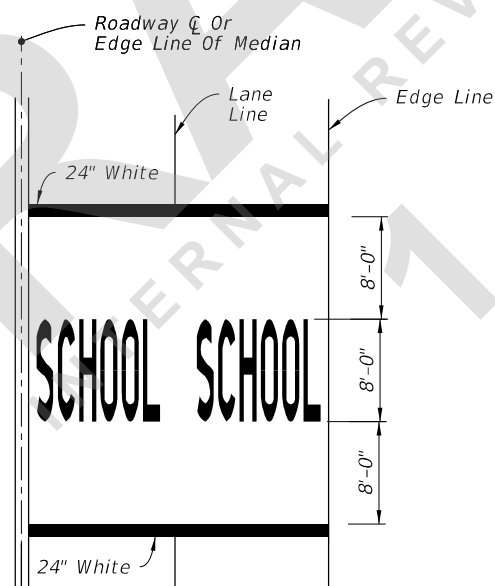

TWO-LANE APPROACH

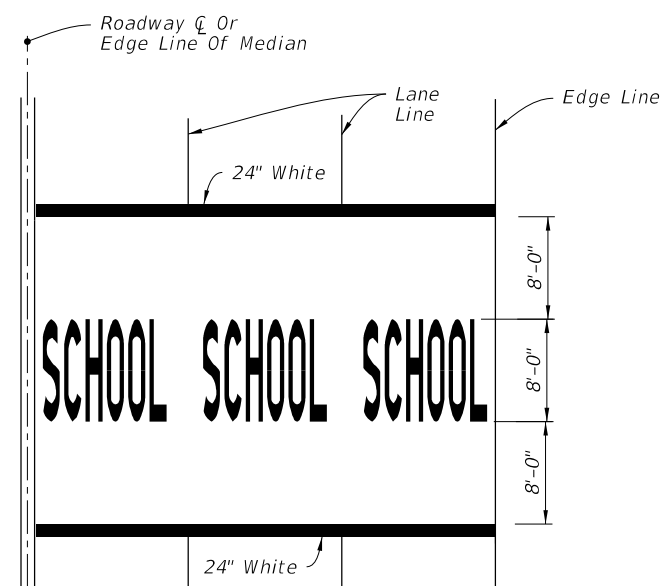

MULTI-LANE APPROACH  
(Three or More)


MARKINGS FOR SCHOOL ZONES

6/28/2021 7:39:40 AM


LAST REVISION 11/01/21	REVISION	DESCRIPTION:	 FY 2022-23 STANDARD PLANS	PAVEMENT MARKINGS	INDEX 711-001	SHEET 12 of 13
---------------------------	----------	--------------	---	-------------------	------------------	-------------------

**NOTE:**

Orient Railroad Dynamic Envelope Marking as shown in the Plans.

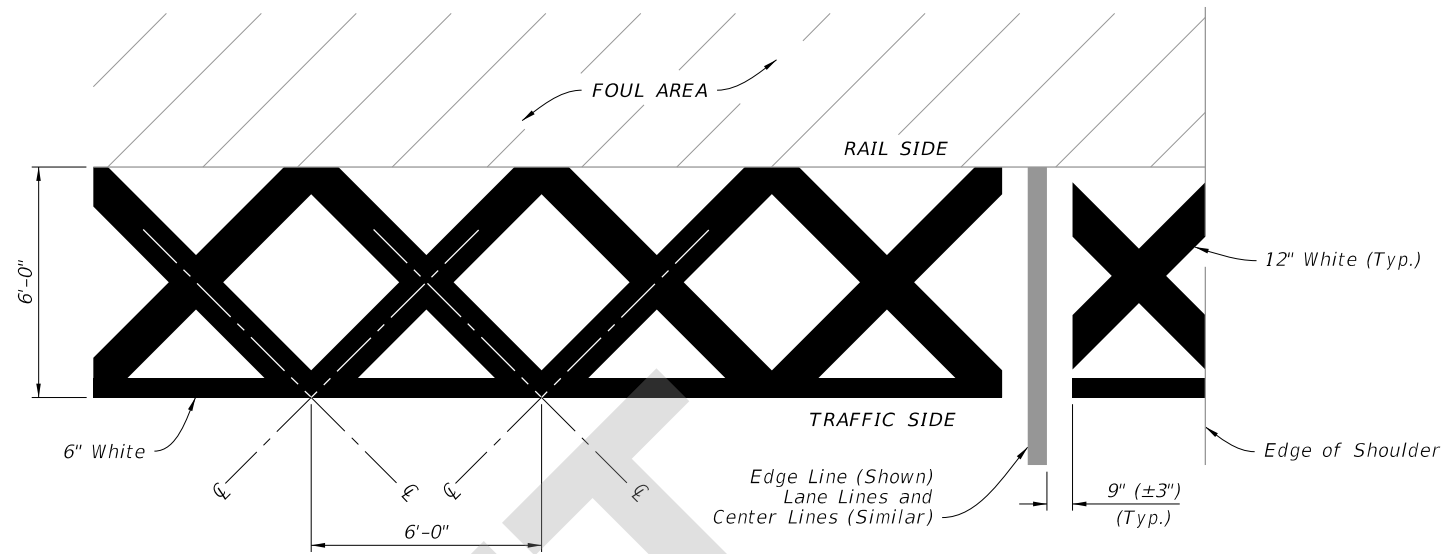


RAILROAD DYNAMIC ENVELOPE (RDE) PAVEMENT MARKING DETAIL

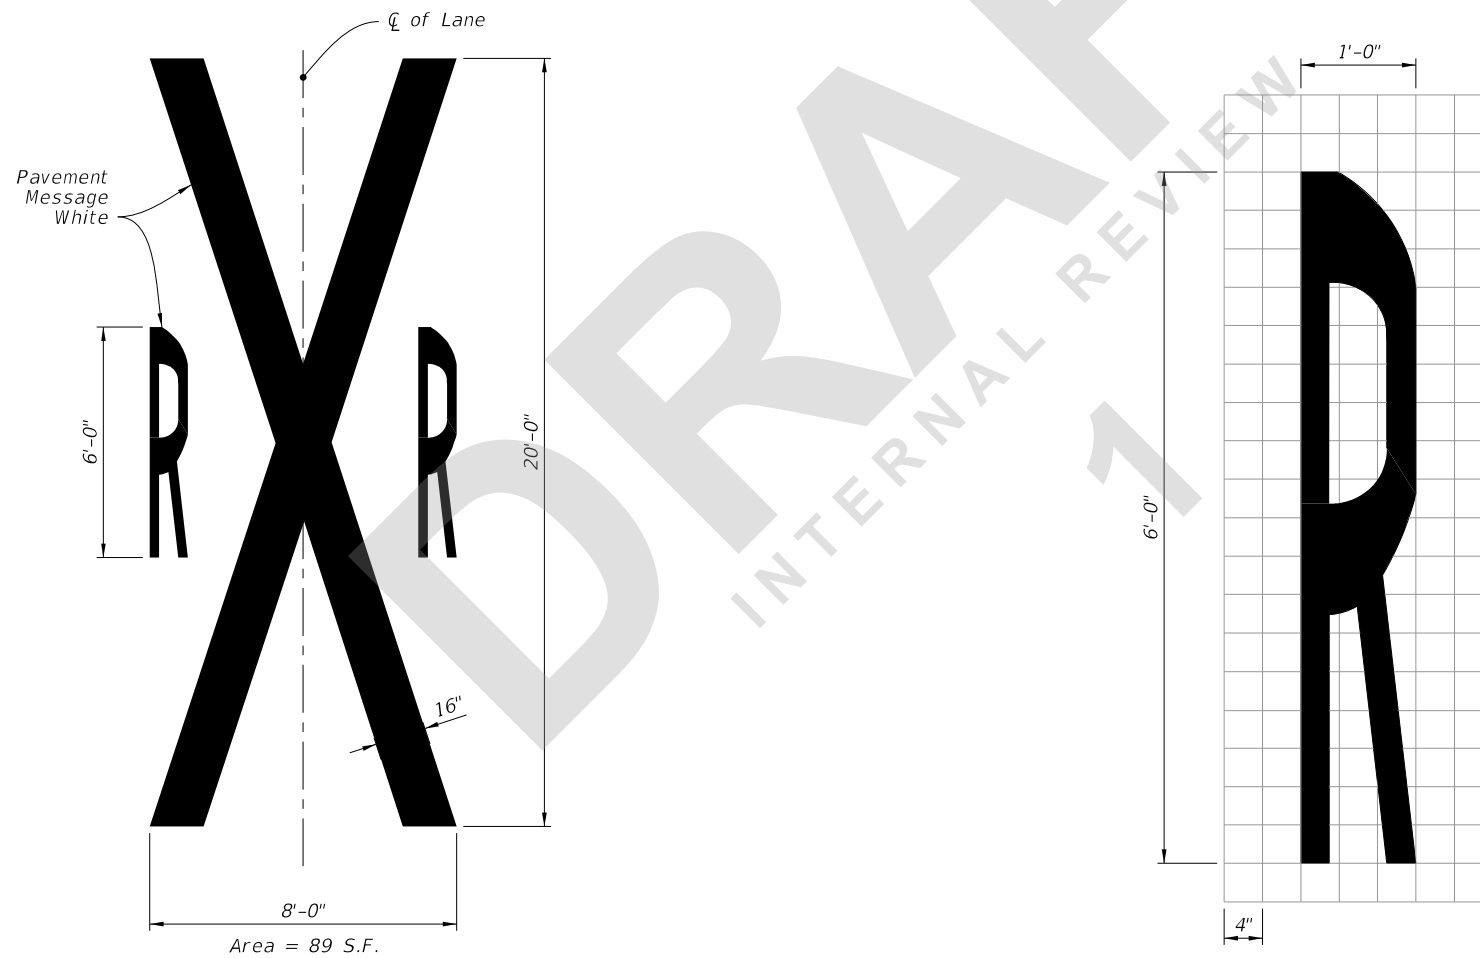

RAILROAD CROSSING PAVEMENT MESSAGE

6/28/2021 7:39:43 AM

LAST REVISION 11/01/21	REVISION	DESCRIPTION:	 FY 2022-23 STANDARD PLANS	PAVEMENT MARKINGS	INDEX 711-001	SHEET 13 of 13
---------------------------	----------	--------------	---	-------------------	------------------	-------------------