
ORIGINATION FORM

Proposed Revisions to a Standard Plans Index

(Please provide all information — Incomplete forms will be returned)

Contact Information:

Date: June 28, 2022

Originator: Matthew DeWitt

Phone: (850) 921-7353

Email: matthew.dewitt@dot.state.fl.us

Standard Plans:

Index Number: 649-020

Sheet Number (s): 1, 2, and 6 of 6

Index Title: STEEL CCTV POLE

Summary of the changes:

Sheet 1: Added new General Note 4 (Reference to Index 676-010 for additional details); Renumbered General Notes; Updated the Ground Mounted Cabinet details to show the Maintenance Service Slab in the STEEL CCTV POLE ASSEMBLY detail.

Sheet 2: Updated the Handhole with Cover callout reference to "7" in the CAMERA LOWERING DEVICE detail.

Sheet 5: Updated the Ground Mounted Cabinet details and updated the "Concrete Slab" callout to "Maintenance Service Slab"; Updated the Pole Mounted Cabinet details and added callout "Maintenance Service Slab" in the STEEL CCTV POLE GROUNDING detail.

Commentary / Background:

These proposed changes were developed based on implementing a maintenance service slab for ITS cabinets recommended during the TDH integration into statewide criteria. Language has also been added to Specification 676 for the maintenance service slab.

Other Affected Offices / Documents: (Provide name of person contacted)

Yes	No	
☐	☒	Other Standard Plans –
☐	☒	FDOT Design Manual –
☐	☒	Basis of Estimates Manual –
☒	☐	Standard Specifications –
☐	☒	Approved Product List –
☐	☒	Construction –
☐	☒	Maintenance –

Origination Package Includes: (Submit package to Rick Jenkins)

Yes	N/A	
☒	☐	Redline Mark-ups
☐	☐	Revised or Proposed Standard Plan Instruction (SPI)
☐	☐	Other Support Documents

Implementation:

☐	Design Bulletin (Interim)
☐	DCE Memo
☐	Program Mgmt. Bulletin
☒	FY-Standard Plans (Next Release)

Contact the Roadway Design Office for assistance in completing this form

Email to: Rick Jenkins rick.jenkins@dot.state.fl.us and Darren Martin darren.martin@dot.state.fl.us

GENERAL NOTES:

1. Work this Index with Specification 649.
2. This Index is considered fully detailed; only submit shop drawings for minor modifications not detailed in the Plans.
3. See Index 635-001 for additional details for Pull Boxes.
- ADDED NEW GENEERAL NOTE 4:
See Index 676-010 for cabinet installation details.

5. ~~4.~~ Materials:

A. Pole: ASTM A1011 Grade 50, 55, 60 or 65 (less than 1/4") or ASTM A572 Grade 50, 60 or 65 (greater than or equal to 1/4") or ASTM A595 Grade A (55 ksi yield) or Grade B (60 ksi yield).

B. Steel Plates and Pole Cap: ASTM A36 or ASTM A709 Grade 50.

C. Weld Metal: E70XX.

D. Bolts: ASTM F3125, Grade A325, Type 1.
Nuts: ASTM A563.
Washers: ASTM F-436.

E. Anchor Bolts: ASTM F1554 Grade 55 with ASTM A563 Grade A heavy-hex nuts and ASTM A36 plate washers.

F. Handhole Frame: ASTM A709 Grade 36 or ASTM A36.

G. Handhole Cover: ASTM A1011 Grade 50, 55, 60 or 65.

H. Stainless Steel Screws: AISI Type 316.

I. Reinforcing Steel: ASTM A615 Grade 60.

J. Galvanization: Bolts, nuts and washers: ASTM F2329 All other steel including plate washer: ASTM A123

K. Concrete: Class IV (Drilled Shaft) for all environment classifications.
6. ~~5.~~ Fabrication:

A. Welding:

a. Specification 460-6.4 and

b. AASHTO RFD Specification for Structural Supports for Highway Signs, Luminaires, and Traffic Signals Section 14.4.4.

B. Poles:

a. Round or 16-sided (Min.)

b. Taper pole diameter at 0.14 inches per foot

c. Fabricate Pole longitudinal seam welds (2 maximum) with 60 percent minimum penetration or fusion welds except as follows:

1. Use a full-penetration groove weld within 6 inches of the circumferential tube-to-plate connection and

2. Use full-penetration groove welds on the female end section of telescopic (i.e., slip type) field splices for a minimum length of one and one-half times the inside diameter of the female section plus 6 inches.

d. Pole shaft may be either one or two sections (with telescopic field splice)

e. Circumferentially welded pole shafts and laminated pole shafts are not permitted

C. Identification Tag: (Submit details for approval)

a. 2"x 4" (Max.) aluminum tag

b. Locate on the inside of the pole and visible from the handhole

c. Secure with 1/8" diameter stainless steel rivets or screws.

d. Include the following information on the ID Tag:

1. Financial Project ID

2. Pole Type

3. Pole Height

4. Manufacturers' Name

5. Yield Strength (Fy of Steel)

6. Base Wall Thickness

D. Except for Anchor Bolts, bolt hole diameters are bolt diameter plus 1/16" and anchor bolt holes are bolt diameter plus 1/2" (Max) prior to galvanizing.

7. ~~6.~~ Pole Installation:

A. Do not install additional wire access holes (not shown in this Index) with a diameter that exceeds 1 1/2" in diameter.

B. Install Anchor Bolts in accordance with Specification 649-5.

C. Cable Supports: Electrical Cable Guides and Eyebolts.

a. Locate top and bottom cable guides within the pole aligned with each other.

b. Position one cable guide 2" below the handhole.

c. Position other cable guide 1" directly below the top of the tenon.

d. Position Park Stands 2" below the top of the handhole.

D. Install Pole with the handhole located away from approaching traffic.

E. Install the Pole plumb.

8. ~~7.~~ Cabinet Installation:

A. Splice fiber optic cables in cabinet to preterminated patch panel.

B. Furnish and install Surge Protection Devices (SPDs) on all cabling in cabinet.

C. Furnish and install secondary SPDs protection on outlets for equipment in cabinet.

D. Ensure that all electronic equipment power is protected and conditioned with SPDs.

E. Ensure that equipment cabinet is bonded to CCTV pole grounding system.

F. Install the pole mounted cabinet with the hinges next to the pole.

G. Sizes and types of conduits and inner ducts for network communications between the pullbox and cabinet are stated in the Contract Documents.

9. ~~8.~~ Lowering Device Installation:


A. Place the lowering cable that moves within the pole in an interior conduit to prevent it from tangling or interfering with any electrical wire that is in the pole. Ensure that any electrical wire within the pole is routed securely and free from slack.

B. Mount lowering device perpendicular to the roadway or as shown in the plans. Position CC TV pole so that the camera can be safely lowered without requiring lane closures.

C. Coordinate all lowering device hardware requirements (including Tenon, Tenon mounting plates, parking stands, etc.) with lowering device manufacturer.
- The diagram illustrates the assembly of a steel CCTV pole. Key components and labels include:

 - Lowering Device Shown Optional Fixed Bracket**: Located at the top of the pole.
 - Air Terminal (See Sheet 6)**: Positioned at the very top.
 - Pole Top (See Sheet 5)**: The uppermost section of the pole.
 - Dome Type CCTV Camera**: Mounted on the pole.
 - CCTV Pole (See Sheet 2)**: The main vertical shaft.
 - Handhole (See Sheet 4)**: A circular access point on the pole.
 - Pole Mounted Cabinet Option (See Sheet 6)**: Attached to the side of the pole.
 - Ground Mounted Cabinet Option (See Sheet 6)**: A separate cabinet on the ground.
 - Pull Box**: A box for cable management.
 - Ground Rod (See Sheet 5)**: A rod for grounding.
 - Foundation (Drilled Shaft) (See Sheet 3)**: The base of the pole in the ground.
 - Shaft Diameter (See Sheet 3)**: The width of the pole shaft.
 - Shaft Length (See Sheet 2)**: The height of the pole shaft.
 - Overall Height (See Sheet 2)**: The total height from the ground to the top.
 - Finished Grade**: The ground level.
 - Fiber Optic Pull Box**: A box for fiber optic cables.
 - UPDATED DETAILS**: A red dashed box highlights the area around the ground-mounted cabinet and pull box.

The title **STEEL CCTV POLE ASSEMBLY** is centered at the bottom of the drawing.
- 12:22:46 PM
9/22/2021
- | LAST REVISION | | DESCRIPTION: | FDOT
FY 2022-23
STANDARD PLANS | STEEL CCTV POLE | INDEX
649-020 | SHEET
1 of 6 |
|---------------|----------|--------------|--------------------------------------|-----------------|------------------|-----------------|
| 11/01/21 | 11/01/22 | | | | | |

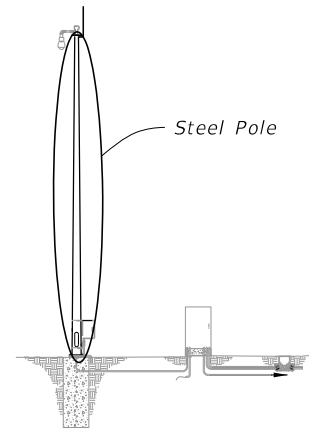

SHAFT DESIGN TABLE

Pole Overall Height (ft)	Shaft Diameter	Shaft Length	Longitudinal Reinforcement
50	4'-0"	11'-0"	(14) #11
55	4'-0"	12'-0"	(14) #11
60	4'-6"	13'-0"	(16) #11
65	4'-6"	13'-0"	(16) #11
70	5'-0"	14'-0"	(18) #11

ADDITIONAL SHAFT DEPTH DUE TO GROUND SLOPE

Ground Slope	4'-0" Shaft Diameter	5'-0" Shaft Diameter
1:5	3'-0"	4'-0"
1:4	4'-0"	5'-0"
1:3	5'-0"	6'-0"
1:2	7'-0"	9'-0"

FOUNDATION NOTES:


1. Shaft Length is based on 1'-0" height above the finished grade.
2. Shaft Design Table Shaft Length is based on level ground (flatter than 1:5). Increase the shaft depth in accordance with the Additional Shaft Depth Due To Ground Slope table for foundations with slopes 1:5 and steeper. Use the higher value for slope or diameter values that fall between those shown on the table.

BASE PLATE AND ANCHOR BOLT DESIGN TABLE

Pole Overall Height (ft)	Base Plate Diameter (in.)	Base Plate Thickness (in.)	Anchor Bolt Circle (in.)	Number of Bolts	Anchor Bolt Diameter (in.)	Anchor Bolt Embedment (in.)	Minimum Anchor Bolt Projection (in.)
50	27	2.5	22	6	1.25	31	8.5
55	28	2.5	23	6	1.25	33	8.5
60	33	2.5	27	6	1.50	34	9.5
65	35	2.5	29	6	1.50	35	9.5
70	40	2.5	33	6	1.75	38	10.5

POLE DESIGN TABLE

Pole Overall Height (ft)	Section 1 (Top)			Section 2 (Bottom)			Joint
	Length	Wall Thickness (in.)	Base Diameter (in.)	Length	Wall Thickness (in.)	Base Diameter (in.)	Minimum Splice Length (in.)
50	---	---	---	50'-0"	0.25	17	---
	25'-0"	0.25	14	28'-0"	0.25	17	27
55	30'-0"	0.25	15	28'-0"	0.3125	18	30
60	35'-0"	0.25	18	29'-0"	0.3125	21	33
65	33'-0"	0.25	19	36'-0"	0.3125	23	33
70	38'-0"	0.25	22	36'-0"	0.3125	26	39

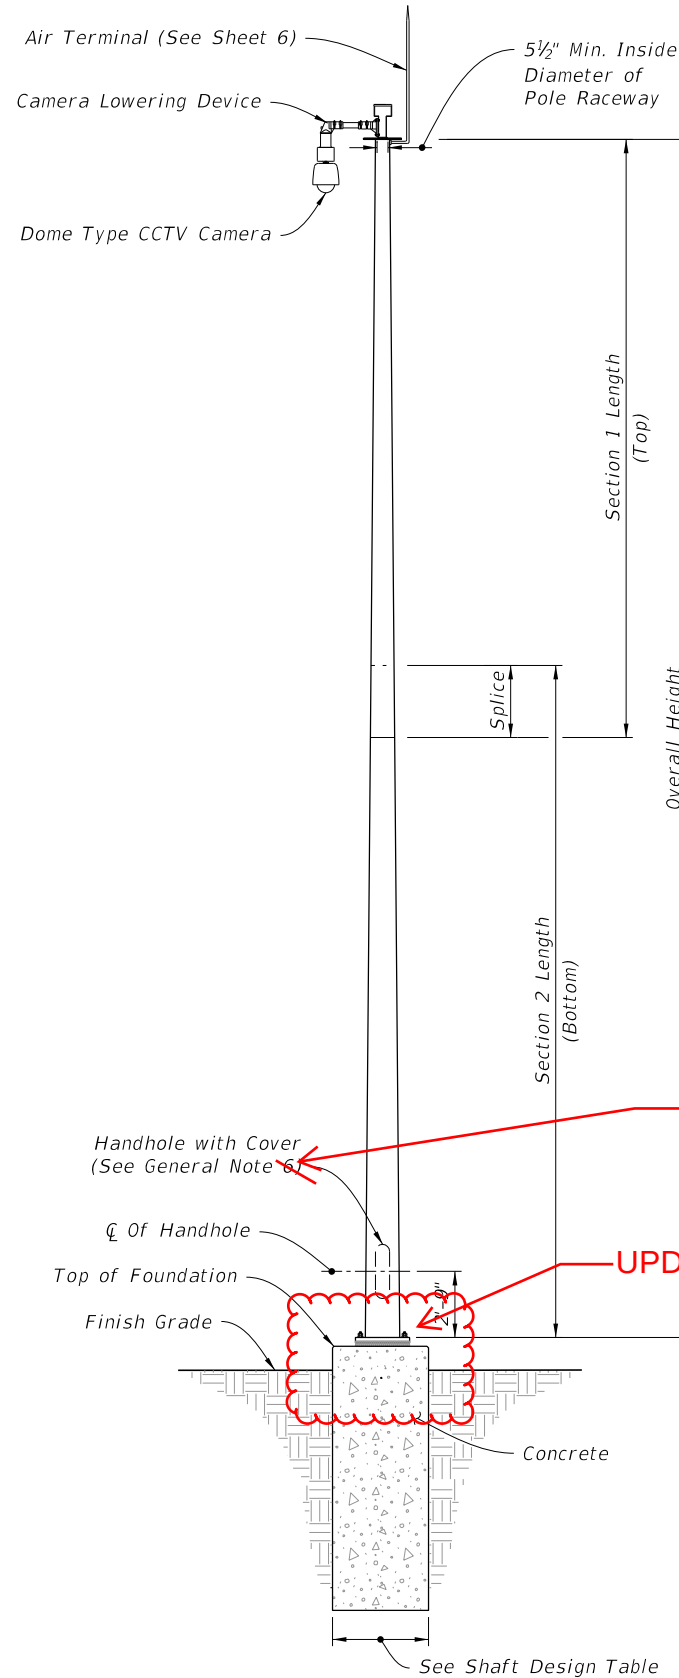









CAMERA LOWERING DEVICE



FIXED MOUNTING BRACKET

ELEVATION

9/22/2021 12:22:49 PM

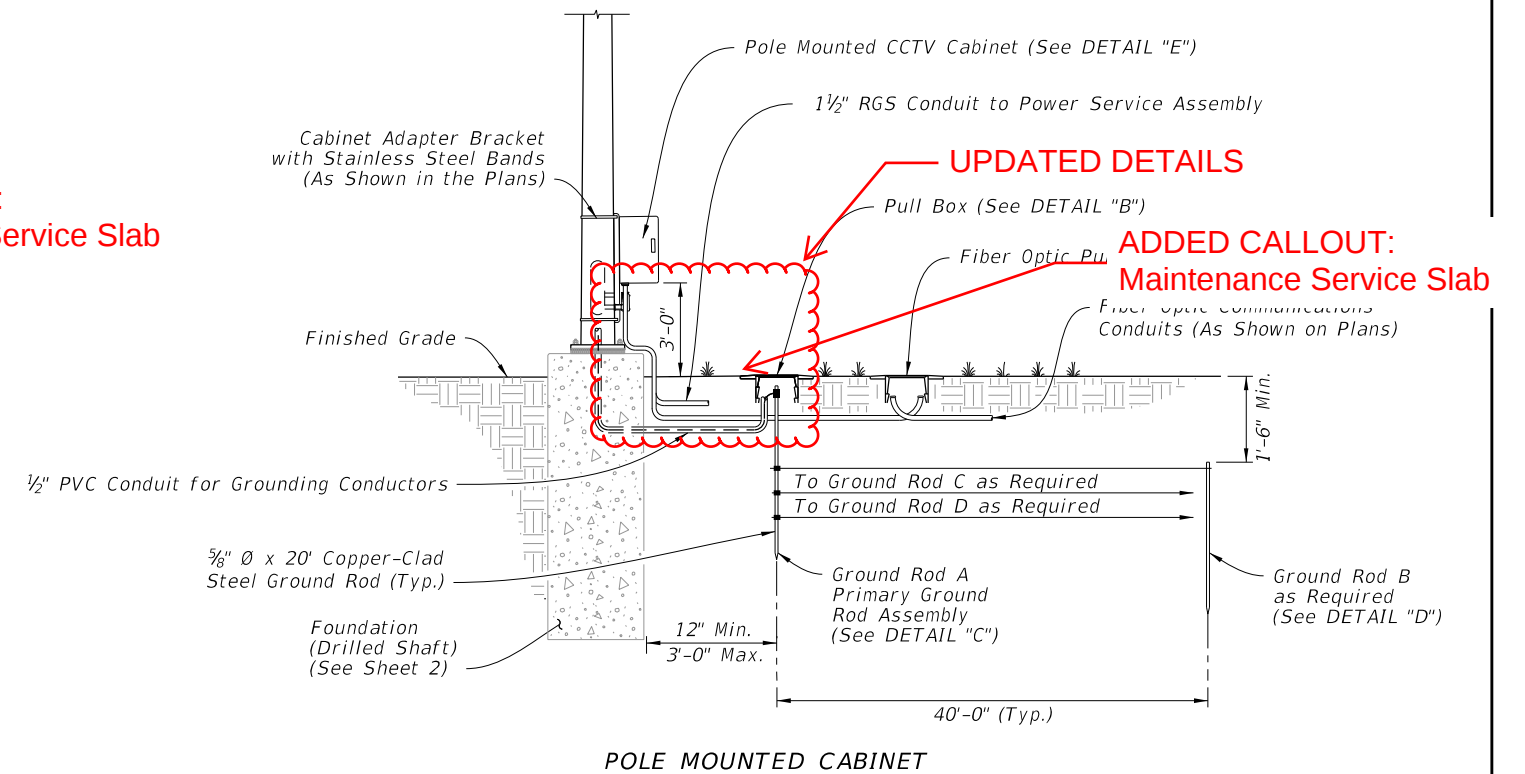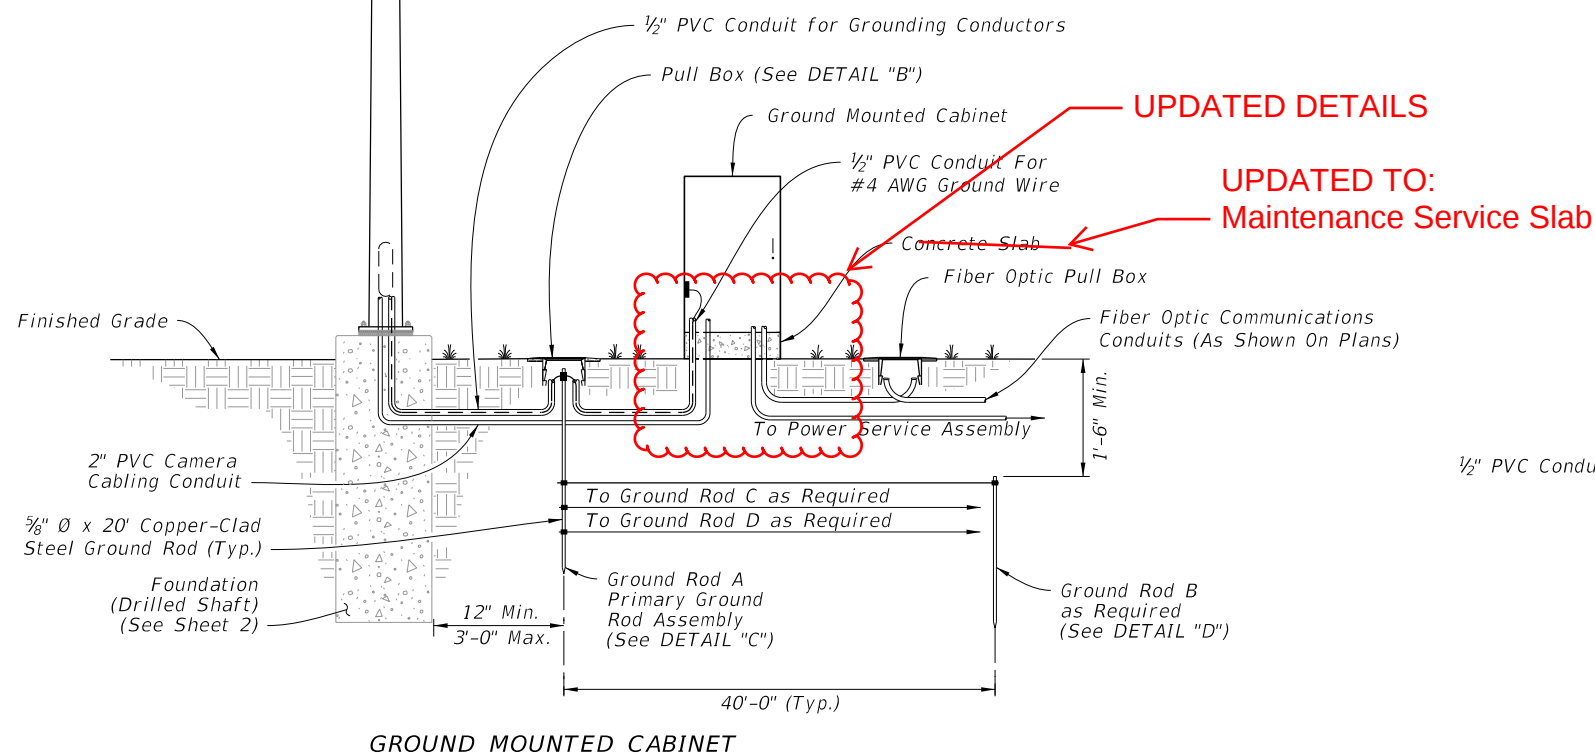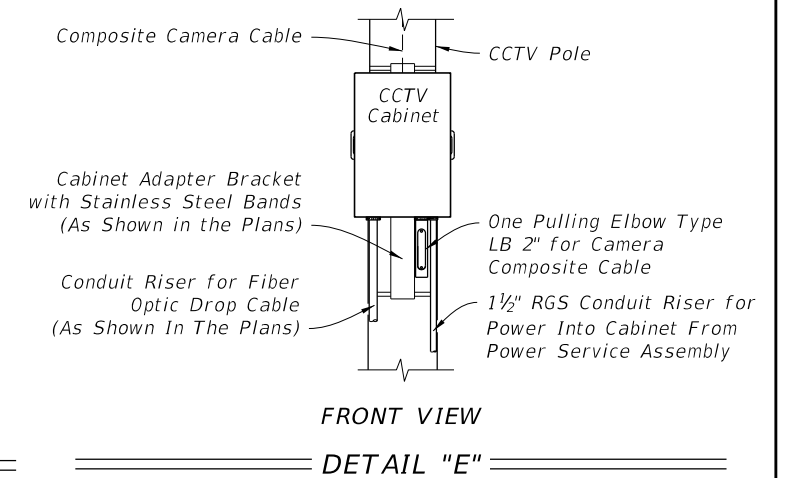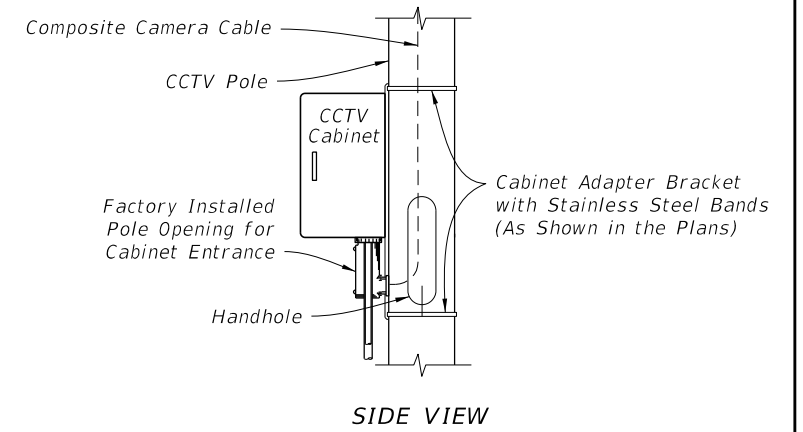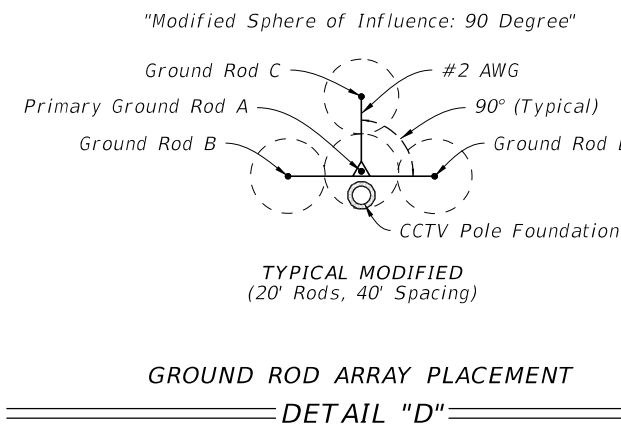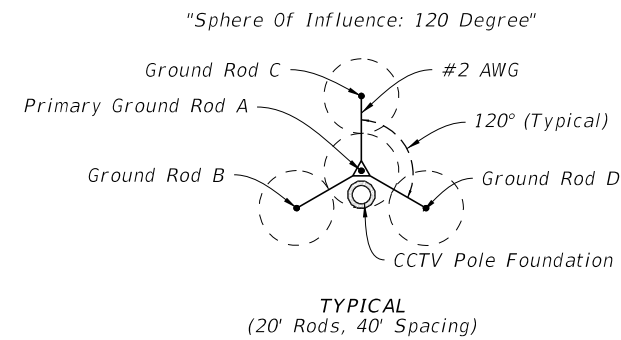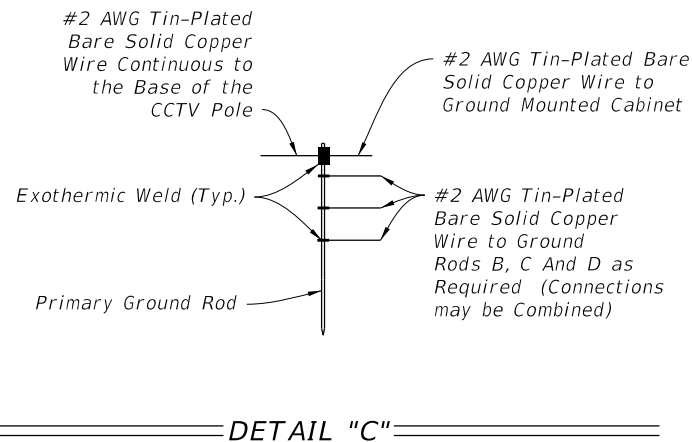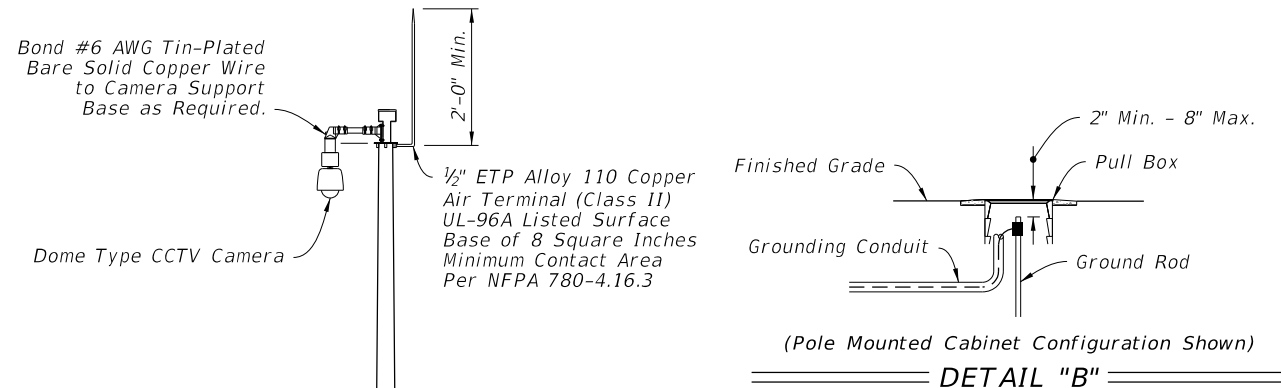

STEEL CCTV POLE GROUNDING

9/22/2021 12:23:05 PM

LAST REVISION	DESCRIPTION:	FDOT	FY 2022-23 STANDARD PLANS	STEEL CCTV POLE	INDEX	SHEET
11/01/21	11/01/22				649-020	6 of 6

GENERAL NOTES:

1. Work this Index with Specification 649.
2. This Index is considered fully detailed; only submit shop drawings for minor modifications not detailed in the Plans.
3. See Index 635-001 for additional Pull Box details.
4. See Index 676-010 for cabinet installation details.
5. Materials:

A. Pole: ASTM A1011 Grade 50, 55, 60 or 65 (less than ¼") or ASTM A572 Grade 50, 60 or 65 (greater than or equal to ¼") or ASTM A595 Grade A (55 ksi yield) or Grade B (60 ksi yield).

B. Steel Plates and Pole Cap: ASTM A36 or ASTM A709 Grade 50.

C. Weld Metal: E70XX.

D. Bolts: ASTM F3125, Grade A325, Type 1.
Nuts: ASTM A563.
Washers: ASTM F-436.

E. Anchor Bolts: ASTM F1554 Grade 55 with ASTM A563 Grade A heavy-hex nuts and ASTM A36 plate washers.

F. Handhole Frame: ASTM A709 Grade 36 or ASTM A36.

G. Handhole Cover: ASTM A1011 Grade 50, 55, 60 or 65.

H. Stainless Steel Screws: AISI Type 316.

I. Reinforcing Steel: ASTM A615 Grade 60.

J. Galvanization: Bolts, nuts and washers: ASTM F2329 All other steel including plate washer: ASTM A123

K. Concrete: Class IV (Drilled Shaft) for all environment classifications.
6. Fabrication:

A. Welding:

a. Specification 460-6.4 and

b. AASHTO RFD Specification for Structural Supports for Highway Signs, Luminaires, and Traffic Signals Section 14.4.4.

B. Poles:

a. Round or 16-sided (Min.)

b. Taper pole diameter at 0.14 inches per foot

c. Fabricate Pole longitudinal seam welds (2 maximum) with 60 percent minimum penetration or fusion welds except as follows:

1. Use a full-penetration groove weld within 6 inches of the circumferential tube-to-plate connection and

2. Use full-penetration groove welds on the female end section of telescopic (i.e., slip type) field splices for a minimum length of one and one-half times the inside diameter of the female section plus 6 inches.

d. Pole shaft may be either one or two sections (with telescopic field splice)

e. Circumferentially welded pole shafts and laminated pole shafts are not permitted

C. Identification Tag: (Submit details for approval)

a. 2"x 4" (Max.) aluminum tag

b. Locate on the inside of the pole and visible from the handhole

c. Secure with ⅛" diameter stainless steel rivets or screws.

d. Include the following information on the ID Tag:

1. Financial Project ID

2. Pole Type

3. Pole Height

4. Manufacturers' Name

5. Yield Strength (Fy of Steel)

6. Base Wall Thickness

D. Except for Anchor Bolts, bolt hole diameters are bolt diameter plus ⅛" and anchor bolt holes are bolt diameter plus ½" (Max) prior to galvanizing.
7. Pole Installation:

A. Do not install additional wire access holes (not shown in this Index) with a diameter that exceeds 1½" in diameter.

B. Install Anchor Bolts in accordance with Specification 649-5.

C. Cable Supports: Electrical Cable Guides and Eyebolts.

a. Locate top and bottom cable guides within the pole aligned with each other.

b. Position one cable guide 2" below the handhole.

c. Position other cable guide 1" directly below the top of the tenon.

d. Position Park Stands 2" below the top of the handhole.

D. Install Pole with the handhole located away from approaching traffic.

E. Install the Pole plumb.
8. Cabinet Installation:

A. Splice fiber optic cables in cabinet to preterminated patch panel.

B. Furnish and install Surge Protection Devices (SPDs) on all cabling in cabinet.

C. Furnish and install secondary SPDs protection on outlets for equipment in cabinet.

D. Ensure that all electronic equipment power is protected and conditioned with SPDs.

E. Ensure that equipment cabinet is bonded to CCTV pole grounding system.


F. Install the pole mounted cabinet with the hinges next to the pole.

G. Sizes and types of conduits and inner ducts for network communications between the pull box and cabinet are stated in the Contract Documents.
9. Lowering Device Installation:

A. Place the lowering cable that moves within the pole in an interior conduit to prevent it from tangling or interfering with any electrical wire that is in the pole. Ensure that any electrical wire within the pole is routed securely and free from slack.

B. Mount lowering device perpendicular to the roadway or as shown in the plans. Position CC TV pole so that the camera can be safely lowered without requiring lane closures.


C. Coordinate all lowering device hardware requirements (including Tenon, Tenon mounting plates, parking stands, etc.) with lowering device manufacturer.

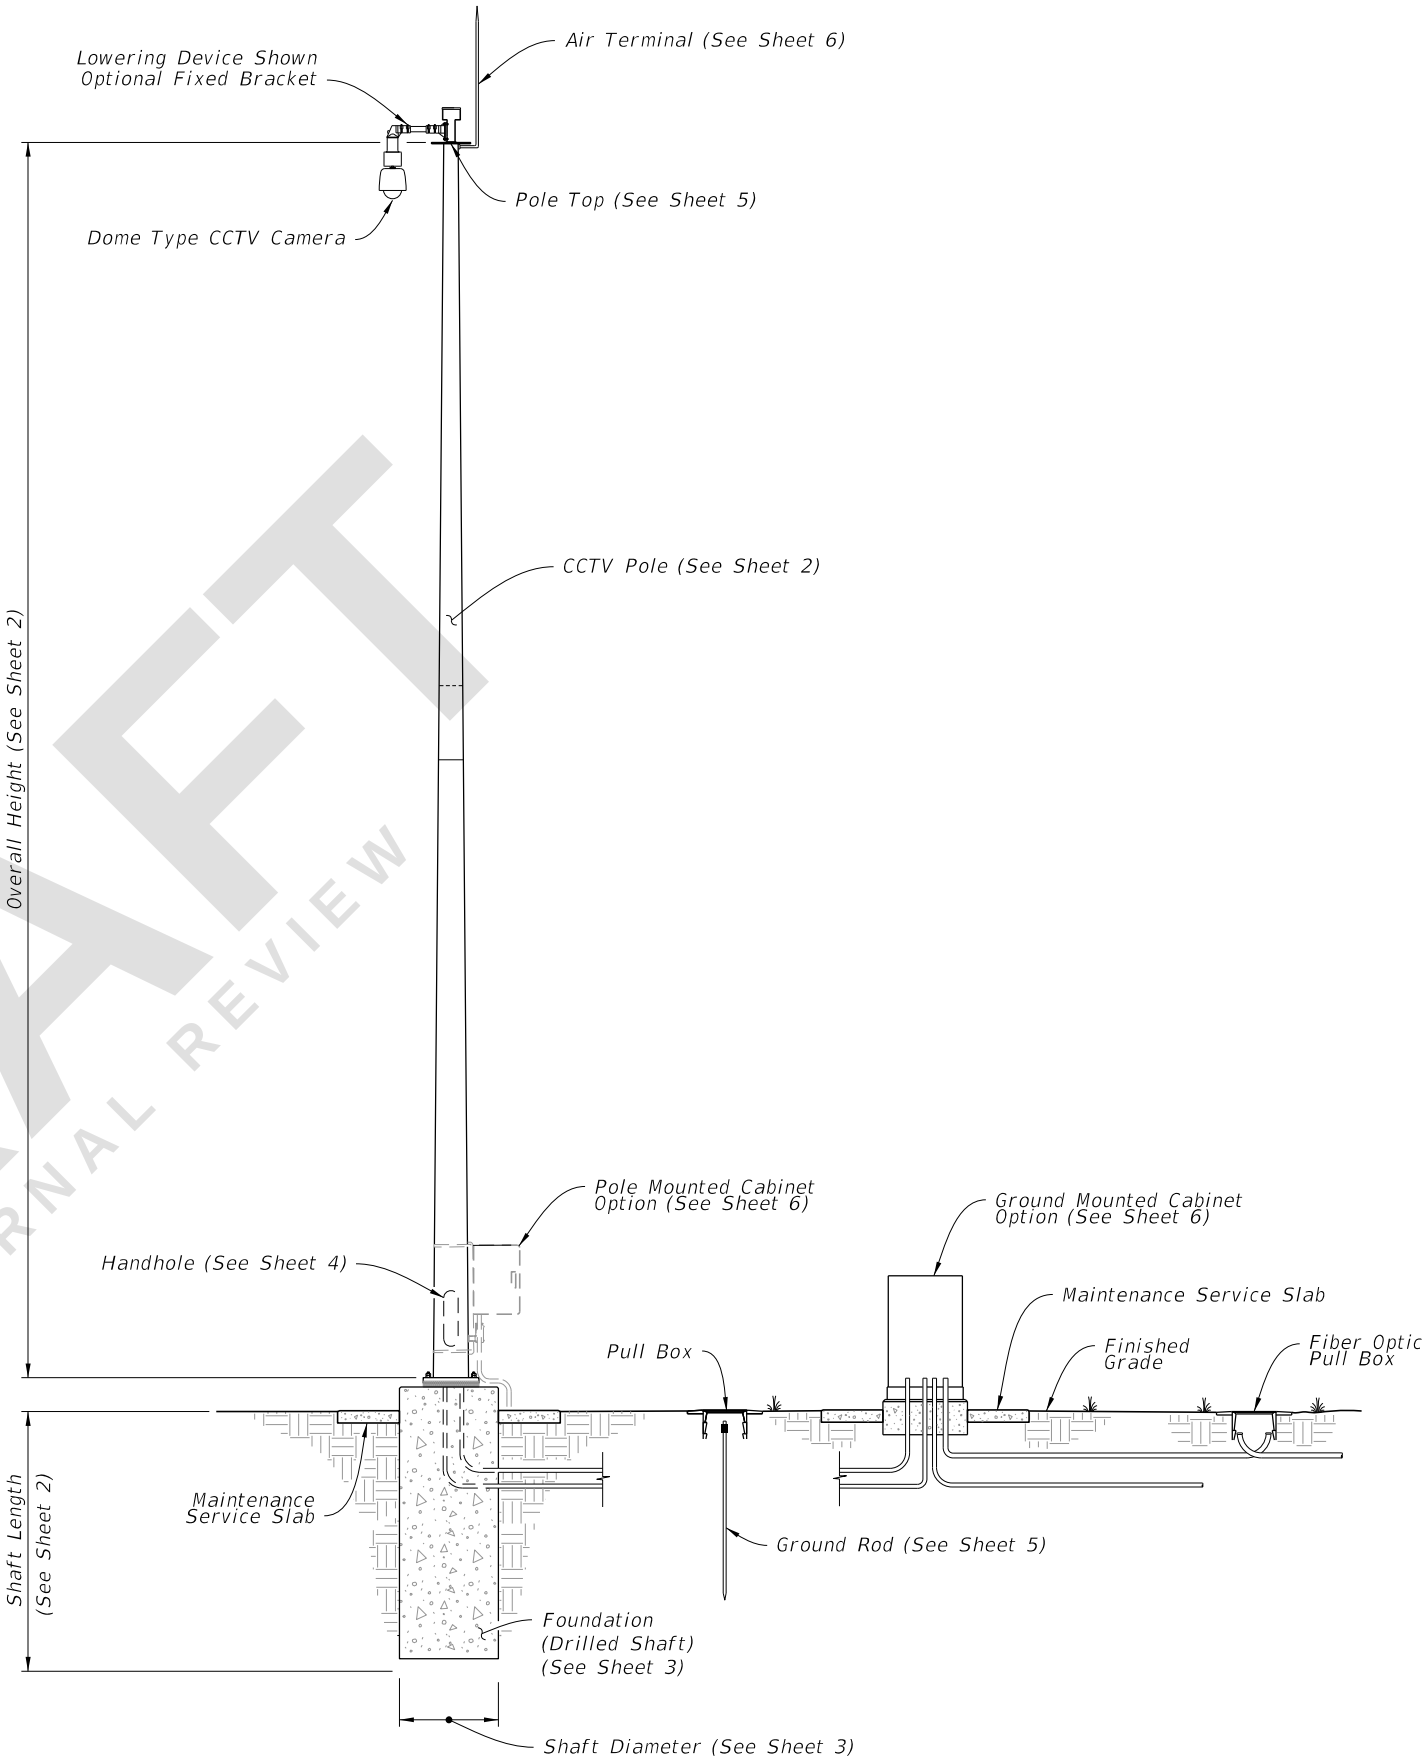

STEEL CCTV POLE ASSEMBLY

LAST REVISION 11/01/22	REVISION	DESCRIPTION:	FDOT	FY 2023-24 STANDARD PLANS	STEEL CCTV POLE	INDEX	SHEET
						649-020	1 of 6

7/17/2022 2:57:29 PM

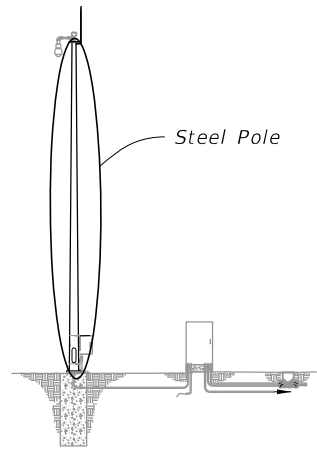

ASSEMBLY

SHAFT DESIGN TABLE			
Pole Overall Height (ft)	Shaft Diameter	Shaft Length	Longitudinal Reinforcement
50	4'-0"	11'-0"	(14) #11
55	4'-0"	12'-0"	(14) #11
60	4'-6"	13'-0"	(16) #11
65	4'-6"	13'-0"	(16) #11
70	5'-0"	14'-0"	(18) #11


ADDITIONAL SHAFT DEPTH DUE TO GROUND SLOPE		
Ground Slope	4'-0" Shaft Diameter	5'-0" Shaft Diameter
1:5	3'-0"	4'-0"
1:4	4'-0"	5'-0"
1:3	5'-0"	6'-0"
1:2	7'-0"	9'-0"

FOUNDATION NOTES:


- Shaft Length is based on 1'-0" height above the finished grade.
- Shaft Design Table Shaft Length is based on level ground (flatter than 1:5). Increase the shaft depth in accordance with the Additional Shaft Depth Due To Ground Slope table for foundations with slopes 1:5 and steeper. Use the higher value for slope or diameter values that fall between those shown on the table.

BASE PLATE AND ANCHOR BOLT DESIGN TABLE							
Pole Overall Height (ft)	Base Plate Diameter (in.)	Base Plate Thickness (in.)	Anchor Bolt Circle (in.)	Number of Bolts	Anchor Bolt Diameter (in.)	Anchor Bolt Embedment (in.)	Minimum Anchor Bolt Projection (in.)
50	27	2.5	22	6	1.25	31	8.5
55	28	2.5	23	6	1.25	33	8.5
60	33	2.5	27	6	1.50	34	9.5
65	35	2.5	29	6	1.50	35	9.5
70	40	2.5	33	6	1.75	38	10.5

POLE DESIGN TABLE							
Pole Overall Height (ft)	Section 1 (Top)			Section 2 (Bottom)			Joint
	Length	Wall Thickness (in.)	Base Diameter (in.)	Length	Wall Thickness (in.)	Base Diameter (in.)	
50	---	---	---	50'-0"	0.25	17	---
	25'-0"	0.25	14	28'-0"	0.25	17	27
55	30'-0"	0.25	15	28'-0"	0.3125	18	30
60	35'-0"	0.25	18	29'-0"	0.3125	21	33
65	33'-0"	0.25	19	36'-0"	0.3125	23	33
70	38'-0"	0.25	22	36'-0"	0.3125	26	39

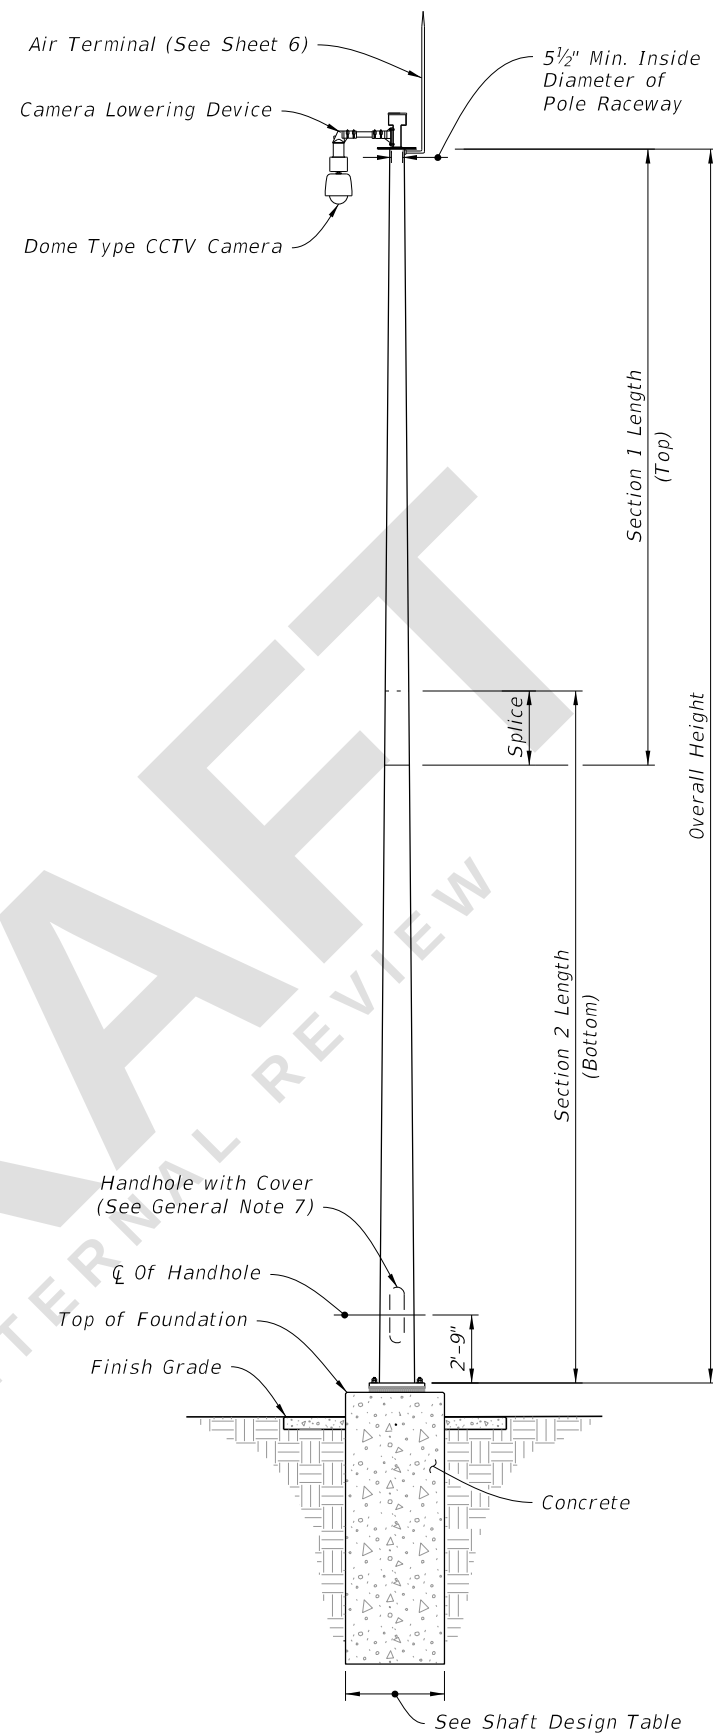









CAMERA LOWERING DEVICE

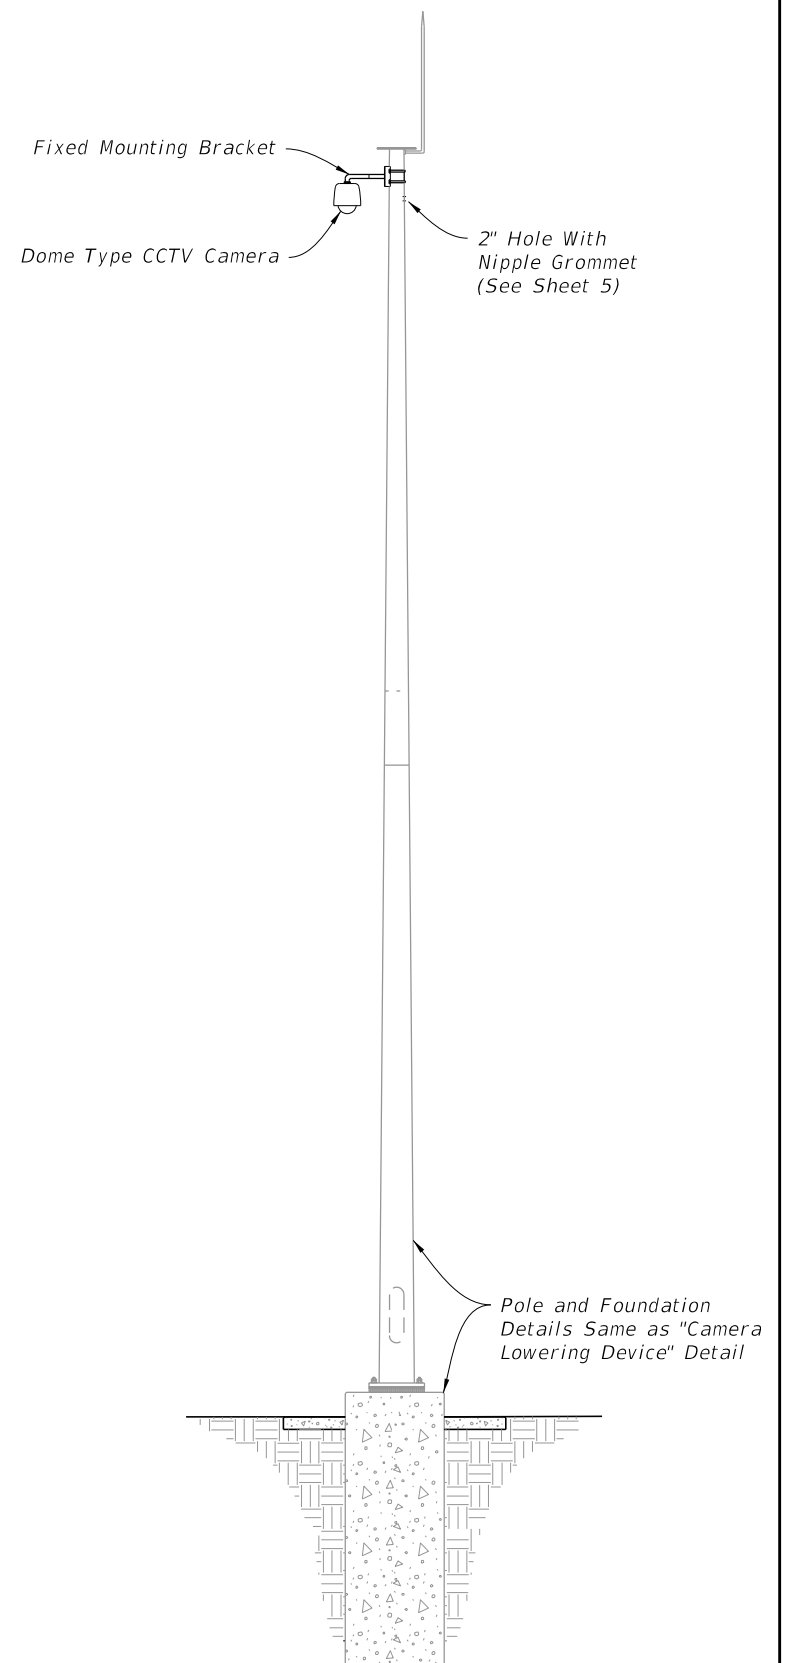

FIXED MOUNTING BRACKET

ELEVATION

7/27/2022 2:57:31 PM

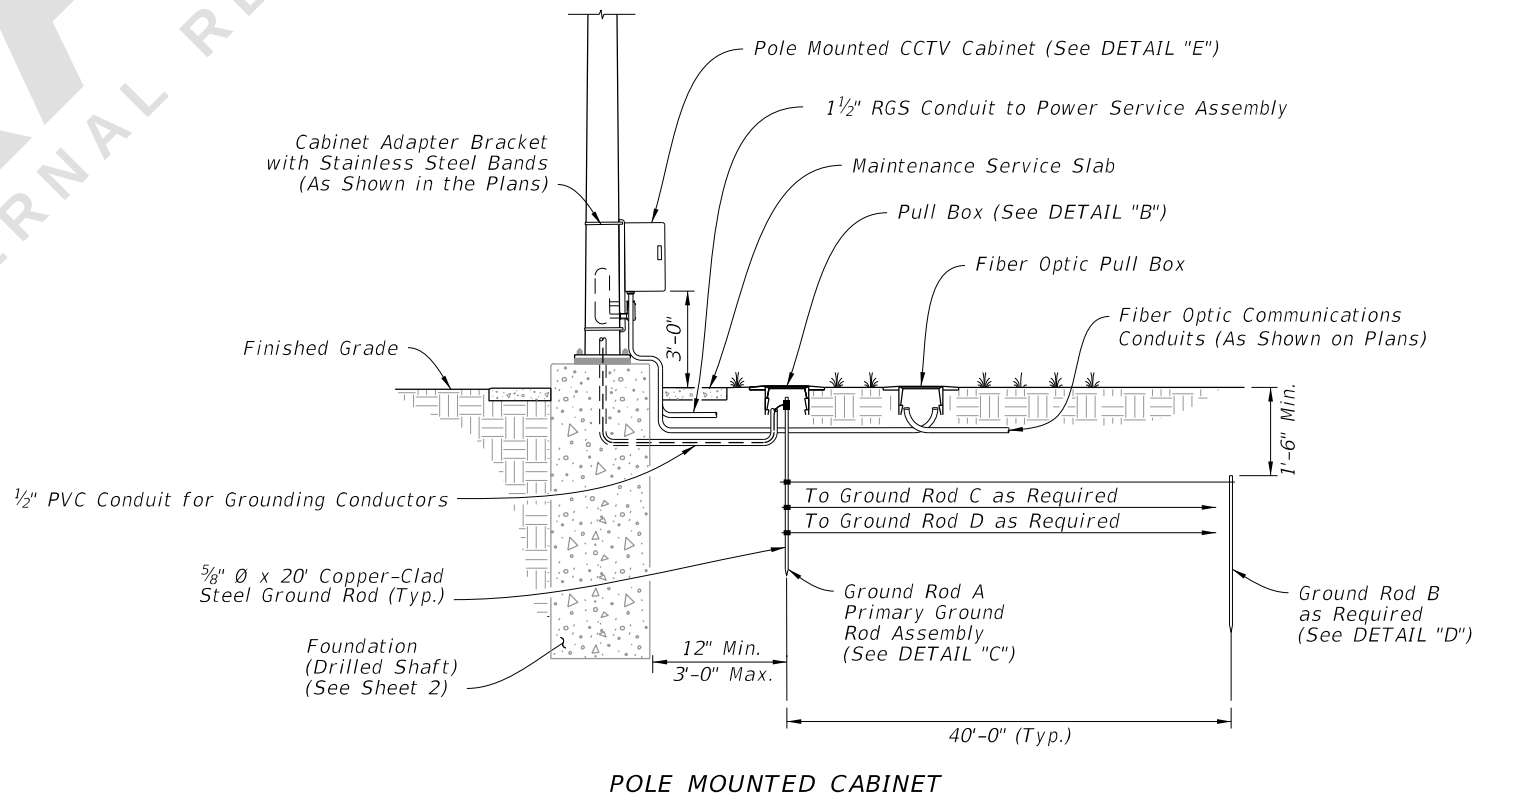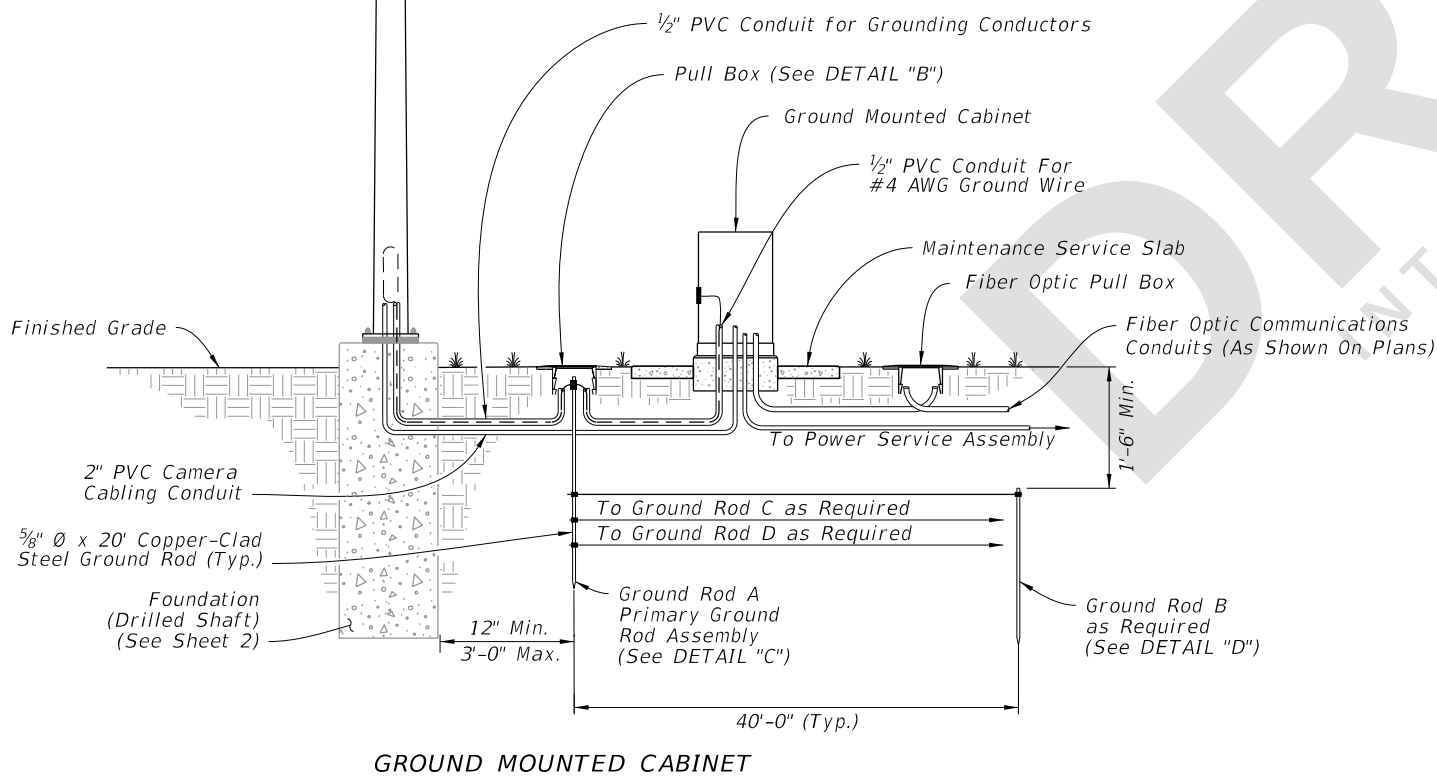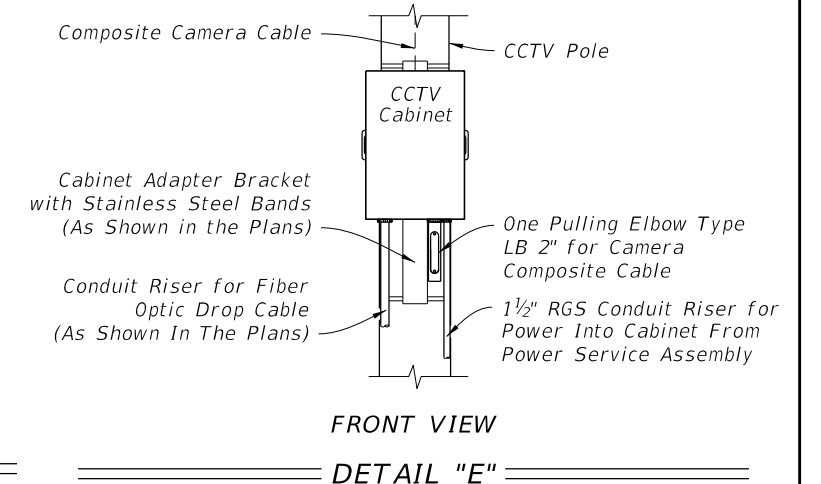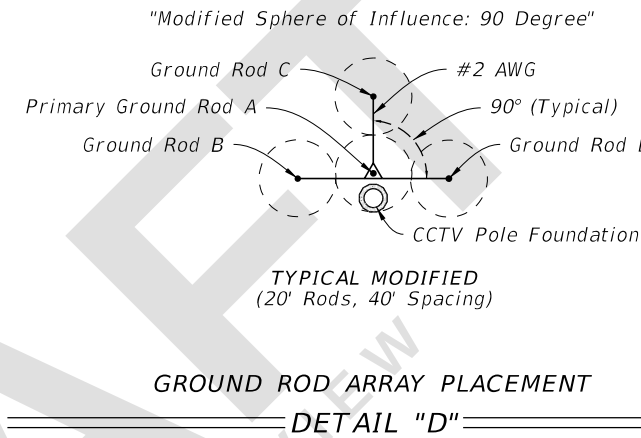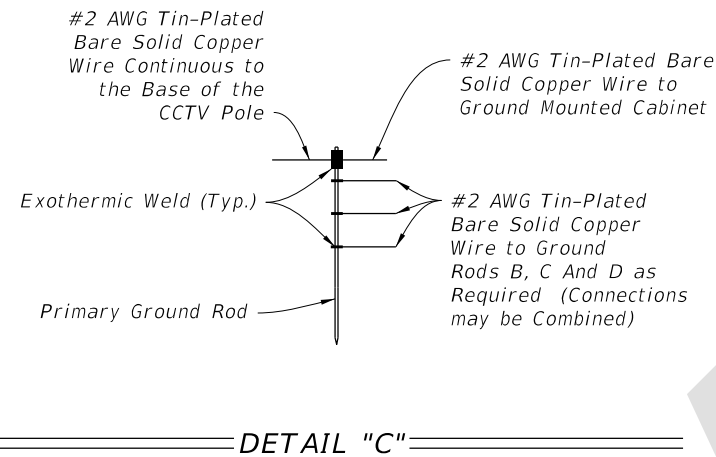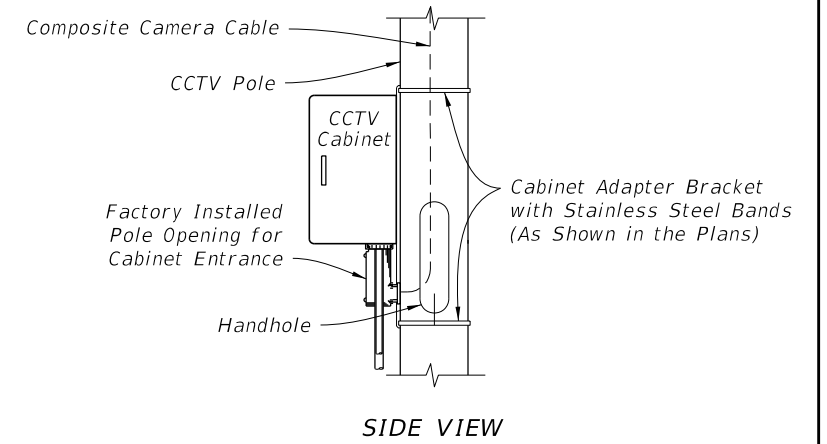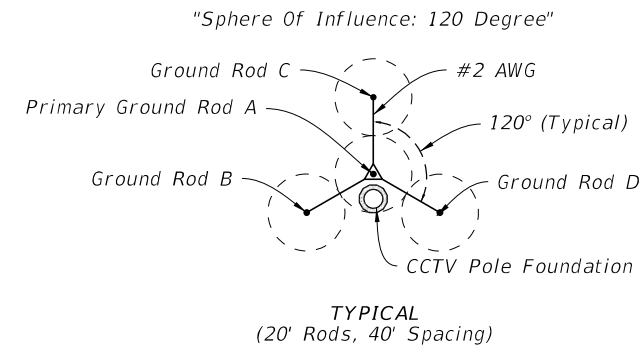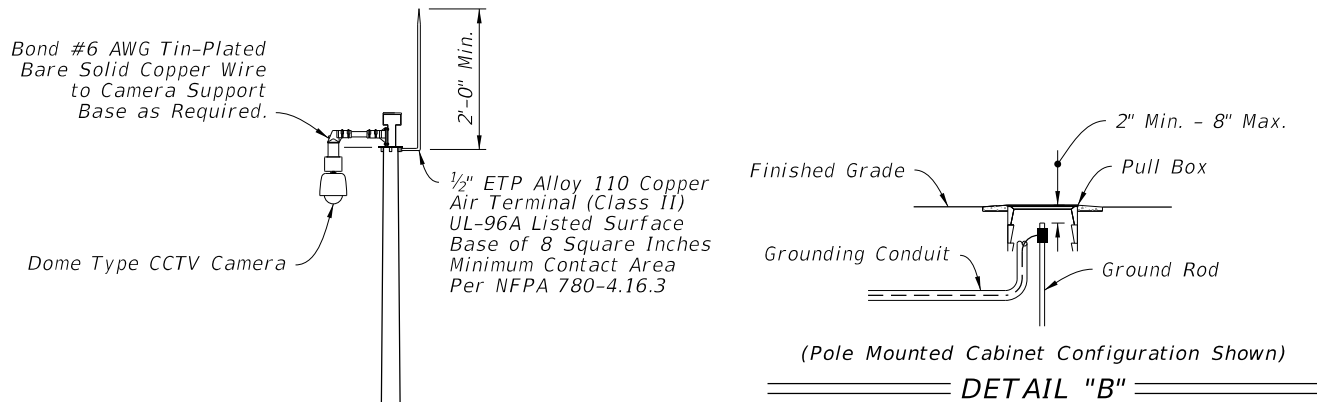

STEEL CCTV POLE GROUNDING

LAST REVISION 11/01/22	REVISION	DESCRIPTION:	FDOT	FY 2023-24 STANDARD PLANS	STEEL CCTV POLE	INDEX 649-020	SHEET 6 of 6
------------------------------	----------	--------------	------	------------------------------	-----------------	------------------	-----------------