
ORIGINATION FORM

Proposed Revisions to a Standard Plans Index

(Please provide all information — Incomplete forms will be returned)

Contact Information:

Date: May 12, 2022

Originator: Rick Jenkins

Phone: (850) 414-4355

Email: Rick.Jenkins@dot.state.fl.us

Standard Plans:

Index Number: 700-031

Sheet Number (s): 2 of 2

Index Title: External Lighting for Signs

Summary of the changes:

Added Note 1 - "Meet the requirements of Specification 700"; Deleted Note 2 and 3; Renumbered Notes.

Commentary / Background:

The 700 Index Series is being edited to remove material information and other information that is located in the Standard Specifications. Revisions are being made to Specification Sections 700, 962 and 965 in conjunction with these changes.

Other Affected Offices / Documents: (Provide name of person contacted)

Yes No

- | | |
|-------------------------------------|--|
| ☒ | ☐ Other Standard Plans – |
| ☐ | ☒ FDOT Design Manual – Dewayne Carver |
| ☒ | ☐ Basis of Estimates Manual – Ryan Gray |
| ☒ | ☐ Standard Specifications – Daniel Strickland |
| ☐ | ☒ Approved Product List – Missy Hollis |
| ☐ | ☒ Construction – Jason Russell |
| ☐ | ☒ Maintenance – Deanna Hutchison |

Origination Package Includes: (Submit package to Rick Jenkins)

Yes N/A

- | | |
|-------------------------------------|--|
| ☒ | ☐ Redline Mark-ups |
| ☐ | ☐ Revised or Proposed Standard Plan Instruction (SPI) |
| ☐ | ☐ Other Support Documents |


Implementation:

- | | |
|-------------------------------------|----------------------------------|
| ☐ | Design Bulletin (Interim) |
| ☐ | DCE Memo |
| ☐ | Program Mgmt. Bulletin |
| ☒ | FY-Standard Plans (Next Release) |

Contact the Roadway Design Office for assistance in completing this form

Email to: Rick Jenkins rick.jenkins@dot.state.fl.us and Darren Martin darren.martin@dot.state.fl.us

9/22/2021 1:51:59 PM

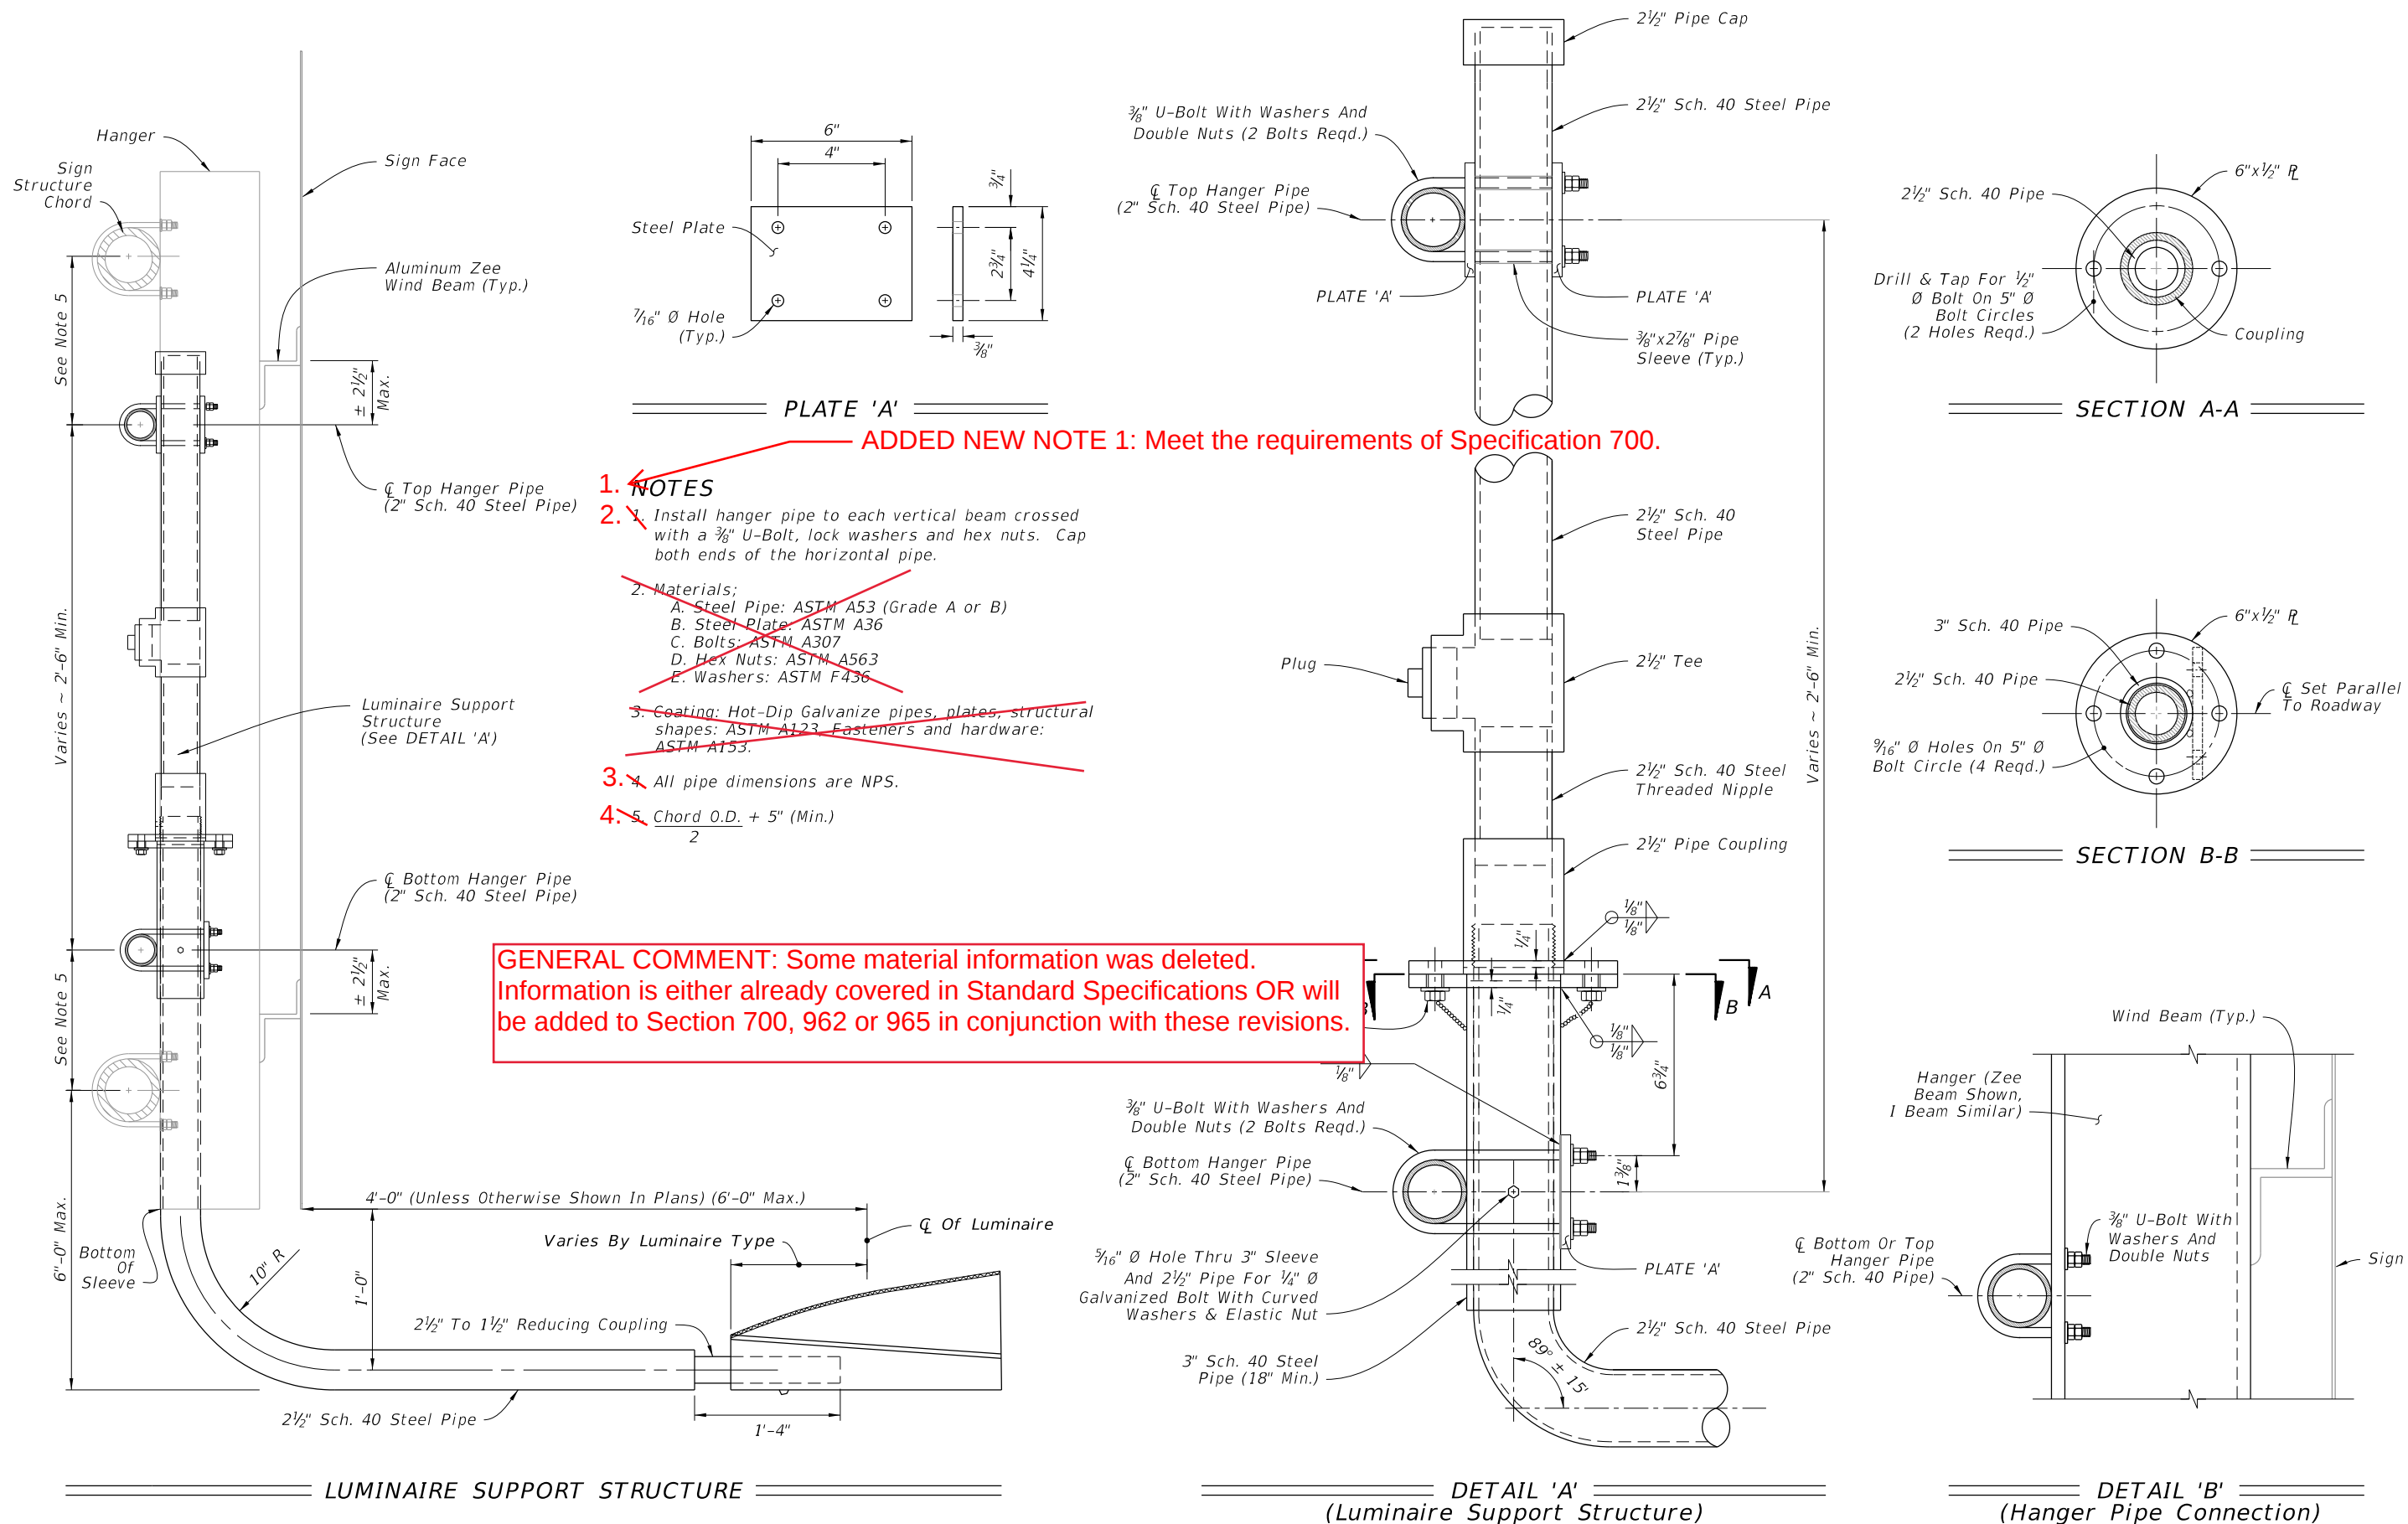

FY 2022-23
STANDARD PLANS

EXTERNAL LIGHTING FOR SIGNS

INDEX
700-031

SHEET
2 of 2

LAST
REVISION
11/01/17
11/01/22

DESCRIPTION:

