
ORIGINATION FORM

Proposed Revisions to a Standard Plans Index

(Please provide all information — Incomplete forms will be returned)

Contact Information:

Date: May 12, 2022

Originator: Rick Jenkins

Phone: (850) 414-4355

Email: Rick.Jenkins@dot.state.fl.us

Standard Plans:

Index Number: 700-041

Sheet Number (s): 1, 2, and 5 of 5

Index Title: Span Sign Structure

Summary of the changes:

Sheet 1: Updated Notes to General Notes; Added New General Note 1 - "Meet the requirements of Specification 700"; Deleted Notes 4 through 7; Moved Note 5.B and 5.C to Sheet 5 Notes; Renumbered Notes.

Sheet 2: Added note 6 detailing the weld pattern of the 'BD' and 'CD' plates indicating that they should be welded in a star pattern.

Sheet 5: Added General Note 5.B and 5.C as New Note 2 - "Chord Splices: Minimum splice spacing is three truss panel lengths apart and three truss panel lengths from the uprights when panel lengths are 10'-0" or less. Chord Splices may be either the Standard Splice or the Alternate Splice, but not both on the same structure." and Note 3 - "Upright splice: Not allowed unless the upright exceeds available mill lengths (35' - 40')."

Commentary / Background:

The 700 Index Series is being edited to remove material information and other information that is located in the Standard Specifications. Revisions are being made to Specification Sections 700, 962 and 965 in conjunction with these changes.

Sheet 2: This process is to help prevent residual stress buildup in base plate connection to prevent cracking.

Other Affected Offices / Documents: (Provide name of person contacted)

Yes	No	
☒	☐	Other Standard Plans –
☐	☒	FDOT Design Manual – Dewayne Carver
☒	☐	Basis of Estimates Manual – Ryan Gray
☒	☐	Standard Specifications – Daniel Strickland
☐	☒	Approved Product List – Missy Hollis
☐	☒	Construction – Jason Russell
☐	☒	Maintenance – Deanna Hutchison

Origination Package Includes: (Submit package to Rick Jenkins)

Yes	N/A	
☒	☐	Redline Mark-ups
☐	☐	Revised or Proposed Standard Plan Instruction (SPI)
☐	☐	Other Support Documents

Implementation:

☐	Design Bulletin (Interim)
☐	DCE Memo
☐	Program Mgmt. Bulletin
☒	FY-Standard Plans (Next Release)

Contact the Roadway Design Office for assistance in completing this form

Email to: Rick Jenkins rick.jenkins@dot.state.fl.us and Darren Martin darren.martin@dot.state.fl.us

1. NOTES:

2. ~~Work this Index in conjunction with SPAN SIGN STRUCTURE DATA TABLES in the Plans and Index 700-030.~~
3. ~~Handholes at the pole base are required for DMS Structures. Refer to Index 700-090 for Handhole Details.~~
4. ~~Shop Drawings are required.~~

Obtain Shop Drawing approval prior to fabrication. Include the following:

A. Upright Pipe height ('C' & 'B') and foundation elevations: Verify dimensions in the field prior to submittal to ensure minimum vertical clearances of the sign panel over the roadway.

B. Height of the foundation above adjacent ground.

C. Anchor bolt orientation with respect to centerline of truss and the direction of traffic.

D. Method to be used to provide the required parabolic camber (see Camber Diagram).

E. Handholes at pole base (when required).

4. Materials:

- A. Sign Structure:
- a. Upright and Chords (Steel Pipe): API 5L X42 PSL2, 42 ksi yield or ASTM A500, Grade B (Min.)
- b. Steel Angles and Plates: ASTM A709 grade 36
- c. Weld Material: E70XX
- B. Bolts, Nuts and Washers:
- a. High Strength Bolts: ASTM F3125, Grade A325, Type 1
- b. Nuts: ASTM A563, Grade DH Heavy-Hex
- c. Washers: ASTM F436, Type 1, one under turned element
- C. Anchor Bolts, Nuts and Washers
- a. Anchor Bolts: ASTM F1554 Grade 55
- b. Nuts: ASTM A563 Grade A Heavy-Hex (5 per bolt)
- c. Plate Washers: ASTM A36 (2 per bolt)
- D. Concrete: Class IV (Drilled Shaft)
- E. Reinforcing Steel: Specification 415

5. Fabrication:

- A. ~~Welding: Specification 460-6.4~~
- B. Chord Splices: Minimum splice spacing is three truss panel lengths apart and three truss panel lengths from the uprights when panel lengths are 10'-0" or less. Chord Splices may be either the Standard Splice or the Alternate Splice, but not both on the same structure.
- C. Upright splice: Not allowed unless the upright exceeds available mill lengths (35' - 40').
- D. Structural bolt hole diameters: Bolt diameter plus $\frac{1}{16}$ ".
- E. Anchor bolt hole diameters: Bolt diameter plus $\frac{1}{2}$ ".
- F. Hot Dip Galvanize after fabrication.
- G. Shop assemble the entire structure after galvanizing to validate/document alignment and clearance for bolted connections as well as contact between connecting plates. Take remedial action, if necessary, prior to shipment.
- H. Disassemble as necessary and secure components for shipment.

6. Coatings:

- A. Bolts, Nuts and Washers: ASTM F2329
- B. All other steel, including Plate Washers, hot dip galvanize: ASTM A123

7. Construction:

- A. Construct foundation in accordance with Specification 455 Drilled Shaft, except payment is included in the cost of the structure.
- B. Prior to erection, record the as-built anchor locations and submit to the Engineer.
5. C. Provide a parabolic camber with the required upward deflection as shown on the Camber Diagram.
- D. ~~Tighten nuts and bolts in accordance with Specification 700. Split-Lock Washers are not permitted.~~
- E. Install Aluminum Sign Panels as shown in the Plans.
- F. After installation, place wire screen between top of foundation and bottom of baseplate in accordance with Specification 649-6.

ADDED NEW NOTE 1: Meet the requirements of Specification 700.


UPDATED: GENERAL NOTES:

DELETED

MOVED TO: Sheet 5 Notes.


DELETED

DELETED

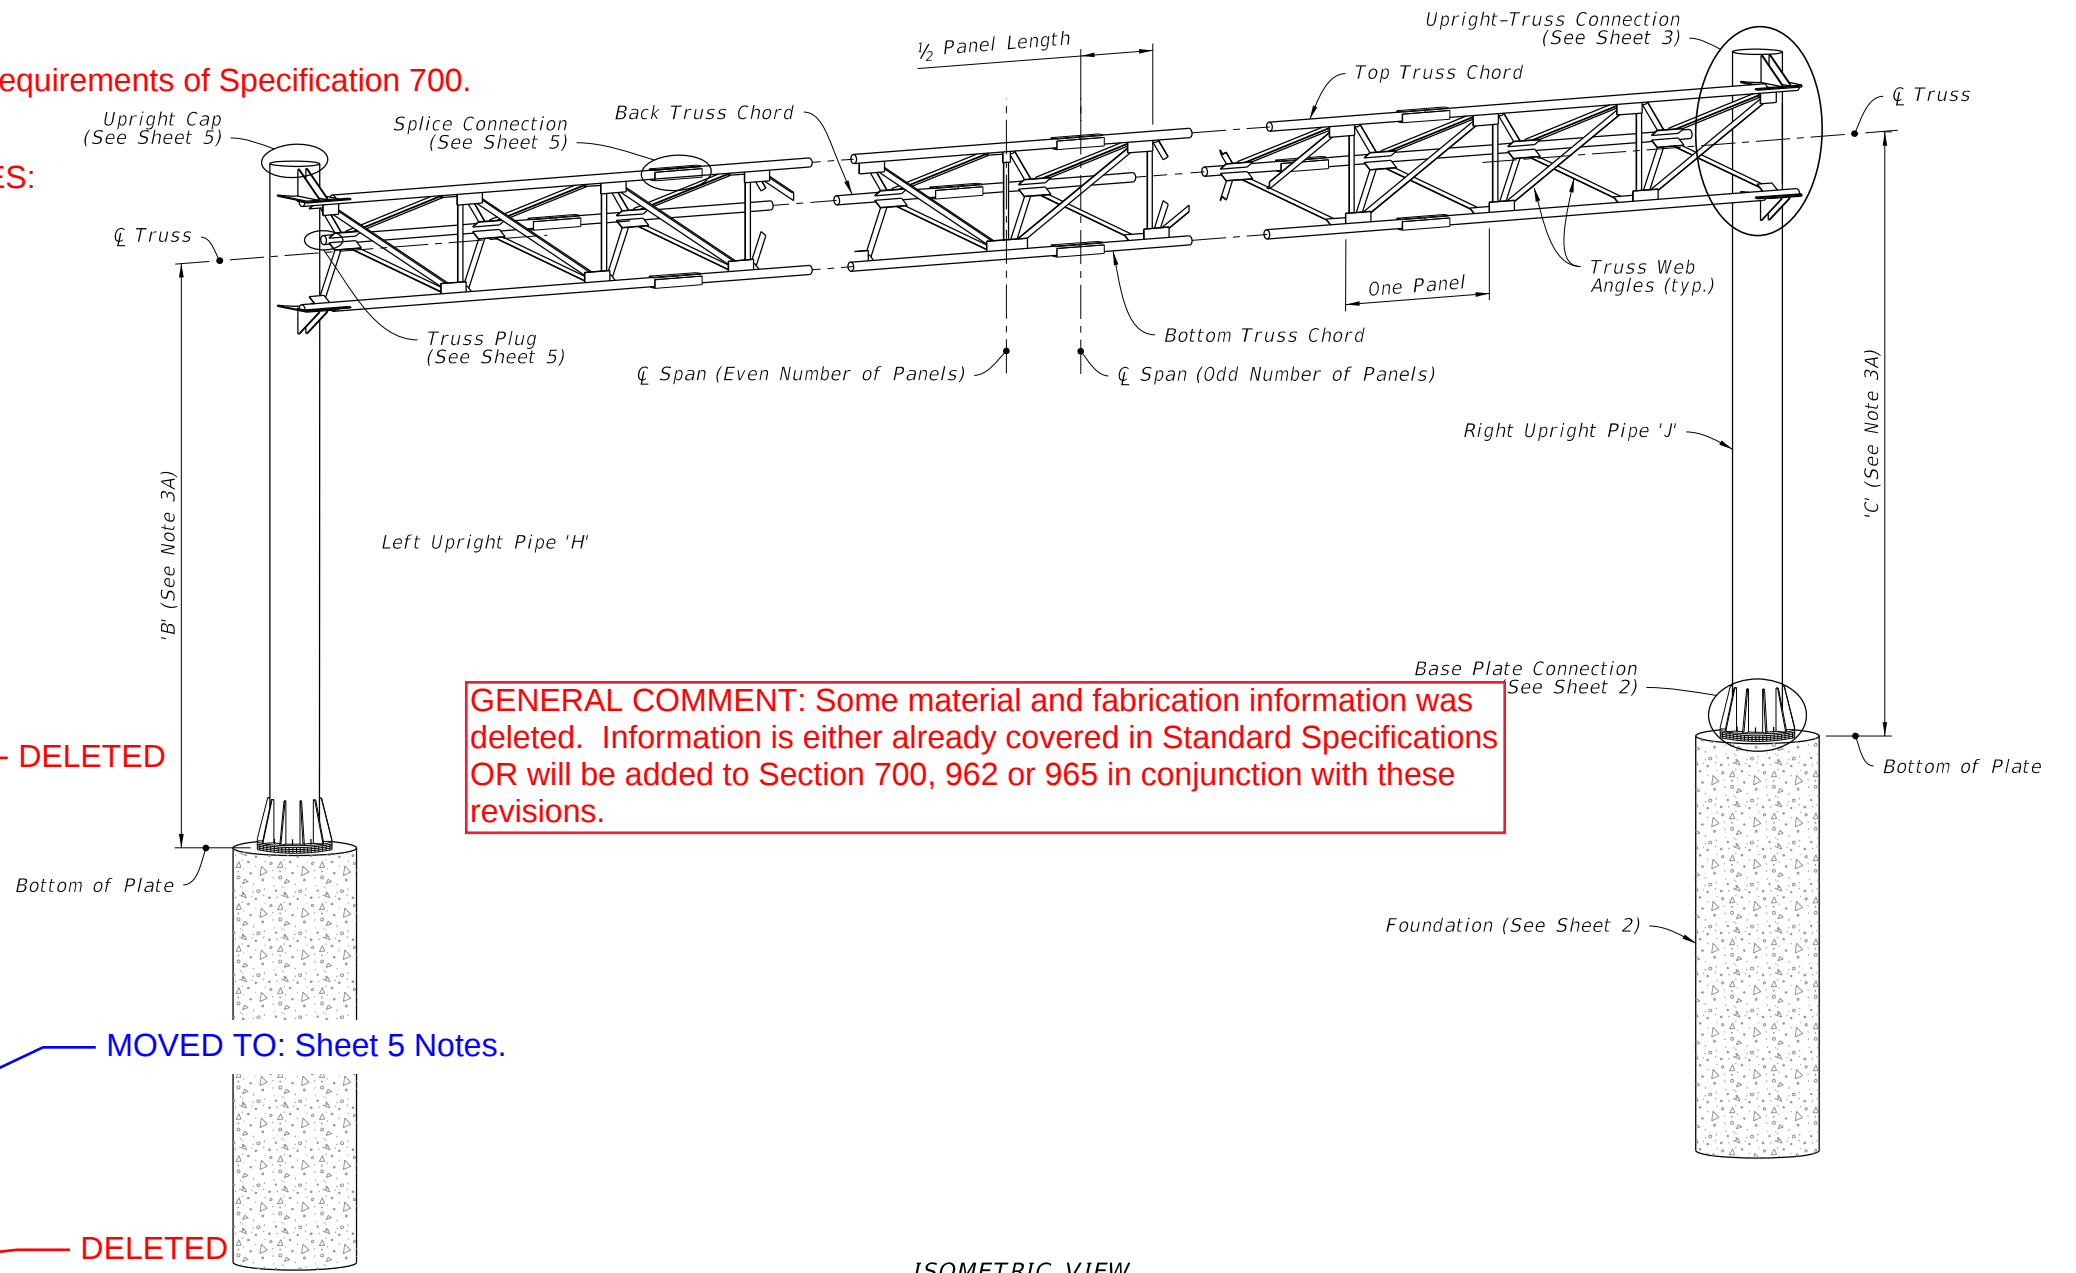

ISOMETRIC VIEW


SPAN SIGN ASSEMBLY

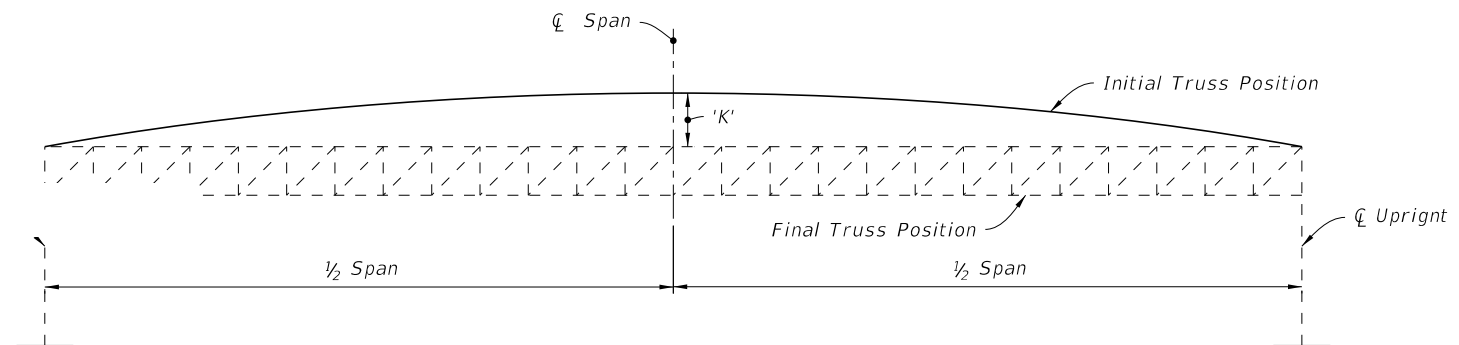


CAMBER DIAGRAM

9/43:50 AM
9/28/2021


LAST REVISION	DESCRIPTION:	FY 2022-23 STANDARD PLANS	SPAN SIGN STRUCTURE	INDEX	SHEET
11/01/19	11/01/22	FDOT		700-041	1 of 5

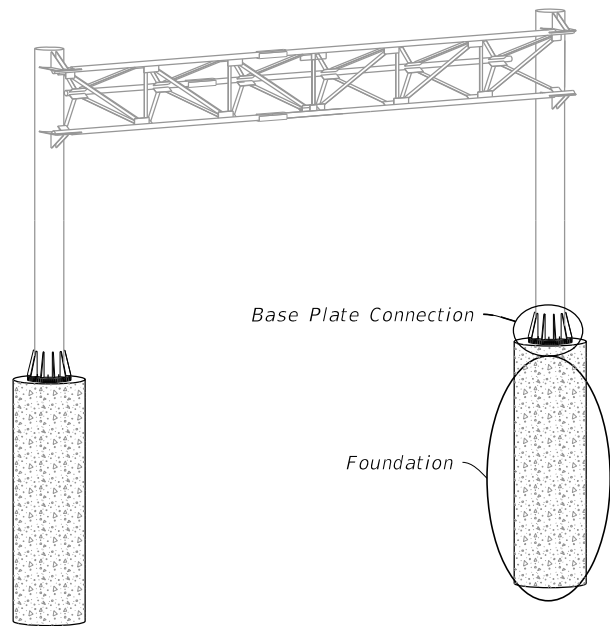

SPAN SIGN ASSEMBLY

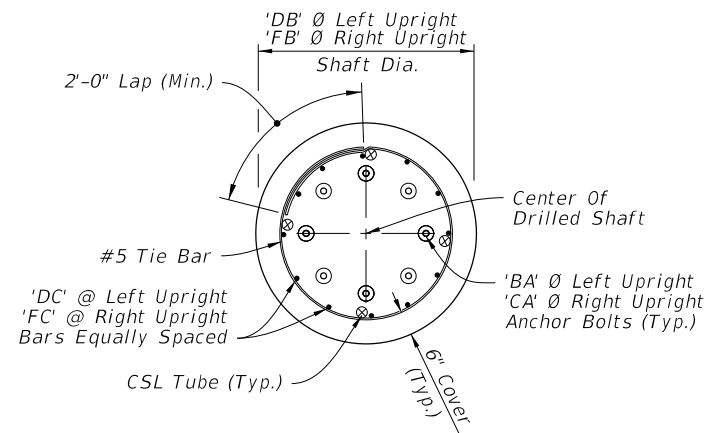

PLAN

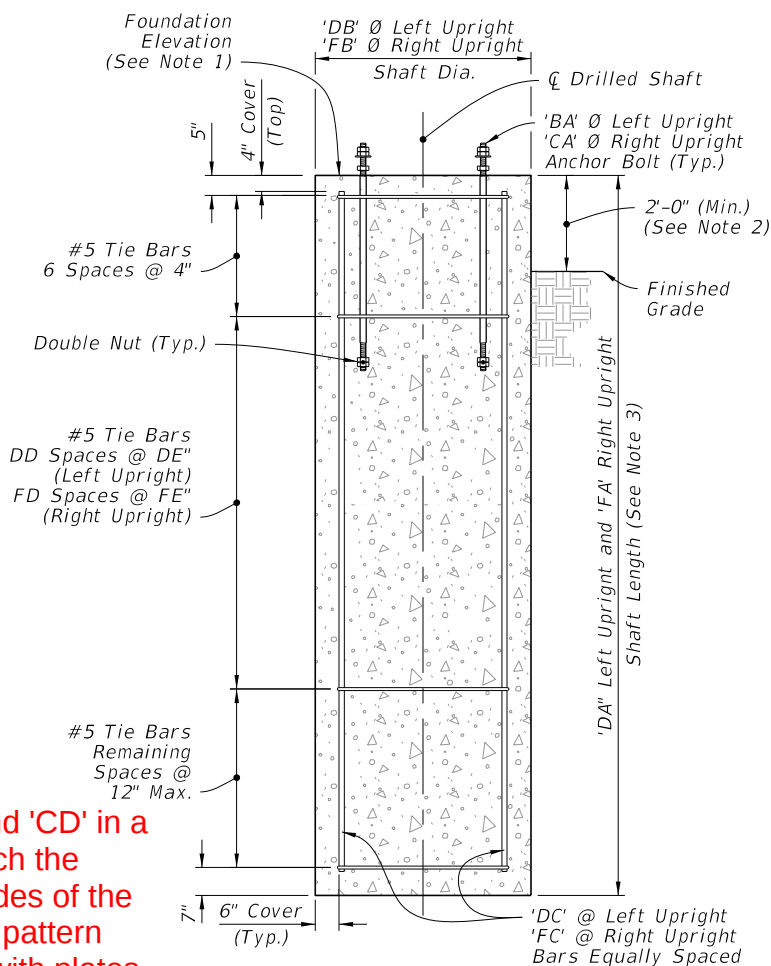

ELEVATION


DRILLED SHAFT

FOUNDATION




DETAIL "A"

DETAIL "B"

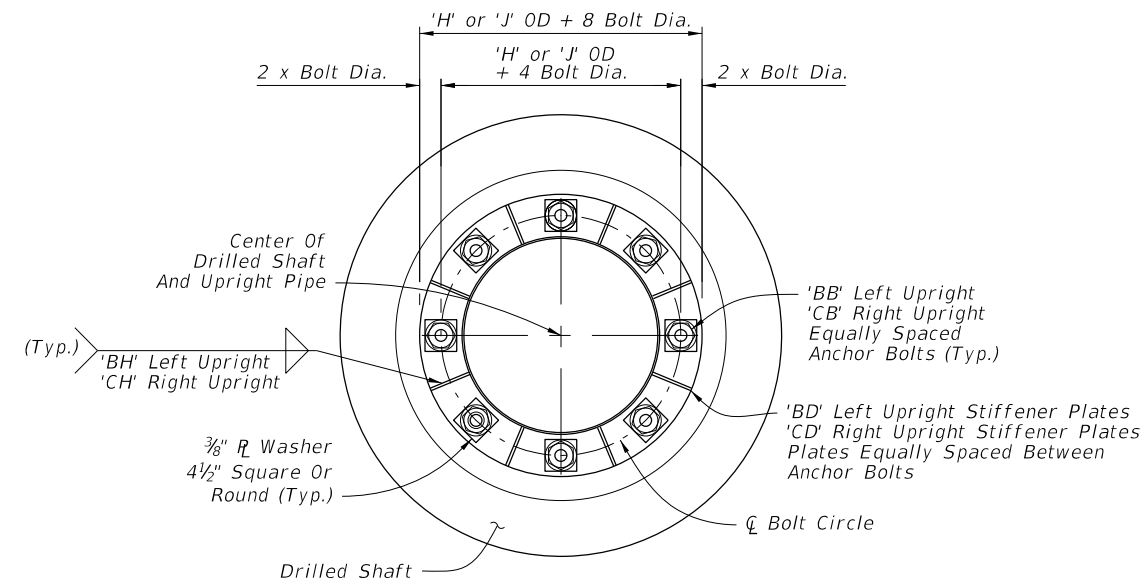

PLAN

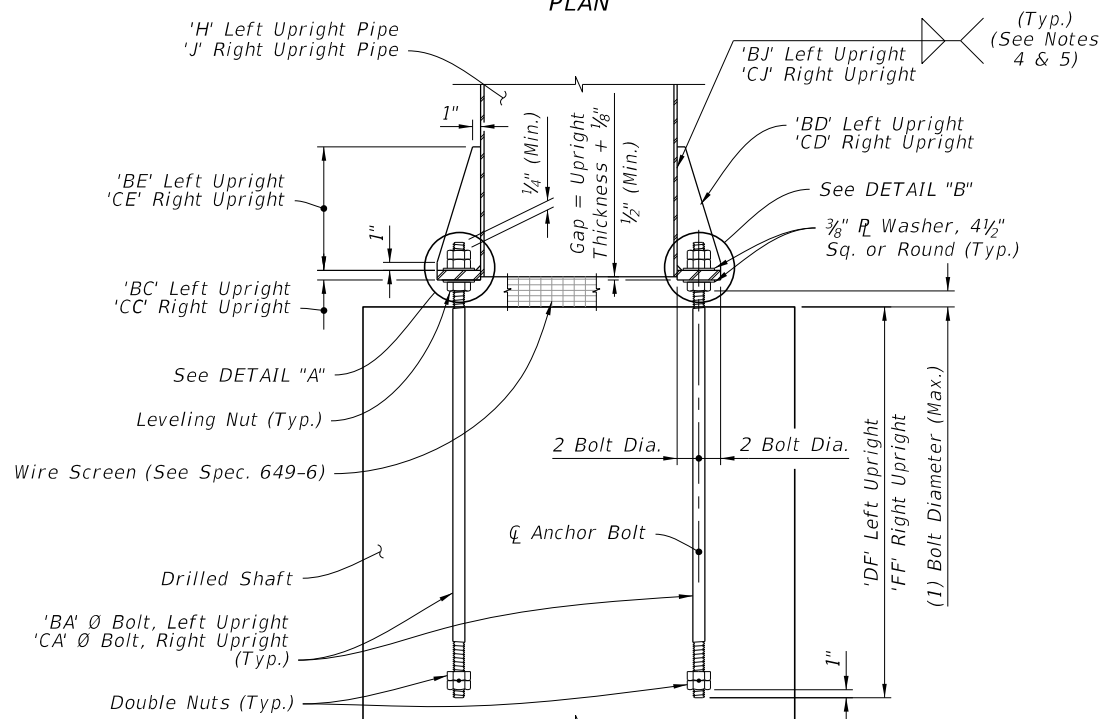

ELEVATION

BASE PLATE CONNECTION


NOTES:

1. See Traffic Plans for elevation at top of Foundation.
2. Install Drilled Shaft with a 2'-0" minimum from top elevation of the drill shaft to the finished grade, unless specified otherwise in the plans.
3. The shaft length is based on 2'-0" height above finished grade.
4. Wrap fillet weld around the stiffener termination on the tube wall (Typ).
5. After galvanizing, provide magnetic particle testing on 100% of upright fillet welds.


6.

ADDED NOTE 6: 6. Weld plates 'BD' and 'CD' in a star pattern. A star pattern is one in which the plates on opposite and near opposite sides of the pole circle are successively welded in a pattern resembling a star. For an 8 plate circle with plates sequentially numbered 1 to 8, weld the plates in the following order: (1, 5, 7, 3, 8, 4, 6, 2).

LAST REVISION	DESCRIPTION:	FY 2022-23 STANDARD PLANS	SPAN SIGN STRUCTURE	INDEX	SHEET
11/01/21	11/01/22	FDOT		700-041	2 of 5

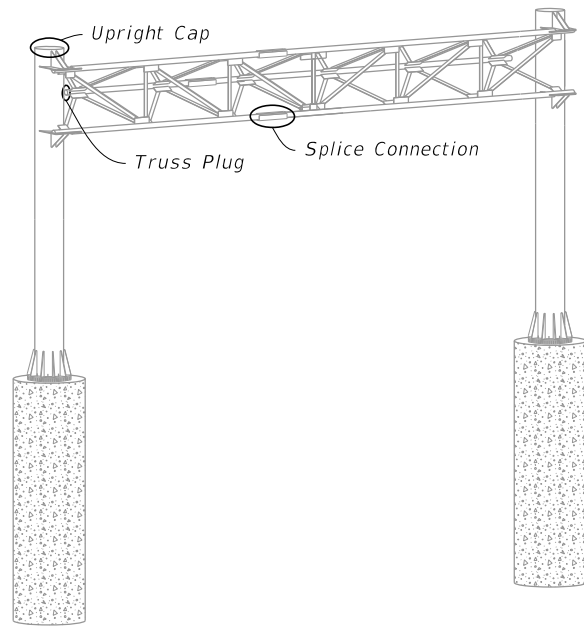


SPAN SIGN ASSEMBLY

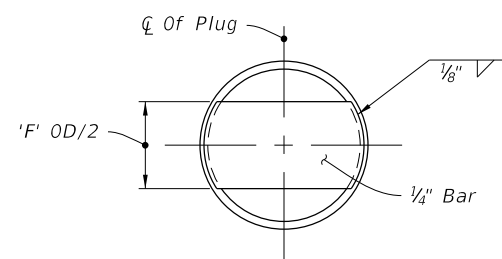


(Each End Of Back Truss Chord)

TRUSS PLUG DETAIL

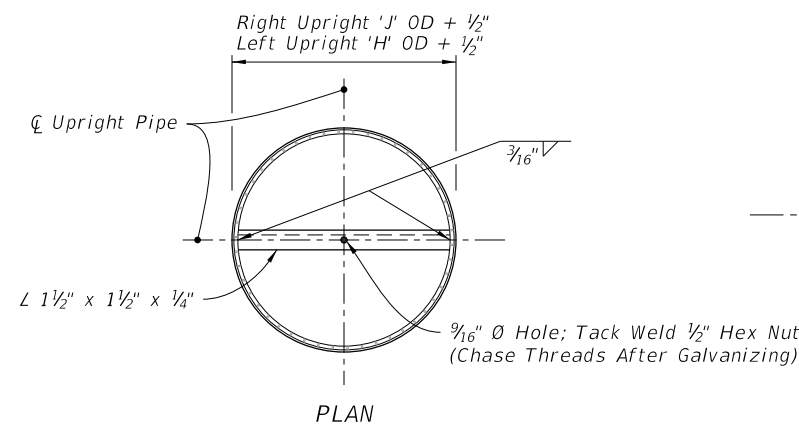

PLAN

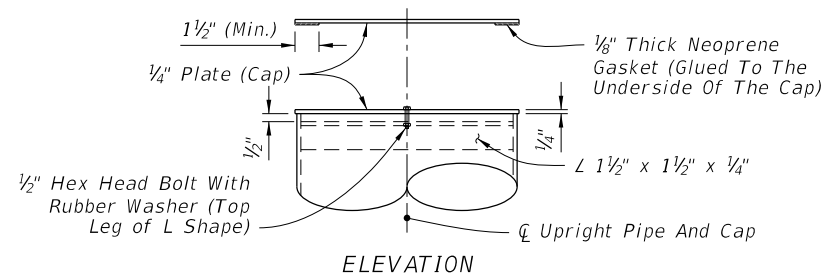

ELEVATION

UPRIGHT CAP DETAIL

Bolt Diameter (in.)	Distance (in.)	
	A	B
1	1 3/4	3 1/2
7/8	1 1/2	3
3/4	1 1/4	2 1/2

SPLICE CONNECTION NOTE:



1. Only 6 bolts are shown in detail for clarity. (One Half Each End Of Splice)

2.
3.


ADDED NOTES 2 AND 3:

2. Chord Splices: Minimum splice spacing is three truss panel lengths apart and three truss panel lengths from the uprights when panel lengths are 10'-0" or less. Chord Splices may be either the Standard Splice or the Alternate Splice, but not both on the same structure.


3. Upright splice: Not allowed unless the upright exceeds available mill lengths (35' - 40').

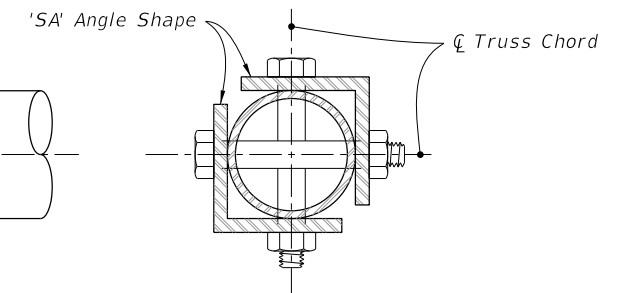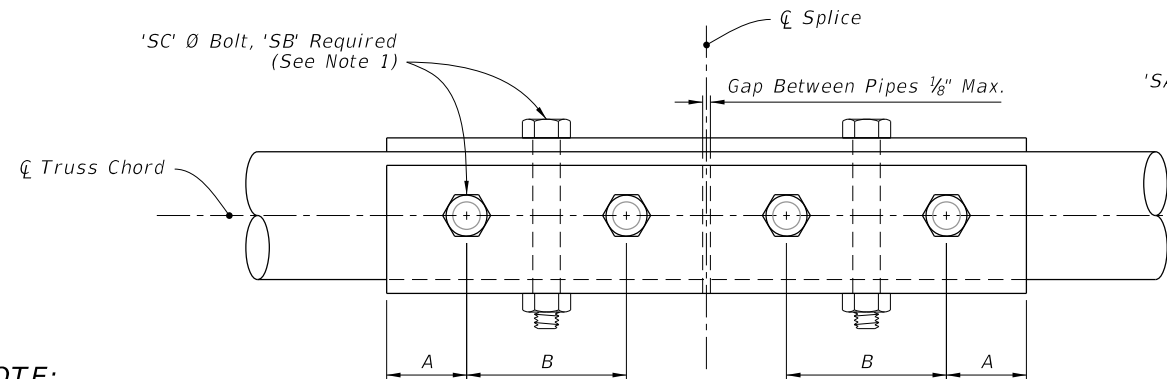


SIDE ELEVATION

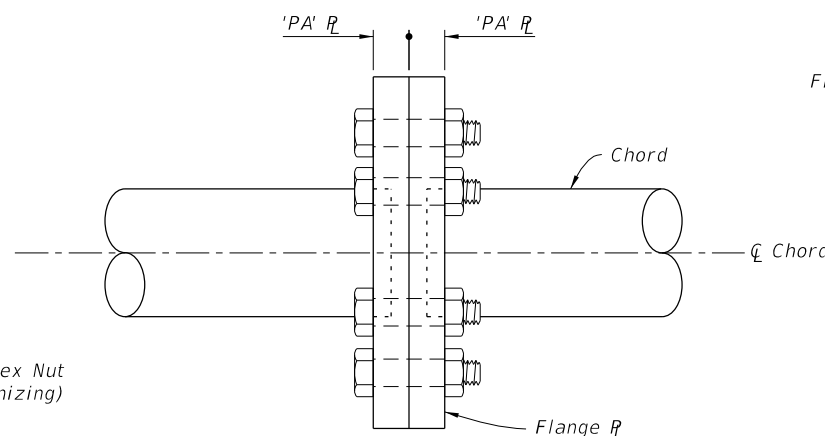

FRONT ELEVATION

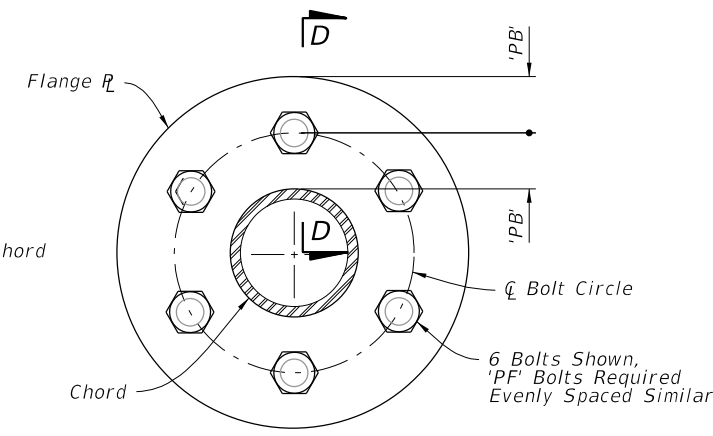

SIDE ELEVATION

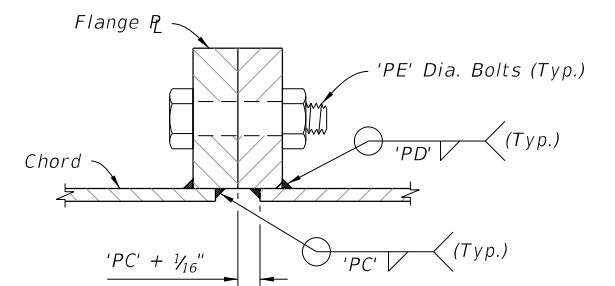

SECTION D-D

ALTERNATE SPLICE CONNECTION DETAIL

9/28/2021 9:43:54 AM

1. Meet the requirements of Specification 700.

- Obtain Shop Drawing approval prior to fabrication. Include the following:*

B. Height of the foundation above adjacent ground.

D. Method to be used to provide the required parabolic camber (see Camber Diagram).

E. Handholes at pole base (when required).


-
- Upright Cap (See Sheet 5)
- Splice Connection (See Sheet 5)
- Back Truss Chord
- 1/2 Panel Length
- Top Truss Chord
- Upright-Truss Connection (See Sheet 3)
- Truss Web Angles (typ.)
- One Panel
- Bottom Truss Chord
- Truss Plug (See Sheet 5)
- Left Upright Pipe 'H'
- Right Upright Pipe 'J'
- Base Plate Connection (See Sheet 2)
- Foundation (See Sheet 2)
- Bottom of Plate
- Bottom of Plate
- CL Truss
- CL Span (Even Number of Panels)
- CL Span (Odd Number of Panels)
- 'B' (See Note 3A)
- 'C' (See Note 3A)
- ISOMETRIC VIEW

ISOMETRIC VIEW


The diagram illustrates the initial and final truss positions of a bridge. The bridge is divided into three sections: a central span of length l and two side spans of length $l/2$. The initial truss position is shown as a solid line, and the final truss position is shown as a dashed line. The vertical displacement of the central span is labeled K . The diagram also shows the initial and final truss positions for the side spans, labeled $l/2$ Span. The initial truss position is labeled $Initial\ Truss\ Position$ and the final truss position is labeled $Final\ Truss\ Position$. The diagram also shows the initial and final truss positions for the side spans, labeled $l/2$ Span. The initial truss position is labeled $Initial\ Truss\ Position$ and the final truss position is labeled $Final\ Truss\ Position$.

= CAMBER DIAGRAM


LAST REVISION 11/01/22	REVISION	DESCRIPTION:	 FY 2023-24 STANDARD PLANS	SPAN SIGN STRUCTURE	INDEX 700-041	SHEET 1 of 5
------------------------------	----------	--------------	---	---------------------	------------------	-----------------

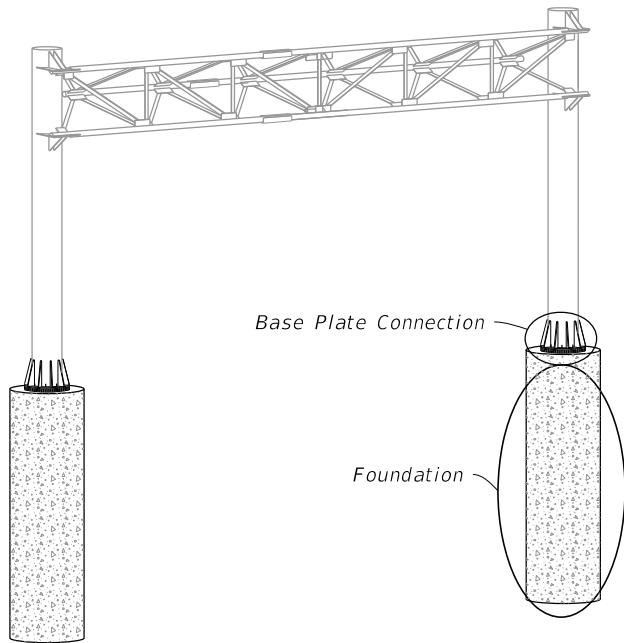

SPAN SIGN ASSEMBLY

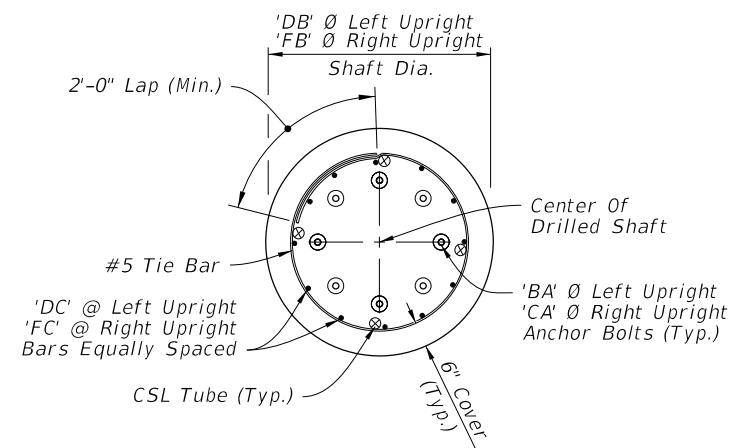


PLAN

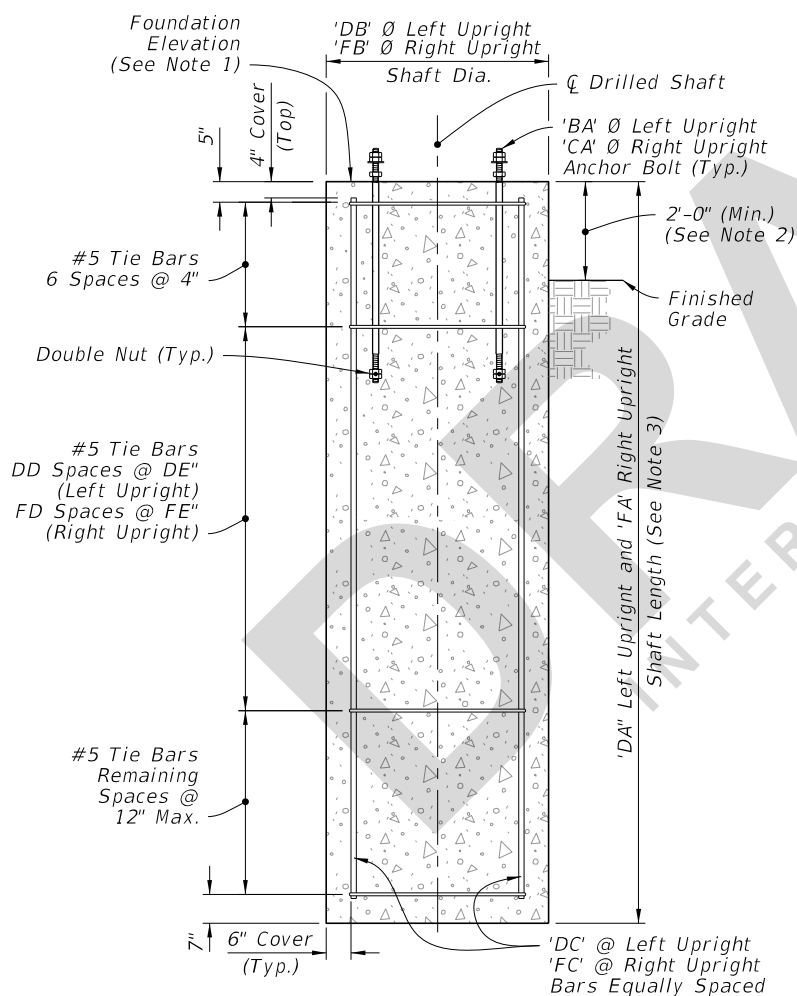


ELEVATION

DRILLED SHAFT


FOUNDATION

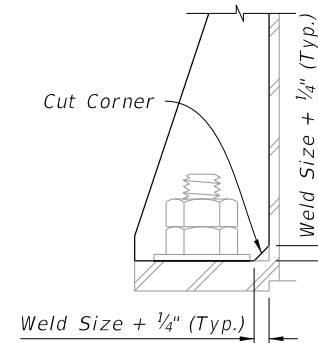


DETAIL "A"

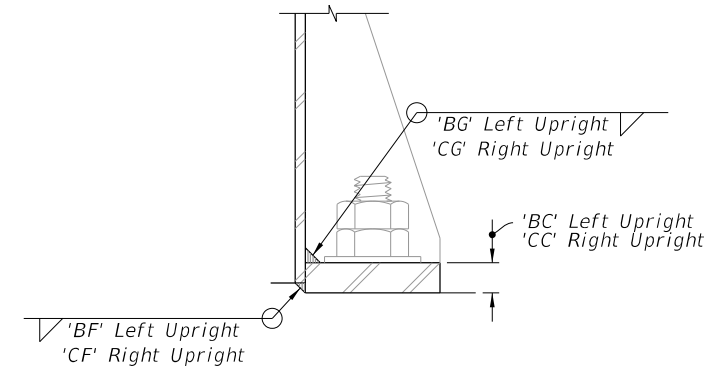

DETAIL "B"

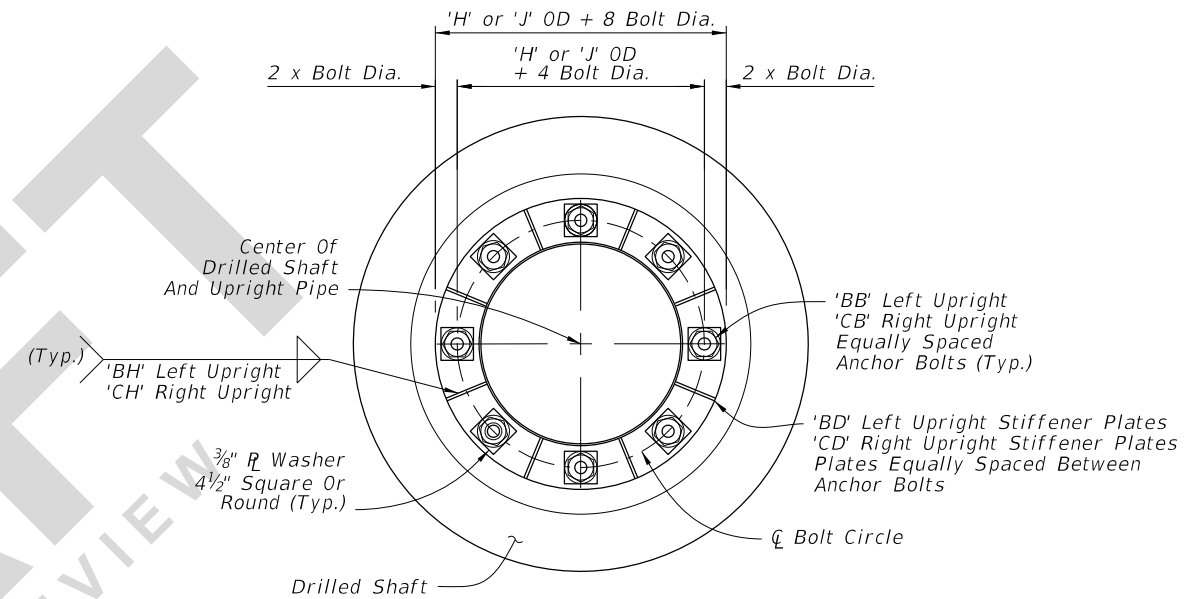

PLAN

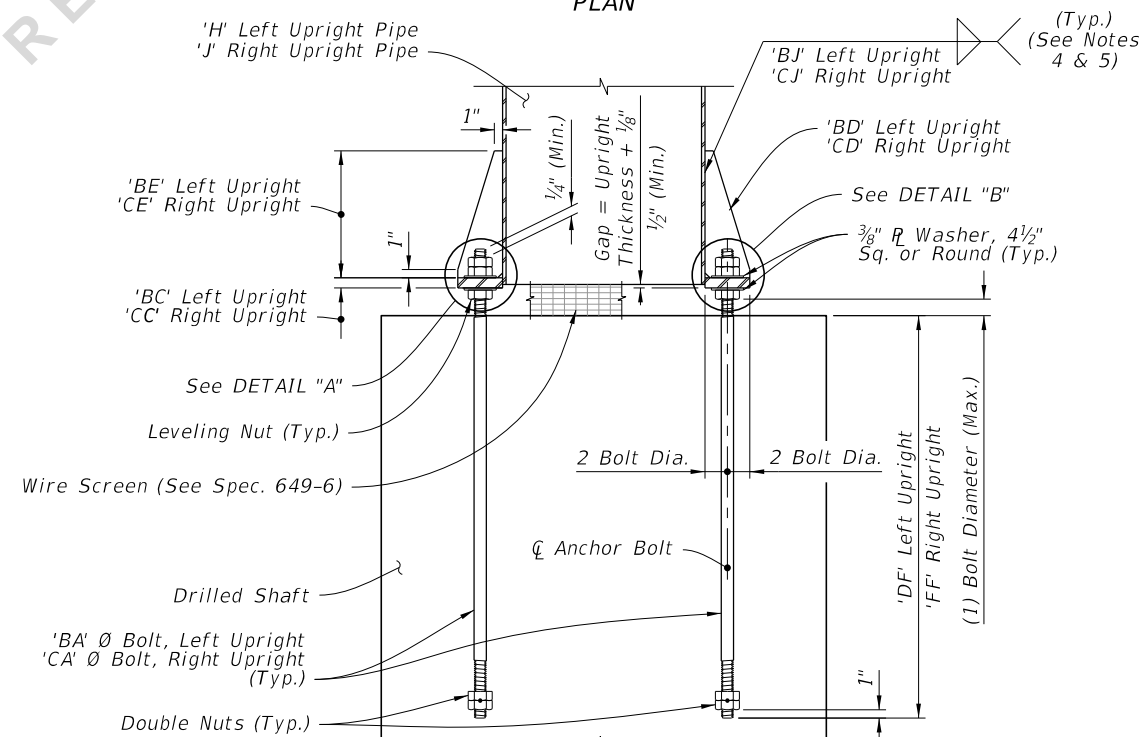


ELEVATION

BASE PLATE CONNECTION

NOTES:

1. See Traffic Plans for elevation at top of Foundation.
2. Install Drilled Shaft with a 2'-0" minimum from top elevation of the drill shaft to the finished grade, unless specified otherwise in the plans.
3. The shaft length is based on 2'-0" height above finished grade.
4. Wrap fillet weld around the stiffener termination on the tube wall (Typ.).
5. After galvanizing, provide magnetic particle testing on 100% of upright fillet welds.
6. Weld plates 'BD' and 'CD' in a star pattern. A star pattern is one in which the plates on opposite and near opposite sides of the pole circle are successively welded in a pattern resembling a star. For an 8 plate circle with plates sequentially numbered 1 to 8, weld the plates in the following order: (1, 5, 7, 3, 8, 4, 6, 2).

LAST REVISION	DESCRIPTION:	FDOT	FY 2023-24 STANDARD PLANS	SPAN SIGN STRUCTURE	INDEX	SHEET
11/01/22					700-041	2 of 5

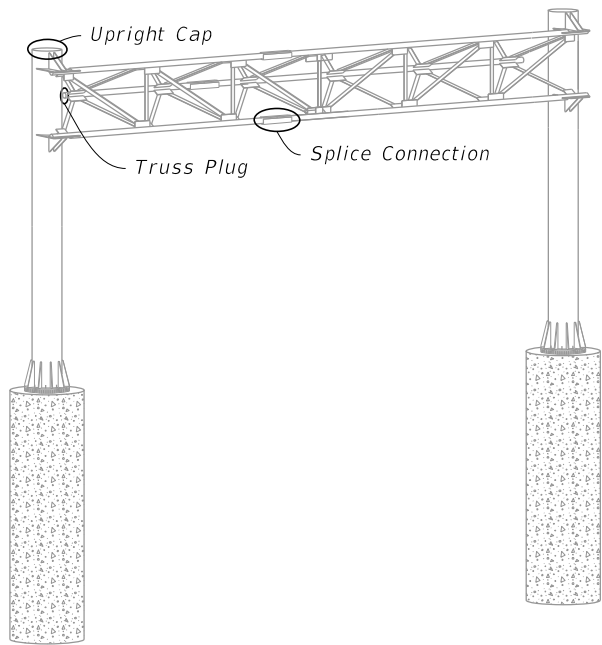


SPAN SIGN ASSEMBLY


Bolt Diameter (in.)	Distance (in.)	
	A	B
1	1 3/4	3 1/2
7/8	1 1/2	3
3/4	1 1/4	2 1/2

SPLICE CONNECTION NOTE:

- Only 6 bolts are shown in detail for clarity.
(One Half Each End Of Splice)
- Chord Splices: Minimum splice spacing is three truss panel lengths apart and three truss panel lengths from the uprights when panel lengths are 10'-0" or less.
Chord Splices may be either the Standard Splice or the Alternate Splice, but not both on the same structure.
- Upright splice: Not allowed unless the upright exceeds available mill lengths (35' - 40').

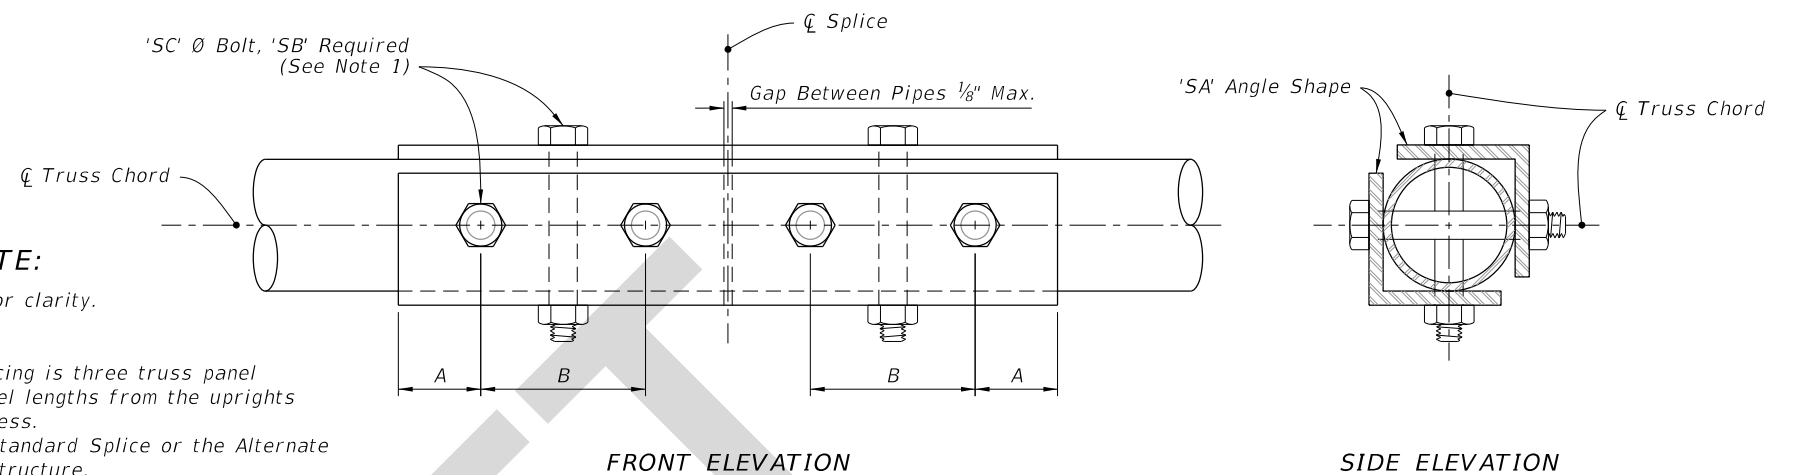


SPLICE CONNECTION DETAIL

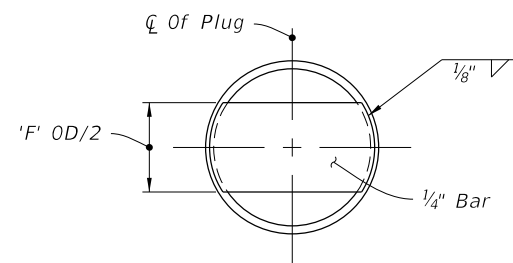


(Each End Of Back Truss Chord)

TRUSS PLUG DETAIL

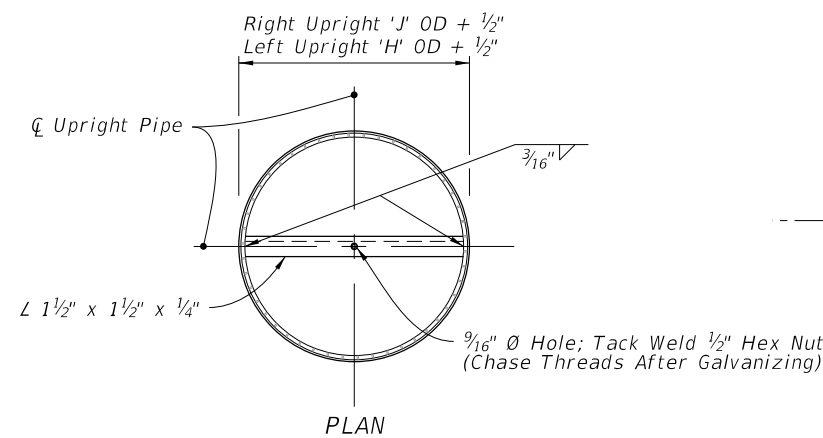


PLAN

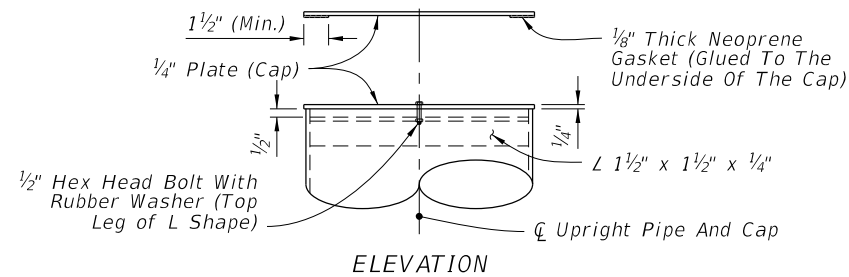

ELEVATION


UPRIGHT CAP DETAIL

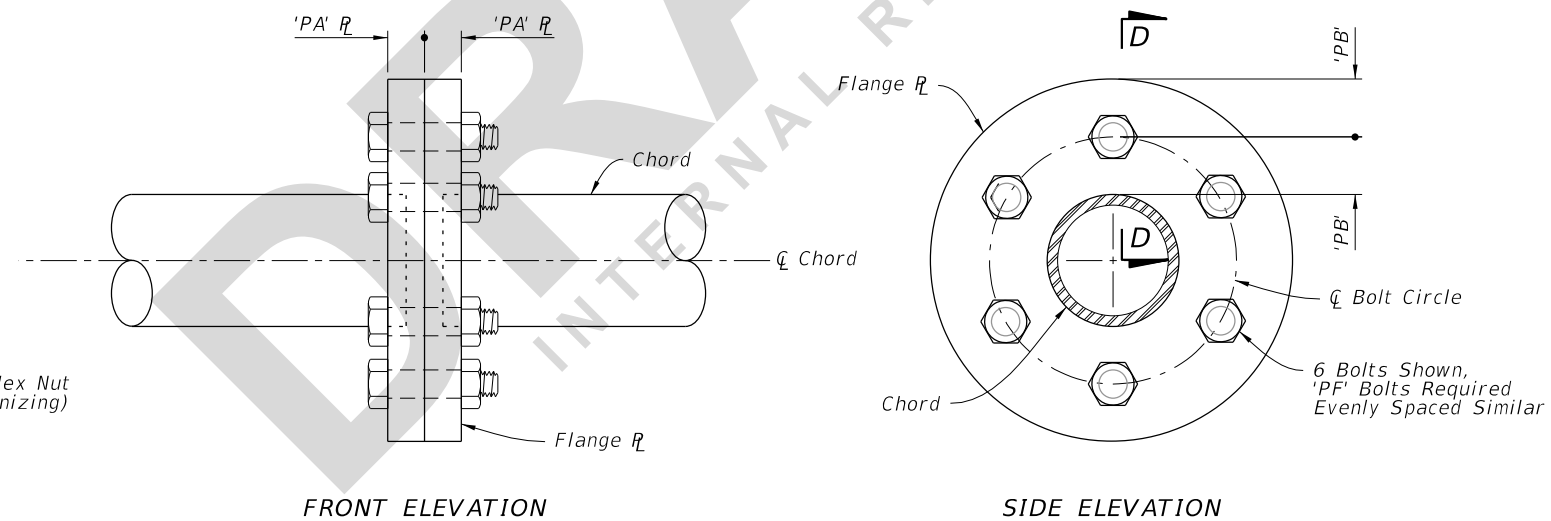

FRONT ELEVATION

SIDE ELEVATION

ALTERNATE SPLICE CONNECTION DETAIL

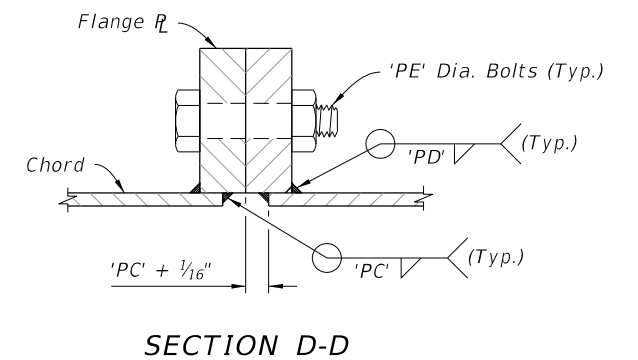

SECTION D-D

6/13/2022 11:58:14 AM