
ORINATION FORM

Proposed Revisions to a Standard Plans Index

(Please provide all information — Incomplete forms will be returned)

Contact Information:

Date: July 14, 2022

Originator: David Amato

Phone: (850) 414-4792

Email: david.amato@dot.state.fl.us

Standard Plans:

Index Number: 711-001

Sheet Number (s): 2 of 13

Index Title: Pavement Markings

Summary of the changes:

Sheet 2 : Changed "SHADOW" with "CONTRAST" in the 10-30' Skip Line and Dotted Line Details;
Added Longitudinal Solid Lane Line With Contrast Markings detail.

Commentary / Background:

This change is being proposed to be consistent with other FDOT documents and MUTCD. The term "shadow markings" is undefined and inconsistent with the other documents.

Other Affected Offices / Documents: (Provide name of person contacted)

- | Yes | No | |
|--------------------------|-------------------------------------|-----------------------------|
| <input type="checkbox"/> | <input checked="" type="checkbox"/> | Other Standard Plans – |
| <input type="checkbox"/> | <input checked="" type="checkbox"/> | FDOT Design Manual – |
| <input type="checkbox"/> | <input checked="" type="checkbox"/> | Basis of Estimates Manual – |
| <input type="checkbox"/> | <input checked="" type="checkbox"/> | Standard Specifications – |
| <input type="checkbox"/> | <input checked="" type="checkbox"/> | Approved Product List – |
| <input type="checkbox"/> | <input checked="" type="checkbox"/> | Construction – |
| <input type="checkbox"/> | <input checked="" type="checkbox"/> | Maintenance – |

Origination Package Includes: (Submit package to Rick Jenkins)



- | Yes | N/A | |
|-------------------------------------|-------------------------------------|---|
| <input checked="" type="checkbox"/> | <input type="checkbox"/> | Redline Mark-ups |
| <input type="checkbox"/> | <input checked="" type="checkbox"/> | Revised or Proposed Standard Plan Instruction (SPI) |
| <input type="checkbox"/> | <input checked="" type="checkbox"/> | Other Support Documents |

Implementation:


- | | |
|-------------------------------------|----------------------------------|
| <input type="checkbox"/> | Design Bulletin (Interim) |
| <input type="checkbox"/> | DCE Memo |
| <input type="checkbox"/> | Program Mgmt. Bulletin |
| <input checked="" type="checkbox"/> | FY-Standard Plans (Next Release) |

Contact the Roadway Design Office for assistance in completing this form


Email to: Rick Jenkins rick.jenkins@dot.state.fl.us and Darren Martin darren.martin@dot.state.fl.us

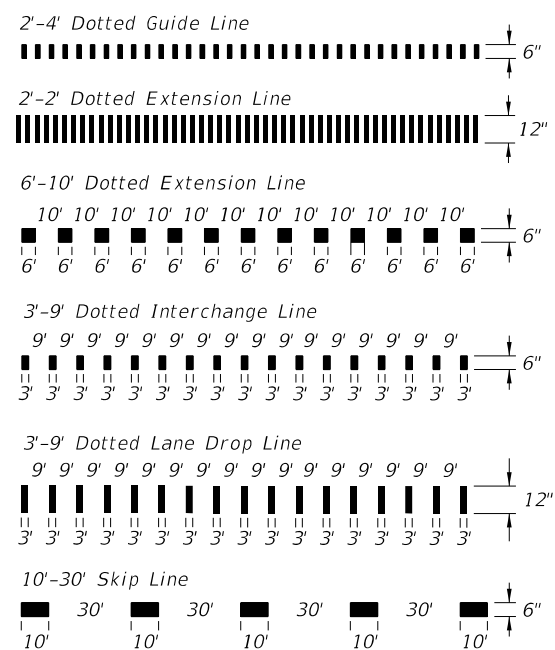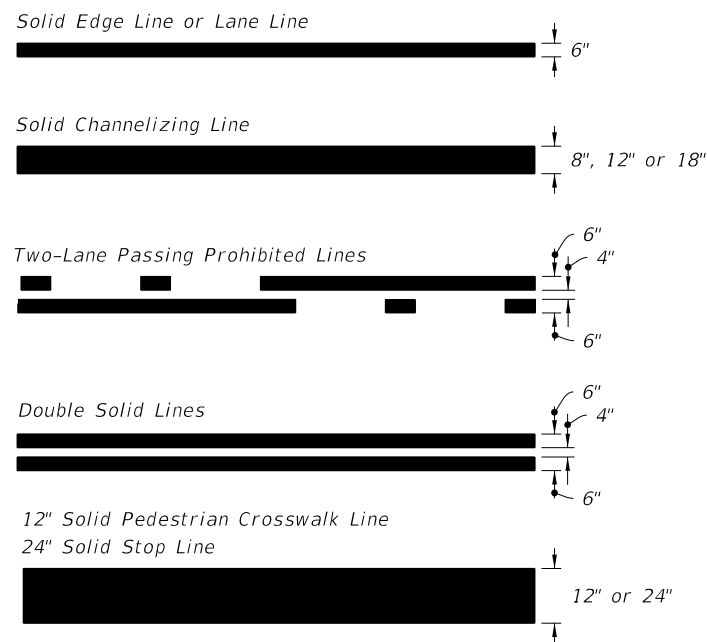


PAVEMENT MARKING LINES

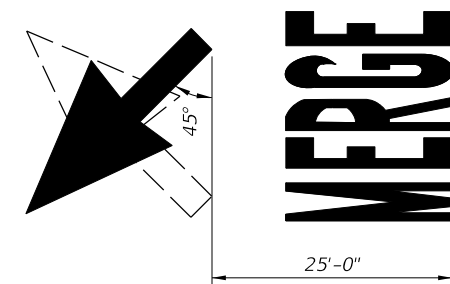

MARKINGS FOR MERGE

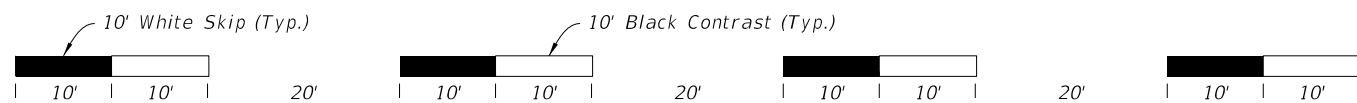


10'-30' SKIP LINE WITH SHADOW MARKINGS

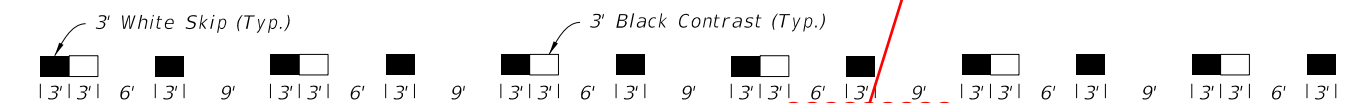

DOTTED LINE WITH ALTERNATING SHADOW MARKINGS
(3'-9' Dotted Line Shown, Other Dotted Lines Similar)

ADDED: Longitudinal Solid Lane Line With Contrast Markings detail.
11/01/22


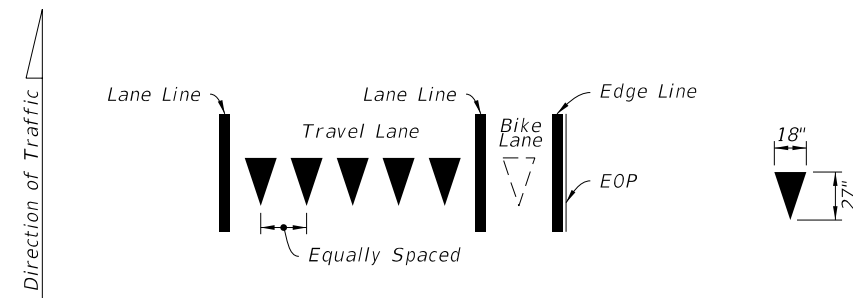


Yield Lines consist of five - 18" X 27" white triangles which face traffic. Equally space triangles within traffic lane. When a bike lane is present, add one additional triangle in the center of the bike lane.

YIELD LINES

9/22/2021 3:12:28 PM


| LAST REVISION | DESCRIPTION: |
|---------------|--|
| 11/01/21 | |
| 11/01/22 | ADDED: Longitudinal Solid Lane Line With Contrast Markings detail. |

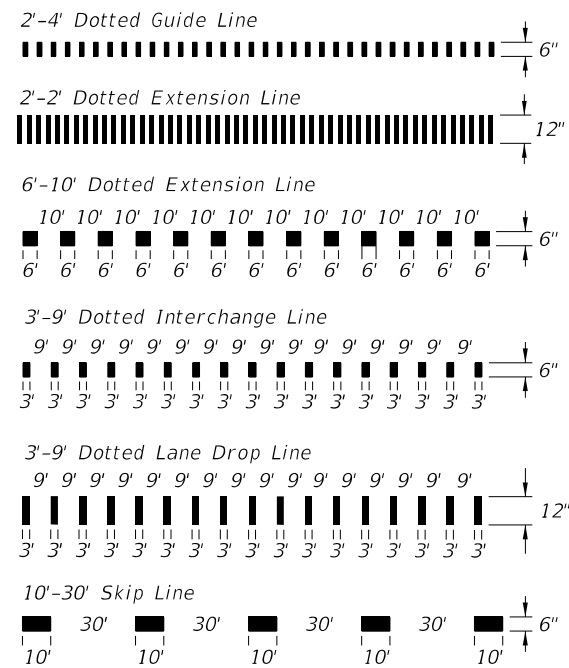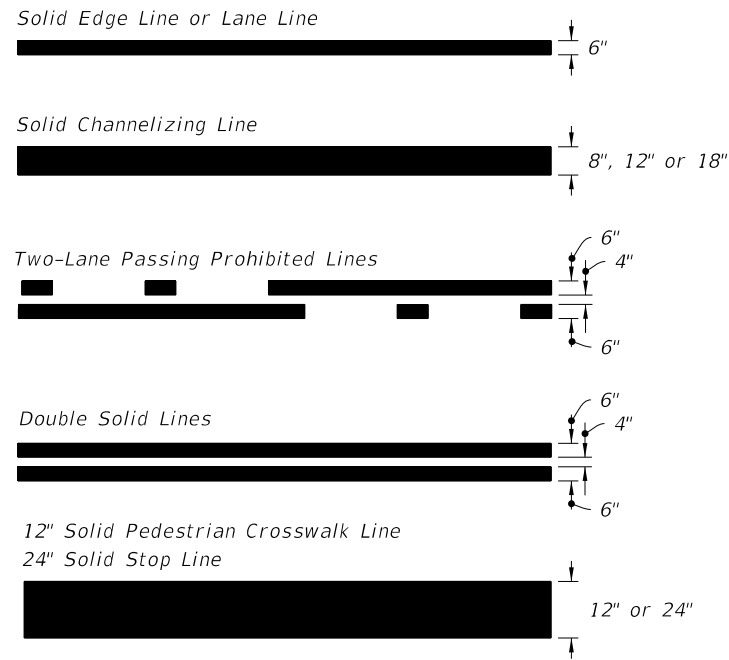


PAVEMENT MARKING LINES



10'-30' SKIP LINE WITH CONTRAST MARKINGS

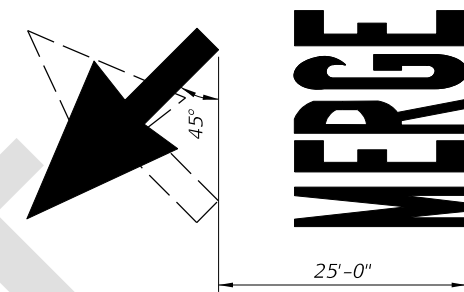


MARKINGS FOR MERGE

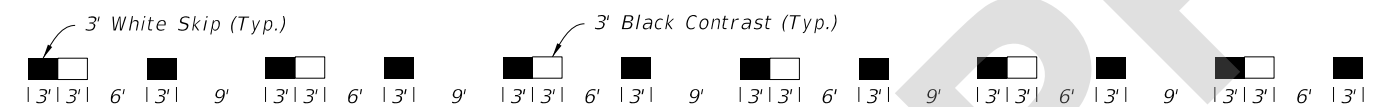


DOTTED LINE WITH ALTERNATING CONTRAST MARKINGS

(3'-9' Dotted Line Shown, Other Dotted Lines Similar)

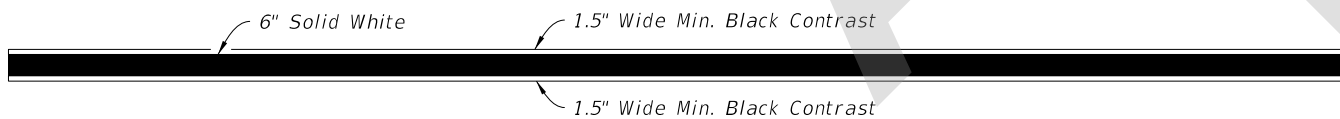

LONGITUDINAL SOLID LANE LINE WITH CONTRAST MARKINGS


(Not For Use On Edge Lines)

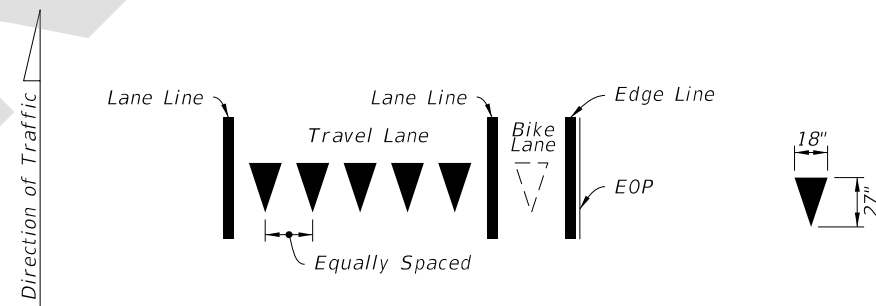

YIELD LINES

Yield Lines consist of five - 18" X 27" white triangles which face traffic. Equally space triangles within traffic lane. When a bike lane is present, add one additional triangle in the center of the bike lane.

9/11/2022 11:07:19 AM

| | | | | | | | |
|---------------------------|----------|--------------|---|------------------------------|-------------------|------------------|------------------|
| LAST REVISION 11/01/22 | REVISION | DESCRIPTION: |  | FY 2023-24 STANDARD PLANS | PAVEMENT MARKINGS | INDEX 711-001 | SHEET 2 of 13 |
|---------------------------|----------|--------------|---|------------------------------|-------------------|------------------|------------------|