

---

## Index 711-001 Pavement Markings

### ORIGINATION

**Date:** July 14, 2022

**Name:** Dave Amato

**Phone:** (850) 414-4792

**Email:** David.Amato@dot.state.fl.us

### COMMENTARY

This change is being proposed to be consistent with other FDOT documents and MUTCD. The term "shadow markings" is undefined and inconsistent with the other documents.

### COMMENTS AND RESPONSES

**BLACK** = Industry Review Comments   **BLUE** = Standard Plans Response   **GREEN** = Change Made to Index

**Name:** Gevin McDaniel



**Date:** 8/26/2022

**COMMENT:** To coincide with changes being proposed to FDM 230, please add a detail showing the longitudinal solid lane line with contrast markings.

**RESPONSE:** Agree Sheet 2 will be updated.

**CHANGE TO THE INDEX:** Add new detail "Longitudinal Solid Lane Line with Contrast Markings" on Sheet 2


*Response Date: 8/26/2022*

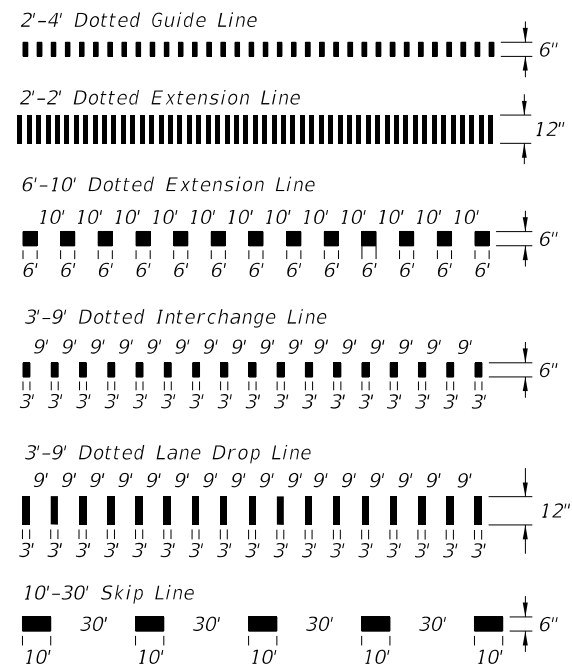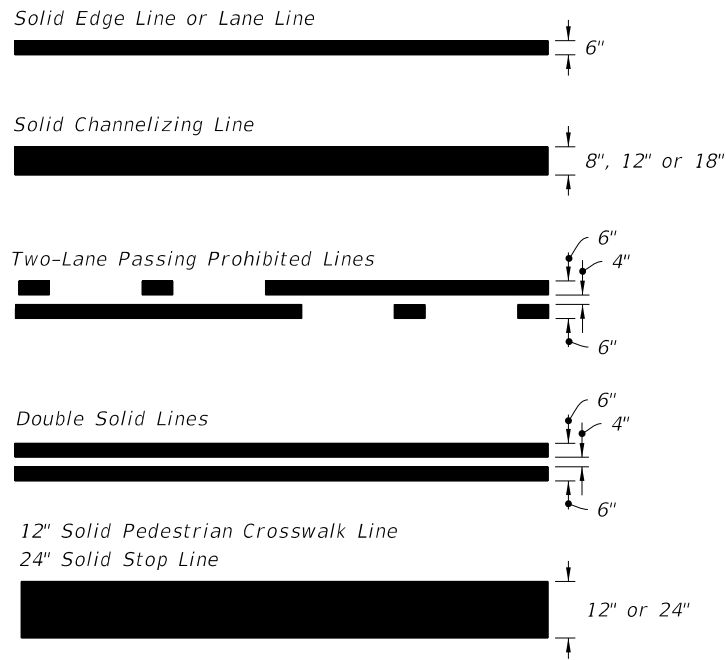


PAVEMENT MARKING LINES




10'-30' SKIP LINE WITH CONTRAST MARKINGS

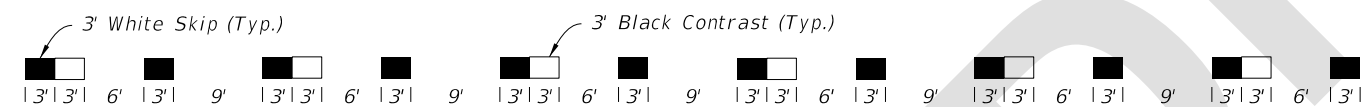


DOTTED LINE WITH ALTERNATING CONTRAST MARKINGS  
(3'-9' Dotted Line Shown, Other Dotted Lines Similar)

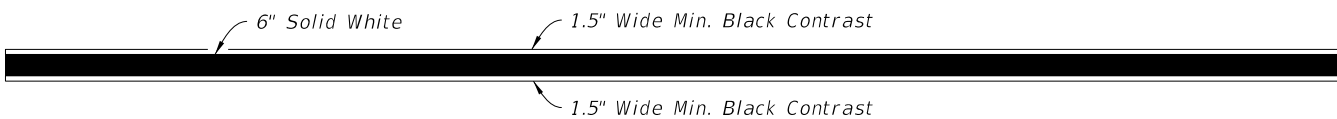

LONGITUDINAL SOLID LANE LINE WITH CONTRAST MARKINGS  
(Not For Use On Edge Lines)

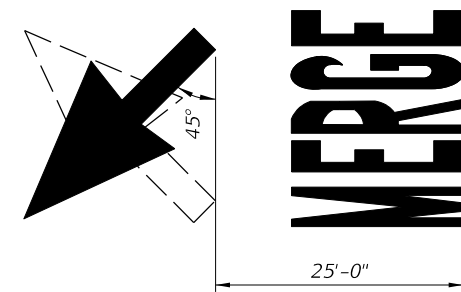


MARKINGS FOR MERGE

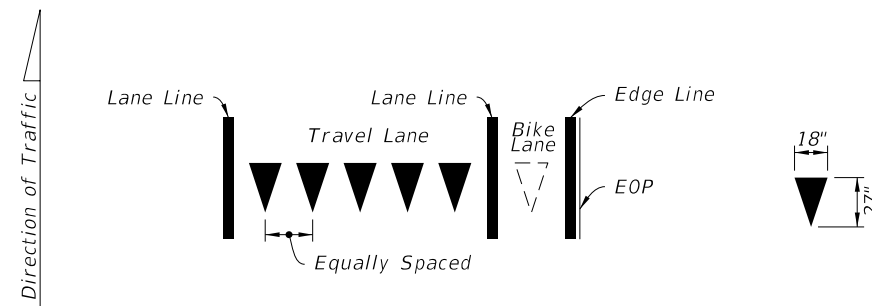

Yield Lines consist of five - 18" X 27" white triangles which face traffic. Equally space triangles within traffic lane. When a bike lane is present, add one additional triangle in the center of the bike lane.

YIELD LINES

9/11/2022 11:07:19 AM

LAST REVISION 11/01/22	REVISION	DESCRIPTION:	 FY 2023-24 STANDARD PLANS	PAVEMENT MARKINGS	INDEX 711-001	SHEET 2 of 13
---------------------------	----------	--------------	---	-------------------	------------------	------------------