
ORINATION FORM

Proposed Revisions to a Standard Plans Index

(Please provide all information — Incomplete forms will be returned)

Contact Information:

Date: July 14, 2022

Originator: David Amato

Phone: (850) 414-4792

Email: david.amato@dot.state.fl.us

Standard Plans:

Index Number: 711-001

Sheet Number (s): 2 of 13

Index Title: Pavement Markings

Summary of the changes:

Sheet 2 : Changed "SHADOW" with "CONTRAST" in the 10-30' Skip Line and Dotted Line Details.

Commentary / Background:

This change is being proposed to be consistent with other FDOT documents and MUTCD. The term "shadow markings" is undefined and inconsistent with the other documents.

Other Affected Offices / Documents: (Provide name of person contacted)

- | Yes | No | |
|--------------------------|-------------------------------------|-----------------------------|
| <input type="checkbox"/> | <input checked="" type="checkbox"/> | Other Standard Plans – |
| <input type="checkbox"/> | <input checked="" type="checkbox"/> | FDOT Design Manual – |
| <input type="checkbox"/> | <input checked="" type="checkbox"/> | Basis of Estimates Manual – |
| <input type="checkbox"/> | <input checked="" type="checkbox"/> | Standard Specifications – |
| <input type="checkbox"/> | <input checked="" type="checkbox"/> | Approved Product List – |
| <input type="checkbox"/> | <input checked="" type="checkbox"/> | Construction – |
| <input type="checkbox"/> | <input checked="" type="checkbox"/> | Maintenance – |

Origination Package Includes: (Submit package to Rick Jenkins)



- | Yes | N/A | |
|-------------------------------------|-------------------------------------|---|
| <input checked="" type="checkbox"/> | <input type="checkbox"/> | Redline Mark-ups |
| <input type="checkbox"/> | <input checked="" type="checkbox"/> | Revised or Proposed Standard Plan Instruction (SPI) |
| <input type="checkbox"/> | <input checked="" type="checkbox"/> | Other Support Documents |

Implementation:


- | | |
|-------------------------------------|----------------------------------|
| <input type="checkbox"/> | Design Bulletin (Interim) |
| <input type="checkbox"/> | DCE Memo |
| <input type="checkbox"/> | Program Mgmt. Bulletin |
| <input checked="" type="checkbox"/> | FY-Standard Plans (Next Release) |

Contact the Roadway Design Office for assistance in completing this form

Email to: Rick Jenkins rick.jenkins@dot.state.fl.us and Darren Martin darren.martin@dot.state.fl.us

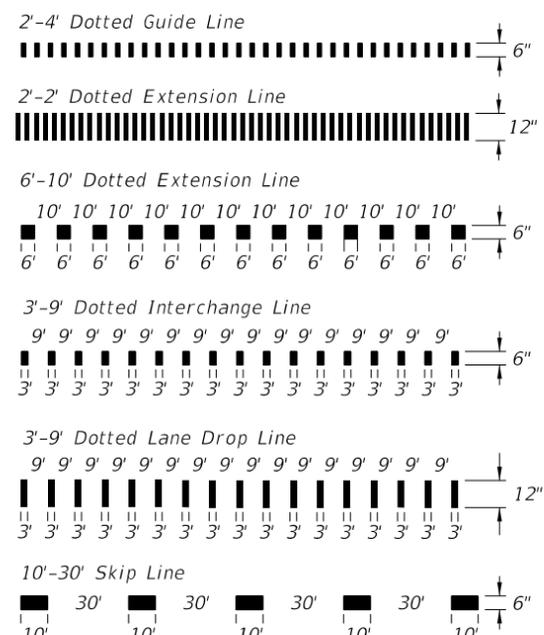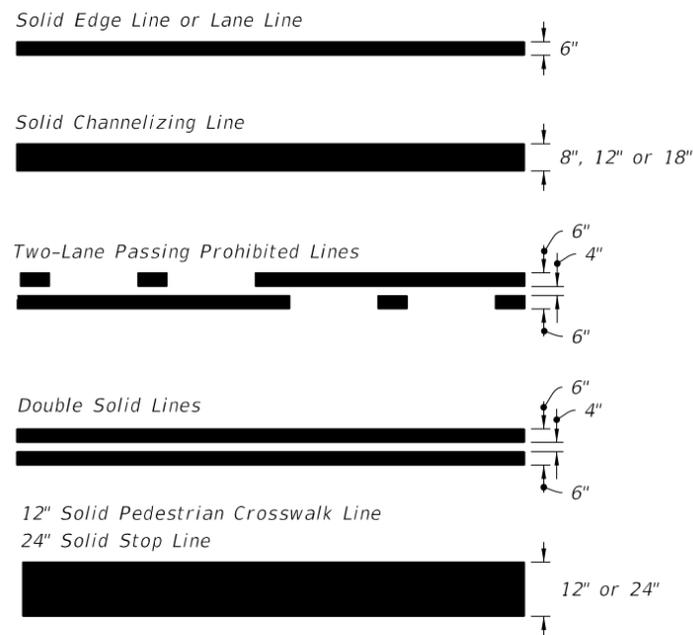

PAVEMENT MARKING LINES

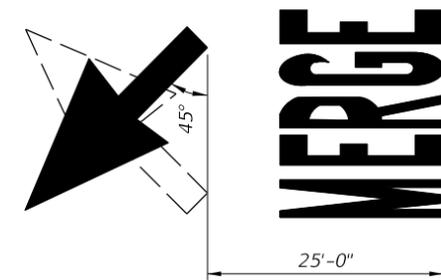


MARKINGS FOR MERGE



10'-30' SKIP LINE WITH SHADOW MARKINGS


CONTRAST

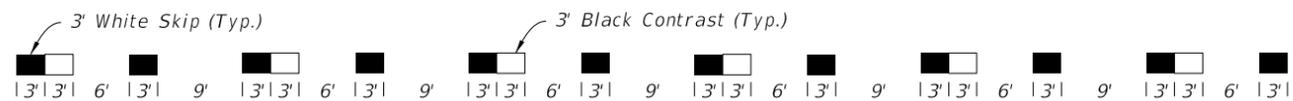

DOTTED LINE WITH ALTERNATING SHADOW MARKINGS

(3'-9' Dotted Line Shown, Other Dotted Lines Similar)

CONTRAST

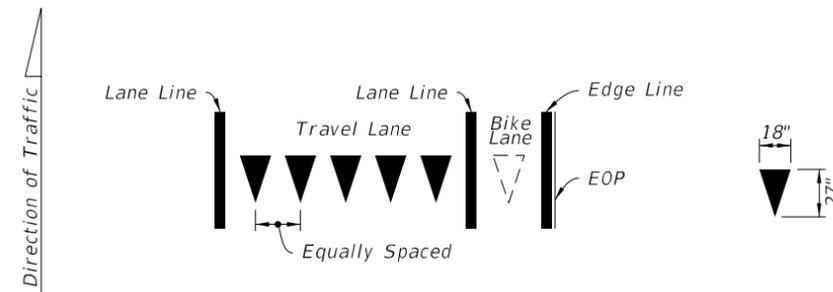

Yield Lines consist of five - 18" X 27" white triangles which face traffic. Equally space triangles within traffic lane. When a bike lane is present, add one additional triangle in the center of the bike lane.

YIELD LINES

9/22/2021 3:12:28 PM

LAST REVISION	DESCRIPTION:
11/01/21	
11/01/22	






FY 2022-23
STANDARD PLANS

PAVEMENT MARKINGS

INDEX
711-001

SHEET
2 of 13

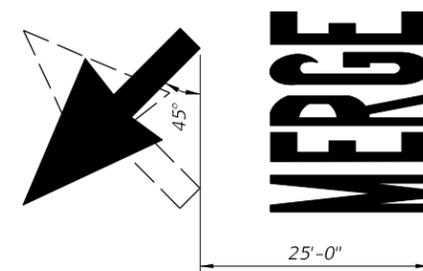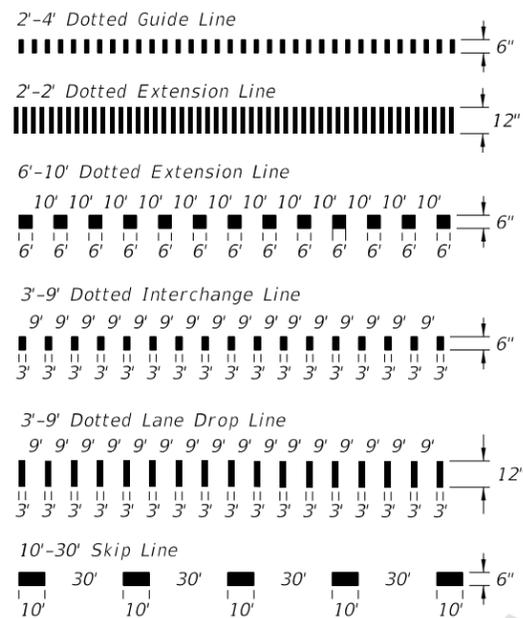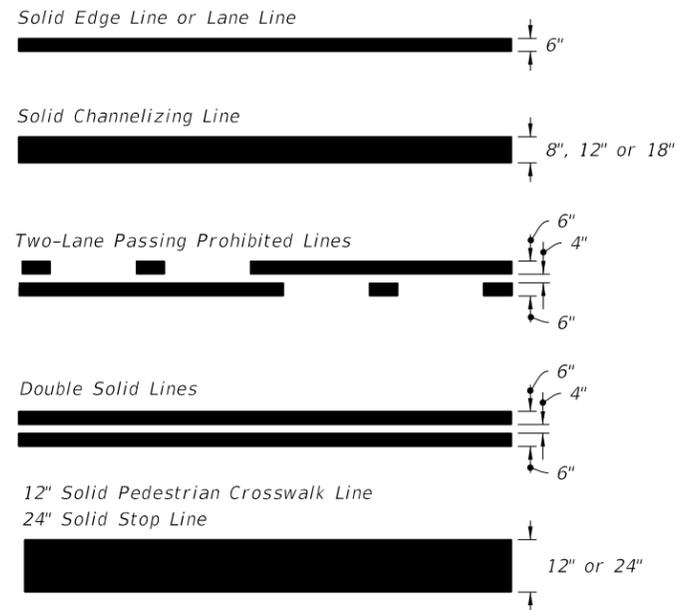

PAVEMENT MARKING LINES


MARKINGS FOR MERGE



10'-30' SKIP LINE WITH CONTRAST MARKINGS



DOTTED LINE WITH ALTERNATING CONTRAST MARKINGS
(3'-9' Dotted Line Shown, Other Dotted Lines Similar)

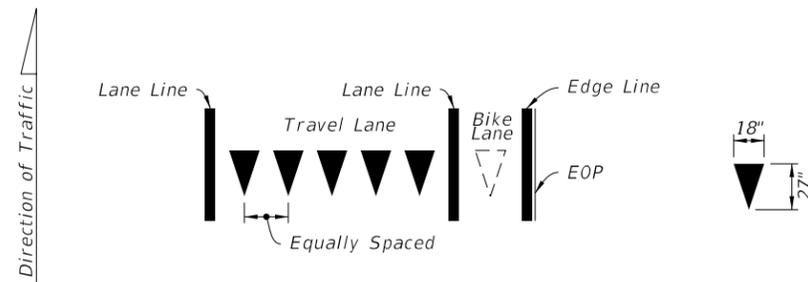

Yield Lines consist of five - 18" X 27" white triangles which face traffic. Equally space triangles within traffic lane. When a bike lane is present, add one additional triangle in the center of the bike lane.

YIELD LINES

7/14/2022 2:02:38 PM

LAST REVISION 11/01/22	REVISION	DESCRIPTION:		FY 2023-24 STANDARD PLANS	PAVEMENT MARKINGS	INDEX 711-001	SHEET 2 of 13
---------------------------	----------	--------------	--	------------------------------	-------------------	------------------	------------------