

---

## ORIGINATION FORM

---

Proposed Revisions to a Standard Plans Index  
(Please provide all information — Incomplete forms will be returned)

**Contact Information:**

Date: June 29, 2023  
Originator: Dana Knox  
Phone: (850) 410-5413  
Email: Dana.Knox@dot.state.fl.us

**Standard Plans:**

Index Number: 700-102  
Sheet Number (s): 12  
Index Title: Special Sign Details

**Summary of the changes:**

For signs G20-1 and G20-2 changed the dimension from height x width to width x height (4'x2')

**Commentary / Background:**

The change is to be consistent with how the MUTCD dimensions signs. Section 700 and 995 will also need to be updated to be consistent with MUTCD.

**Other Affected Offices / Documents: (Provide name of person contacted)**

Yes	No	
<input type="checkbox"/>	<input checked="" type="checkbox"/>	Other Standard Plans –
<input type="checkbox"/>	<input checked="" type="checkbox"/>	FDOT Design Manual –
<input type="checkbox"/>	<input checked="" type="checkbox"/>	Basis of Estimates Manual –
<input checked="" type="checkbox"/>	<input type="checkbox"/>	Standard Specifications – Daniel Strickland
<input type="checkbox"/>	<input checked="" type="checkbox"/>	Approved Product List –
<input type="checkbox"/>	<input checked="" type="checkbox"/>	Construction –
<input type="checkbox"/>	<input checked="" type="checkbox"/>	Maintenance –

**Origination Package Includes:** (Submit package to Rick Jenkins)

Yes	N/A	
<input checked="" type="checkbox"/>	<input type="checkbox"/>	Redline Mark-ups
<input type="checkbox"/>	<input type="checkbox"/>	Revised or Proposed Standard Plan Instruction (SPI)
<input type="checkbox"/>	<input type="checkbox"/>	Other Support Documents

**Implementation:**


<input type="checkbox"/>	Design Bulletin (Interim)
<input type="checkbox"/>	DCE Memo
<input type="checkbox"/>	Program Mgmt. Bulletin
<input checked="" type="checkbox"/>	FY-Standard Plans (Next Release)

---


Contact the Roadway Design Office for assistance in completing this form

---


Email to: Rick Jenkins [rick.jenkins@dot.state.fl.us](mailto:rick.jenkins@dot.state.fl.us) and Darren Martin [darren.martin@dot.state.fl.us](mailto:darren.martin@dot.state.fl.us)

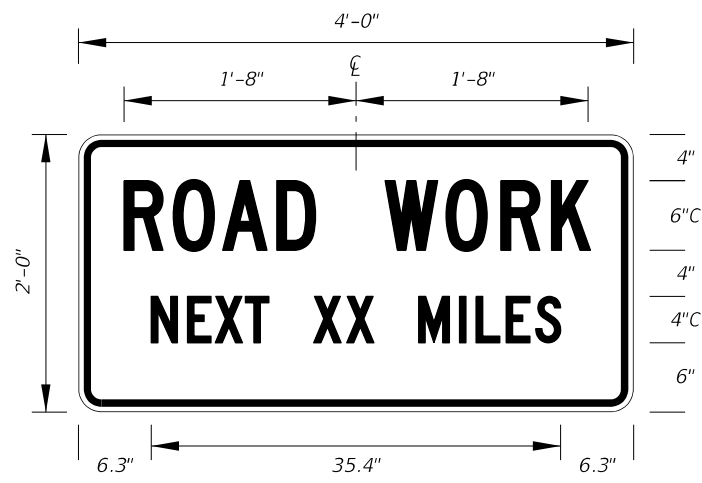


**G20-1**  
4' X 2'  
1.5" Radii 3/4" Border  
*Update Dimension*  
Orange Background  
Black Legend and Border

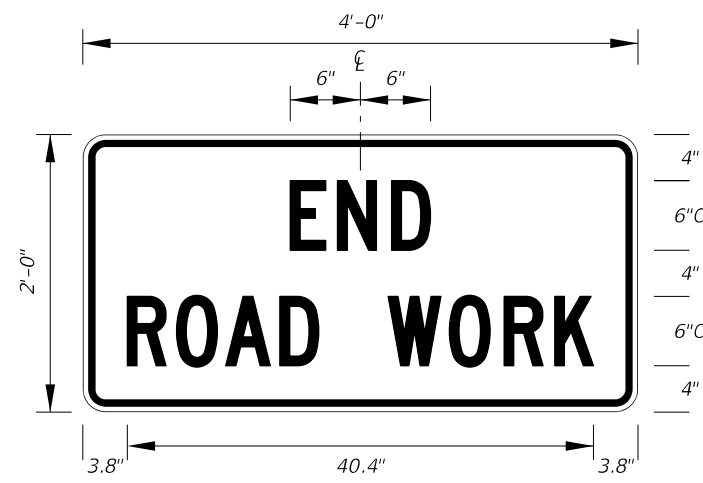


**G20-2**  
4' X 2'  
1.5" Radii 3/4" Border  
Orange Background  
Black Legend and Border

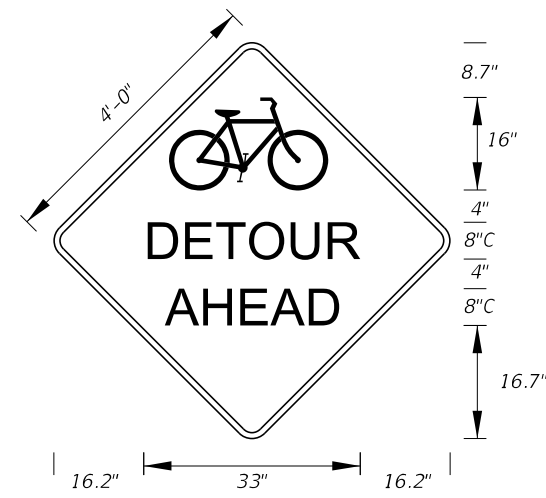


**MOT-20-21**  
4' X 4'  
3" Radii 3/4" Border  
8" Series C Legend  
Orange Background  
Black Legend and Border

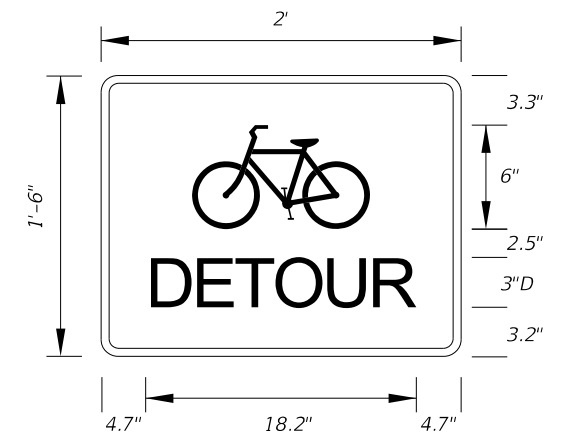

**MOT-21-21**  
2' X 1'-6"  
1.5" Radii 1/2" Border  
3" Series D Legend  
Orange Background  
Black Legend and Border

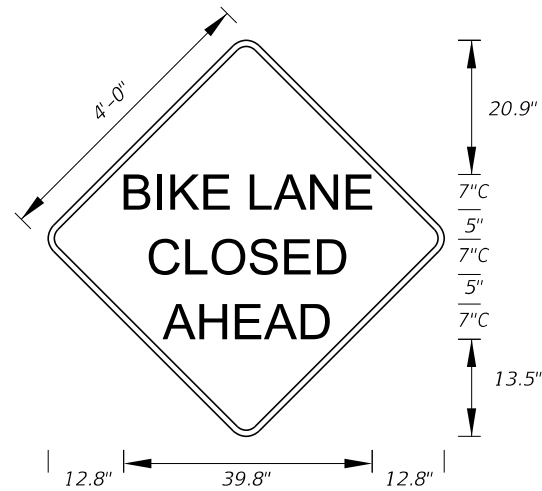

**MOT-22-21**  
4' X 4'  
3" Radii 3/4" Border  
7" Series C Legend  
Orange Background  
Black Legend and Border

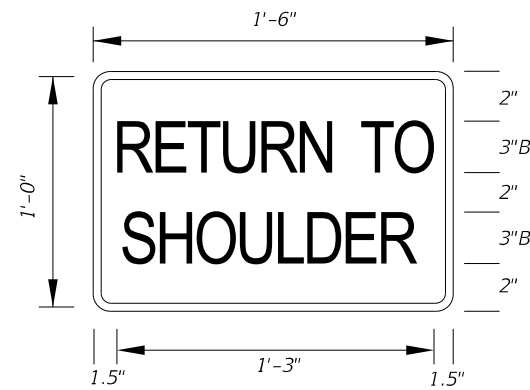


**MOT-23-21**  
1'-6" X 1'-0"  
1.5" Radii 1/4" Border  
3" Series B Legend  
Orange Background  
Black Legend and Border




**MOT-24-21**  
2'-6" X 1'-6"  
1.5" Radii 1/2" Border  
4" Series C Legend  
White Background  
Black Legend and Border



**MOT-25-21**  
2'-0" X 1'-6"  
1.5" Radii 1/2" Border  
4" Series B Legend  
White Background  
Black Legend and Border

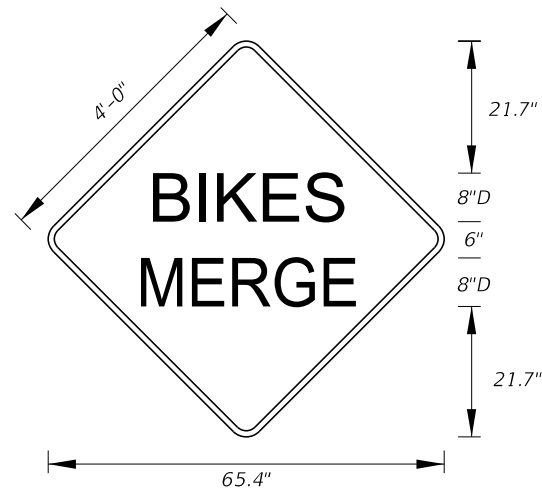

**MOT-26A-22**  
4' X 4'  
3" Radii 3/4" Border  
8" Series D Legend  
Orange Background  
Black Legend and Border

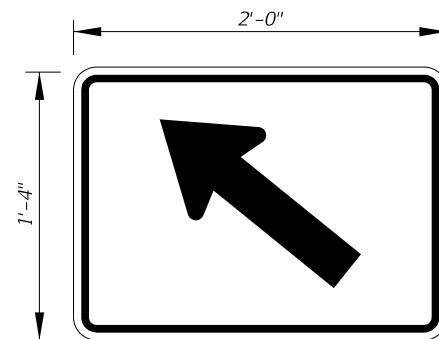

**MOT-26B-22**  
2'-0" X 1'-4"  
1.5" Radii 5/8" Border  
Orange Background  
Black Legend and Border

10/6/2022 2:39:00 PM

LAST REVISION	DESCRIPTION:
<del>11/01/21</del>	<del>11/01/21</del>
11/01/23	




FY 2023-24  
STANDARD PLANS


SPECIAL SIGN DETAILS

INDEX  
700-102


SHEET  
12 of 12

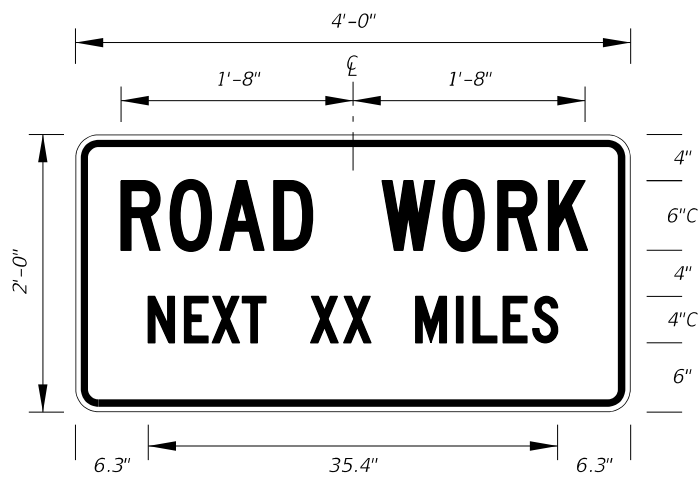


**G20-1**  
4' X 2'  
1.5" Radii 3/4" Border  
Orange Background  
Black Legend and Border

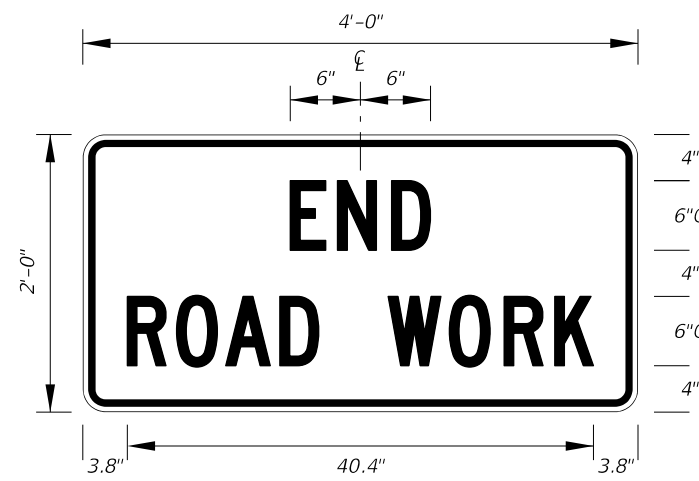


**G20-2**  
4' X 2'  
1.5" Radii 3/4" Border  
Orange Background  
Black Legend and Border

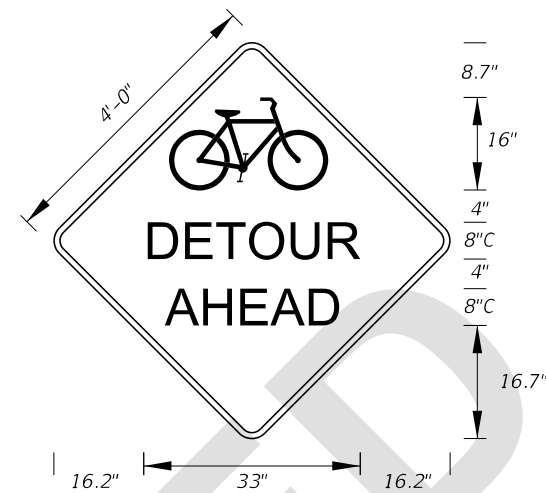


**MOT-20-21**  
4' X 4'  
3" Radii 3/4" Border  
8" Series C Legend  
Orange Background  
Black Legend and Border

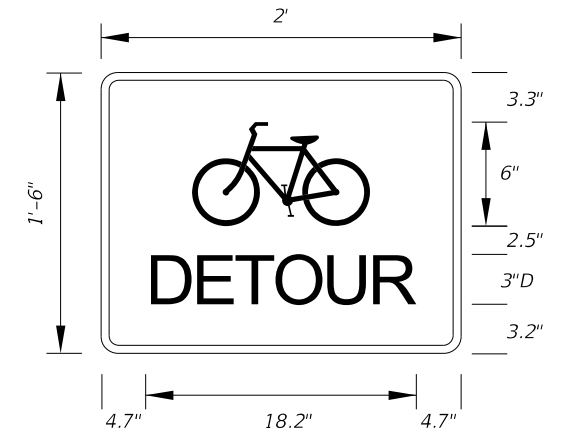

**MOT-21-21**  
2' X 1'-6"  
1.5" Radii 1/2" Border  
3" Series D Legend  
Orange Background  
Black Legend and Border

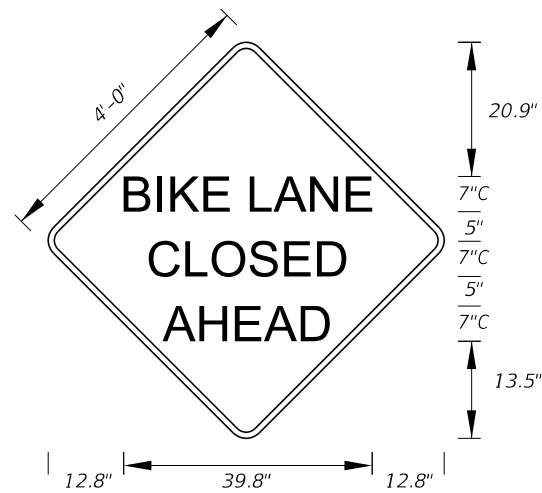


**MOT-22-21**  
4' X 4'  
3" Radii 3/4" Border  
7" Series C Legend  
Orange Background  
Black Legend and Border

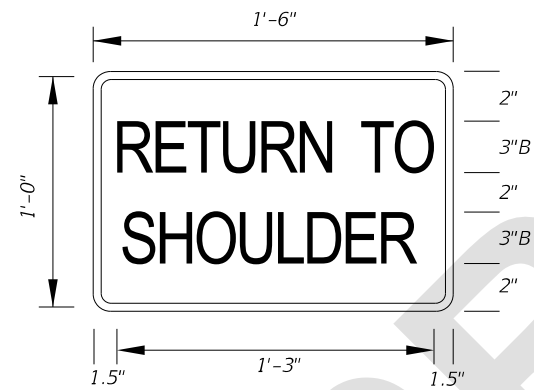


**MOT-23-21**  
1'-6" X 1'-0"  
1.5" Radii 1/4" Border  
3" Series B Legend  
Orange Background  
Black Legend and Border




**MOT-24-21**  
2'-6" X 1'-6"  
1.5" Radii 1/2" Border  
4" Series C Legend  
White Background  
Black Legend and Border

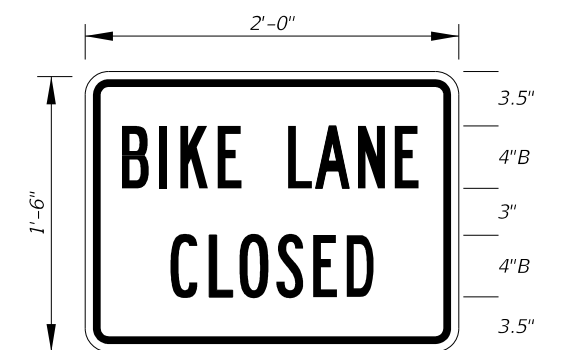

**MOT-25-21**  
2'-0" X 1'-6"  
1.5" Radii 1/2" Border  
4" Series B Legend  
White Background  
Black Legend and Border

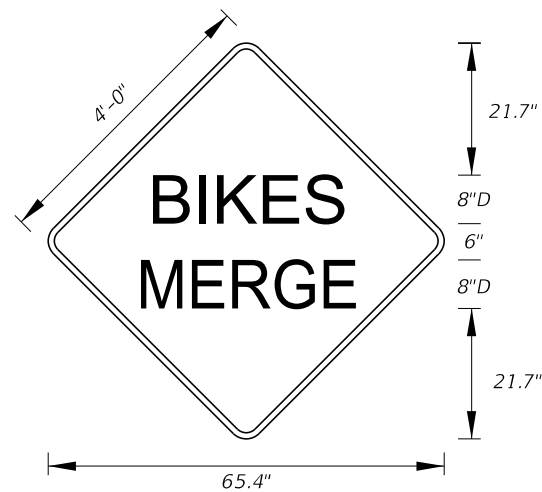

**MOT-26A-22**  
4' X 4'  
3" Radii 3/4" Border  
8" Series D Legend  
Orange Background  
Black Legend and Border

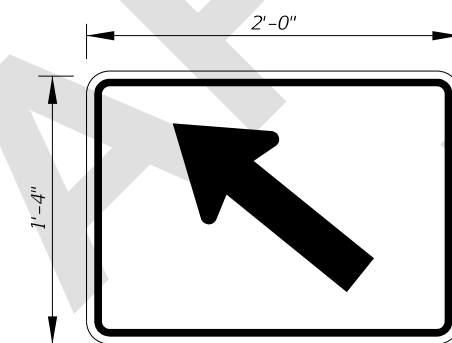

**MOT-26B-22**  
2'-0" X 1'-4"  
1.5" Radii 5/8" Border  
Orange Background  
Black Legend and Border

7/25/2023 8:42:56 AM

LAST REVISION	DESCRIPTION:
11/01/23	