
ORIGINATION FORM

Proposed Revisions to a Standard Plans Index
(Please provide all information — Incomplete forms will be returned)

Contact Information:

Date: June 29, 2023
Originator: Dana Knox
Phone: (850) 410-5413
Email: Dana.Knox@dot.state.fl.us

Standard Plans:

Index Number: 700-110
Sheet Number (s): 1
Index Title: Mounting Exit Number Panels To Signs

Summary of the changes:

Changed all reference of length to width to keep consistent with MUTCD

Commentary / Background:

The change is to be consistent with how the MUTCD dimensions signs. Section 700 and 995 will also need to be updated to be consistent with MUTCD.

Other Affected Offices / Documents: (Provide name of person contacted)

Yes	No	
☐	☒	Other Standard Plans –
☐	☒	FDOT Design Manual –
☐	☒	Basis of Estimates Manual –
☒	☐	Standard Specifications – Daniel Strickland
☐	☒	Approved Product List –
☐	☒	Construction –
☐	☒	Maintenance –

Origination Package Includes: (Submit package to Rick Jenkins)

Yes	N/A	
☒	☐	Redline Mark-ups
☐	☐	Revised or Proposed Standard Plan Instruction (SPI)
☐	☐	Other Support Documents

Implementation:


☐ Design Bulletin (Interim)
☐ DCE Memo
☐ Program Mgmt. Bulletin
☒ FY-Standard Plans (Next Release)

Contact the Roadway Design Office for assistance in completing this form


Email to: Rick Jenkins rick.jenkins@dot.state.fl.us and Darren Martin darren.martin@dot.state.fl.us

GENERAL NOTES:

1. Meet the requirements of *Specification 700*.
2. Work with *Indexes 700-020 and 700-030*.
3. *Fabrication:*
See sign layout sheet for dimension **"L"** and sign face details in the *Plans*.
4. For right exits, install the *Exit Numbering Panel* to the top right side of the *Highway Sign*.
5. For left exits, install the *Exit Numbering Panel* to the top left side of the *Highway Sign*.

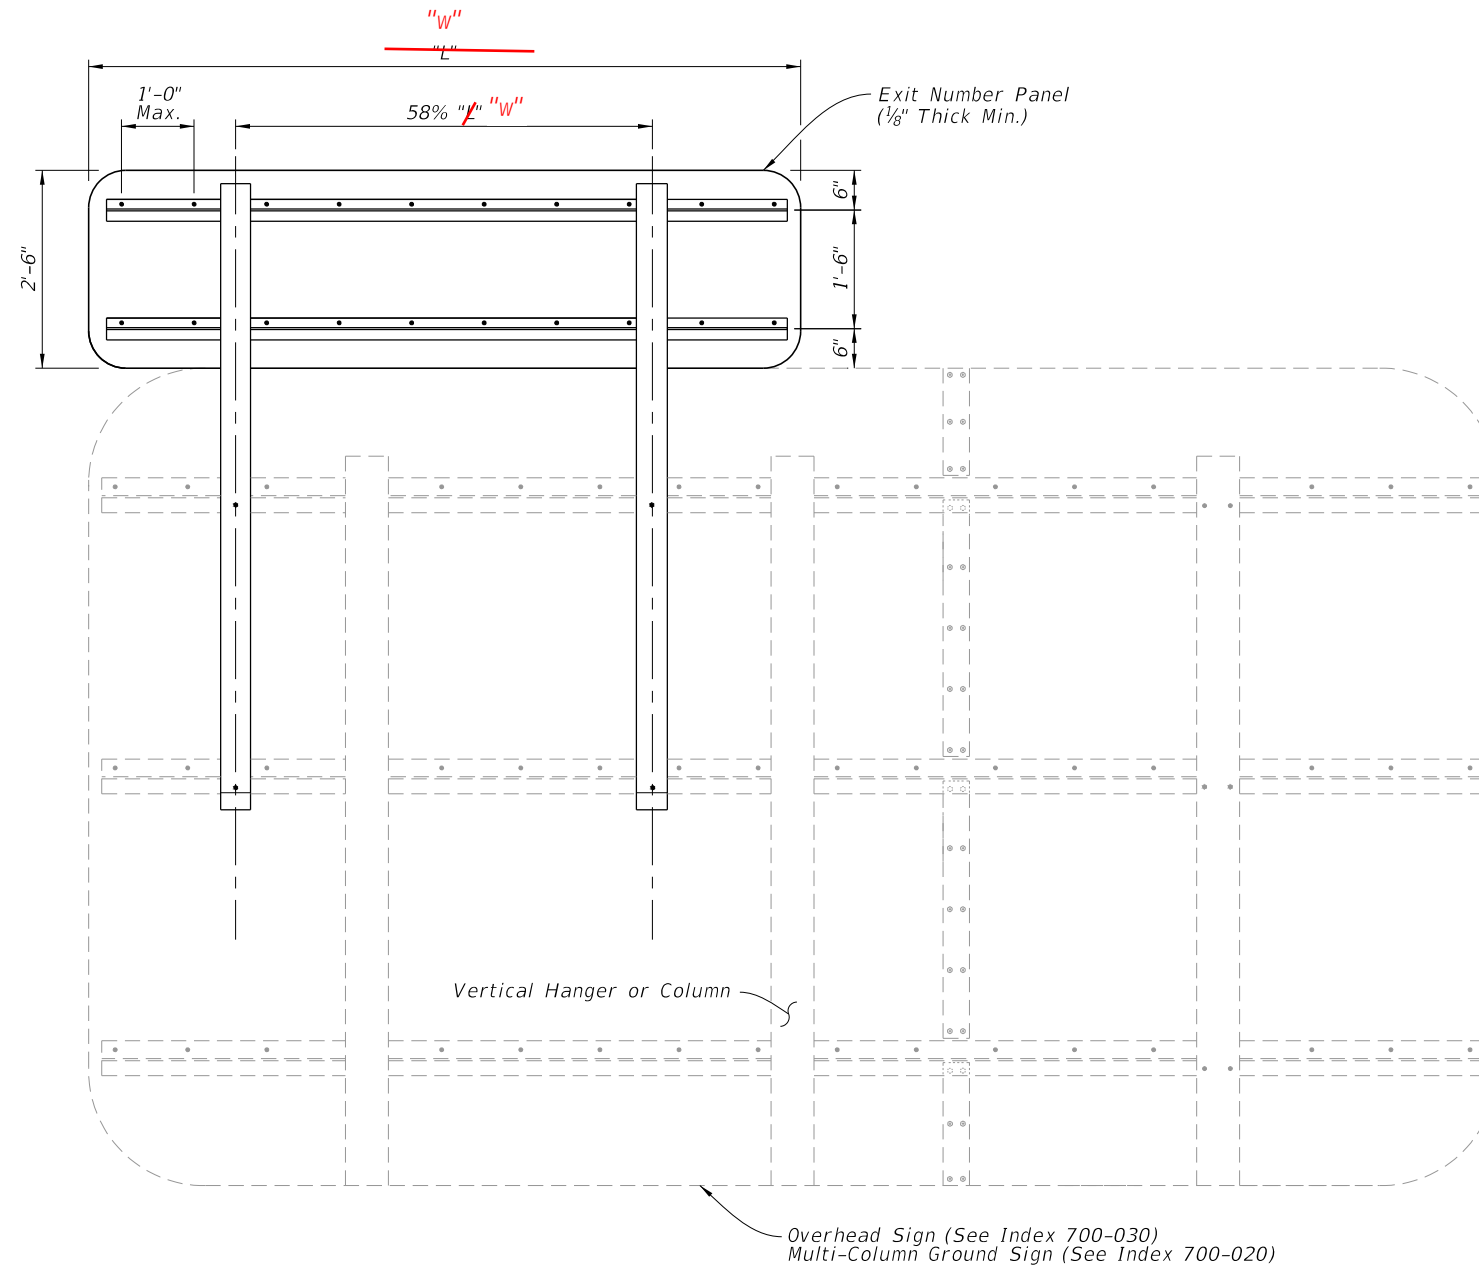

BACK ELEVATION

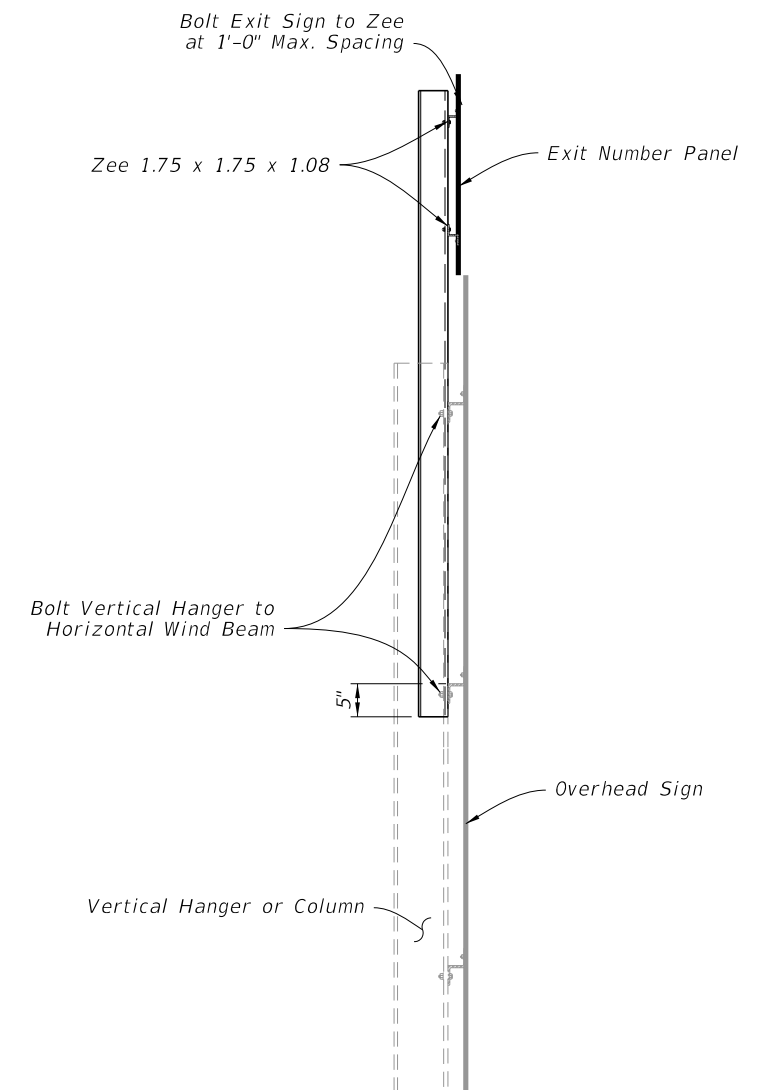


SIDE ELEVATION


LAST REVISION 11/01/22	REVISION	DESCRIPTION:	 FY 2023-24 STANDARD PLANS	MOUNTING EXIT NUMBER PANELS TO SIGNS	INDEX 700-110	SHEET 1 of 1
------------------------------	----------	--------------	---	--------------------------------------	------------------	-----------------

GENERAL NOTES:

- 1. Meet the requirements of Specification 700.
- 2. Work with Indexes 700-020 and 700-030.
- 3. Fabrication:
See sign layout sheet for dimension "W" and sign face details in the Plans.
- 4. For right exits, install the Exit Numbering Panel to the top right side of the Highway Sign.
- 5. For left exits, install the Exit Numbering Panel to the top left side of the Highway Sign.

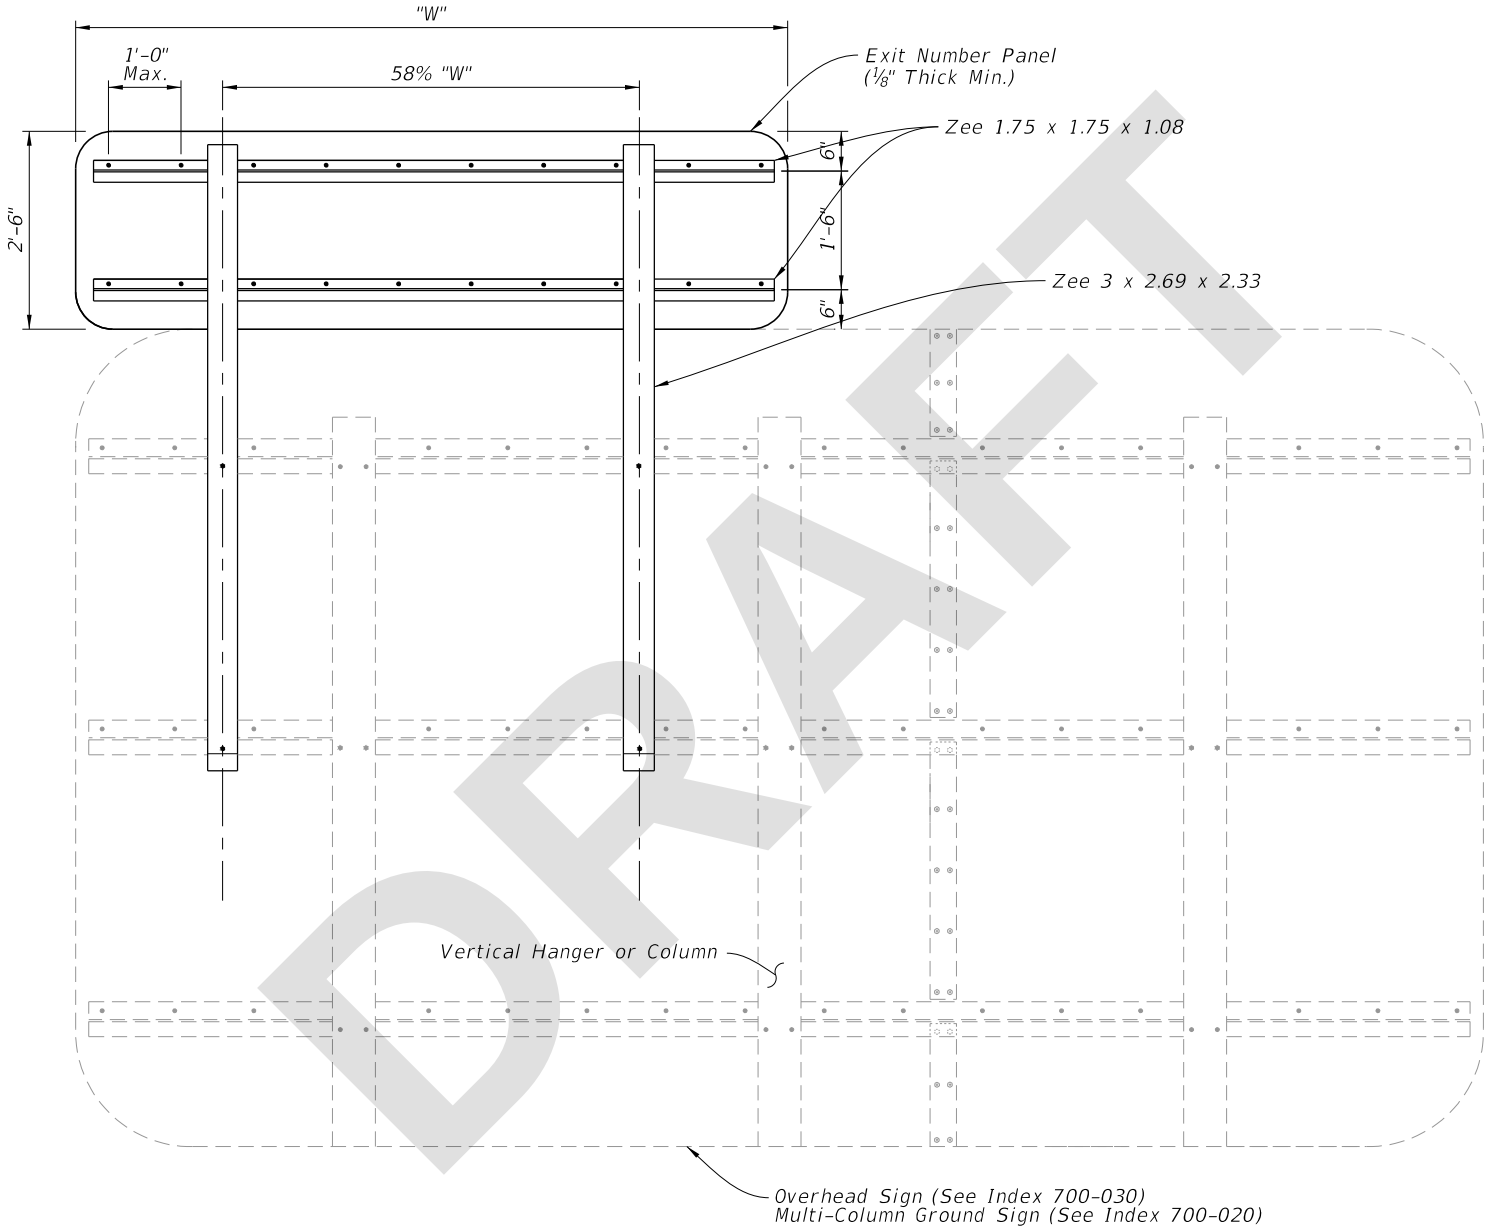

BACK ELEVATION

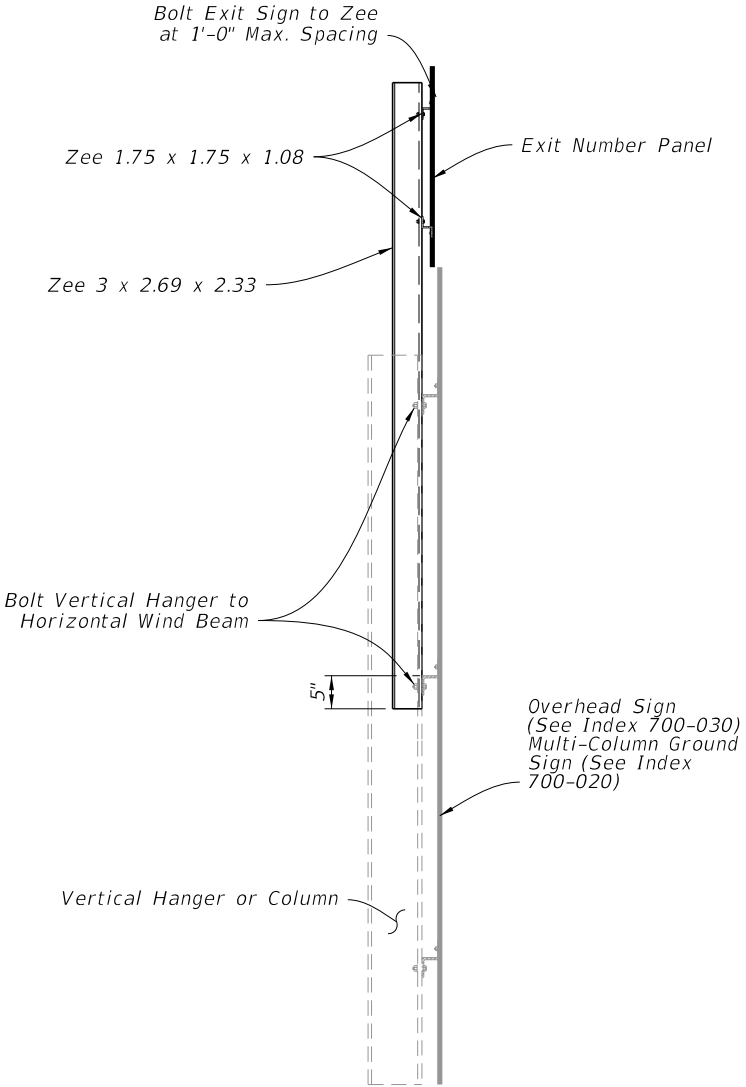

SIDE ELEVATION

7/25/2023 9:08:42 AM

LAST REVISION	DESCRIPTION:	FDOT	FY 2024-25 STANDARD PLANS	MOUNTING EXIT NUMBER PANELS TO SIGNS	INDEX	SHEET
11/01/23					700-110	1 of 1