
ORIGINATION FORM

Proposed Revisions to a Standard Plans Index

(Please provide all information — Incomplete forms will be returned)

Contact Information:

Date: March 23, 2023

Originator: Joshua Turley

Phone: (850) 414-4475

Email: joshua.turley@dot.state.fl.us

Standard Plans:

Index Number: 700-110

Sheet Number (s): 1 of 1

Index Title: MOUNTING EXIT NUMBER PANELS TO SIGNS

Summary of the changes:

Sheet 1: Added missing callout; Added additional callouts for clarity.

Commentary / Background:

This Standard was modified around 2018 and a callout was not copied over as required. We added the missing callout and made some minor callout changes for clarity.

Other Affected Offices / Documents: (Provide name of person contacted)

Yes	No
☐	☒ Other Standard Plans –
☐	☒ FDOT Design Manual –
☐	☒ Basis of Estimates Manual –
☐	☒ Standard Specifications –
☐	☒ Approved Product List –
☐	☒ Construction –
☐	☒ Maintenance –

Origination Package Includes: (Submit package to Rick Jenkins)

Yes	N/A
☒	☐ Redline Mark-ups
☐	☐ Revised or Proposed Standard Plan Instruction (SPI)
☐	☐ Other Support Documents

Implementation:


☐ Design Bulletin (Interim)
☐ DCE Memo
☐ Program Mgmt. Bulletin
☒ FY-Standard Plans (Next Release)

Contact the Roadway Design Office for assistance in completing this form

Email to: Rick Jenkins rick.jenkins@dot.state.fl.us and Darren Martin darren.martin@dot.state.fl.us

GENERAL NOTES:

- 1. Meet the requirements of Specification 700.
- 2. Work with Indexes 700-020 and 700-030.
- 3. Fabrication:
See sign layout sheet for dimension "L" and sign face details in the Plans.
- 4. For right exits, install the Exit Numbering Panel to the top right side of the Highway Sign.
- 5. For left exits, install the Exit Numbering Panel to the top left side of the Highway Sign.

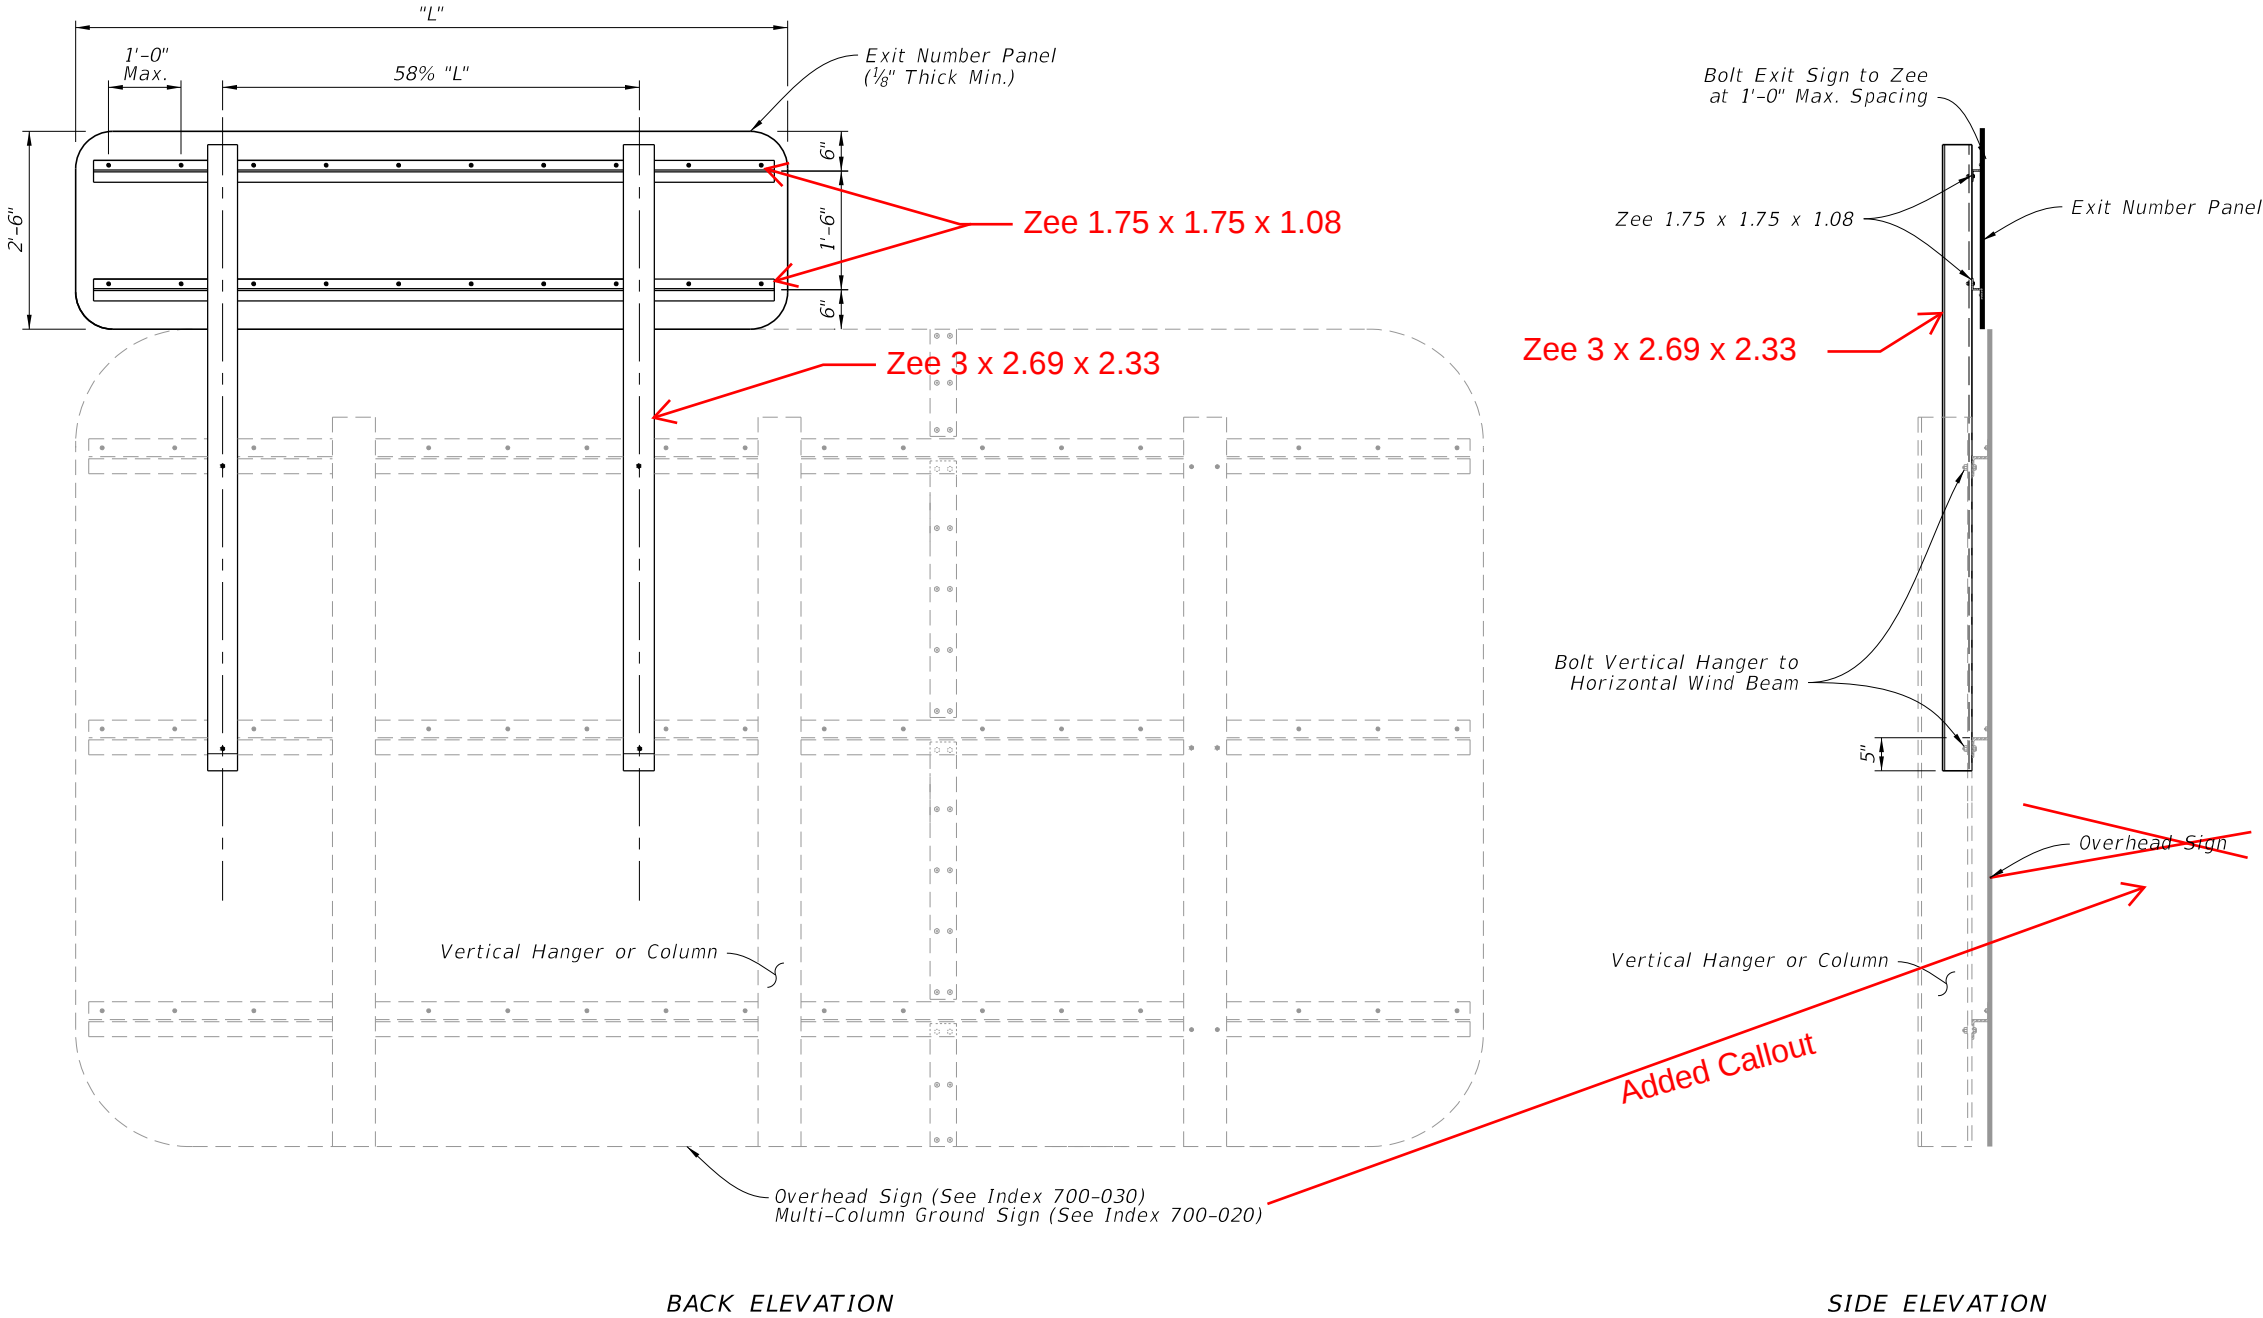

10/6/2022 2:40:18 PM

LAST REVISION	DESCRIPTION:
11/01/22	
11/01/23	



FY 2023-24
STANDARD PLANS

MOUNTING EXIT NUMBER PANELS TO SIGNS

INDEX
700-110

SHEET
1 of 1

5. For left exits, install the Exit Numbering Panel to the top left side of the Highway Sign.

