
ORIGINATION FORM

Proposed Revisions to a Standard Plans Index

(Please provide all information — Incomplete forms will be returned)

Contact Information:

Date: May 19, 2023

Originator: Richard Stepp

Phone: (850) 414-4313

Email: richard.stepp@dot.state.fl.us

Standard Plans:

Index Number: 715-002

Sheet Number (s): 4, 5, 6

Index Title: STANDARD ALUMINUM LIGHTING

Summary of the changes:

Sheet 4: Added Shaft Foundation Note 3 to allow for concrete foundation with an octagon shape as a substitute for the circular shaped shaft foundation shown.

Sheet 5: Added new structural grout pad details to the plan and section view. Added new Note 9 to explain structural grout pad construction and reference specification.

Sheet 6: Changed weld detail to say "CJP."

Commentary / Background:

Sheet 4: A non-circular, octagon shaft option was requested by industry to simplify formwork.

Sheet 5: At the request of the Districts, a grout pad is added to assist with constructibility and leveling of the light pole.

Sheet 6: Changing non-standard language to standard language consistent with AWS. Spec 460 will accompany the revision. This revision is being managed by Josh Turley in the SDO.

Other Affected Offices / Documents: (Provide name of person contacted)

Yes	No	
☐	☒	Other Standard Plans –
☐	☒	FDOT Design Manual –
☐	☒	Basis of Estimates Manual –
☒	☐	Standard Specifications – Daniel Strickland
☐	☒	Approved Product List –
☐	☒	Construction –
☐	☒	Maintenance –

Origination Package Includes: (Submit package to Rick Jenkins)


Yes	N/A	
☒	☐	Redline Mark-ups
☐	☐	Revised or Proposed Standard Plan Instruction (SPI)
☐	☐	Other Support Documents

Implementation:


☐	Design Bulletin (Interim)
☐	DCE Memo
☐	Program Mgmt. Bulletin
☒	FY-Standard Plans (Next Release)

Contact the Roadway Design Office for assistance in completing this form


Email to: Rick Jenkins rick.jenkins@dot.state.fl.us and Darren Martin darren.martin@dot.state.fl.us

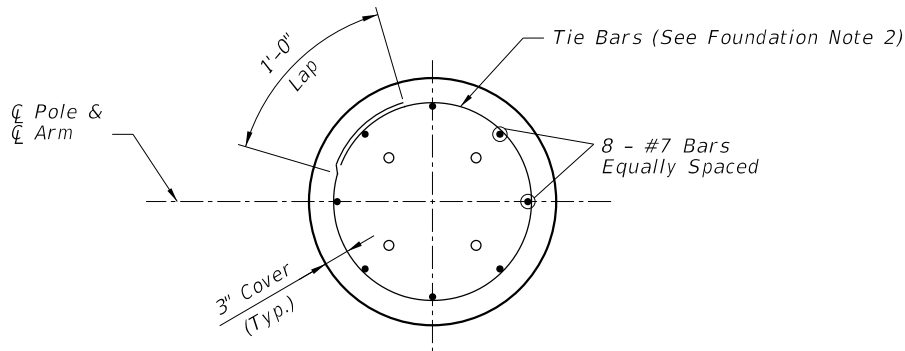


SECTION C-C

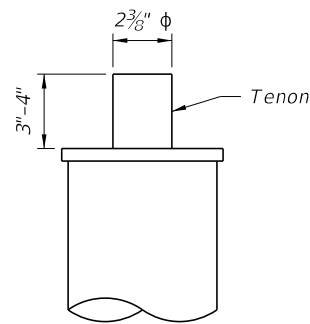


TOP MOUNT TENON

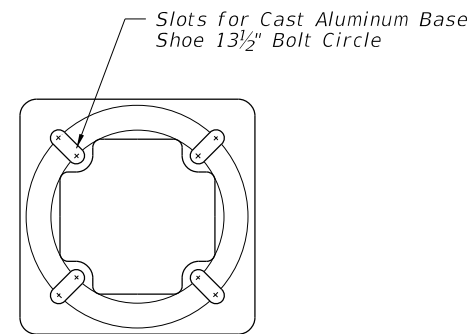


TOP VIEW TRANSFORMER BASE

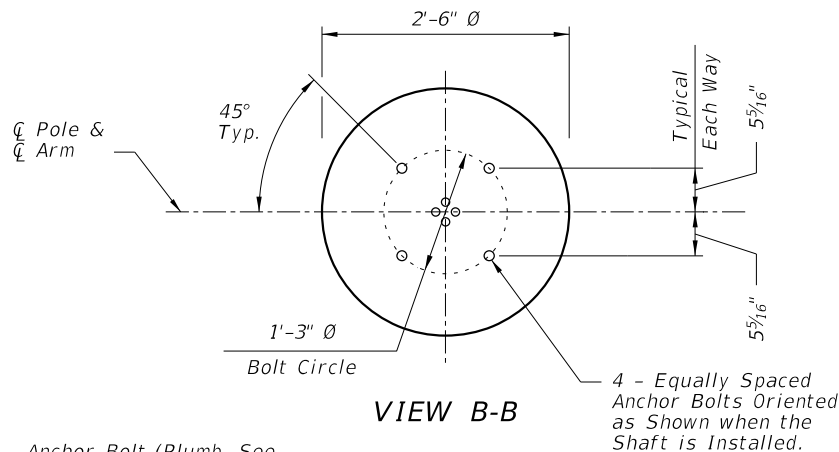


VIEW B-B

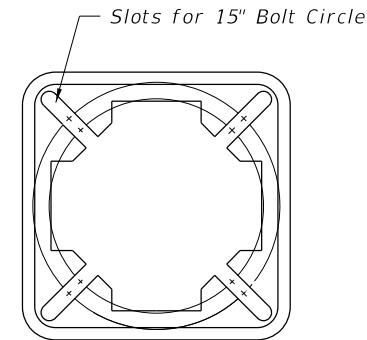

BOTTOM VIEW TRANSFORMER BASE

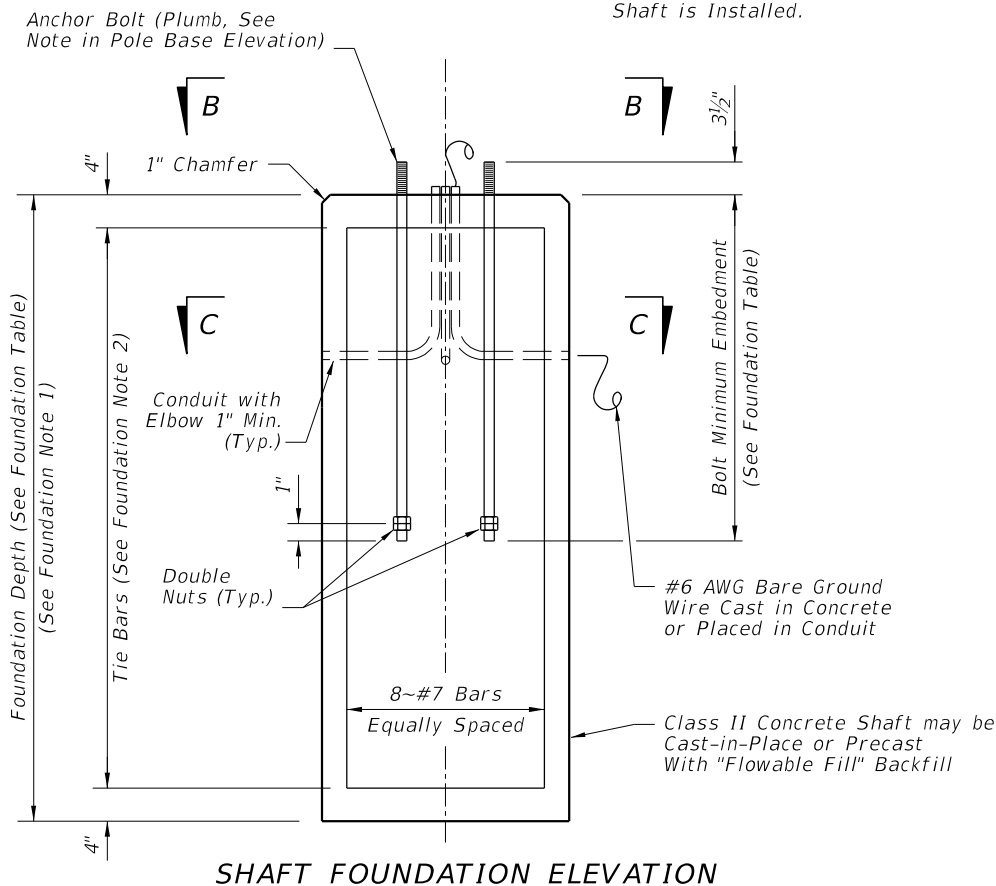

SHAFT FOUNDATION ELEVATION

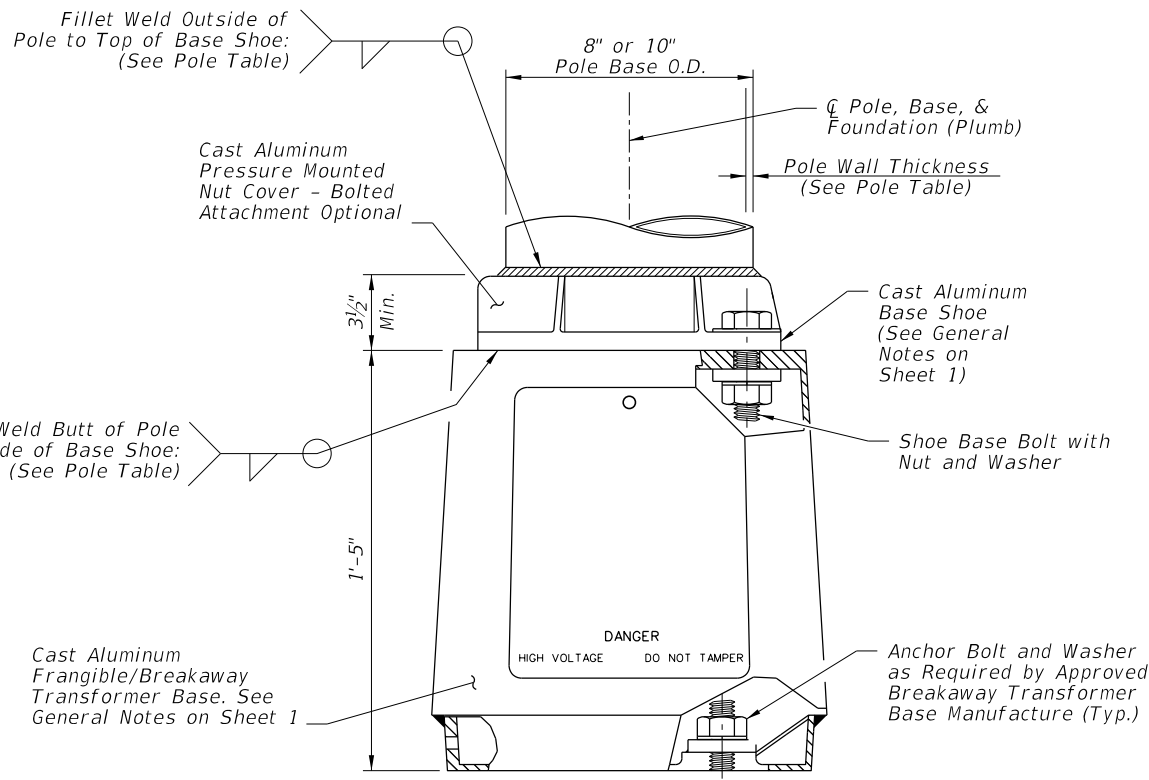

POLE BASE ELEVATION

ARM-POLE TABLE					
FOR STANDARD ALUMINUM LIGHT POLES WITH ARM					
Mounting Height (Ft.)	Wind Speed and Arm Lengths (Ft.)				
	120 mph	140 mph	160 mph		
30	8, 10, 12, 15	8, 10, 12	15	8, 10	12, 15
35	A1-P1	A1-P1	A2-P1	A1-P1	A2-P1
40				A1-P2	A2-P2
45	A1-P2	A1-P2	A2-P2	A1-P3	A2-P3
50					

ARM POLE NOTES:

1. See ARM SECTION detail on Sheet 3 for all A1 and A2 Values.
2. See Pole Table for all P1, P2, and P3 values.
3. For Median Barrier Mounted Pole, Use Arm A1.
4. For 20' and 25' assembly heights use only 8' or 10' arm A1 with P0.

POLE TABLE			
Pole	Pole Wall Thickness	Top of Base Shoe Weld	Inside of Base Shoe Weld
P0	0.156	3/16"	5/32"
P1	0.156	3/16"	5/32"
P2	0.250	1/4"	1/4"
P3	0.313	5/16"	5/16"

POLE NOTES:

1. Pole wall thicknesses shown are nominal and must be within the Aluminum Association tolerances.
2. Thicker walls are permitted and tapered walls may be used in accordance with the minimum Aluminum Association thicknesses.

TOP MOUNT POLE TABLE			
FOR STANDARD ALUMINUM LIGHT POLES WITH TOP MOUNT			
Mounting Height (Ft.)	Wind Speed and Arm Lengths (Ft.)		
	120 mph	140 mph	160 mph
20	Pole P0	Pole P0	Pole P0
25	Pole P1	Pole P1	Pole P1
30			Pole P1
35	Pole P2	Pole P2	Pole P2
40			Pole P2
45	Pole P2	Pole P2	Pole P2
50			Pole P2

SHAFT FOUNDATION TABLE				
Pole	P0	P1	P2	P3
Depth	6'-0"	7'-0"	8'-0"	8'-0"
Bolt Min. Embedment	2'-6"	3'-6"	3'-6"	3'-6"


SHAFT FOUNDATION OPTION WITH LIGHT POLE & BASE DETAILS

SHAFT FOUNDATION NOTES:


1. Depths shown are for slopes equal to or flatter than 1:4. For slopes steeper than 1:4 and equal to or flatter than 1:2 add 2'-6" to foundation depths shown.
2. Foundation Tie Bars: #4 Tie Bars @ 12" centers (max.) or D10 (or W10) spiral @ 6" pitch, 3 flat turns top and 1 flat turn bottom.

Added Note 3 for new precast option with octagon shape shaft foundation

10/6/2022 2:42:47 PM

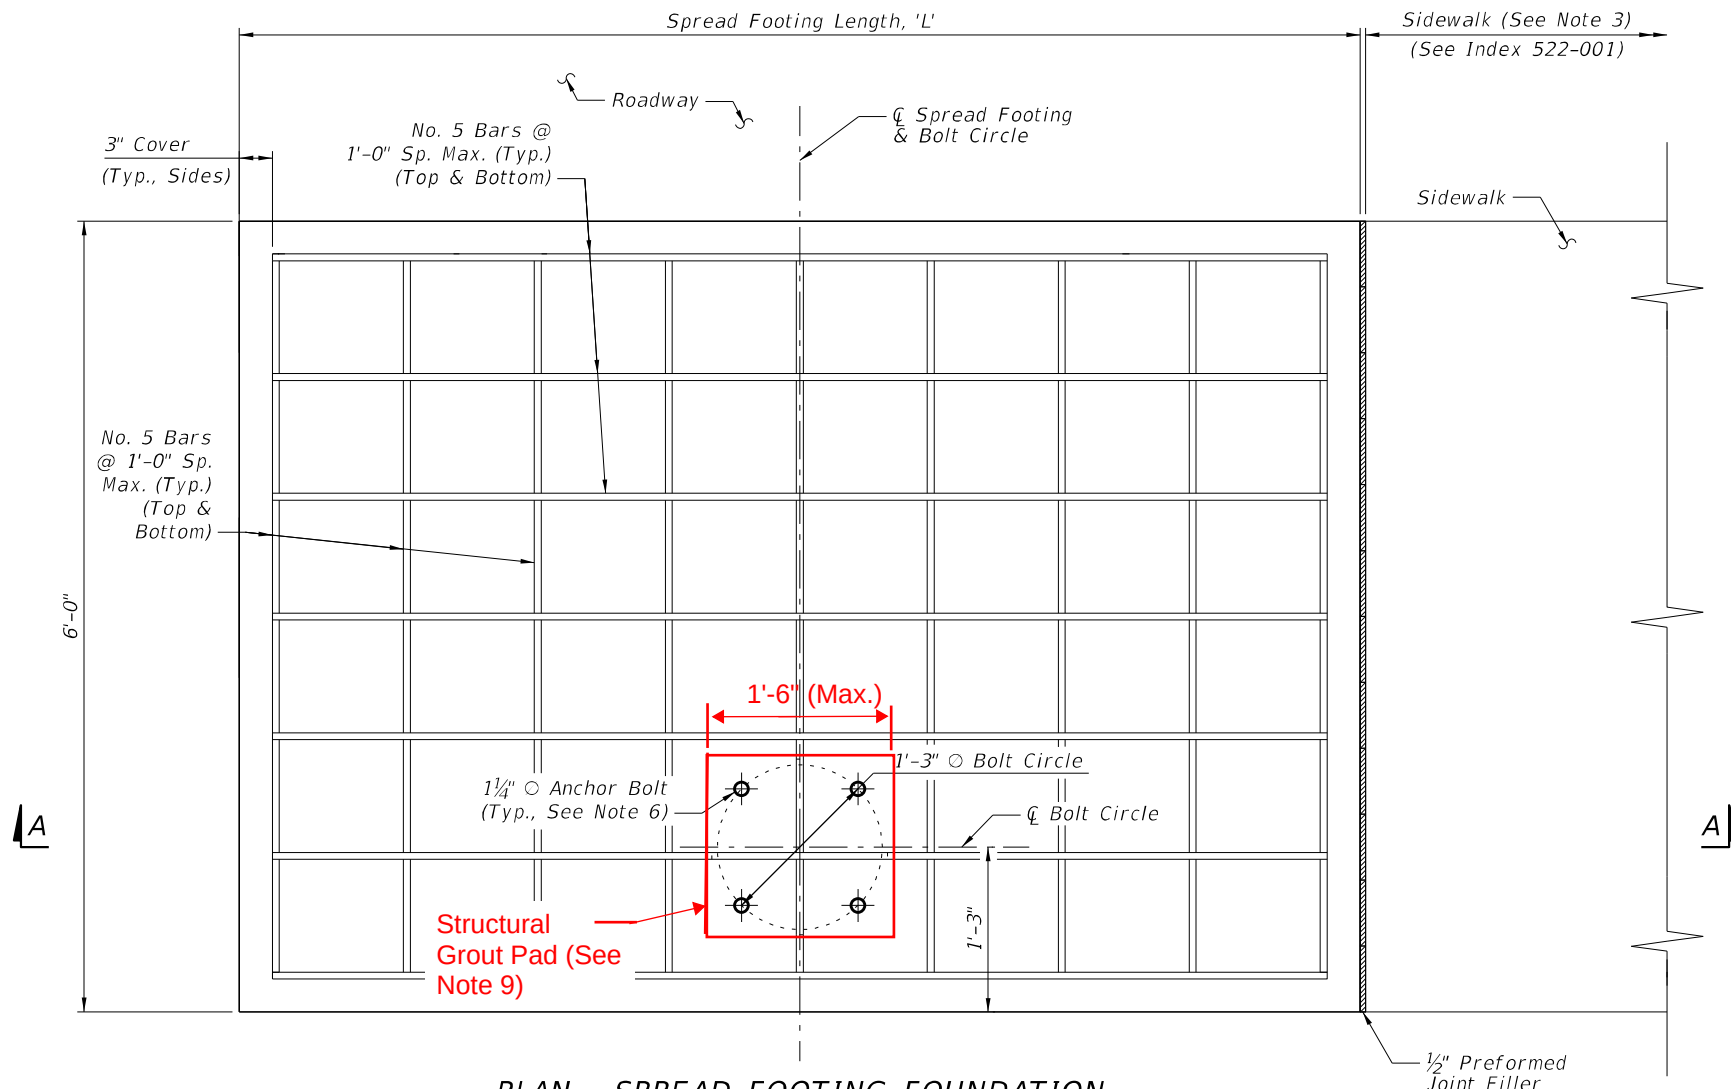

PLAN - SPREAD FOOTING FOUNDATION

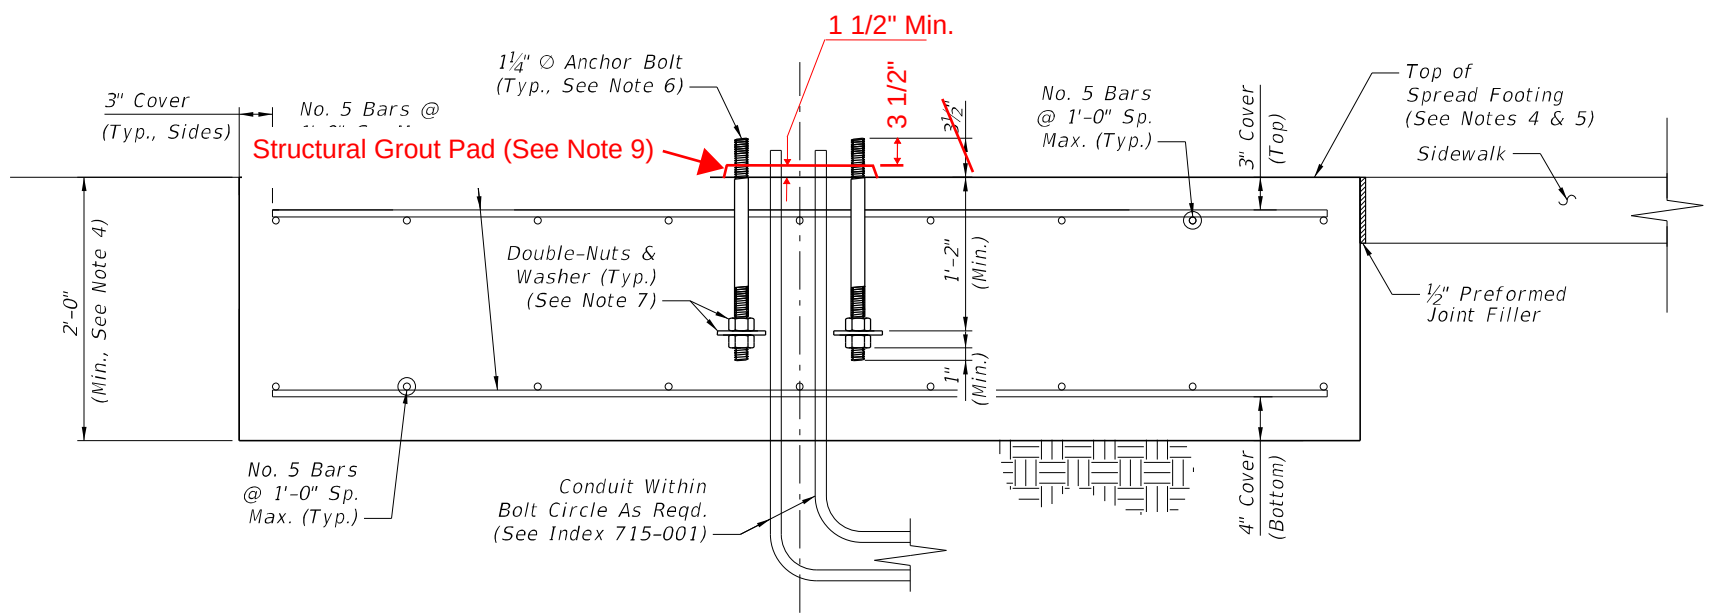

SECTION A-A - SPREAD FOOTING FOUNDATION ELEVATION

SPREAD FOOTING LENGTH, 'L'			
Mounting Height (Ft.)	Wind Speed (All Arm Lengths)		
	120 mph	140 mph	160 mph
20	4'-6"	5'-0"	6'-0"
25	4'-6"	5'-0"	6'-0"
30	7'-0"	7'-0"	7'-0"
35	7'-0"	7'-0"	7'-0"
40	7'-0"	7'-0"	10'-0"
45	8'-6"	10'-0"	10'-0"
50	8'-6"	10'-0"	11'-6"



NOTES:

1. Install the Spread Footing Foundation Option only where called for in the Plans.
2. The Spread Footing Foundation Option is only permitted for use with single arm or top mount light poles. Where applicable, the pole arm must be oriented towards the roadway side of the footing as shown. Double arm configurations are not permitted.
3. Sidewalk placed on the other side or both sides of the spread footing is permitted where shown in the Plans. The sidewalk connection to spread footing requires the 1/2" expansion joint shown regardless of the side.
4. The top of the spread footing must match the cross slope of the adjacent sidewalk where applicable per the Plans. The nominal bottom of the spread footing must remain level.
5. Apply concrete surface finish to the top of the spread footing in accordance with Specification 522-7.
6. Mount the anchor bolts plumb. For the corresponding pole base details, see Sheet 4.
7. Place zinc-plated steel washers with 15/16" or 13/8" I.D. and a minimum thickness of 1/4". Use either 4" O fender washers or 3"x3" square washers.
8. Where raised curb is called for in the Plans, provide a tooled cold joint with bond breaker between the foundation and back of raised curb. See Sheet 2 and the connection between concrete sidewalk and raised curb per Index 522-001.

Added Note 9 for new Structural Grout Pad details


SPREAD FOOTING FOUNDATION OPTION

10/6/2022 2:42:48 PM

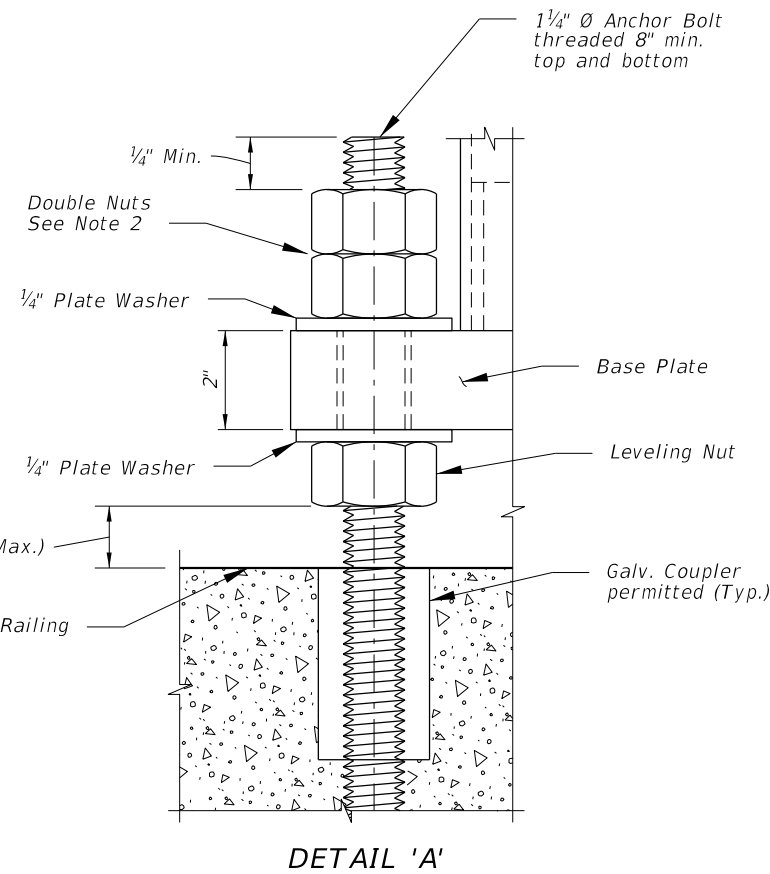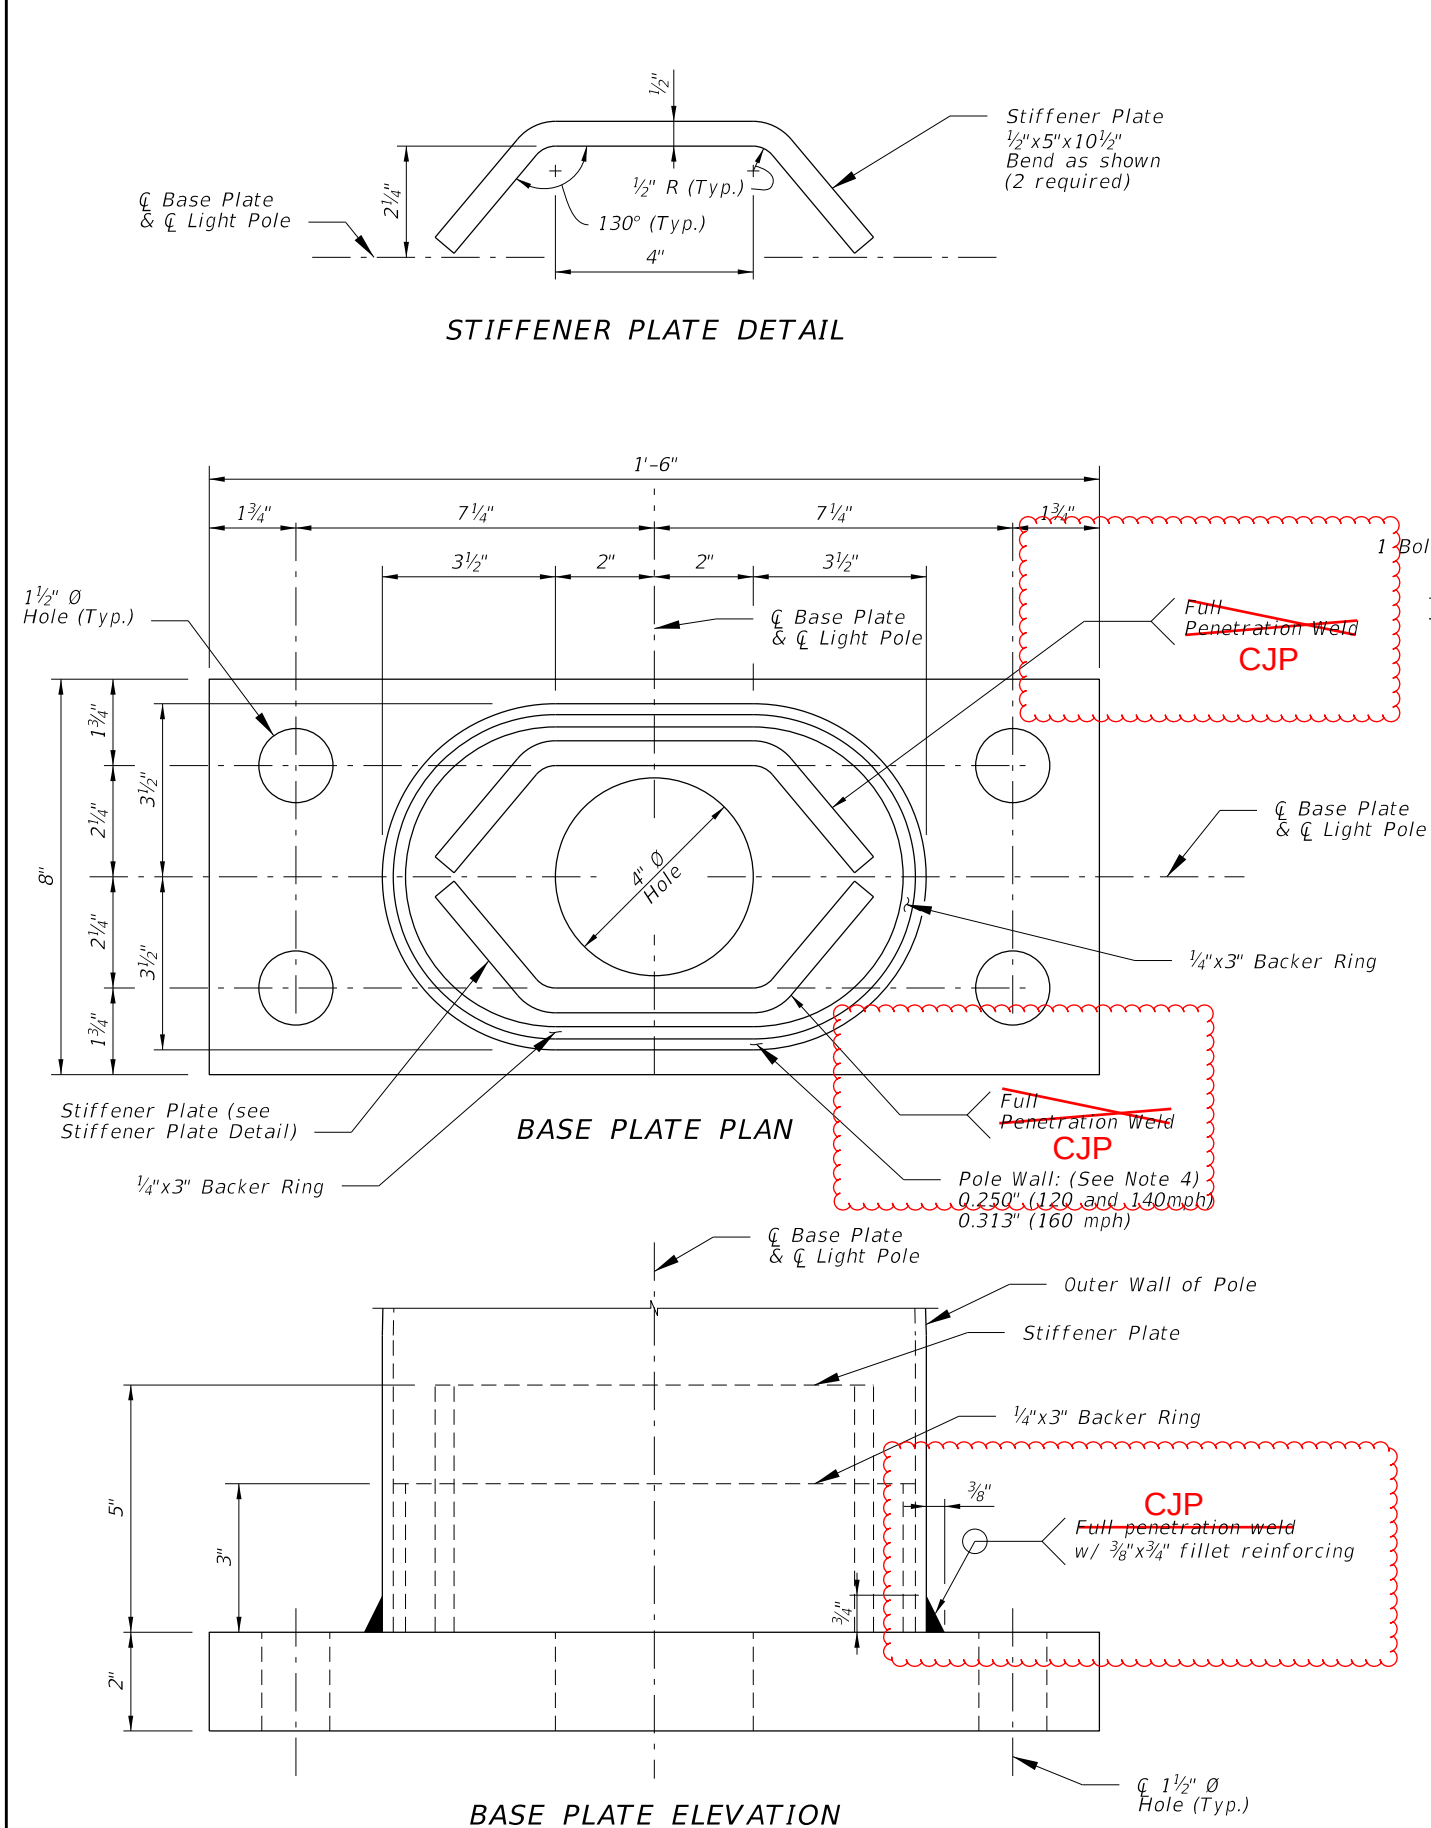


NOTES:

1. For locations of Bearing Plates, Base Plates and Detail 'A' see Sheets 7 thru 9.
2. Double Nuts: The bottom hex nut may be substituted by a half-height 'jam' nut.
3. Provide individual nut covers (not shown) for each bolt.
4. Pole wall thicknesses shown are nominal and shall be within the Aluminum Association Tolerances. Thicker walls are permitted and tapered walls may be used in accordance with the minimum Aluminum Association thicknesses.

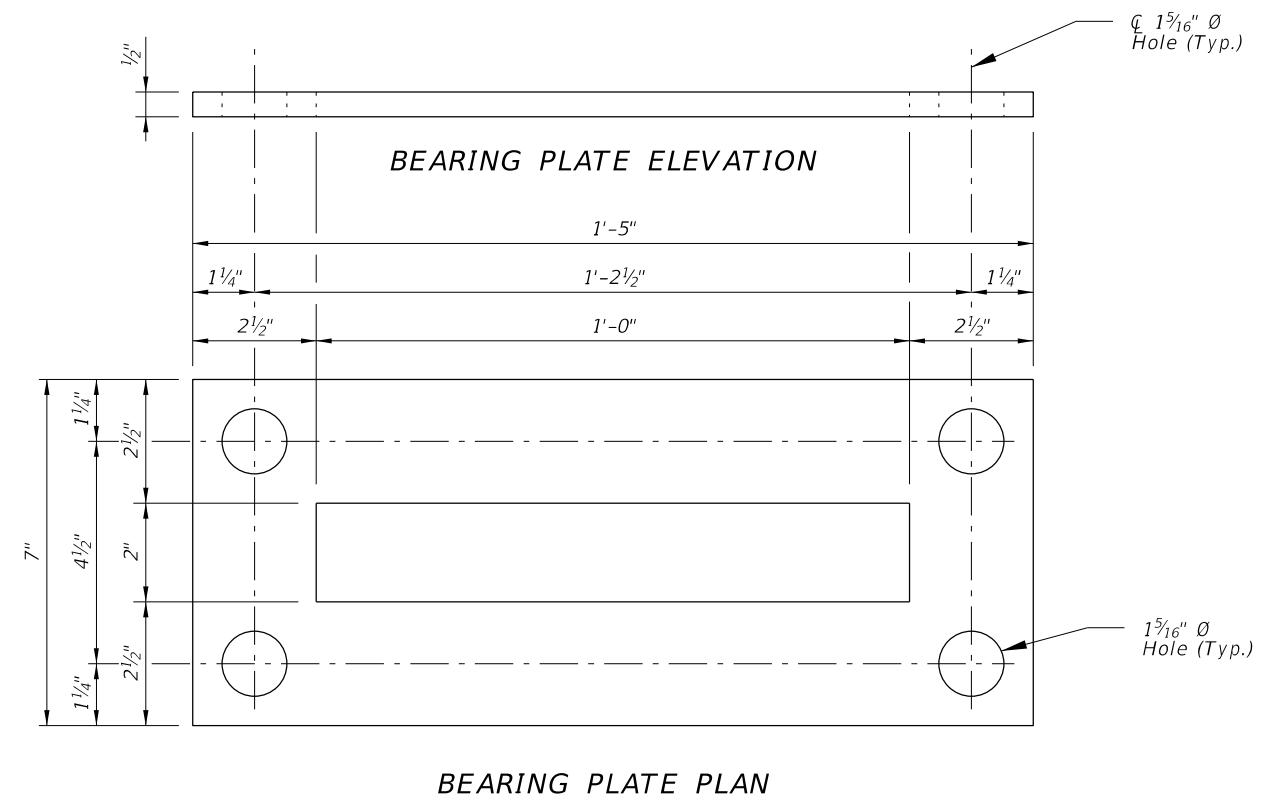


BASE PLATE DETAILS FOR MEDIAN BARRIER MOUNTED ALUMINUM LIGHT POLE


LAST REVISION		DESCRIPTION:	FDOT	FY 2023-24 STANDARD PLANS	STANDARD ALUMINUM LIGHTING	INDEX 715-002	SHEET 6 of 9
11/01/22	11/01/23						

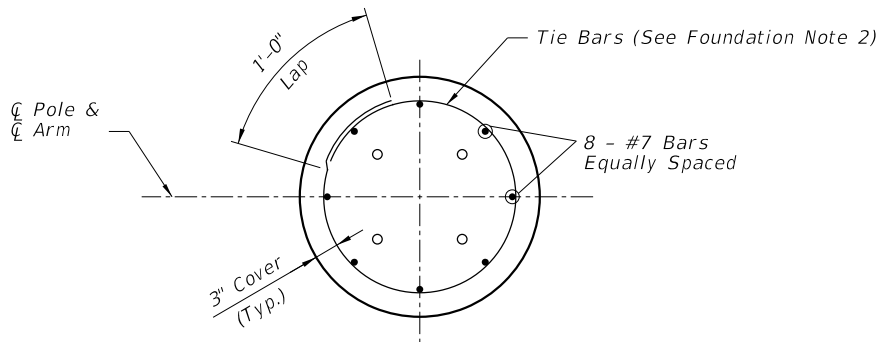


SECTION C-C

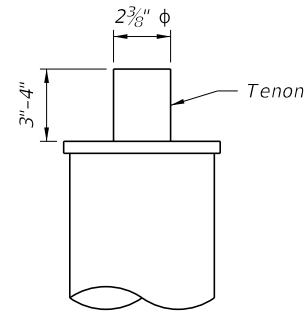

TOP MOUNT TENON

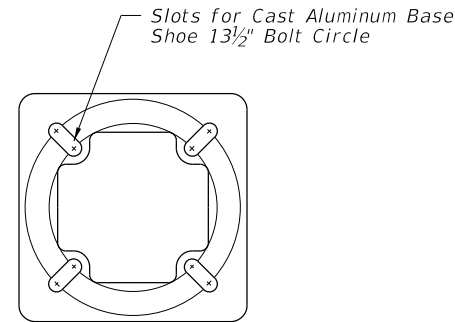


TOP VIEW
TRANSFORMER BASE

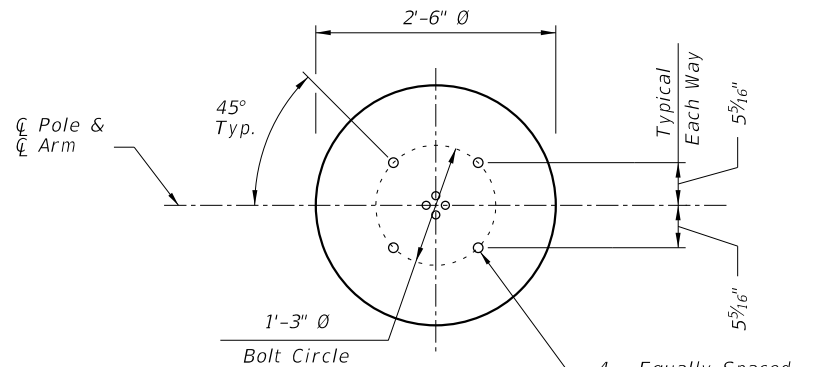

VIEW B-B

Anchor Bolt (Plumb, See Note in Pole Base Elevation)

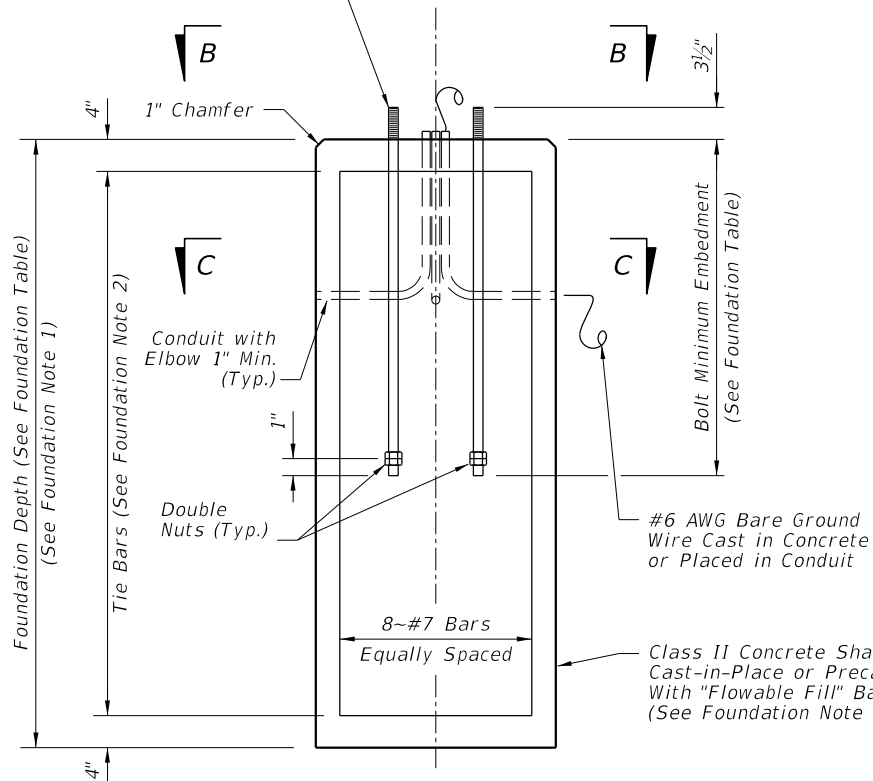

SHAFT FOUNDATION ELEVATION

SHAFT FOUNDATION NOTES:


1. Depths shown are for slopes equal to or flatter than 1:4. For slope steeper than 1:4 and equal to or flatter than 1:2 add 2'-6" to foundation depths shown.
2. Foundation Tie Bars: #4 Tie Bars @ 12" centers (max.) or D10 (or W10) spiral @ 6" pitch, 3 flat turns top and 1 flat turn bottom.
3. For precast foundations, the circular cross section shown herein may be substituted with an octagon shape. The out-to-out distance between parallel edges of the octagon must be $\geq$ 2'-6". Maintain the reinforcing diameter and placement shown herein with a minimum 3" cover.

Fillet Weld Outside of Pole to Top of Base Shoe: (See Pole Table)

Cast Aluminum Pressure Mounted Nut Cover - Bolted Attachment Optional

Fillet Weld Butt of Pole to Inside of Base Shoe: (See Pole Table)

Cast Aluminum Frangible/Breakaway Transformer Base. See General Notes on Sheet 1

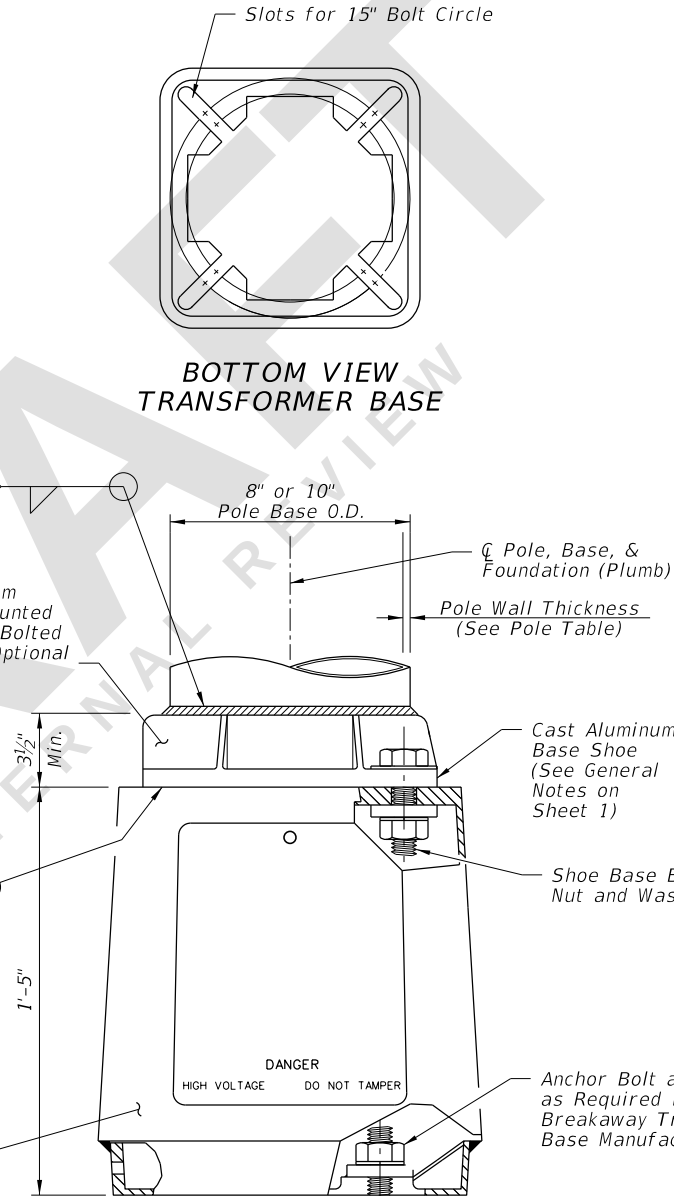

POLE BASE ELEVATION

ARM-POLE TABLE

FOR STANDARD ALUMINUM LIGHT POLES WITH ARM

Mounting Height (Ft.)	Wind Speed and Arm Lengths (Ft.)					
	120 mph	140 mph		160 mph		
	8, 10, 12, 15	8, 10, 12	15	8, 10	12, 15	
30	A1-P1	A1-P1	A2-P1	A1-P1	A2-P1	
35				A1-P2	A2-P2	
40						
45	A1-P2	A1-P2	A2-P2	A1-P3	A2-P3	
50						

ARM POLE NOTES:

1. See ARM SECTION detail on Sheet 3 for all A1 and A2 Values.
2. See Pole Table for all P1, P2, and P3 values.
3. For Median Barrier Mounted Pole, Use Arm A1.
4. For 20' and 25' assembly heights use only 8' or 10' arm A1 with P0.

POLE TABLE

Pole	Pole Wall Thickness	Top of Base Shoe Weld	Inside of Base Shoe Weld
P0	0.156	3/16"	5/32"
P1	0.156	3/16"	5/32"
P2	0.250	1/4"	1/4"
P3	0.313	5/16"	5/16"

POLE NOTES:

1. Pole wall thicknesses shown are nominal and must be within the Aluminum Association tolerances.
2. Thicker walls are permitted and tapered walls may be used in accordance with the minimum Aluminum Association thicknesses.

TOP MOUNT POLE TABLE

FOR STANDARD ALUMINUM LIGHT POLES WITH TOP MOUNT

Mounting Height (Ft.)	Wind Speed and Arm Lengths (Ft.)		
	120 mph	140 mph	160 mph
20	Pole P0	Pole P0	Pole P0
25			
30			
35	Pole P1	Pole P1	Pole P1
40			
45	Pole P2	Pole P2	Pole P2
50			


SHAFT FOUNDATION TABLE

Pole	P0	P1	P2	P3
Depth	6'-0"	7'-0"	8'-0"	8'-0"
Bolt Min. Embedment	2'-6"	3'-6"	3'-6"	3'-6"


SHAFT FOUNDATION OPTION
WITH LIGHT POLE & BASE DETAILS

5/24/2023 10:28:43 AM

5/24/2023

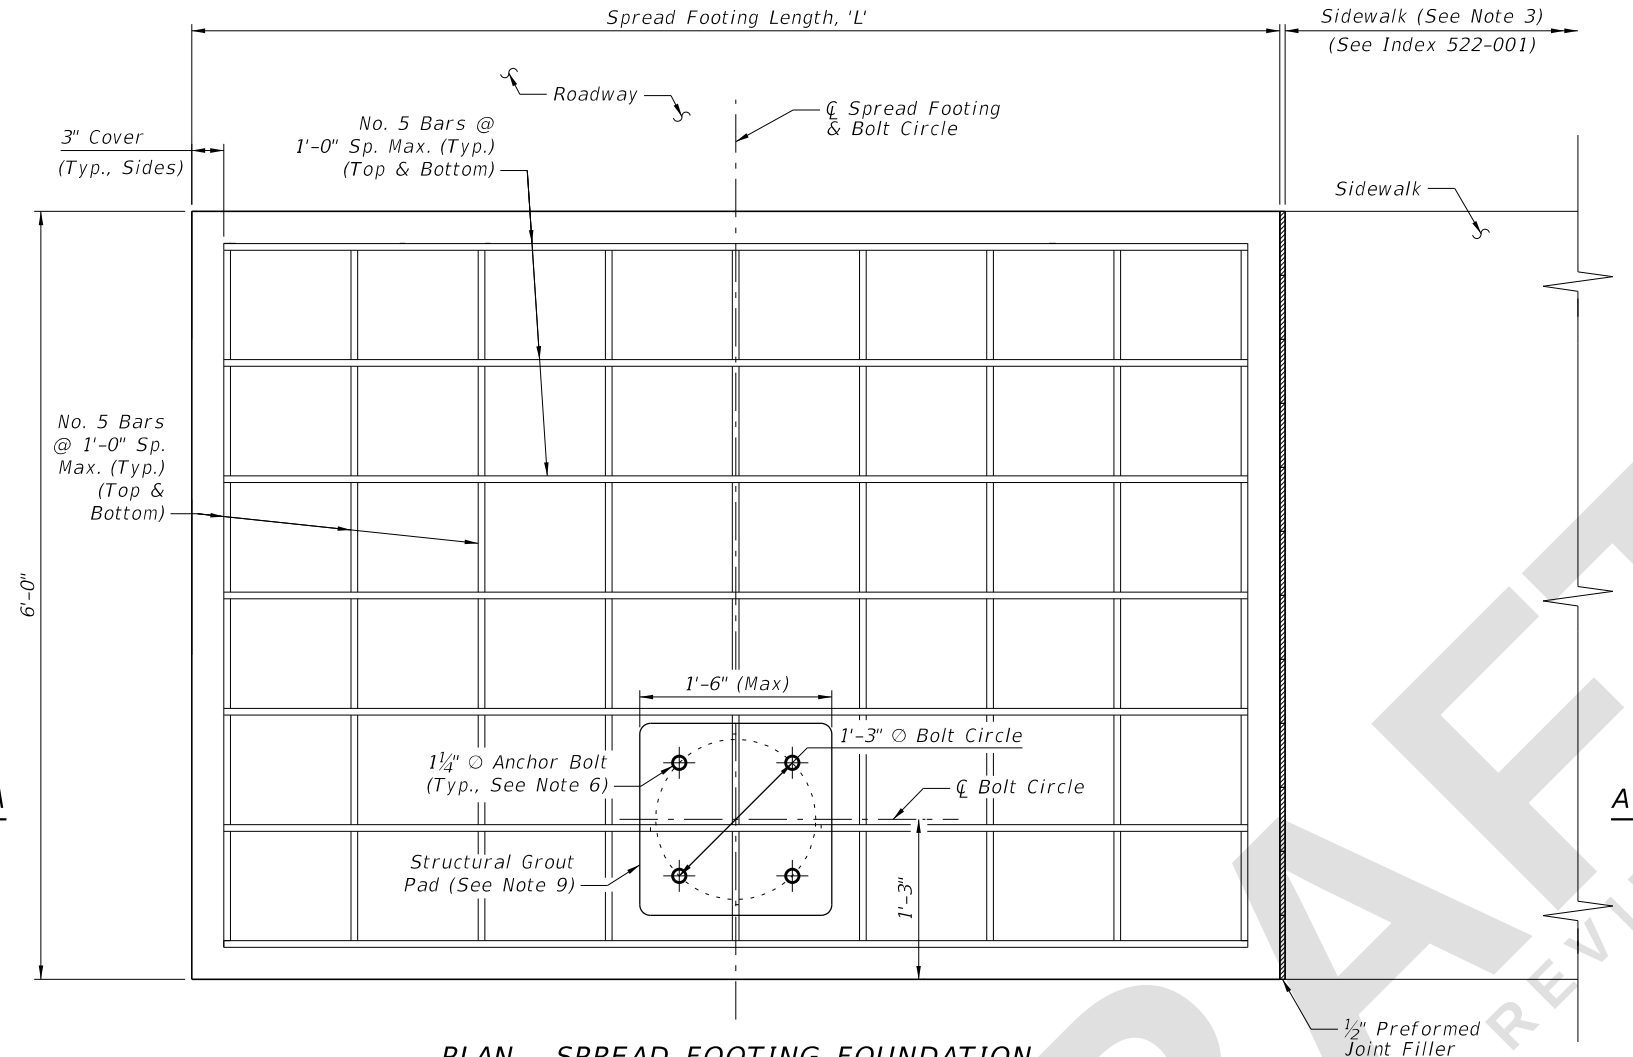

PLAN - SPREAD FOOTING FOUNDATION

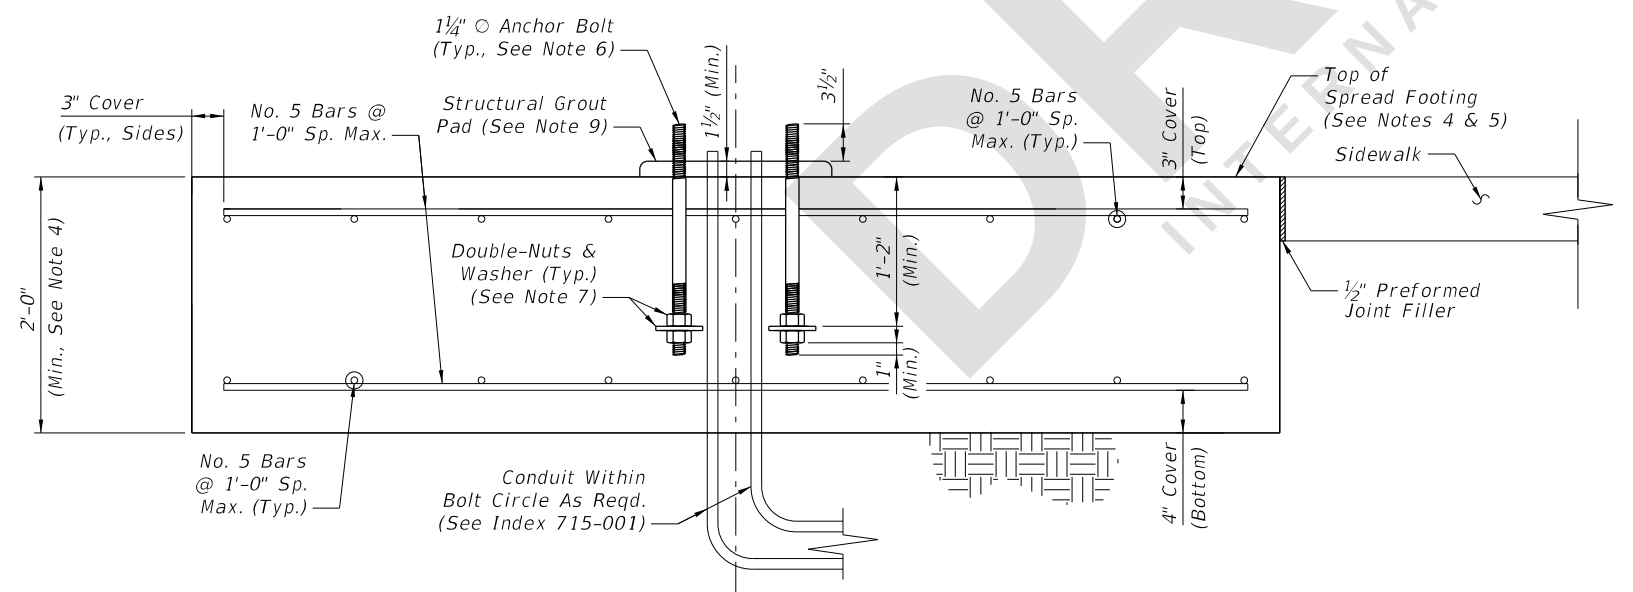

SECTION A-A - SPREAD FOOTING FOUNDATION ELEVATION

SPREAD FOOTING LENGTH, 'L'			
Mounting Height (Ft.)	Wind Speed (All Arm Lengths)		
	120 mph	140 mph	160 mph
20	4'-6"	5'-0"	6'-0"
25	4'-6"	5'-0"	6'-0"
30	7'-0"	7'-0"	7'-0"
35	7'-0"	7'-0"	7'-0"
40	7'-0"	7'-0"	10'-0"
45	8'-6"	10'-0"	10'-0"
50	8'-6"	10'-0"	11'-6"



NOTES:

1. Install the Spread Footing Foundation Option only where called for in the Plans.
2. The Spread Footing Foundation Option is only permitted for use with single arm or top mount light poles. Where applicable, the pole arm must be oriented towards the roadway side of the footing as shown. Double arm configurations are not permitted.
3. Sidewalk placed on the other side or both sides of the spread footing is permitted where shown in the Plans. The sidewalk connection to spread footing requires the 1/2" expansion joint shown regardless of the side.
4. The top of the spread footing must match the cross slope of the adjacent sidewalk where applicable per the Plans. The nominal bottom of the spread footing must remain level.
5. Apply concrete surface finish to the top of the spread footing in accordance with Specification 522-7.
6. Mount the anchor bolts plumb. For the corresponding pole base details, see Sheet 4.
7. Place zinc-plated steel washers with 1 5/16" or 1 3/8" I.D. and a minimum thickness of 1/4". Use either 4" O fender washers or 3"x3" square washers.
8. Where raised curb is called for in the Plans, provide a tooled cold joint with bond breaker between the foundation and back of raised curb. See Sheet 2 and the connection between concrete sidewalk and raised curb per Index 522-001.
9. Place a structural grout pad in accordance with Specification 649-9. The grout pad is square and centered on the bolt circle centerlines. Level the top of the grout pad and smooth the edges and corners per the approval of the Engineer. Install the transformer base in accordance with Sheet 4 and the manufacturer's specifications.


SPREAD FOOTING FOUNDATION OPTION

5/24/2023 10:22:32 AM

5/24/2023 10:29:21 AM

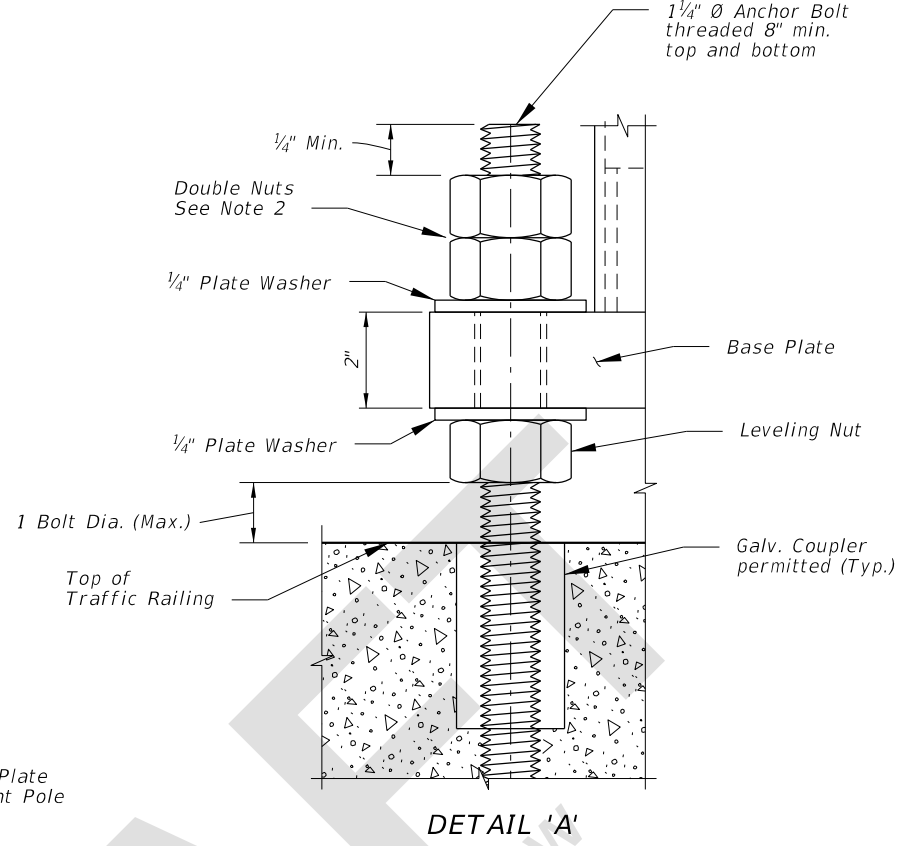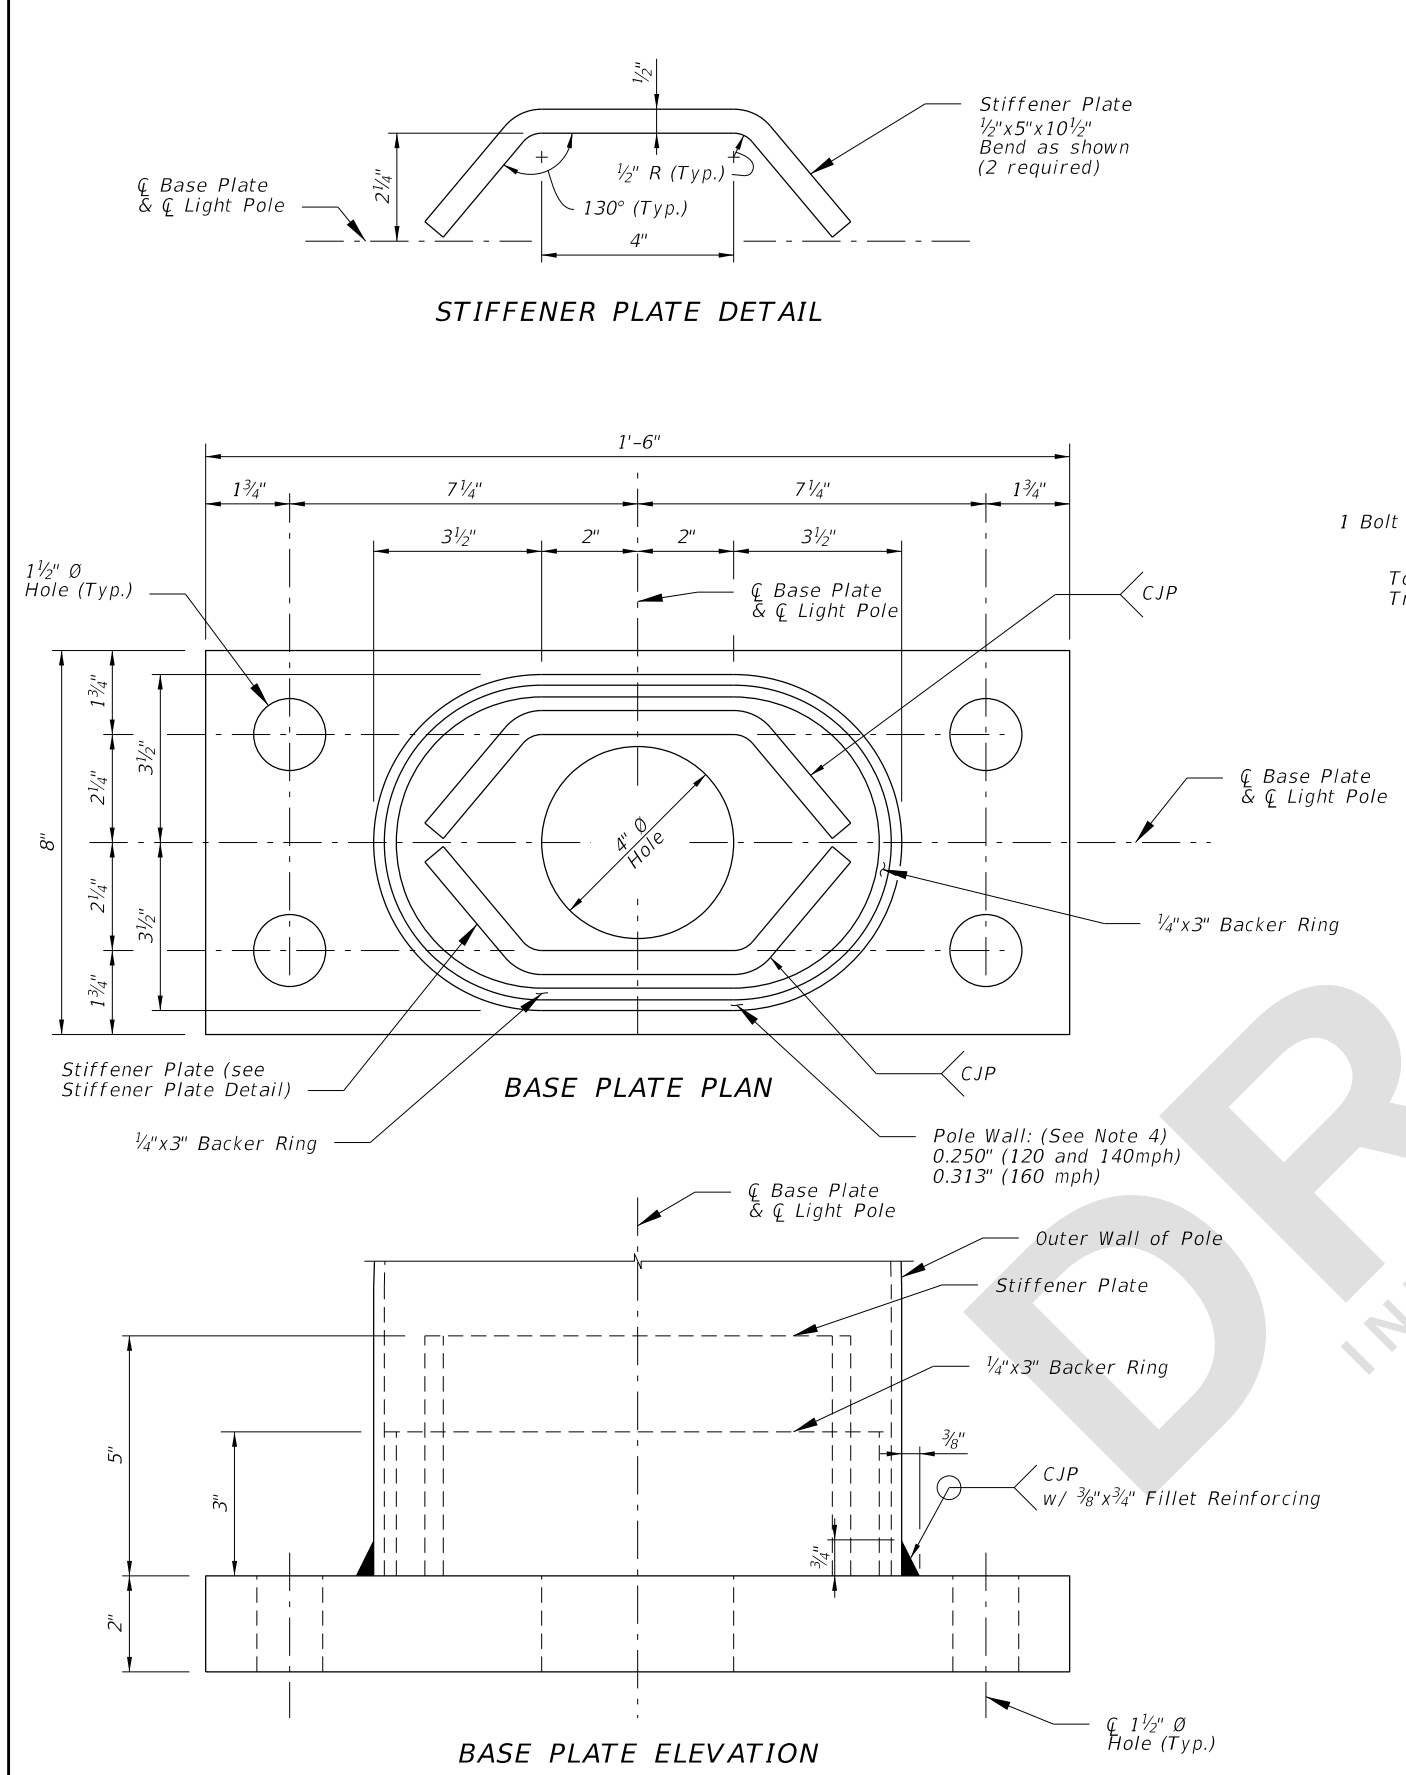

- NOTES:**
1. For locations of Bearing Plates, Base Plates and Detail 'A' see Sheets 7 thru 9.
 2. Double Nuts: The bottom hex nut may be substituted by a half-height 'jam' nut.
 3. Provide individual nut covers (not shown) for each bolt.
 4. Pole wall thicknesses shown are nominal and shall be within the Aluminum Association Tolerances. Thicker walls are permitted and tapered walls may be used in accordance with the minimum Aluminum Association thicknesses.

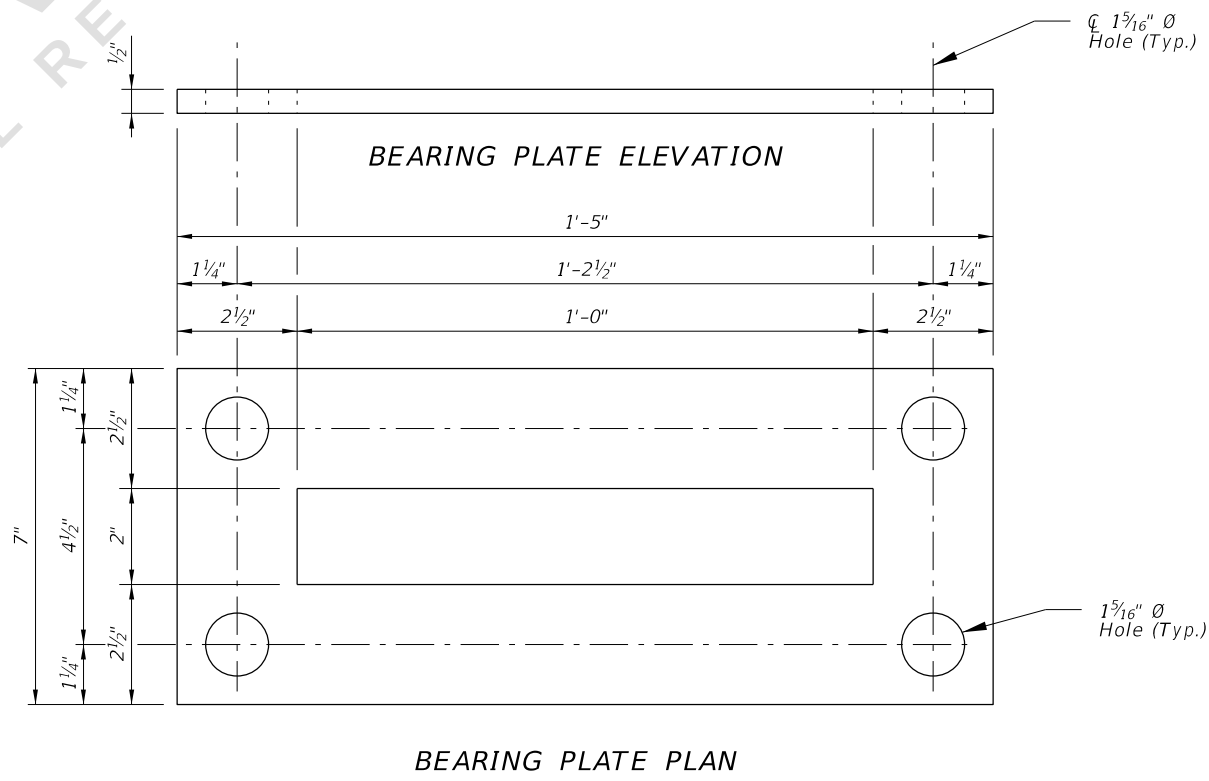

BASE PLATE DETAILS FOR MEDIAN BARRIER MOUNTED ALUMINUM LIGHT POLE			STANDARD ALUMINUM LIGHTING		
LAST REVISION 11/01/23	DESCRIPTION:	FDOT FY 2024-25 STANDARD PLANS	INDEX 715-002	SHEET 6 of 9	