
Index 700-102 Special Sign Details

ORIGINATION

Date: 7/22/24

Name: Benazir Portal

Phone: 954-903-8107

Email: Benazir.portal@dot.state.fl.us

COMMENTARY

The 11th edition of the MUTCD now includes Work Zone Bike Warning Signs, which means some MOT signs shown in Index 700-102 can be deleted. Additionally, the 11th edition of the MUTCD includes Temporary Traffic Control Typical Applications for Work in the Vicinity of Bicycle Lanes and Shared Use Paths, which specify what warning signs need to be used and where they should be placed. Consequently, the "BIKE LANE CLOSED AHEAD" plaques (MOT-24-21, MOT-25-21) will no longer be used.

The depictions of FTP-68A-06 and FTP-68B-06 are being updated to more closely depict R10-3f and R10-3i in the MUTCD 11th Edition.

COMMENTS AND RESPONSES

BLACK = Industry Review Comments **BLUE** = Standard Plans Response **GREEN** = Change Made to Index

Name: David Zeller

Date: 8/1/24

COMMENT: Sheet 10 – In Sign FTP-86-21, consider changing “WITHIN” to “IN” to match the version in the new MUTCD.

Deleting FTP-68B-06 from Index 700-102 is a terrible mistake. This design is very frequently used in our district's signalization plans and there is nothing in the new MUTCD that sufficiently replaces it. We need the flexibility to use pedestrian detector signs which do not include directional arrows.

RESPONSE: For FTP-86-21, due to the ongoing research associated with the corresponding Request to Experiment (RTE), we will hold off on making changes on the sign legend and size until further coordination with FHWA.

We will add FTP-68A-06 and FTP-68B-06 back in with it updated to more closely align with the MUTCD 11th edition.

CHANGE MADE TO INDEX: Yes, FTP-86A-06 and FTP-86B-06 were added back into the index and updated.

Response Date: 8/15/24

Name: Alan Mrvica


Date: 8/1/24

COMMENT: Add details for Right Turn ONLY and Thru Only arrows signs similar to FTP-55L-06.


RESPONSE: Thank you for your comment. This is outside the scope of this change and will be considered in future cycles.

CHANGE MADE TO INDEX: No.

Response Date: 8/15/24

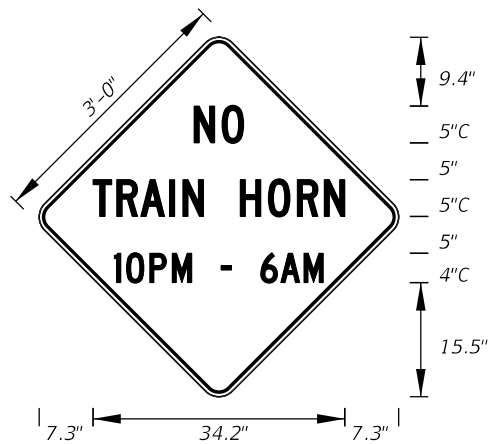

FTP-62-06
 3' X 3'
 2" Radii 3/4" Border 4" and 5" Series C Legend
 Yellow Background Black Legend and Border

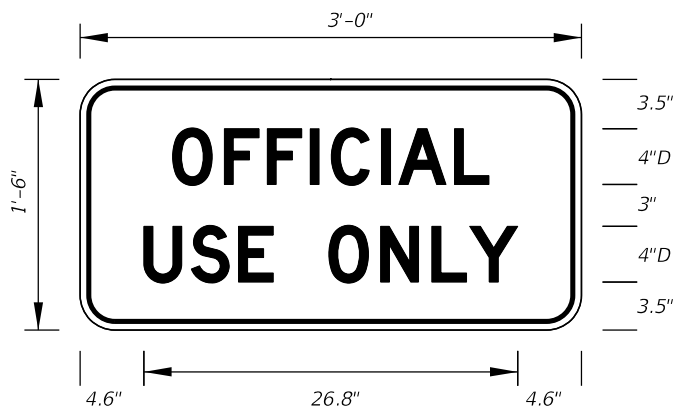

FTP-65-06
 3' X 1'-6"
 2" Radii 3/4" Border 4" Series D Legend
 White Background Black Legend and Border



FTP-66-21
 4' X 5'
 3" Radii 1" Border 6" Series D Legend
 Blue Background White Legend and Border




FTP-67-21
 5.5' X 6'
 3" Radii 1" Border 8" Series D Legend
 Blue Background White Legend and Border



DETAIL for FTP-66 AND FTP-67


Sign Mounting Holes Can Be Punched Or Field Drilled With No Obstruction To Text Or Symbols From Holes Or Bolts.

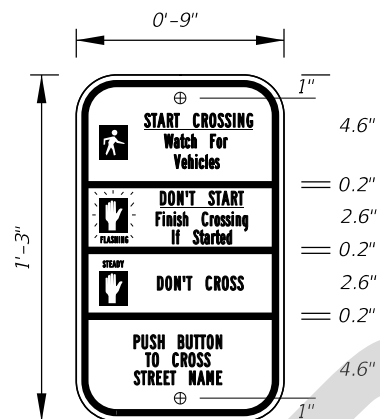

FTP-68A-06
 9" X 1'-3"
 1.5" Radii 3/4" Border Series B Legend
 White Background Black Legend and Border


See MUTCD R10-3f for Letter Size, Spacing, and Symbol Sizes and Color

Sign Mounting Holes Can Be Punched Or Field Drilled With No Obstruction To Text Or Symbols From Holes Or Bolts.

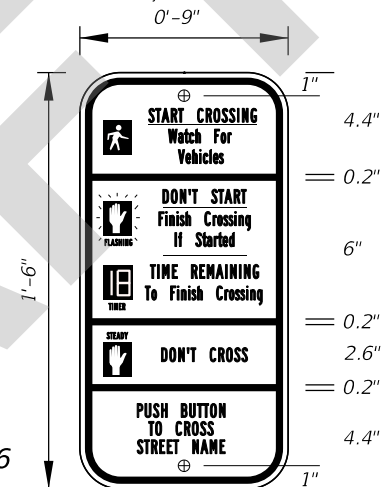


FTP-68B-06
 9" X 1'-6"
 1.5" Radii 3/4" Border Series B Legend
 White Background Black Legend and Border

See MUTCD R10-3i for Letter Size, Spacing, and Symbol Sizes and Color

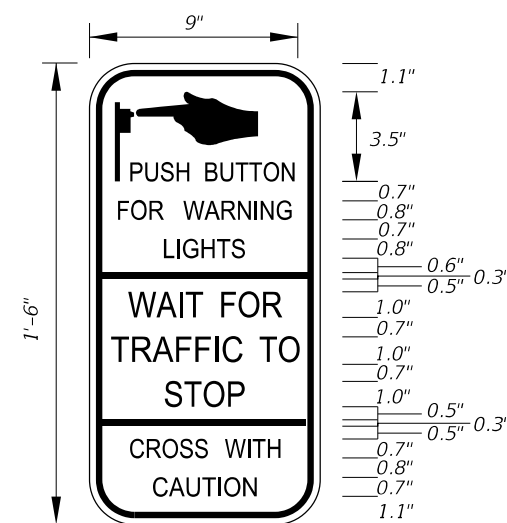

FTP-68C-21
 9" X 1'-6"
 1.5" Radii 1/4" Border Series D Legend
 White Background Black Legend and Border

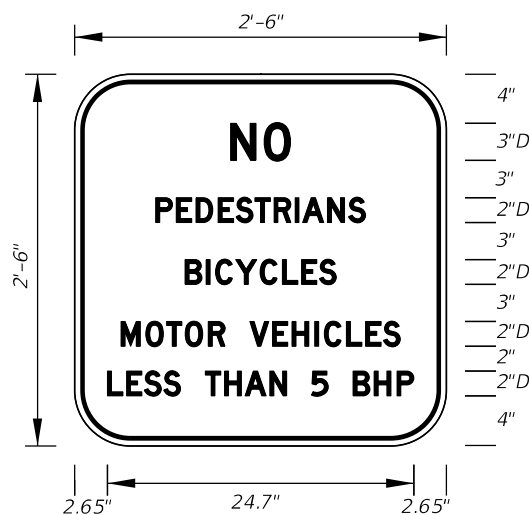

FTP-69-06
 2'-6" X 2'-6"
 4" Radii 3/4" Border 2" and 3" Series D Legend
 White Background Black Legend and Border



FTP-70-06
 3'-6" X 2'-6"
 2.25" Radii 3/4" Border 5" Series C and 7" Series C Legend
 Blue Background White Legend and Border



FTP-71-06
 4' X 4'
 2" Radii 3/4" Border 8" Series C Legend
 Yellow Background Black Legend and Border



FTP-72-06
 3' X 3'
 2" Radii 3/4" Border 6" Series C Legend
 Yellow Background Black Legend and Border

8/15/2024 2:49:01 PM

LAST REVISION	DESCRIPTION:
11/01/24	



FY 2025-26
 STANDARD PLANS

SPECIAL SIGN DETAILS

INDEX
 700-102

SHEET
 8 of 12