

Origination Form

Proposed Revisions to a Standard Plans Index

Originator:	Gibbs, Shae	Index Number:	711-001
Date:	9/17/24	Sheet Number(s):	4
E-mail:	shae.gibbs@dot.state.fl.us	Index Title:	Pavement Markings

Summary of the changes:

Sheet 4: Updated Buffered Express Lane Striping Detail to replace "Express" with "Managed" in title and callouts; Deleted "Buffered" in detail title and callout; Replaced "Buffer" with "Separation" in callout; Deleted extraneous lines from the detail; Updated Note 3 to replace "Express Lane" with "Tubular"


Commentary/Background:

Coordination between FHWA and the FDOT Traffic Operations Office resulted in changes to the FDM and TEM to coincide with the MUTCD. The changes to this Index were made to coincide with the proposed updates to the FDM and TEM.

Other Affected Documents/Offices	Person Contacted	Affected (Yes/No)
Other Standard Plans		No
FDOT Design Manual		No
Standard Specifications		No
Basis of Estimates Manual		No
Approved Product List		No
Construction Office		No
Maintenance Office		No

Implementation


["FY-Standard Plans (Next Release)"]

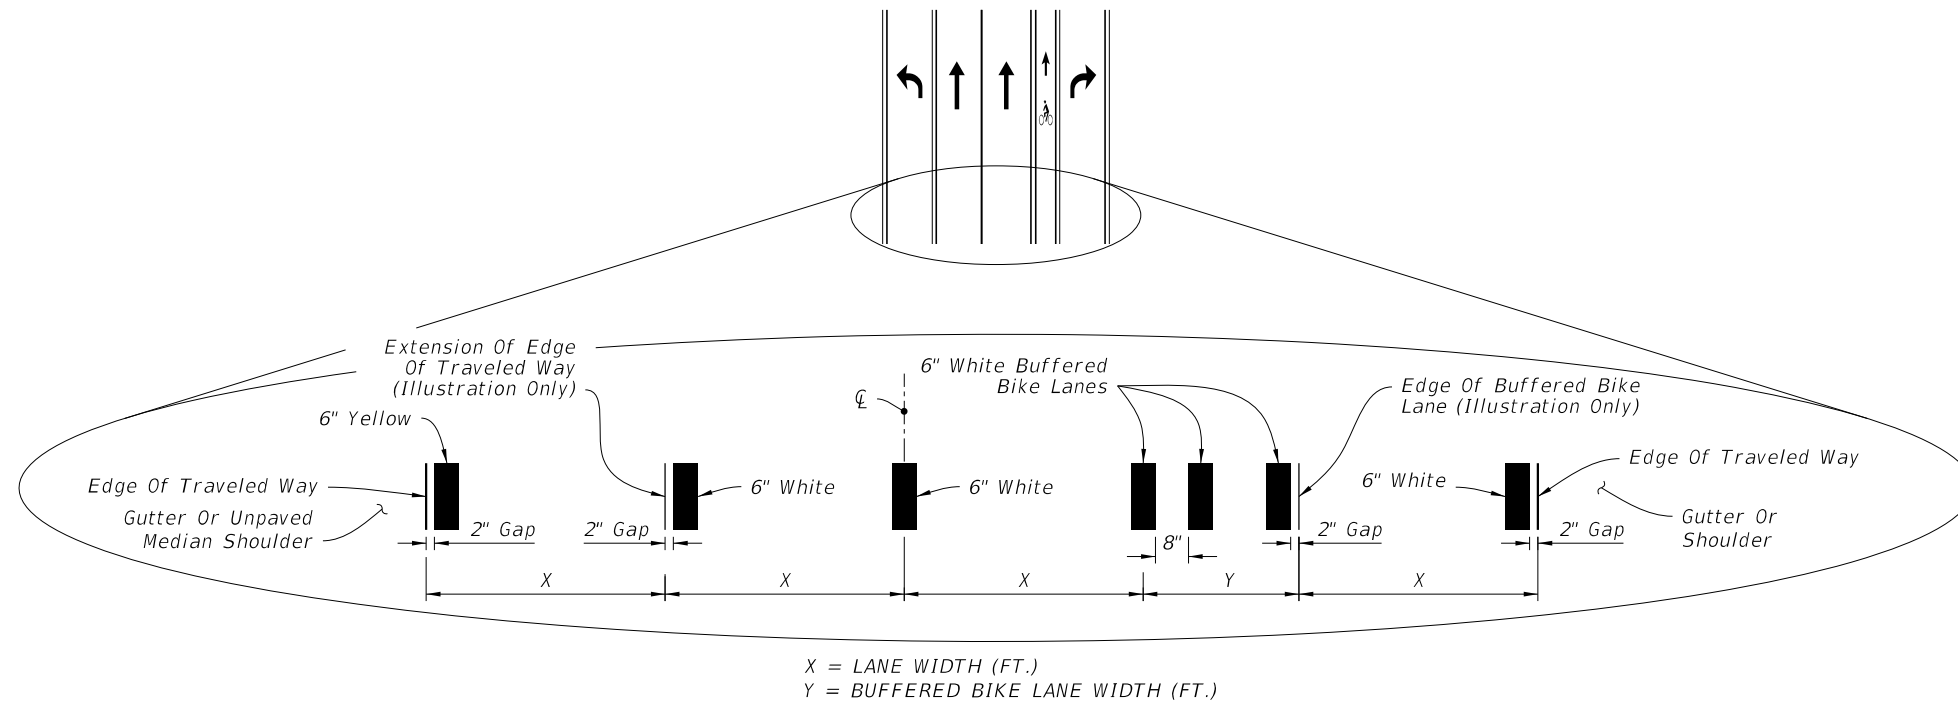

INTERSECTION APPROACH STRIPING WITH TURN LANES AND BUFFERED BIKE LANE KEY HOLE

NOTES:

1. Lane widths (X) may not be same for each lane in the section.
2. For placement of RPMs, see Index 706-001.
3. For placement of ~~Express Lane~~ **Tubular** markers and associated RPMs, see the Plans.

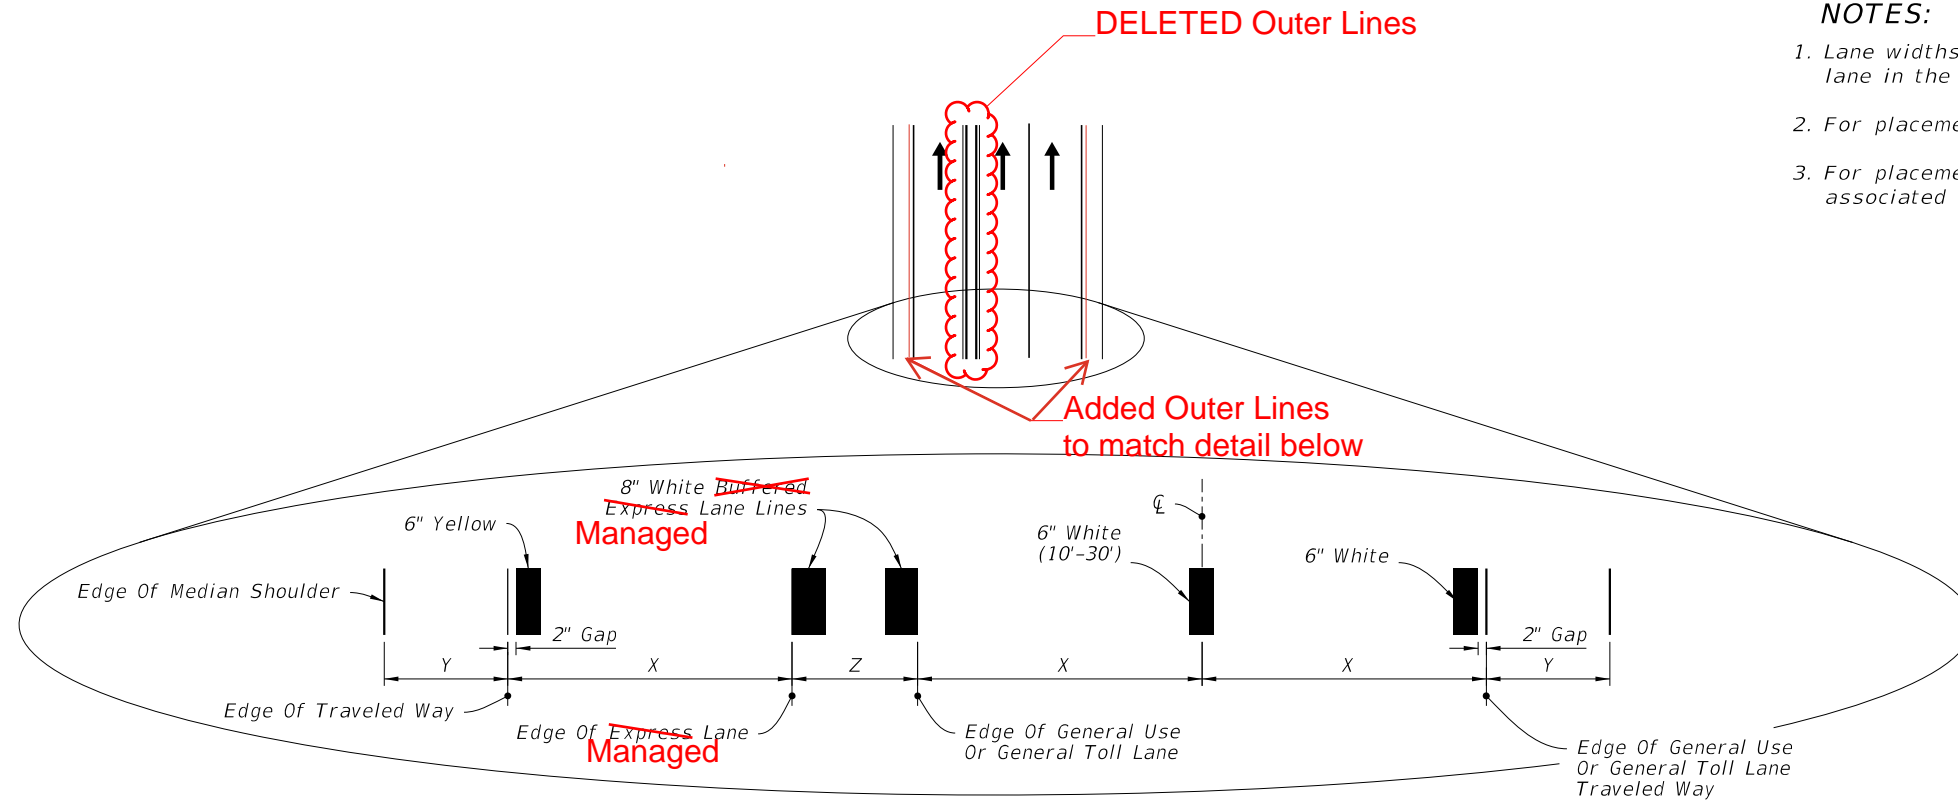


~~BUFFERED EXPRESS LANE STRIPING~~

PLACEMENT OF LONGITUDINAL PAVEMENT MARKINGS

10/17/2023 7:24:49 AM


LAST REVISION 11/01/21 11/01/24	REVISION	DESCRIPTION:		FY 2024-25 2025-26 STANDARD PLANS	PAVEMENT MARKINGS	INDEX 711-001	SHEET 4 of 13
---	----------	--------------	--	--	-------------------	------------------	------------------

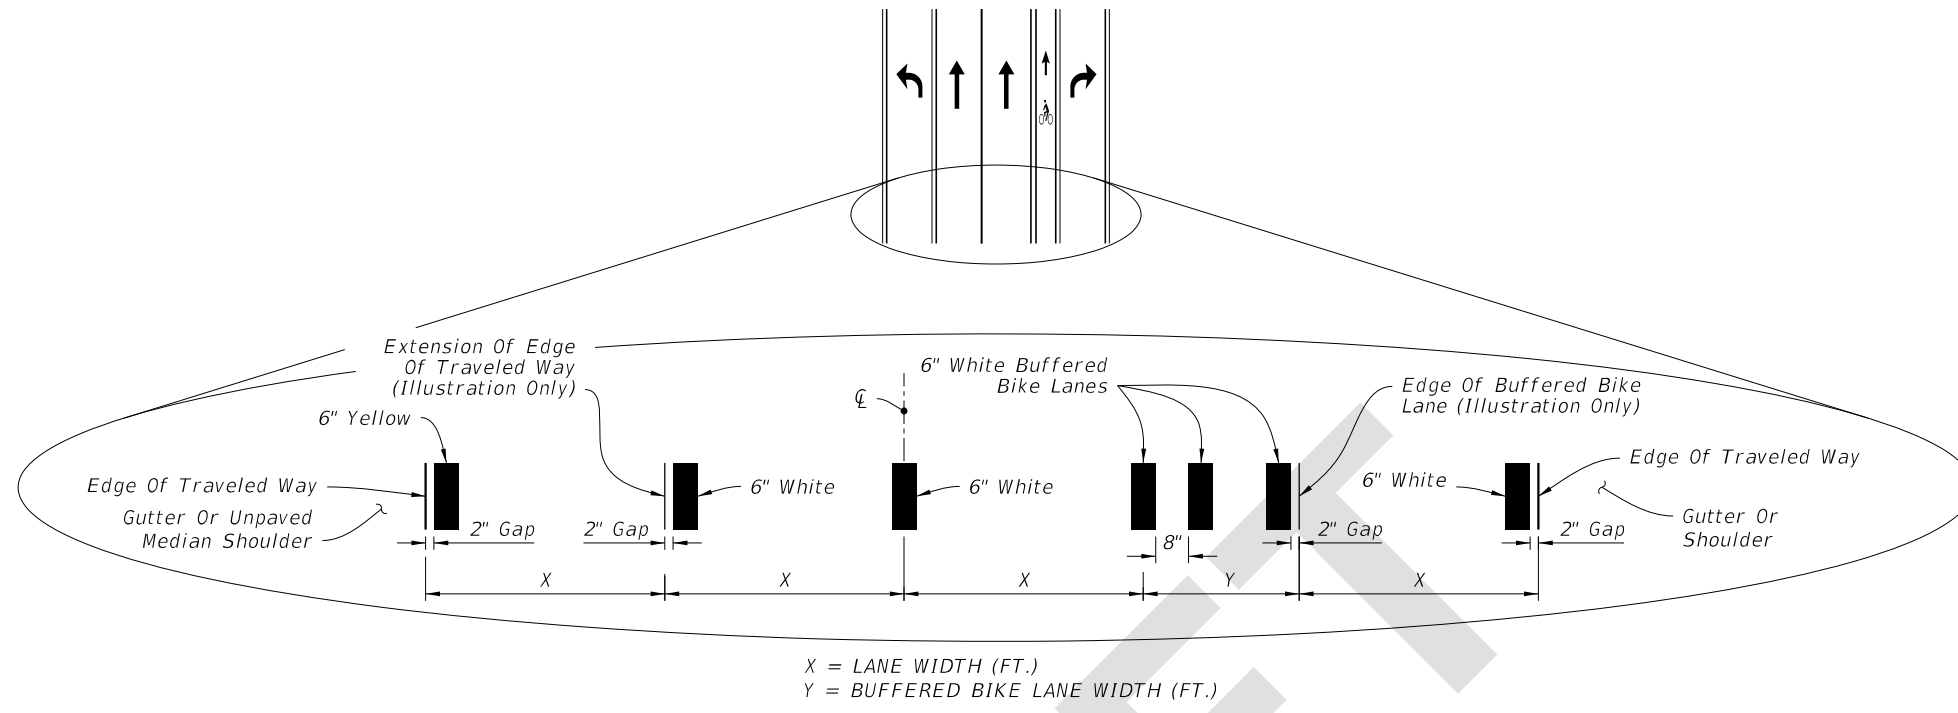

INTERSECTION APPROACH STRIPING WITH TURN LANES AND BUFFERED BIKE LANE KEY HOLE

NOTES:


1. Lane widths (X) may not be same for each lane in the section.
2. For placement of RPMs, see Index 706-001.
3. For placement of tubular markers and associated RPMs, see the Plans.

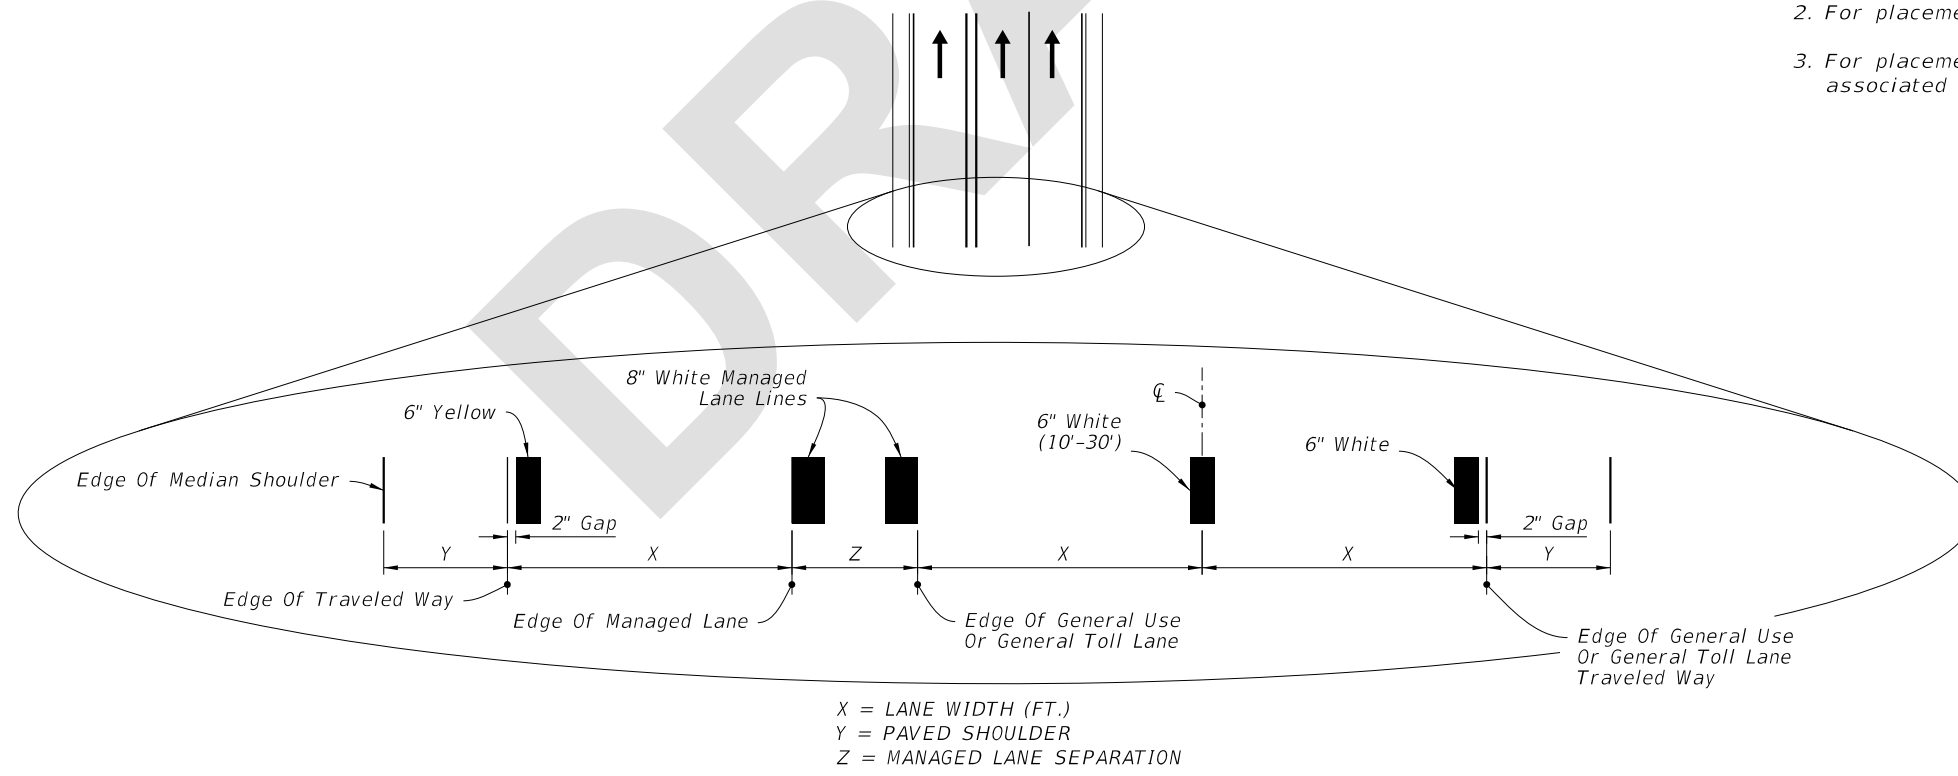

MANAGED LANE STRIPING

PLACEMENT OF LONGITUDINAL PAVEMENT MARKINGS

10:08:44 AM
10/3/2024

LAST REVISION 11/01/24	REVISION	DESCRIPTION:	 FY 2025-26 STANDARD PLANS	PAVEMENT MARKINGS	INDEX 711-001	SHEET 4 of 13
---------------------------	----------	--------------	--	--------------------------	------------------	------------------