

Origination Form

Proposed Revisions to a Standard Plans Index

Originator:	Gibbs, Shae	Index Number:	711-001
Date:	6/18/2024	Sheet Number(s):	3
E-mail:	Shae.Gibbs@dot.state.fl.us	Index Title:	Pavement Markings

Summary of the changes:

Sheet 3: Deleted Buffered Bike Lane Flush Shoulder detail


Commentary/Background:

Paved Shoulders are no longer allowed to be marked as Bike Lanes per the new MUTCD 11th edition Section 9E.01


Other Affected Documents/Offices	Person Contacted	Affected (Yes/No)
Other Standard Plans		No
FDOT Design Manual		No
Standard Specifications		No
Basis of Estimates Manual		No
Approved Product List		No
Construction Office		No
Maintenance Office		No

Implementation


["FY-Standard Plans (Next Release)"]

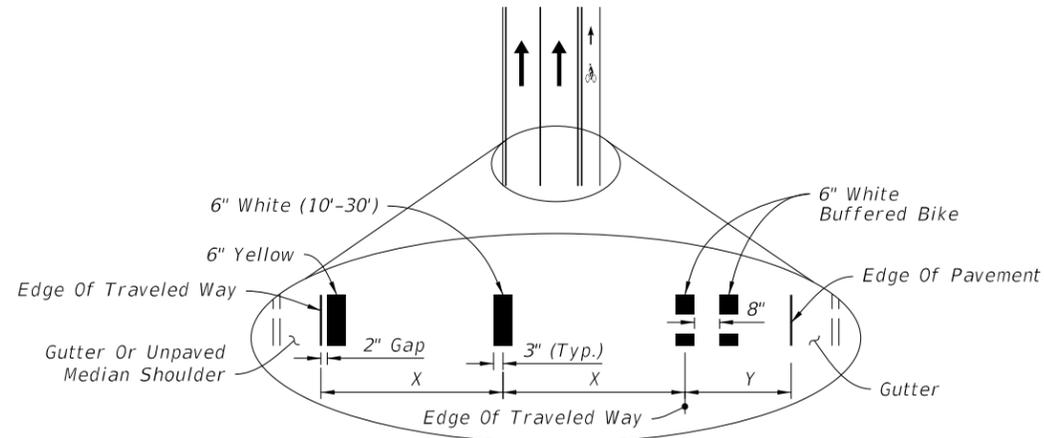


CURB AND GUTTER

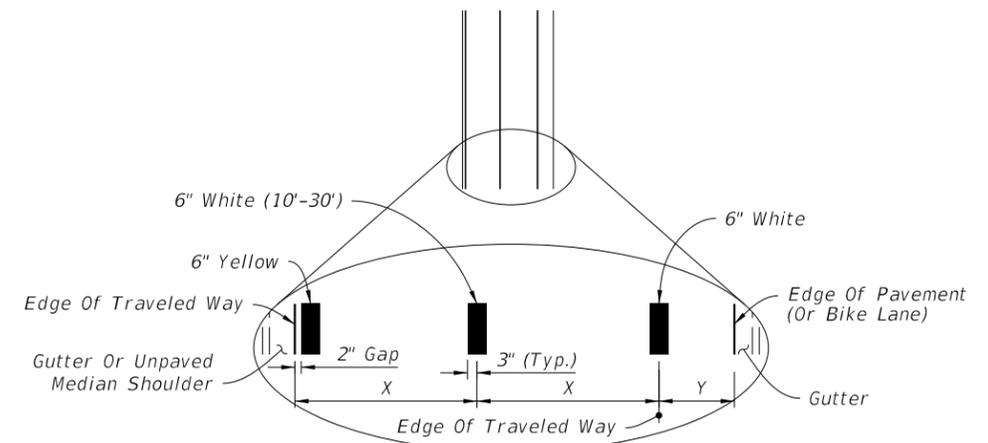

CURB AND GUTTER

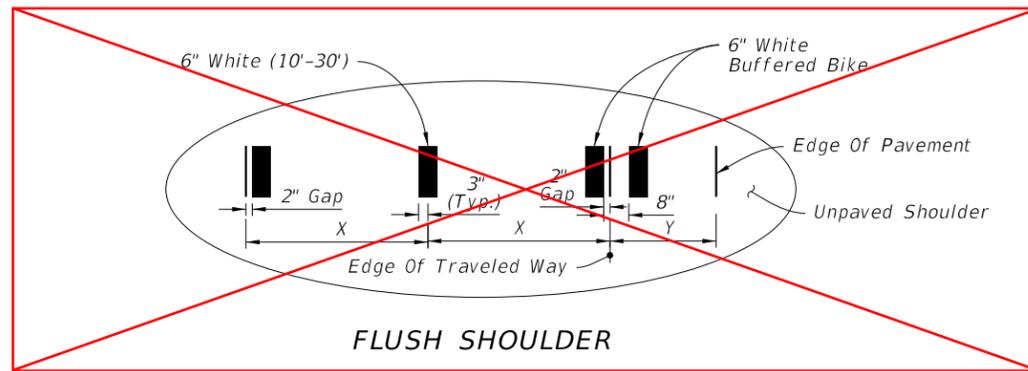

FLUSH SHOULDER

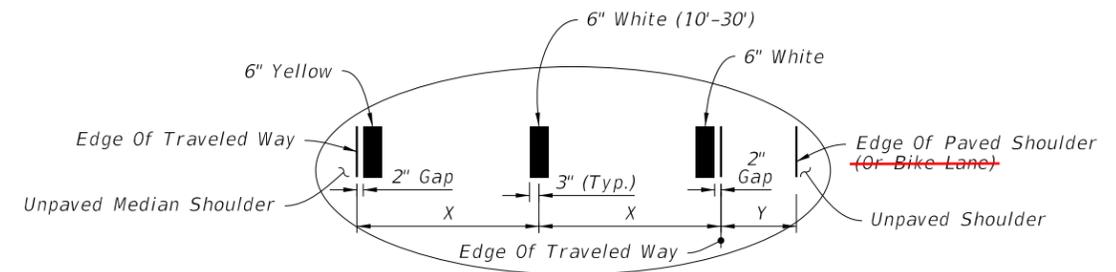

FLUSH SHOULDER

X = LANE WIDTH (FT.)


Y = BUFFERED BIKE LANE WIDTH (FT.)

X = LANE WIDTH (FT.)

Y = PAVED SHOULDER / BIKE LANE

STRIPING FOR BUFFERED BIKE LANE

STRIPING WITH SHOULDER OR NON-BUFFERED BIKE LANE

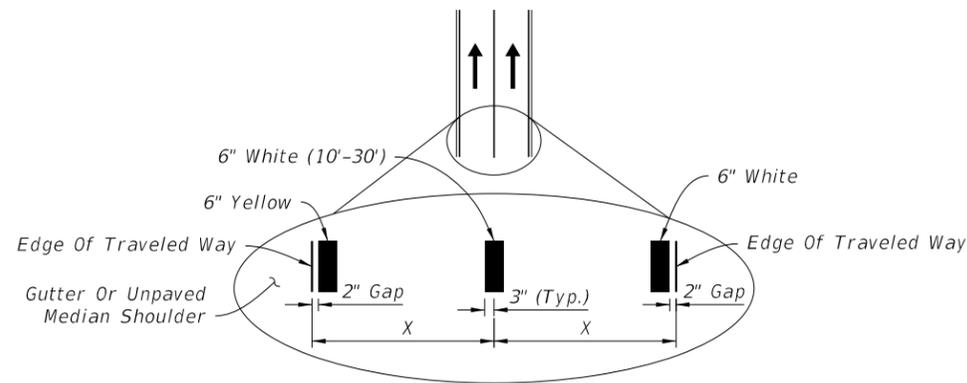

X = LANE WIDTH (FT.)

STRIPING WITH NO SHOULDER OR BIKE LANE

NOTES:

1. Lane widths (X) may not be same for each lane in the section.
2. For placement of RPMs, see Index 706-001.


10/17/2023 7:24:43 AM

LAST REVISION 11/01/21 11/01/24	REVISION	DESCRIPTION:
---------------------------------------	----------	--------------

2025-26
FY ~~2024-25~~
STANDARD PLANS

PLACEMENT OF LONGITUDINAL PAVEMENT MARKINGS
PAVEMENT MARKINGS


INDEX 711-001	SHEET 3 of 13
------------------	------------------

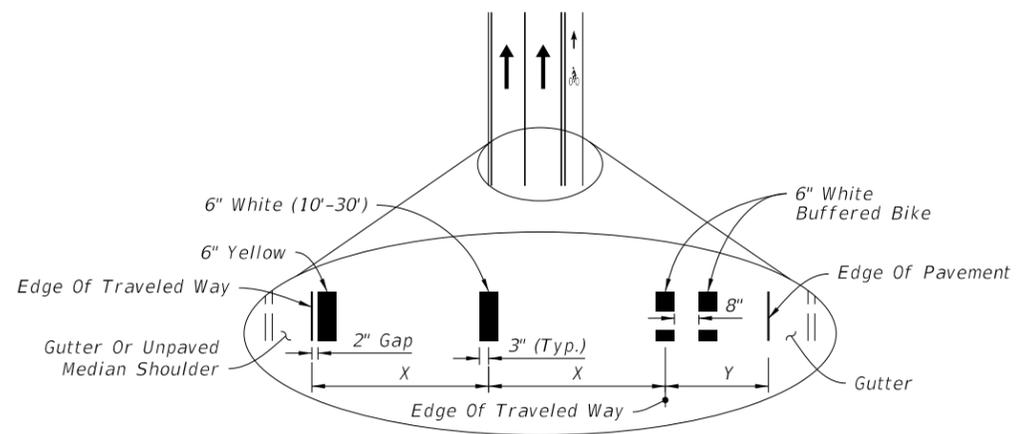


CURB AND GUTTER

X = LANE WIDTH (FT.)
 Y = BUFFERED BIKE LANE WIDTH (FT.)

=====**STRIPING FOR BUFFERED BIKE LANE**=====

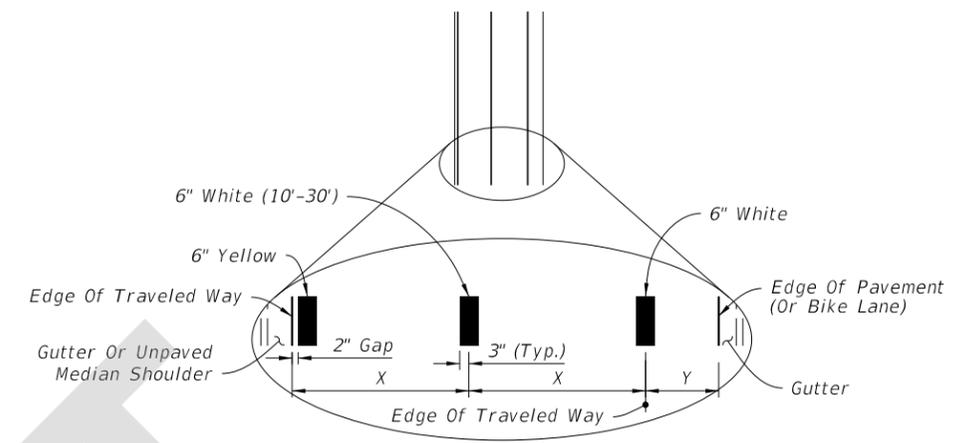


CURB AND GUTTER

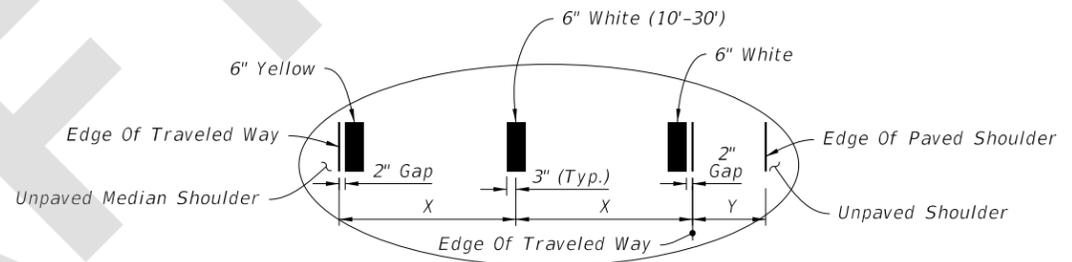

FLUSH SHOULDER

X = LANE WIDTH (FT.)
 Y = PAVED SHOULDER

=====**STRIPING WITH SHOULDER OR NON-BUFFERED BIKE LANE**=====

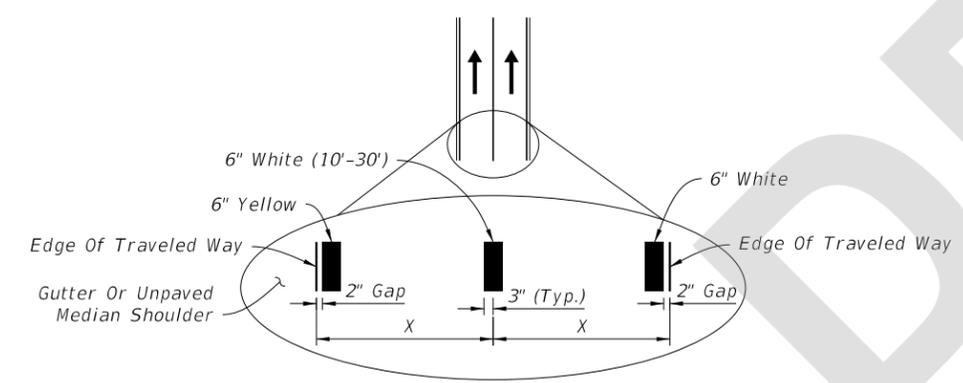

X = LANE WIDTH (FT.)

=====**STRIPING WITH NO SHOULDER OR BIKE LANE**=====

NOTES:

1. Lane widths (X) may not be same for each lane in the section.
2. For placement of RPMs, see Index 706-001.

7/9/2024 8:13:12 AM

PLACEMENT OF LONGITUDINAL PAVEMENT MARKINGS

LAST REVISION 11/01/24	REVISION	DESCRIPTION:		FY 2025-26 STANDARD PLANS	PAVEMENT MARKINGS	INDEX 711-001	SHEET 3 of 13
---------------------------	----------	--------------	---	-------------------------------------	--------------------------	-------------------------	-------------------------