

Origination Form

Proposed Revisions to a Standard Plans Index

Originator:	Turley, Joshua	Index Number:	715-010
Date:	5/17/2024	Sheet Number(s):	3
E-mail:	Joshua.Turley@dot.state.fl.us	Index Title:	HIGH MAST LIGHTING

Summary of the changes:

Sheet 3: SECTION A-A - Corrected weld detailing; HANDHOLE RING DETAIL - Removed superfluous CJP symbol. SECTION C-C - Removed weld hatching and updated weld symbol. Corrected order of anchor bolt nut labels. Corrected which nut may be half height and added thread extension min. SECTION D-D - Update wall thickness dimension and weld symbol.





Commentary/Background:

These changes fix weld detailing errors and add clarity and brevity. There is an associated Spec change being drafted for Section 649 that pertains to process for tightening the anchor bolts. These changes make it so that the language aligns between the Spec and the Standard

Other Affected Documents/Offices	Person Contacted	Affected (Yes/No)
Other Standard Plans		No
FDOT Design Manual		No
Standard Specifications		No
Basis of Estimates Manual		No
Approved Product List		No
Construction Office		No
Maintenance Office		No





Implementation

["FY-Standard Plans (Next Release)"]

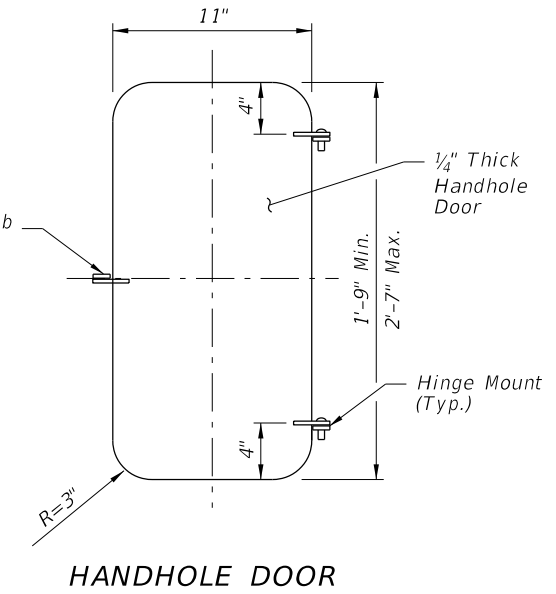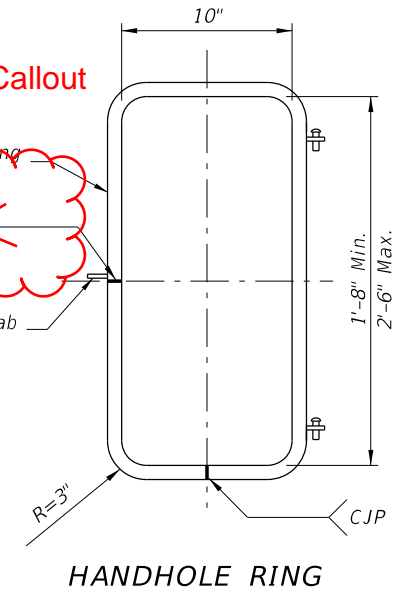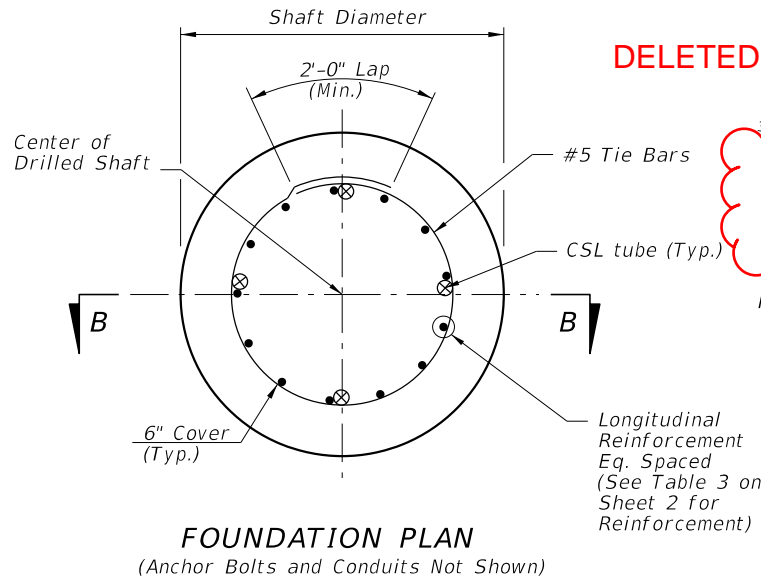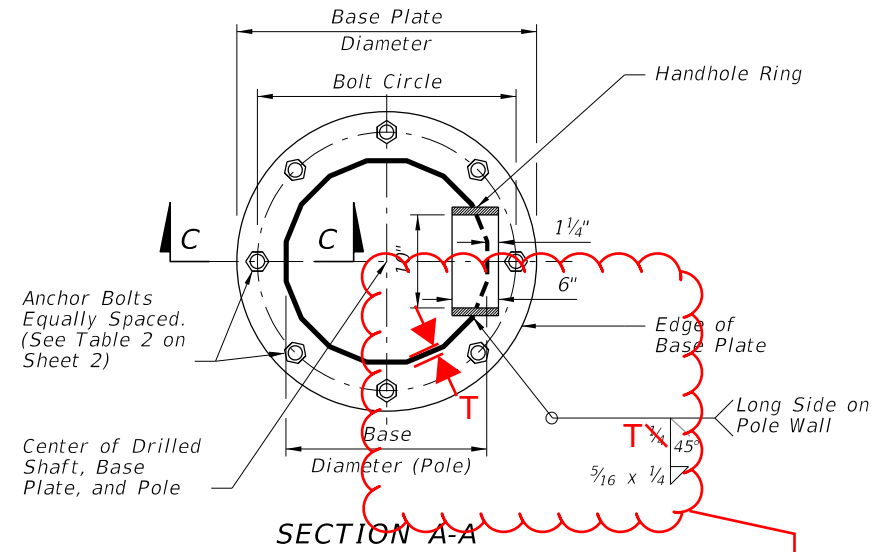

ADDED Dimension
UPDATED Weld Marking

UPDATED Weld Marking
UPDATED: Retainer Nut

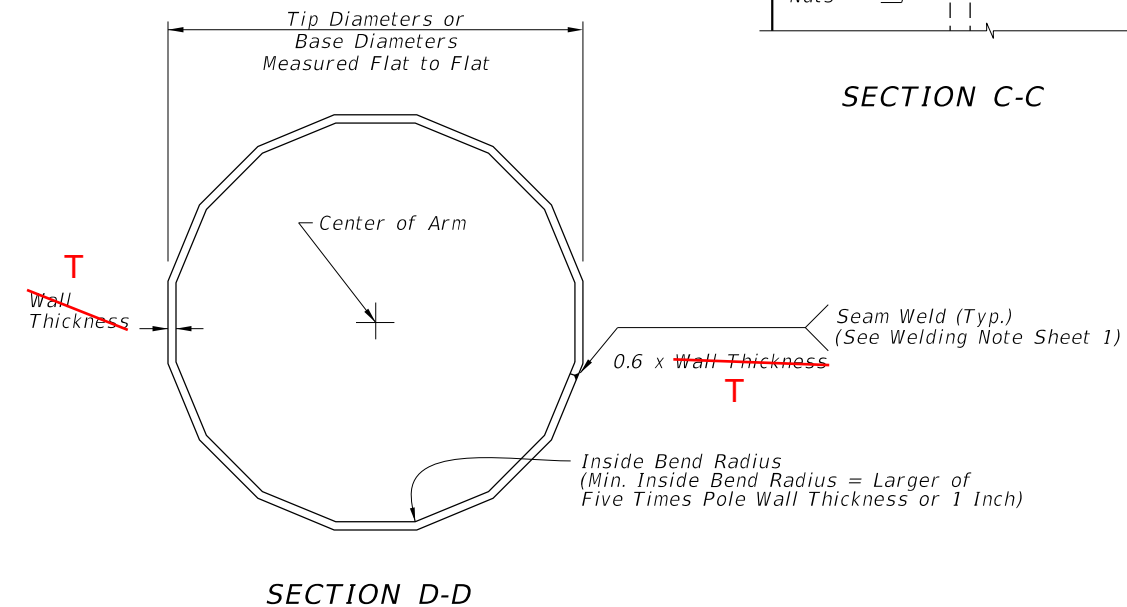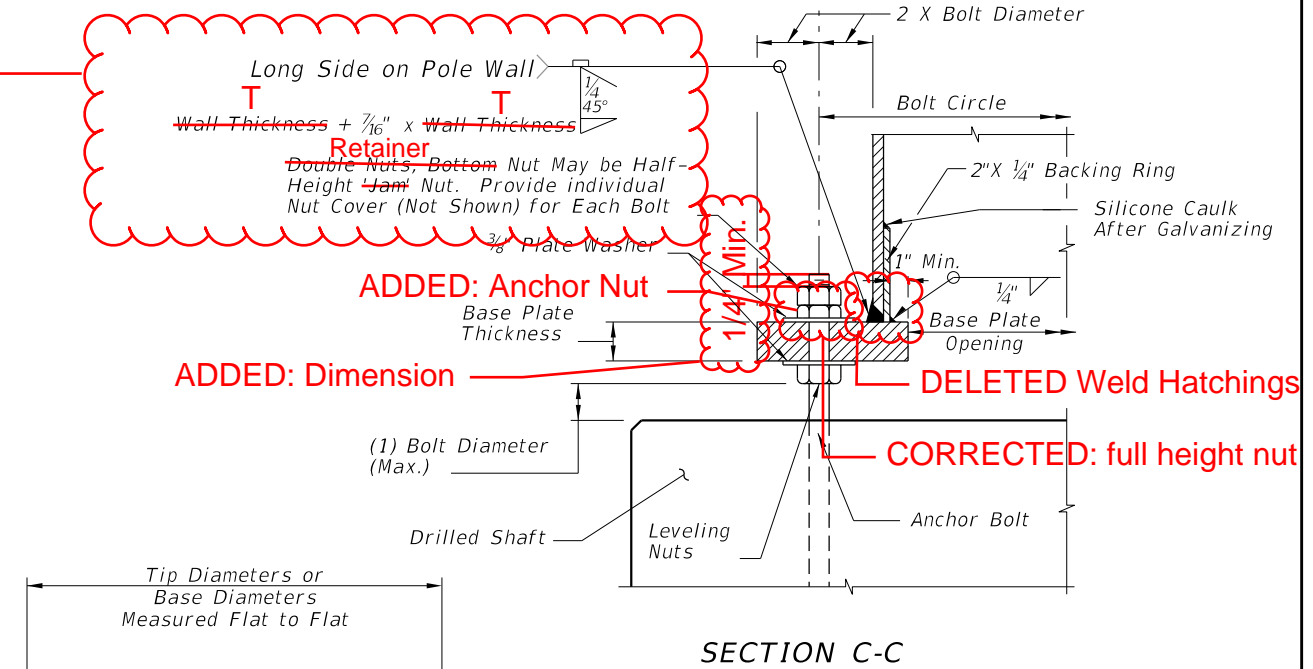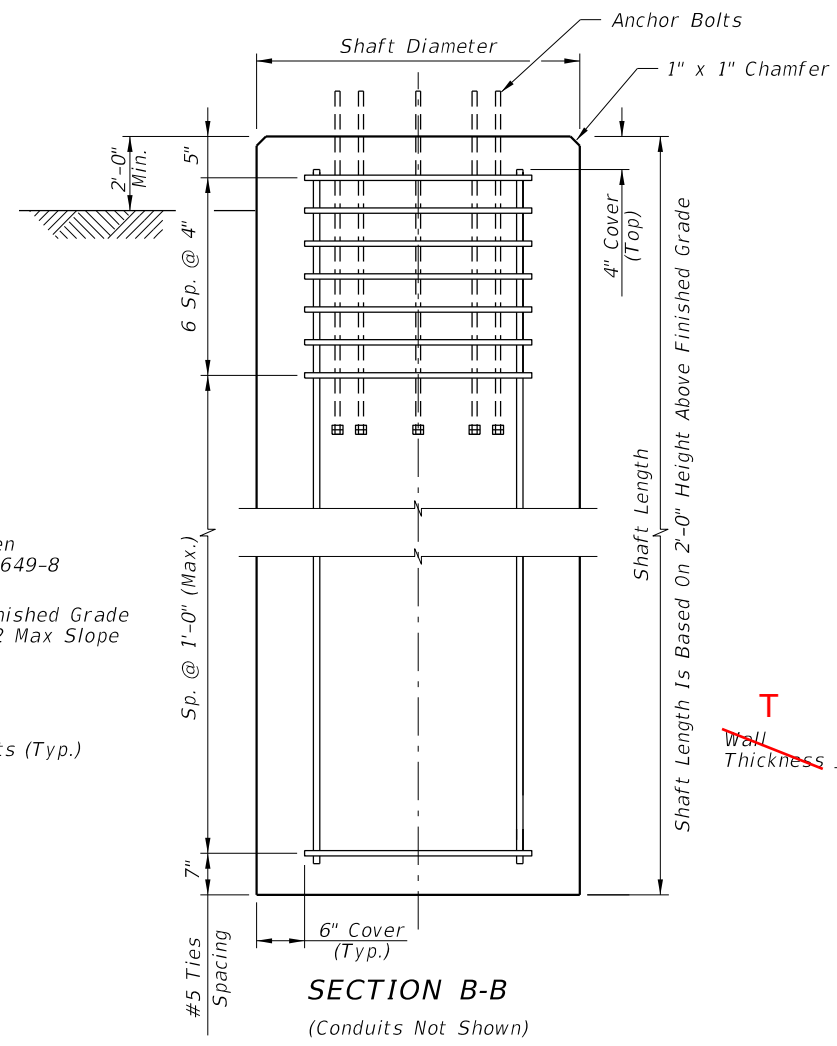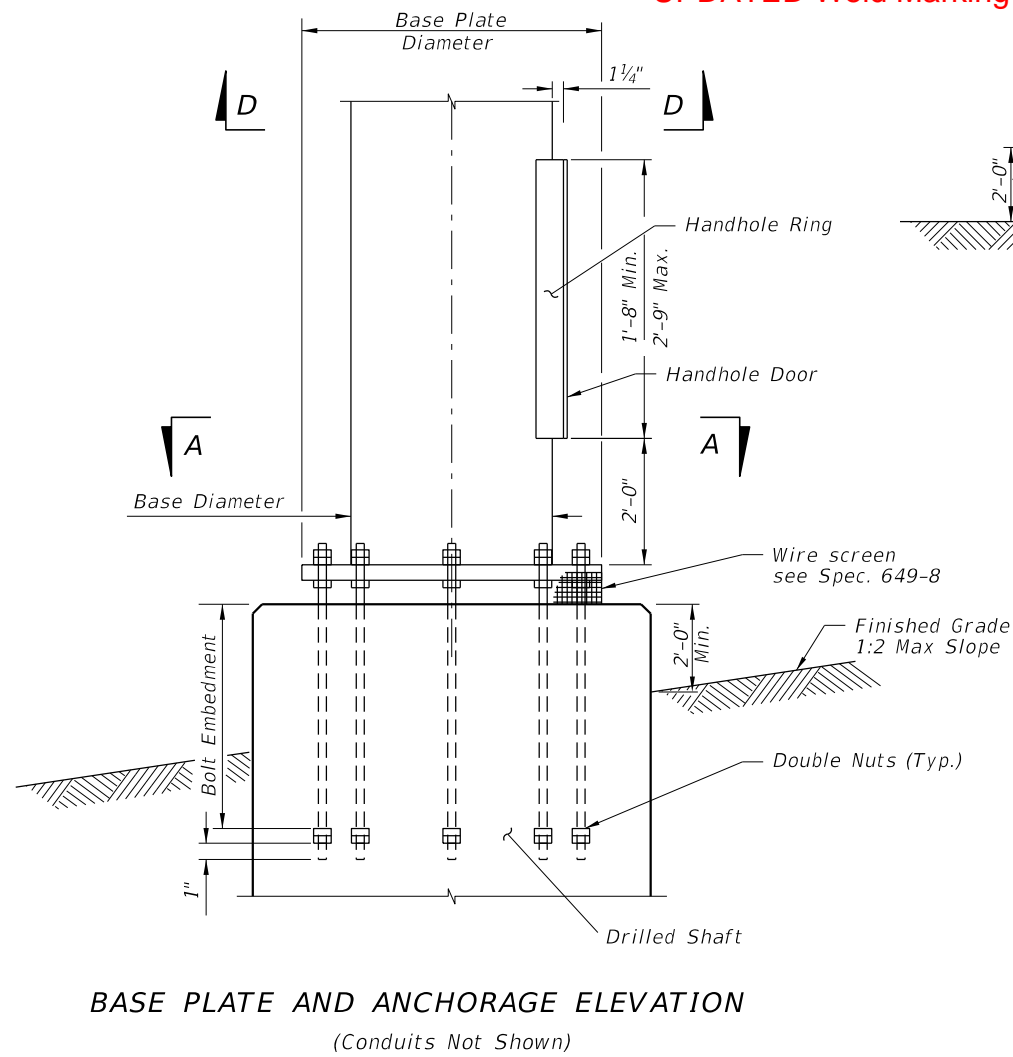

10/4/2023 7:05:01 AM

LAST REVISION 11/01/23	DESCRIPTION:
---------------------------	--------------











2025-26
FY 2024-25
STANDARD PLANS

HIGH MAST LIGHTING

POLE FOUNDATION

INDEX 715-010	SHEET 3 of 6
------------------	-----------------

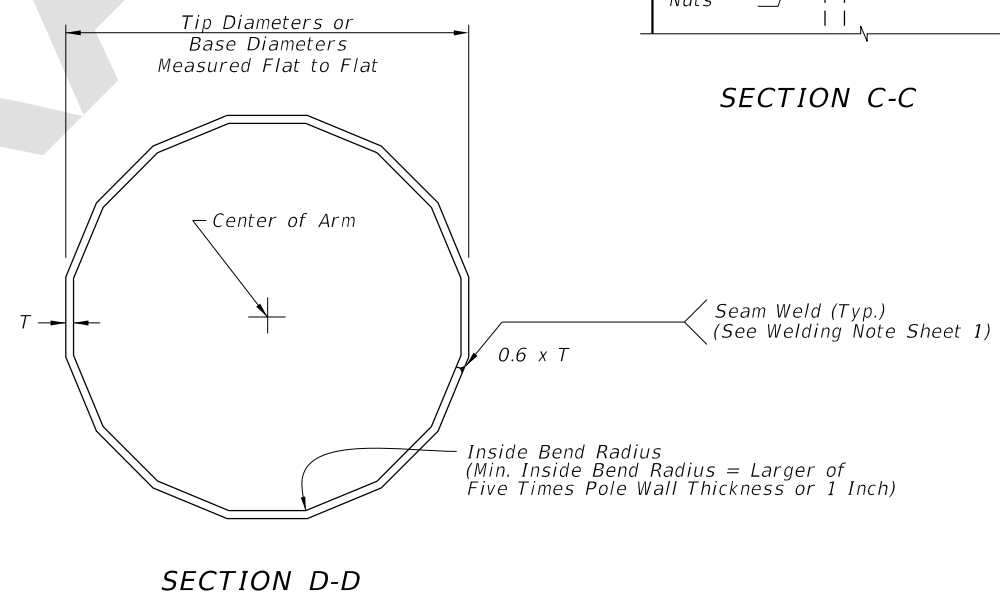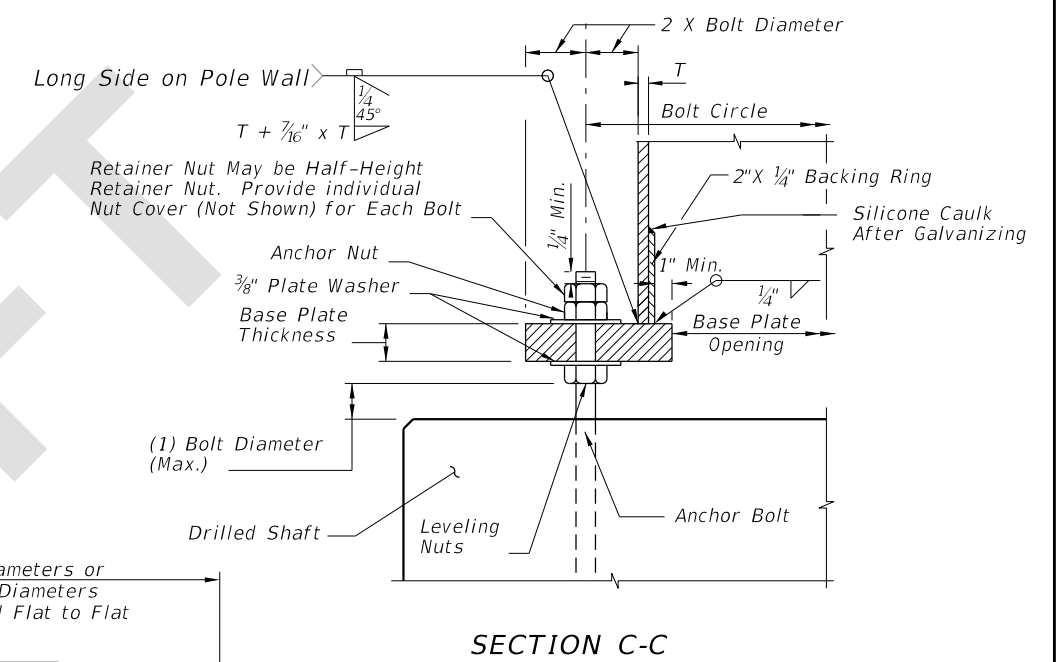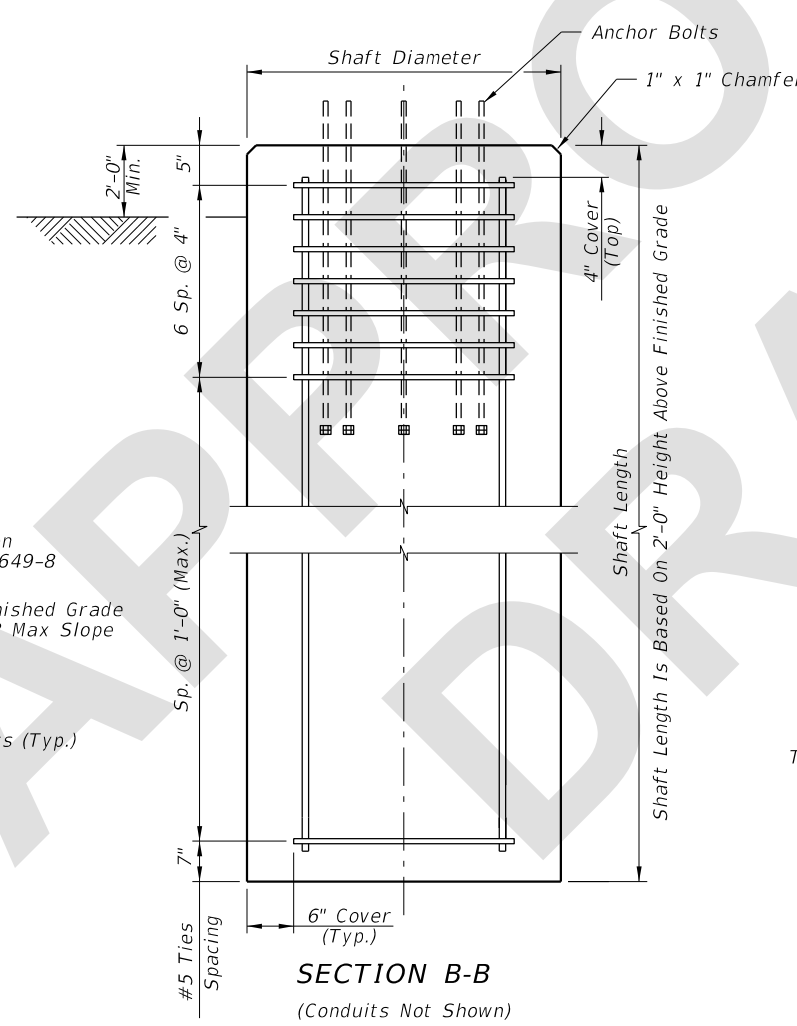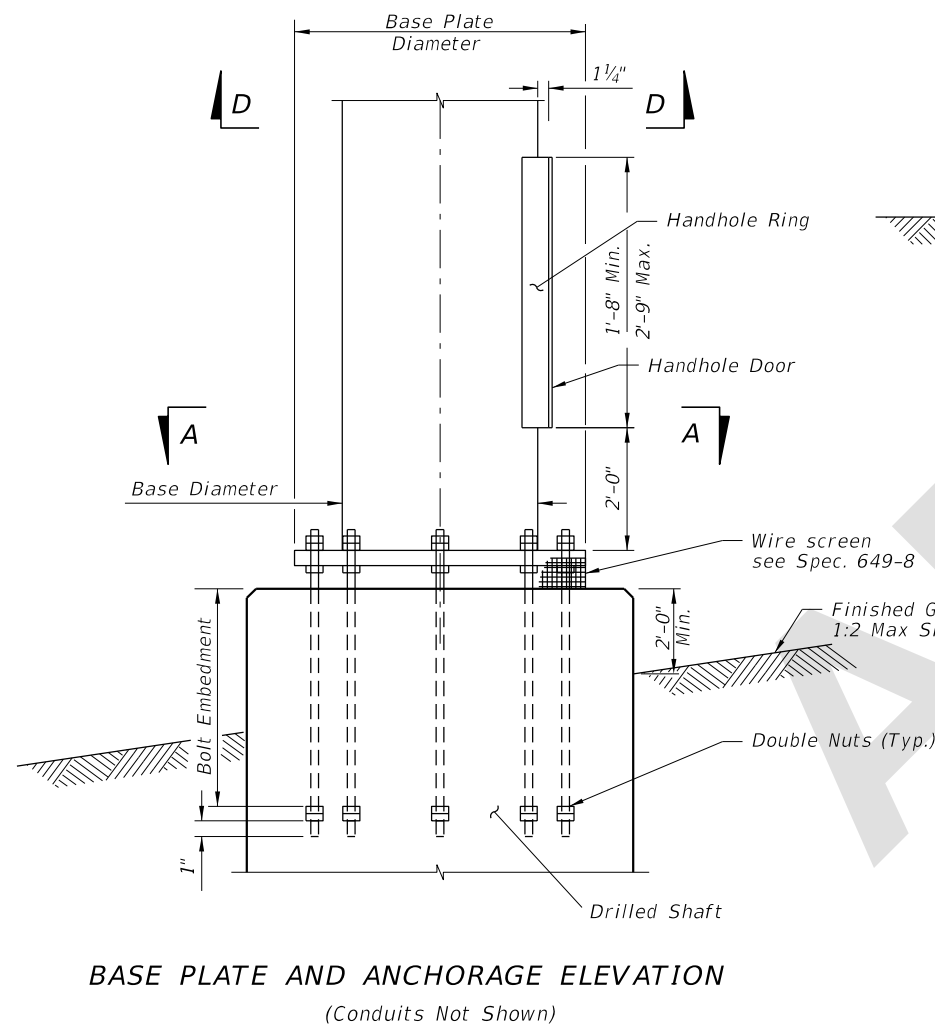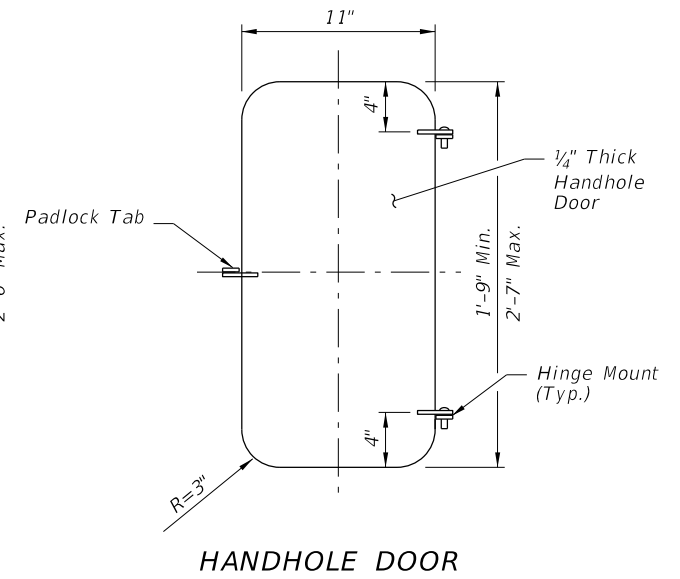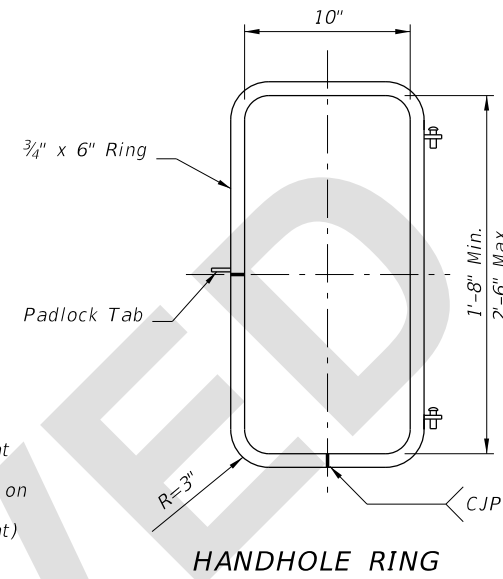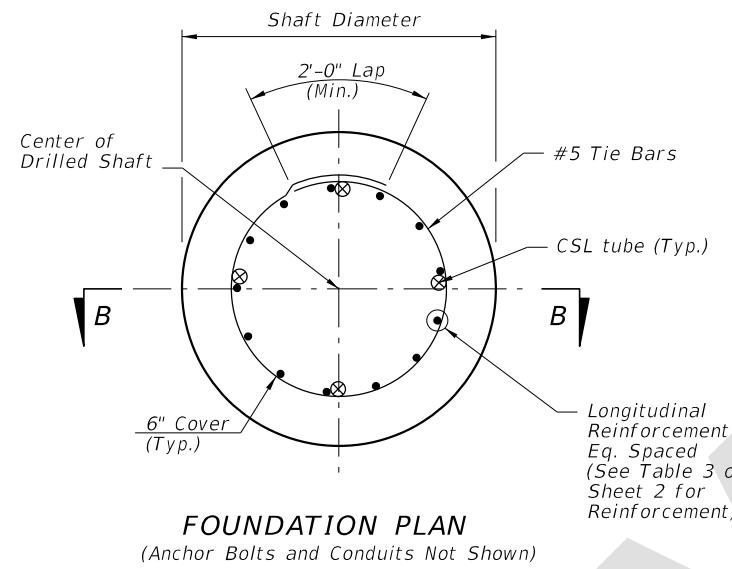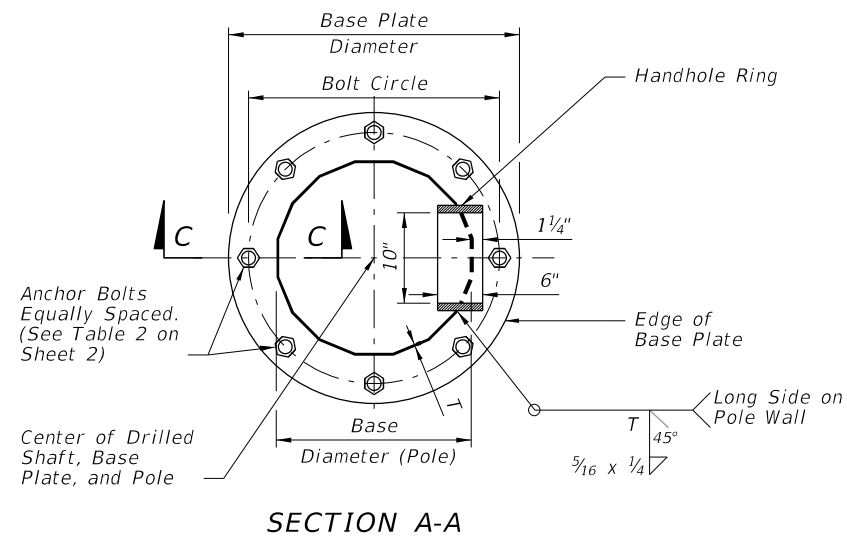

9:04:12 AM
7/12/2024

POLE FOUNDATION

LAST REVISION 11/01/24	DESCRIPTION:
---------------------------	--------------


**FY 2025-26
STANDARD PLANS**

HIGH MAST LIGHTING

INDEX 715-010	SHEET 3 of 6
------------------	-----------------