

Origination Form
Proposed Revisions to a Standard Plans Index

Originator:	Stepp, Richard	Index Number:	102-110
Date:	10/18/2024	Sheet Number(s):	1,4, 7-10
E-mail:	richard.stepp@dot.state.fl.us	Index Title:	Type K Temporary Concrete Barrier System

Summary of the changes:

Sheet 1: General Notes - Rename "THRIE-BEAM GUARDRAIL SPLICE INSTALLATION NOTES" to "CONNECTION TO PERMANENT RIGID BARRIER NOTES". Added a new Note 1 to reference sheet numbers with splice connections and define barrier nomenclature. Incremented previous note numbers to account for the new Note 1.

Sheet 4: Deleted "Fabric" from "Geotextile Fabric" callout on Typical Section details

Sheets 7-10: Revised detail labels to simplify and include "Single-Slope" Traffic Railings and Concrete Barriers where applicable.

Commentary/Background:

To accommodate newer Standard Plans options, "Single-Slope" traffic railing and concrete barrier shapes are being added as permanent barrier connection options throughout Index 102-110.


Also, per a revision request from the State Materials Office, the word "fabric" is being removed from "geotextile" callouts.

Other Affected Documents/Offices	Person Contacted	Affected (Yes/No)
Other Standard Plans		No
FDOT Design Manual		No
Standard Specifications		No
Basis of Estimates Manual		No
Approved Product List		No
Construction Office		No
Maintenance Office		No

Implementation

GENERAL NOTES:

1. Meet the requirements of Index 102-100.
2. For fabrication details see Sheets 15 thru 17.
3. **HANDLING:** Do not lift or move the Barrier Units by using Bars 6D that extend from the ends of the units. Approximate weight of one unit equals 2.7 tons.
4. **CONNECTION PIN ASSEMBLY:** Use steel for Connection Pin and Top Plate assemblies in accordance with ASTM A36 or ASTM A709 Grade 36. Nondestructive testing of welds is not required. At the Contractor's option, a 3⁄8" diameter hole may be provided at the bottom of the Connection Pin, as shown, for the installation of a vandal resistance bolt.
5. **CONNECTION PIN INSTALLATION:** Initially set Barrier Units by using a 35⁄8" wooden block between ends of adjacent units. Install Connection Pin between adjacent Barrier Units as shown, then pull newly placed Barrier Unit away from adjacent Barrier Unit to remove slack between Connection Pin and Bars 6D (except as shown on Sheet 2). Do not use Barrier Units unconnected.
6. **REUSE OF CONNECTION PINS AND STAKES:** Connection pins and stakes may be reused if they have the structural integrity of new pins.
7. **REMOVAL OF BOLTS, STAKES AND KEEPER PINS:** Upon removal or relocation of Barrier Units, remove all Anchor Bolts and completely fill the remaining holes in bridge decks, approach slabs and roadway rigid pavements that are to remain with Magnesium Ammonium Phosphate Concrete in accordance with Specification 930 or with an Epoxy Resin Compound, Type F or Q, in accordance with Specification 926. If a flexible pavement is present and is to remain, completely fill the remaining holes in the flexible pavement with hot or cold patch asphalt material.
8. **TYPE K ANCHORED TO FREE-STANDING TRANSITIONS:** Use the 3-3-2-1 Anchorage Transition Detail when transitioning Free-Standing and Anchored Units or when connecting Free-Standing runs to Crash Cushions, as shown in this Index.

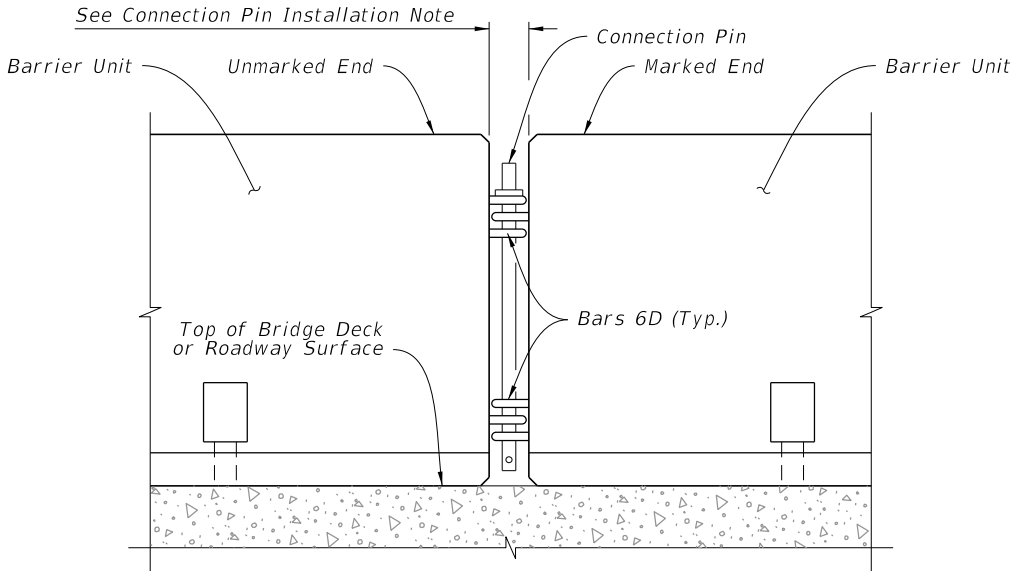


DETAIL OF CONNECTION BETWEEN BARRIER UNITS

CONNECTION TO PERMANENT RIGID BARRIER NOTES:
~~THRIE-BEAM GUARDRAIL SPLICE INSTALLATION NOTES:~~



1. For splice connection details between Type K Temporary Concrete Barriers and Permanent Traffic Railings, see Sheets 7 thru 10. Within this Index, the term Traffic Railing also applies to Concrete Barrier, where both terms refer to permanent installations shown in the Index 521 series.

2. **THRIE-BEAM GUARDRAIL:** Provide Thrie-Beam Guardrail for splices meeting the requirements of Specification 967 and as follows: Two panels per splice (One panel per side) of Class B (10 Gauge), or Four panels per splice (Two nested panels per side) of Class A (12 Gauge). Use a 12'-6" guardrail panel. Provide and install all other associated metallic guardrail components (Terminal Connectors, Shoulder Bolts, Hex Bolts and Nuts, Filler Plates, etc.) in accordance with Index 536-001. Install five Guardrail Anchor Bolts at each end of each splice in any of the standard seven anchor bolt holes in the Thrie-Beam Terminal Connector. If reinforcing steel is encountered when drilling holes for Guardrail Anchor Bolts in Type K Barrier Units, shift Thrie-Beam Terminal Connector so as to clear reinforcing steel within the given tolerances or select a different bolt hole to use. Do not drill or cut through reinforcing steel within Type K Barrier Units. Drilling or cutting through reinforcing steel within permanent concrete traffic railings is permitted.
3. **GUARDRAIL OFFSET BLOCKS:** Provide and install timber Offset Blocks meeting the requirements of Specification 967. Field trim Offset Blocks as required for proper fit. Utilize Offset Blocks as shown and required in order to prevent bending or kinking of Thrie-Beam Guardrail panels.
4. **CONCRETE FOR FILLING TAPERED TRAFFIC RAILING TOES:** Provide concrete for filling tapered toes of Traffic Railings as shown meeting the material requirements of Specification 346, any Class, or a commercially available pre-bagged concrete mix (3000 psi minimum compressive strength). Sampling, testing, evaluation and certification of the concrete in accordance with Specification 346 is not required. Saturate with water the surfaces upon and against which the concrete fill will be placed prior to placing concrete. Place and finish concrete fill using forms or by hand methods to the general configurations shown so as to provide a smooth shape transition between the Type K Barrier and the adjacent traffic railing. A low slump is desirable if placing and finishing concrete by hand methods. Cure the concrete fill by application of a curing compound, or by covering with a wet tarp or burlap for a minimum of 24 hours. Completely remove the concrete fill upon relocation or removal of the Type K Temporary Concrete Barrier.

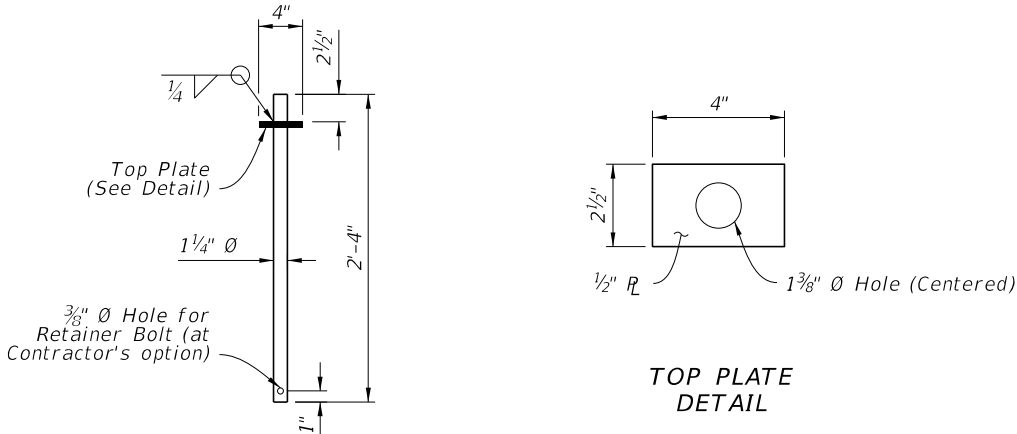

CONNECTION PIN DETAIL

SYMBOL:

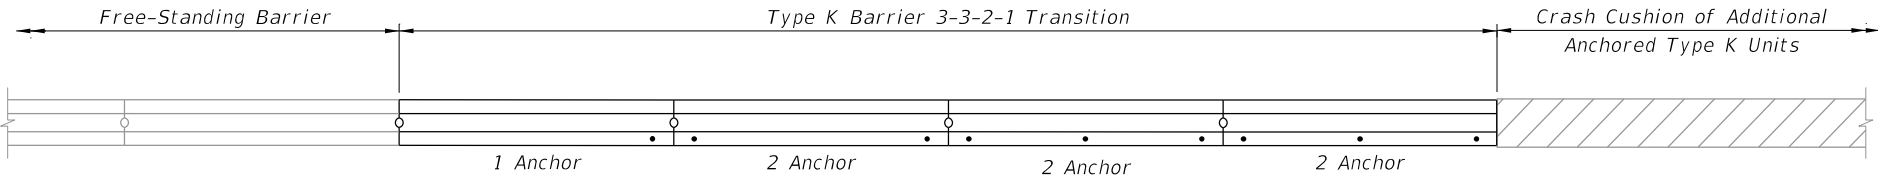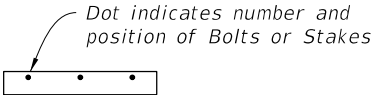

3-3-2-1 ANCHORAGE TRANSITION DETAIL



FY ~~2025-26~~ 2026-27
STANDARD PLANS

TYPE K TEMPORARY CONCRETE BARRIER SYSTEM


INDEX
102-110

SHEET
1 of 17

LAST
REVISION
11/01/25

DESCRIPTION:


10/30/2024 2:44:48 PM

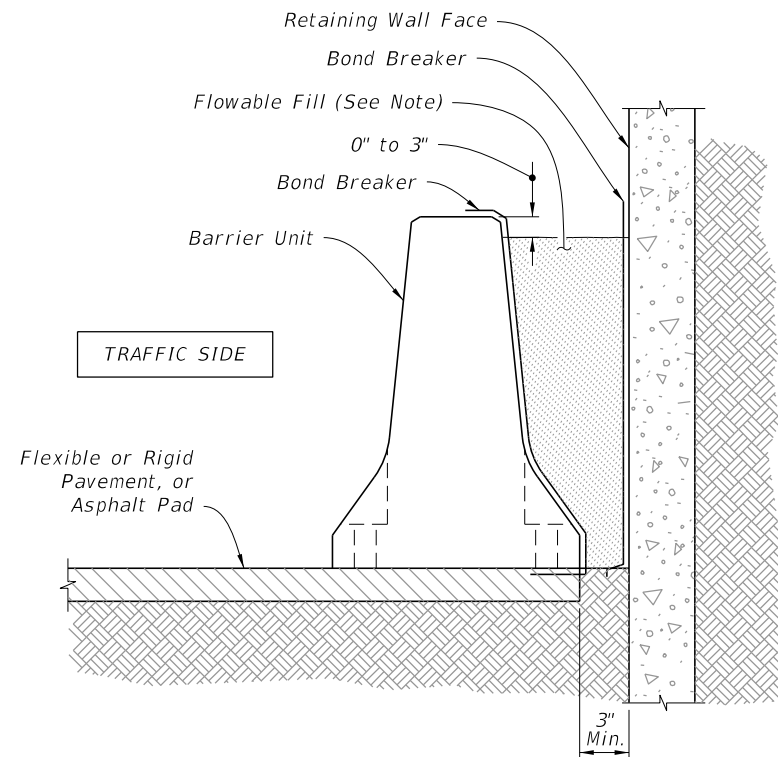


NOTE:
Provide Excavatable Flowable Fill in accordance with Specification 121.

TYPICAL SECTION
ADJACENT TO RETAINING WALL WITH FLOWABLE FILL BACK-FILL

FLOWABLE FILL BACK-FILL ROADSIDE INSTALLATIONS

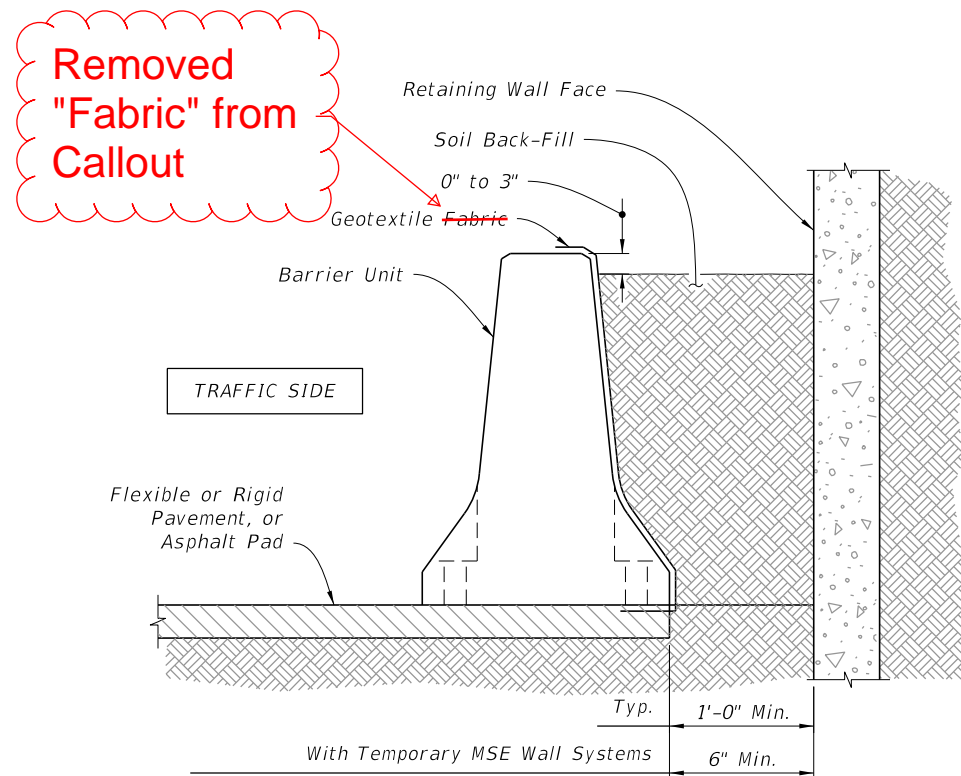

TYPICAL SECTION
ADJACENT TO RETAINING WALL WITH SOIL BACK-FILL

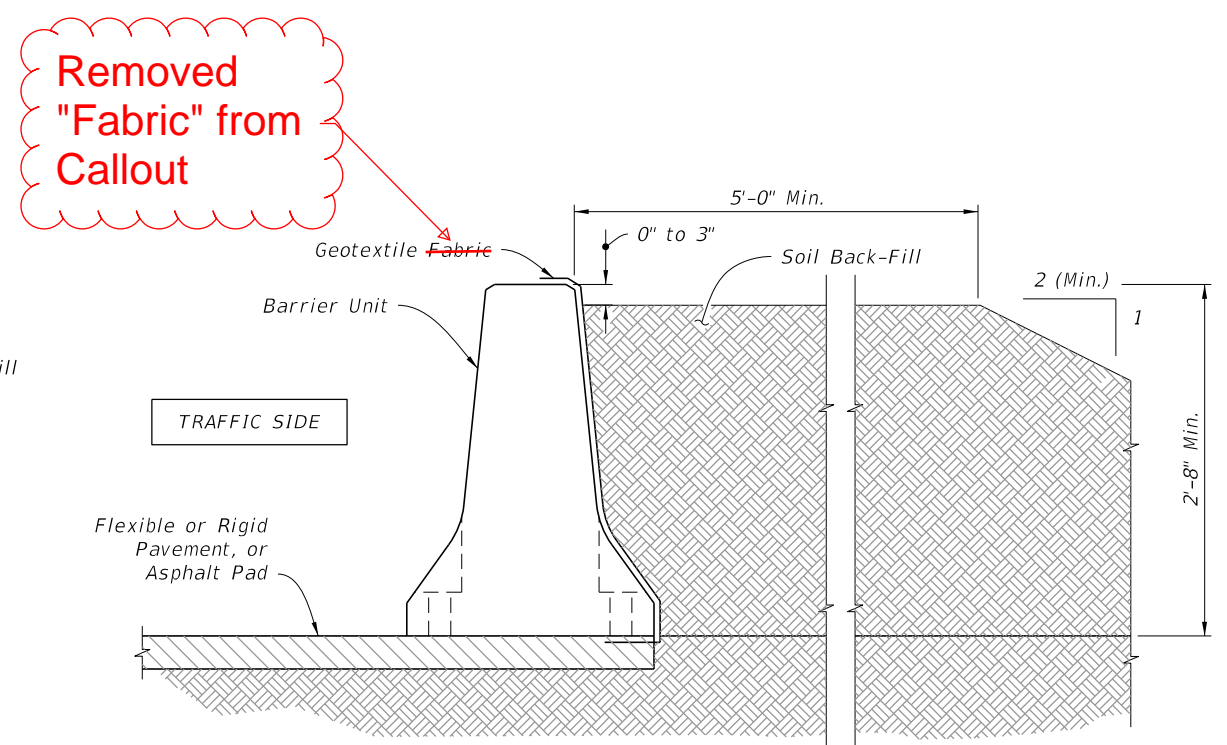

TYPICAL SECTION
WITH SOIL BACK-FILL


NOTES:
SOIL BACK-FILL MATERIAL: Provide Back-Fill Material consisting of any available clean soil. Compact Back-Fill Material until the soil mass is firm and unyielding. Provide erosion control as specified in the Plans. If none is specified in the Plans, provide erosion control as required to maintain the integrity of the Back-Fill embankment.
GEOTEXTILE: Provide and install Type D-5 geotextile in accordance with Specification 514 to contain Back-Fill Material behind the Barrier Units. Geotextile may be continuous over the length and height of the installation or may be individual pieces as required to cover the Lift/DrainSlots and open vertical joints between Barrier Units.

SOIL BACK-FILLED ROADSIDE INSTALLATIONS

10/30/2024 2:45:10 PM


LAST REVISION 11/01/23	DESCRIPTION: 11/01/25	FDOT	FY 2025-26 2026-27 STANDARD PLANS	TYPE K TEMPORARY CONCRETE BARRIER SYSTEM	INDEX 102-110	SHEET 4 of 17
---	--------------------------	------	---	--	------------------	------------------

F-Shape, Single-Slope, ~~32" F~~ or New Jersey Shape Median Traffic Railing

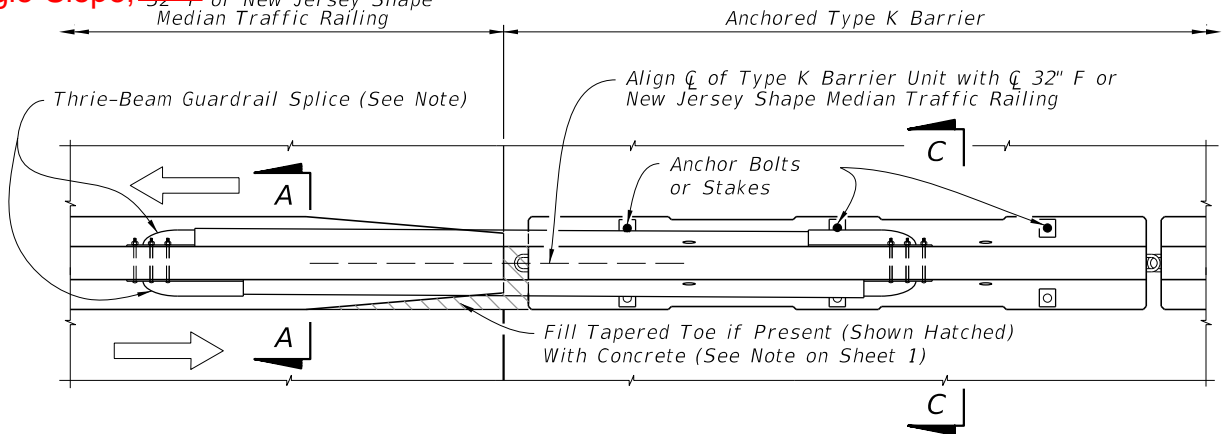


PARTIAL PLAN VIEW AT MEDIAN TRAFFIC RAILING

~~32" Florida Corral Traffic Railing (Shown)~~
~~32" & 42" Vertical Shape Traffic Railings (Similar)~~

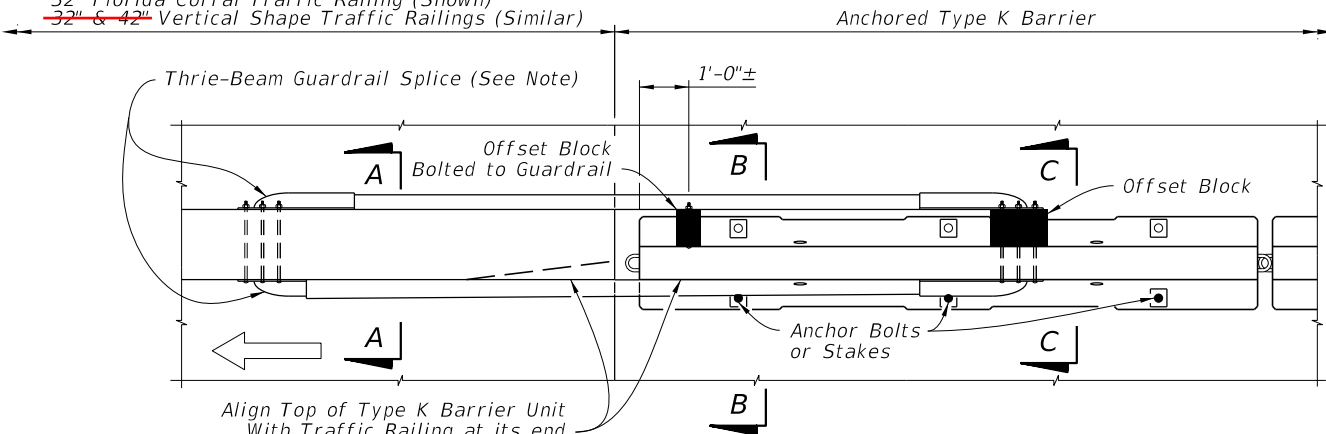


PARTIAL PLAN VIEW

Single-Slope and ~~32" F Shape Traffic Railing (Shown)~~
~~32" New Jersey Shape and 42" F Shape Traffic Railings and 8' or 14' Traffic Railing / Noise Walls (Similar)~~

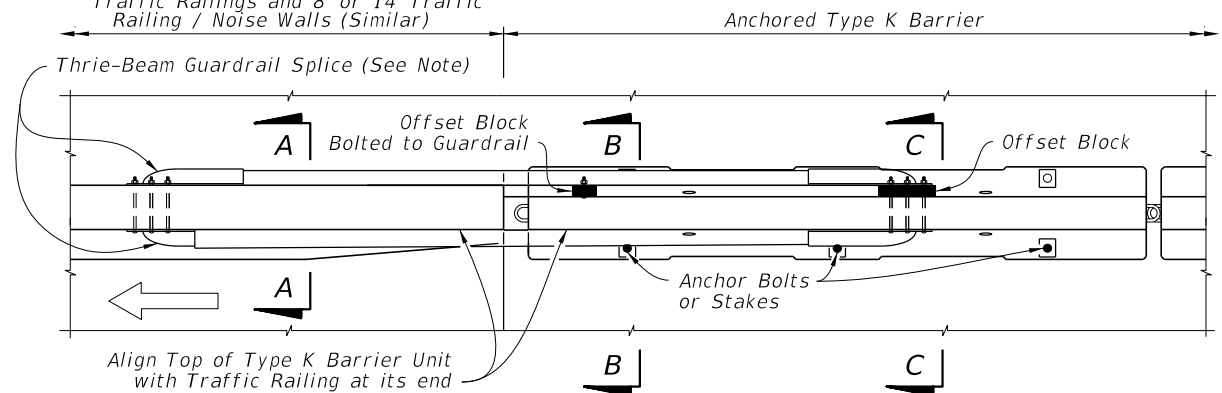


PARTIAL PLAN VIEW AT SHOULDER TRAFFIC RAILING

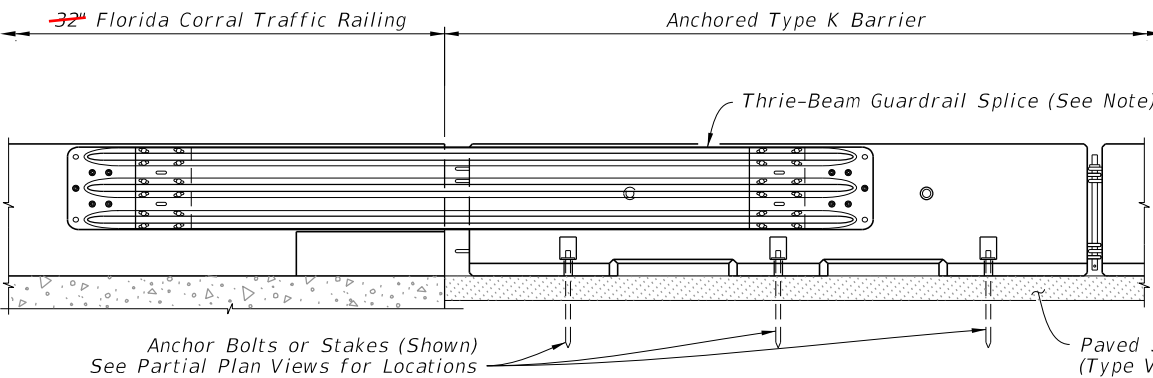


PARTIAL ELEVATION VIEW - FLORIDA CORRAL TRAFFIC RAILING

Single-Slope and ~~32" F Shape Traffic Railing (Shown)~~
~~32" New Jersey Shape and 42" F Shape Traffic Railings and 8' or 14' Traffic Railing / Noise Walls (Similar)~~

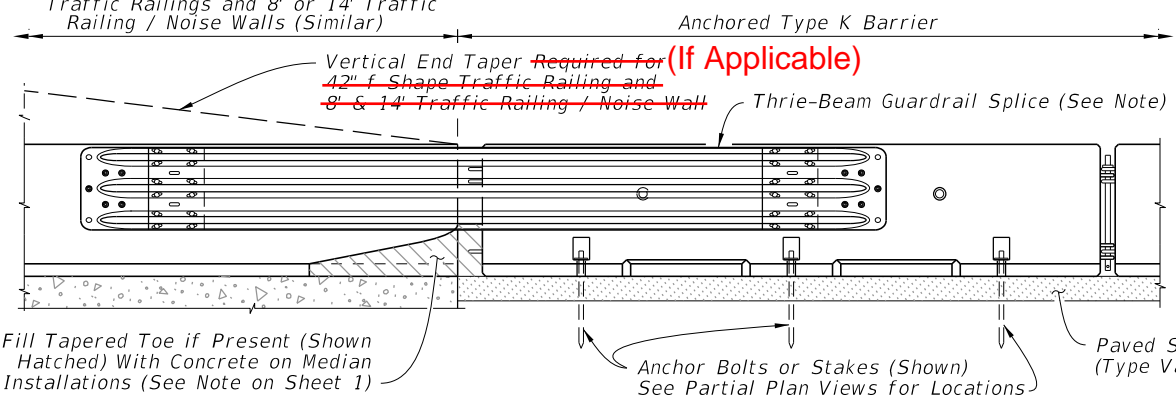

PARTIAL ELEVATION VIEW

~~42" Vertical Shape Traffic Railing (Shown)~~
~~32" Vertical Shape Traffic Railing (Similar)~~

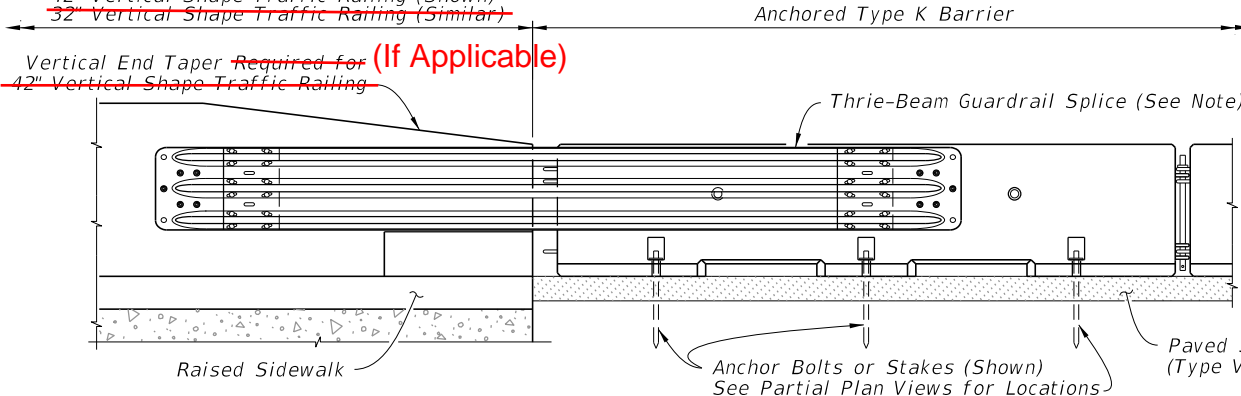

PARTIAL ELEVATION VIEW - VERTICAL SHAPE TRAFFIC RAILINGS

For Single-Slope, F-Shape,

APPROACH TRANSITION SPLICE DETAIL
FOR ~~F~~ AND NEW JERSEY SHAPE TRAFFIC RAILINGS AND 8' & 14'
TRAFFIC RAILING / NOISE WALLS (CONCRETE BARRIER ~~WALL~~ SIMILAR)

SYMBOL:
➡ Direction of Traffic


NOTE:
See Thrie-Beam Guardrail Positioning Detail,
Sheet 10 and Notes for Thrie-Beam Guardrail
Splice Installations, Sheet 1.

CROSS REFERENCES:
See Sheet 10 for Section A-A,
Section B-B and Section C-C.


APPROACH TRANSITION SPLICE DETAIL
FOR FLORIDA CORRAL AND VERTICAL
SHAPE TRAFFIC RAILINGS

10/30/2024 2:45:30 PM


LAST REVISION	DESCRIPTION:	FDOT	FY 2025-26 2026-27	TYPE K TEMPORARY CONCRETE BARRIER SYSTEM	INDEX	SHEET
11/01/17 11/01/25			STANDARD PLANS		102-110	7 of 17

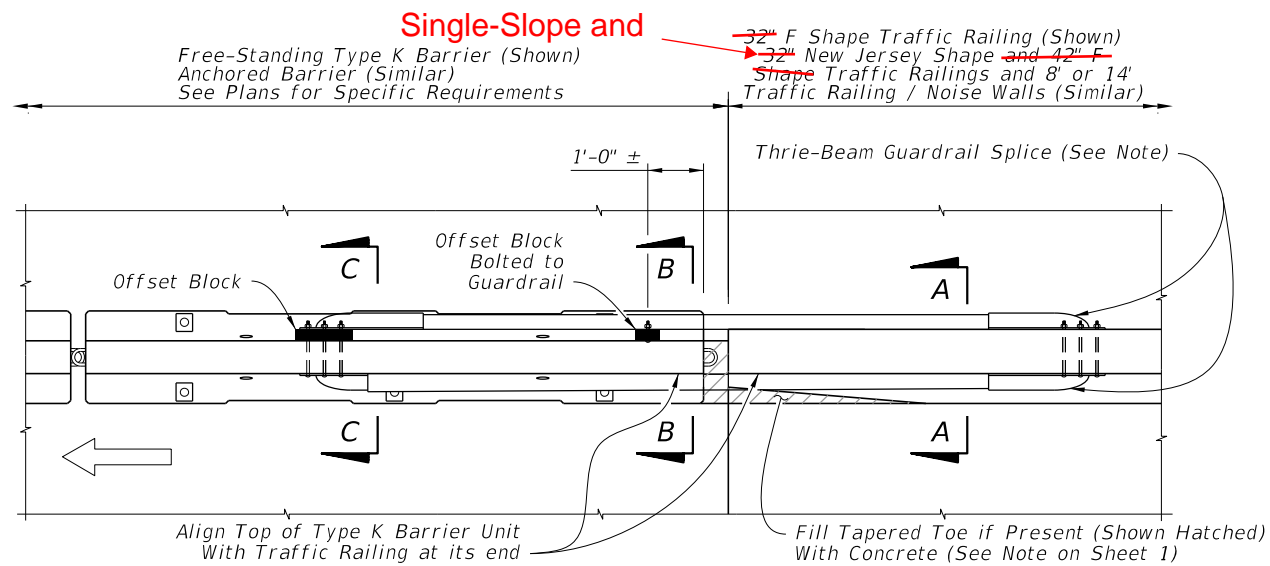


PARTIAL PLAN VIEW

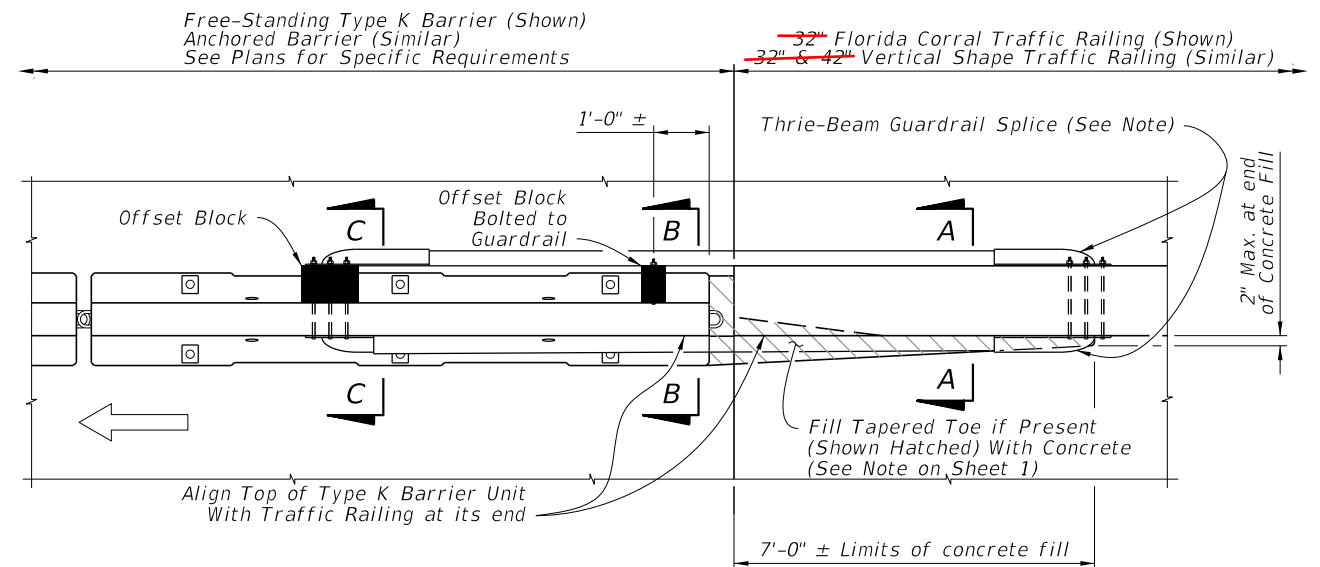

PARTIAL PLAN VIEW

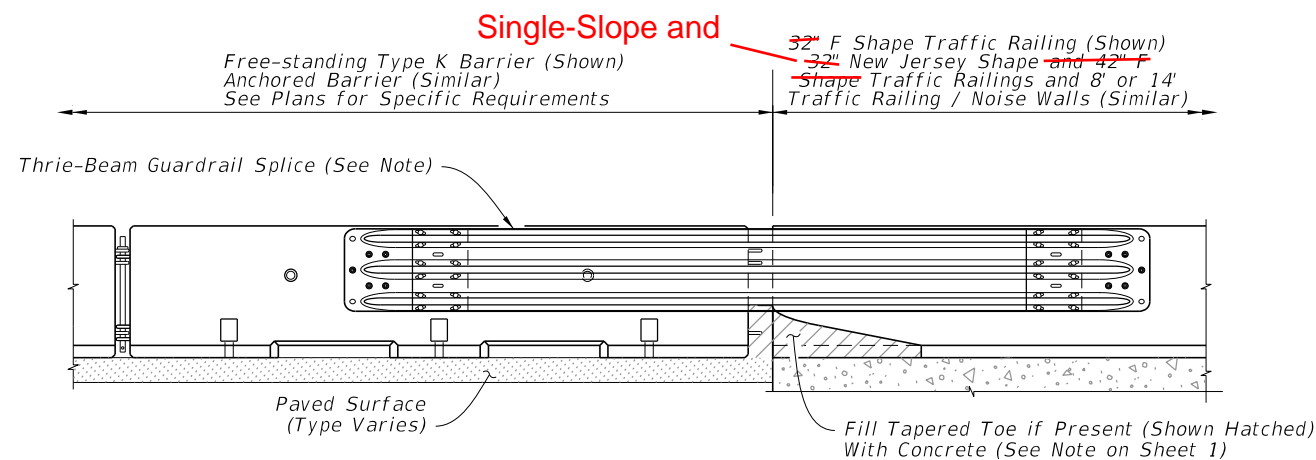

PARTIAL ELEVATION VIEW

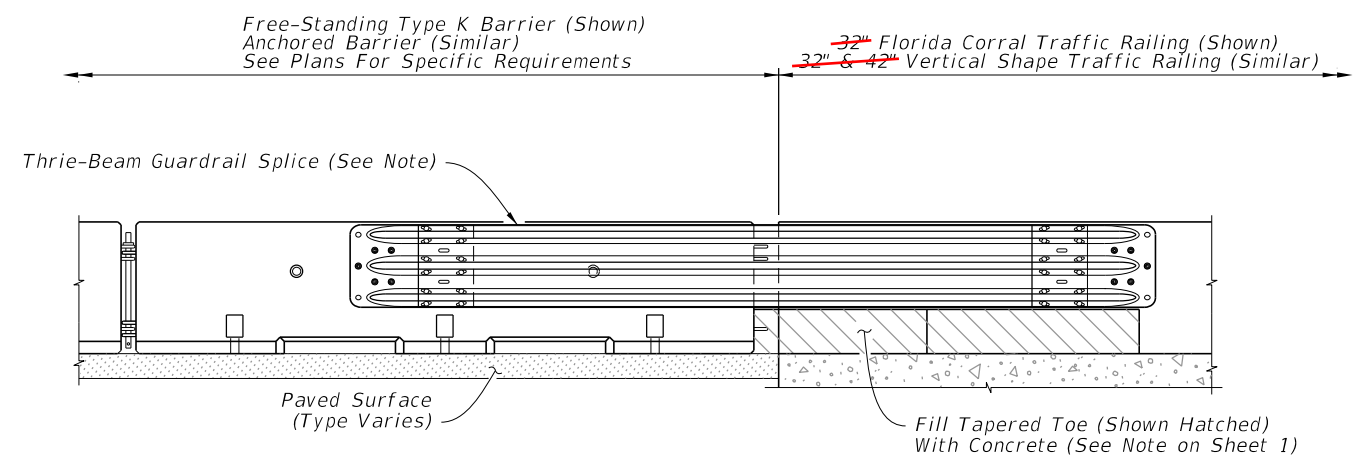

PARTIAL ELEVATION VIEW

For Single-Slope, F-Shape, ~~FOR F AND NEW JERSEY SHAPE TRAFFIC RAILINGS~~ AND 8' & 14' TRAFFIC RAILING / NOISE WALLS (Concrete Barrier Similar)

TRAILING END SPLICE DETAIL FOR FLORIDA CORRAL AND VERTICAL SHAPE TRAFFIC RAILINGS

SYMBOL:

➡ Direction of Traffic

NOTE:


See Thrie-Beam Guardrail Positioning Detail, Sheet 10 and Notes for Thrie-Beam Guardrail Splice Installations, Sheet 1.

CROSS REFERENCES:


See Sheet 10 for Section A-A, Section B-B and Section C-C.

10/30/2024 2:45:37 PM


LAST REVISION	DESCRIPTION:	FDOT	FY 2025-26 2026-27	STANDARD PLANS	TYPE K TEMPORARY CONCRETE BARRIER SYSTEM	INDEX	SHEET
11/01/17 11/01/25						102-110	8 of 17

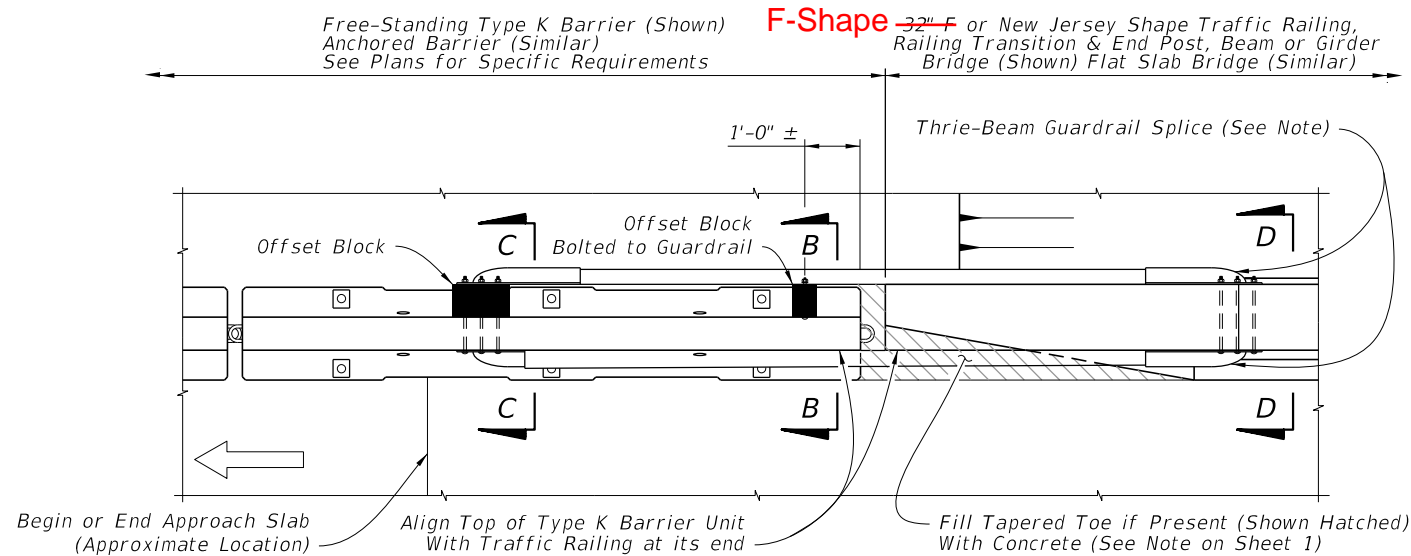

PARTIAL PLAN VIEW

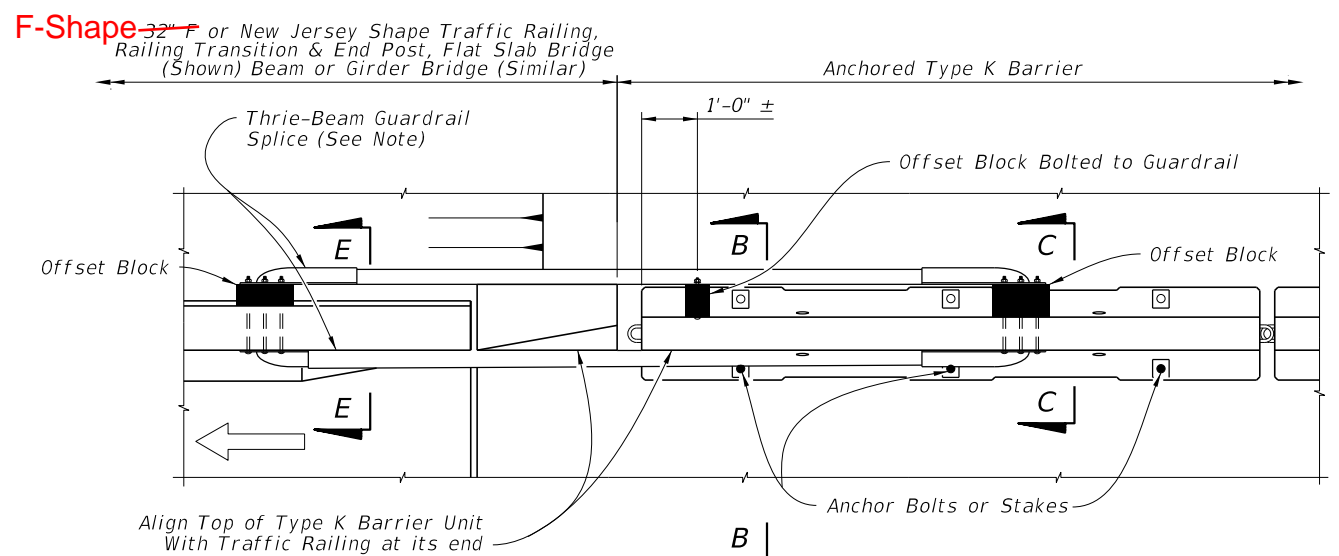


PARTIAL PLAN VIEW

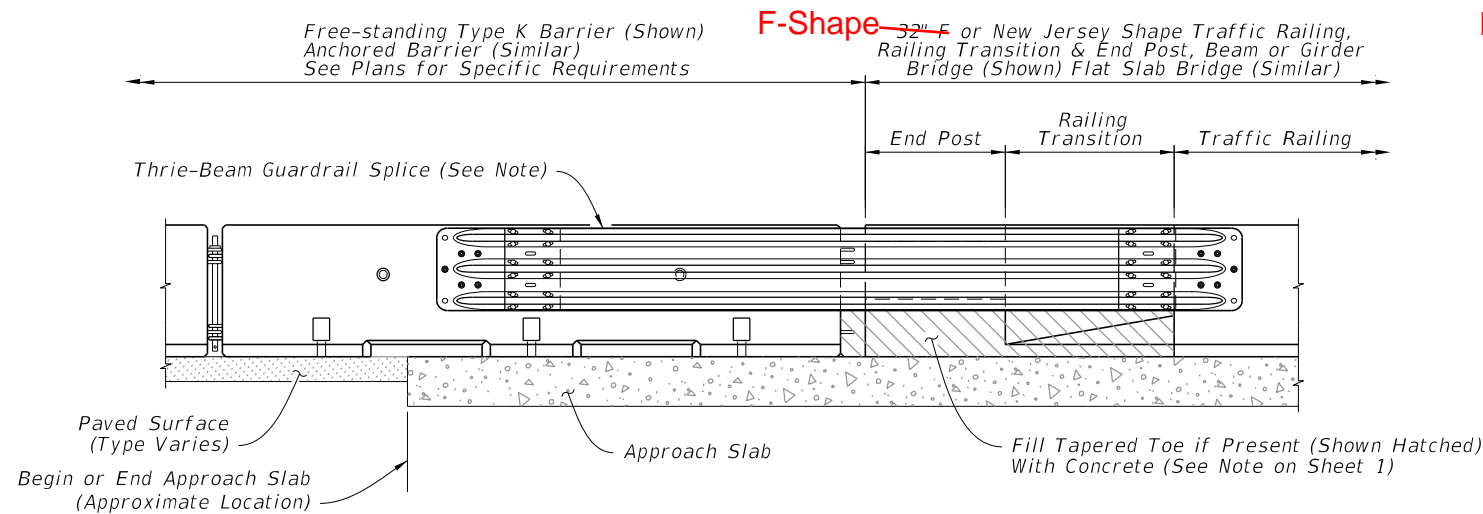

CROSS REFERENCES:
See Sheet 10 for Section B-B,
Section C-C and Section D-D.

PARTIAL ELEVATION VIEW

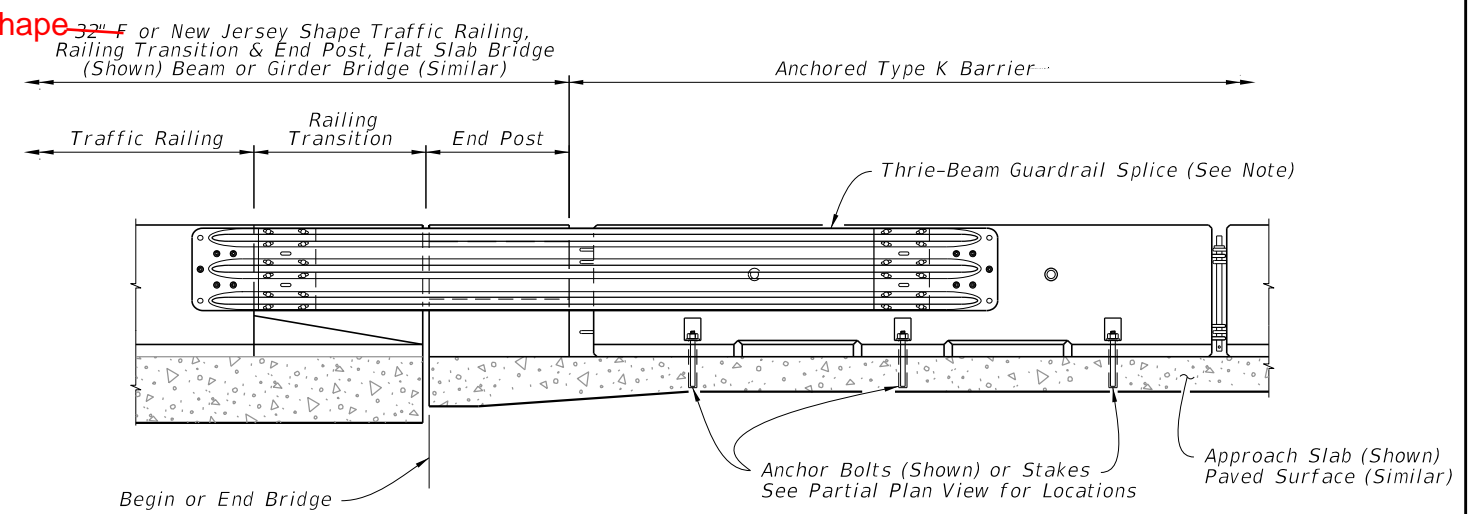

CROSS REFERENCES:
See Sheet 10 for Section B-B,
Section C-C and Section E-E.

PARTIAL ELEVATION VIEW

TRAILING END SPLICE DETAIL
For F-Shape ~~FOR 32" F~~ AND NEW JERSEY SHAPE TRAFFIC RAILINGS
WITH RAILING TRANSITION AND END POST

APPROACH TRANSITION SPLICE DETAIL
For F-Shape ~~FOR 32" F~~ AND NEW JERSEY SHAPE TRAFFIC RAILINGS
WITH RAILING TRANSITION AND END POST

SYMBOL:


→ Direction of Traffic

NOTE:

See Thrie-Beam Guardrail Positioning Detail,
Sheet 10 and Notes for Thrie-Beam Guardrail
Splice Installations, Sheet 1.

10/30/2024 2:45:44 PM


LAST REVISION 11/01/17	REVISION 11/01/25	DESCRIPTION:	FDOT	FY 2025-26 2026-27 STANDARD PLANS	TYPE K TEMPORARY CONCRETE BARRIER SYSTEM	INDEX 102-110	SHEET 9 of 17
---	----------------------	--------------	------	---	--	------------------	------------------

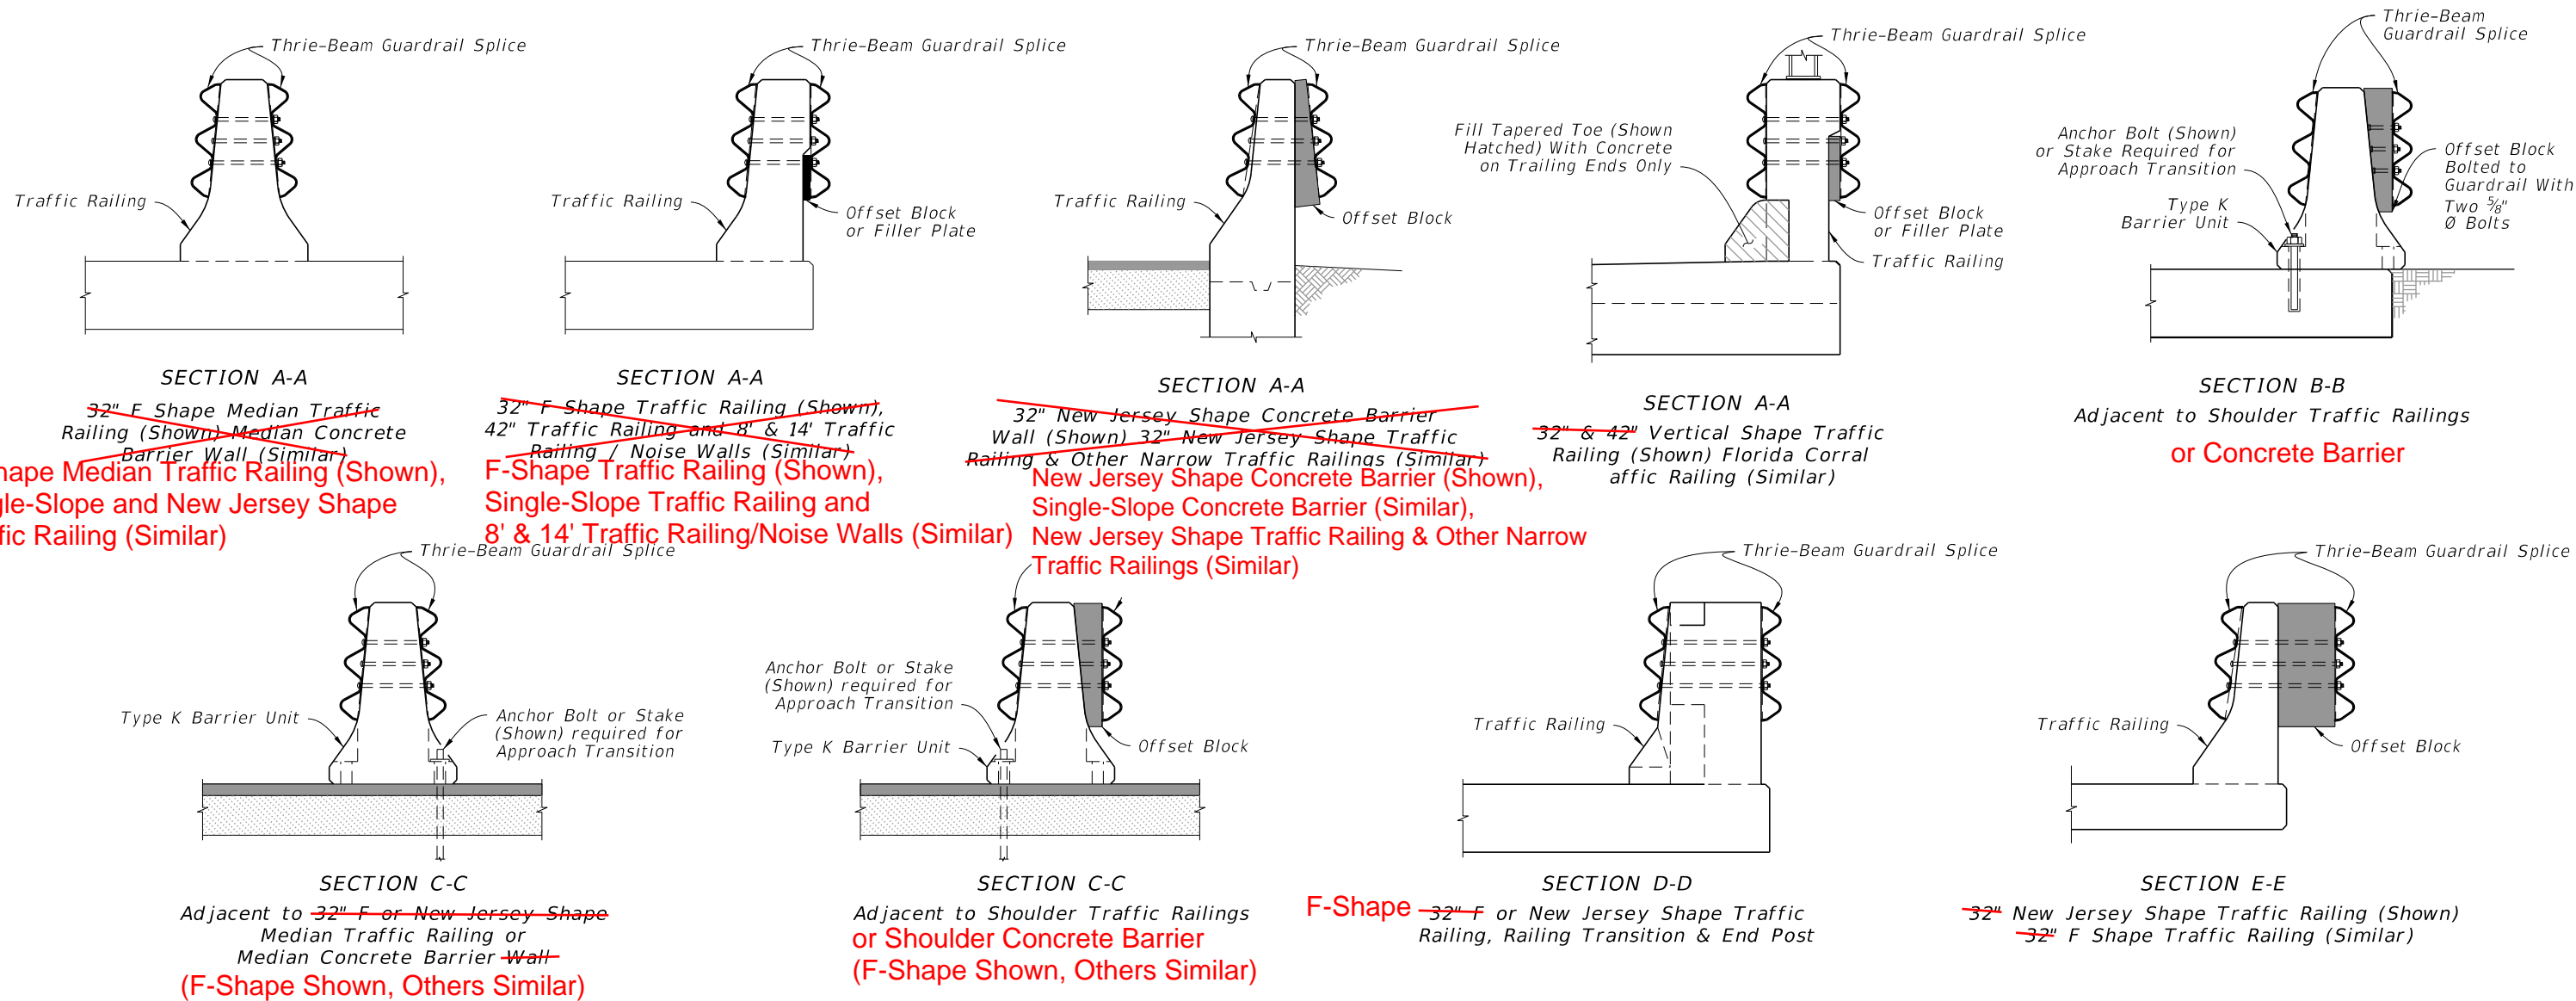

CROSS SECTIONS

NOTE S:

1. Shift Thrie-Beam Guardrail Splice beyond Open Joint 1'-0" Min. (as shown) when 3" Min. dimension can not be obtained
2. See Sheets 7-9 for additional details

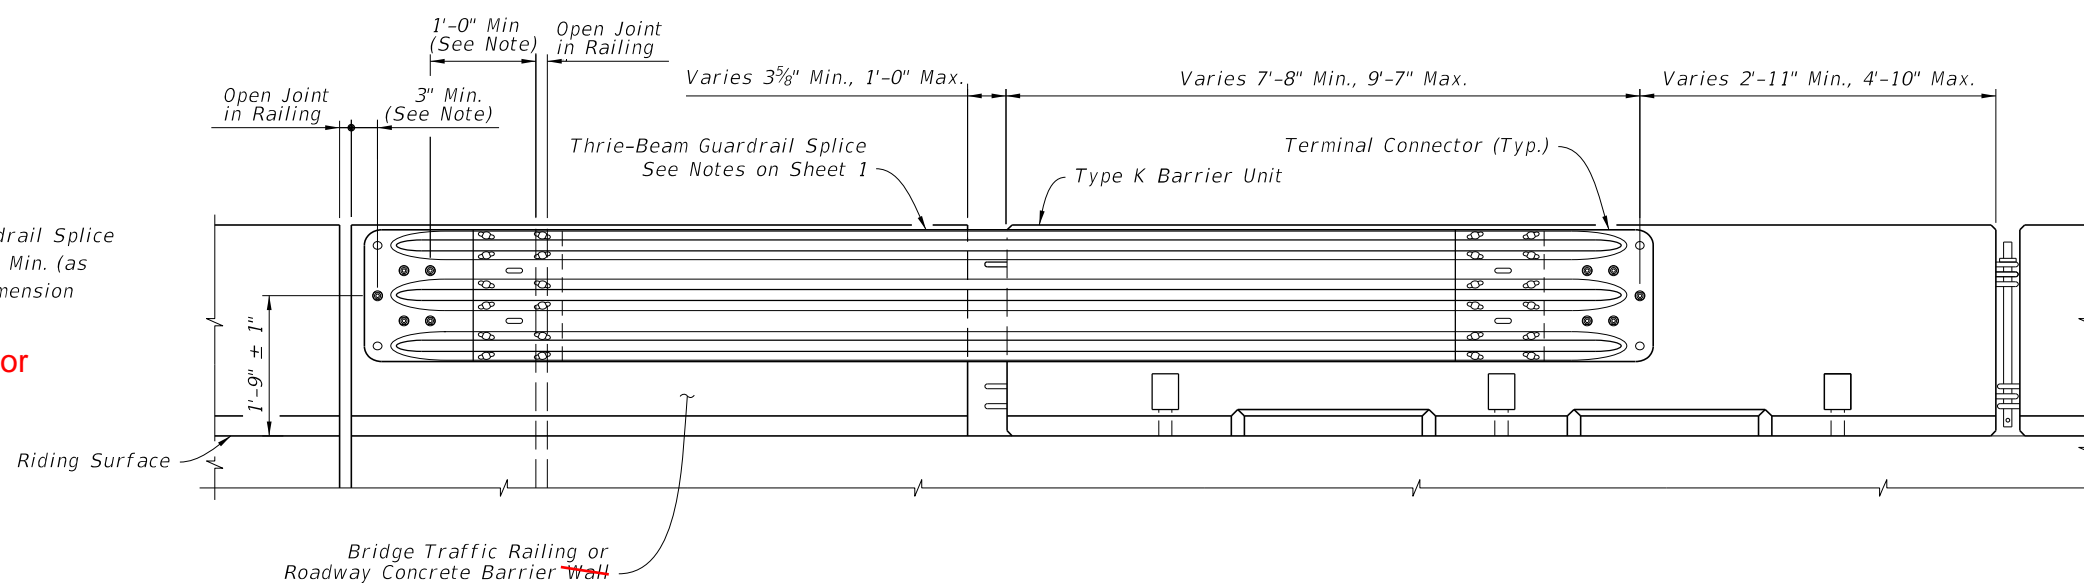


THRIE-BEAM GUARDRAIL POSITIONING DETAIL

10/30/2024 2:45:51 PM

LAST REVISION 11/01/17	DESCRIPTION: 11/01/17 11/01/25	FDOT	FY 2025-26 2026-27 STANDARD PLANS	TYPE K TEMPORARY CONCRETE BARRIER SYSTEM	INDEX 102-110	SHEET 10 of 17
---	--	------	---	--	------------------	-------------------

GENERAL NOTES:


1. Meet the requirements of Index 102-100.
2. For fabrication details see Sheets 15 thru 17.
3. **HANDLING:** Do not lift or move the Barrier Units by using Bars 6D that extend from the ends of the units. Approximate weight of one unit equals 2.7 tons.
4. **CONNECTION PIN ASSEMBLY:** Use steel for Connection Pin and Top Plate assemblies in accordance with ASTM A36 or ASTM A709 Grade 36. Nondestructive testing of welds is not required. At the Contractor's option, a $\frac{3}{8}$ " diameter hole may be provided at the bottom of the Connection Pin, as shown, for the installation of a vandal resistance bolt.
5. **CONNECTION PIN INSTALLATION:** Initially set Barrier Units by using a $3\frac{5}{8}$ " wooden block between ends of adjacent units. Install Connection Pin between adjacent Barrier Units as shown, then pull newly placed Barrier Unit away from adjacent Barrier Unit to remove slack between Connection Pin and Bars 6D (except as shown on Sheet 2). Do not use Barrier Units unconnected.
6. **REUSE OF CONNECTION PINS AND STAKES:** Connection pins and stakes may be reused if they have the structural integrity of new pins.
7. **REMOVAL OF BOLTS, STAKES AND KEEPER PINS:** Upon removal or relocation of Barrier Units, remove all Anchor Bolts and completely fill the remaining holes in bridge decks, approach slabs and roadway rigid pavements that are to remain with Magnesium Ammonium Phosphate Concrete in accordance with Specification 930 or with an Epoxy Resin Compound, Type F or Q, in accordance with Specification 926. If a flexible pavement is present and is to remain, completely fill the remaining holes in the flexible pavement with hot or cold patch asphalt material.
8. **TYPE K ANCHORED TO FREE-STANDING TRANSITIONS:** Use the 3-3-2-1 Anchorage Transition Detail when transitioning Free-Standing and Anchored Units or when connecting Free-Standing runs to Crash Cushions, as shown in this Index.

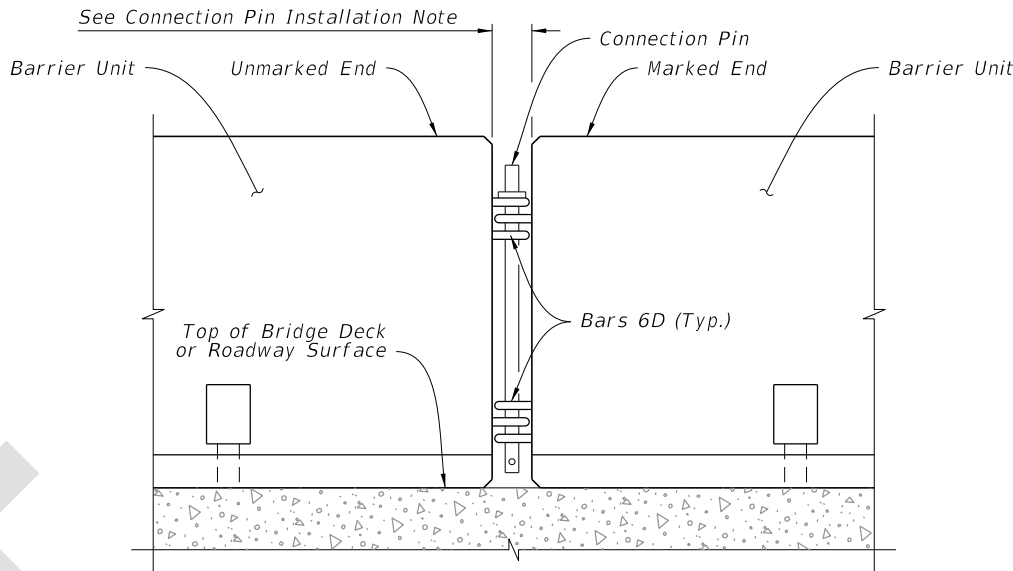

DETAIL OF CONNECTION BETWEEN BARRIER UNITS



CONNECTION TO PERMANENT RIGID BARRIER NOTES:

1. For splice connection details between Type K Temporary Concrete Barriers and Permanent Traffic Railings, see Sheets 7 thru 10. Within this Index, the term Traffic Railing also applies to Concrete Barrier, where both terms refer to permanent installations shown in the Index 521 series.
2. **THRIE-BEAM GUARDRAIL:** Provide Thrie-Beam Guardrail for splices meeting the requirements of Specification 967 and as follows: Two panels per splice (One panel per side) of Class B (10 Gauge), or Four panels per splice (Two nested panels per side) of Class A (12 Gauge). Use a 12'-6" guardrail panel. Provide and install all other associated metallic guardrail components (Terminal Connectors, Shoulder Bolts, Hex Bolts and Nuts, Filler Plates, etc.) in accordance with Index 536-001. Install five Guardrail Anchor Bolts at each end of each splice in any of the standard seven anchor bolt holes in the Thrie-Beam Terminal Connector. If reinforcing steel is encountered when drilling holes for Guardrail Anchor Bolts in Type K Barrier Units, shift Thrie-Beam Terminal Connector so as to clear reinforcing steel within the given tolerances or select a different bolt hole to use. Do not drill or cut through reinforcing steel within Type K Barrier Units. Drilling or cutting through reinforcing steel within permanent concrete traffic railings is permitted.
3. **GUARDRAIL OFFSET BLOCKS:** Provide and install timber Offset Blocks meeting the requirements of Specification 967. Field trim Offset Blocks as required for proper fit. Utilize Offset Blocks as shown and required in order to prevent bending or kinking of Thrie-Beam Guardrail panels.
4. **CONCRETE FOR FILLING TAPERED TRAFFIC RAILING TOES:** Provide concrete for filling tapered toes of Traffic Railings as shown meeting the material requirements of Specification 346, any Class, or a commercially available pre-bagged concrete mix (3000 psi minimum compressive strength). Sampling, testing, evaluation and certification of the concrete in accordance with Specification 346 is not required. Saturate with water the surfaces upon and against which the concrete fill will be placed prior to placing concrete. Place and finish concrete fill using forms or by hand methods to the general configurations shown so as to provide a smooth shape transition between the Type K Barrier and the adjacent traffic railing. A low slump is desirable if placing and finishing concrete by hand methods. Cure the concrete fill by application of a curing compound, or by covering with a wet tarp or burlap for a minimum of 24 hours. Completely remove the concrete fill upon relocation or removal of the Type K Temporary Concrete Barrier.

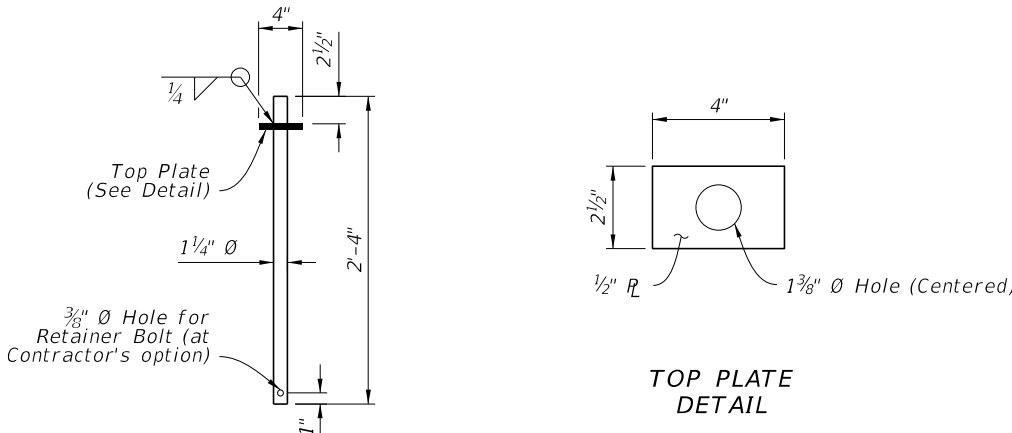

CONNECTION PIN DETAIL

SYMBOL:

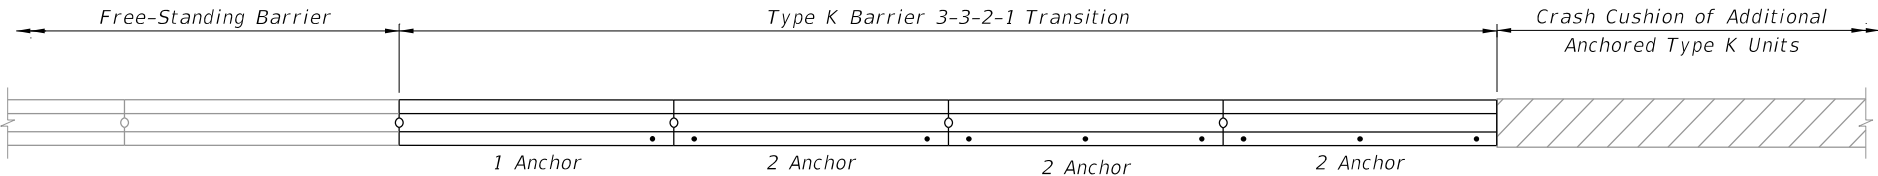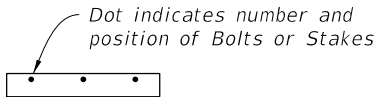

3-3-2-1 ANCHORAGE TRANSITION DETAIL



FY 2026-27
STANDARD PLANS

TYPE K TEMPORARY CONCRETE BARRIER SYSTEM

INDEX
102-110


SHEET
1 of 17

LAST
REVISION
11/01/25

REVISION

DESCRIPTION:


7/22/2025 7:14:50 AM

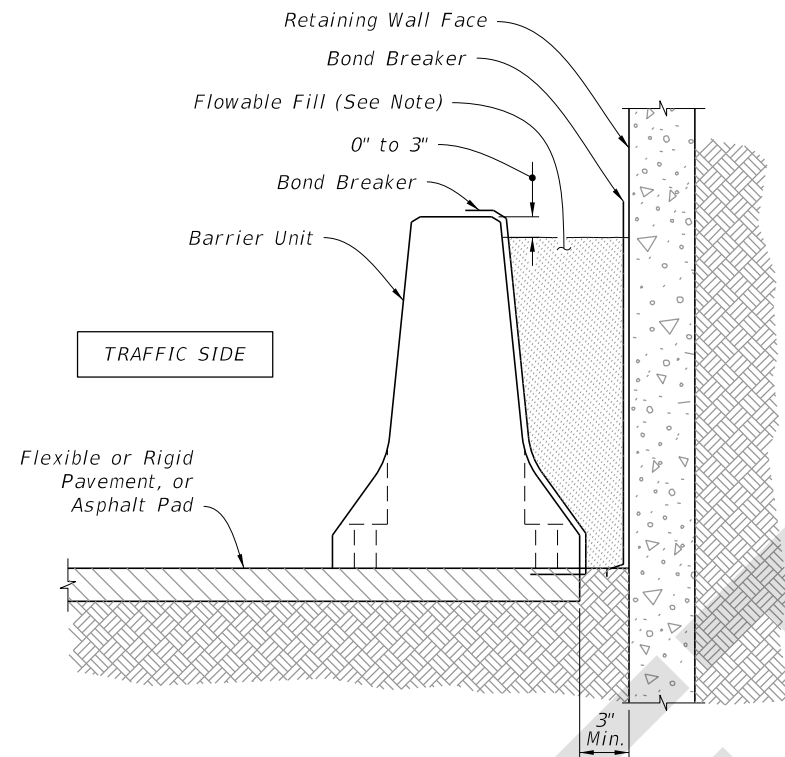


NOTE:
Provide Excavatable Flowable Fill in accordance with Specification 121.

TYPICAL SECTION
ADJACENT TO RETAINING WALL WITH FLOWABLE FILL BACK-FILL

FLOWABLE FILL BACK-FILL ROADSIDE INSTALLATIONS

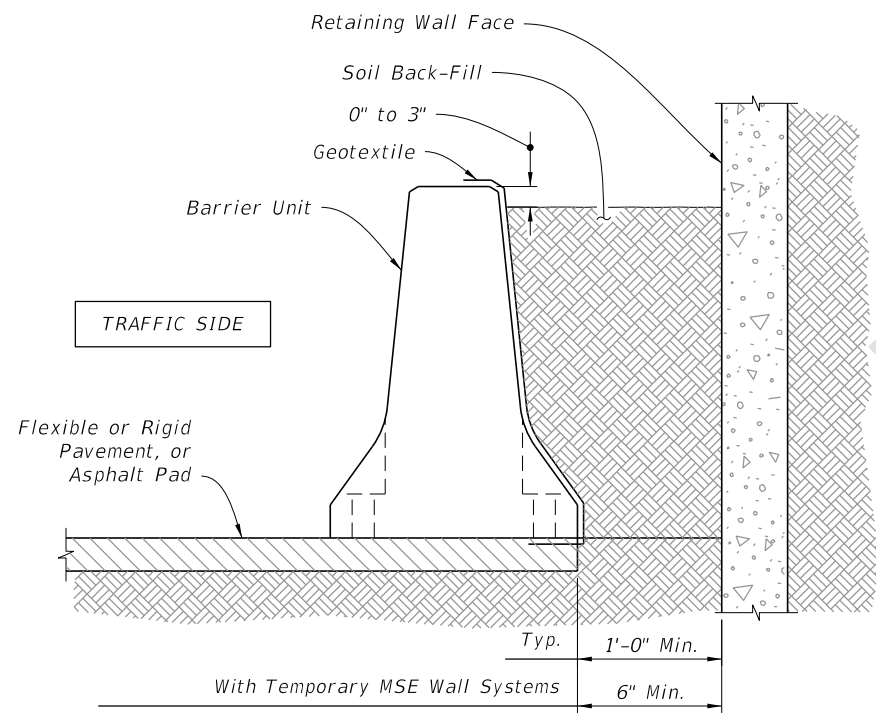

NOTES:
SOIL BACK-FILL MATERIAL: Provide Back-Fill Material consisting of any available clean soil. Compact Back-Fill Material until the soil mass is firm and unyielding. Provide erosion control as specified in the Plans. If none is specified in the Plans, provide erosion control as required to maintain the integrity of the Back-Fill embankment.
GEOTEXTILE: Provide and install Type D-5 geotextile in accordance with Specification 514 to contain Back-Fill Material behind the Barrier Units. Geotextile may be continuous over the length and height of the installation or may be individual pieces as required to cover the Lift/DrainSlots and open vertical joints between Barrier Units.

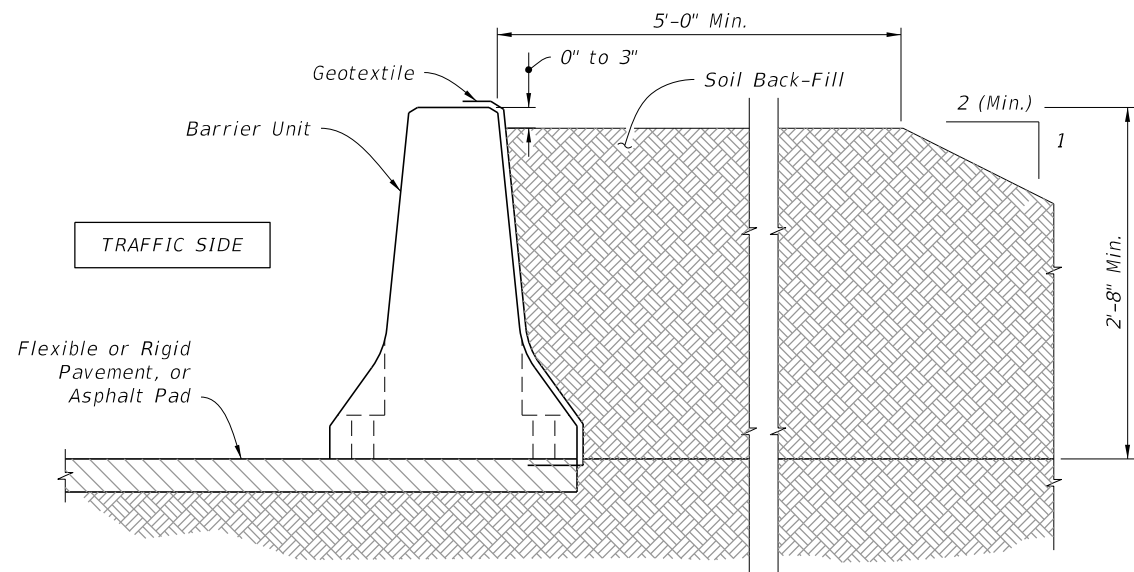


TYPICAL SECTION
ADJACENT TO RETAINING WALL WITH SOIL BACK-FILL


TYPICAL SECTION
WITH SOIL BACK-FILL

SOIL BACK-FILLED ROADSIDE INSTALLATIONS


7/22/2025 7:15:00 AM

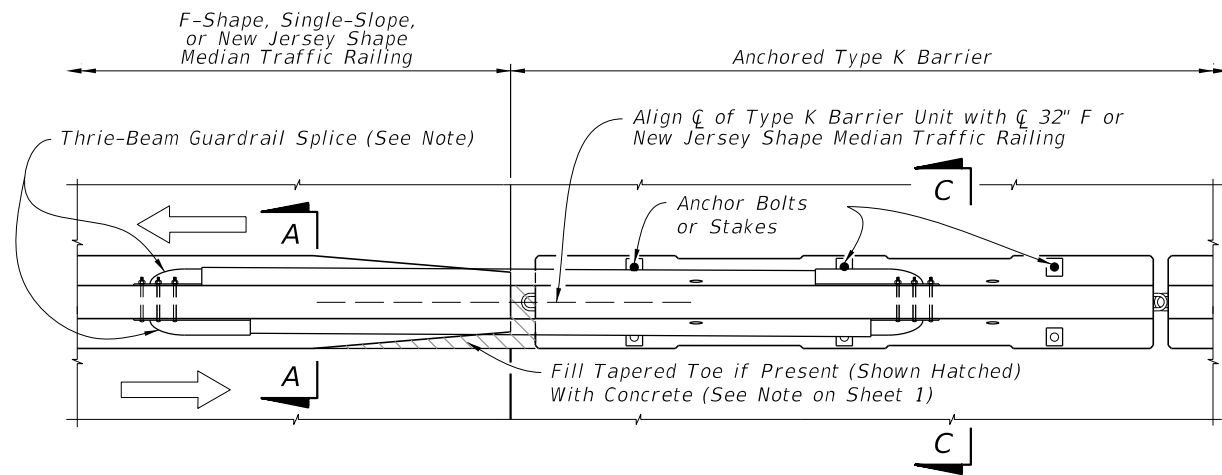

PARTIAL PLAN VIEW AT MEDIAN TRAFFIC RAILING

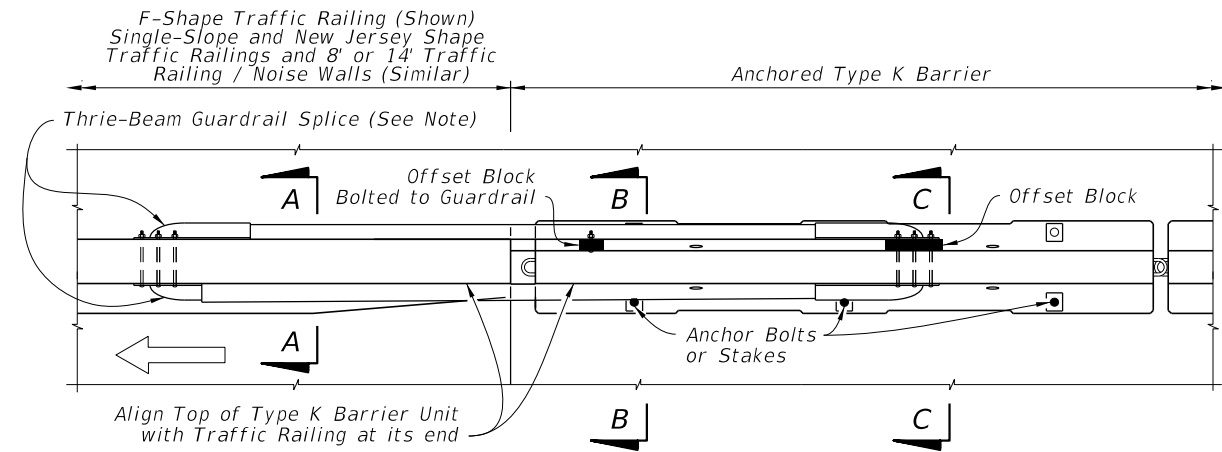

PARTIAL PLAN VIEW AT SHOULDER TRAFFIC RAILING

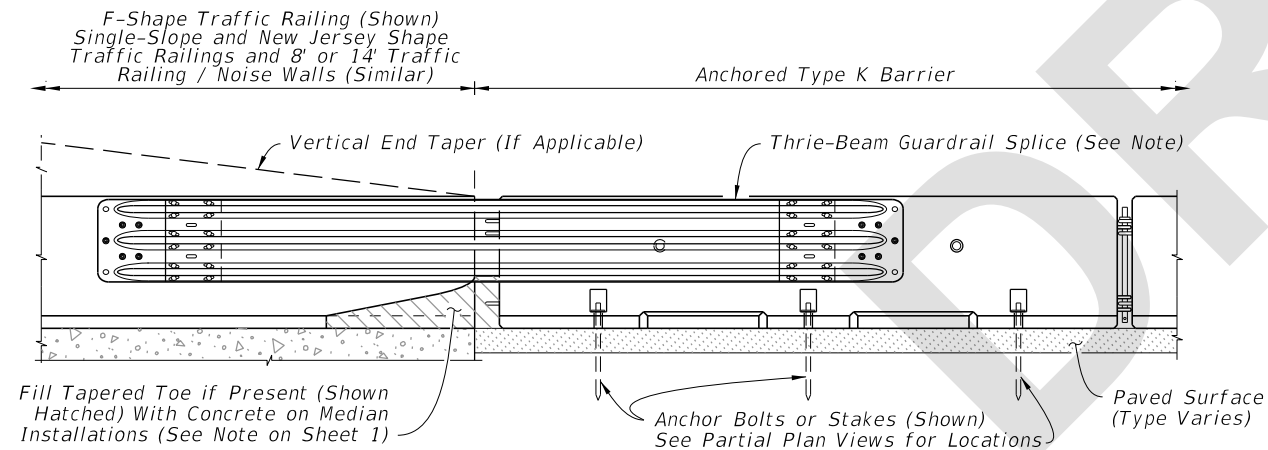

PARTIAL ELEVATION VIEW


APPROACH TRANSITION SPLICE DETAIL
FOR SINGLE-SLOPE, F-SHAPE, AND NEW JERSEY SHAPE TRAFFIC RAILINGS AND 8' & 14'
TRAFFIC RAILING / NOISE WALLS (CONCRETE BARRIER SIMILAR)

SYMBOL:


→ Direction of Traffic

NOTE:


See Thrie-Beam Guardrail Positioning Detail, Sheet 10 and Notes for Thrie-Beam Guardrail Splice Installations, Sheet 1.

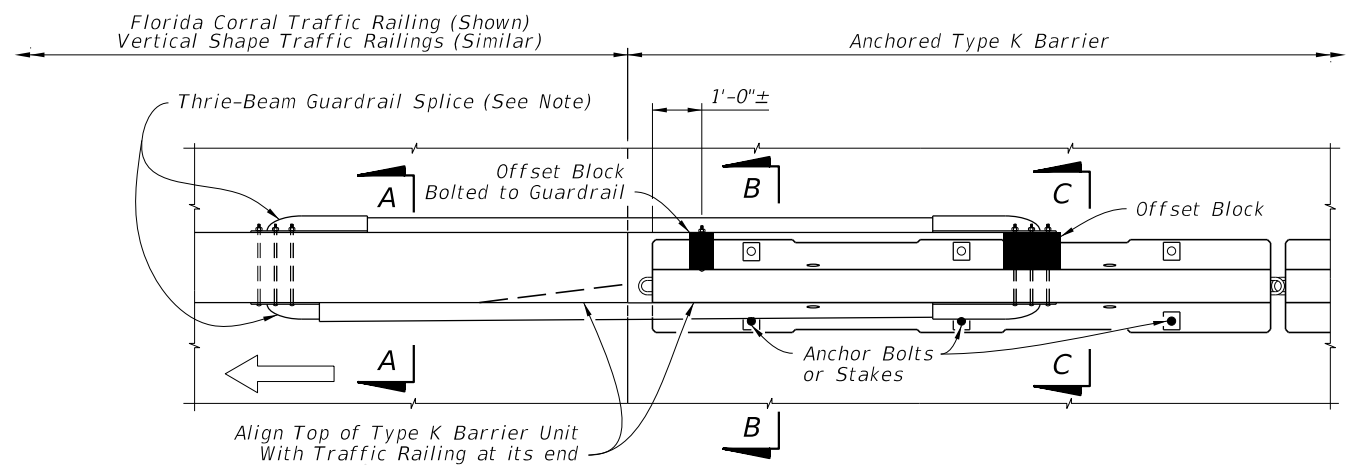

PARTIAL PLAN VIEW

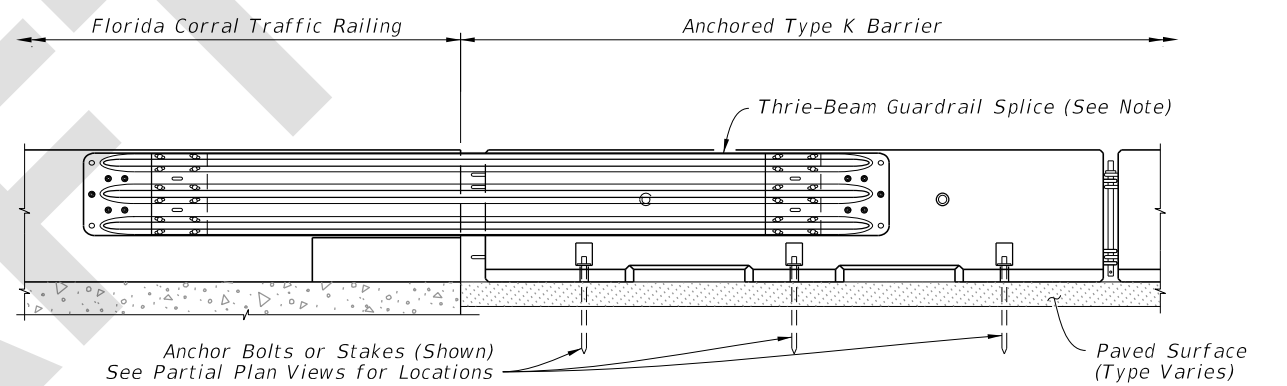

PARTIAL ELEVATION VIEW - FLORIDA CORRAL TRAFFIC RAILING

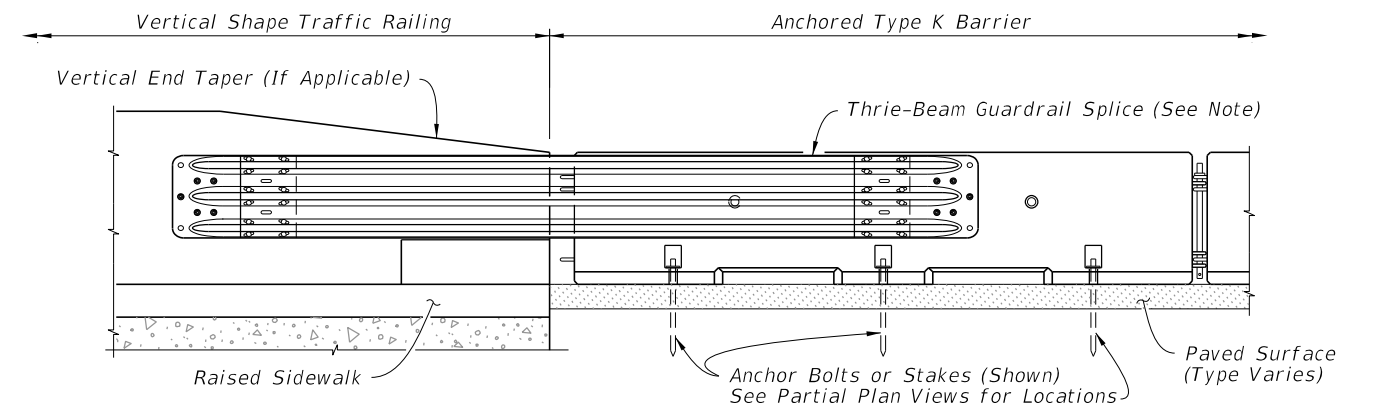

PARTIAL ELEVATION VIEW - VERTICAL SHAPE TRAFFIC RAILINGS

APPROACH TRANSITION SPLICE DETAIL
FOR FLORIDA CORRAL AND VERTICAL
SHAPE TRAFFIC RAILINGS


CROSS REFERENCES:

See Sheet 10 for Section A-A, Section B-B and Section C-C.


7/22/2025 7:15:07 AM

LAST REVISION 11/01/25	REVISION	DESCRIPTION:	FDOT	FY 2026-27 STANDARD PLANS	TYPE K TEMPORARY CONCRETE BARRIER SYSTEM	INDEX 102-110	SHEET 7 of 17
------------------------------	----------	--------------	------	------------------------------	--	------------------	------------------

7/22/2025 7:15:14 AM

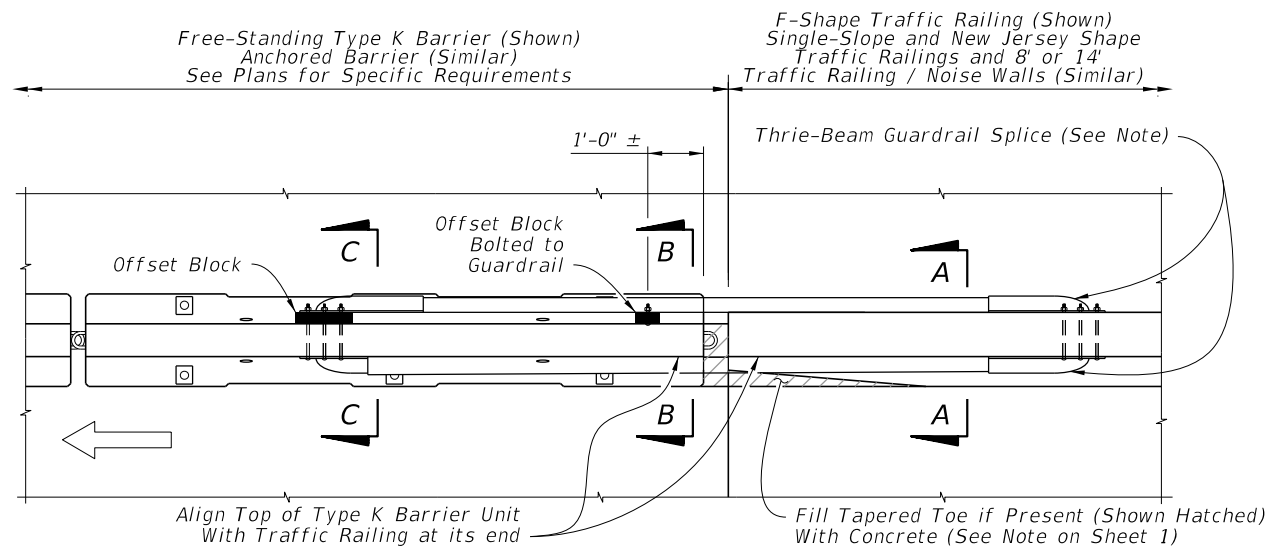

PARTIAL PLAN VIEW

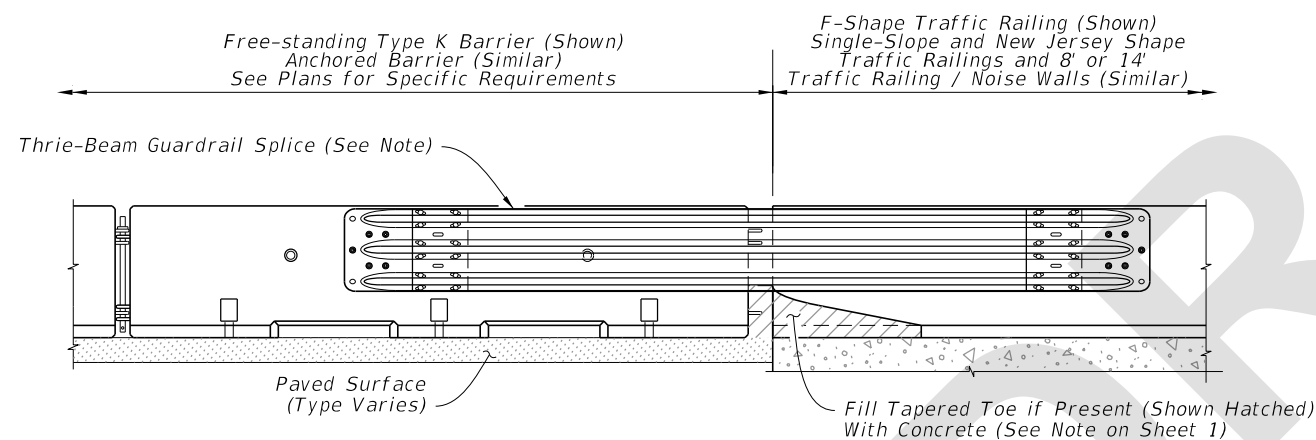

PARTIAL ELEVATION VIEW

TRAILING END SPLICE DETAIL
FOR SINGLE-SLOPE, F-SHAPE, AND NEW JERSEY SHAPE TRAFFIC RAILINGS AND 8' & 14'
TRAFFIC RAILING / NOISE WALLS (CONCRETE BARRIER SIMILAR)

SYMBOL:


➡ Direction of Traffic

NOTE:


See Thrie-Beam Guardrail Positioning Detail,
Sheet 10 and Notes for Thrie-Beam Guardrail
Splice Installations, Sheet 1.

CROSS REFERENCES:

See Sheet 10 for Section A-A,
Section B-B and Section C-C.

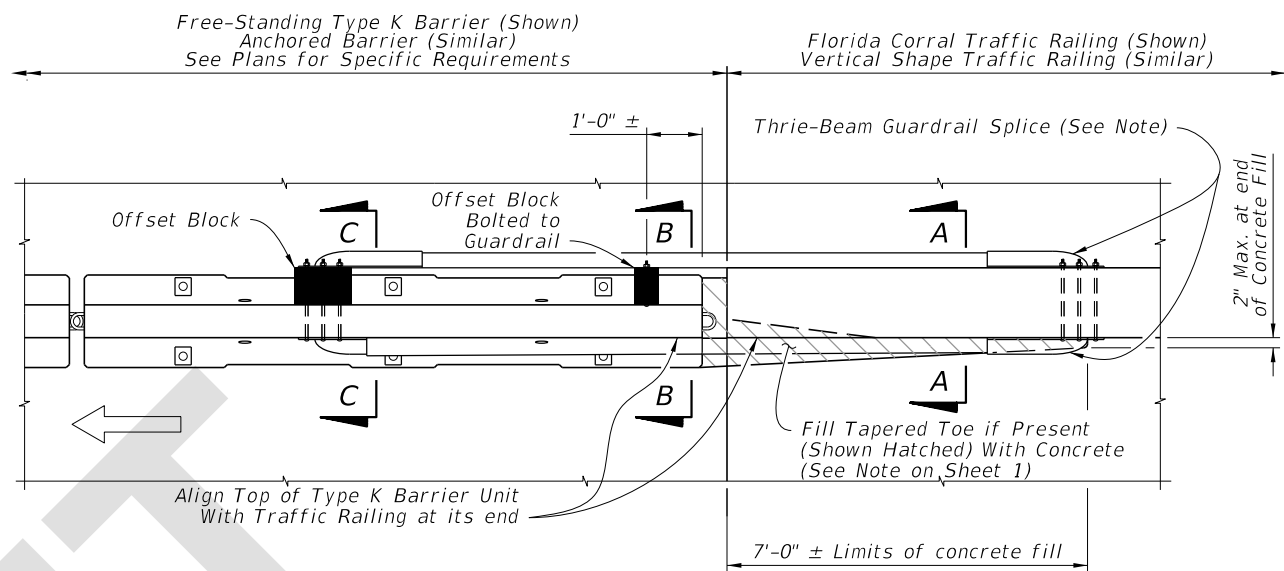

PARTIAL PLAN VIEW

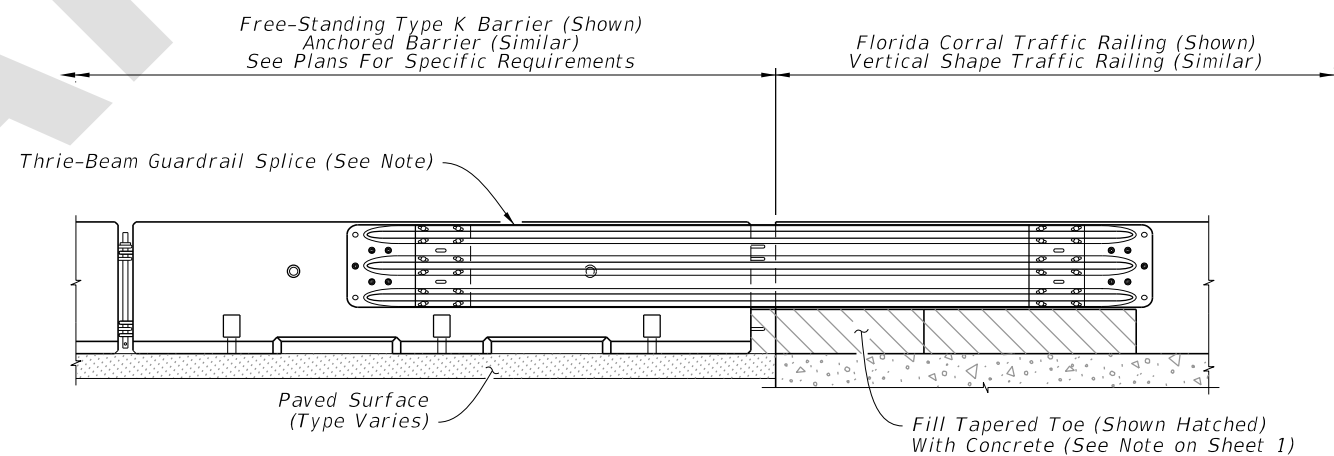

PARTIAL ELEVATION VIEW

TRAILING END SPLICE DETAIL
FOR FLORIDA CORRAL AND VERTICAL
SHAPE TRAFFIC RAILINGS



FY 2026-27
STANDARD PLANS

TYPE K TEMPORARY CONCRETE BARRIER SYSTEM


INDEX
102-110

SHEET
8 of 17


LAST
REVISION
11/01/25

REVISION


DESCRIPTION:

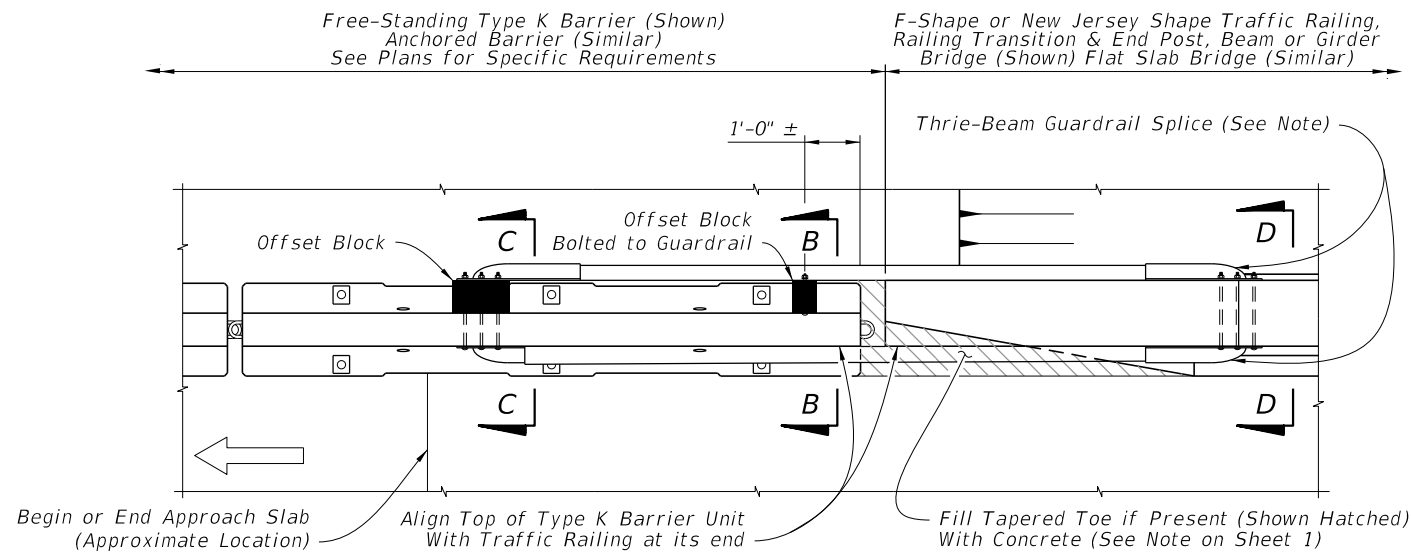

PARTIAL PLAN VIEW

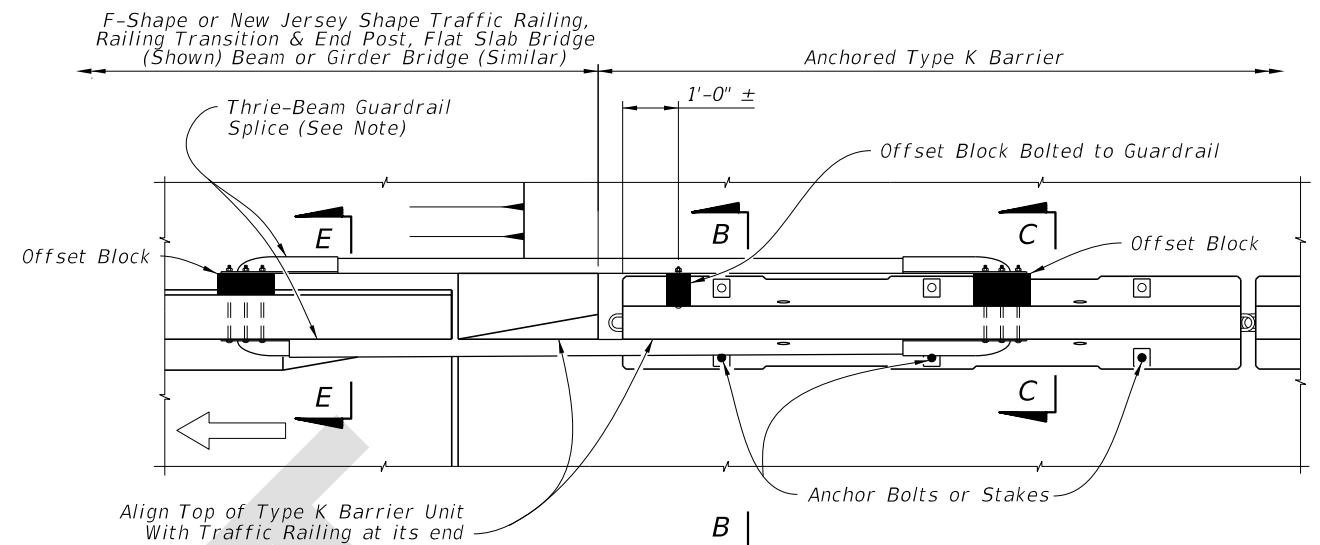


PARTIAL PLAN VIEW

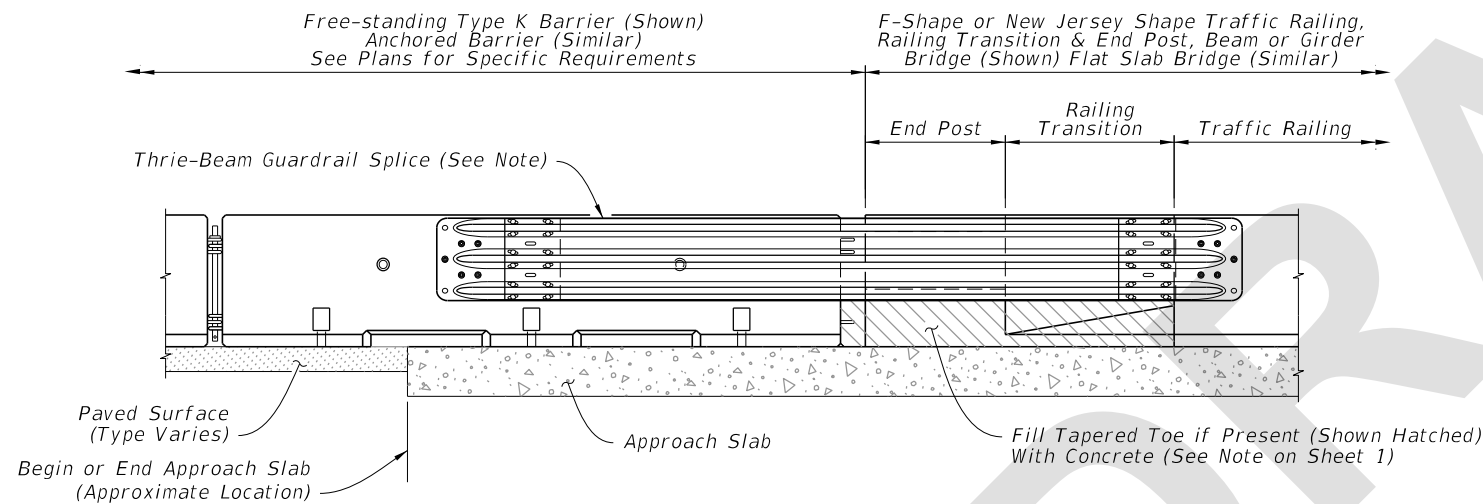

CROSS REFERENCES:
See Sheet 10 for Section B-B,
Section C-C and Section D-D.

PARTIAL ELEVATION VIEW

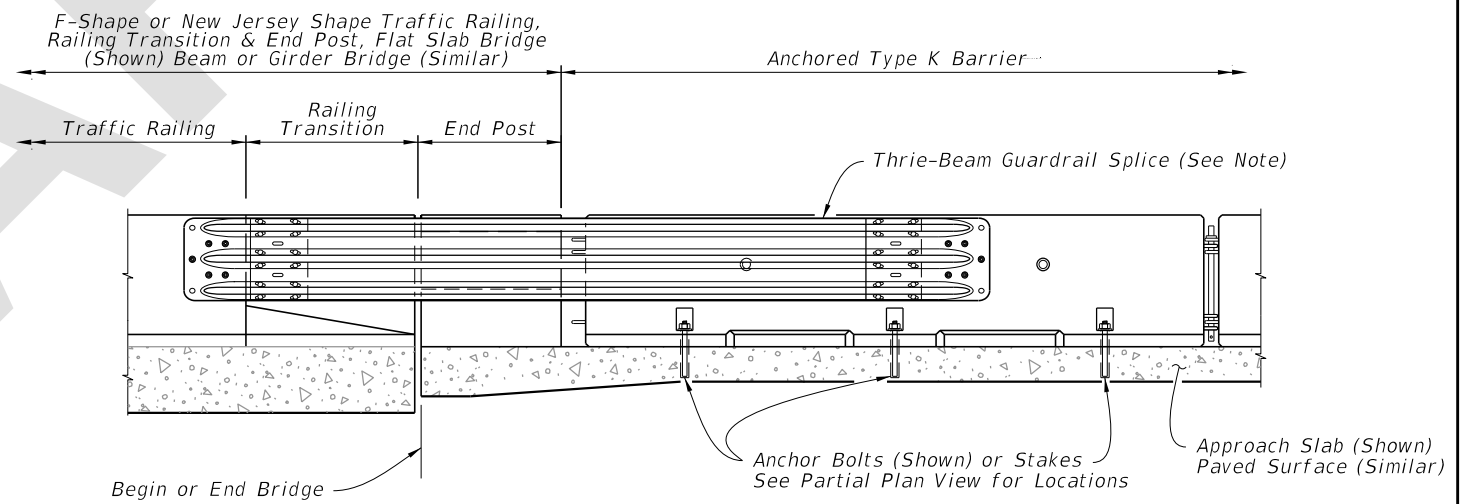

CROSS REFERENCES:
See Sheet 10 for Section B-B,
Section C-C and Section E-E.

PARTIAL ELEVATION VIEW

TRAILING END SPLICE DETAIL
FOR F-SHAPE AND NEW JERSEY SHAPE TRAFFIC RAILINGS
WITH RAILING TRANSITION AND END POST

APPROACH TRANSITION SPLICE DETAIL
FOR F-SHAPE AND NEW JERSEY SHAPE TRAFFIC RAILINGS
WITH RAILING TRANSITION AND END POST


SYMBOL:


→ Direction of Traffic

NOTE:

See Thrie-Beam Guardrail Positioning Detail, Sheet 10 and Notes for Thrie-Beam Guardrail Splice Installations, Sheet 1.

7/22/2025 7:15:21 AM


LAST REVISION 11/01/25	REVISION	DESCRIPTION:	 FY 2026-27 STANDARD PLANS	TYPE K TEMPORARY CONCRETE BARRIER SYSTEM	INDEX 102-110	SHEET 9 of 17
------------------------------	----------	--------------	--	---	------------------	------------------

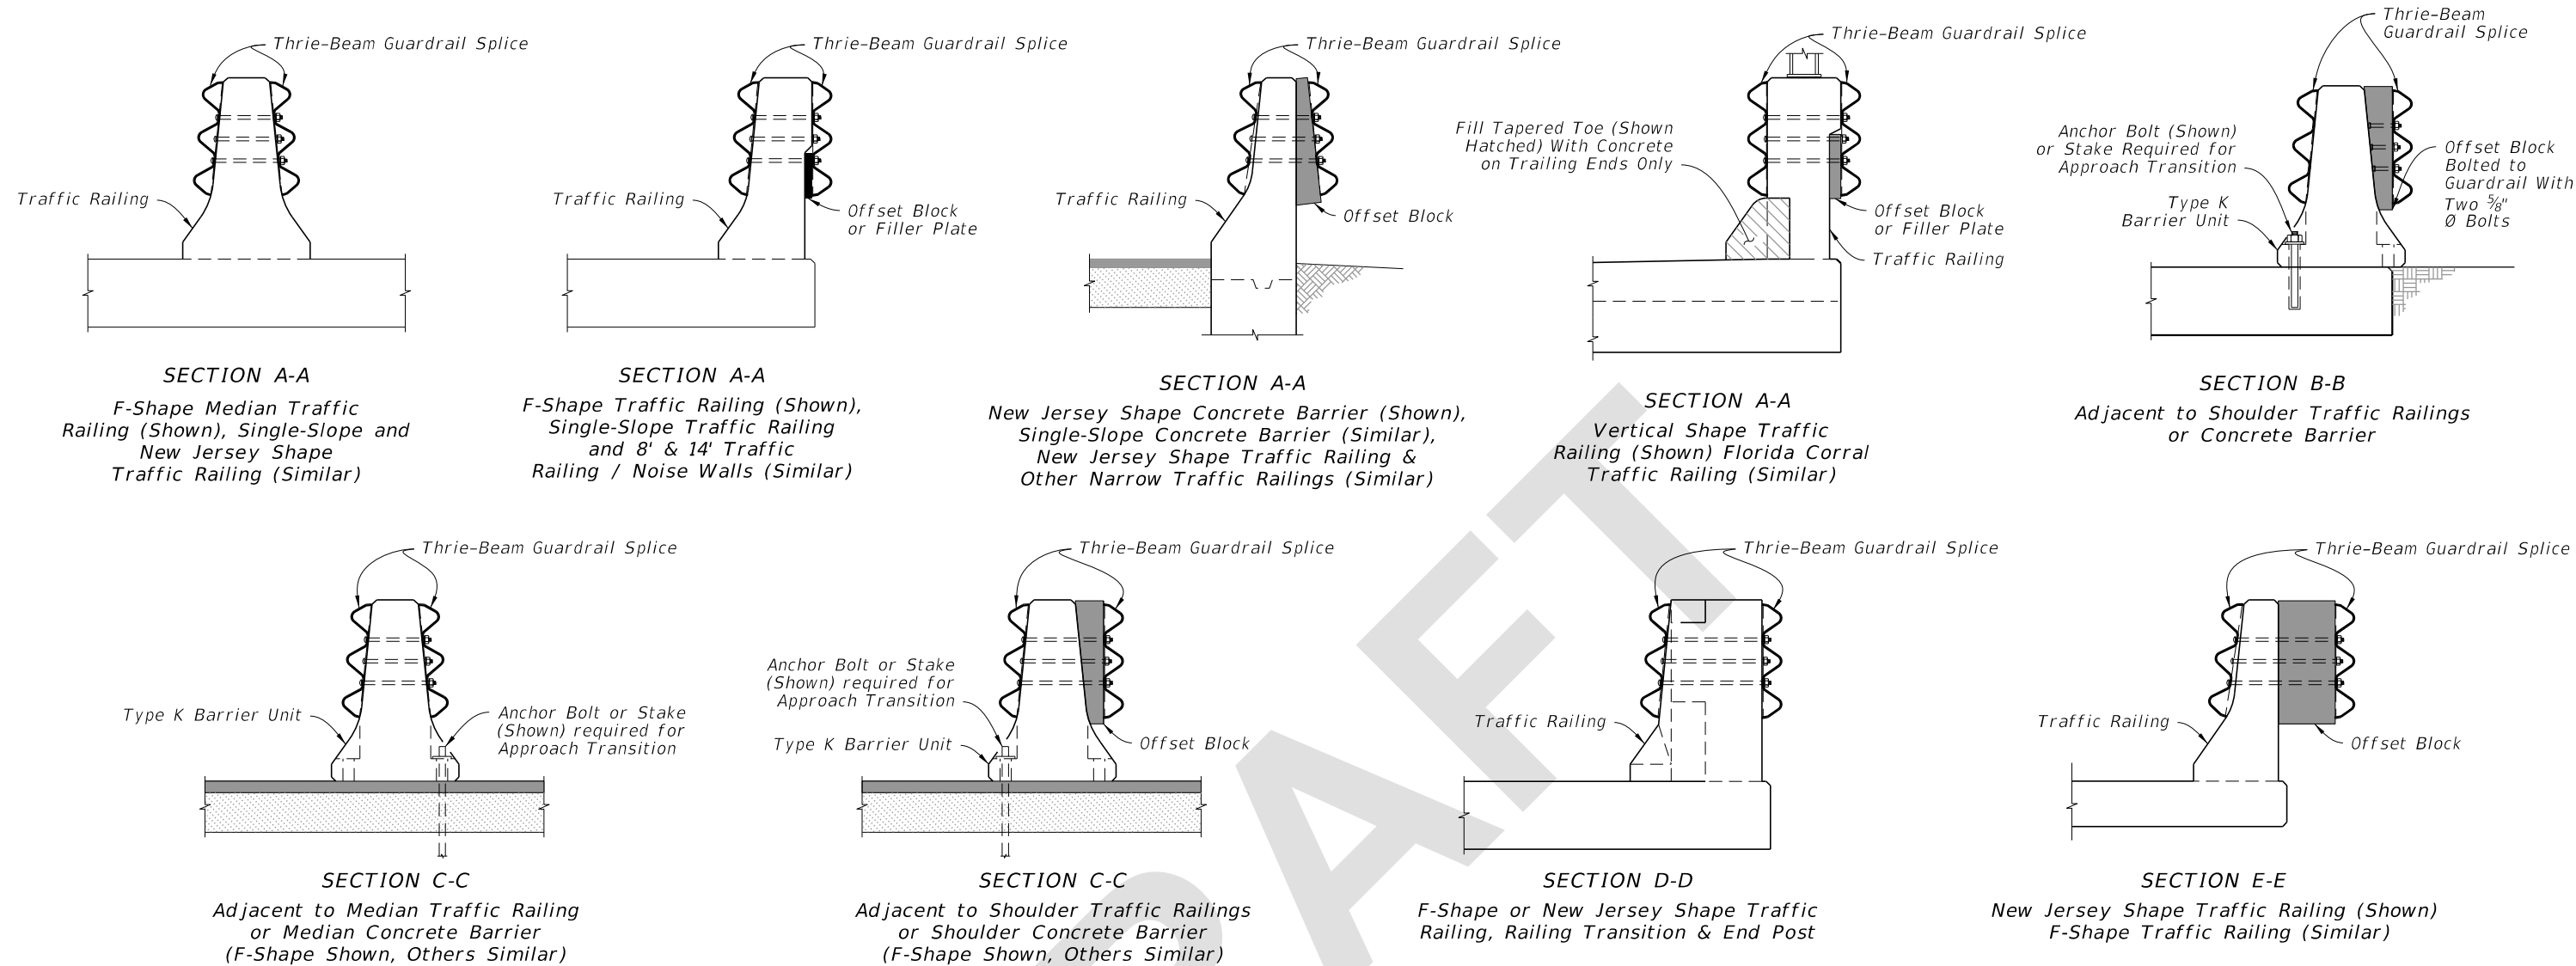


CROSS SECTIONS

NOTES:

1. Shift Thrie-Beam Guardrail Splice beyond Open Joint 1'-0" Min. (as shown) when 3" Min. dimension can not be obtained
2. See Sheets 7 thru 9 for additional details

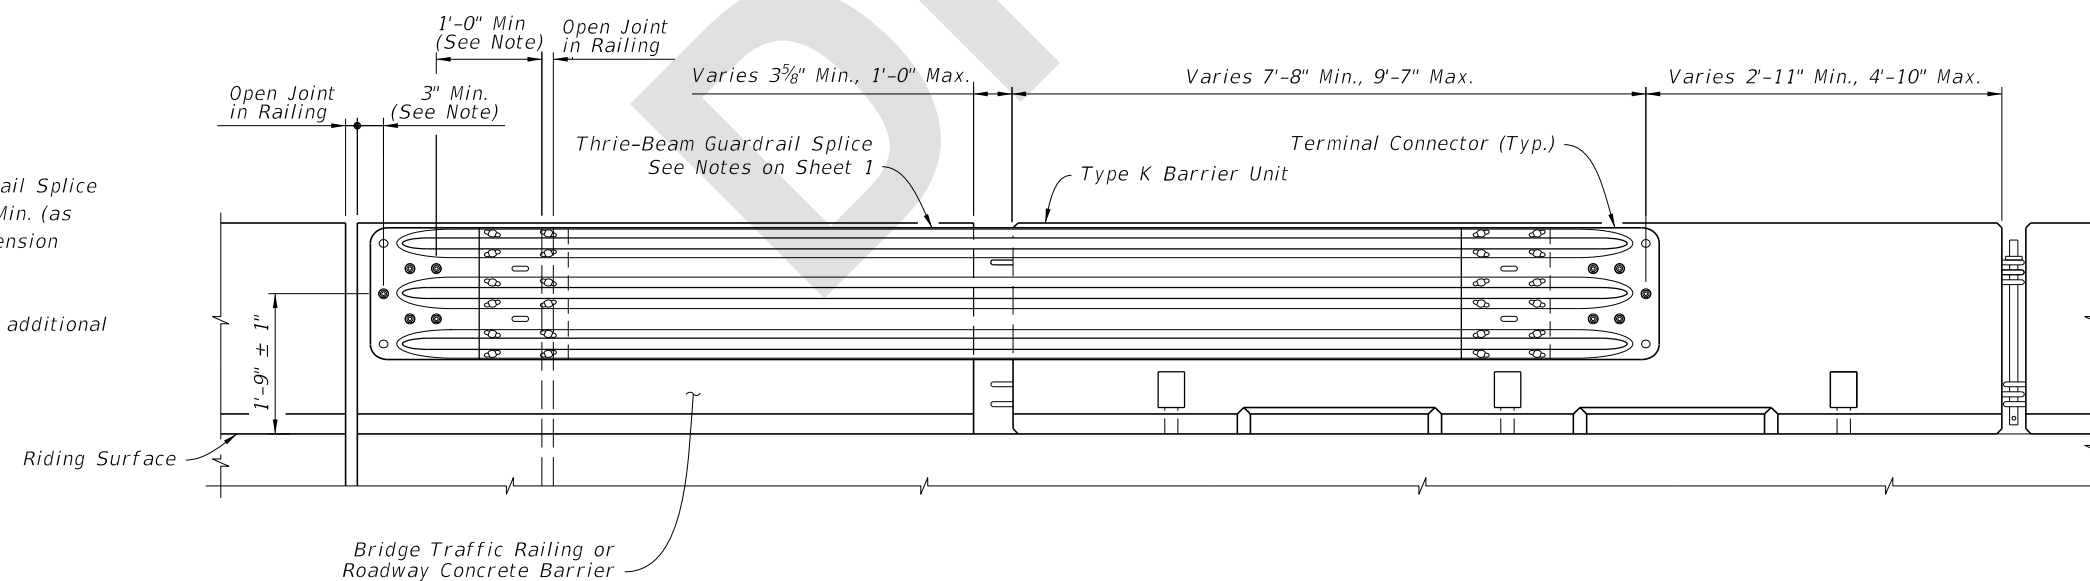

THRIE-BEAM GUARDRAIL POSITIONING DETAIL

LAST REVISION 11/01/25	DESCRIPTION:	 FY 2026-27 STANDARD PLANS	TYPE K TEMPORARY CONCRETE BARRIER SYSTEM	INDEX 102-110	SHEET 10 of 17
------------------------------	--------------	--	---	-------------------------	--------------------------