

Origination Form
Proposed Revisions to a Standard Plans Index

Originator:	Turley, Joshua	Index Number:	102-210
Date:	5/15/2025	Sheet Number(s):	All Sheets
E-mail:	Joshua.Turley@dot.state.fl.us	Index Title:	TEMPORARY DETOUR BRIDGE TIMBER PILE FOUNDATIONS

Summary of the changes:

All: Changed the Title of the index from "Foundations" to "Backwall Bent"
Sheet 2: Updated references of "Filter Fabric" to "Geotextile"


Commentary/Background:

All: Updating sheet title to reflect the more precise terminology
Sheet 2: Missed callouts when clarifying these references in past years


Other Affected Documents/Offices	Person Contacted	Affected (Yes/No)
Other Standard Plans		No
FDOT Design Manual		No
Standard Specifications		No
Basis of Estimates Manual		No
Approved Product List		No
Construction Office		No
Maintenance Office		No

Implementation

["FY-Standard Plans (Next Release)"]

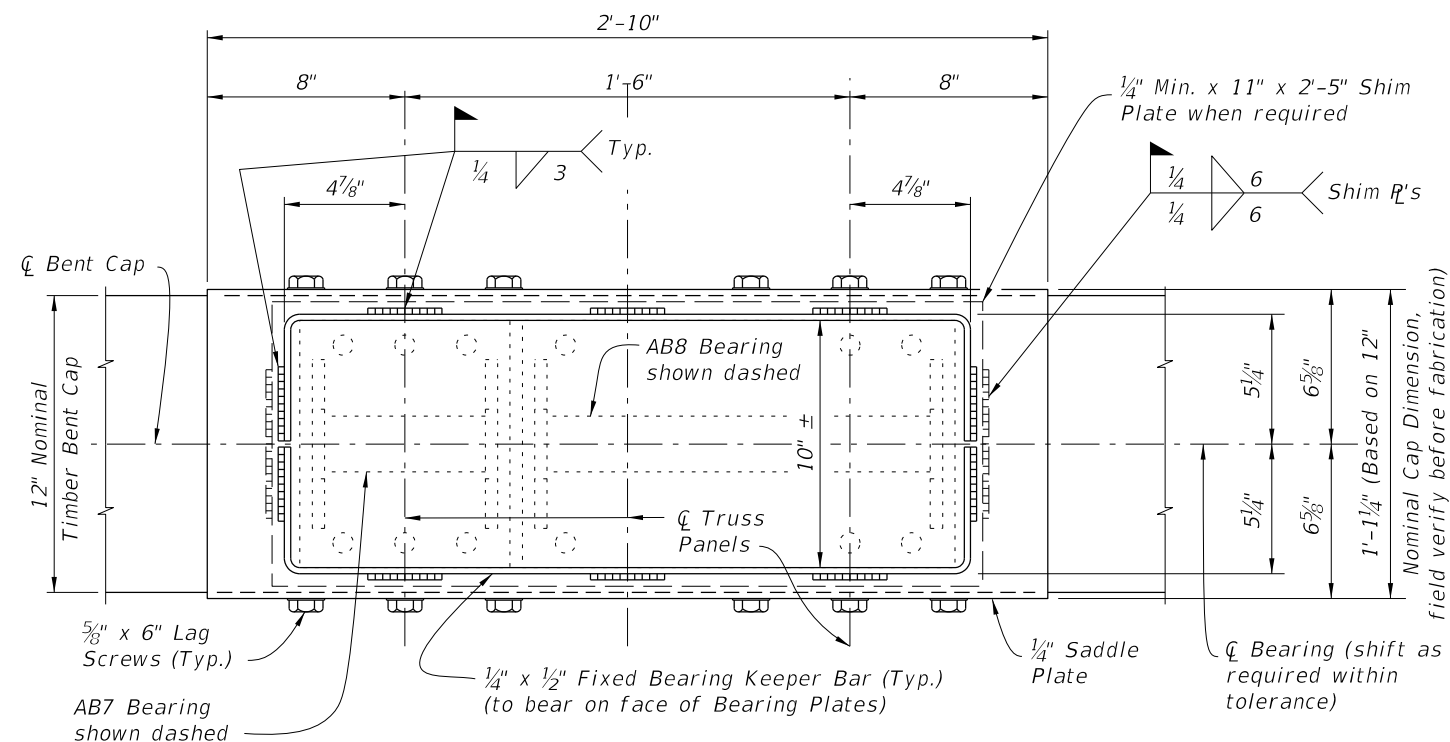


PLAN VIEW

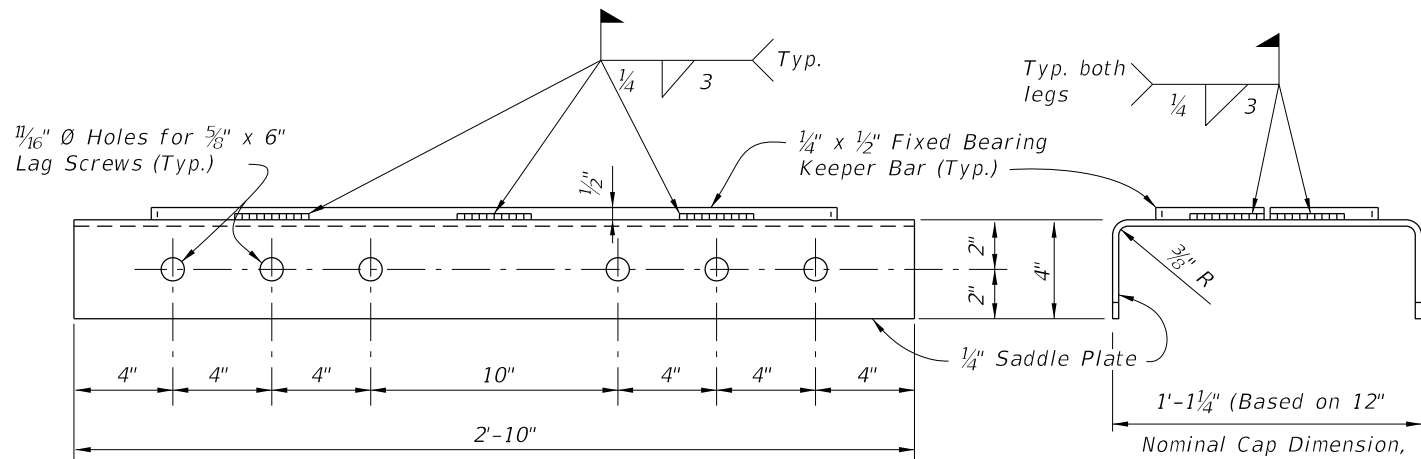

ELEVATION VIEW OF SADDLE PLATE

END VIEW

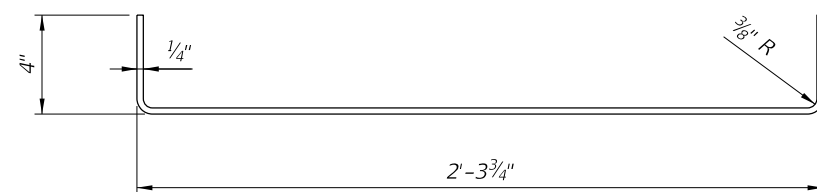


FIXED BEARING KEEPER BAR DETAIL

FIXED BEARING DETAILS


2026-27



FY ~~2025-26~~
STANDARD PLANS

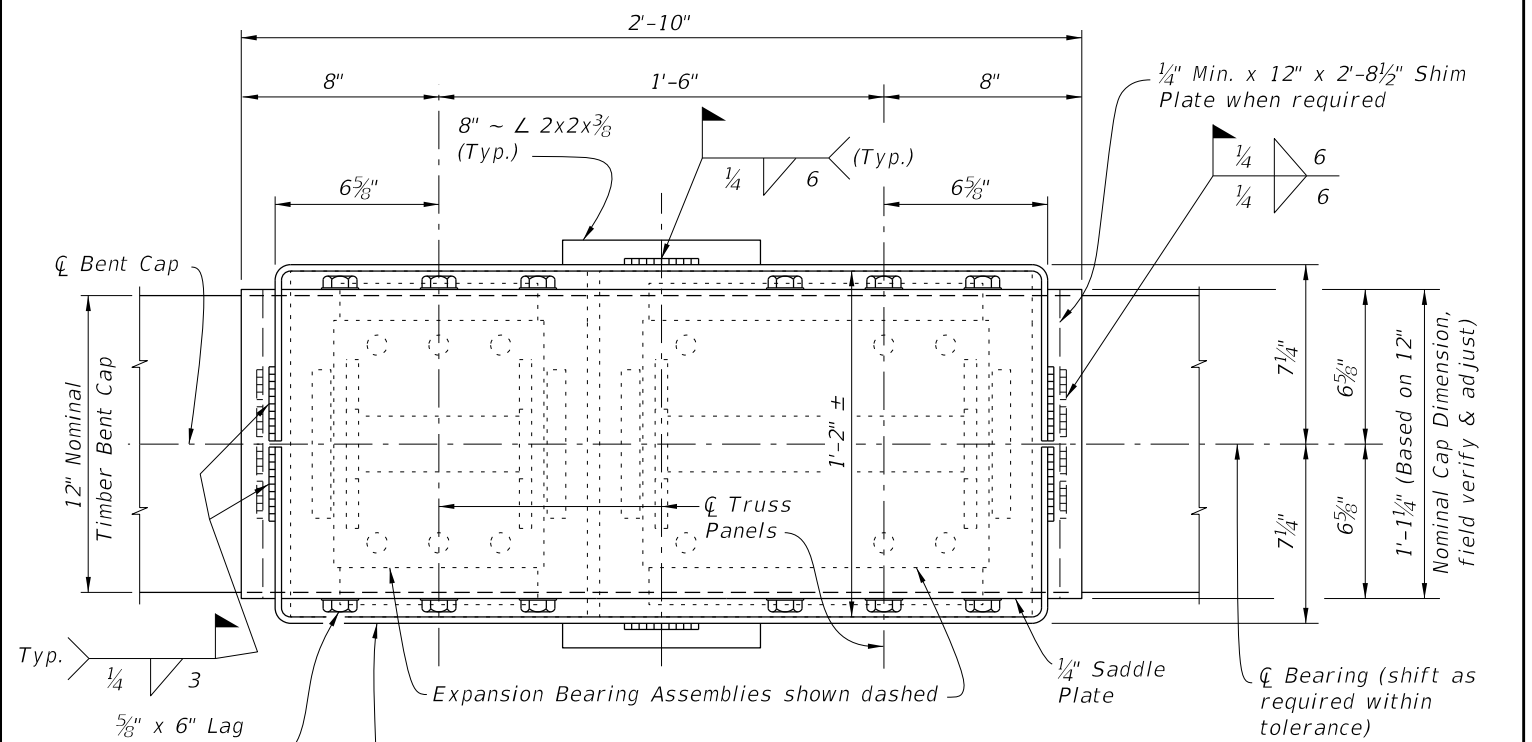


PLAN VIEW

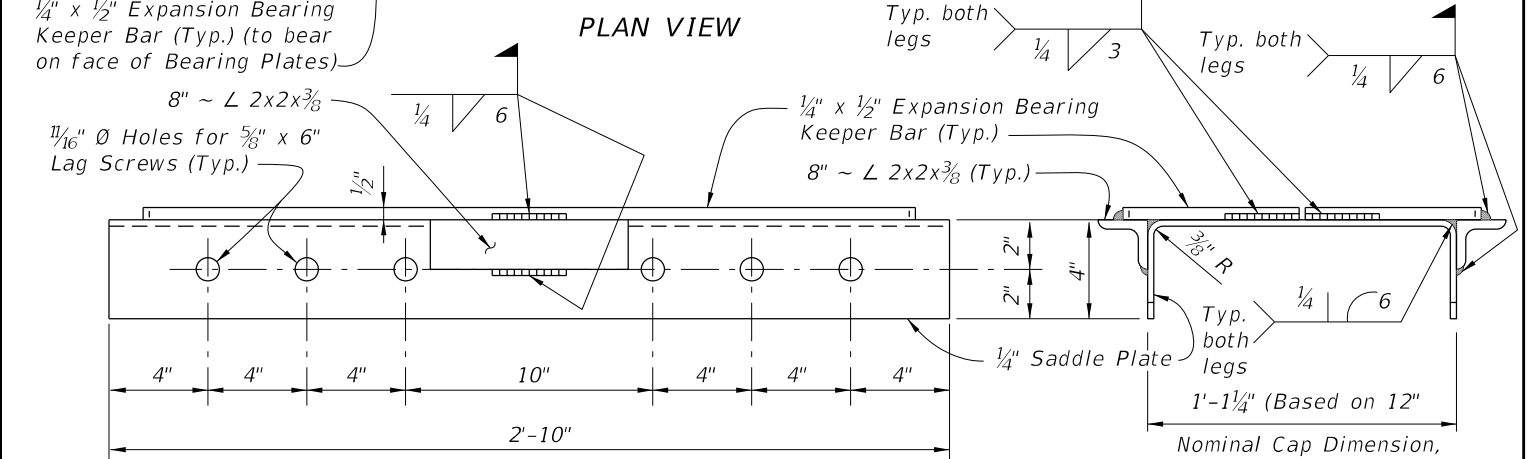

ELEVATION VIEW OF SADDLE PLATE

END VIEW

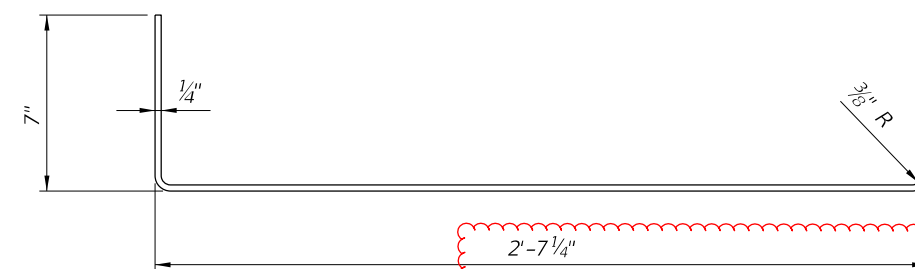

EXPANSION BEARING KEEPER BAR DETAIL

EXPANSION BEARING DETAILS

Backwall Bent

10/17/2024 8:01:26 AM

LAST
REVISION
01/01/16
11/01/25


REVISION

DESCRIPTION:


TEMPORARY DETOUR BRIDGE
TIMBER PILE FOUNDATIONS

INDEX
102-210

SHEET
1 of 3

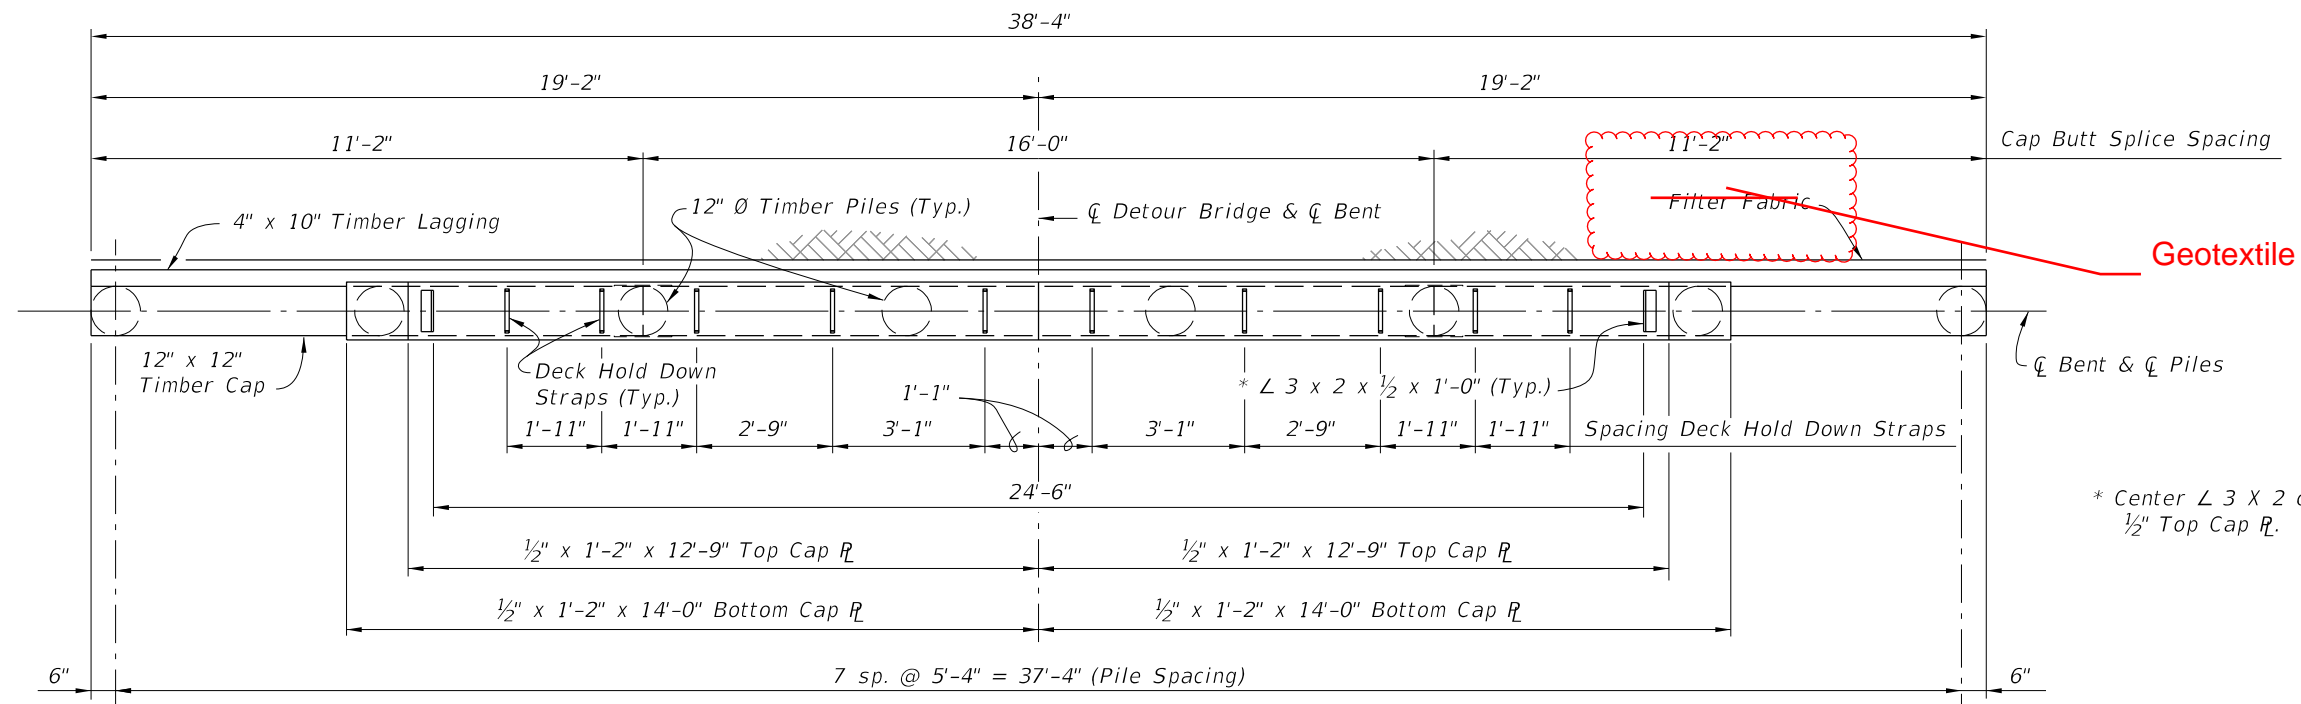

PLAN VIEW

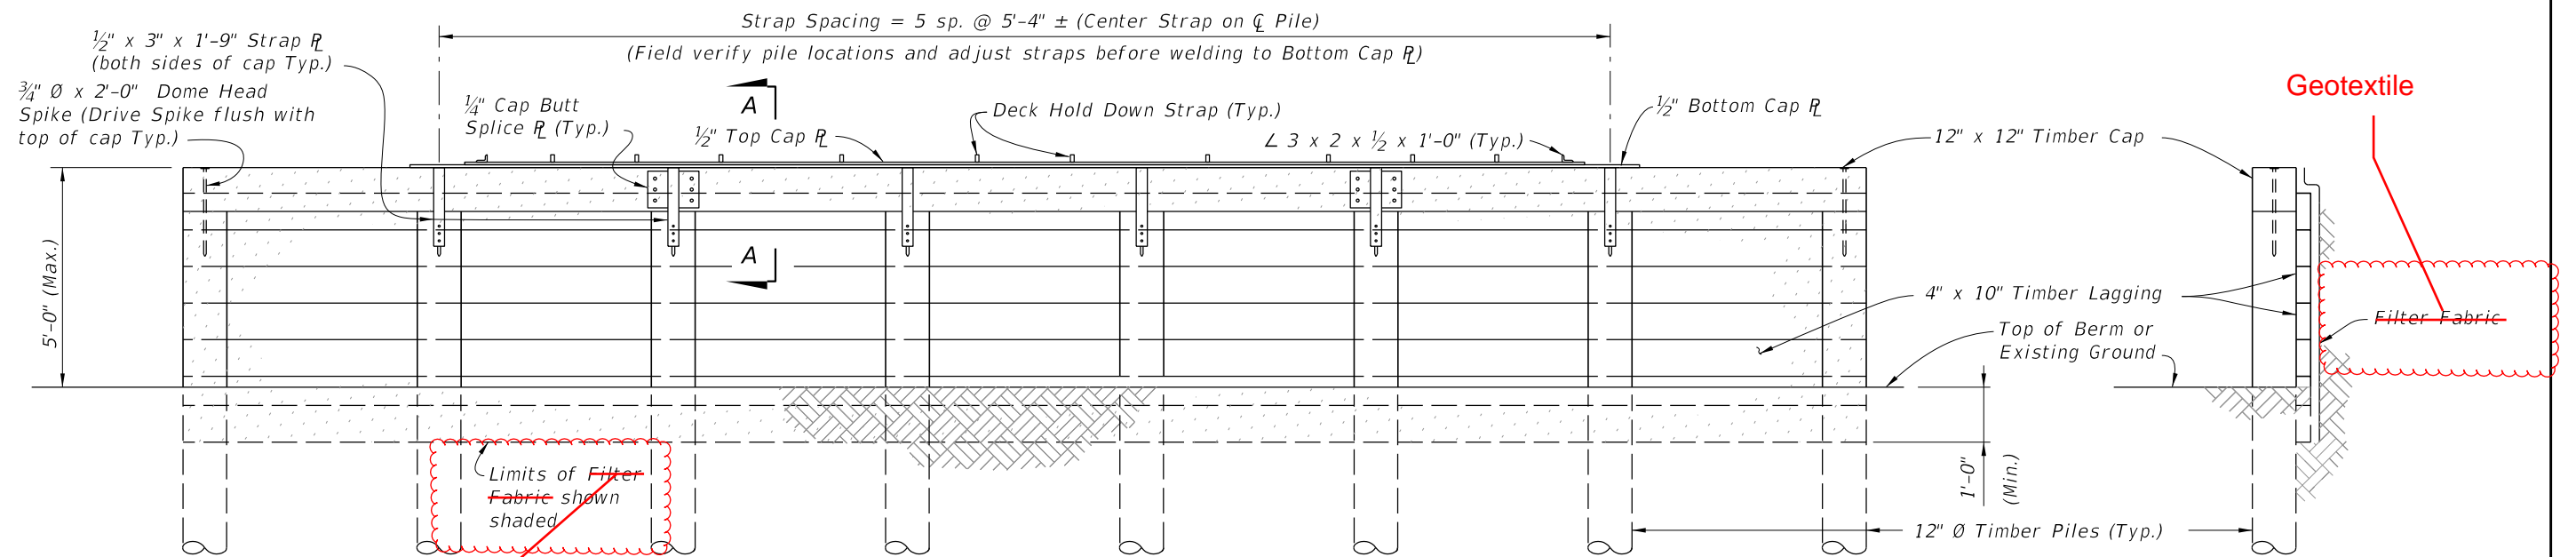


ELEVATION VIEW

END VIEW

BACKWALL BENT DETAILS


2026-27

LAST REVISION 07/01/06 11/01/25	REVISION	DESCRIPTION:	FDOT	FY 2025-26 STANDARD PLANS	TEMPORARY DETOUR BRIDGE TIMBER PILE FOUNDATIONS	INDEX 102-210	SHEET 2 of 3
--	----------	--------------	------	---	--	------------------	-----------------

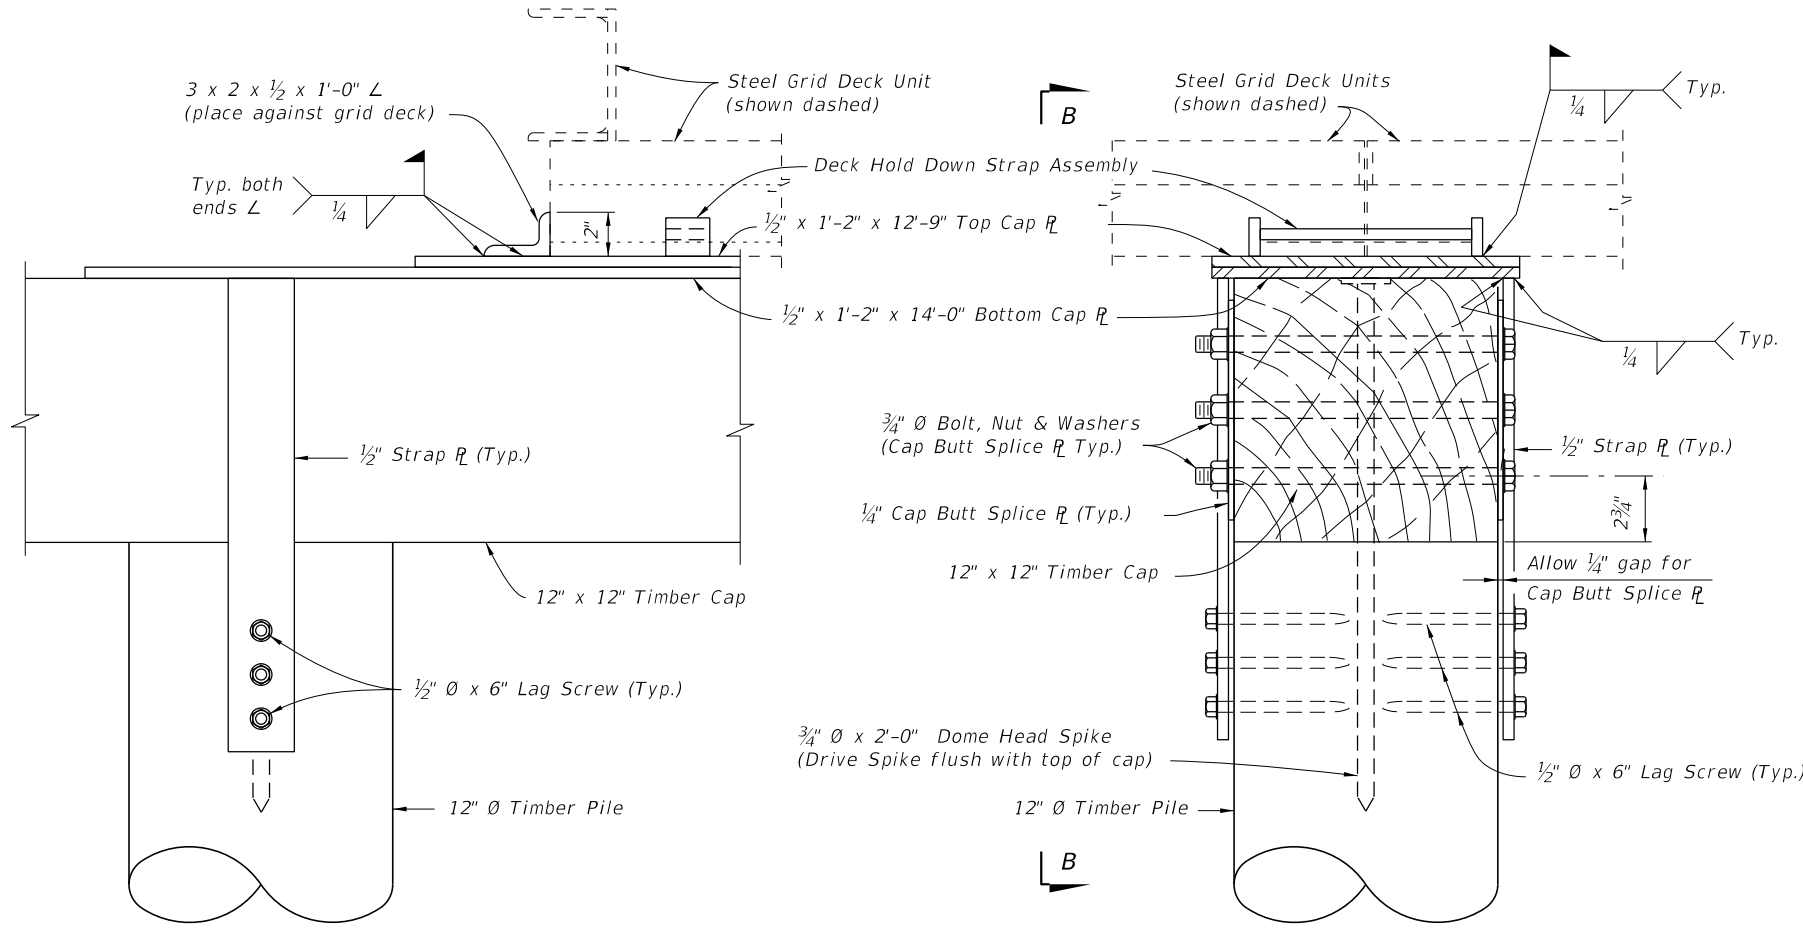


VIEW B-B
(SHOWING END OF CAP PLATES)


SECTION A-A

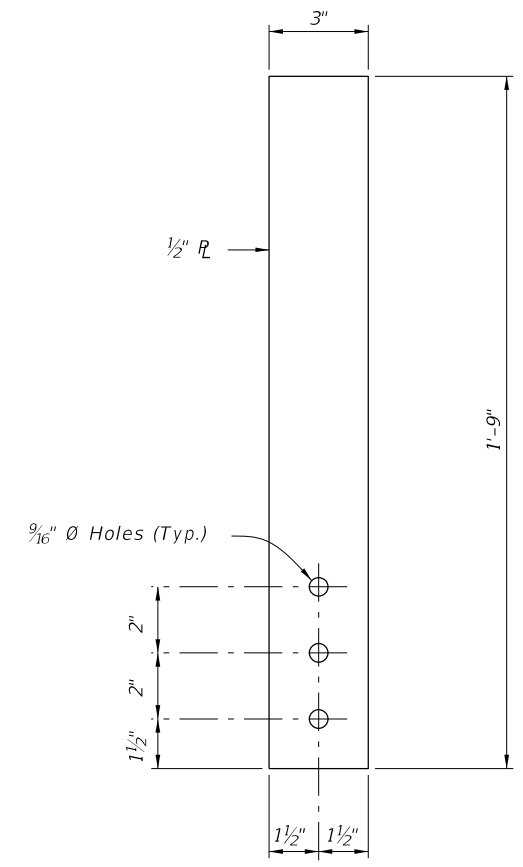

STRAP PLATE DETAIL

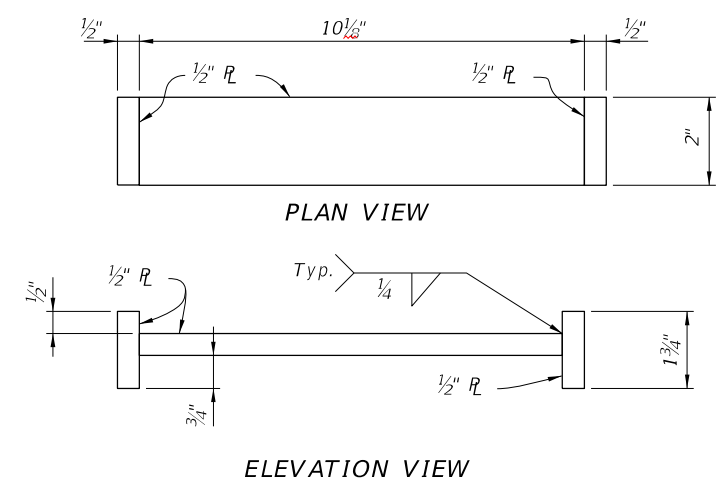



HOLD DOWN STRAP ASSEMBLY DETAIL

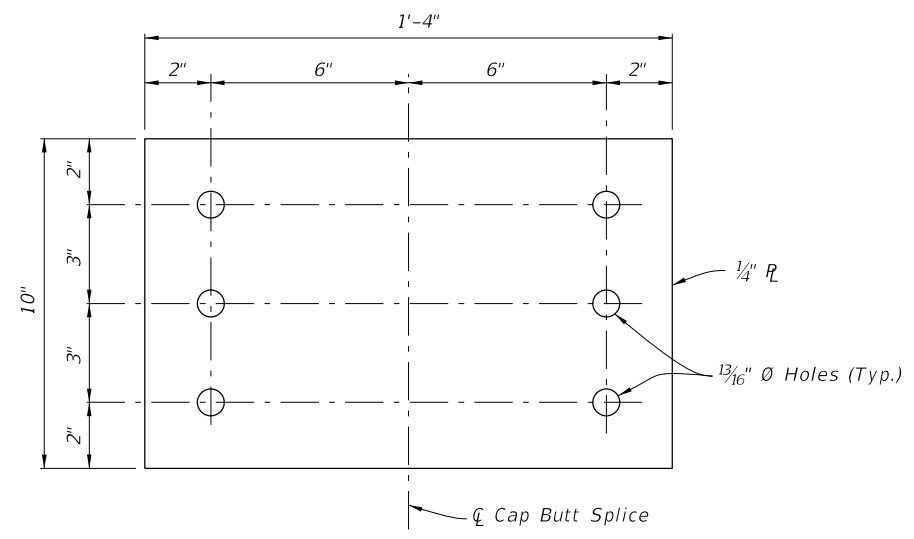


CAP BUTT SPLICE PLATE DETAIL

BACKWALL BENT DETAILS
2026-27

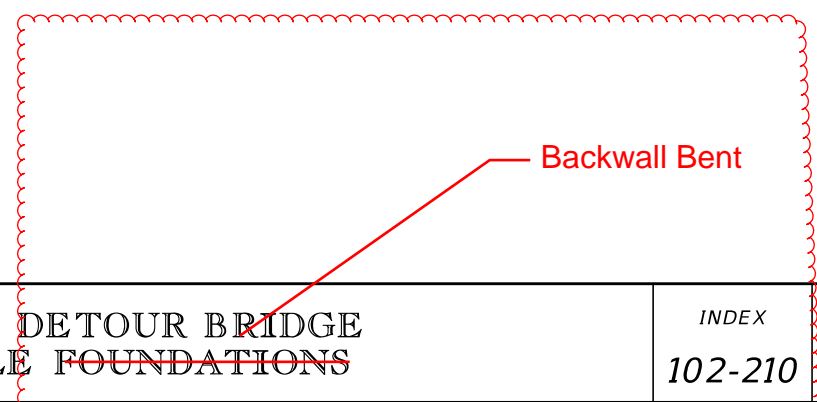

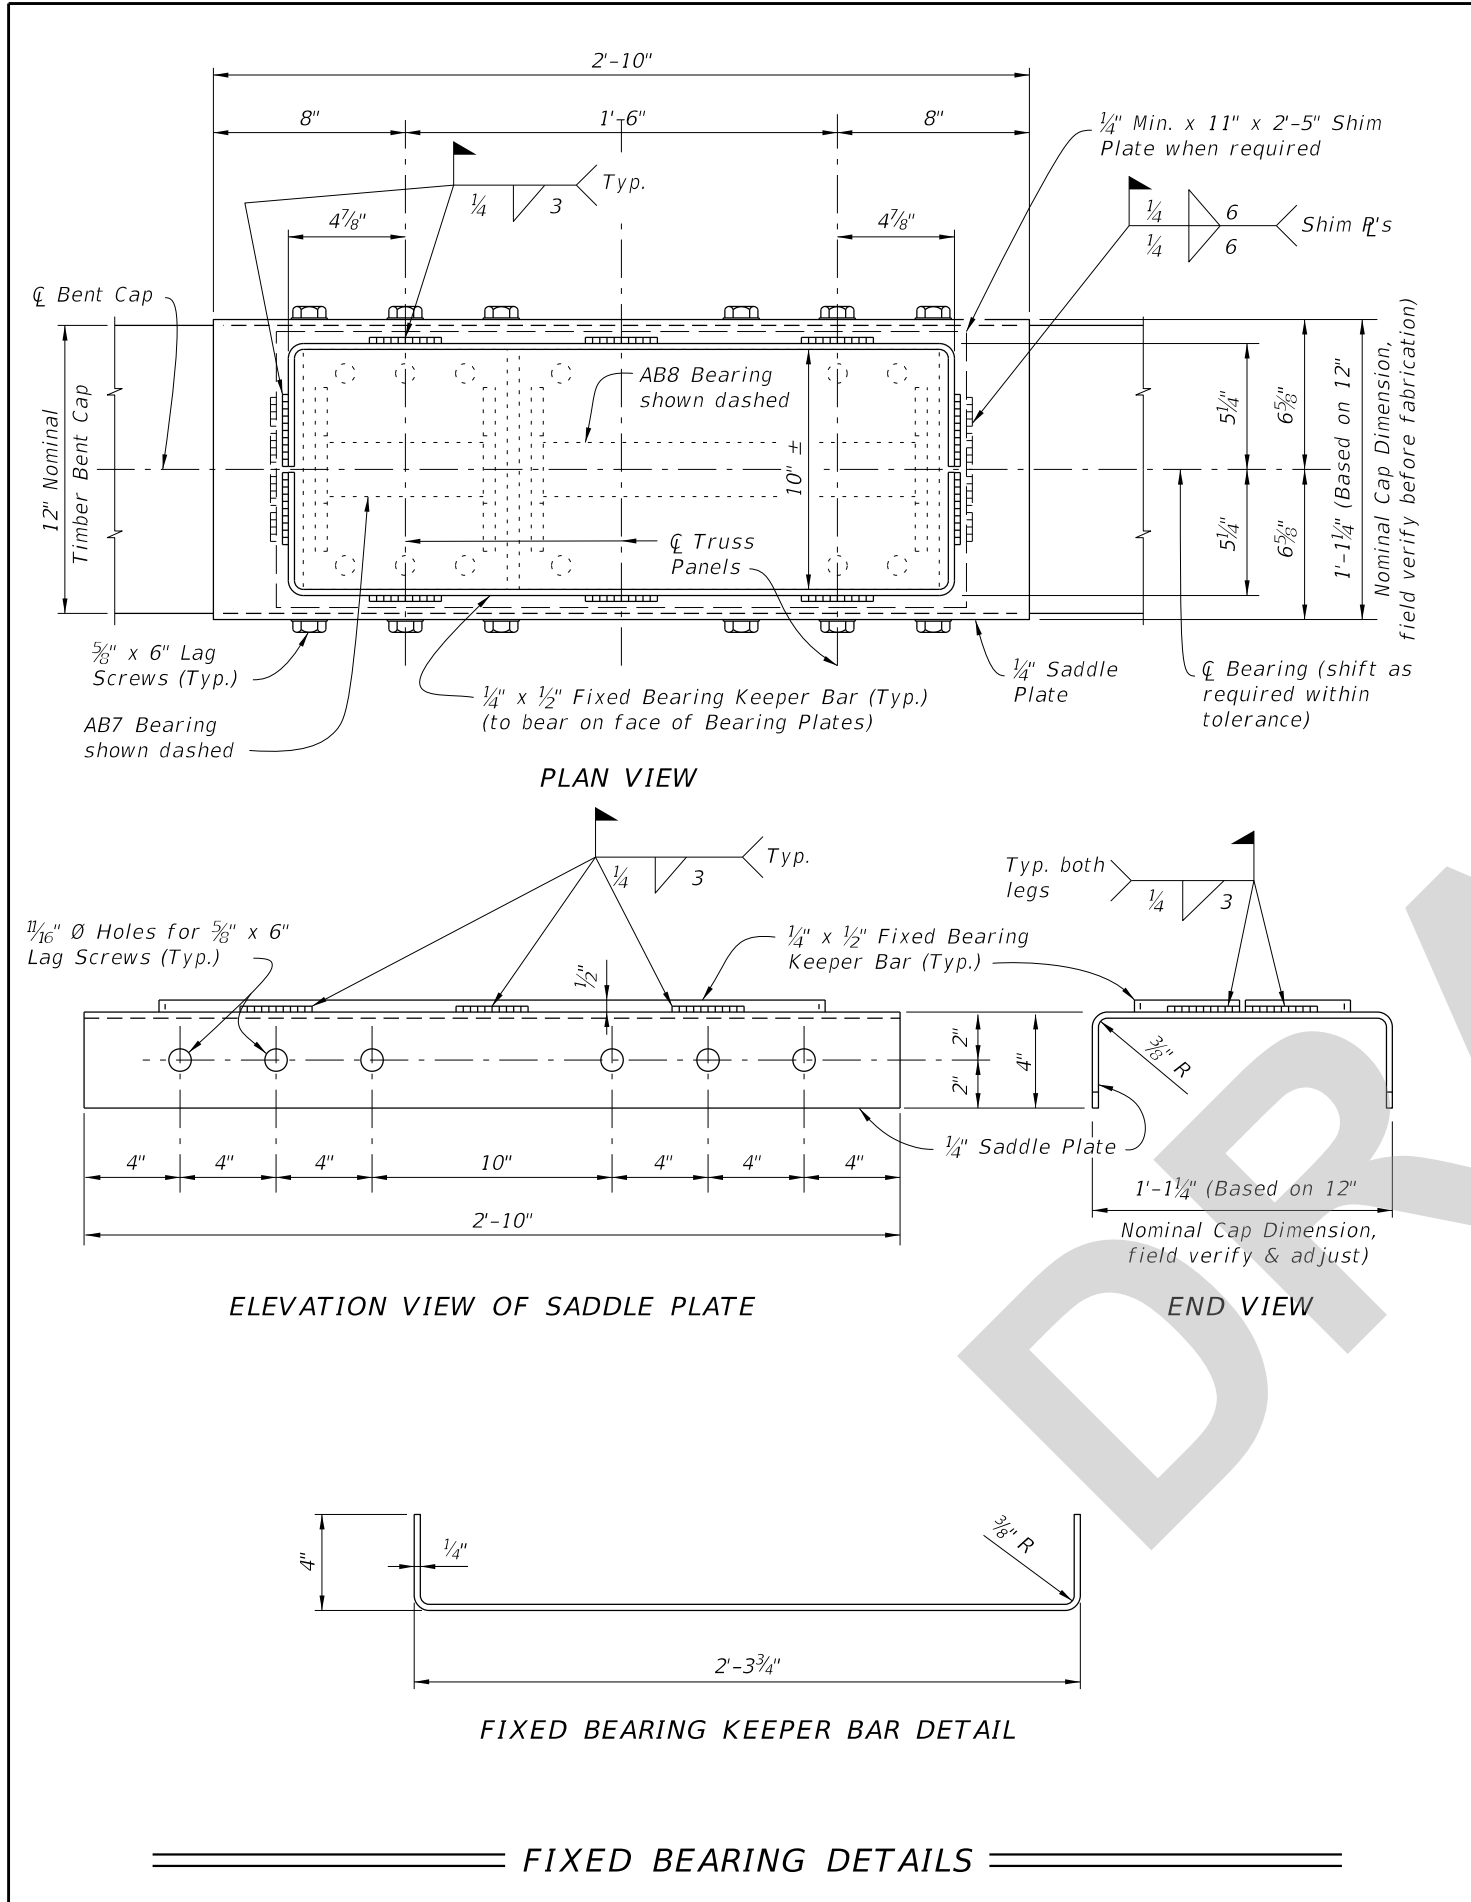


FIXED BEARING DETAILS

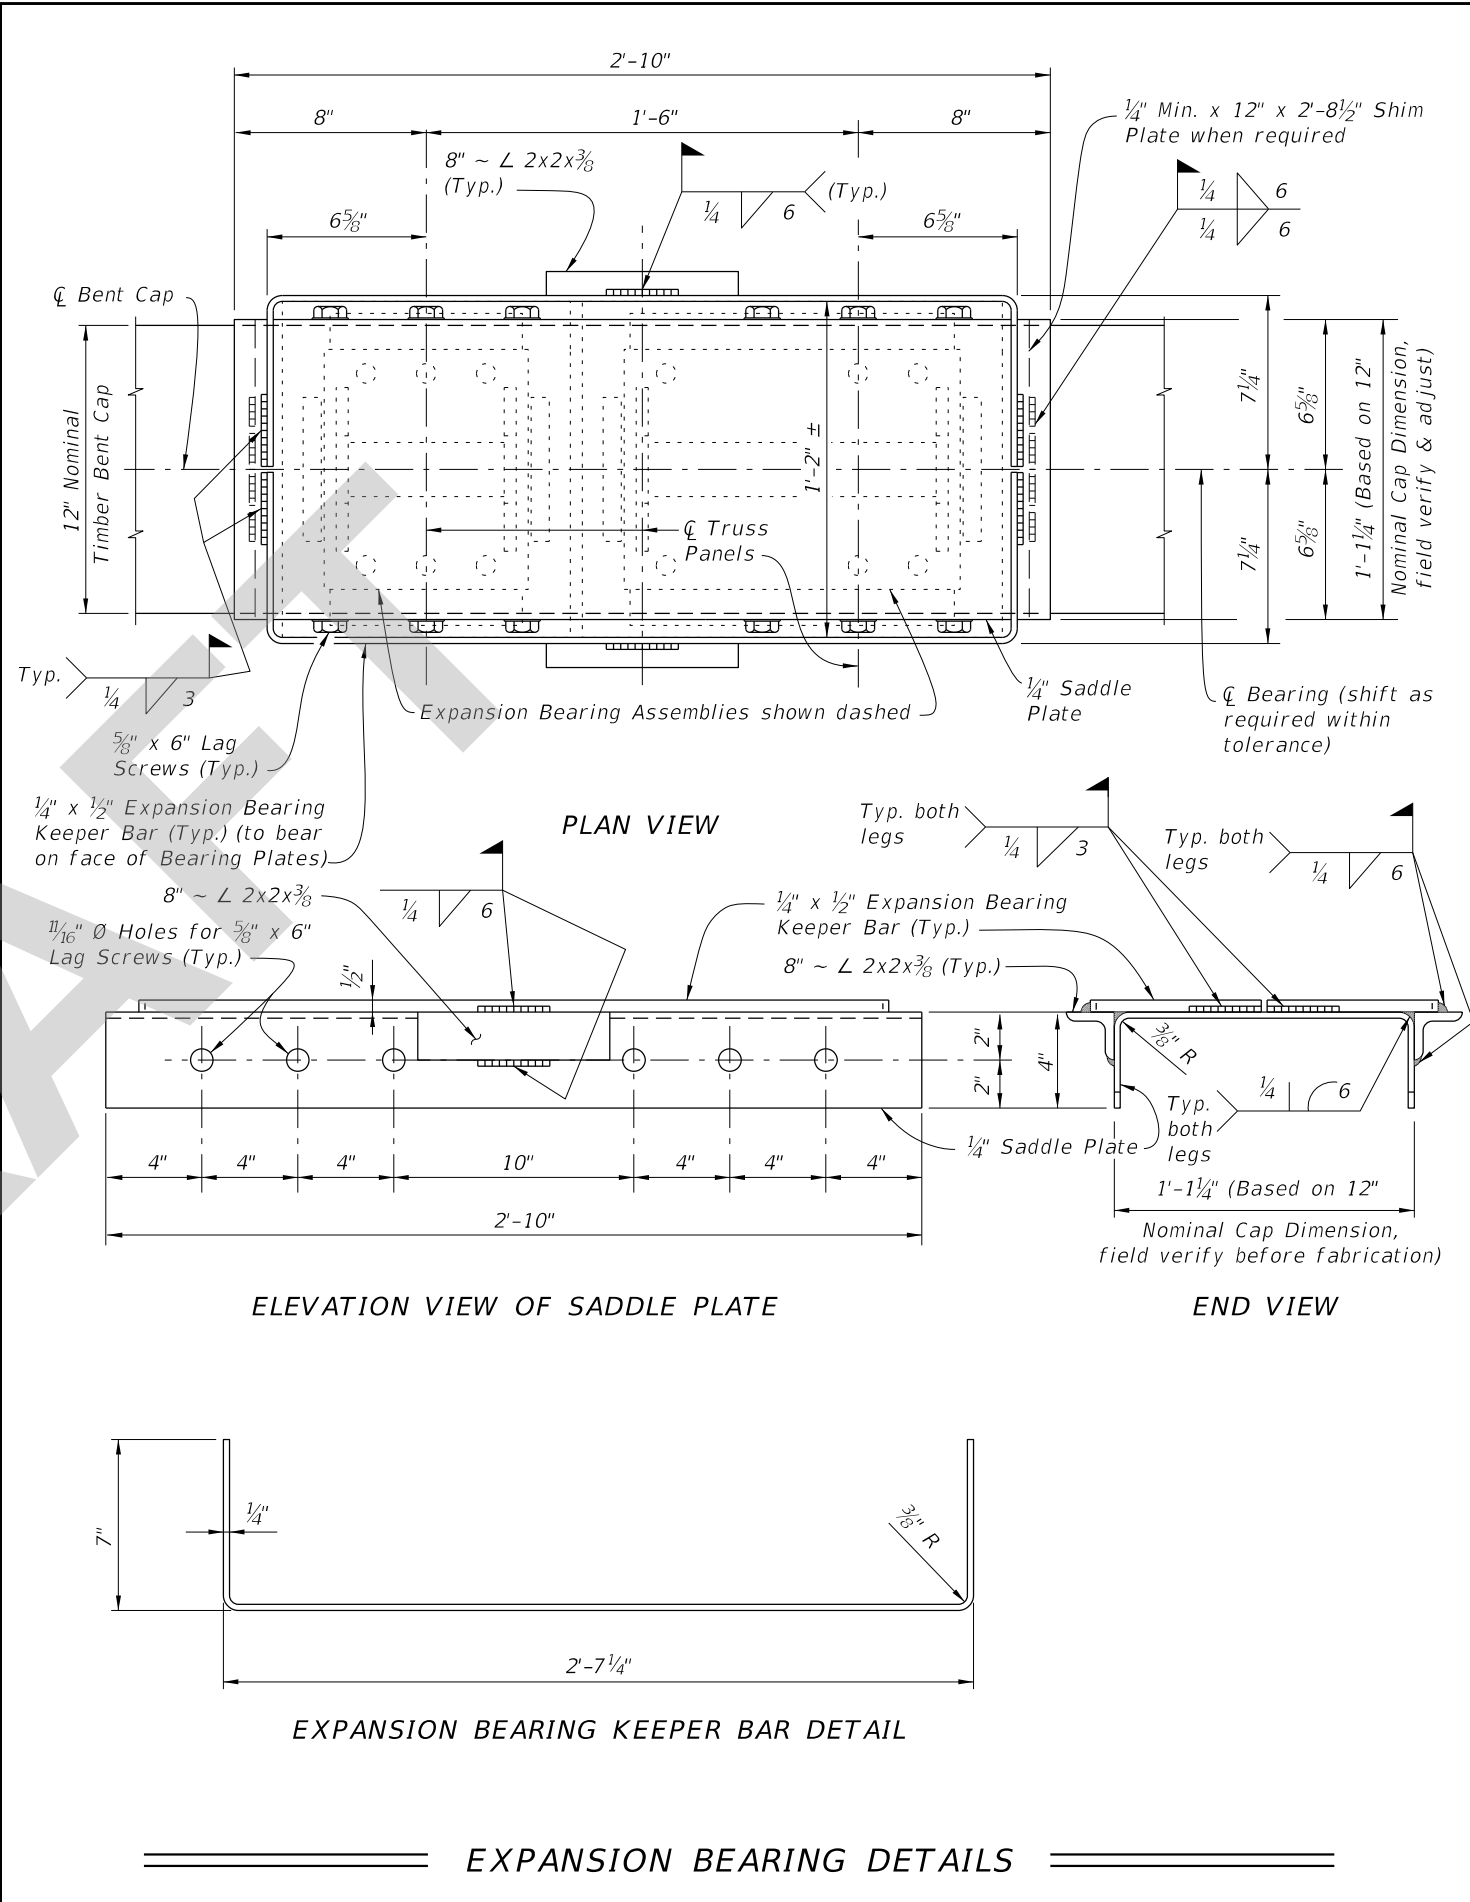


EXPANSION BEARING DETAILS

5/23/2025 12:13:13 PM

<p>LAST REVISION 11/01/25</p>	<p>DESCRIPTION:</p>	<p>FDOT FY 2026-27 STANDARD PLANS</p>	<p>TEMPORARY DETOUR BRIDGE TIMBER PILE BACKWALL BENT</p>	<p>INDEX 102-210</p>	<p>SHEET 1 of 3</p>
---------------------------------------	---------------------	---	--	--------------------------	-------------------------

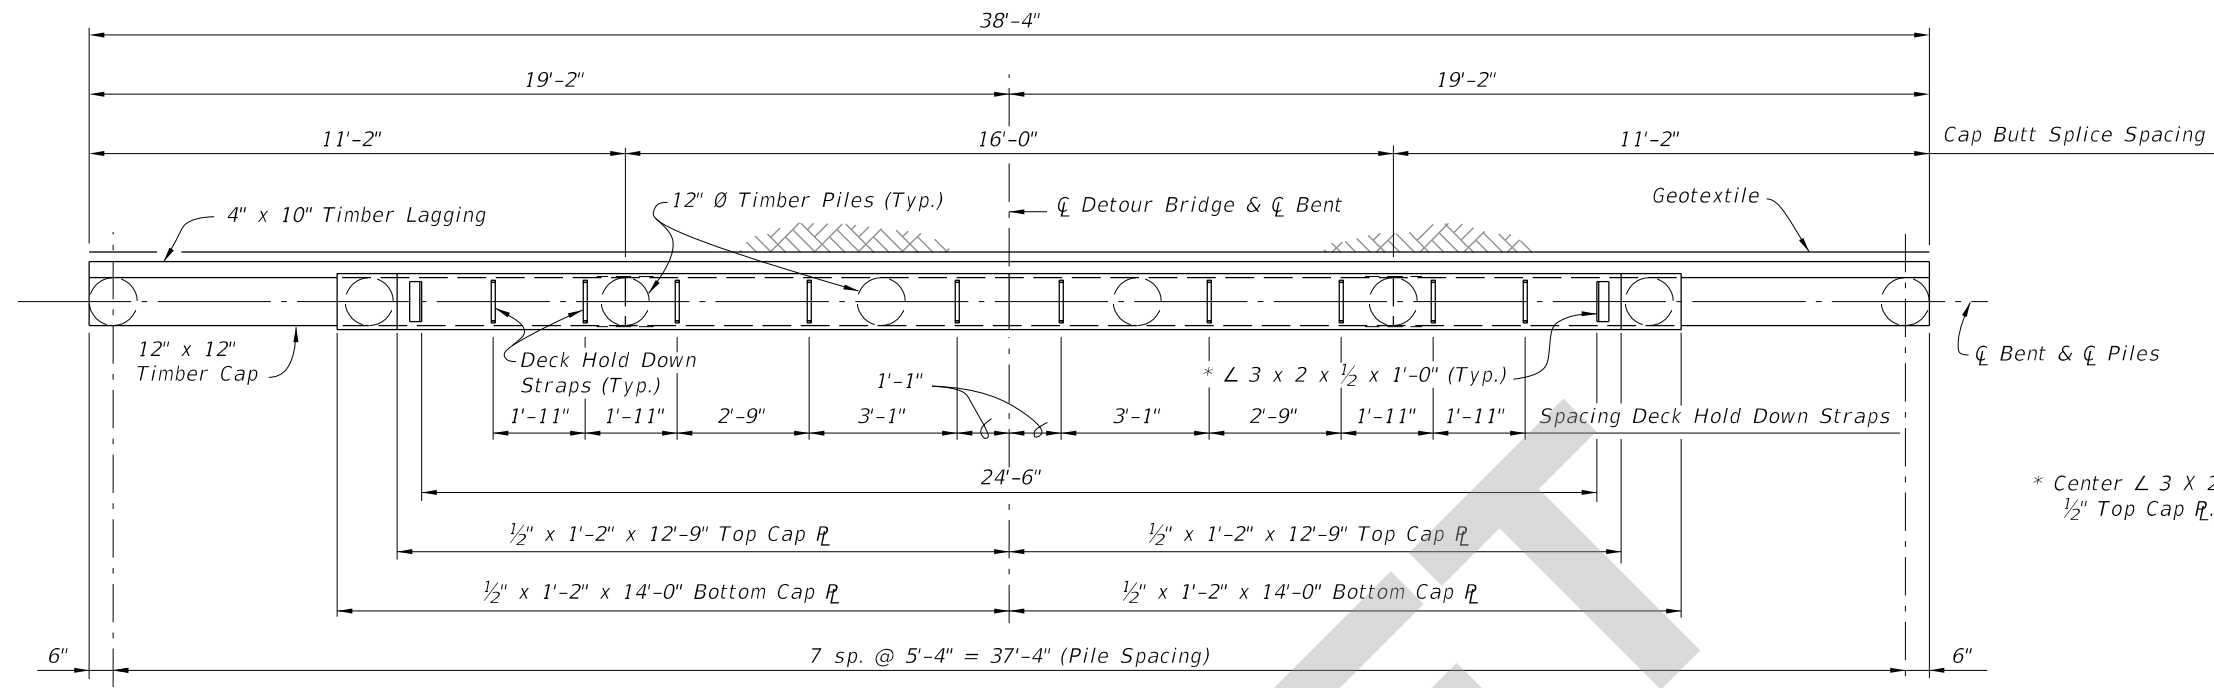

PLAN VIEW

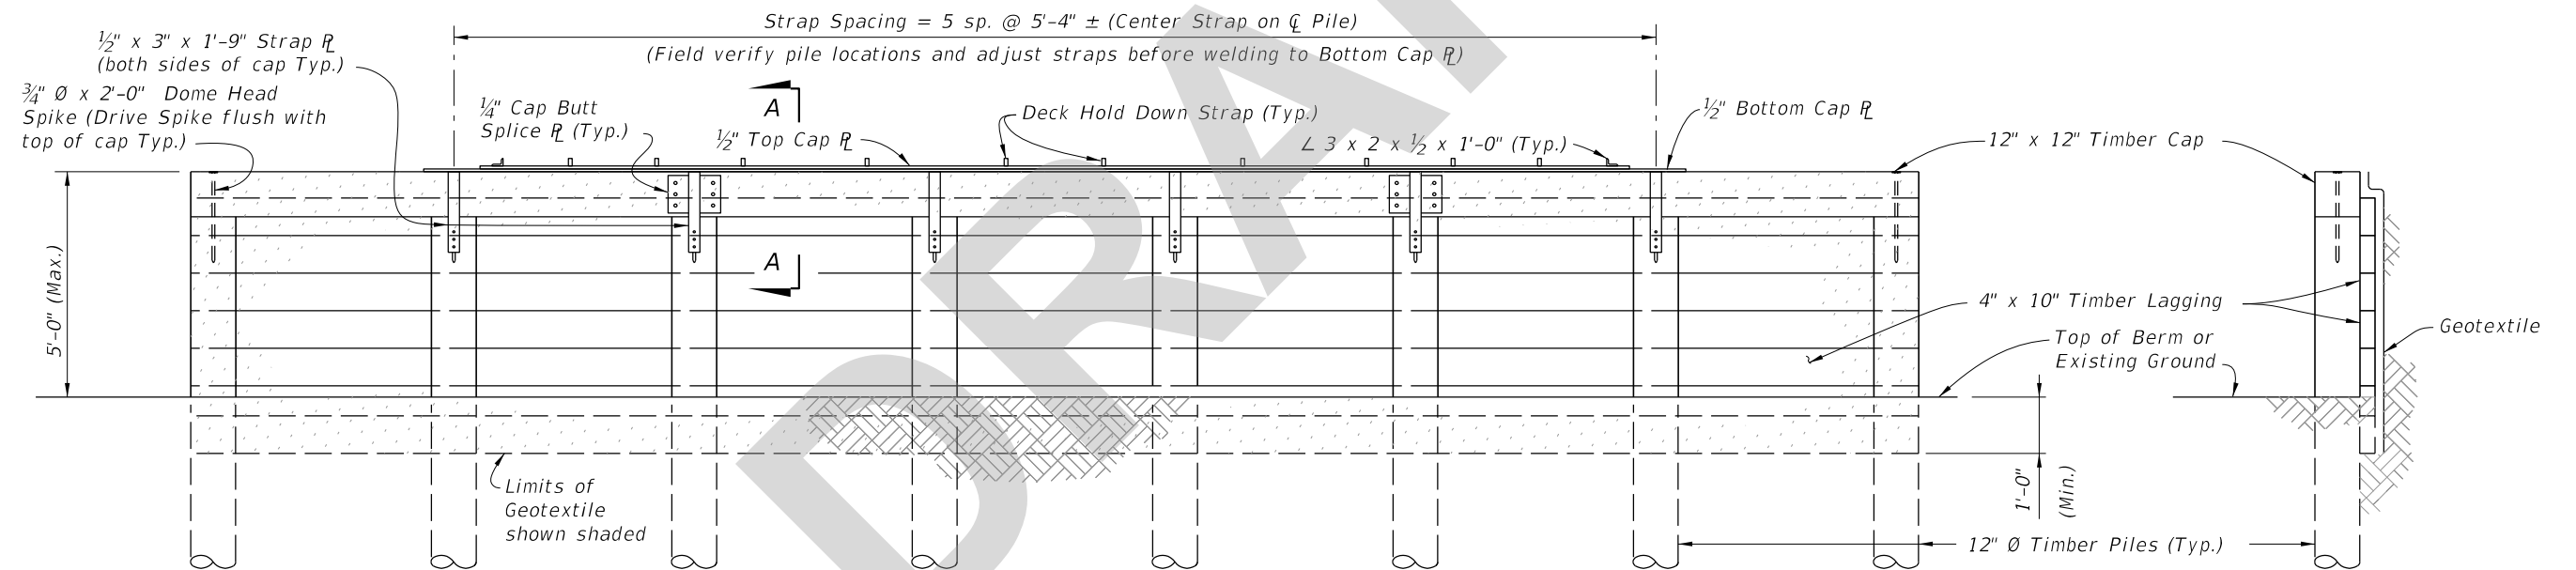

ELEVATION VIEW


END VIEW

BACKWALL BENT DETAILS

5/23/2025 12:13:44 PM

LAST REVISION 11/01/25	REVISION	DESCRIPTION:	FDOT FY 2026-27 STANDARD PLANS	TEMPORARY DETOUR BRIDGE TIMBER PILE BACKWALL BENT	INDEX 102-210	SHEET 2 of 3
------------------------------	----------	--------------	--------------------------------------	--	------------------	-----------------

5/23/2025 12:14:10 PM

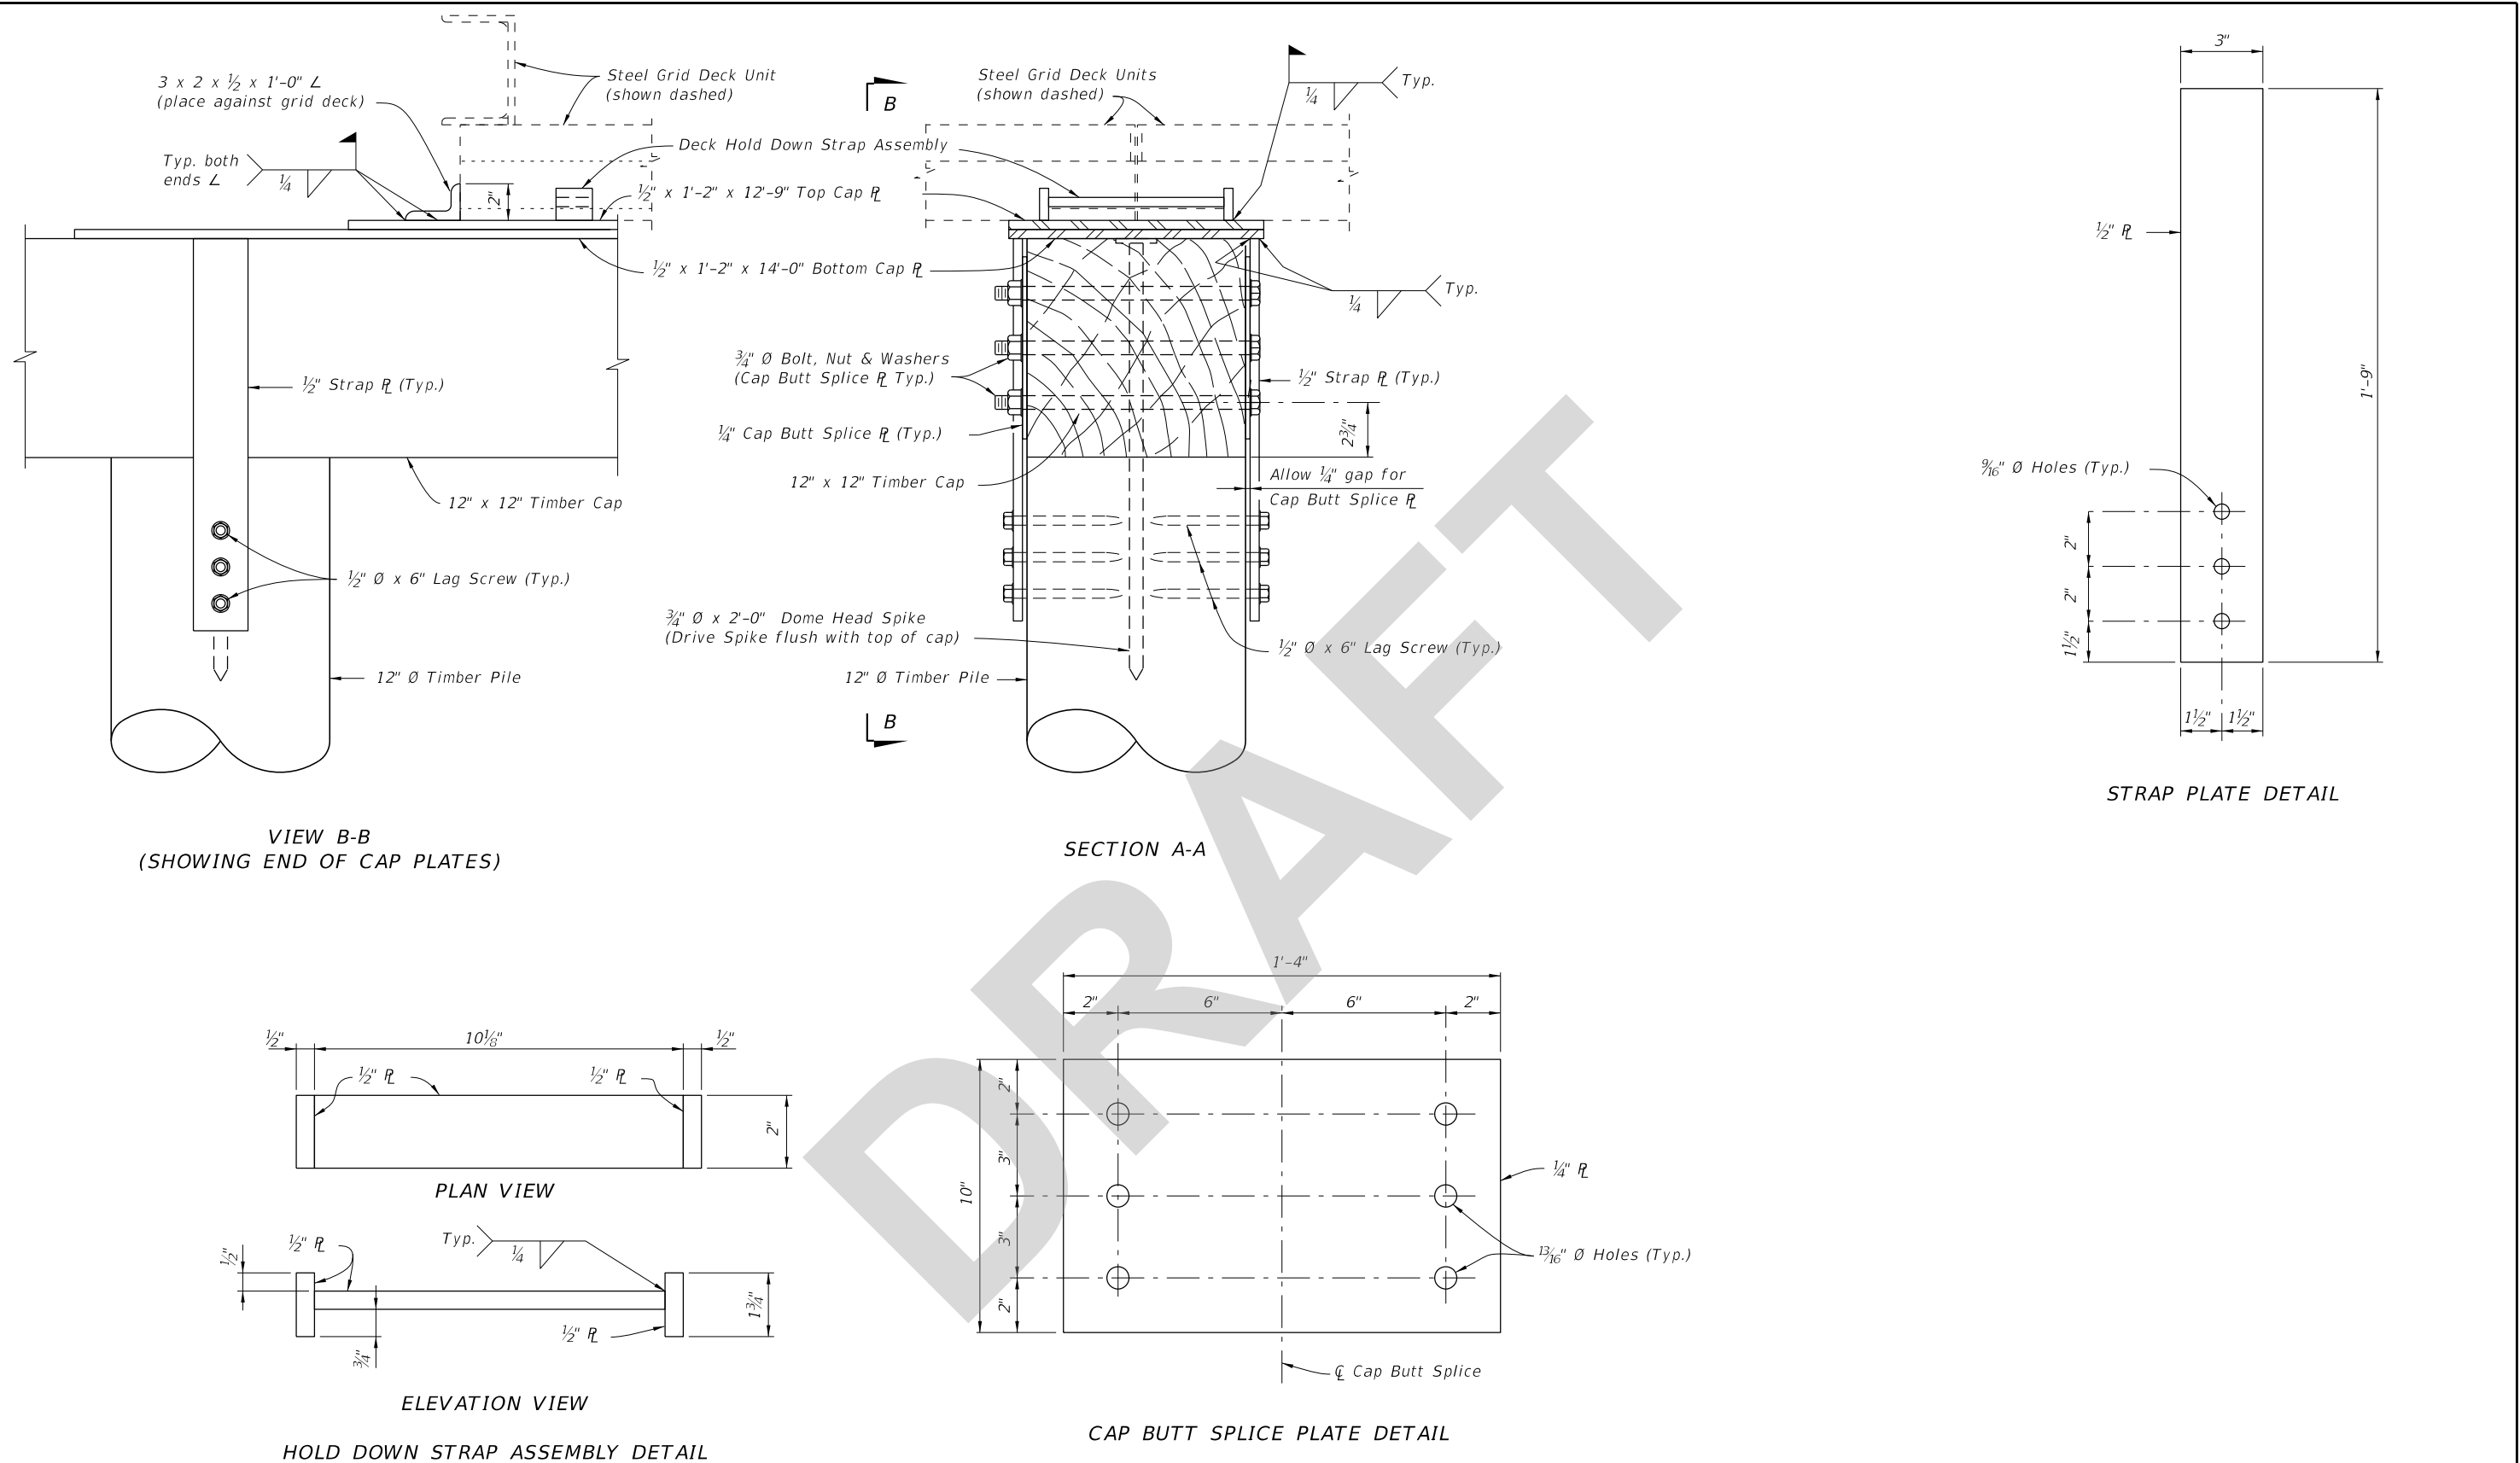

BACKWALL BENT DETAILS

LAST REVISION 11/01/25	REVISION	DESCRIPTION:	FDOT FY 2026-27 STANDARD PLANS	TEMPORARY DETOUR BRIDGE TIMBER PILE BACKWALL BENT	INDEX 102-210	SHEET 3 of 3
------------------------------	----------	--------------	--------------------------------------	--	------------------	-----------------