

**Origination Form**  
Proposed Revisions to a Standard Plans Index

<b>Originator:</b>	Stepp, Richard	<b>Index Number:</b>	536-002
<b>Date:</b>	2/14/2025	<b>Sheet Number(s):</b>	2
<b>E-mail:</b>	richard.stepp@dot.state.fl.us	<b>Index Title:</b>	GUARDRAIL TRANSITIONS AND CONNECTIONS FOR EXISTING BRIDGES

**Summary of the changes:**

Updated "Trailing Anchorage Type II" callout in the DIVIDED ROADWAY - DETAILS I and T to "Trailing Anchorage".


**Commentary/Background:**

"Type II" is an outdated reference and refers to a previous Trailing Anchorage type that no longer applies. Term changed with recent MASH design update in Index 536-001.

Other Affected Documents/Offices	Person Contacted	Affected (Yes/No)
Other Standard Plans		No
FDOT Design Manual		No
Standard Specifications		No
Basis of Estimates Manual		No
Approved Product List		No
Construction Office		No
Maintenance Office		No


**Implementation**

FY-Standard Plans (Next Release)

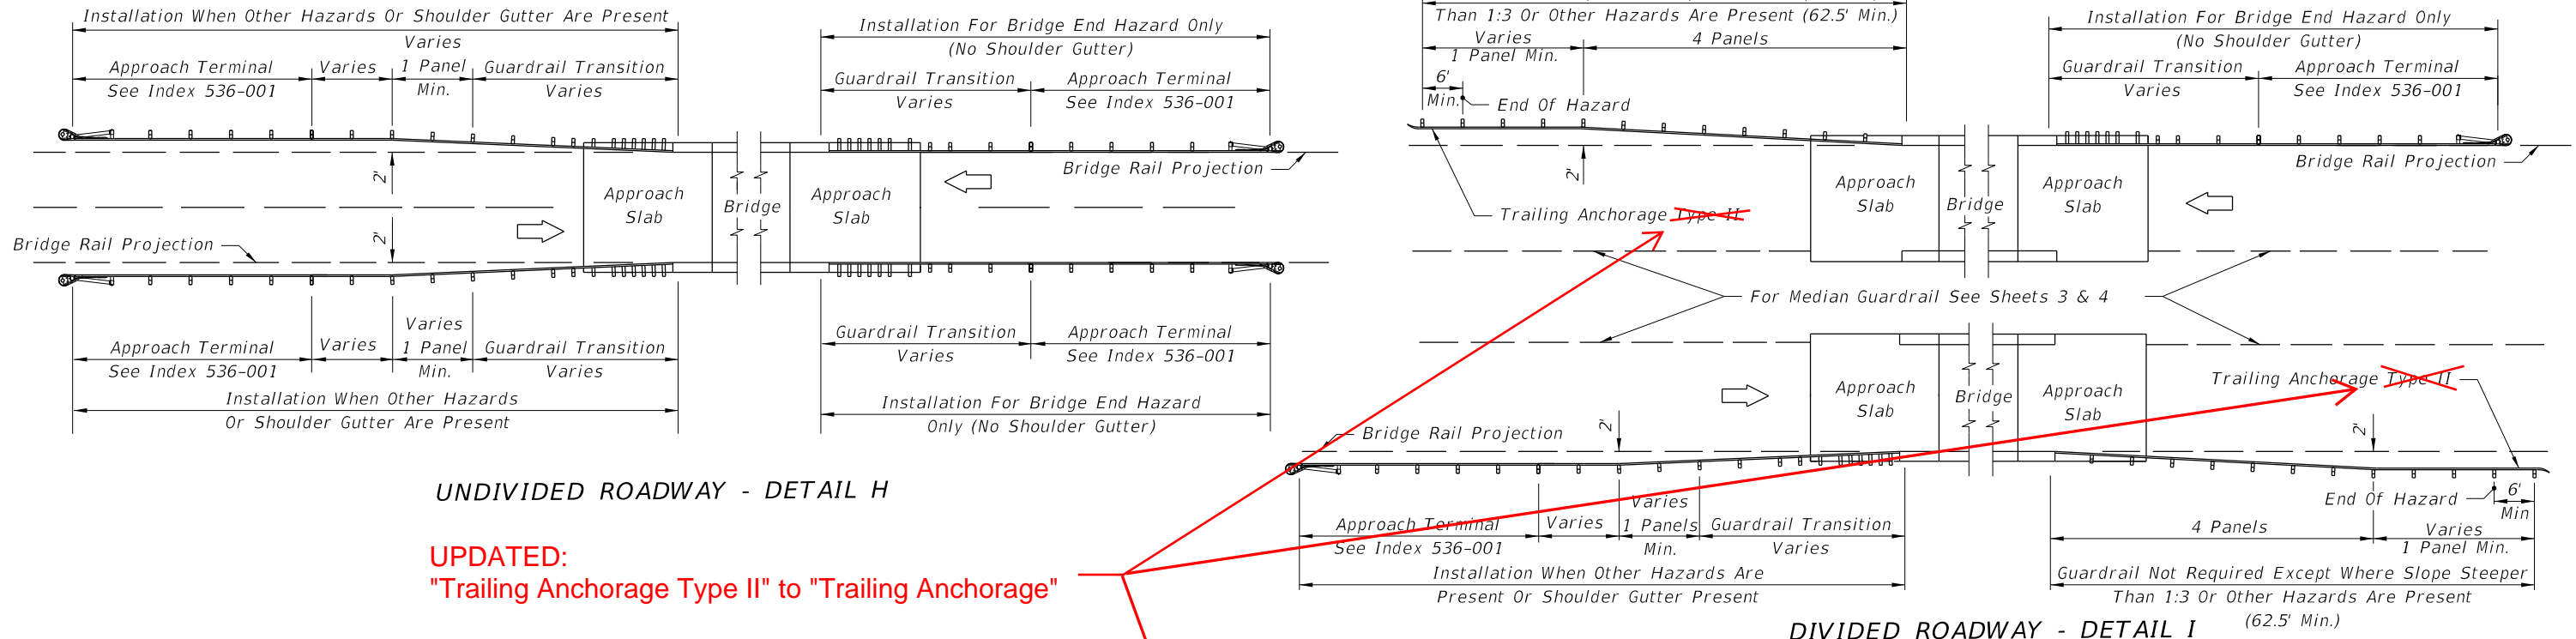

UPDATED:  
"Trailing Anchorage Type II" to "Trailing Anchorage"

**GUARDRAIL APPLICATIONS FOR BRIDGES WITH FULL WIDTH SHOULDERS AND SAFETY SHAPE TRAFFIC RAILING BARRIER EXTENDING LESS THAN FULL APPROACH SLAB LENGTH**

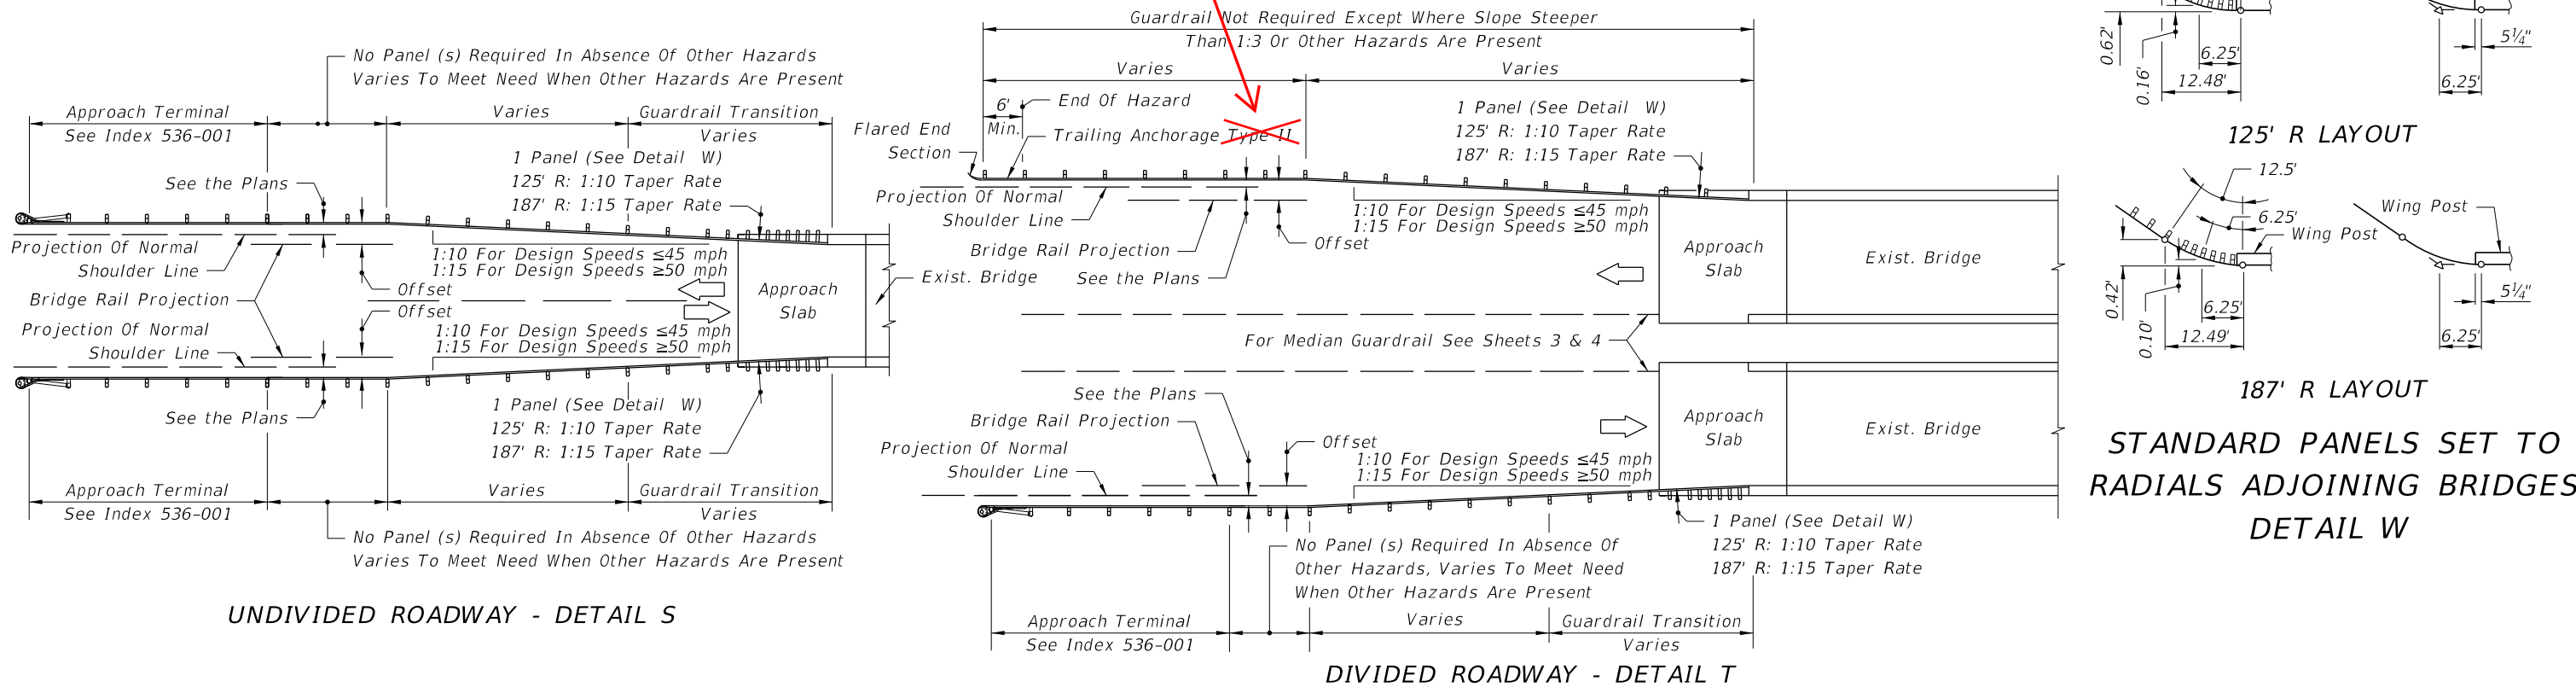


**GUARDRAIL APPLICATIONS FOR BRIDGES WITH LESS THAN FULL WIDTH SHOULDERS AND CONCRETE TRAFFIC RAILING EXTENDING LESS THAN FULL APPROACH SLAB LENGTH**


2026-27

9/10/2024 1:53:24 PM

LAST REVISION <del>11/01/19</del>	DESCRIPTION: 11/01/25	FDOT	FY <del>2025-26</del> STANDARD PLANS	GUARDRAIL TRANSITIONS AND CONNECTIONS FOR EXISTING BRIDGES	INDEX 536-002	SHEET 2 of 28
--------------------------------------	--------------------------	------	---	--	------------------	------------------

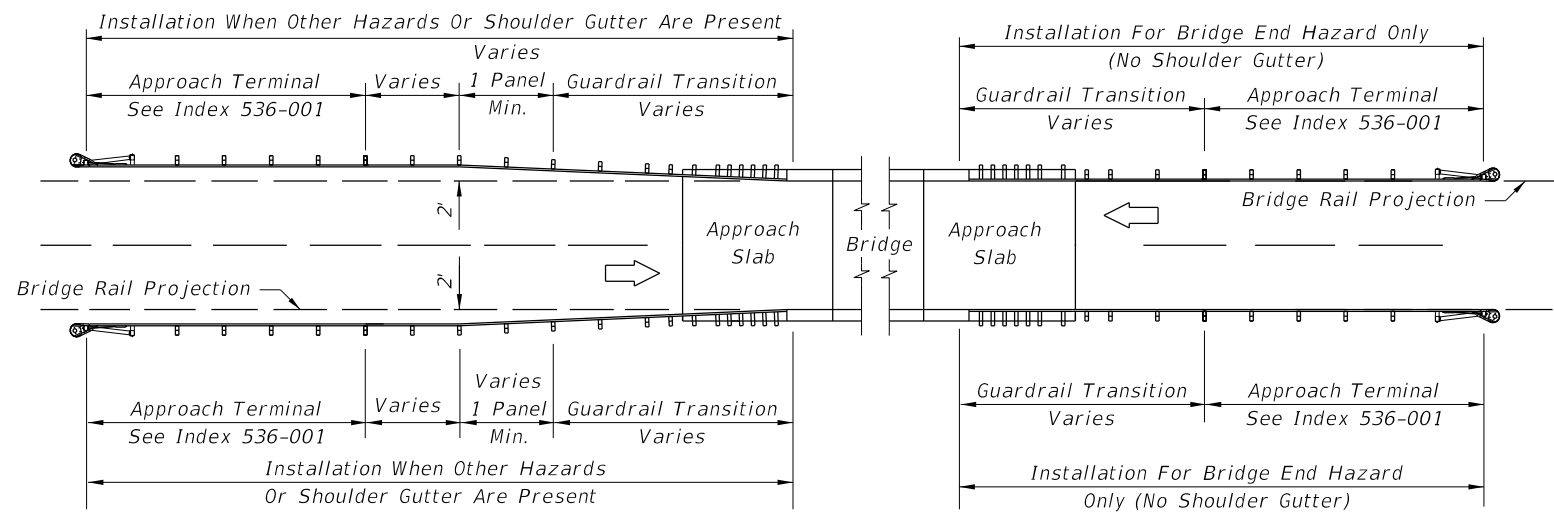


UNDIVIDED ROADWAY - DETAIL H

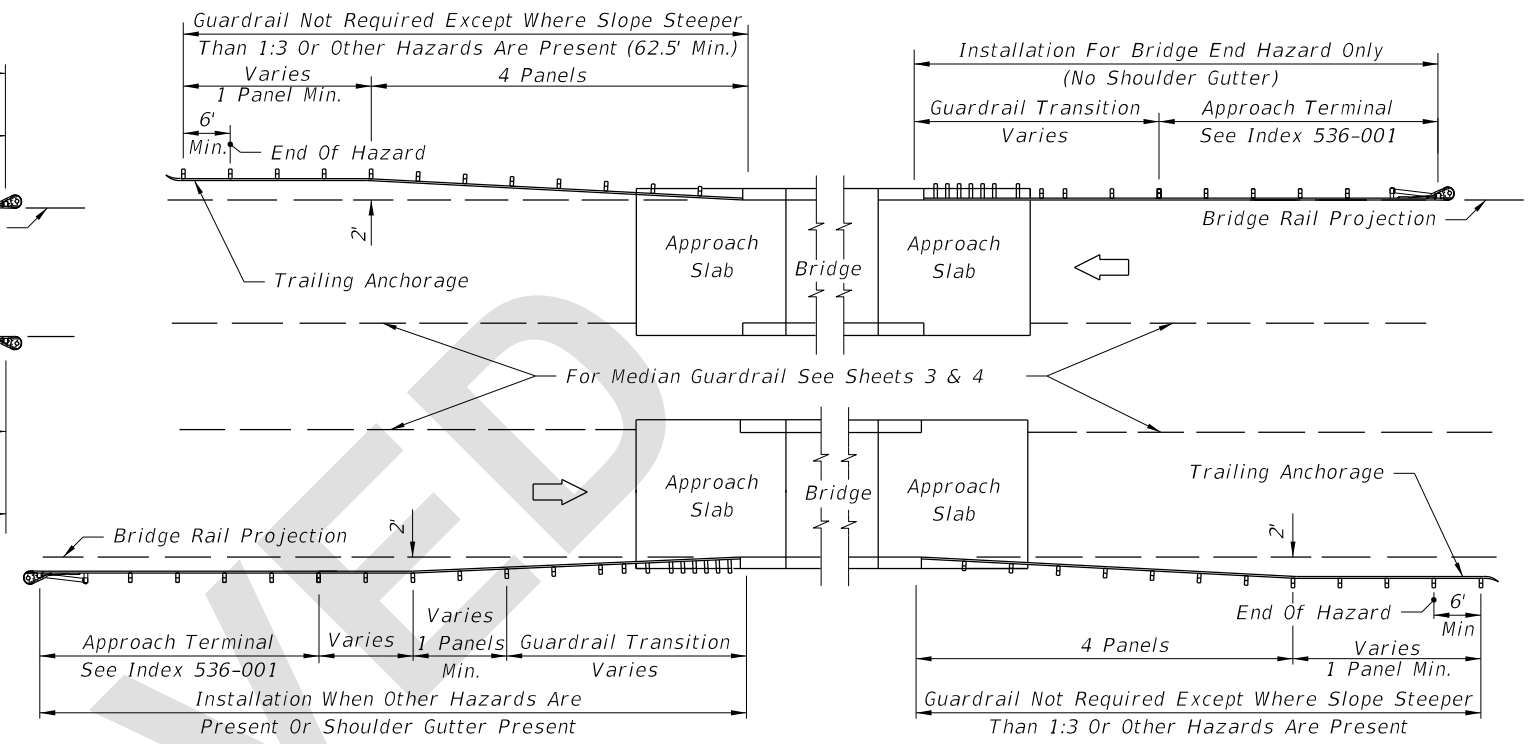

DIVIDED ROADWAY - DETAIL I


GUARDRAIL APPLICATIONS FOR BRIDGES WITH FULL WIDTH SHOULDERS AND SAFETY SHAPE TRAFFIC RAILING BARRIER EXTENDING LESS THAN FULL APPROACH SLAB LENGTH

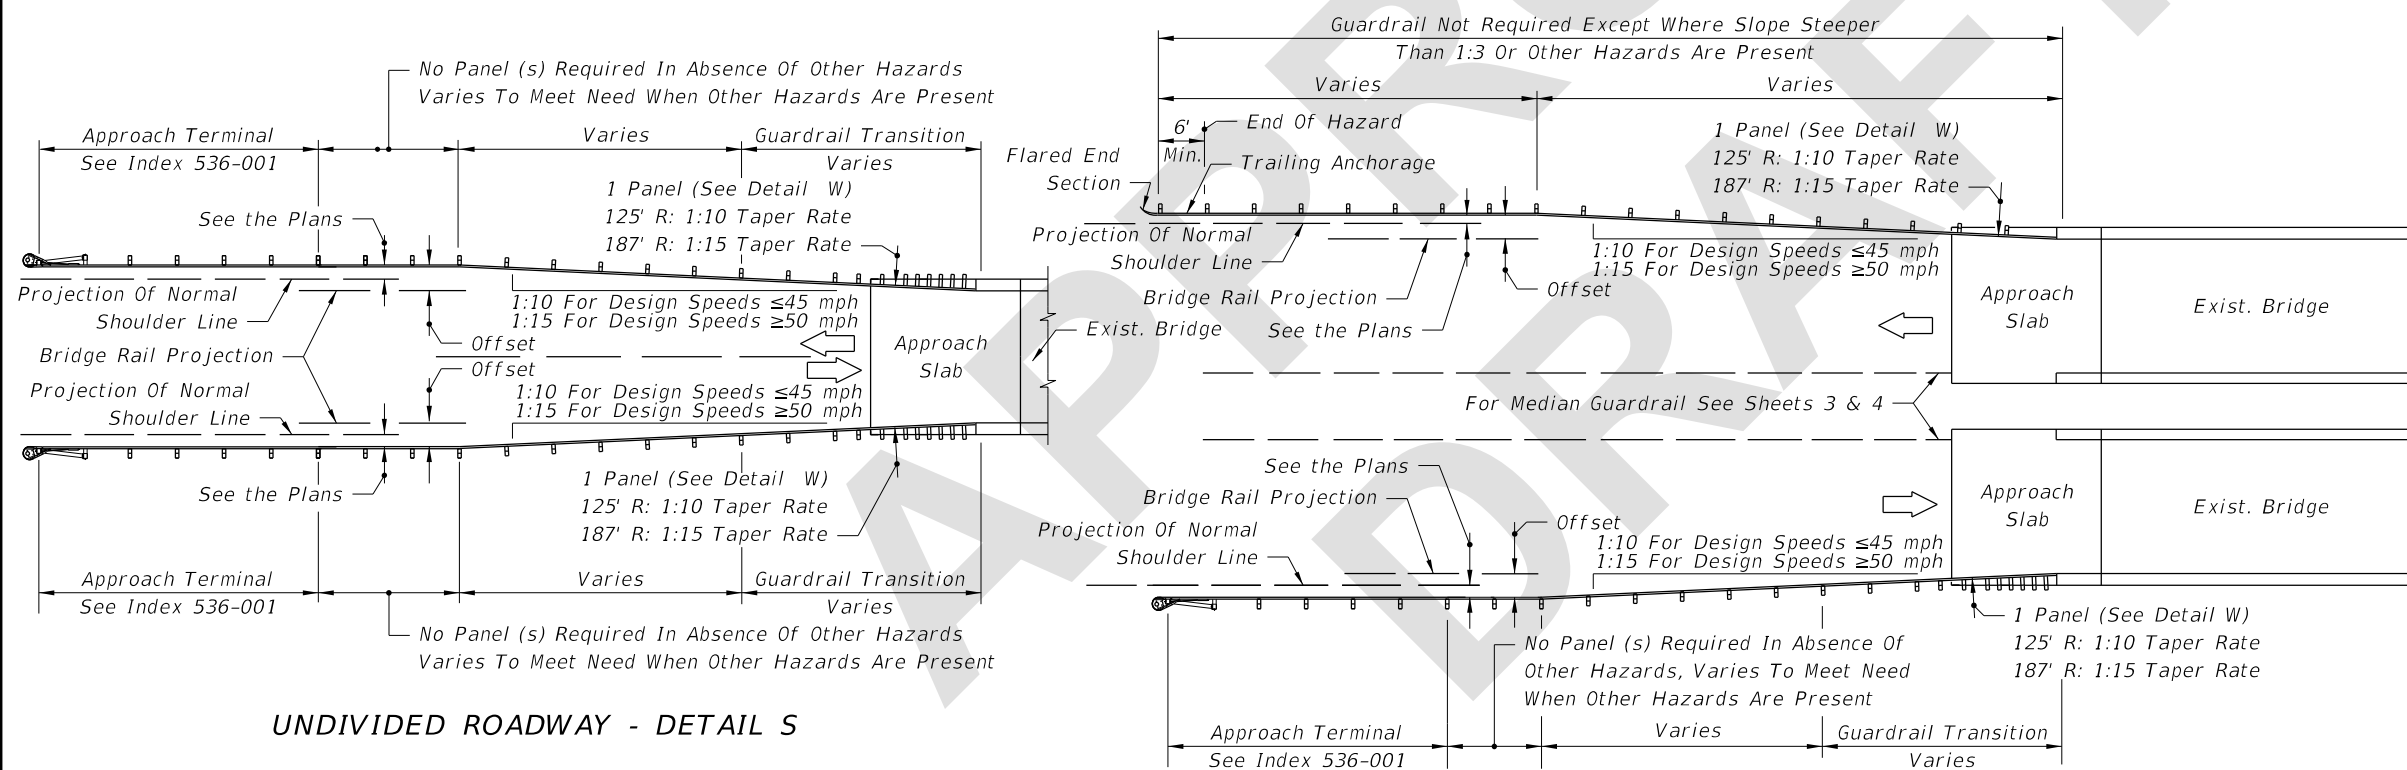


UNDIVIDED ROADWAY - DETAIL S

DIVIDED ROADWAY - DETAIL T

GUARDRAIL APPLICATIONS FOR BRIDGES WITH LESS THAN FULL WIDTH SHOULDERS AND CONCRETE TRAFFIC RAILING EXTENDING LESS THAN FULL APPROACH SLAB LENGTH

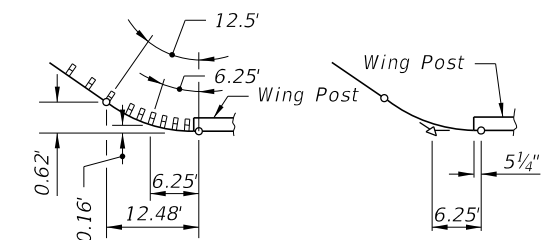


125' R LAYOUT

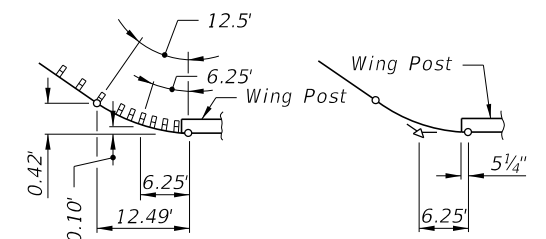

187' R LAYOUT

STANDARD PANELS SET TO RADIALS ADJOINING BRIDGES  
DETAIL W

7/21/2025 8:58:29 AM

LAST REVISION 11/01/25	REVISION	DESCRIPTION:		FY 2026-27 STANDARD PLANS	GUARDRAIL TRANSITIONS AND CONNECTIONS FOR EXISTING BRIDGES	INDEX 536-002	SHEET 2 of 28
---------------------------	----------	--------------	---	------------------------------	---	------------------	------------------