

Origination Form
 Proposed Revisions to a Standard Plans Index


Originator:	Gray, Ryan	Index Number:	711-001
Date:	4/30/2025	Sheet Number(s):	7
E-mail:	ryan.gray@dot.state.fl.us	Index Title:	PAVEMENT MARKINGS

Summary of the changes:
 Added Drivable Base option to Detail "A"; Updated Notes 1 and 2


Commentary/Background:
 Additional attachment types for Tubular Markers in grassed medians are being requested by Industry.

Other Affected Documents/Offices	Person Contacted	Affected (Yes/No)
Other Standard Plans		No
FDOT Design Manual		No
Standard Specifications		No
Basis of Estimates Manual		No
Approved Product List		No
Construction Office		No
Maintenance Office		No

Implementation
 FY 2026-27

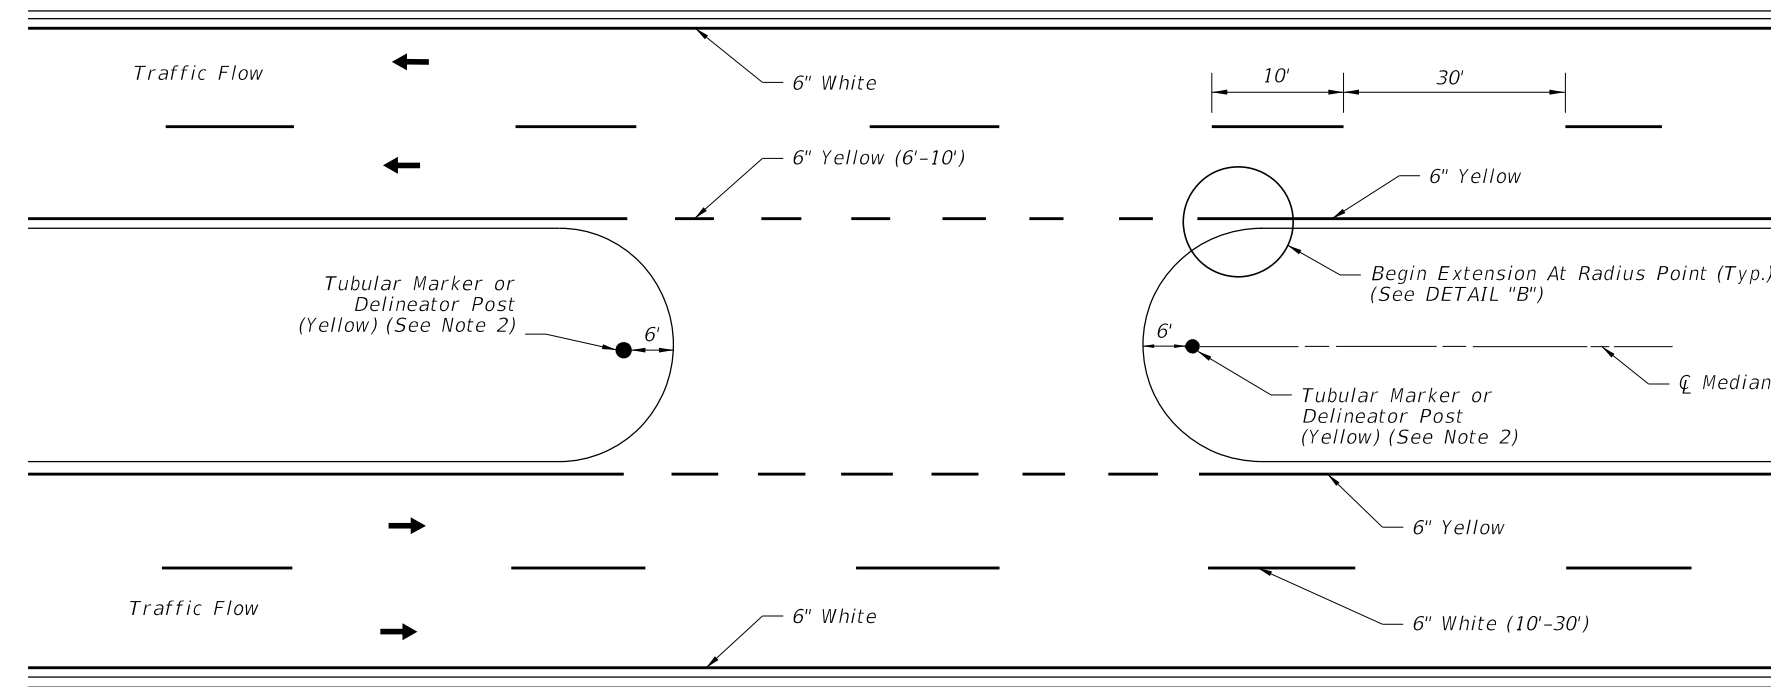


Added "Drivable Base" example to Detail "A"

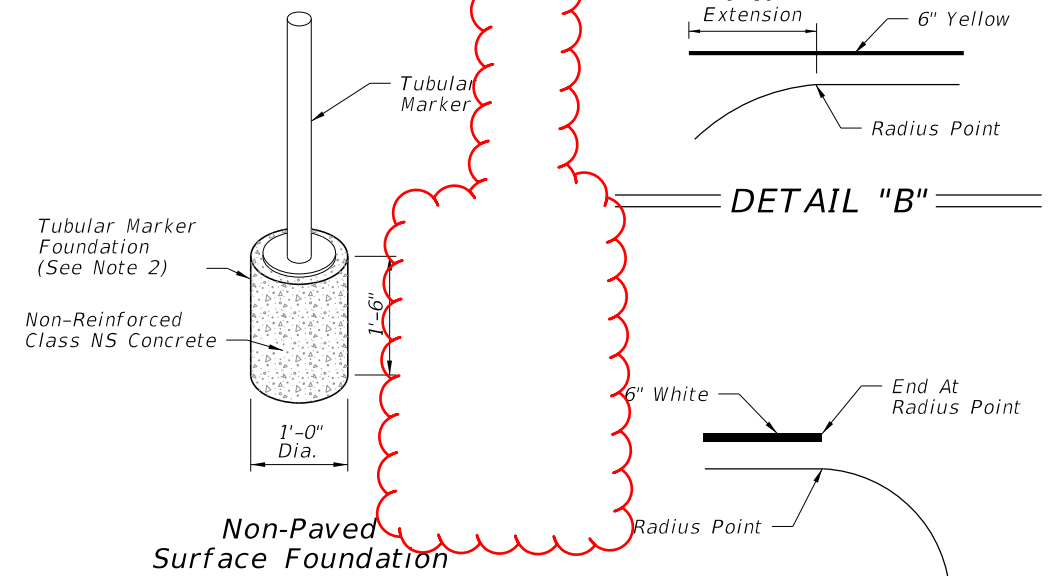

PAVEMENT MARKINGS AND DELINEATORS FOR MEDIAN CROSSOVER

DETAIL "A"

DETAIL "C"

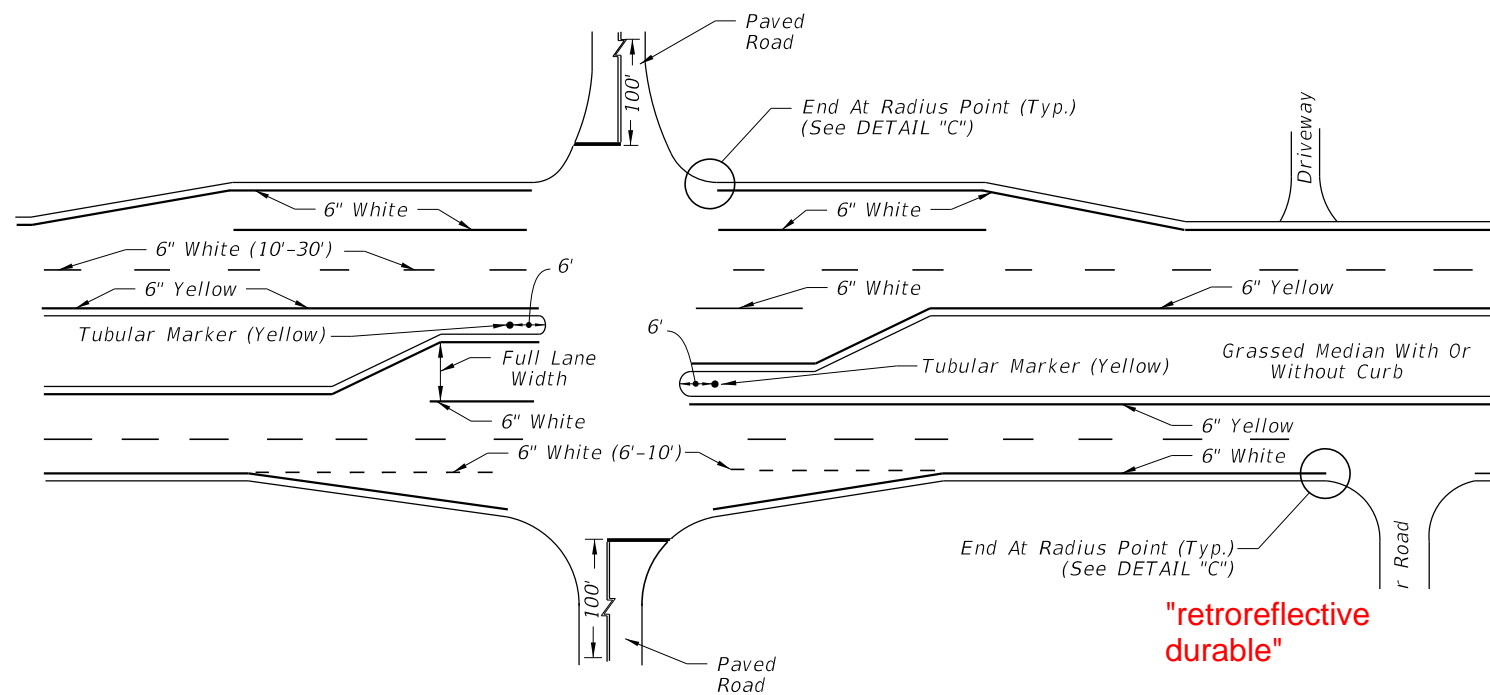


NOTES:

- Apply yellow ~~reflective~~ **"retroreflective durable"** paint to the noses of curbed medians, traffic separators, and raised islands. When applying yellow ~~reflective~~ paint in conjunction with Raised Pavement Markers, see Index 706-001.
- Options for grassed medians:
 - Option 1: Tubular Marker (Yellow). Attach Tubular Marker according to manufacturer's instructions. ~~Non-Paved Surface Foundation (See Detail "A") is provided as an option if no other suitable surface is provided.~~ Install Non-Paved Surface Foundation flush with the surrounding ground surface.
 - Option 2: Delineator Post. Use yellow retro-reflective sheeting on both sides of the delineator. Install the post so that the top is 4'-0" above the grade at the edge of the pavement.
- Extend double yellow centerlines 100' back from intersection on all approaches or 50' for unmarked cross roads.



R3-4



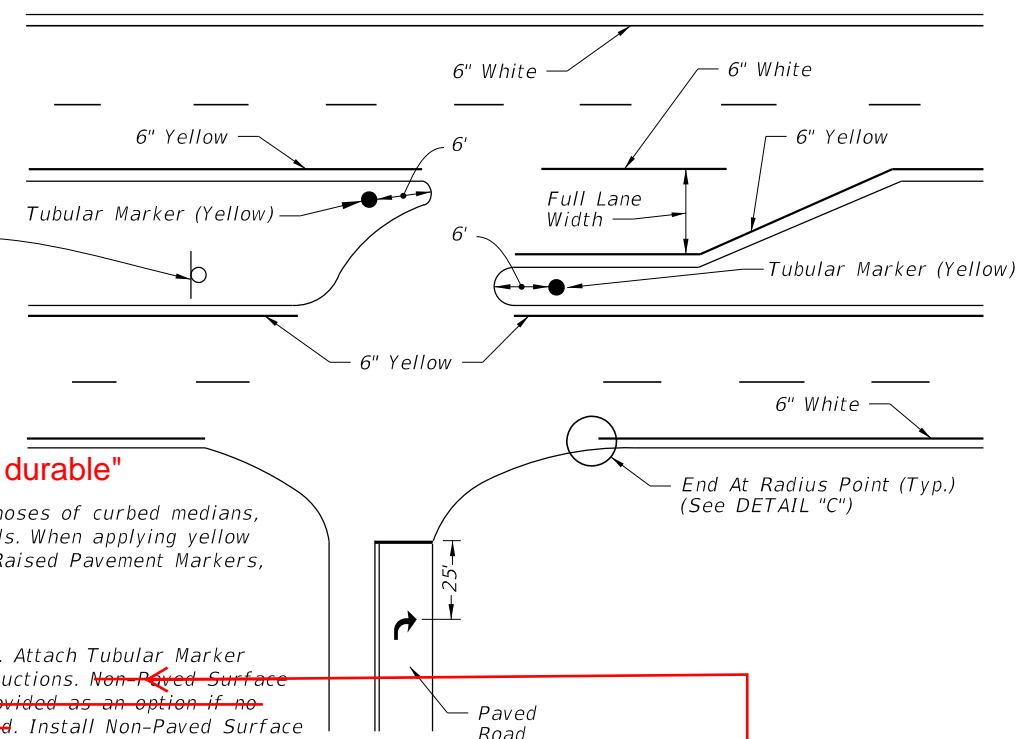


Updated Note 2: "For grassed medians without a suitable mounting surface, use either a drivable base type, or provide a Non-Paved Surface Foundation (See Detail "A")"



PAVEMENT MARKINGS FOR INTERSECTIONS WITH MAJOR AND MINOR ROADS

9/10/2024 2:59:05 PM

LAST REVISION 11/01/21	DESCRIPTION: 11/01/25	FDOT	FY 2025-26 2026-27	STANDARD PLANS	PAVEMENT MARKINGS	INDEX 711-001	SHEET 7 of 13
---------------------------	--------------------------	------	-------------------------------	----------------	-------------------	------------------	------------------

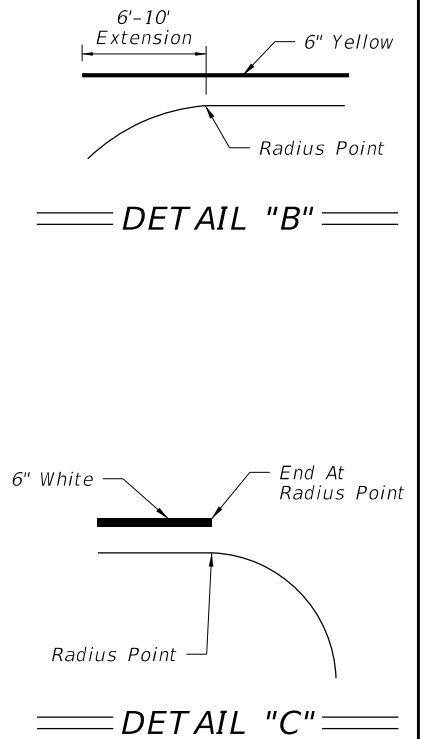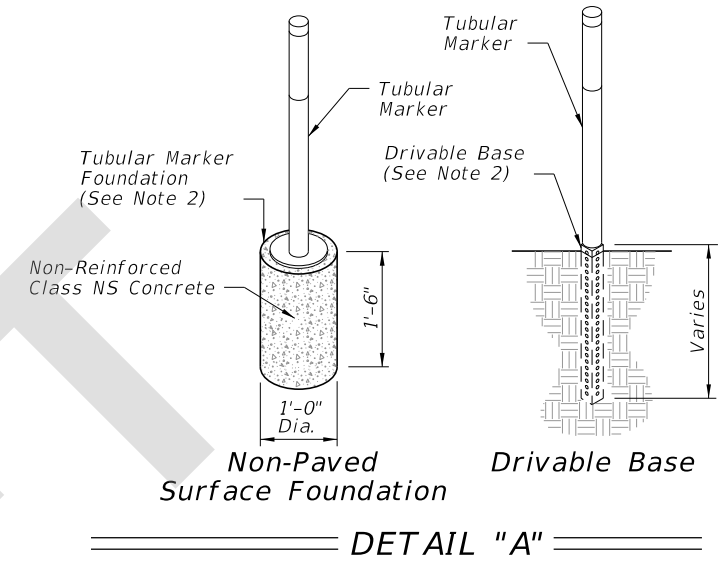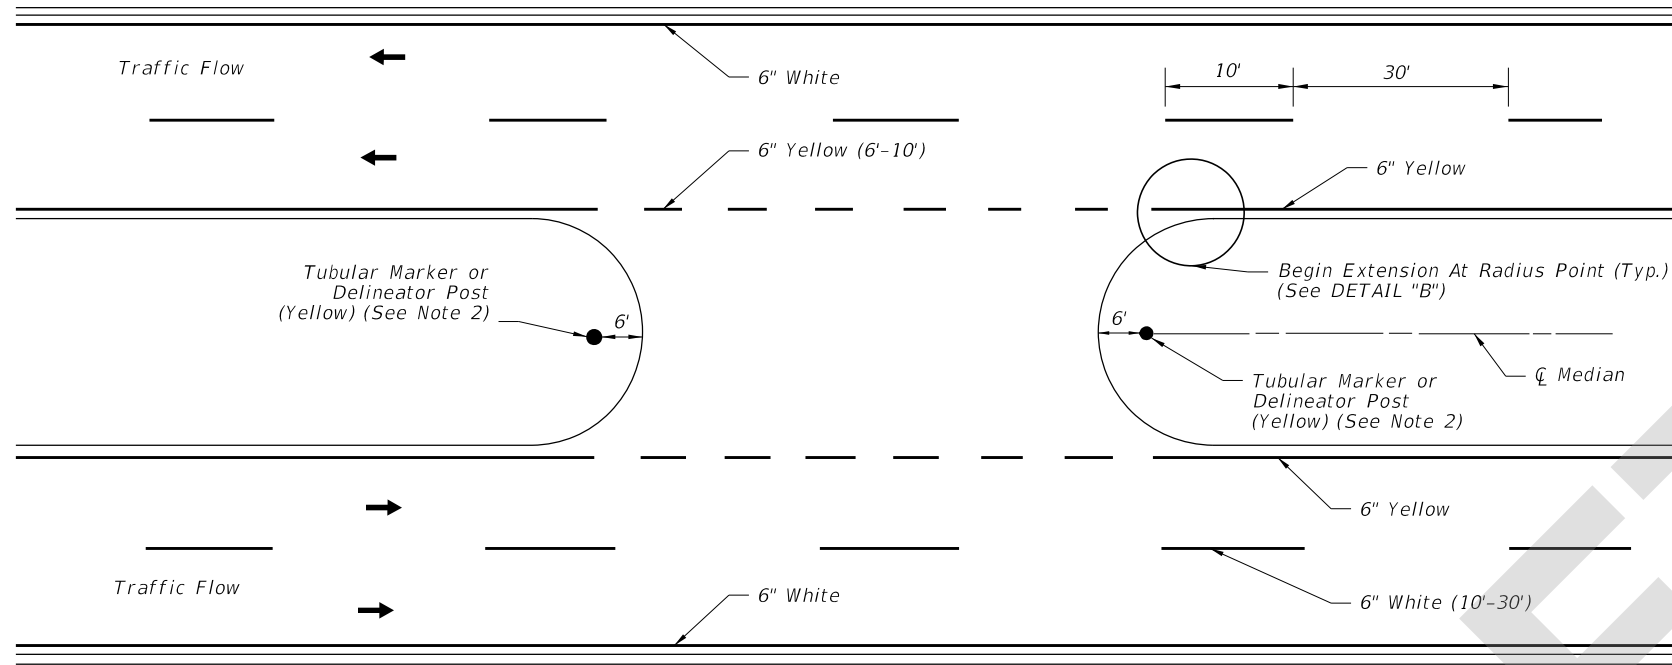

PAVEMENT MARKINGS AND DELINEATORS FOR MEDIAN CROSSOVER

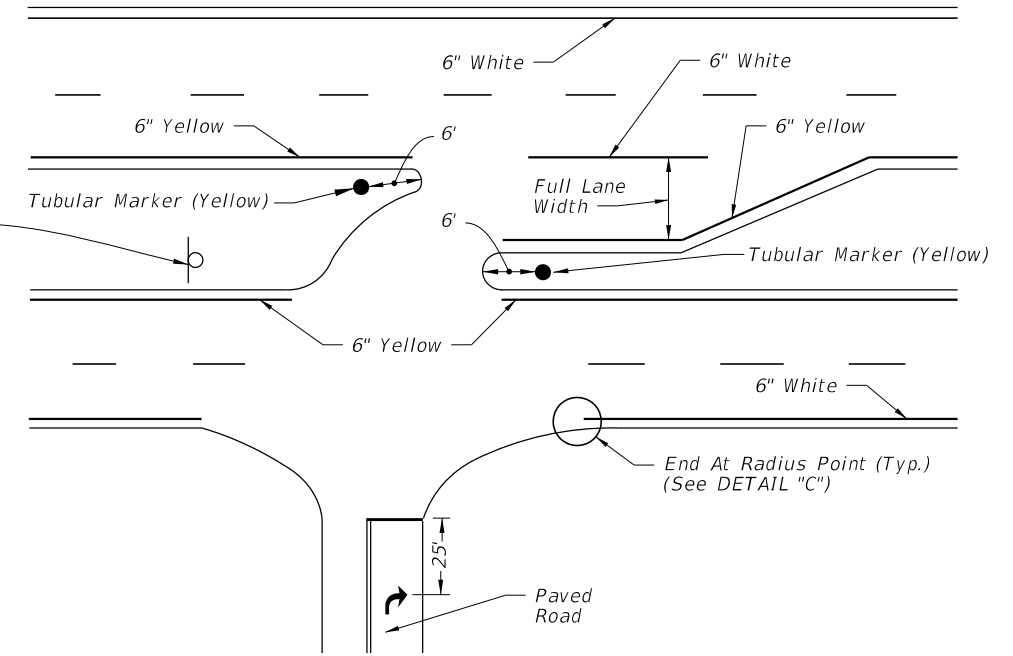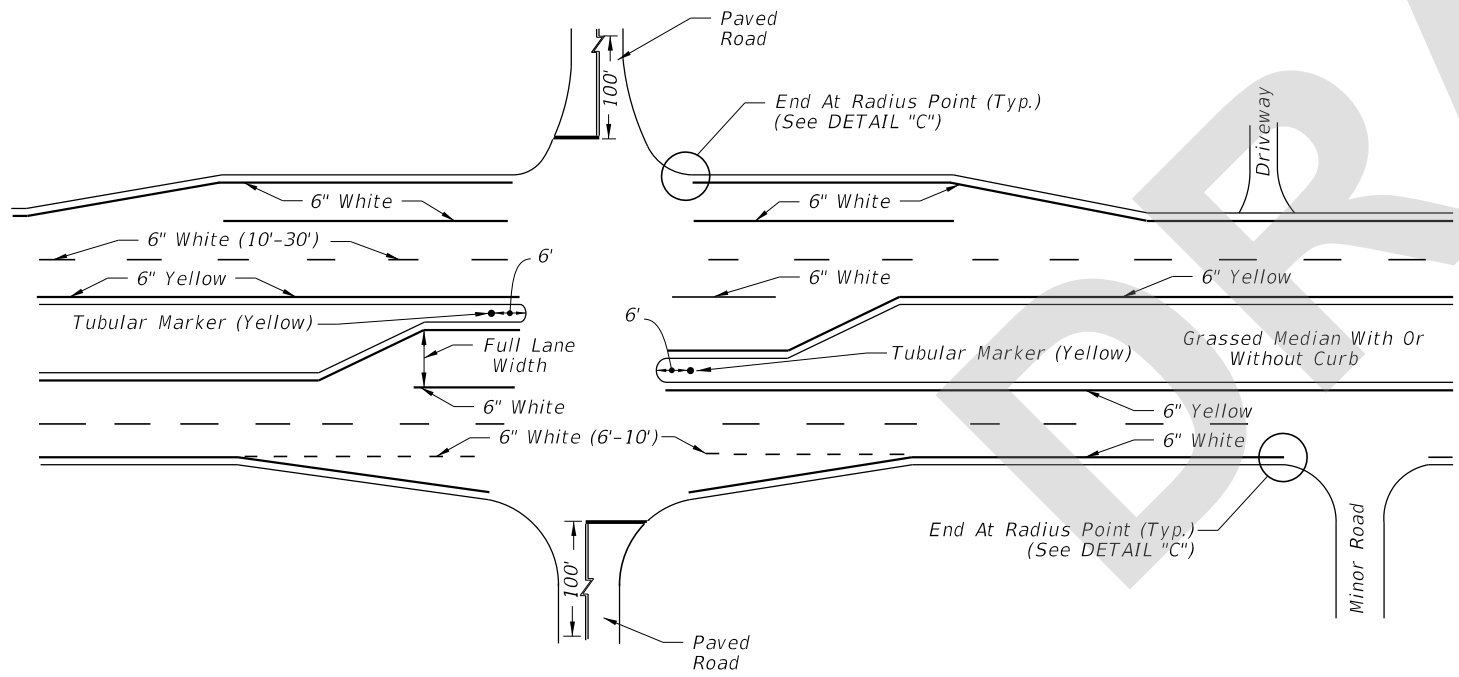


NOTES:

- Apply yellow retroreflective durable paint to the noses of curbed medians, traffic separators, and raised islands; When applying yellow retroreflective paint in conjunction with Raised Pavement Markers, see Index 706-001.
- Options for grassed medians:
 - Option 1: Tubular Marker (Yellow). Attach Tubular Marker according to manufacturer's instructions. For grassed medians without a suitable mounting surface, use either a drivable base type, or provide a Non-Paved Surface Foundation (See Detail "A"). Install Non-Paved Surface Foundation flush with the surrounding ground surface.
 - Option 2: Delineator Post. Use yellow retroreflective sheeting on both sides of the delineator. Install the post so that the top is 4'-0" above the grade at the edge of the pavement.
- Extend double yellow centerlines 100' back from intersection on all approaches or 50' for unmarked cross roads.

PAVEMENT MARKINGS FOR INTERSECTIONS WITH MAJOR AND MINOR ROADS

5/7/2025 9:52:36 AM

LAST REVISION 11/01/25	REVISION	DESCRIPTION:	 FY 2026-27 STANDARD PLANS	PAVEMENT MARKINGS	INDEX 711-001	SHEET 7 of 13
---------------------------	----------	--------------	---	-------------------	------------------	------------------