

**Origination Form**  
Proposed Revisions to a Standard Plans Index

<b>Originator:</b>	Gibbs, Shae	<b>Index Number:</b>	711-003
<b>Date:</b>	5/5/2025	<b>Sheet Number(s):</b>	2,5,6,7
<b>E-mail:</b>	shae.gibbs@dot.state.fl.us	<b>Index Title:</b>	Interchange Markings

**Summary of the changes:**

Sheet 2: Added SINGLE-LANE PARALLEL-TYPE ENTRANCE WITHOUT ADDED LANE detail.  
 Sheet 5: Updated wrong-way arrows to match 706-001.  
 Sheet 6: Updated wrong-way arrows to match 706-001.  
 Sheet 7: Updated wrong-way arrows to match 706-001, removed edge line markings from crosswalk areas.


**Commentary/Background:**

Sheet 2: Due to ongoing confusion on what striping to use in Parallel-Type Entrances, a detail was added for SINGLE-LANE PARALLEL-TYPE ENTRANCE WITHOUT ADDED LANE for clarification  
  
 Sheets 5, 6, and 7: Update WWD Arrows to match proposed revision to 706-001


Other Affected Documents/Offices	Person Contacted	Affected (Yes/No)
Other Standard Plans		No
FDOT Design Manual		No
Standard Specifications		No
Basis of Estimates Manual		No
Approved Product List		No
Construction Office		No
Maintenance Office		No

**Implementation**

--

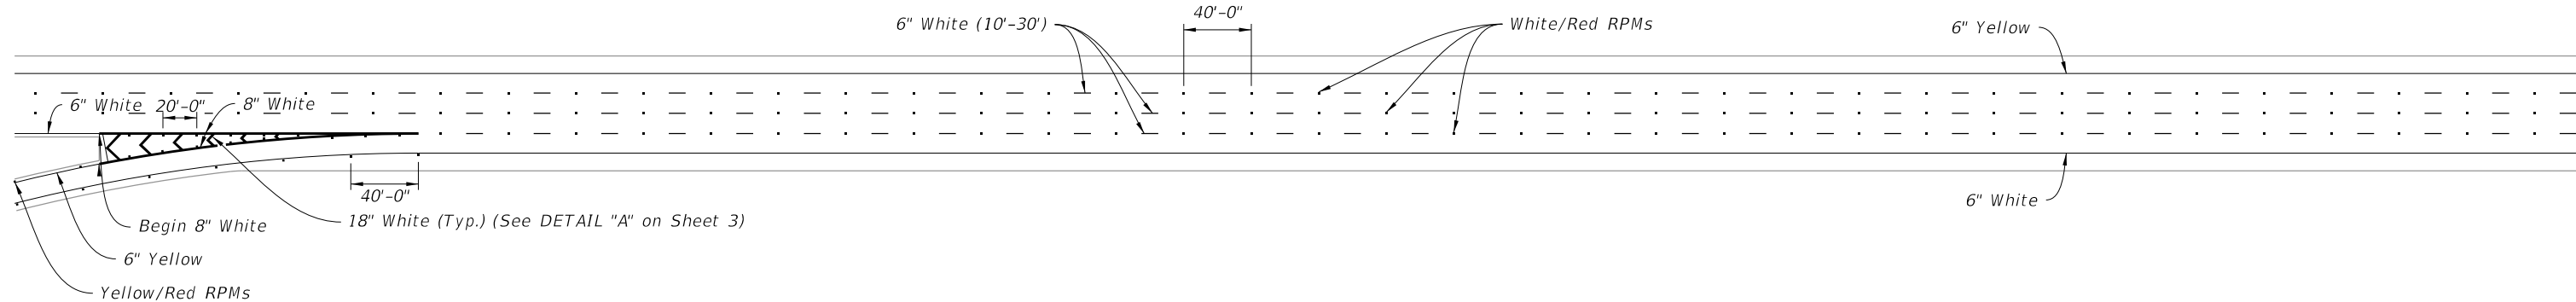


PARALLEL-TYPE ENTRANCE WITH ADDED LANE

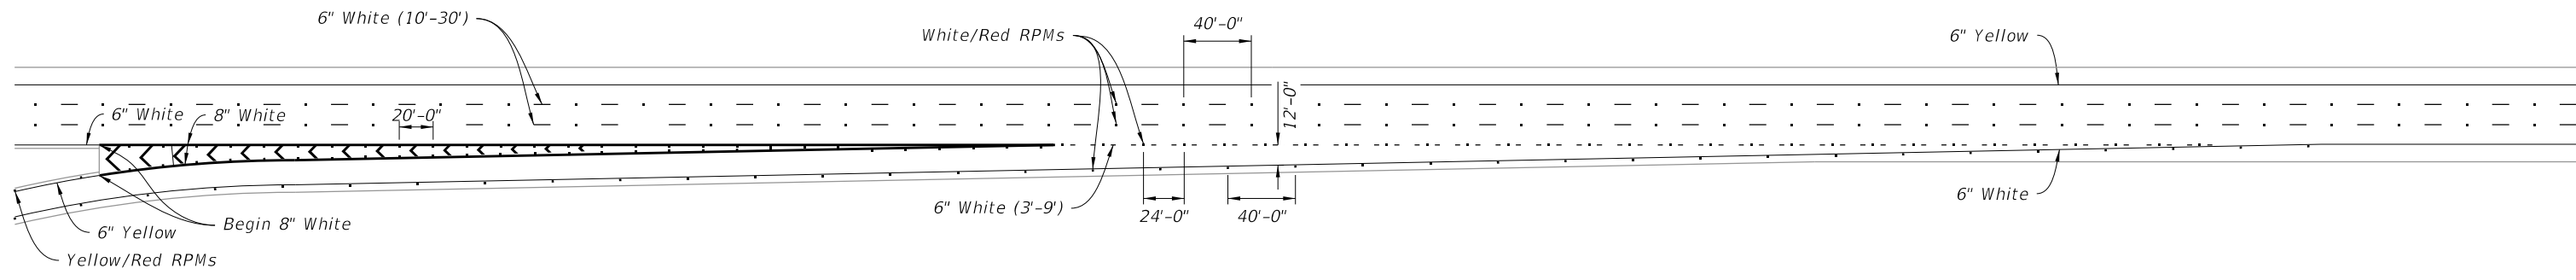

TAPER-TYPE ENTRANCE

**ADDED: SINGLE-LANE PARALLEL-TYPE ENTRANCE WITHOUT ADDED LANE detail**

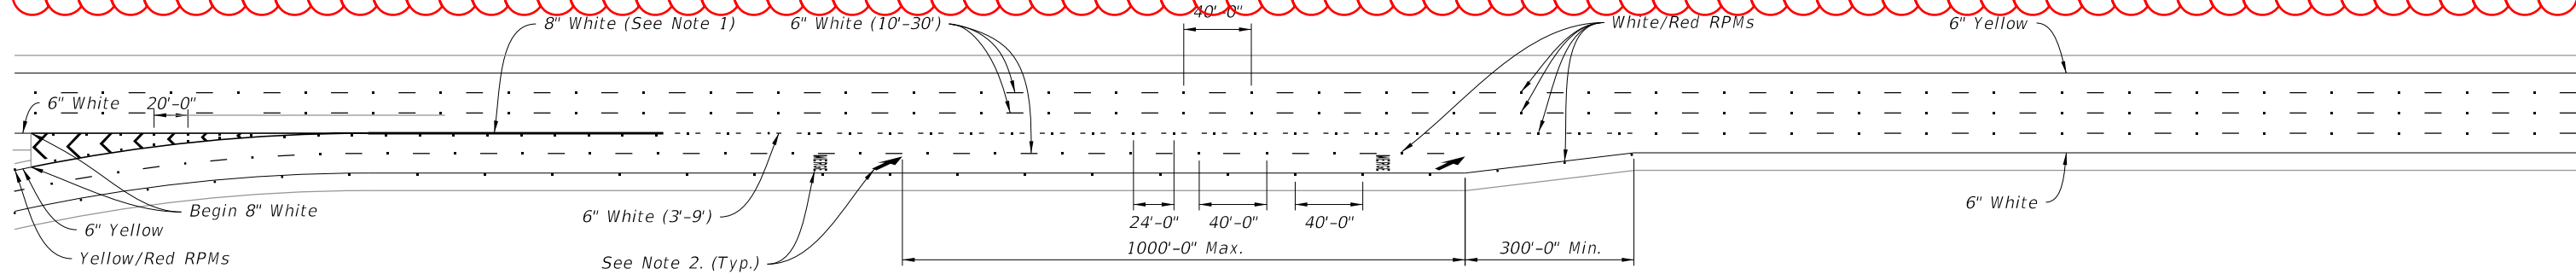

TWO-LANE PARALLEL-TYPE ENTRANCE WITH ADDED LANE  
(Single-Lane Parallel-Type Entrance Without Added Lane Similar, See Note 3)

**NOTES:**

1. Extend this 8" white Pavement Marker one-fourth the length of the acceleration lane from the gore markings.
2. See Index 711-001 for pavement message dimensions and details.
3. Merge Pavement Message and Arrow only used for Two-Lane Entrances.


12/20/2024 2:22:44 PM

2026-27

**TYPICAL PAVEMENT MARKINGS AT ENTRANCE RAMPS**

LAST REVISION <b>11/01/23</b> <b>11/01/25</b>	REVISION	DESCRIPTION:		FY <del>2025-26</del> <b>STANDARD PLANS</b>	<b>INTERCHANGE MARKINGS</b>	INDEX <b>711-003</b>	SHEET <b>2 of 8</b>
---	----------	--------------	--	--	-----------------------------	-------------------------	------------------------


9/10/2024 3:01:22 PM



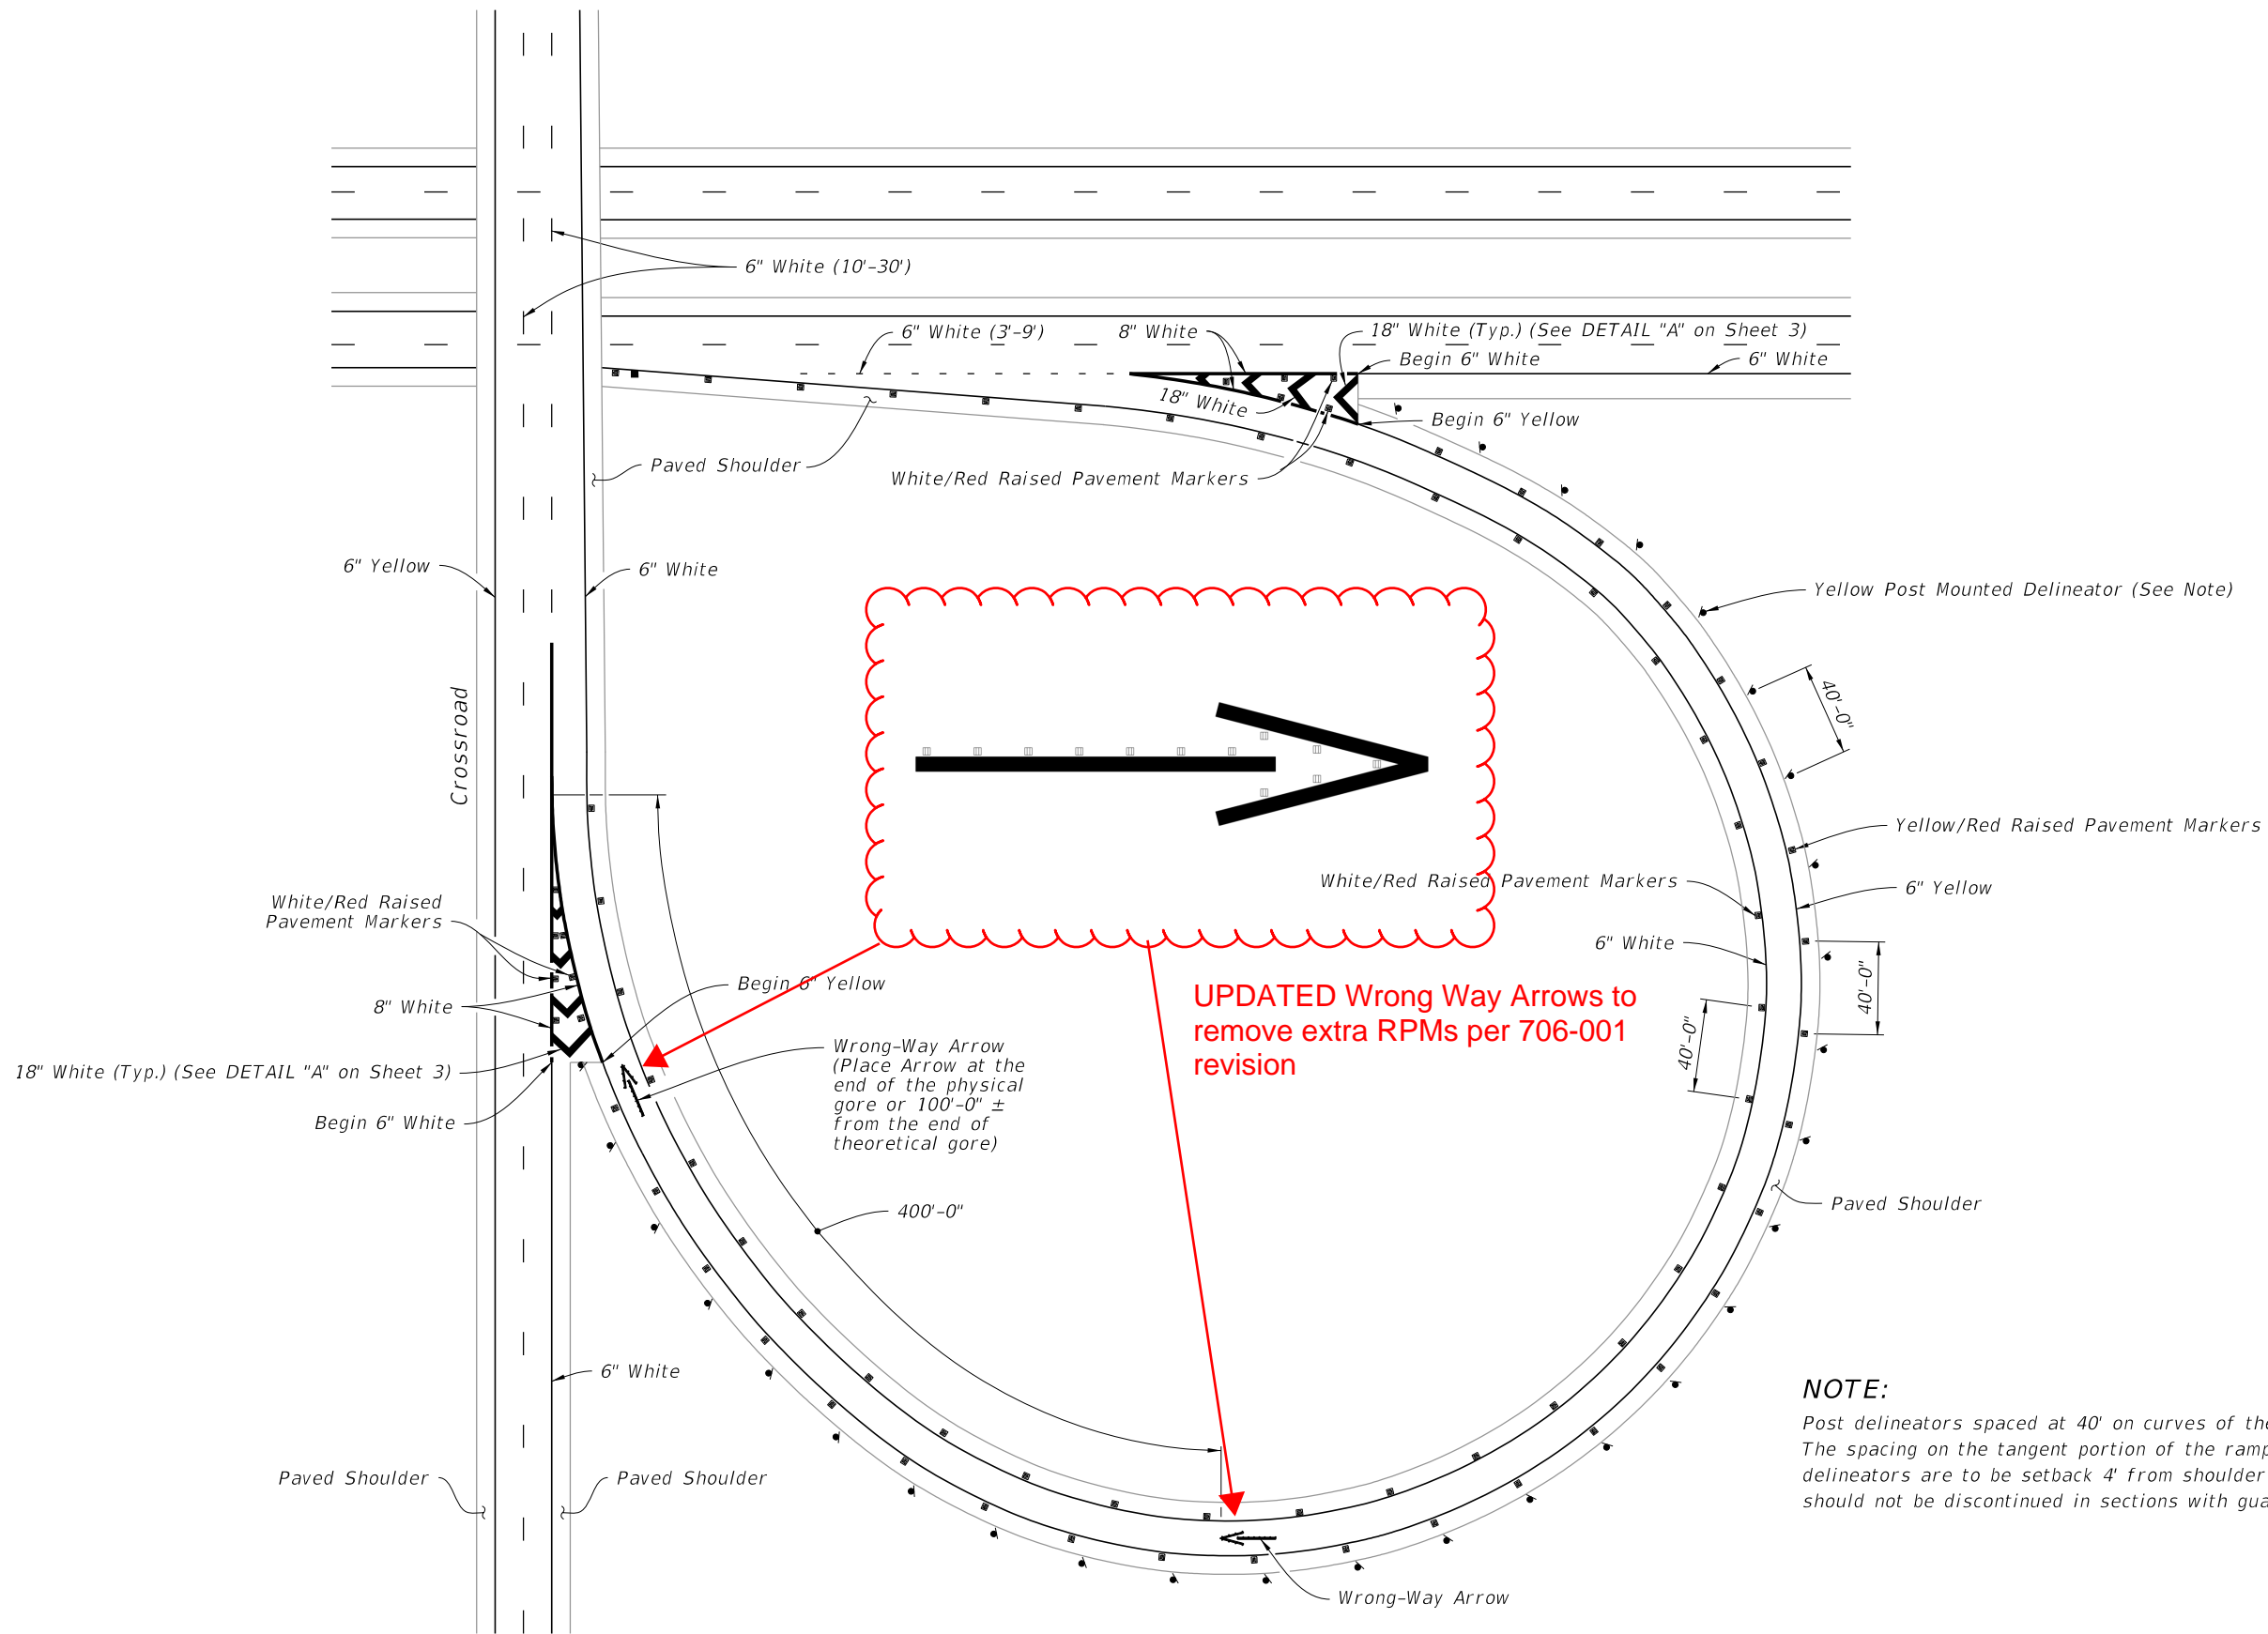


**NOTE:**  
 Post delineators spaced at 40' on curves of the entrance and exit of ramps. The spacing on the tangent portion of the ramp section is 300'-0". All delineators are to be setback 4' from shoulder break. Post delineators should not be discontinued in sections with guardrail.

TYPICAL CURVED EXIT RAMP

TYPICAL CURVED EXIT RAMP

LAST REVISION 11/01/21 11/01/25	REVISION DESCRIPTION:	 2026-27 FY <del>2025-26</del> STANDARD PLANS	INTERCHANGE MARKINGS	INDEX	SHEET
				711-003	5 of 8

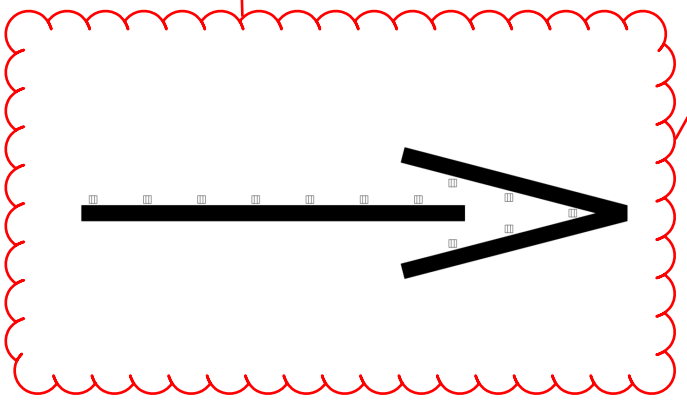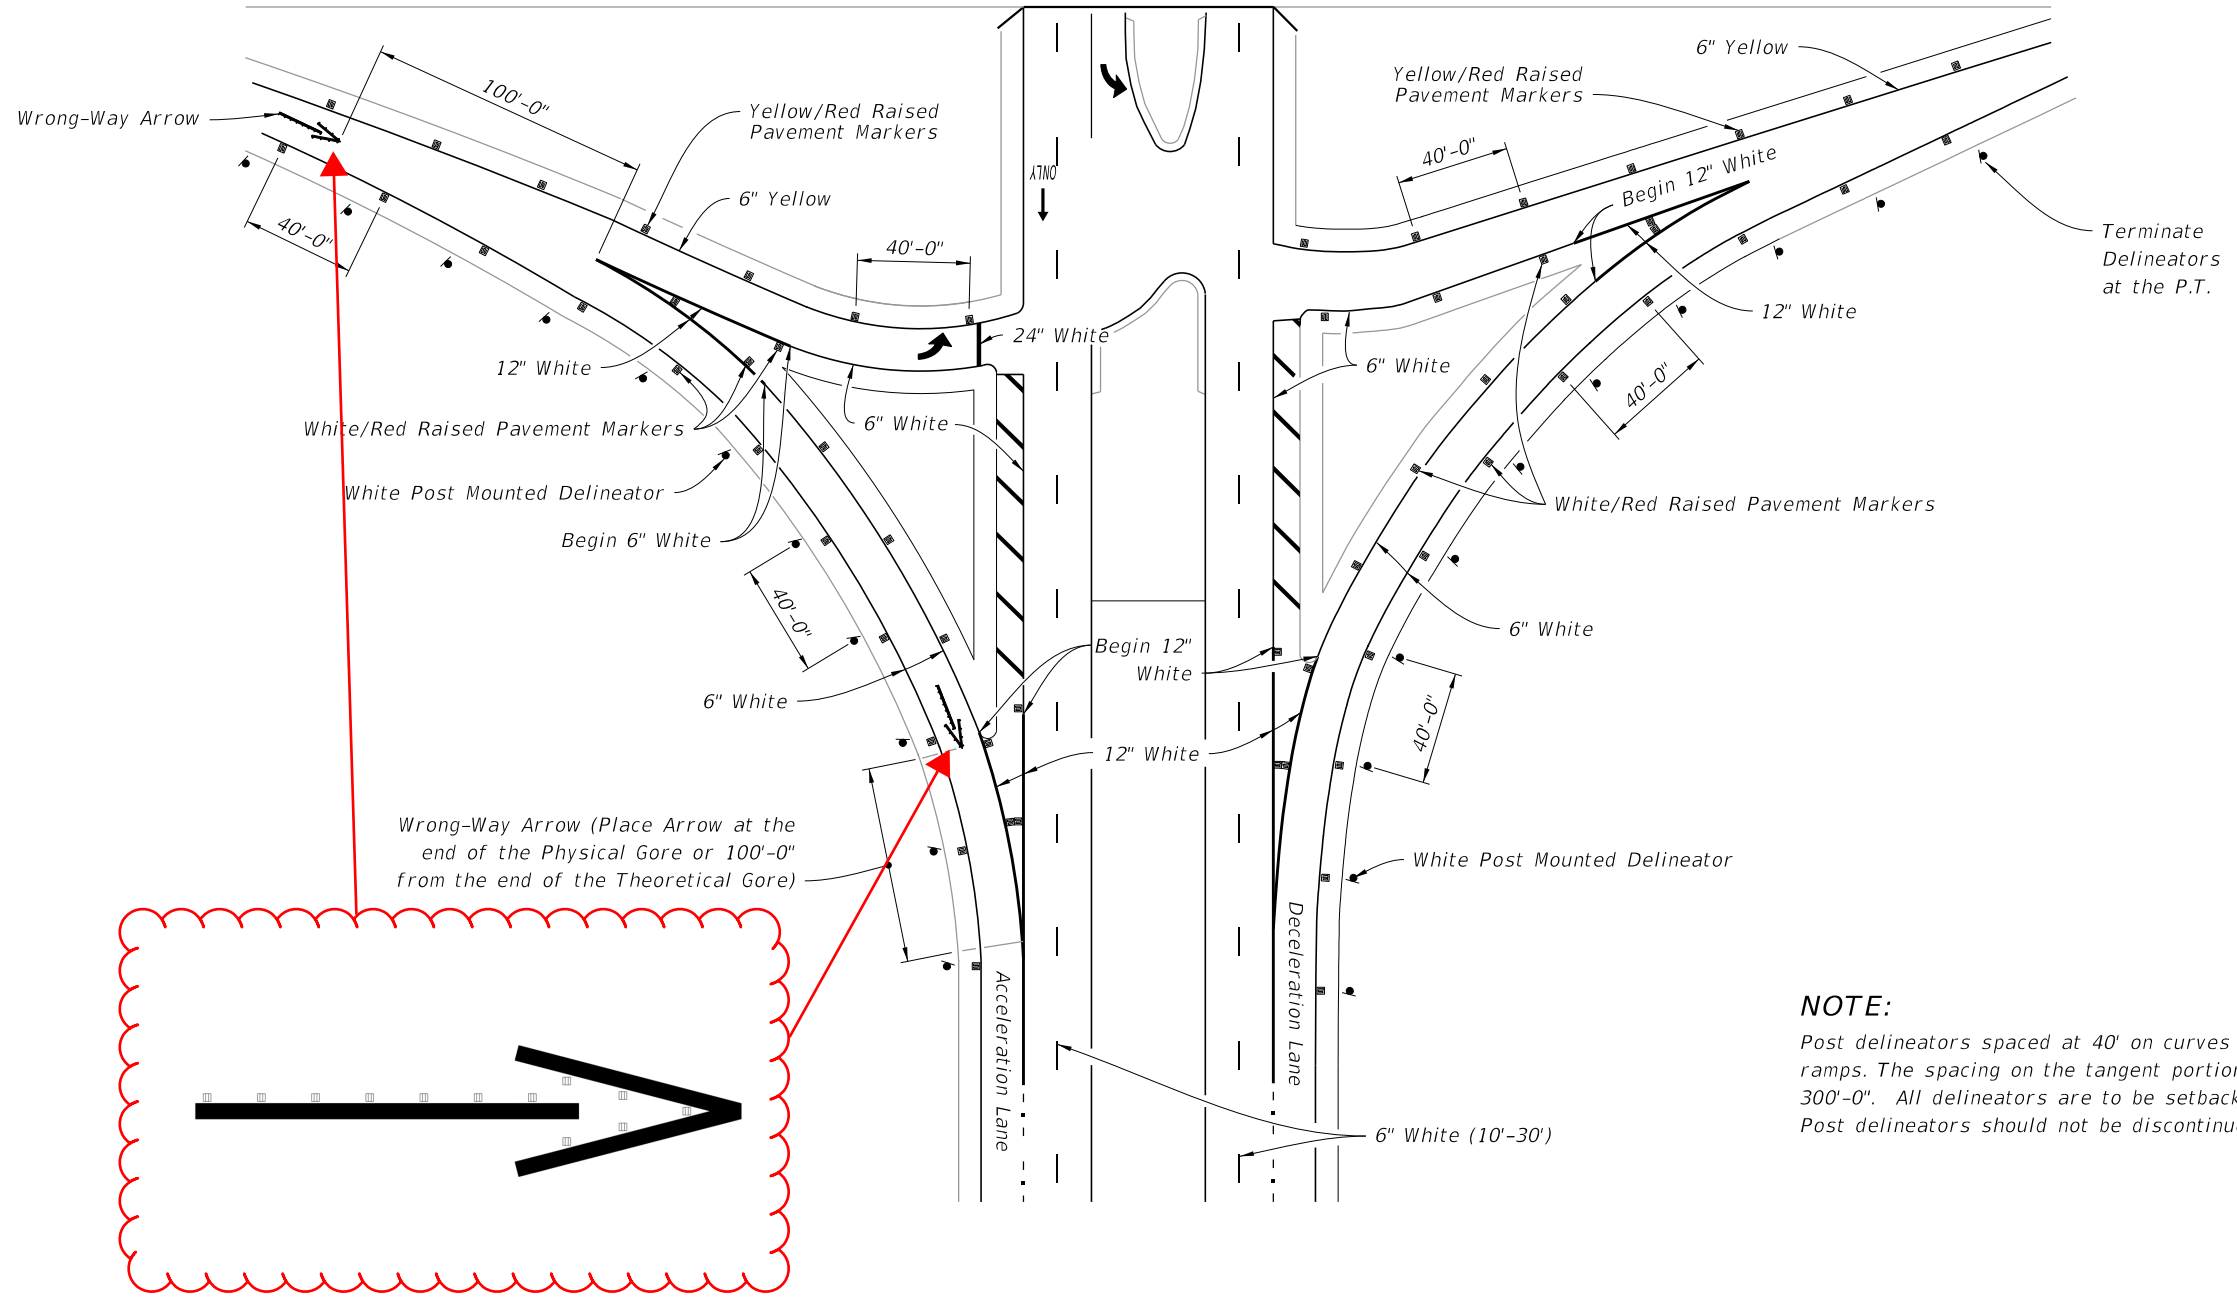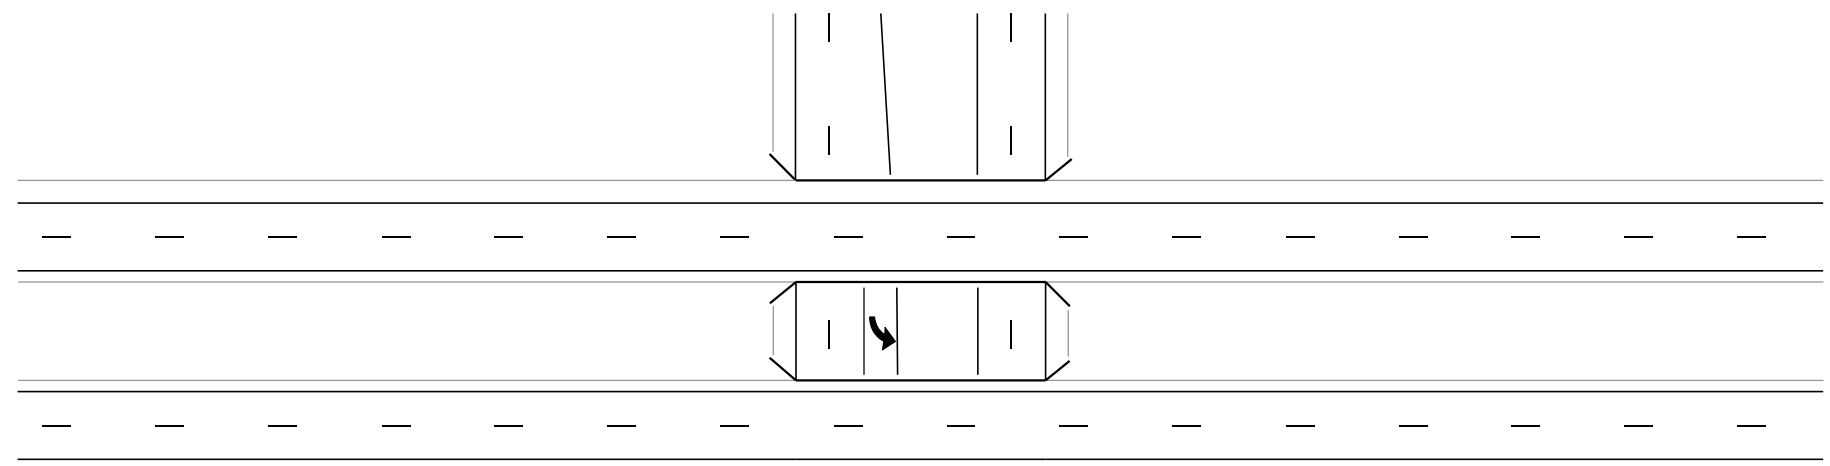

UPDATED Wrong Way Arrows to remove extra RPMs per 706-001 revision

**NOTE:**  
 Post delineators spaced at 40' on curves of the entrance and exit of ramps. The spacing on the tangent portion of the ramp section is 300'-0". All delineators are to be setback 4' from shoulder break. Post delineators should not be discontinued in sections with guardrail.


9/10/2024 3:01:28 PM

LAST REVISION 11/01/21 <del>11/01/25</del>	DESCRIPTION:	 FY <del>2025-26</del> STANDARD PLANS	INTERCHANGE MARKINGS	INDEX 711-003	SHEET 6 of 8
--	--------------	---	----------------------	------------------	-----------------


TYPICAL INTERSECTION

2026-27

9/10/2024 3:01:35 PM

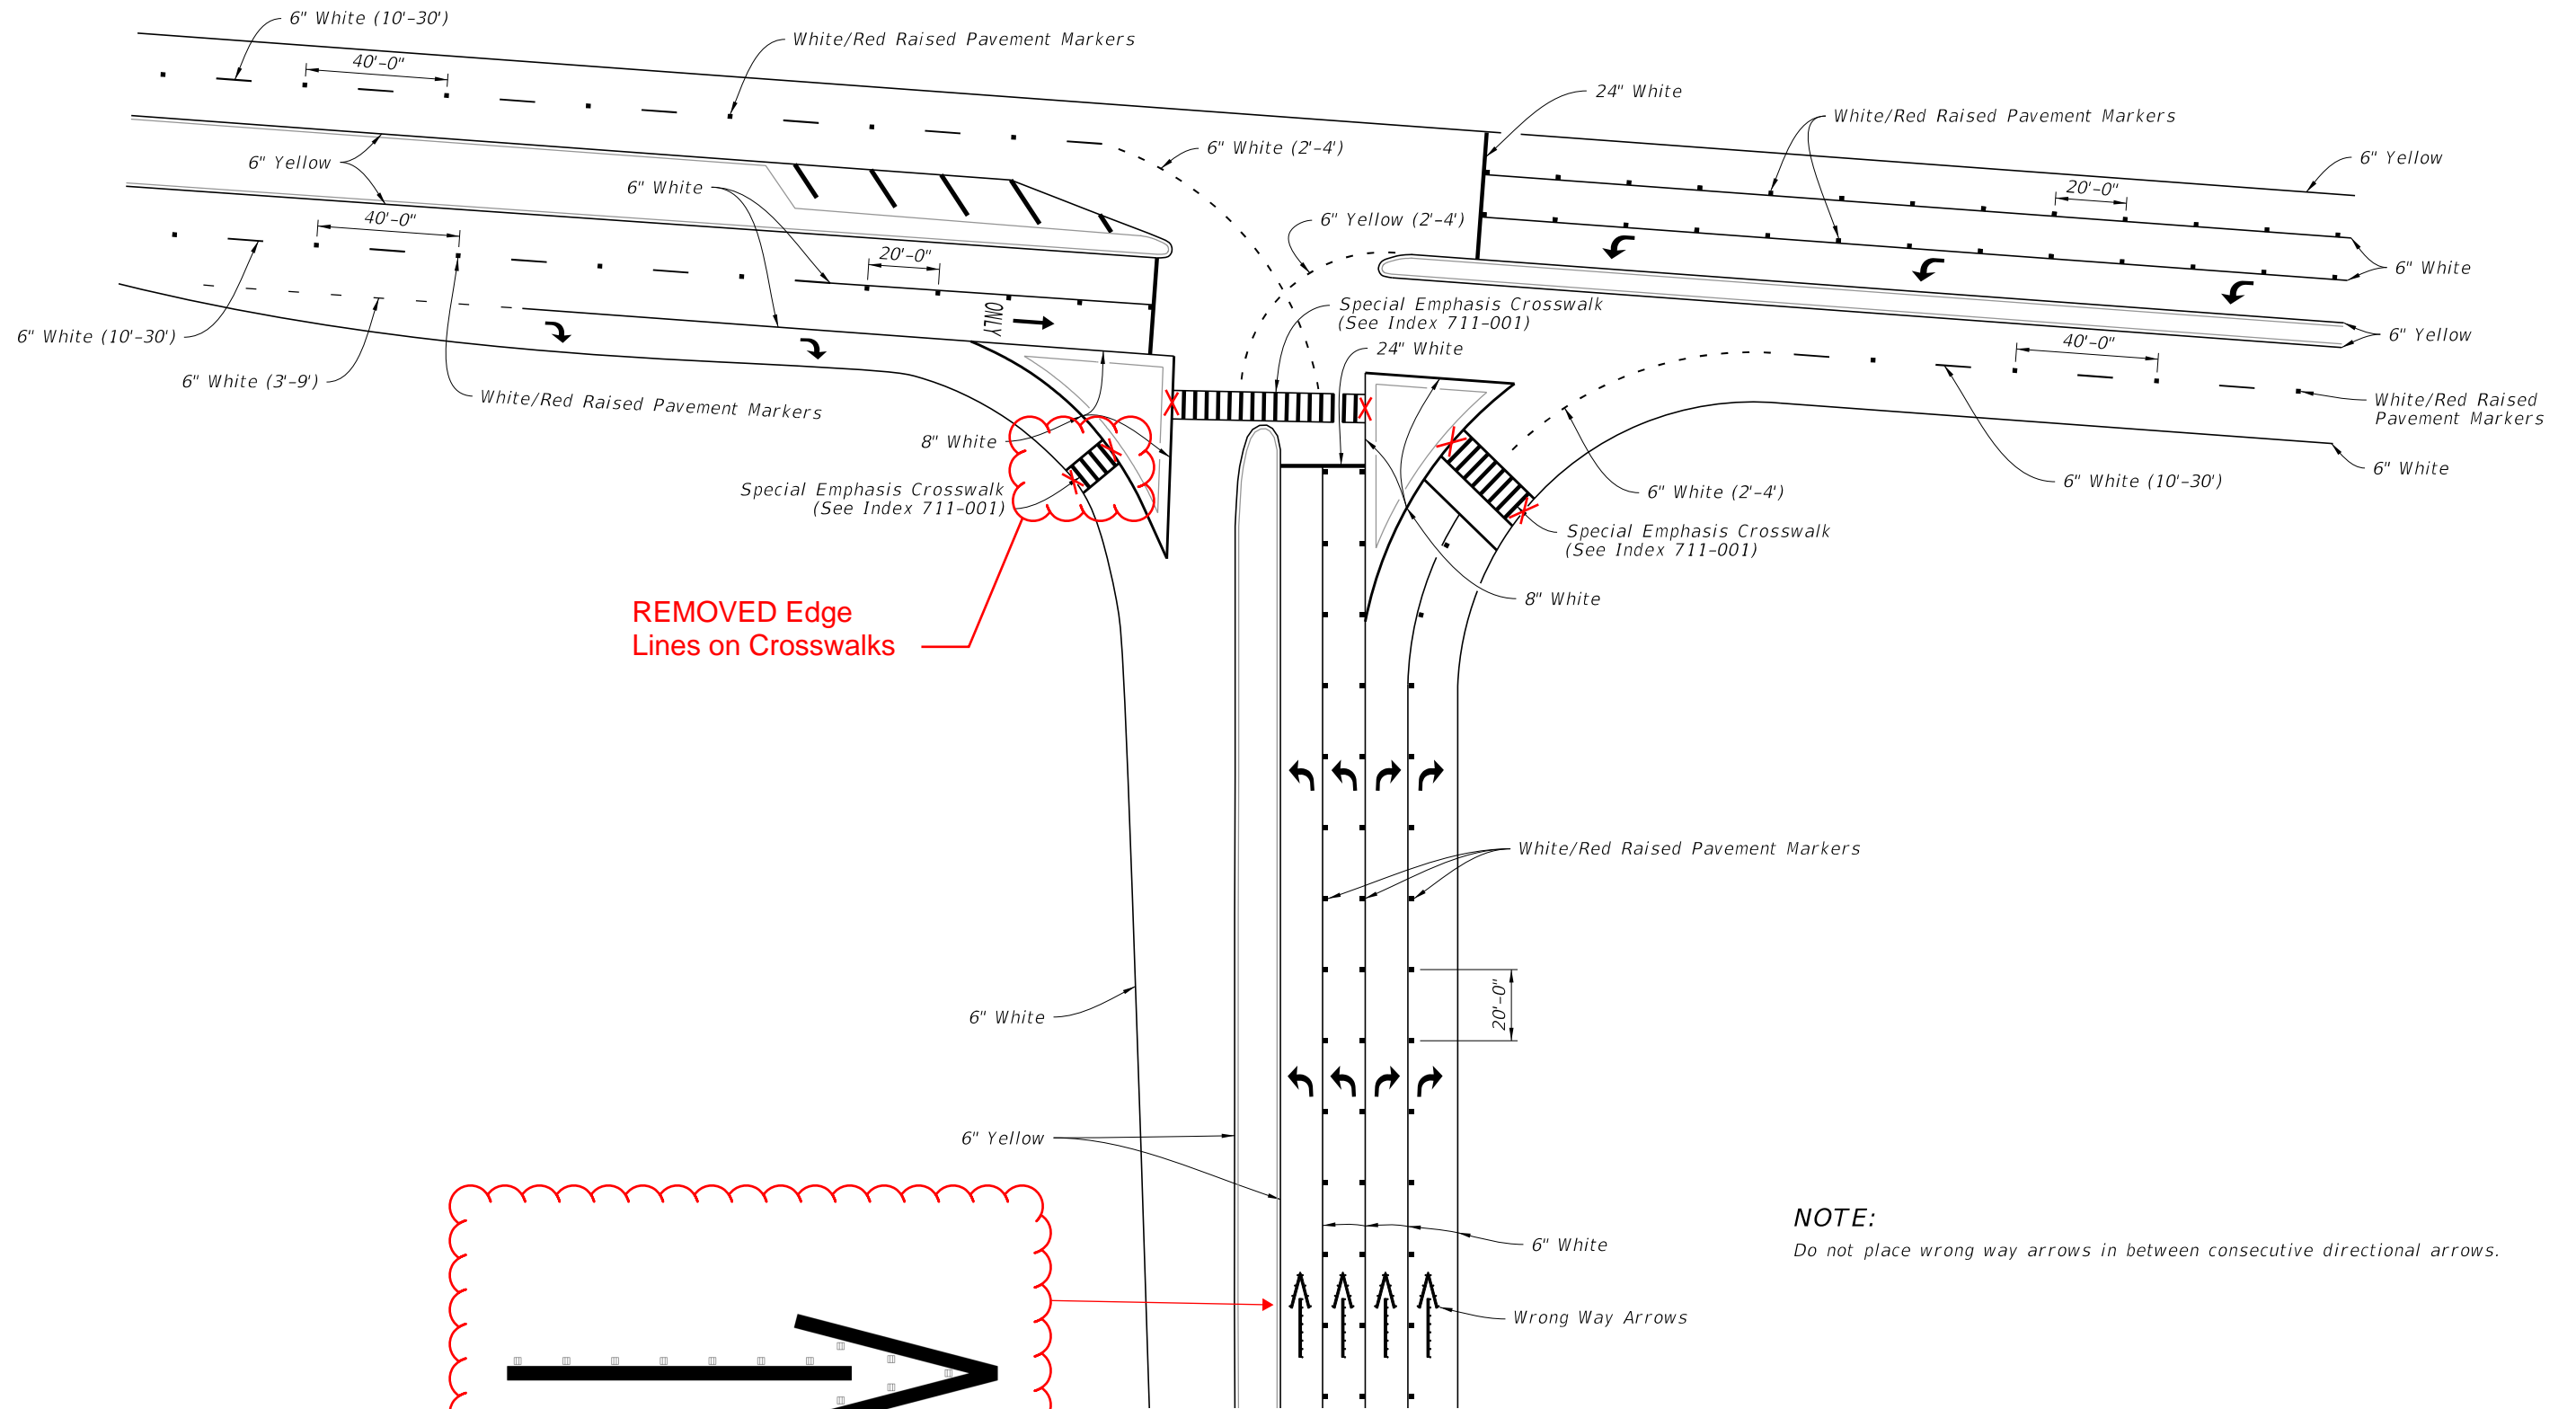

REMOVED Edge Lines on Crosswalks

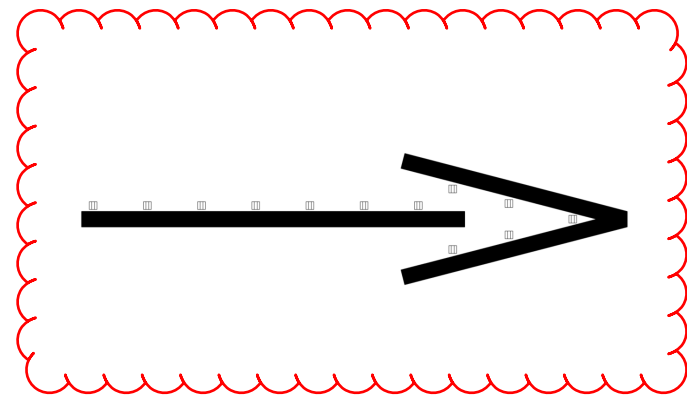


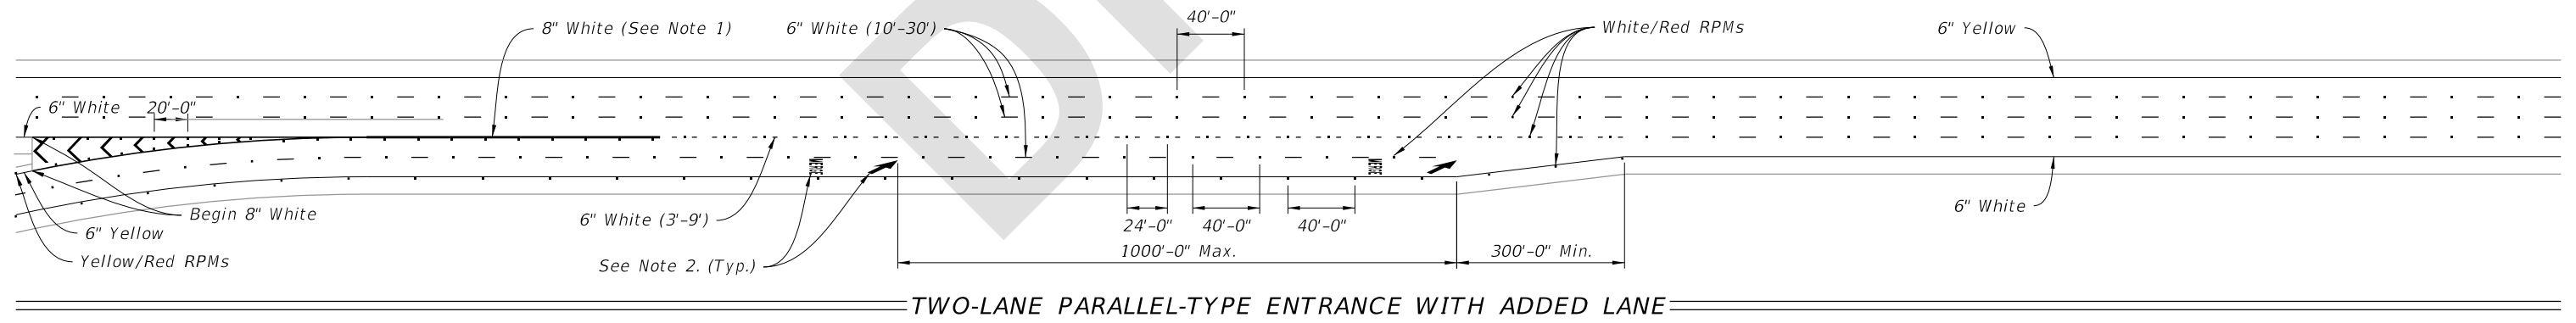
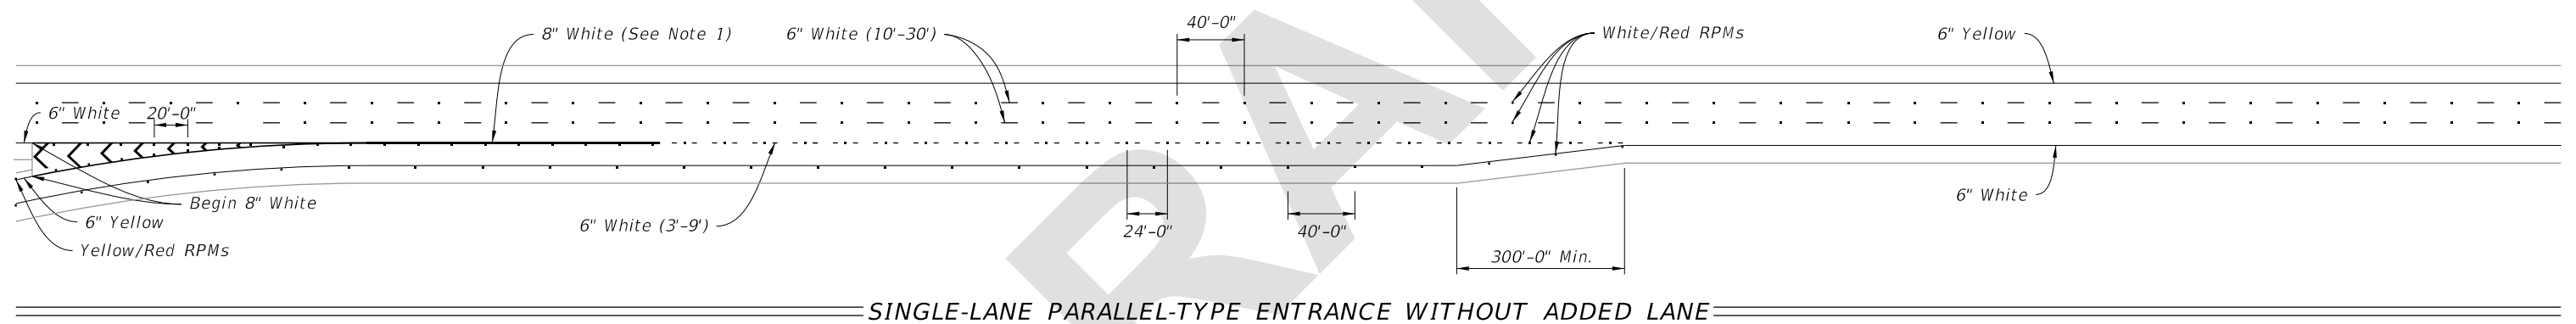
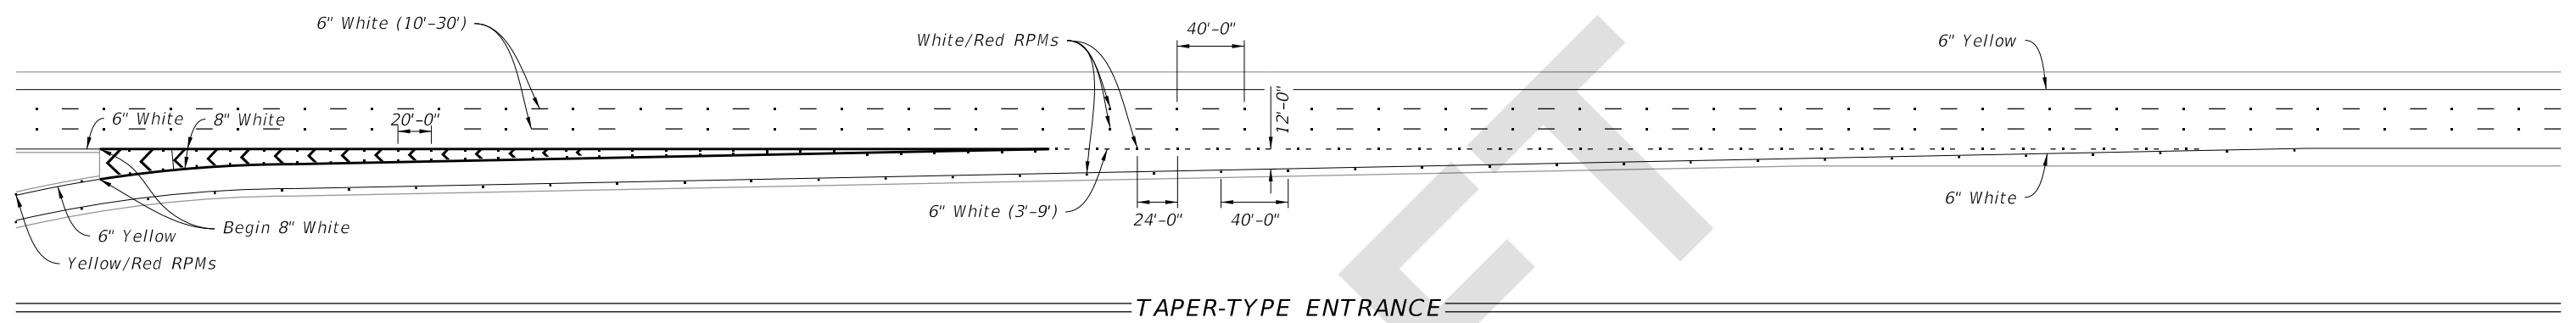
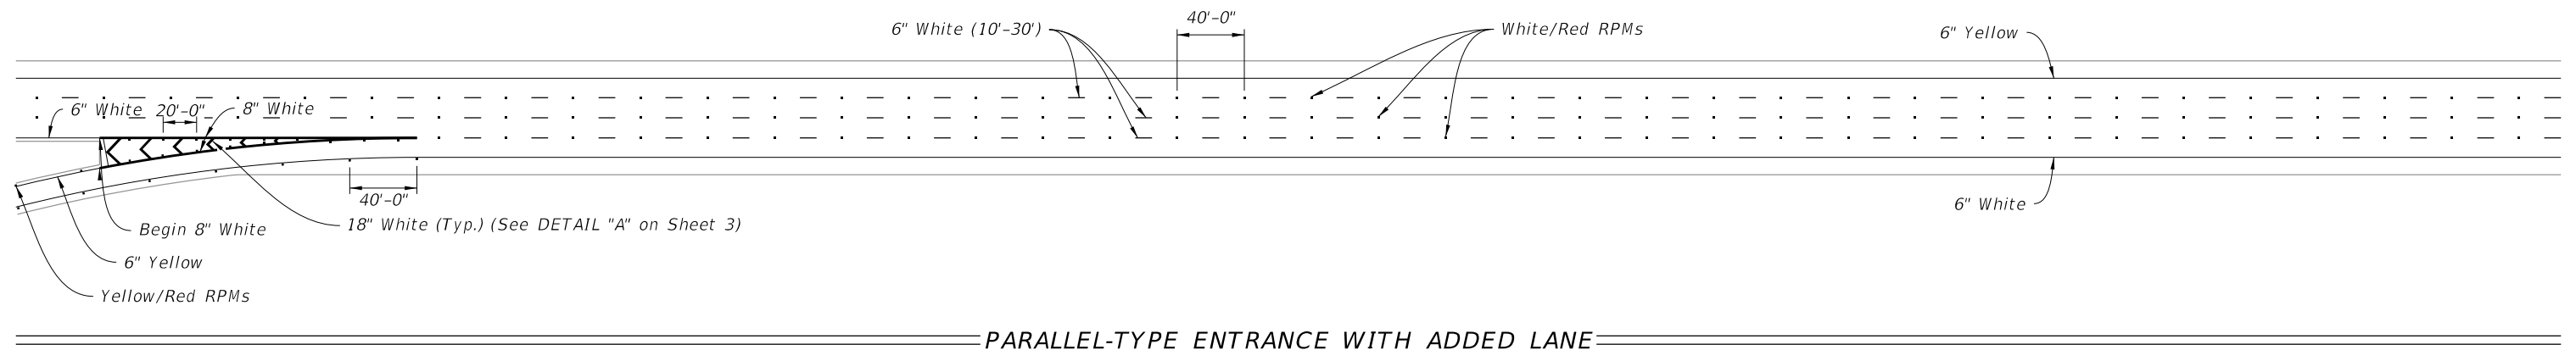
UPDATED Wrong Way Arrows to remove extra RPMs per 706-001 revision

NOTE:  
Do not place wrong way arrows in between consecutive directional arrows.

2026-27

TYPICAL PARTIAL CLOVERLEAF/TRUMPET EXIT RAMP

LAST REVISION 11/01/21 11/01/25	DESCRIPTION:  	 FY <del>2025-26</del> STANDARD PLANS	INTERCHANGE MARKINGS	INDEX 711-003	SHEET 7 of 8
---------------------------------------	----------------------	--	----------------------	------------------	-----------------




**NOTES:**


1. Extend this 8" white Pavement Marker one-fourth the length of the acceleration lane from the gore markings.
2. See Index 711-001 for pavement message dimensions and details.
3. Merge Pavement Message and Arrow only used for Two-Lane Entrances.

**TYPICAL PAVEMENT MARKINGS AT ENTRANCE RAMPS**

7/11/2025 7:08:50 AM

LAST REVISION 11/01/25	DESCRIPTION:	 FY 2026-27 STANDARD PLANS	INTERCHANGE MARKINGS	INDEX	SHEET
				711-003	2 of 8


7/11/2025 7:08:57 AM

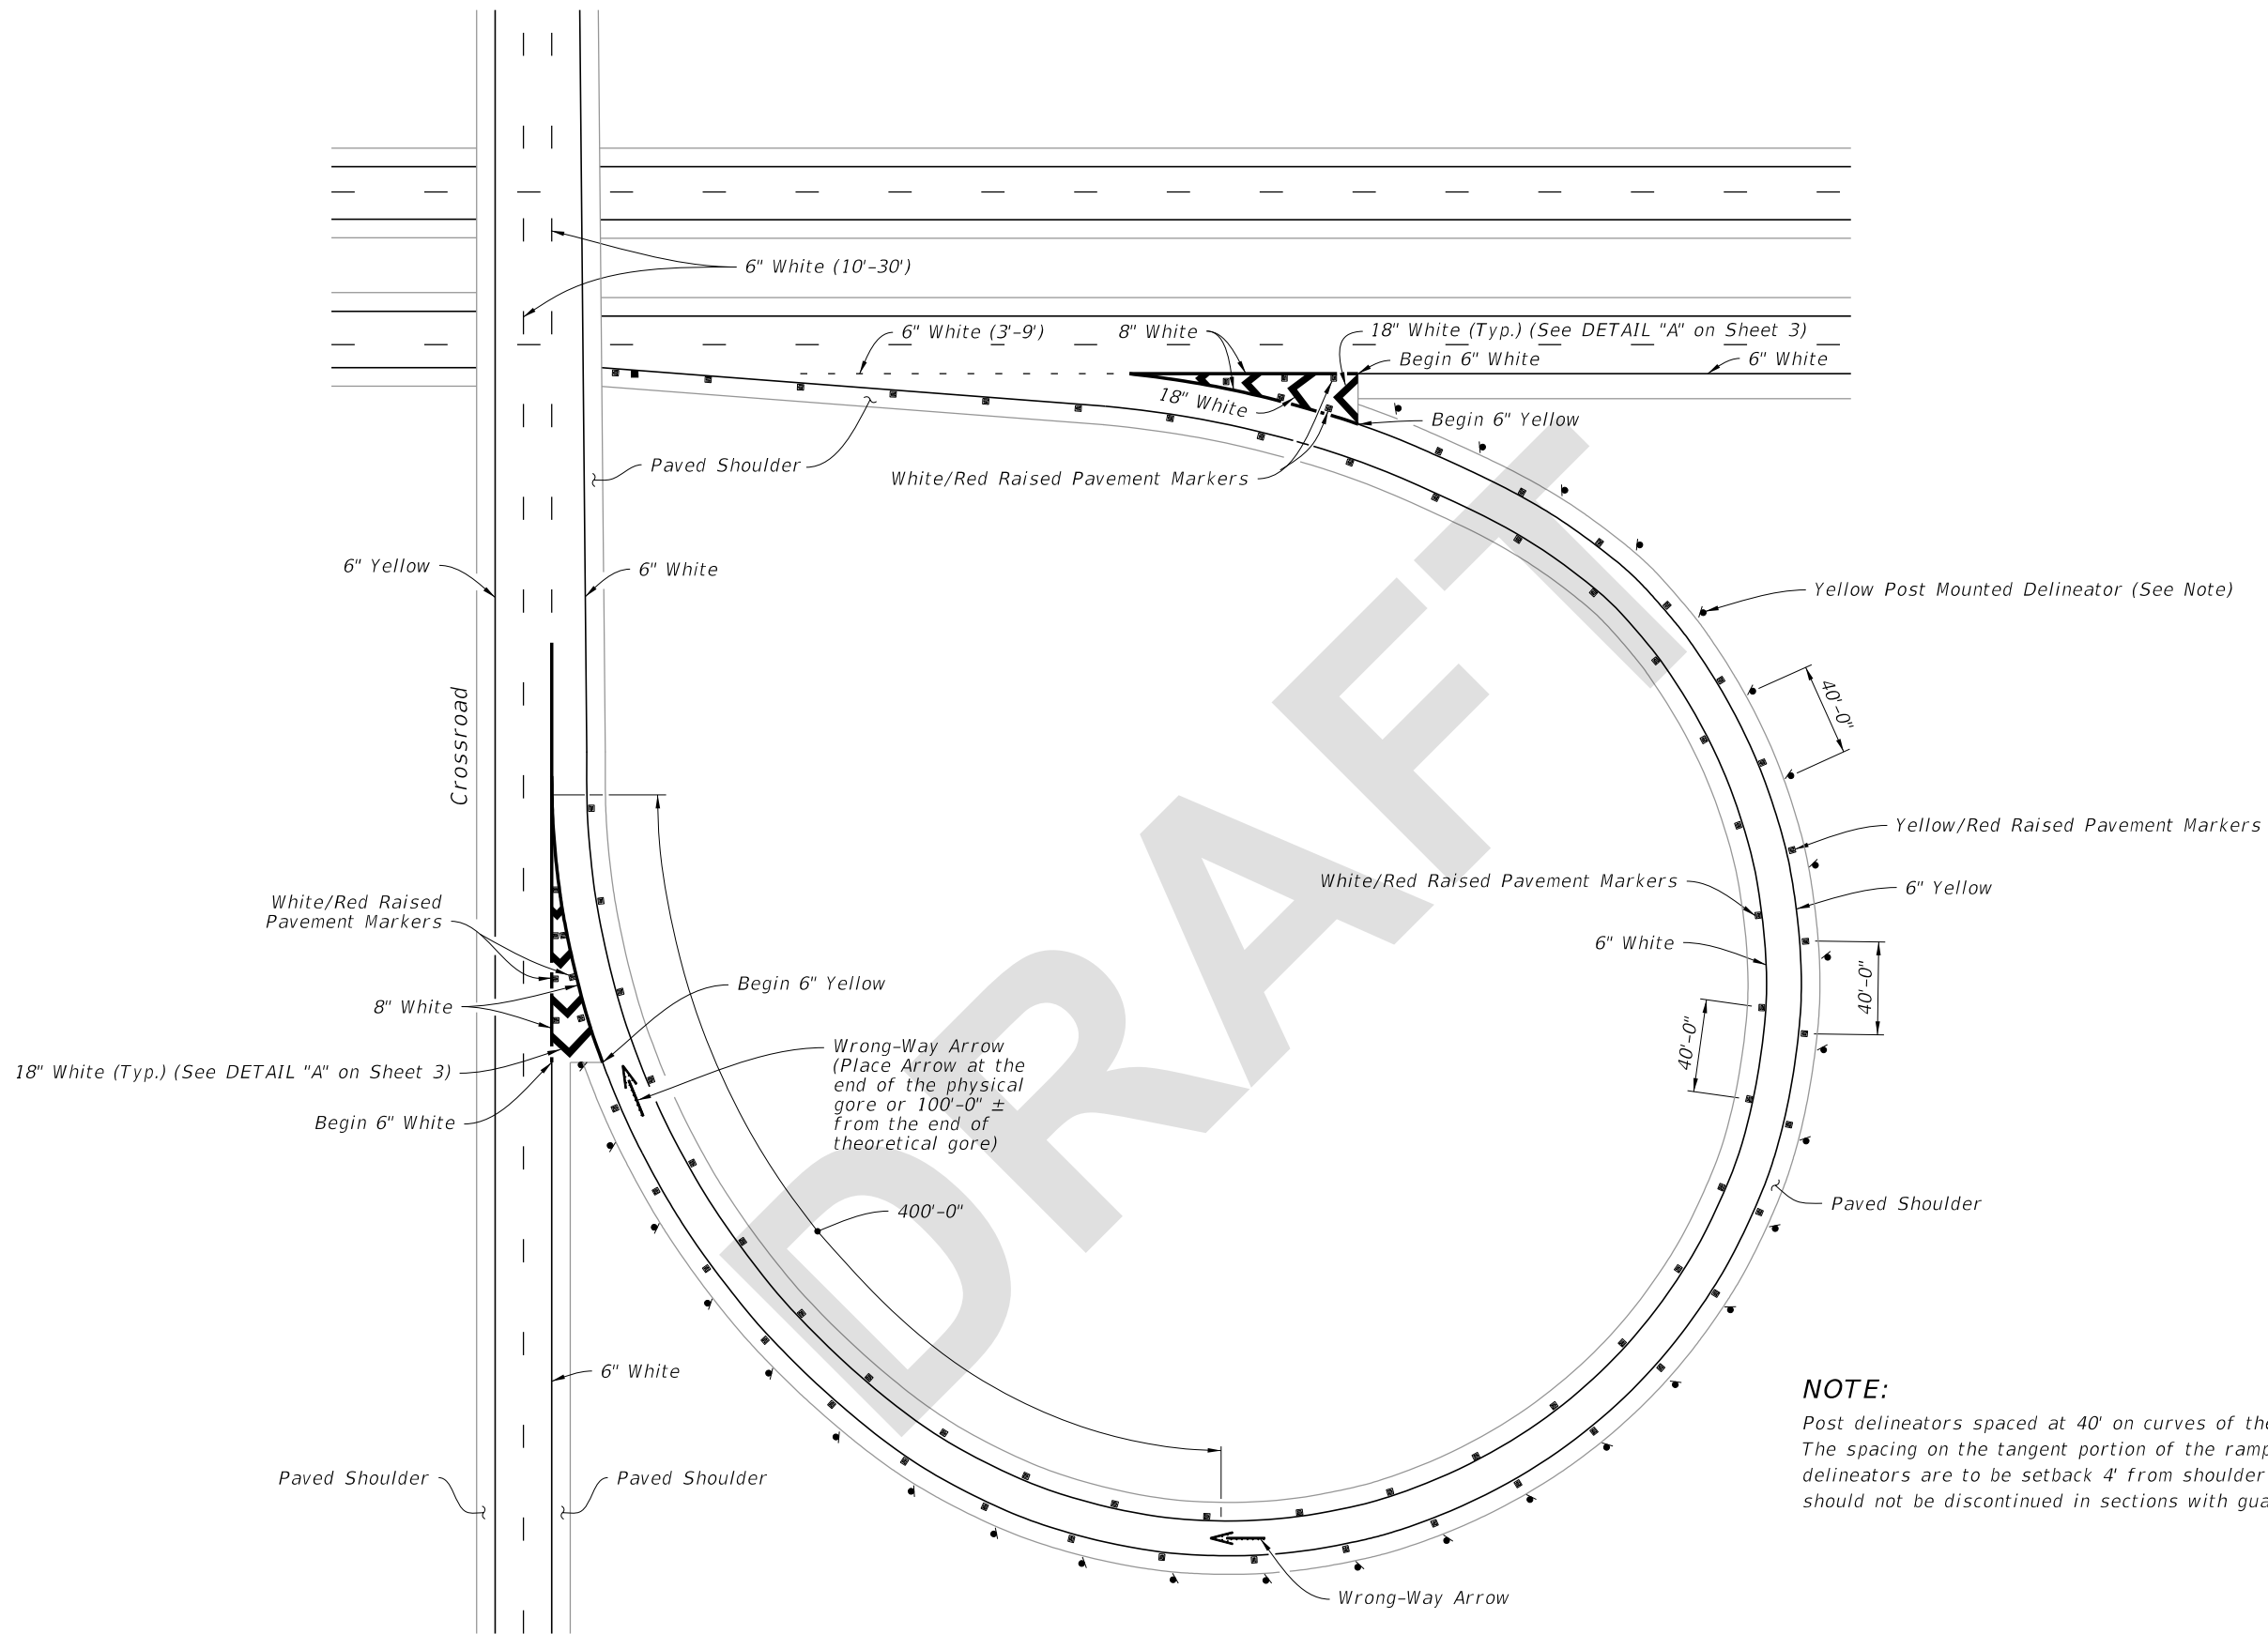


**NOTE:**  
 Post delineators spaced at 40' on curves of the entrance and exit of ramps.  
 The spacing on the tangent portion of the ramp section is 300'-0". All delineators are to be setback 4' from shoulder break. Post delineators should not be discontinued in sections with guardrail.

TYPICAL CURVED EXIT RAMP

TYPICAL CURVED EXIT RAMP


LAST REVISION 11/01/25	DESCRIPTION:	 FY 2026-27 STANDARD PLANS	INTERCHANGE MARKINGS	INDEX 711-003	SHEET 5 of 8
---------------------------	--------------	---	----------------------	------------------	-----------------

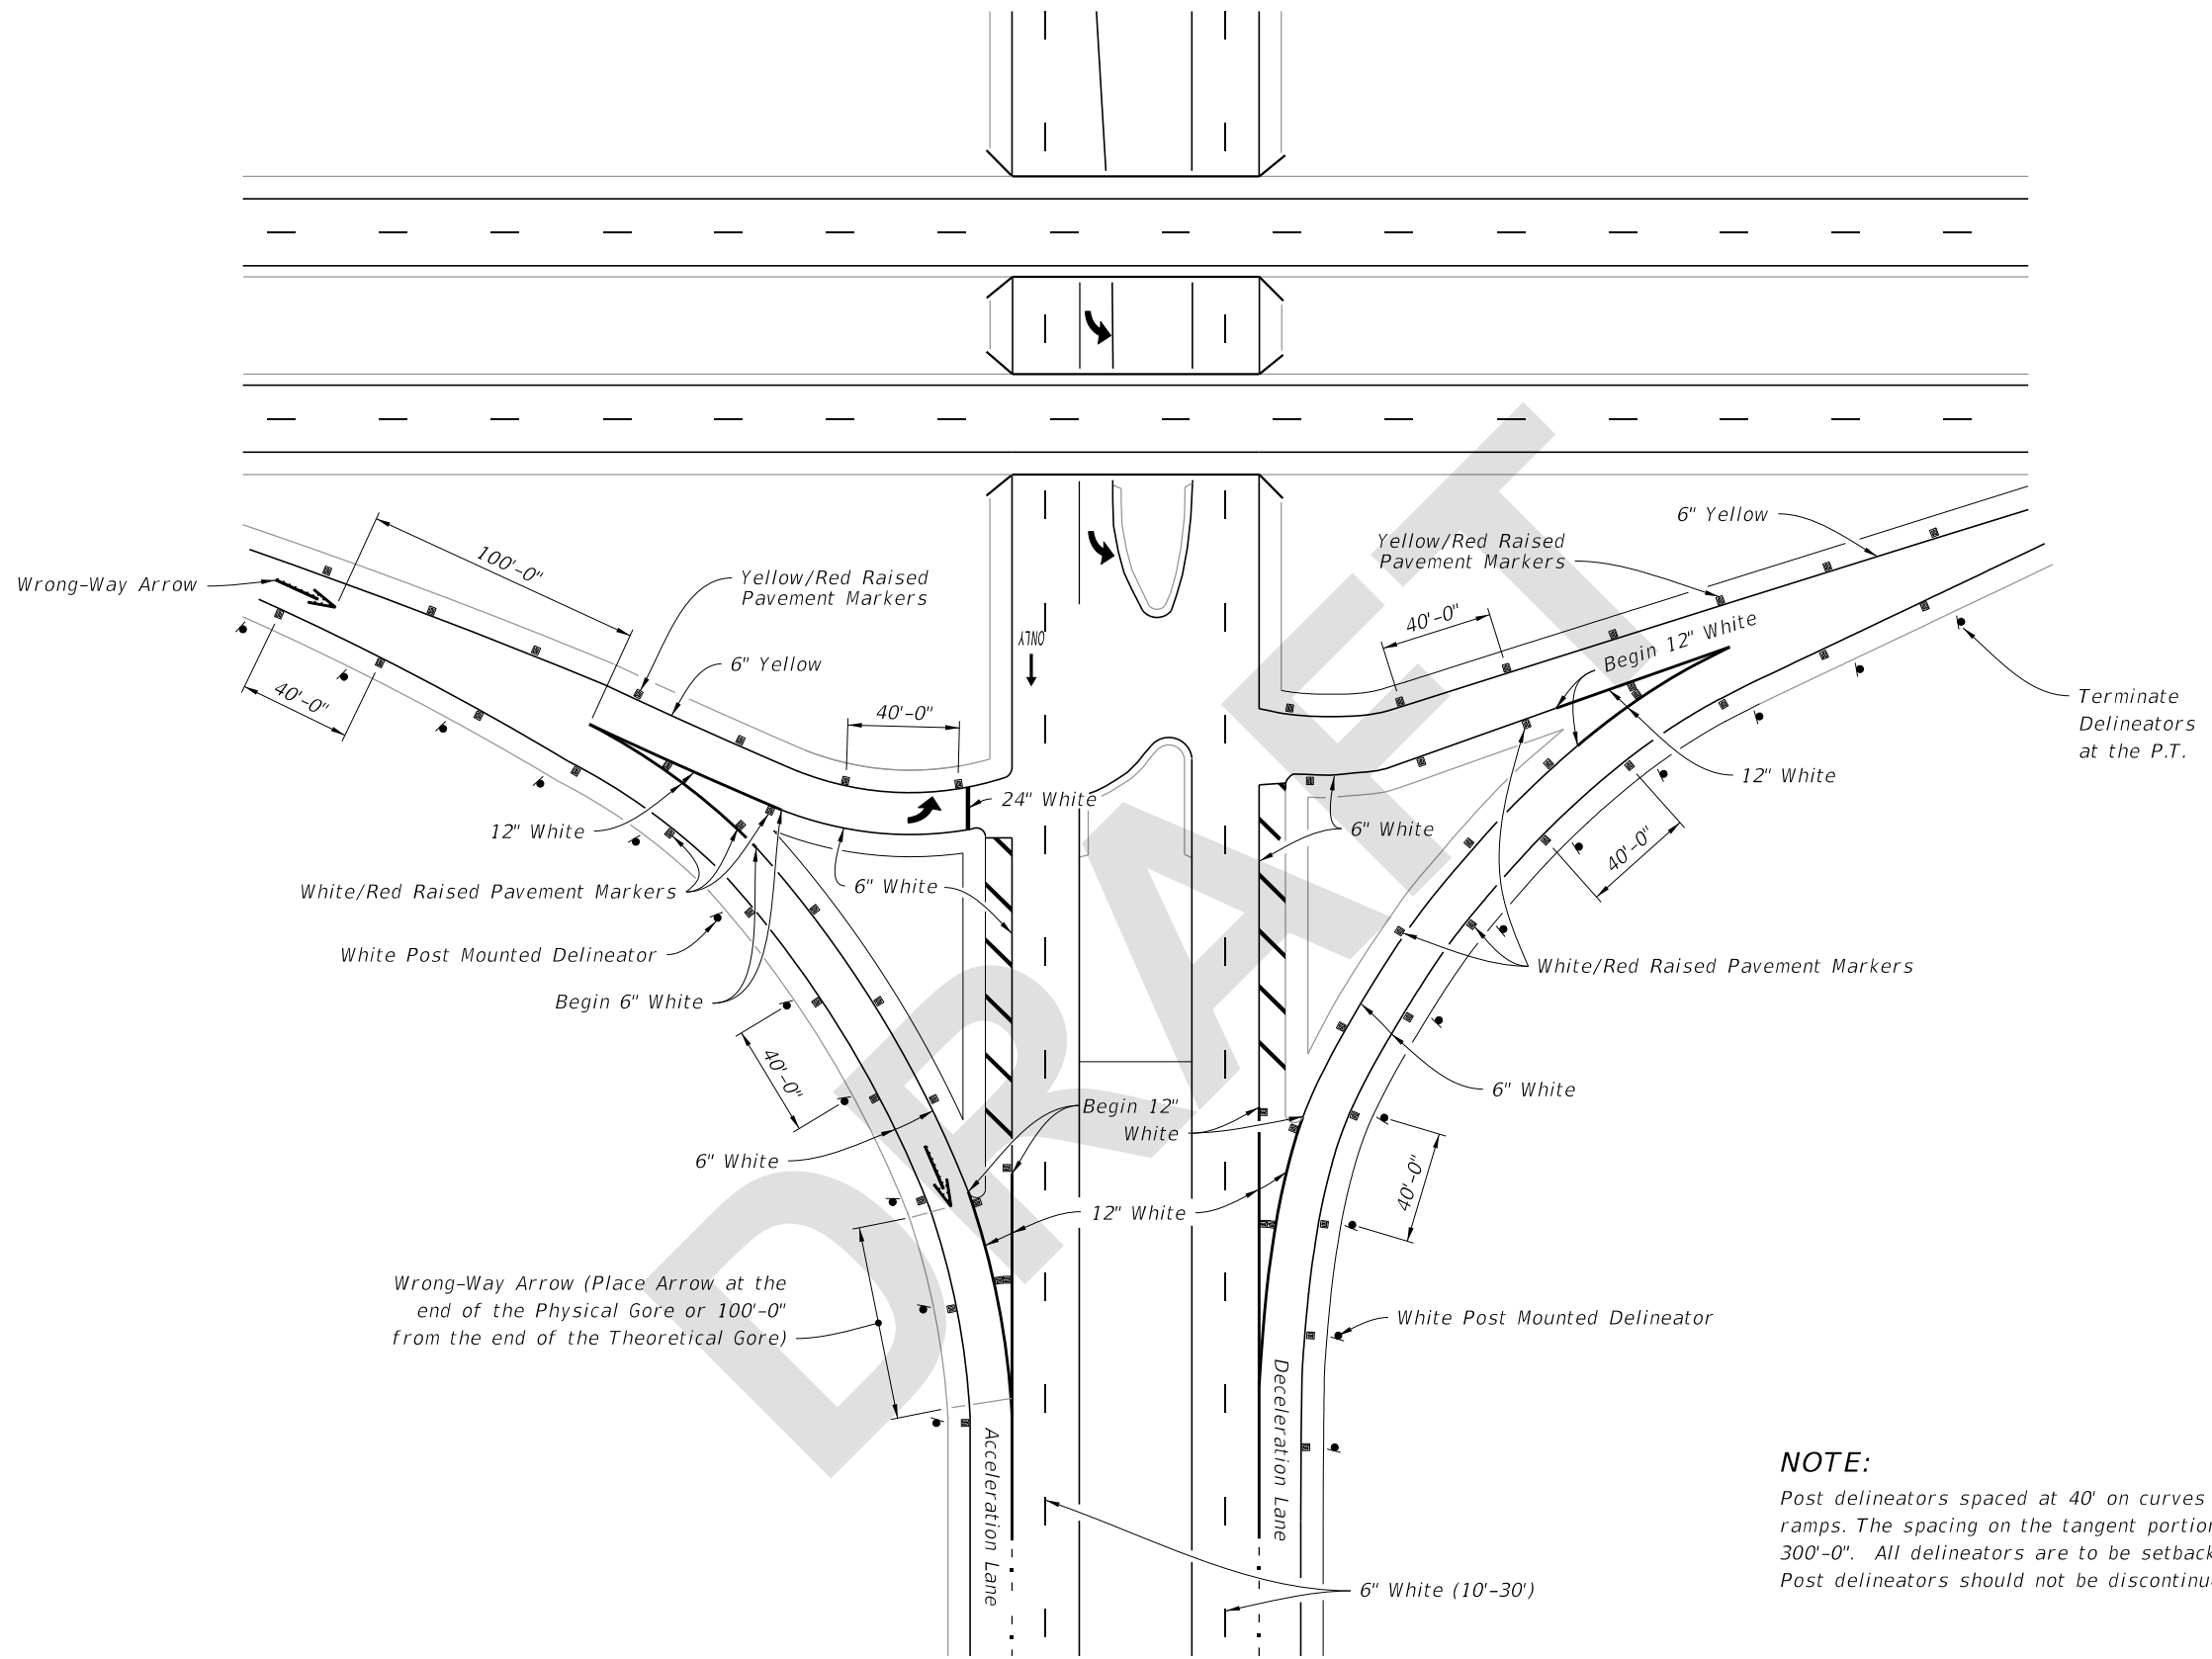


**NOTE:**  
 Post delineators spaced at 40' on curves of the entrance and exit of ramps. The spacing on the tangent portion of the ramp section is 300'-0". All delineators are to be setback 4' from shoulder break. Post delineators should not be discontinued in sections with guardrail.

7/11/2025 7:09:03 AM

**TYPICAL INTERSECTION**


LAST REVISION 11/01/25	REVISION	DESCRIPTION:		FY 2026-27 STANDARD PLANS	INTERCHANGE MARKINGS	INDEX 711-003	SHEET 6 of 8
---------------------------	----------	--------------	--	------------------------------	----------------------	------------------	-----------------

7/11/2025 7:09:10 AM

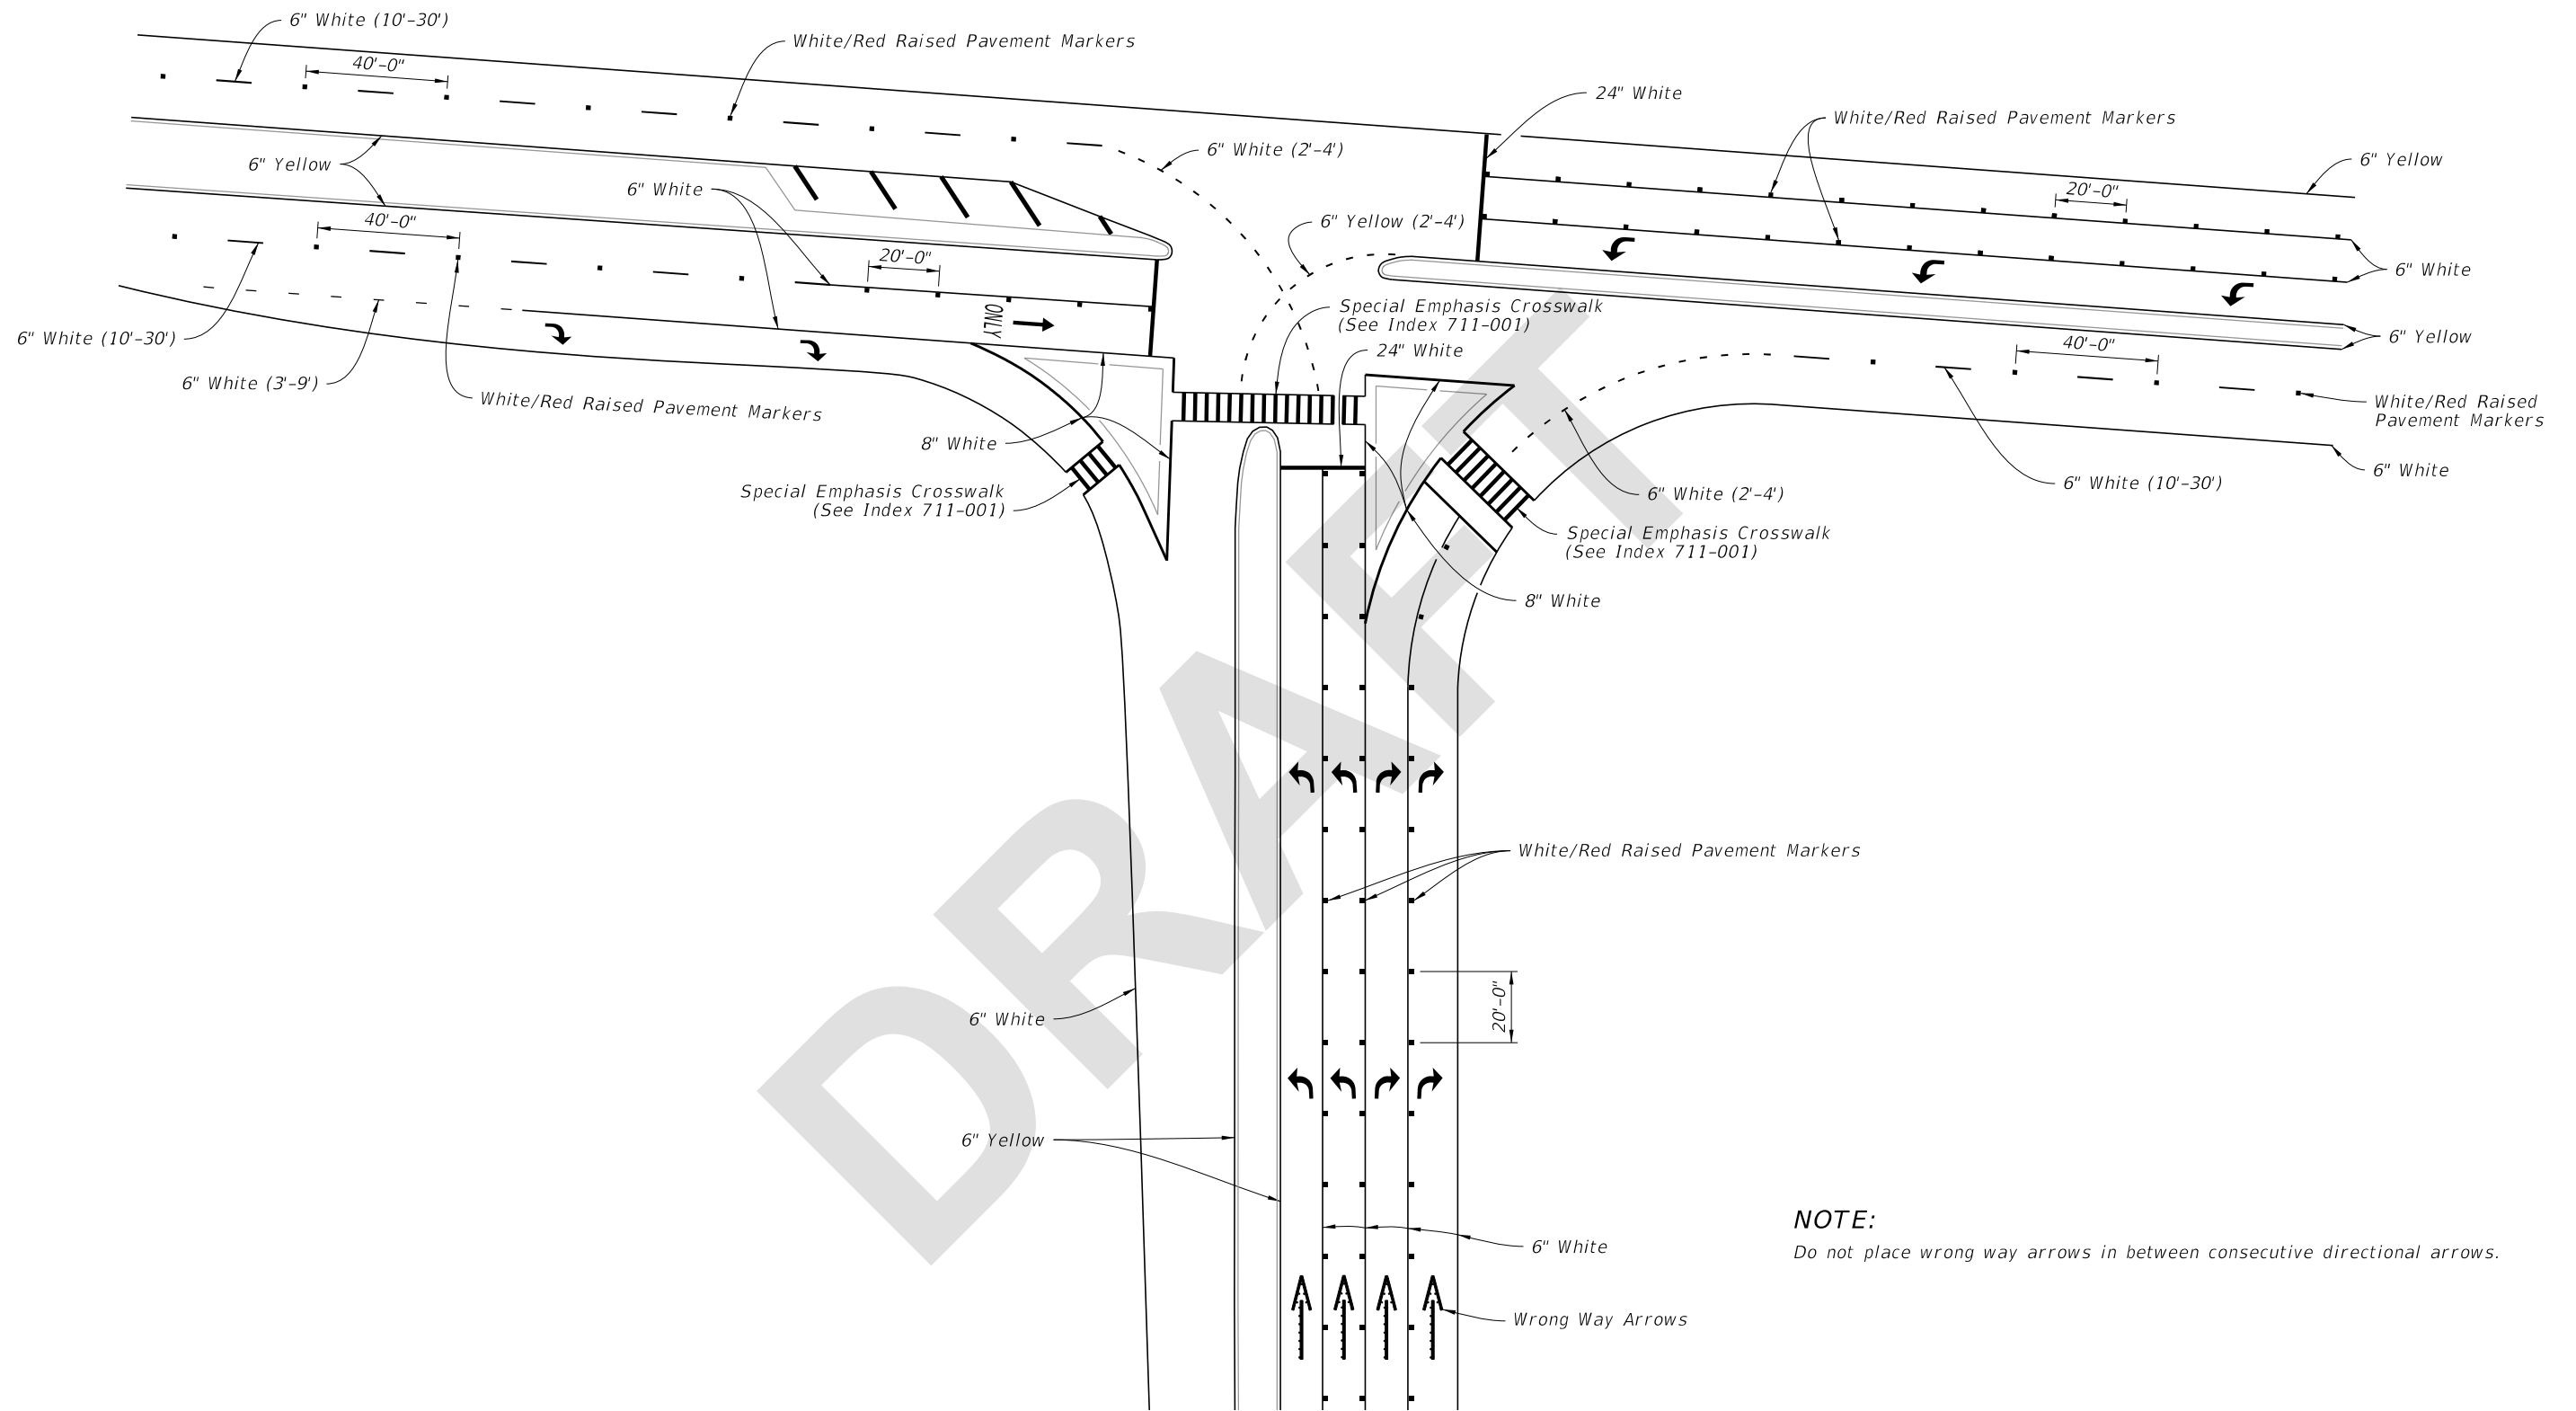

**NOTE:**  
Do not place wrong way arrows in between consecutive directional arrows.

TYPICAL PARTIAL CLOVERLEAF/TRUMPET EXIT RAMP

LAST REVISION 11/01/25	REVISION DESCRIPTION:	 FY 2026-27 STANDARD PLANS	INTERCHANGE MARKINGS	INDEX 711-003	SHEET 7 of 8
---------------------------	--------------------------	--	----------------------	------------------	-----------------