

Origination Form
Proposed Revisions to a Standard Plans Index

Originator:	Gray, Ryan	Index Number:	711-003
Date:	8/6/2025	Sheet Number(s):	6
E-mail:	ryan.gray@dot.state.fl.us	Index Title:	Interchange Markings

Summary of the changes:

Sheet 6: DELETED arrow pointers for 6" white lines; CHANGED 12" to 8"; UPDATED Note 1; ADDED Note 2; ADDED Detail "C"; ADDED chevron markings to gores; CLARIFIED edge of pavement details.


Commentary/Background:

For traffic passing to the right of the gores at the collector ends of ramps, the inside edge line adjacent to the physical gore should be a wide white line, or a yellow edgeline, to be consistent with MUTCD guidance. Added Note 2 to clarify RPM color for either channelizing/edgeline option; Updated Note 1 to clarify delineator spacings and termination point; Added chevrons and related Detail "C".

Other Affected Documents/Offices	Person Contacted	Affected (Yes/No)
Other Standard Plans		No
FDOT Design Manual		No
Standard Specifications		No
Basis of Estimates Manual		No
Approved Product List		No
Construction Office		No
Maintenance Office		No

Implementation

["FY-Standard Plans (Next Release)"]

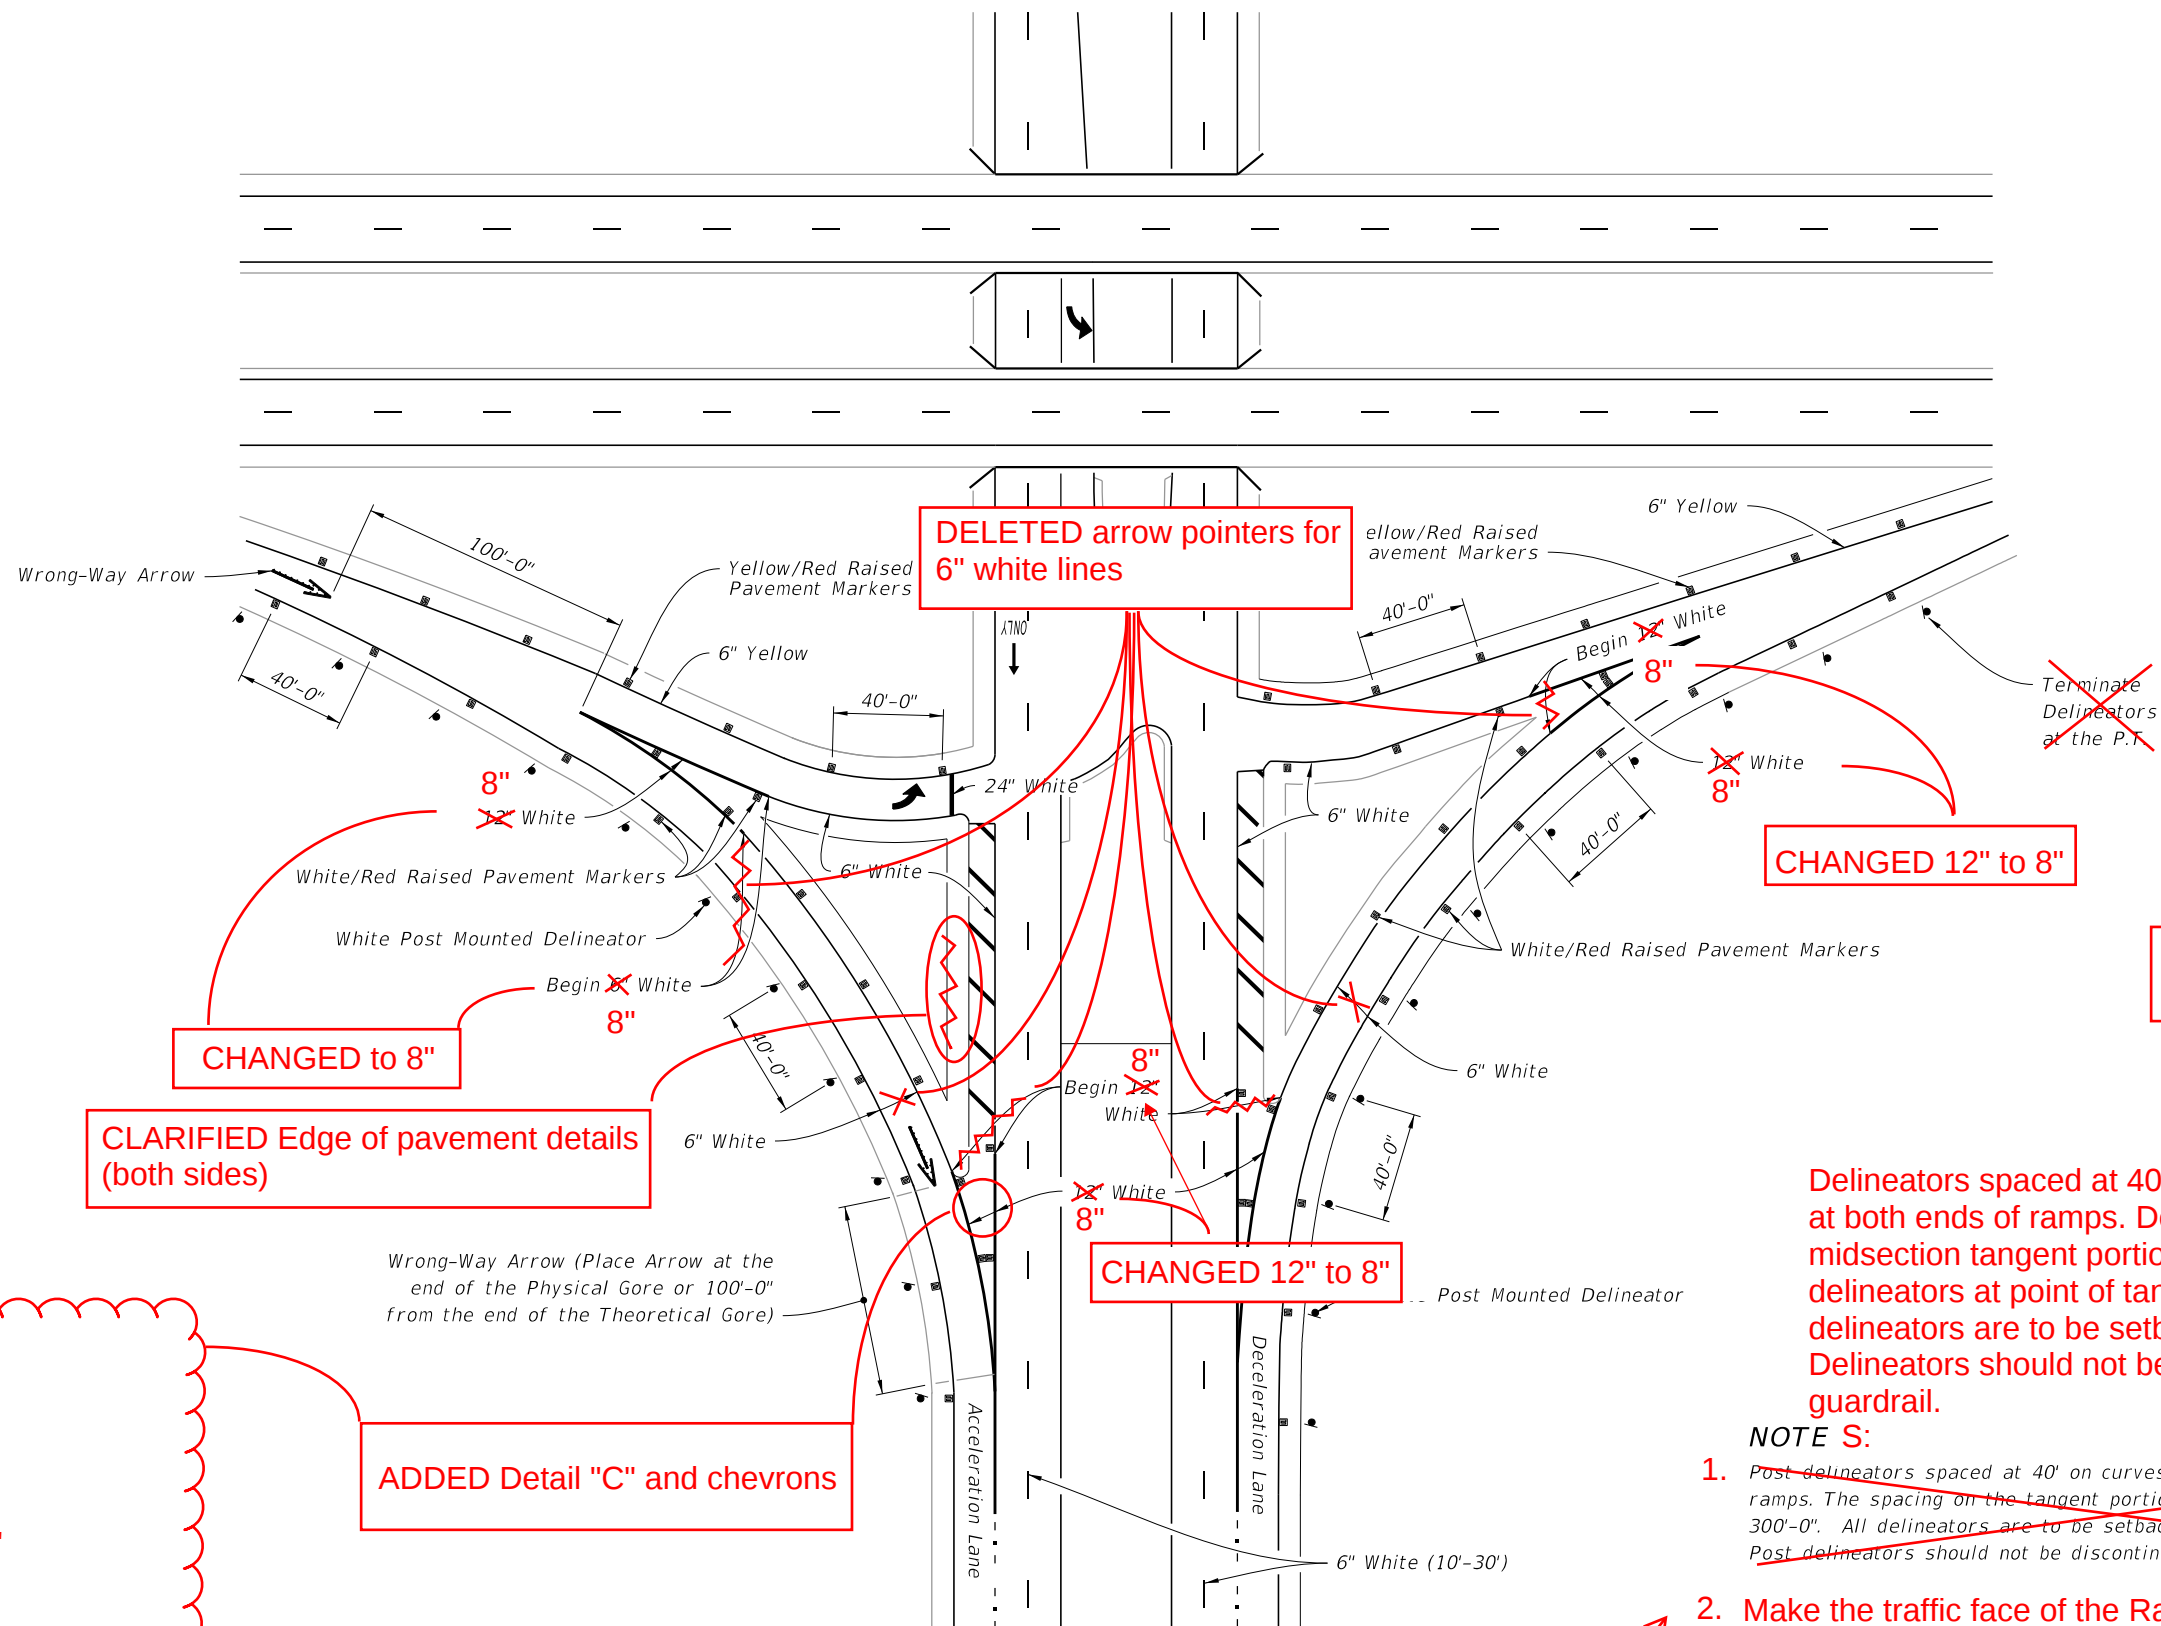

2026-27

TYPICAL INTERSECTION

LAST REVISION 11/01/21	DESCRIPTION: 11/01/25	FDOT FY 2025-26 STANDARD PLANS	INTERCHANGE MARKINGS	INDEX 711-003	SHEET 6 of 8
--	-------------------------------------	---	-----------------------------	-----------------------------	----------------------------

